


Vermont Agency of Transportation
RECEIVED
 ON: March 21, 2016
 and Checked for
CONFORMANCE
 BY: ABC DATE:

- NO EXCEPTION TAKEN
- MAKE CORRECTIONS NOTED
- REJECTED
- REVISE AND RESUBMIT
- SUBMIT SPECIFIED ITEM

CHECKING IS ONLY FOR THE GENERAL CONFORMANCE WITH THE DESIGN CONCEPT OF THE PROJECT AND GENERAL COMPLIANCE WITH THE INFORMATION GIVEN IN THE CONTRACT DOCUMENTS. ANY ACTION SHOWN IS SUBJECT TO THE REQUIREMENTS OF THE PLANS AND SPECIFICATIONS. CONTRACTOR IS RESPONSIBLE FOR DIMENSIONS WHICH SHALL BE CONFIRMED AND CORRELATED AT THE JOB SITE; FABRICATION PROCESSES AND TECHNIQUES OF CONSTRUCTION; COORDINATION OF HIS WORK WITH THAT OF ALL OTHER TRADES AND THE SATISFACTORY PERFORMANCE OF THE WORK.

BILL OF MATERIAL				JOB NO.	DRAWING NO.	REV.	
				598	18		
PAGE/LINE	MARK	QTY	MATERIAL	LENGTH FT INCHES	REMARKS	MT	PROCUREMENT NOTES
	18FB1	1	FLOORBEAM		SEE NOTE "C" ALIKE EXCEPT FOR MARK		4195
	18FB7	1	FLOORBEAM		SEE NOTE "C"		4195
1	Y	2	a18	W 24x117	31' 11 1/16	M270-S0F2 (FCM)	3735
4	H	8	x8k	WT 8x35.5	1' 2 3/8	RENT M270-S0F2 (FCM)	43
4	K	4	x6t	L 6x4x 1/2	1' 4 1/2	M270-S0F2 (FCM)	22
4	K	4	x6v	L 6x4x 1/2	1' 4 1/2	M270-S0F2 (FCM)	22
4	L	4	x6w	PL 1/2x7 1/4	1' 0 3/4	FILL	7
6	E	280	STUD 7/8"	0' 7"	RBW		1
	18FB10	1	FLOORBEAM		SEE NOTE "C" ALIKE EXCEPT FOR MARK		4195
	18FB18	1	FLOORBEAM		SEE NOTE "C"		4195
1	Y	2	b18	W 24x117	31' 11 1/16	M270-S0F2 (FCM)	3735
4	H	8	x8k	WT 8x35.5	1' 2 3/8	RENT M270-S0F2 (FCM)	43
4	K	4	x6t	L 6x4x 1/2	1' 4 1/2	M270-S0F2 (FCM)	22
4	K	4	x6v	L 6x4x 1/2	1' 4 1/2	M270-S0F2 (FCM)	22
4	L	4	x6w	PL 1/2x7 1/4	1' 0 3/4	FILL	7
6	E	280	STUD 7/8"	0' 7"	RBW		1

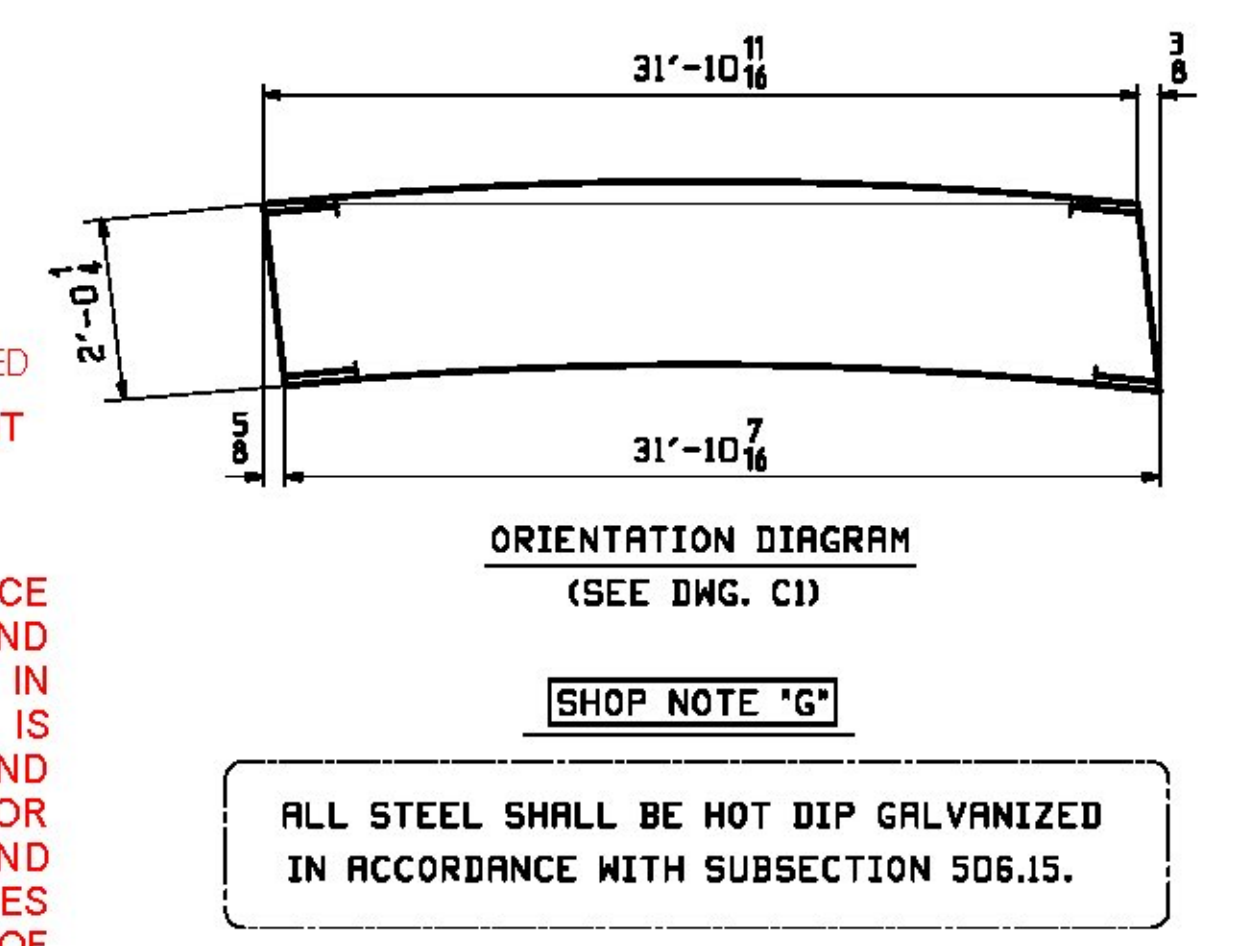

FLOORBEAM DATE: 1/29/2016 BY: J. Najdowski

MARK	REQ'D	SECT.- ①	②
ALIKE EXCEPT FOR MARK (e L1)	ONE	C1	a18
(e L7)	ONE		
ALIKE EXCEPT FOR MARK (e L10)	ONE	C2	b18
(e L18)	ONE		

- NOTES:
 1. FOR GENERAL NOTES SEE DWG. GNI.
 2. FOR STANDARD DETAILS SEE DWG. X6.
 3. BTS DENOTES BOLT TO SHIP OR SECURE FOR SHIPMENT.

REV.	DATE	REMARKS	DWN	CHK	APVL	SHOP
0						
MATERIAL:		SURFACE PREP. & PAINT:		HOLES:		SHOP BOLTS:
M270-S0 (UN)		SEE DWG. GNI		15 16"		NONE
DESCRIPTION: FLOORBEAM DETAILS						
CASCO BAY STEEL STRUCTURES, INC. 1 WALLACE AVE. SOUTH PORTLAND, ME 04106 PHONE (207) 780-6722 FAX (207) 780-6726				TENSAR STRUCTURES		
STRUCTURE: TH-10 OVER OTTER CREEK PONY TRUSS BRIDGE				DRAWN:	DATE:	
				RB	12/22/15	
				CHKD:	DATE:	
				WJL	1/15/16	
LOCATION: RUTLAND CITY, VERMONT				JOB NO.	DWG NO.	
PROJ NO. BRF 3000 (19)				598	18	
CUSTOMER: KUBRICKY CONSTRUCTION CORP.					REV.	