


VIEW B-B
ONE ~ DIAGONAL ~ 30L9U10N
(L9 - U10 NORTH)

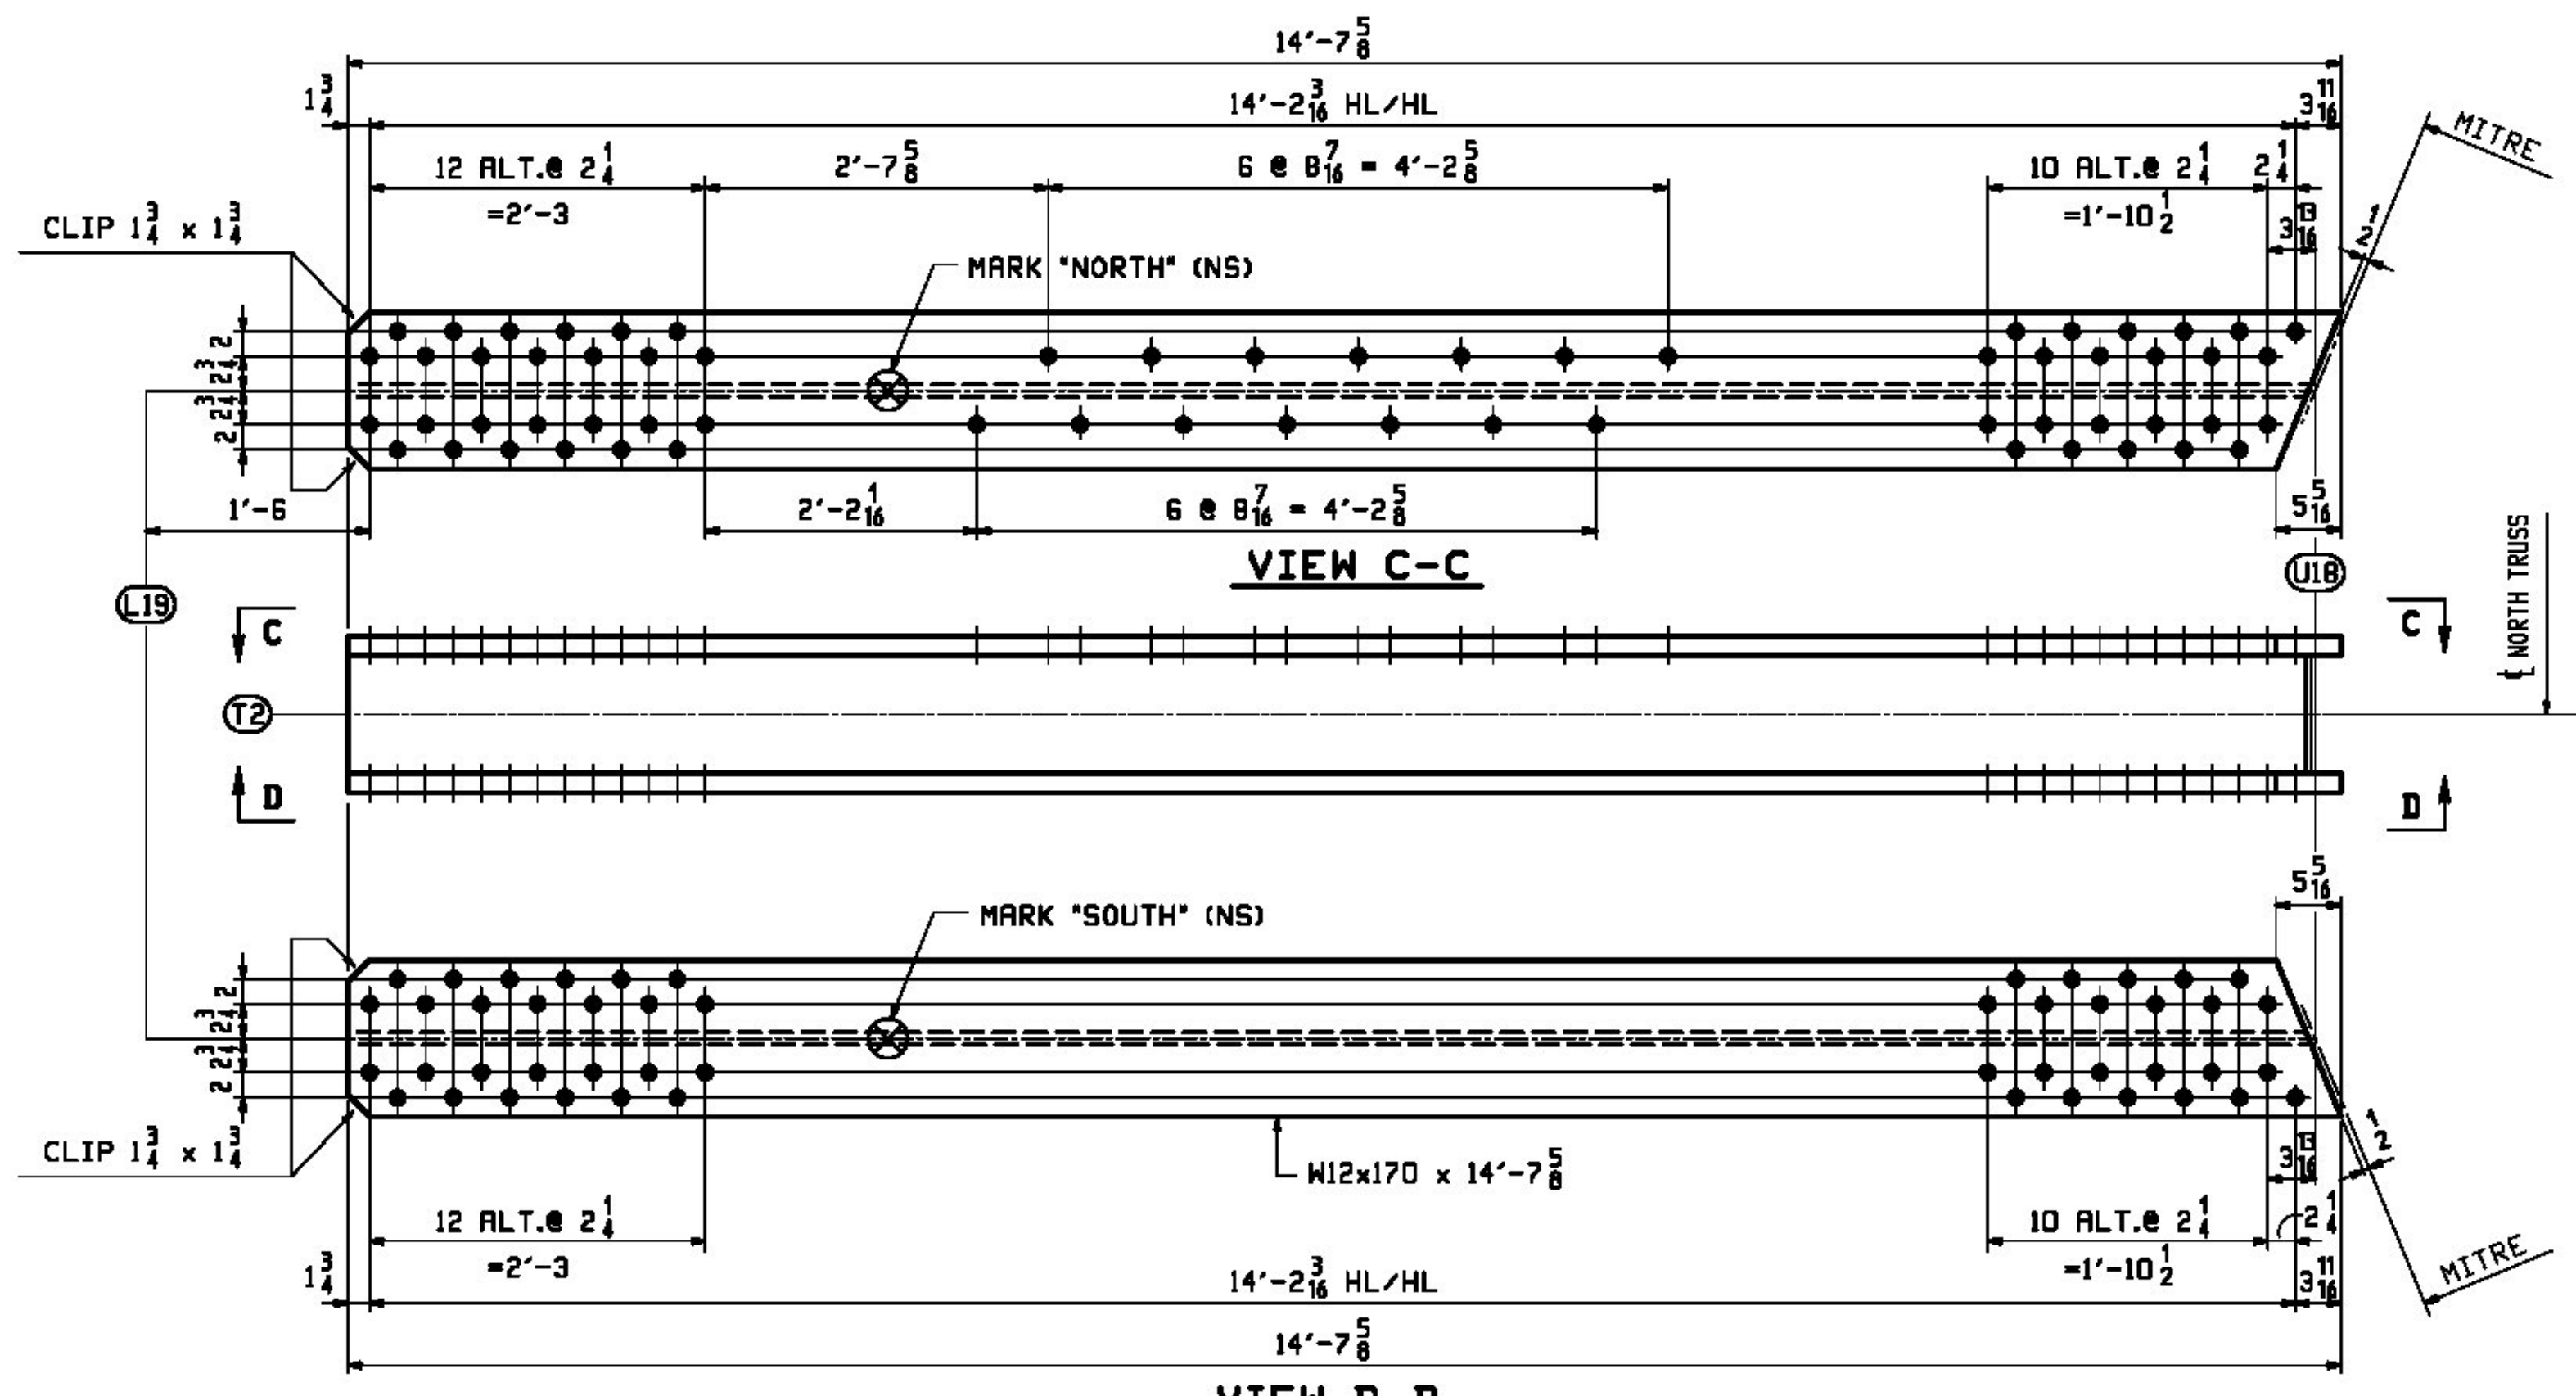

VIEW D-D
ONE ~ DIAGONAL ~ 30L19U18N
(L19 - U18 NORTH)

Vermont Agency of Transportation
RECEIVED
ON: March 21, 2016
and Checked for
CONFORMANCE
BY: ABC DATE:

BILL OF MATERIAL					JOB NO.	DRAWING NO.	REV.
					598	30	
PAGE LINE	MARK	QTY	MATERIAL	LENGTH FT INCHES	REMARKS	MT	PROCUREMENT NOTES
			DIAGONALS				
1	M	30L9U10N	M 12x170	14'-7 5/8"	GRV. M270-SQT2 (CVN)		2489
1	M	30L19U18N	M 12x170	14'-7 5/8"	GRV. M270-SQT2 (CVN)		2489

SHOP NOTE 'G'
ALL STEEL SHALL BE HOT DIP GALVANIZED
IN ACCORDANCE WITH SUBSECTION 506.15.

- NO EXCEPTION TAKEN
- MAKE CORRECTIONS NOTED
- REJECTED
- REVISE AND RESUBMIT
- SUBMIT SPECIFIED ITEM

CHECKING IS ONLY FOR THE GENERAL CONFORMANCE WITH THE DESIGN CONCEPT OF THE PROJECT AND GENERAL COMPLIANCE WITH THE INFORMATION GIVEN IN THE CONTRACT DOCUMENTS. ANY ACTION SHOWN IS SUBJECT TO THE REQUIREMENTS OF THE PLANS AND SPECIFICATIONS. CONTRACTOR IS RESPONSIBLE FOR DIMENSIONS WHICH SHALL BE CONFIRMED AND CORRELATED AT THE JOB SITE; FABRICATION PROCESSES AND TECHNIQUES OF CONSTRUCTION; COORDINATION OF HIS WORK WITH THAT OF ALL OTHER TRADES AND THE SATISFACTORY PERFORMANCE OF THE WORK.

CHA
DATE 1/29/2016 BY J. Najdowski

- NOTES:
- FOR GENERAL NOTES SEE DWG. GNI.
 - CVN - DENOTES MATERIAL SUBJECT TO CHARNY V-NOTCH TESTING.

REV.	DATE	REMARKS	DNW	CHK	APVL	SHOP
0						
MATERIAL: M270-50		SURFACE PREP. & PAINT: SEE DWG. GNI	HOLES: 15 1/16"		SHOP BOLTS: NONE	
DESCRIPTION: TRUSS DIAGONALS						
STRUCTURE: TH-10 OVER OTTER CREEK PONY TRUSS BRIDGE		DRAWN: RB		DATE: 12/19/15		
		CHKD: WJL		DATE: 1/19/16		
LOCATION: RUTLAND CITY, VERMONT			JOB NO. 598		DWG NO. 30	
PROJ NO. BRF 3000 (19)			CUSTOMER: KUBRICKY CONSTRUCTION CORP.		REV. 30	

1/16" 1/8" 3/16" 1/4" 5/16" 3/8" 1/2" 5/8" 3/4" 7/8" 1" 1 1/8" 1 1/4" 1 1/2" 1 3/4" 1 7/8" 2" 2 1/8" 2 1/4" 2 1/2" 2 3/4" 3" 3 1/8" 3 1/4" 3 1/2" 3 3/4" 4" 4 1/8" 4 1/4" 4 1/2" 4 3/4" 5" 5 1/8" 5 1/4" 5 1/2" 5 3/4" 6" 6 1/8" 6 1/4" 6 1/2" 6 3/4" 7" 7 1/8" 7 1/4" 7 1/2" 7 3/4" 8" 8 1/8" 8 1/4" 8 1/2" 8 3/4" 9" 9 1/8" 9 1/4" 9 1/2" 9 3/4" 10" 10 1/8" 10 1/4" 10 1/2" 10 3/4" 11" 11 1/8" 11 1/4" 11 1/2" 11 3/4" 12" 12 1/8" 12 1/4" 12 1/2" 12 3/4" 13" 13 1/8" 13 1/4" 13 1/2" 13 3/4" 14" 14 1/8" 14 1/4" 14 1/2" 14 3/4" 15" 15 1/8" 15 1/4" 15 1/2" 15 3/4" 16" 16 1/8" 16 1/4" 16 1/2" 16 3/4" 17" 17 1/8" 17 1/4" 17 1/2" 17 3/4" 18" 18 1/8" 18 1/4" 18 1/2" 18 3/4" 19" 19 1/8" 19 1/4" 19 1/2" 19 3/4" 20" 20 1/8" 20 1/4" 20 1/2" 20 3/4" 21" 21 1/8" 21 1/4" 21 1/2" 21 3/4" 22" 22 1/8" 22 1/4" 22 1/2" 22 3/4" 23" 23 1/8" 23 1/4" 23 1/2" 23 3/4" 24" 24 1/8" 24 1/4" 24 1/2" 24 3/4" 25" 25 1/8" 25 1/4" 25 1/2" 25 3/4" 26" 26 1/8" 26 1/4" 26 1/2" 26 3/4" 27" 27 1/8" 27 1/4" 27 1/2" 27 3/4" 28" 28 1/8" 28 1/4" 28 1/2" 28 3/4" 29" 29 1/8" 29 1/4" 29 1/2" 29 3/4" 30" 30 1/8" 30 1/4" 30 1/2" 30 3/4" 31" 31 1/8" 31 1/4" 31 1/2" 31 3/4" 32" 32 1/8" 32 1/4" 32 1/2" 32 3/4" 33" 33 1/8" 33 1/4" 33 1/2" 33 3/4" 34" 34 1/8" 34 1/4" 34 1/2" 34 3/4" 35" 35 1/8" 35 1/4" 35 1/2" 35 3/4" 36" 36 1/8" 36 1/4" 36 1/2" 36 3/4" 37" 37 1/8" 37 1/4" 37 1/2" 37 3/4" 38" 38 1/8" 38 1/4" 38 1/2" 38 3/4" 39" 39 1/8" 39 1/4" 39 1/2" 39 3/4" 40" 40 1/8" 40 1/4" 40 1/2" 40 3/4" 41" 41 1/8" 41 1/4" 41 1/2" 41 3/4" 42" 42 1/8" 42 1/4" 42 1/2" 42 3/4" 43" 43 1/8" 43 1/4" 43 1/2" 43 3/4" 44" 44 1/8" 44 1/4" 44 1/2" 44 3/4" 45" 45 1/8" 45 1/4" 45 1/2" 45 3/4" 46" 46 1/8" 46 1/4" 46 1/2" 46 3/4" 47" 47 1/8" 47 1/4" 47 1/2" 47 3/4" 48" 48 1/8" 48 1/4" 48 1/2" 48 3/4" 49" 49 1/8" 49 1/4" 49 1/2" 49 3/4" 50" 50 1/8" 50 1/4" 50 1/2" 50 3/4" 51" 51 1/8" 51 1/4" 51 1/2" 51 3/4" 52" 52 1/8" 52 1/4" 52 1/2" 52 3/4" 53" 53 1/8" 53 1/4" 53 1/2" 53 3/4" 54" 54 1/8" 54 1/4" 54 1/2" 54 3/4" 55" 55 1/8" 55 1/4" 55 1/2" 55 3/4" 56" 56 1/8" 56 1/4" 56 1/2" 56 3/4" 57" 57 1/8" 57 1/4" 57 1/2" 57 3/4" 58" 58 1/8" 58 1/4" 58 1/2" 58 3/4" 59" 59 1/8" 59 1/4" 59 1/2" 59 3/4" 60" 60 1/8" 60 1/4" 60 1/2" 60 3/4" 61" 61 1/8" 61 1/4" 61 1/2" 61 3/4" 62" 62 1/8" 62 1/4" 62 1/2" 62 3/4" 63" 63 1/8" 63 1/4" 63 1/2" 63 3/4" 64" 64 1/8" 64 1/4" 64 1/2" 64 3/4" 65" 65 1/8" 65 1/4" 65 1/2" 65 3/4" 66" 66 1/8" 66 1/4" 66 1/2" 66 3/4" 67" 67 1/8" 67 1/4" 67 1/2" 67 3/4" 68" 68 1/8" 68 1/4" 68 1/2" 68 3/4" 69" 69 1/8" 69 1/4" 69 1/2" 69 3/4" 70" 70 1/8" 70 1/4" 70 1/2" 70 3/4" 71" 71 1/8" 71 1/4" 71 1/2" 71 3/4" 72" 72 1/8" 72 1/4" 72 1/2" 72 3/4" 73" 73 1/8" 73 1/4" 73 1/2" 73 3/4" 74" 74 1/8" 74 1/4" 74 1/2" 74 3/4" 75" 75 1/8" 75 1/4" 75 1/2" 75 3/4" 76" 76 1/8" 76 1/4" 76 1/2" 76 3/4" 77" 77 1/8" 77 1/4" 77 1/2" 77 3/4" 78" 78 1/8" 78 1/4" 78 1/2" 78 3/4" 79" 79 1/8" 79 1/4" 79 1/2" 79 3/4" 80" 80 1/8" 80 1/4" 80 1/2" 80 3/4" 81" 81 1/8" 81 1/4" 81 1/2" 81 3/4" 82" 82 1/8" 82 1/4" 82 1/2" 82 3/4" 83" 83 1/8" 83 1/4" 83 1/2" 83 3/4" 84" 84 1/8" 84 1/4" 84 1/2" 84 3/4" 85" 85 1/8" 85 1/4" 85 1/2" 85 3/4" 86" 86 1/8" 86 1/4" 86 1/2" 86 3/4" 87" 87 1/8" 87 1/4" 87 1/2" 87 3/4" 88" 88 1/8" 88 1/4" 88 1/2" 88 3/4" 89" 89 1/8" 89 1/4" 89 1/2" 89 3/4" 90" 90 1/8" 90 1/4" 90 1/2" 90 3/4" 91" 91 1/8" 91 1/4" 91 1/2" 91 3/4" 92" 92 1/8" 92 1/4" 92 1/2" 92 3/4" 93" 93 1/8" 93 1/4" 93 1/2" 93 3/4" 94" 94 1/8" 94 1/4" 94 1/2" 94 3/4" 95" 95 1/8" 95 1/4" 95 1/2" 95 3/4" 96" 96 1/8" 96 1/4" 96 1/2" 96 3/4" 97" 97 1/8" 97 1/4" 97 1/2" 97 3/4" 98" 98 1/8" 98 1/4" 98 1/2" 98 3/4" 99" 99 1/8" 99 1/4" 99 1/2" 99 3/4" 100" 100 1/8" 100 1/4" 100 1/2" 100 3/4"