


Structure Product Detail						Inside Area View			
Item	Product	Qty	Product Description	Yards	Weight				
	2000000	0.5	TRUCKING, FLAT BED	0.00	0				
Rim	N164250	1	R-1642 HD 26" RD. LID "SEWER"	0.00	126				
Top 1	N164220	1	R-1642 HD 26" RD. FRAME 7" HIGH	0.00	147				
Top 3	0548473	1	48" I.D. X 3'-2" CONE (24"OPEN)	0.68	2,700				
Item 1	0548481	1	48" I.D. X 1' RISER	0.22	867				
Base	0548020	1	48" I.D. X 2' MONO SPECIAL	0.86	3,429				
Misc 1	1403100	4	MASTIC, CON-SEAL, 1" X 14 1/2' (8 ROLLS/BOX) CS-102	0.00	5				
Misc 2	1600013	6	LADDER RUNG, PS2-PFSL 13 3/4"(1 1/4" DIA) (500/P)	0.00	6				
Acces	40612W	1	BOOT, KOR N SEAL 12W-(1-180 BAND)C-12-2-10 IPS	0.00	7				
Acces	60612A	2	BOOT, KOR-N-SEAL 12A-(1-180 BAND)	0.00	14				
	0930002	1	INVERT, SLOPED FOR 2 LINES	0.57	2,300				
	1614801	7	Coating for 48"ID	0.00	0				
	1211180	3	BAND, KOR-N-SEAL 1-180	0.00	0				

Elevations							
Rim	Elev	Angle	Pipe	Hole Type	Hole" Height	Hole" Width	Up"
(1)	518.6						
(1)	511.63	0	8 PVC	60612AWP	12	12	2
(2)	511.73	135	8 DUCTILE	40612WP	12	12	3
(3)	511.73	180	8 PVC	60612AWP	12	12	3
(4)		0			0	0	0
(5)		0			0	0	0
(6)		0			0	0	0
(7)		0			0	0	0
(8)		0			0	0	0

Description: 48" I.D. X 2' MONO SPECIAL  
 Product ID: 0548020S  
 Item: Base Step Location: 90

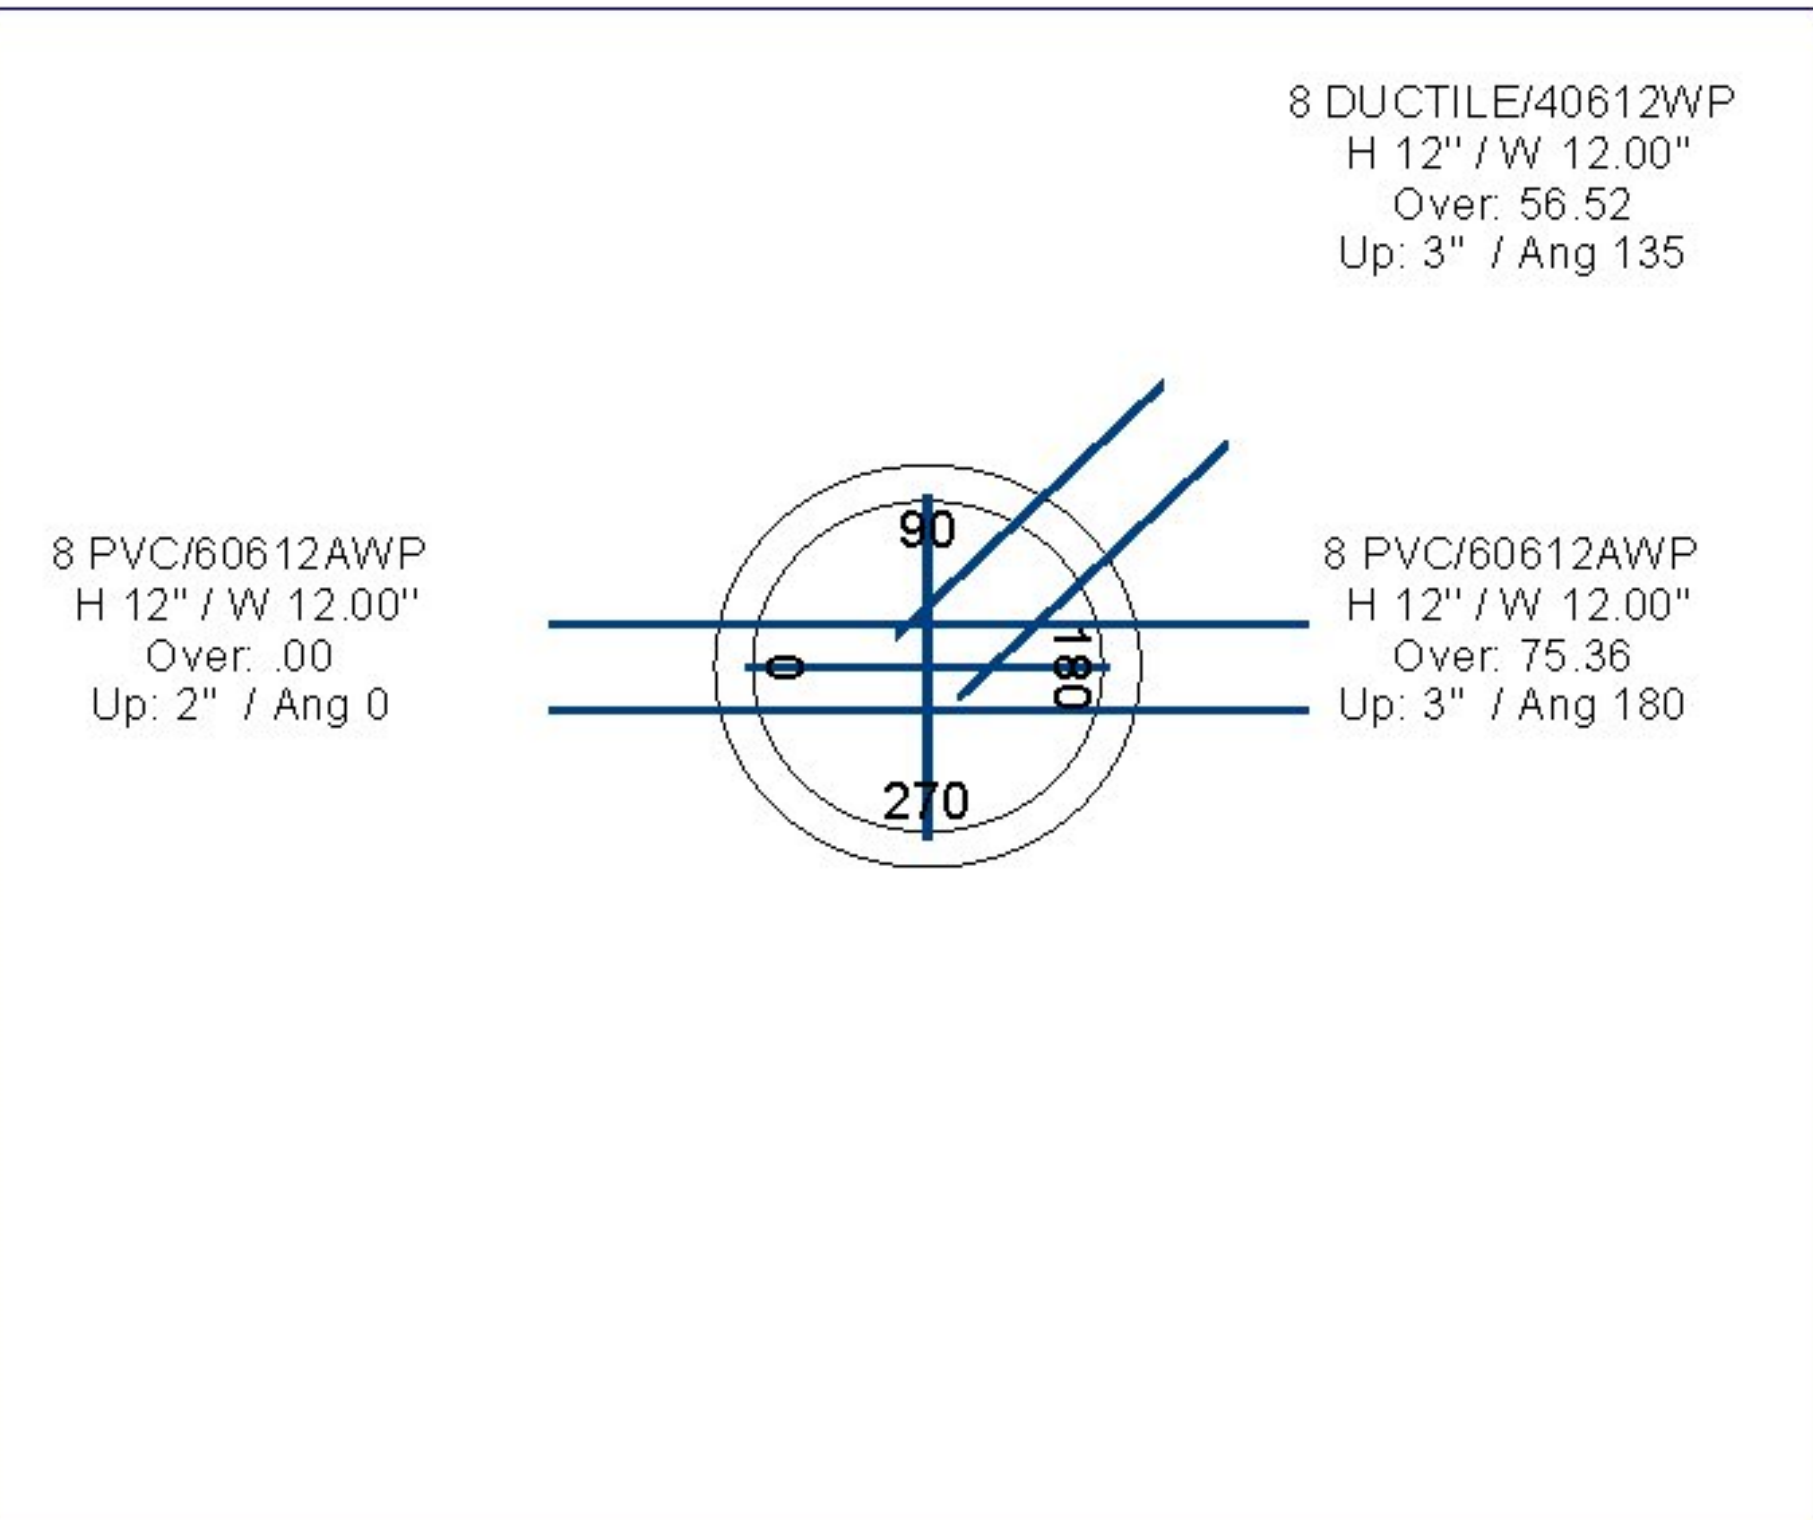

- NO EXCEPTION TAKEN
- MAKE CORRECTIONS NOTED
- REJECTED
- REVISE AND RESUBMIT
- SUBMIT SPECIFIED ITEM

CHECKING IS ONLY FOR THE GENERAL CONFORMANCE WITH THE DESIGN CONCEPT OF THE PROJECT AND GENERAL COMPLIANCE WITH THE INFORMATION GIVEN IN THE CONTRACT DOCUMENTS. ANY ACTION SHOWN IS SUBJECT TO THE REQUIREMENTS OF THE PLANS AND SPECIFICATIONS. CONTRACTOR IS RESPONSIBLE FOR DIMENSIONS WHICH SHALL BE CONFIRMED AND CORRELATED AT THE JOB SITE; FABRICATION PROCESSES AND TECHNIQUES OF CONSTRUCTION; COORDINATION OF HIS WORK WITH THAT OF ALL OTHER TRADES AND THE SATISFACTORY PERFORMANCE OF THE WORK.



DATE 3/25/2015 BY James Rashford