


- NO EXCEPTION TAKEN
- MAKE CORRECTIONS NOTED
- REJECTED
- REVISE AND RESUBMIT
- SUBMIT SPECIFIED ITEM

CHECKING IS ONLY FOR THE GENERAL CONFORMANCE WITH THE DESIGN CONCEPT OF THE PROJECT AND GENERAL COMPLIANCE WITH THE INFORMATION GIVEN IN THE CONTRACT DOCUMENTS. ANY ACTION SHOWN IS SUBJECT TO THE REQUIREMENTS OF THE PLANS AND SPECIFICATIONS. CONTRACTOR IS RESPONSIBLE FOR DIMENSIONS WHICH SHALL BE CONFIRMED AND CORRELATED AT THE JOB SITE; FABRICATION PROCESSES AND TECHNIQUES OF CONSTRUCTION; COORDINATION OF HIS WORK WITH THAT OF ALL OTHER TRADES AND THE SATISFACTORY PERFORMANCE OF THE WORK.

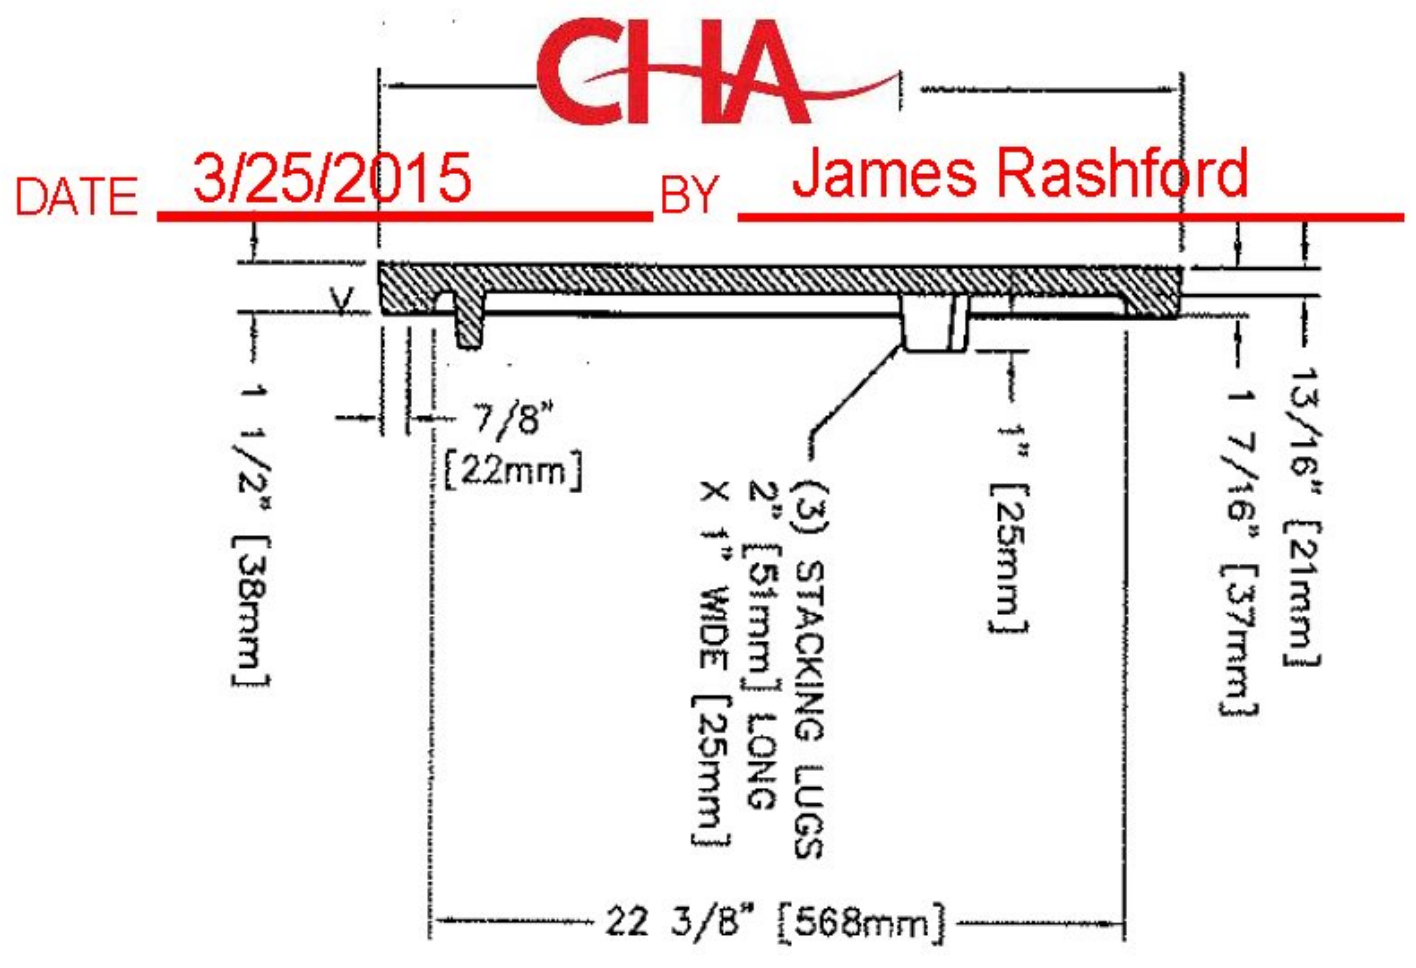

NOTE: ALL DIMENSIONS SHOWN ARE IN ENGLISH AND [METRIC]  
 MATERIAL: CAST GRAY IRON ASTM A-48, CLASS 35B  
 FINISH: NO PAINT  
 WEIGHT: 125#

CAD DWG. REF: 16425028.DWG- 4		DATE: 01-18-95		TITLE: R-1642 TYPE "B" PLATEN LID	
DR.	CSK	SCALE	1/8"=1"	NEENAH FOUNDRY COMPANY	
CH.		DWG. CHK.		NEENAH FOUNDRY COMPANY	
APR.		DATE	01-18-95	NF-16425028 B	

3-11-2015	REVISED	CONC. POKE DETAIL
3-11-2015	REVISED	DRAG
3-11-2015	REVISED	WEIGHT
3-11-2015	REVISED	FINISH
3-11-2015	REVISED	REVISION

DATE 3/25/2015 BY James Rashford

