


STA 33+70 END OF PAVING

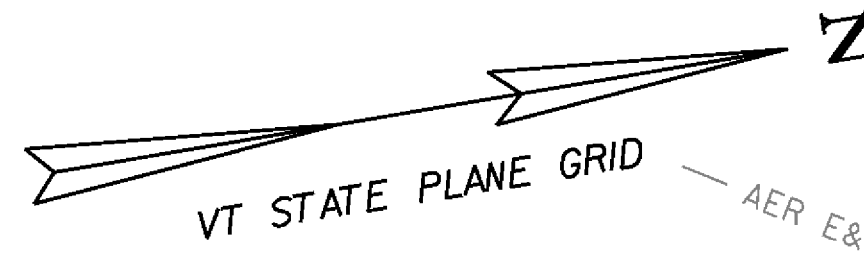

COTROFELD, JOSEPH W. AND KATHLEEN H.

32+50.00
END PROJECT
STP 0114 (3)

AMERICAN LEGION POST 69

AMERICAN LEGION POST 69

NEW BIT. CONC. APRON

AMERICAN LEGION POST 69

REMOVE 12" EXIST. SUBGRADE. FILL WITH 12" DENSE GRADED CRUSHED STONE. **MOVED**
NEW 1" SEAMLESS COPPER WATER TUBE, CONNECT TO EXISTING 4" CI WATER IN EAST ARLINGTON ROAD. CAP EXISTING ABANDONED 1" WATER SERVICE IN PLACE. PAYMENT WILL BE MADE UNDER ITEM 629.23

REMOVE EXISTING CONCRETE PAD. PAYMENT WILL BE MADE UNDER ITEM 900.645 SPECIAL PROVISION (MILITARY TANK REMOVED AND RELOCATED)

REMOVE 12" EXIST. LEGION RD. SURFACE. GRADE TO DRAIN, 4" TOPSOIL AND SEED. PAYMENT WILL BE MADE UNDER ITEMS 203.28, 651.35, AND 651.15, RESPECTIVELY.

WALSH, JOHN F. 111

NEW MANHOLE AND NEW 44' - 18" RCP WITH NEW 18" RCPES. PAYMENT WILL BE MADE UNDER ASSOCIATED PIPE ITEMS.
MANHOLE
INV 684.00
STA 30+43.23 OFFSET 52.73
RCPES
INV 694.44
STA 30+30.90 OFFSET 9.90

NEW PCC PAD
SEE CONCRETE PAD DETAIL (SHEET 20). PAYMENT WILL BE MADE UNDER ITEMS 507.11 AND 541.25 REPECTIVELY.

REMOVE EXIST. 12" CMP AND INSTALL 28" x 12" CSP
PAYMENT WILL BE MADE UNDER ITEM 601.0005

EXIST. RR R.O.W.

VERMONT RAILWAY

NEW BIT. CONC. APRON

LEGION SIGN

NEW SWALE

DEPEYSTER, VALERIE

MAGINNISS, LINWOOD W. AND BERTA W.

REPAIR EXISTING CB

30' LF 16" DI SLEEVE

MEET EXIST. DRIVE

LIMIT OF PAVEMENT

SEE NOTE 3
EXIST. TOWN R.O.W.

EXIST. POLE TO BE RETIRED BY OTHERS

RELOCATED MAIL BOX AND PAVE APPROACH

EXIST. POLE TO BE REPLACED BY OTHERS

12+00 PC 12+06.45

EAST ARLINGTON ROAD

SIDEWALK EXTENDED 12' EXIST. RR SIGNAL

DETECTABLE WARNING SURFACE
SEE DETAIL ON SHEET 8 (TYP)

EXISTING SERVICE TO BE CUT AND CAPPED AT MAIN AND EXISTING ABANDONED 1" WATER SERVICE TO BE CAPPED IN PLACE. WORK WILL BE INCLUDED UNDER ITEM 629.23

REGRADED EXISTING DITCH LINE

EXIST. RR R.O.W.

LEGEND:

 EXISTING SURFACE REMOVAL
 TOP OF CUT
 TOE OF SLOPE

SAWCUT EXISTING PAVEMENT. INCIDENTAL TO PAY ITEM 900.680 SPECIAL PROVISION (BITUMINOUS CONCRETE PAVEMENT, SMALL QUANTITY).

REGRADE EXISTING DITCH AND PLACED TYPE II STONE


NEW EXTENSION SERVICE BOX AND CURB STOP WILL BE PAID UNDER ITEM 629.25

30+00.00 BEGIN APPROACH

30+07.00 BEGIN PROJECT STP 0114 (4) END APPROACH

NOTES:

- FOR RAILROAD SIGNALS AND SIGNAL FACILITIES SEE RAILROAD SIGNAL LAYOUT (SHEET 15).
- EXIST. UTILITY POLE TO BE REPLACED BY OTHERS. EXIST. 15 FT ANCHORS WILL BE REMOVED AND REINSTALLED BY OTHERS ALONG WITH TWO NEW 17 FT ANCHORS.
- NEW UTILITY POLE WILL BE INSTALLED BY OTHERS WITH 30 FT (MIN.) PUSH BRACE. (LOCATE POLE 45 FT NORTH ALONG EAST ARLINGTON ROAD FROM EXISTING POLE)
- PAYMENT FOR INSTALLING NEW PIPES WILL BE PAID UNDER THE APPROPRIATE PIPE ITEMS.

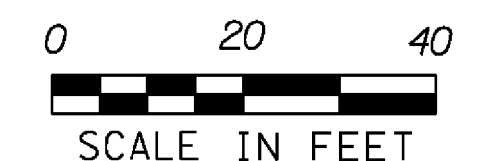

PROJECT NAME: ARLINGTON
PROJECT NUMBER: STP 0114 (4)

FILE NAME: z09g052bdr.dgn
PROJECT LEADER: J. READ
DESIGNED BY: ABR
ROADWAY LAYOUT

PLOT DATE: 2/22/2016
DRAWN BY: NSB
CHECKED BY: J. READ
SHEET 12 OF 27

P701020069