

- NOTES:**
1. ALL EXISTING SIGNS NOT SHOWN SHALL BE RETAINED UNLESS DIRECTED OTHERWISE BY THE ENGINEER.
  2. SEE VAOT STANDARD E-121 FOR STANDARD SIGN PLACEMENT.
  3. REMOVE ALL CONFLICTING EXISTING PAVEMENT MARKINGS.
  4. FOR ADDITIONAL SIGNAL LOCATION INFORMATION SEE SHEET 15.
  5. FOR CONSTRUCTION STAGING AND TEMPORARY TRAFFIC CONTROL INFORMATION TO RELOCATE THE MILITARY TANK SEE SHEETS 24 AND 25.


**REMOVE EXIST. DYCL (DOUBLE YELLOW CENTER LINE) ITEM 646.85**  
 E. ARLINGTON RD STA 11+57 STA 14+50  
 E. ARLINGTON RD STA 14+92 STA 17+91

**4 INCH DYCL ITEM 646.412**  
 E. ARLINGTON RD STA 11+57 STA 14+31  
 E. ARLINGTON RD STA 15+60 STA 17+91  
 LEGION RD STA 30+17 STA 31+08

**24 INCH STOP BAR ITEM 646.482**  
 E. ARLINGTON RD STA 14+95.88 LT 18.19' STA 15+19.88 LT 18.14'

**RAILROAD CROSSING SYMBOL ITEM 646.512**  
 E. ARLINGTON RD STA 12+07 RT  
 E. ARLINGTON RD STA 17+63 LT  
 E. ARLINGTON RD STA 16+10 RT 115' (AT CHITTENDEN RD)

**CROSSWALK ITEM 646.502**  
 E. ARLINGTON RD STA 14+29 RT 11.26' STA 15+32 RT 11.26'

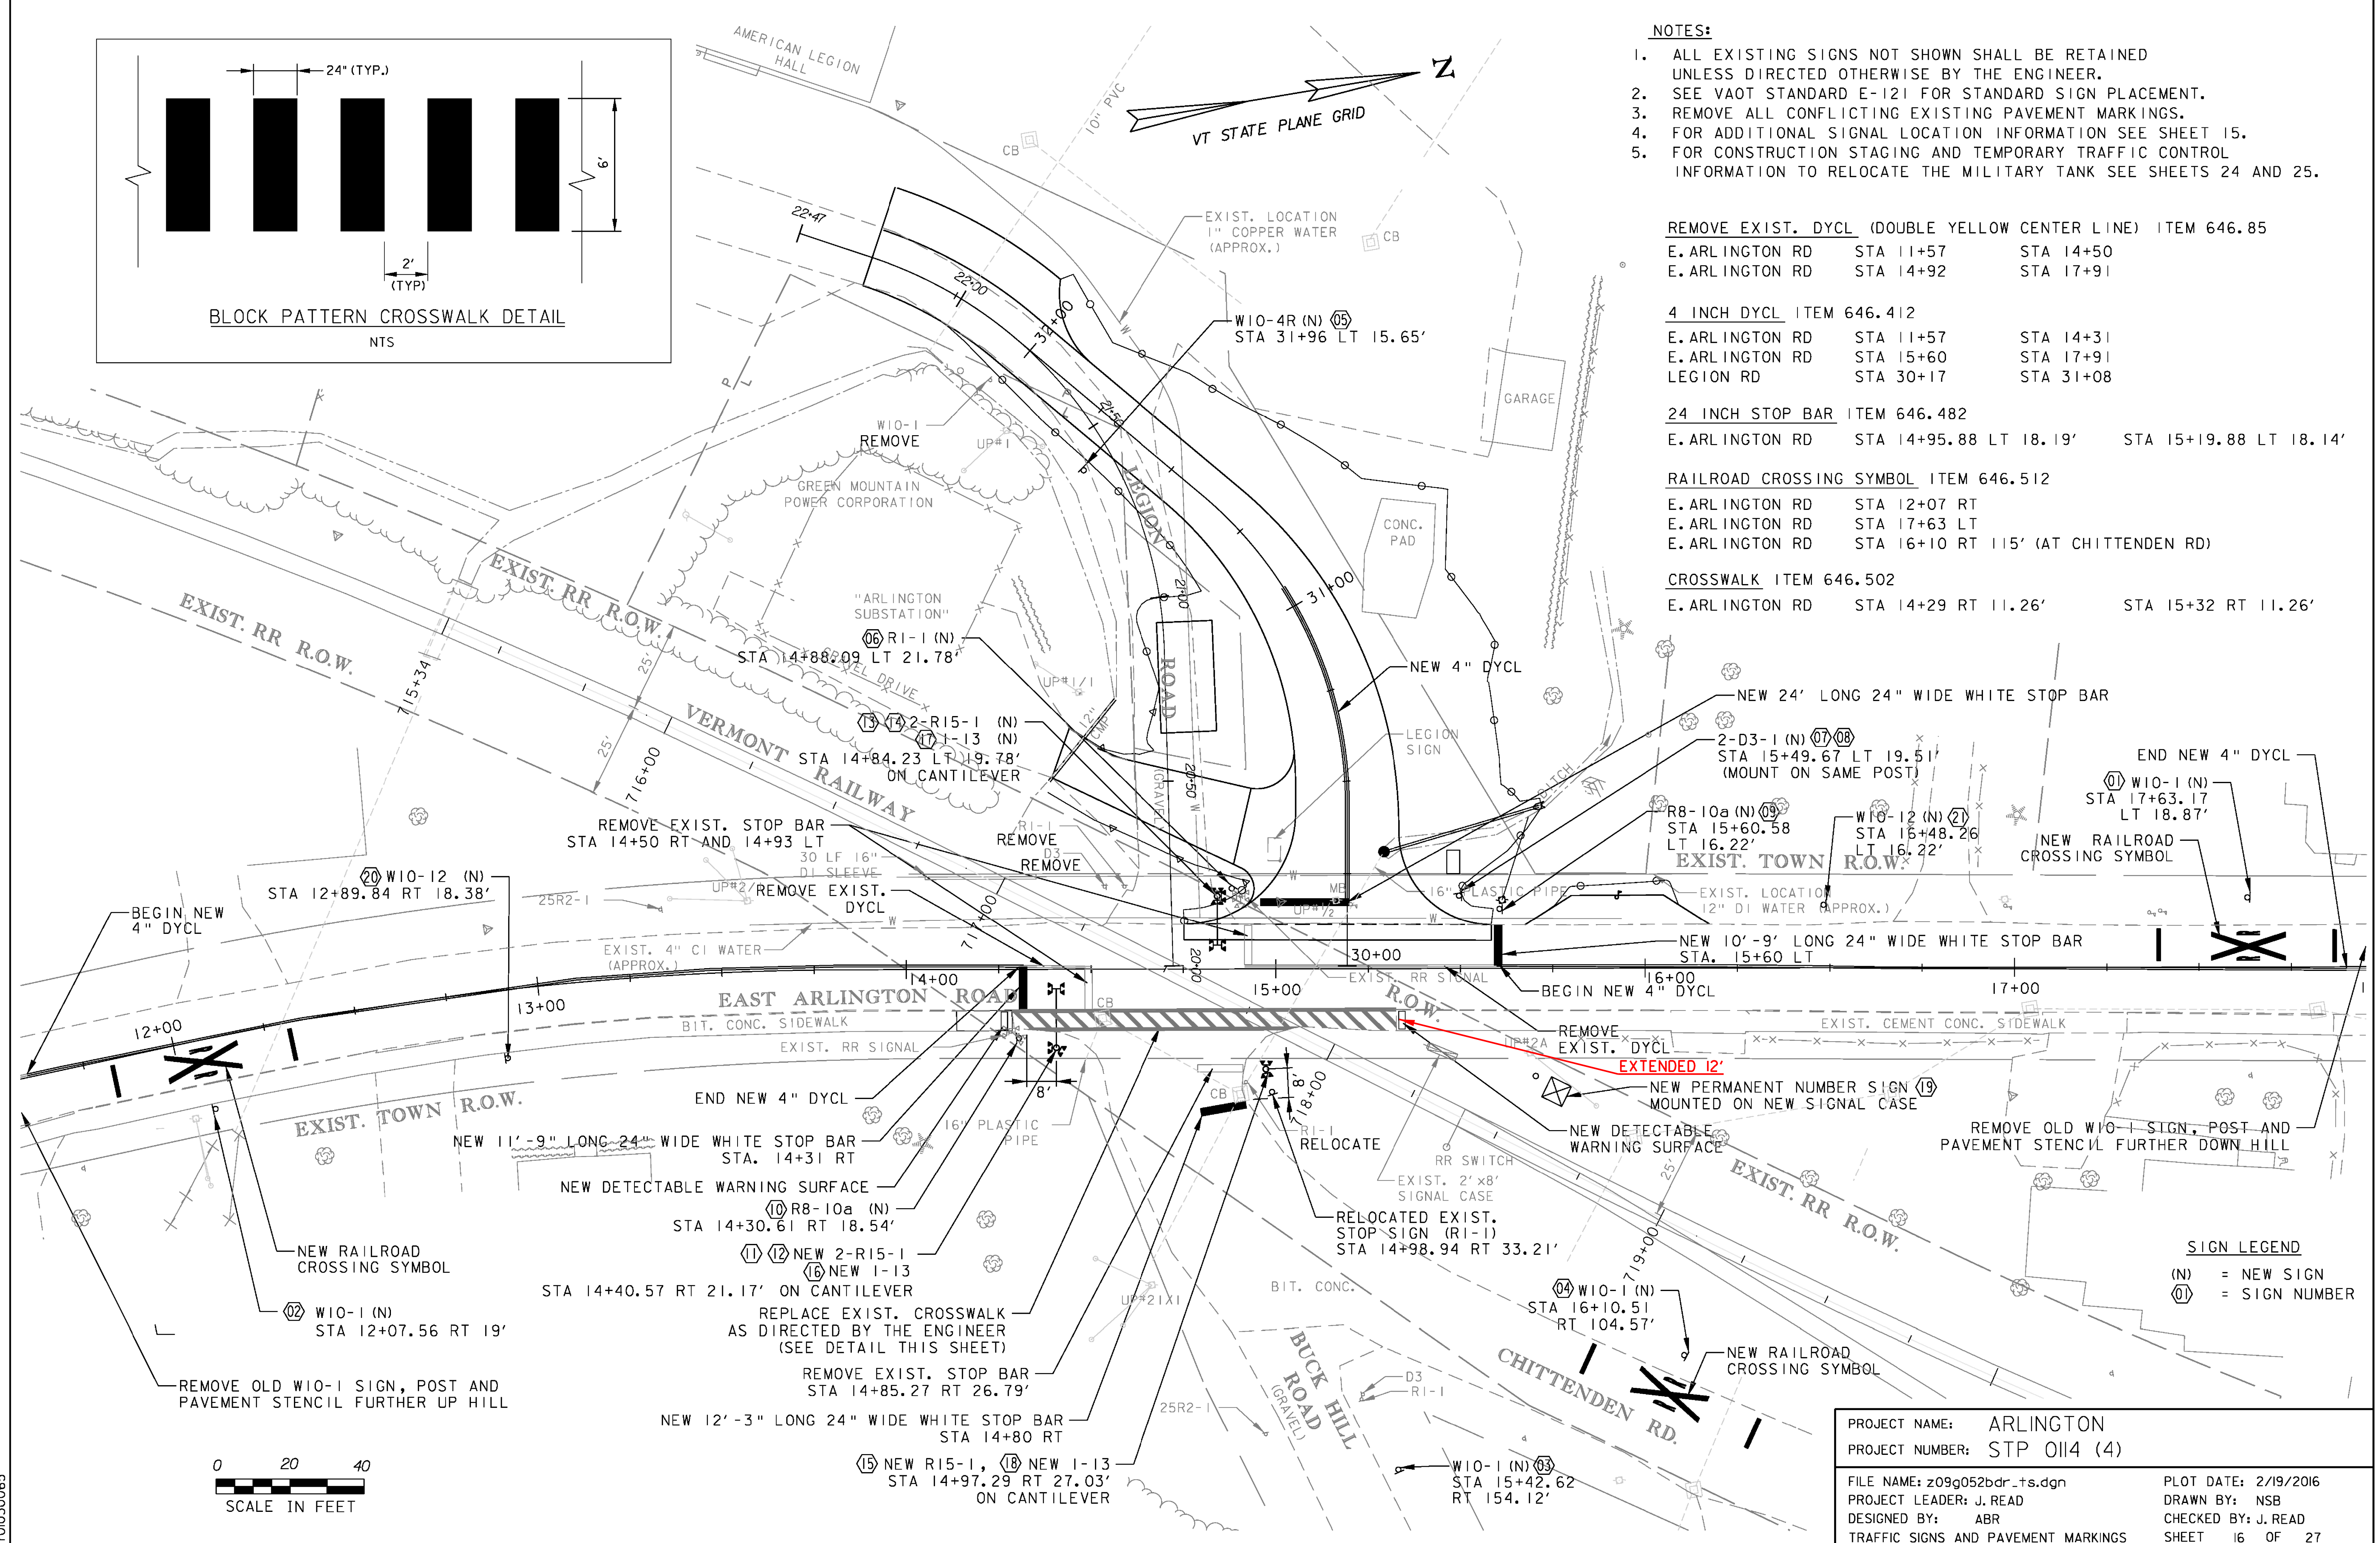

**SIGN LEGEND**  
 (N) = NEW SIGN  
 (1) = SIGN NUMBER

PROJECT NAME:	ARLINGTON	PLOT DATE:	2/19/2016
PROJECT NUMBER:	STP 0114 (4)	DRAWN BY:	NSB
FILE NAME:	z09g052bdr_ts.dgn	CHECKED BY:	J. READ
PROJECT LEADER:	J. READ	TRAFFIC SIGNS AND PAVEMENT MARKINGS	SHEET 16 OF 27
DESIGNED BY:	ABR		



P701030065