




30+11.52 EDGE OF E. ARLINGTON ROAD

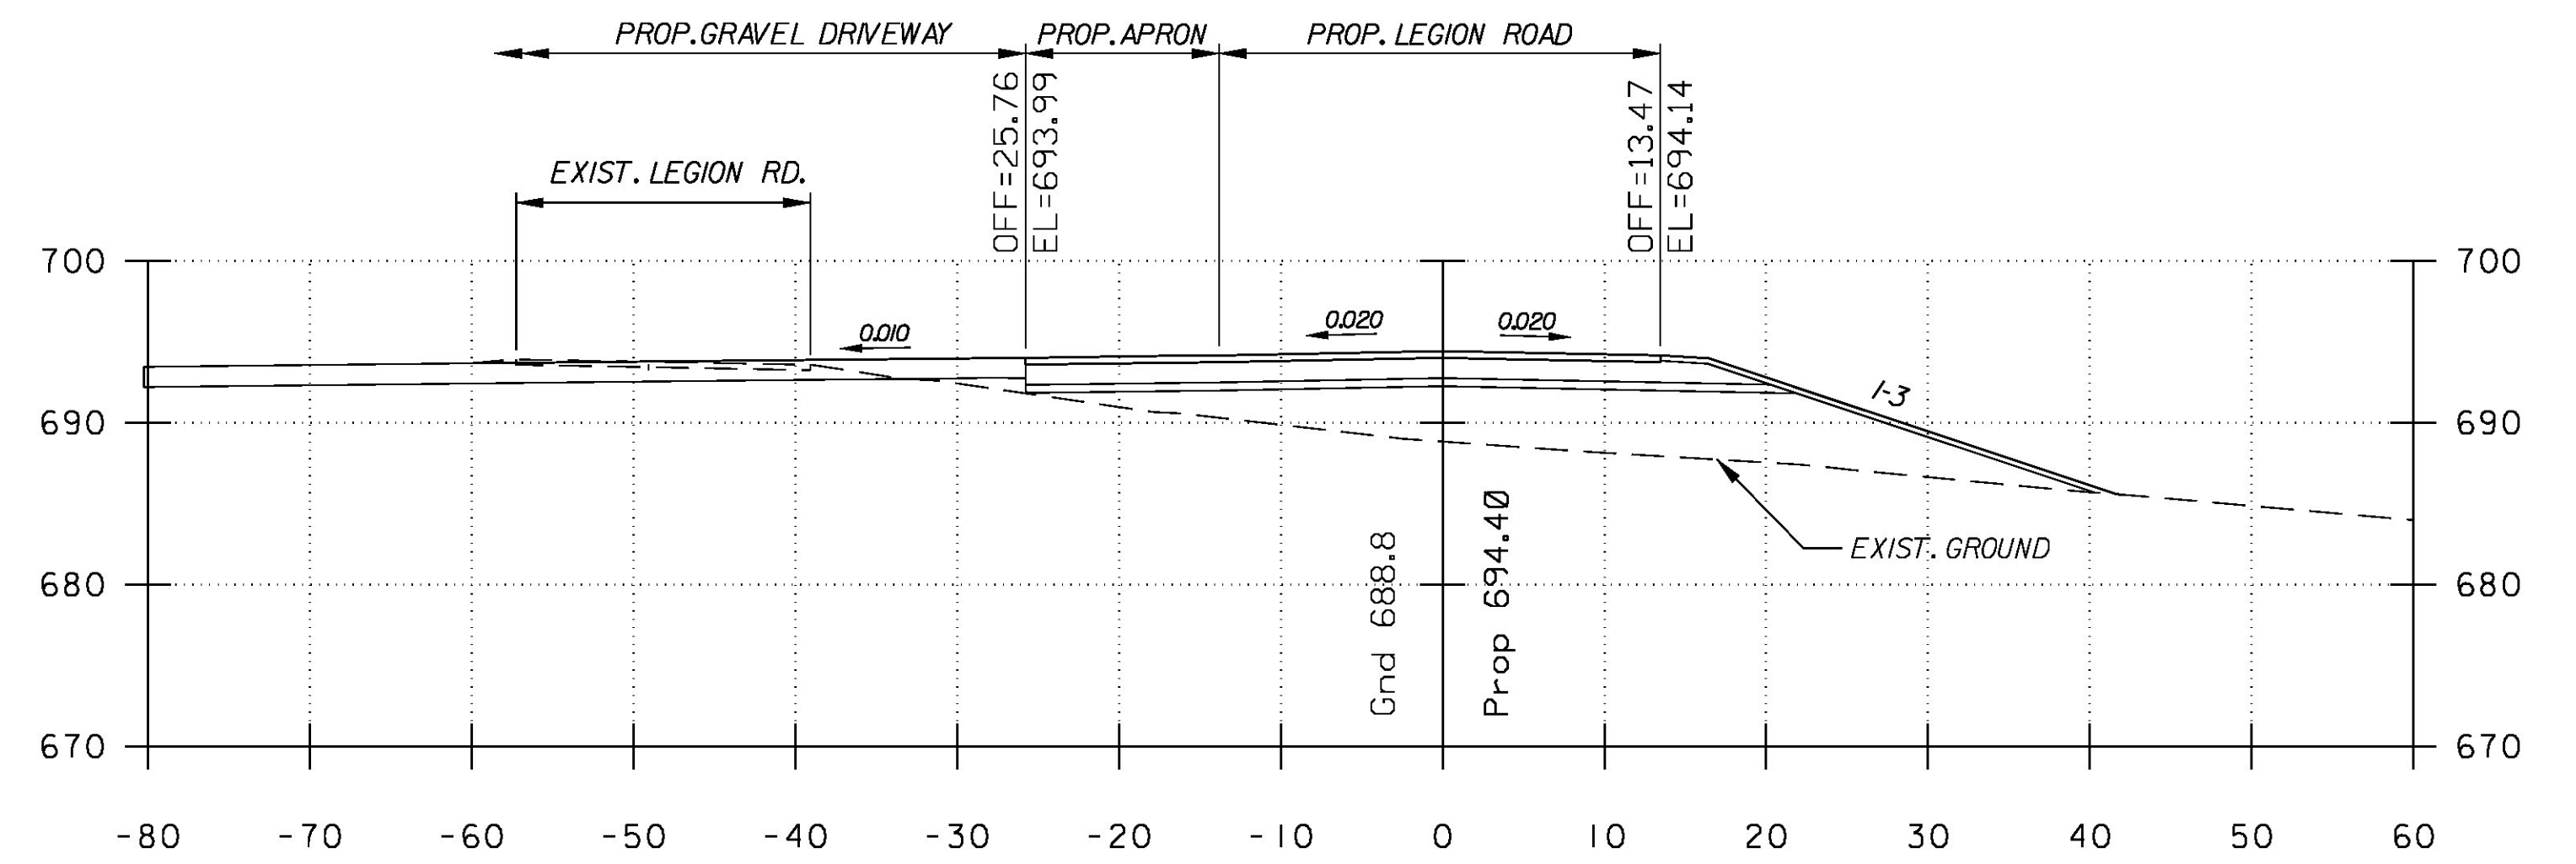


30+50

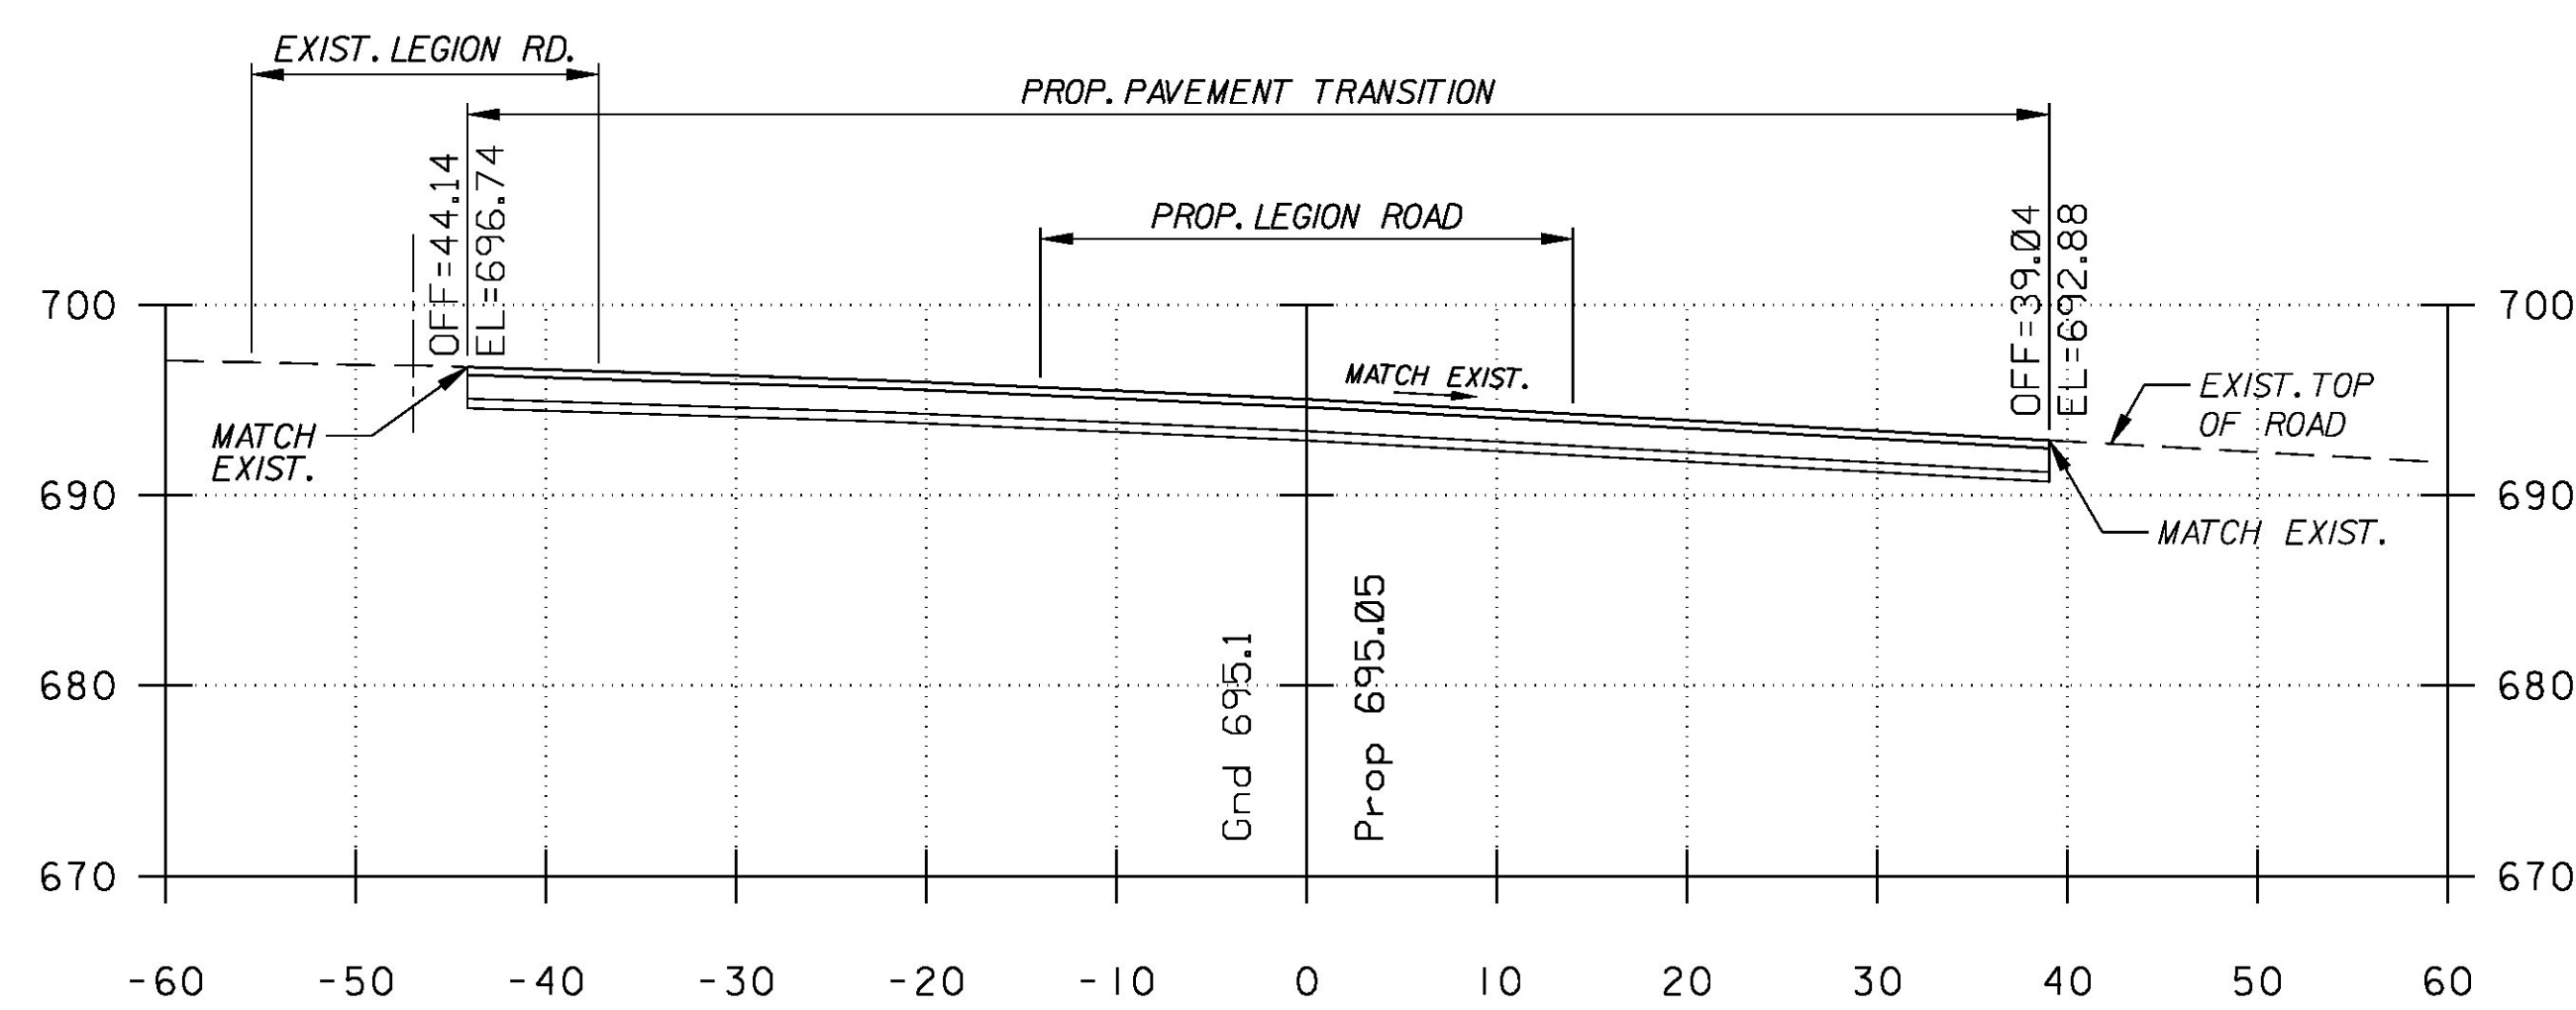


30+07 BEGIN PROJECT

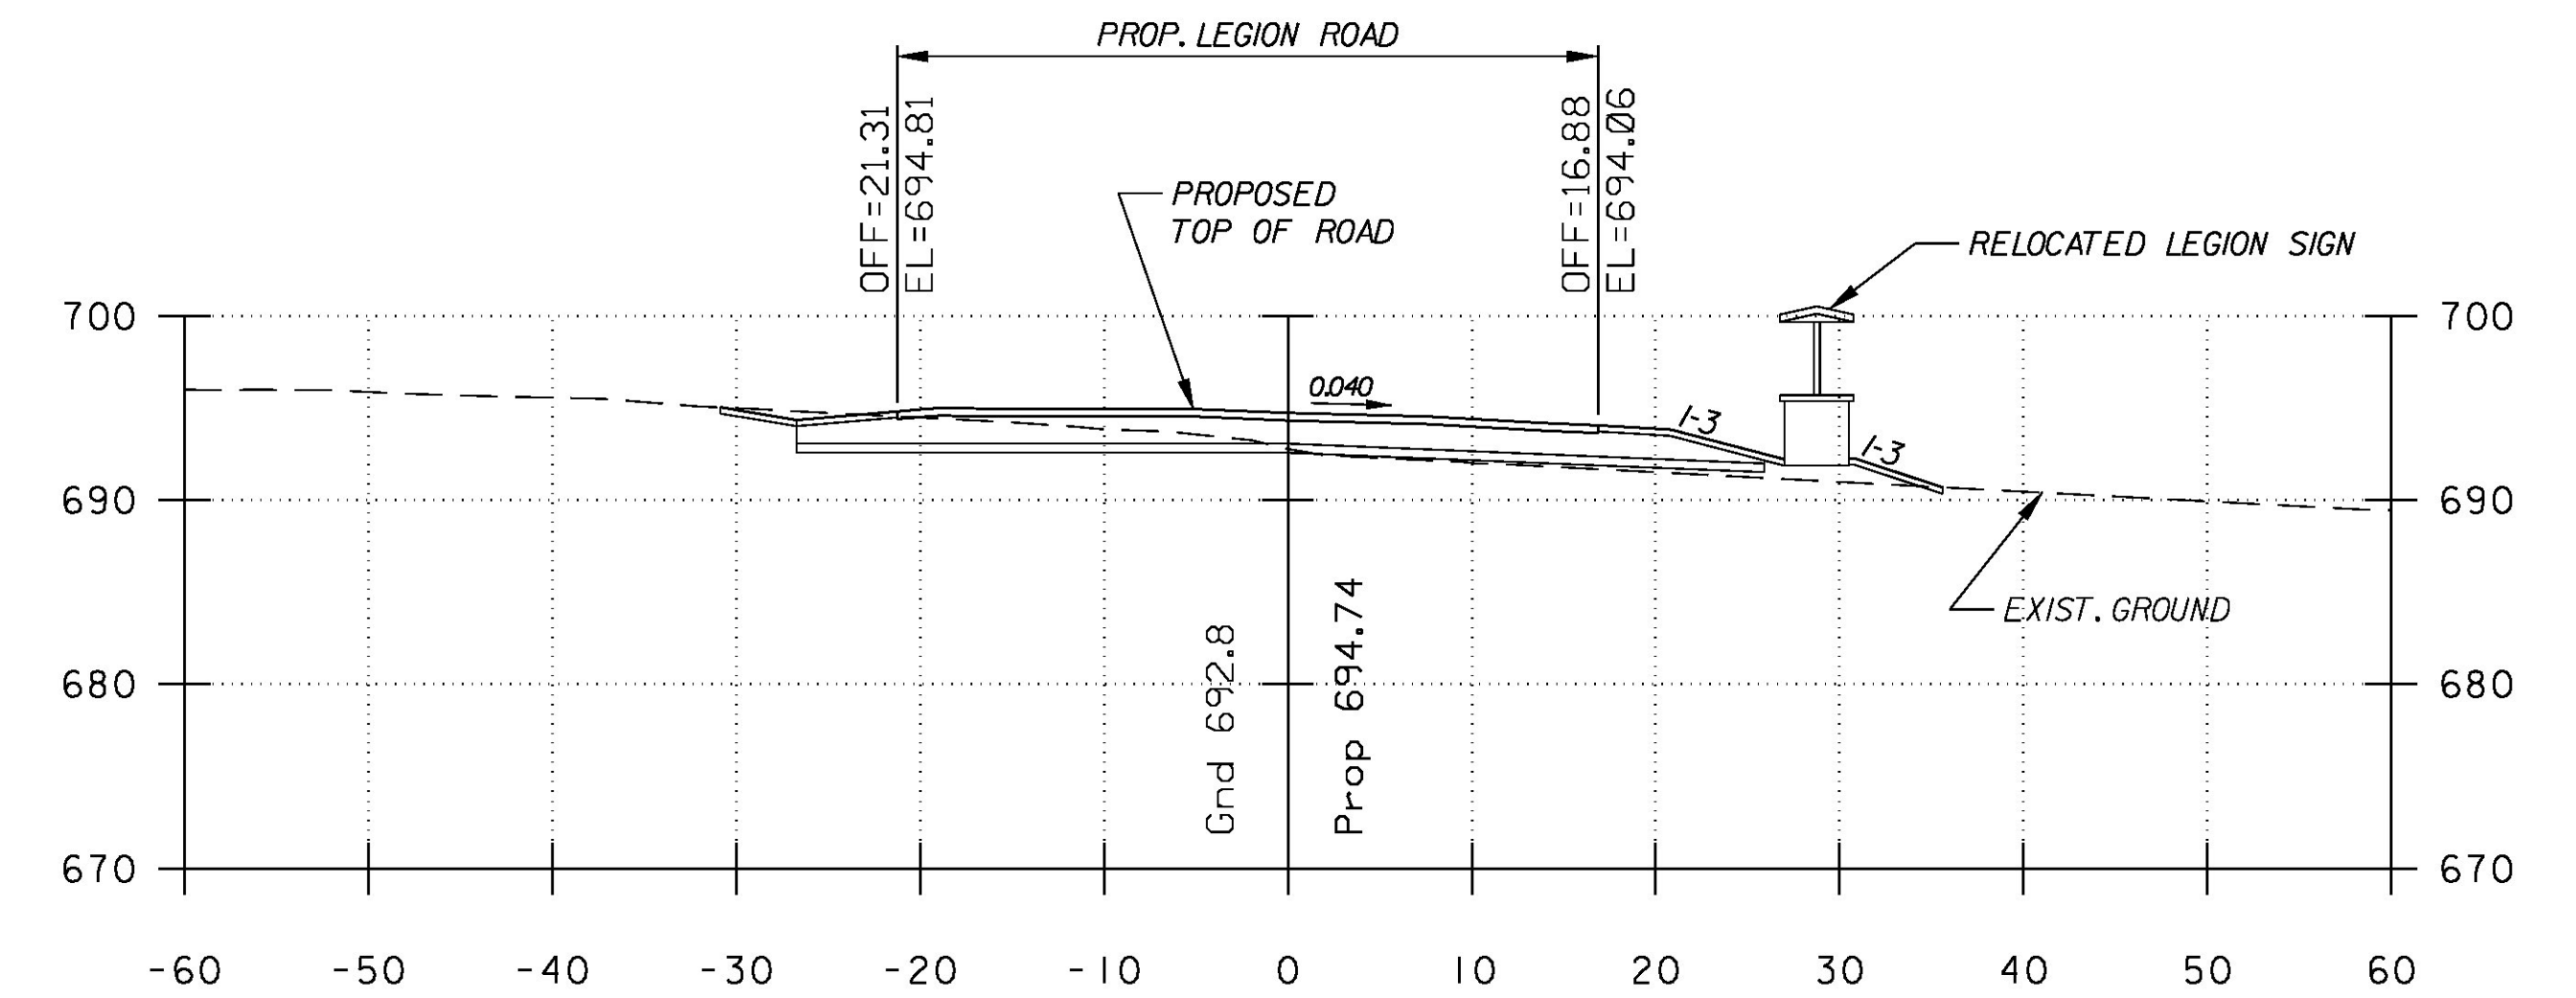

30+25

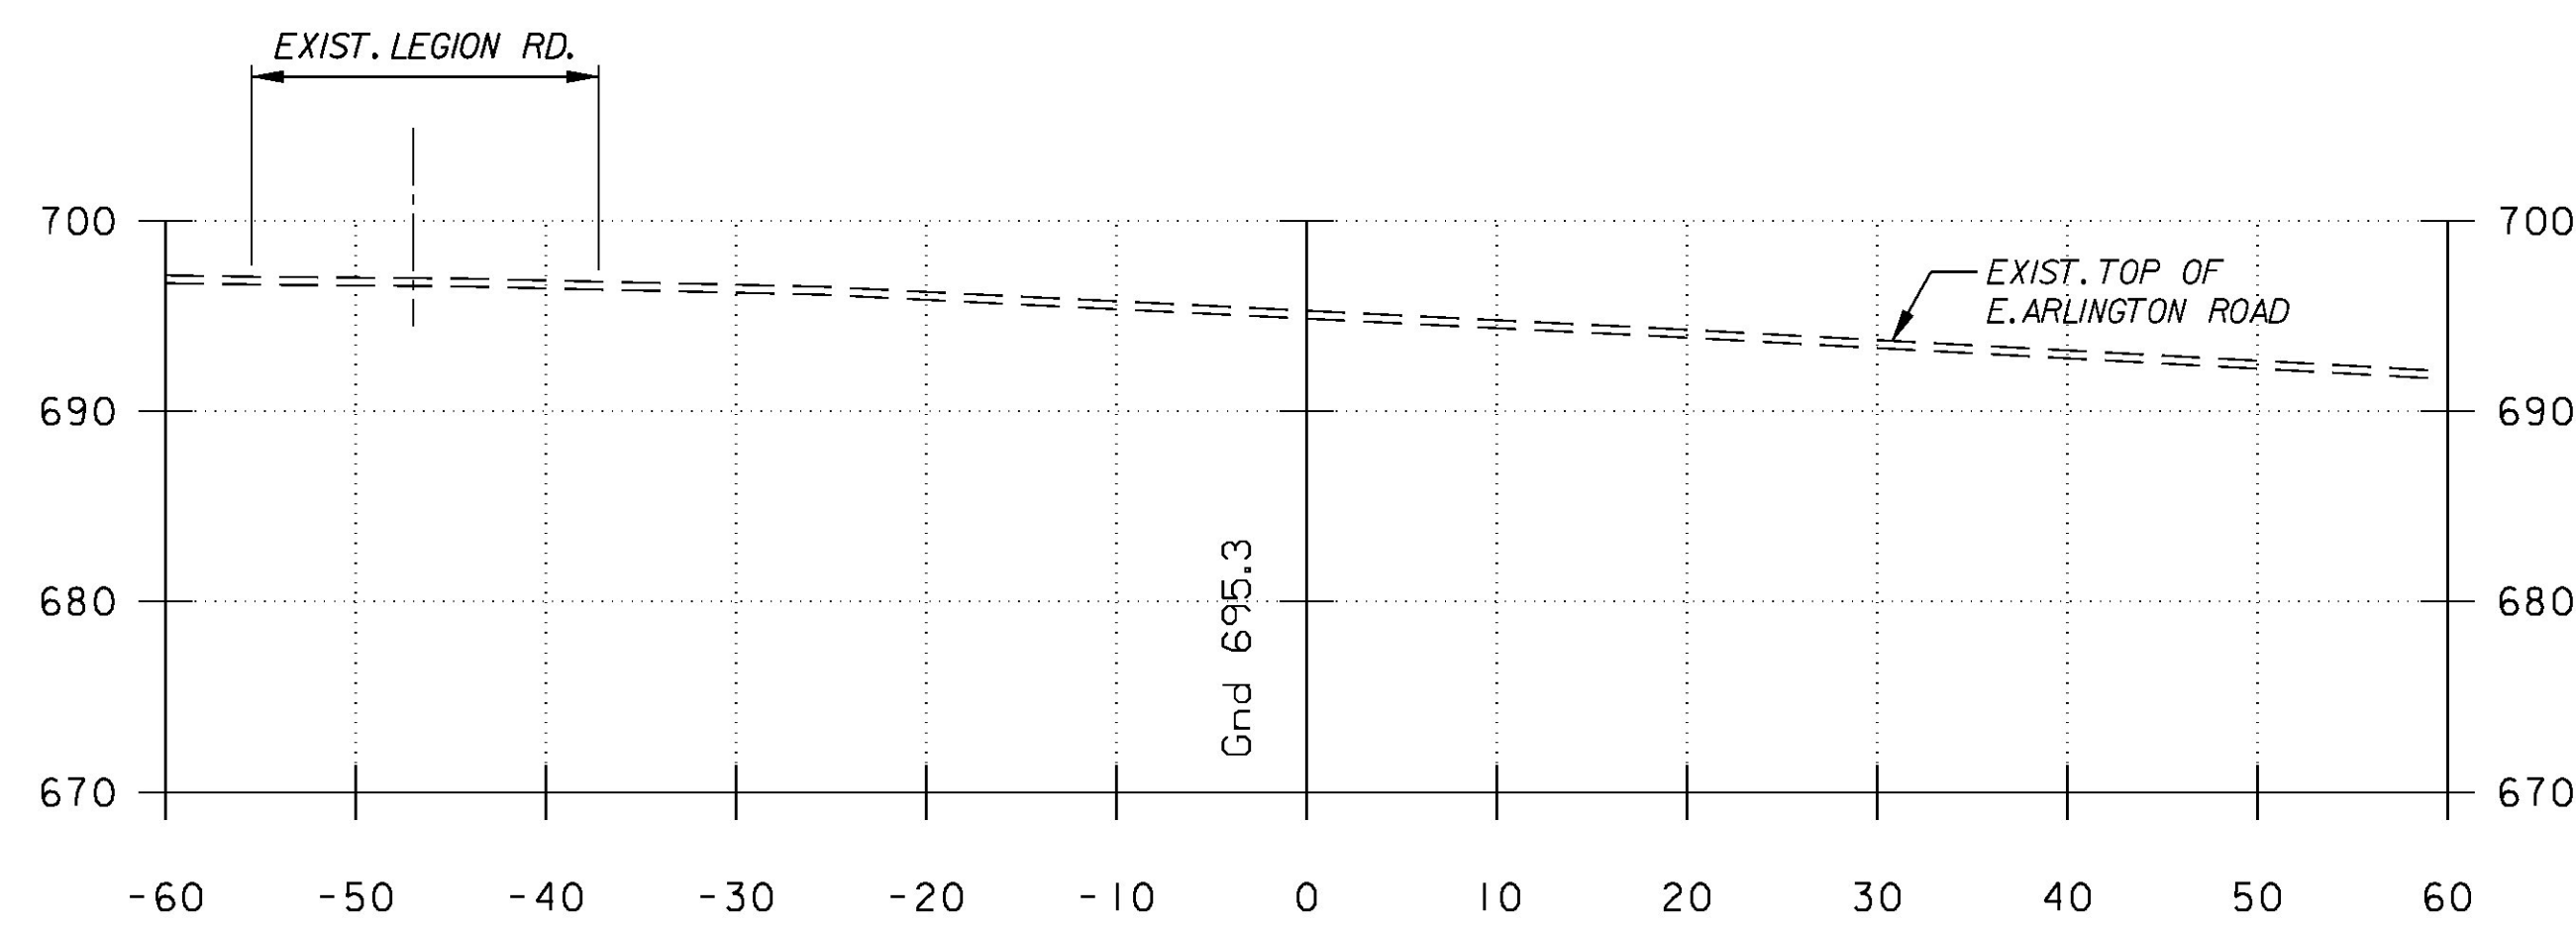

30+00 BEGIN APPROACH

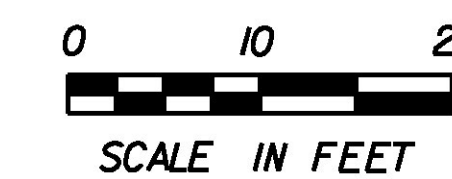

STA. 30+00 - 30+50

PROJECT NAME:	ARLINGTON	FILE NAME:	z09g052xsl.dgn	PLOT DATE:	2/5/2016
PROJECT NUMBER:	STP 0114 (4)	PROJECT LEADER:	A. RIEGER	DRAWN BY:	LB
		DESIGNED BY:	LB	CHECKED BY:	J. READ
		CROSS SECTIONS -	1	SHEET	21 OF 27