




31+25

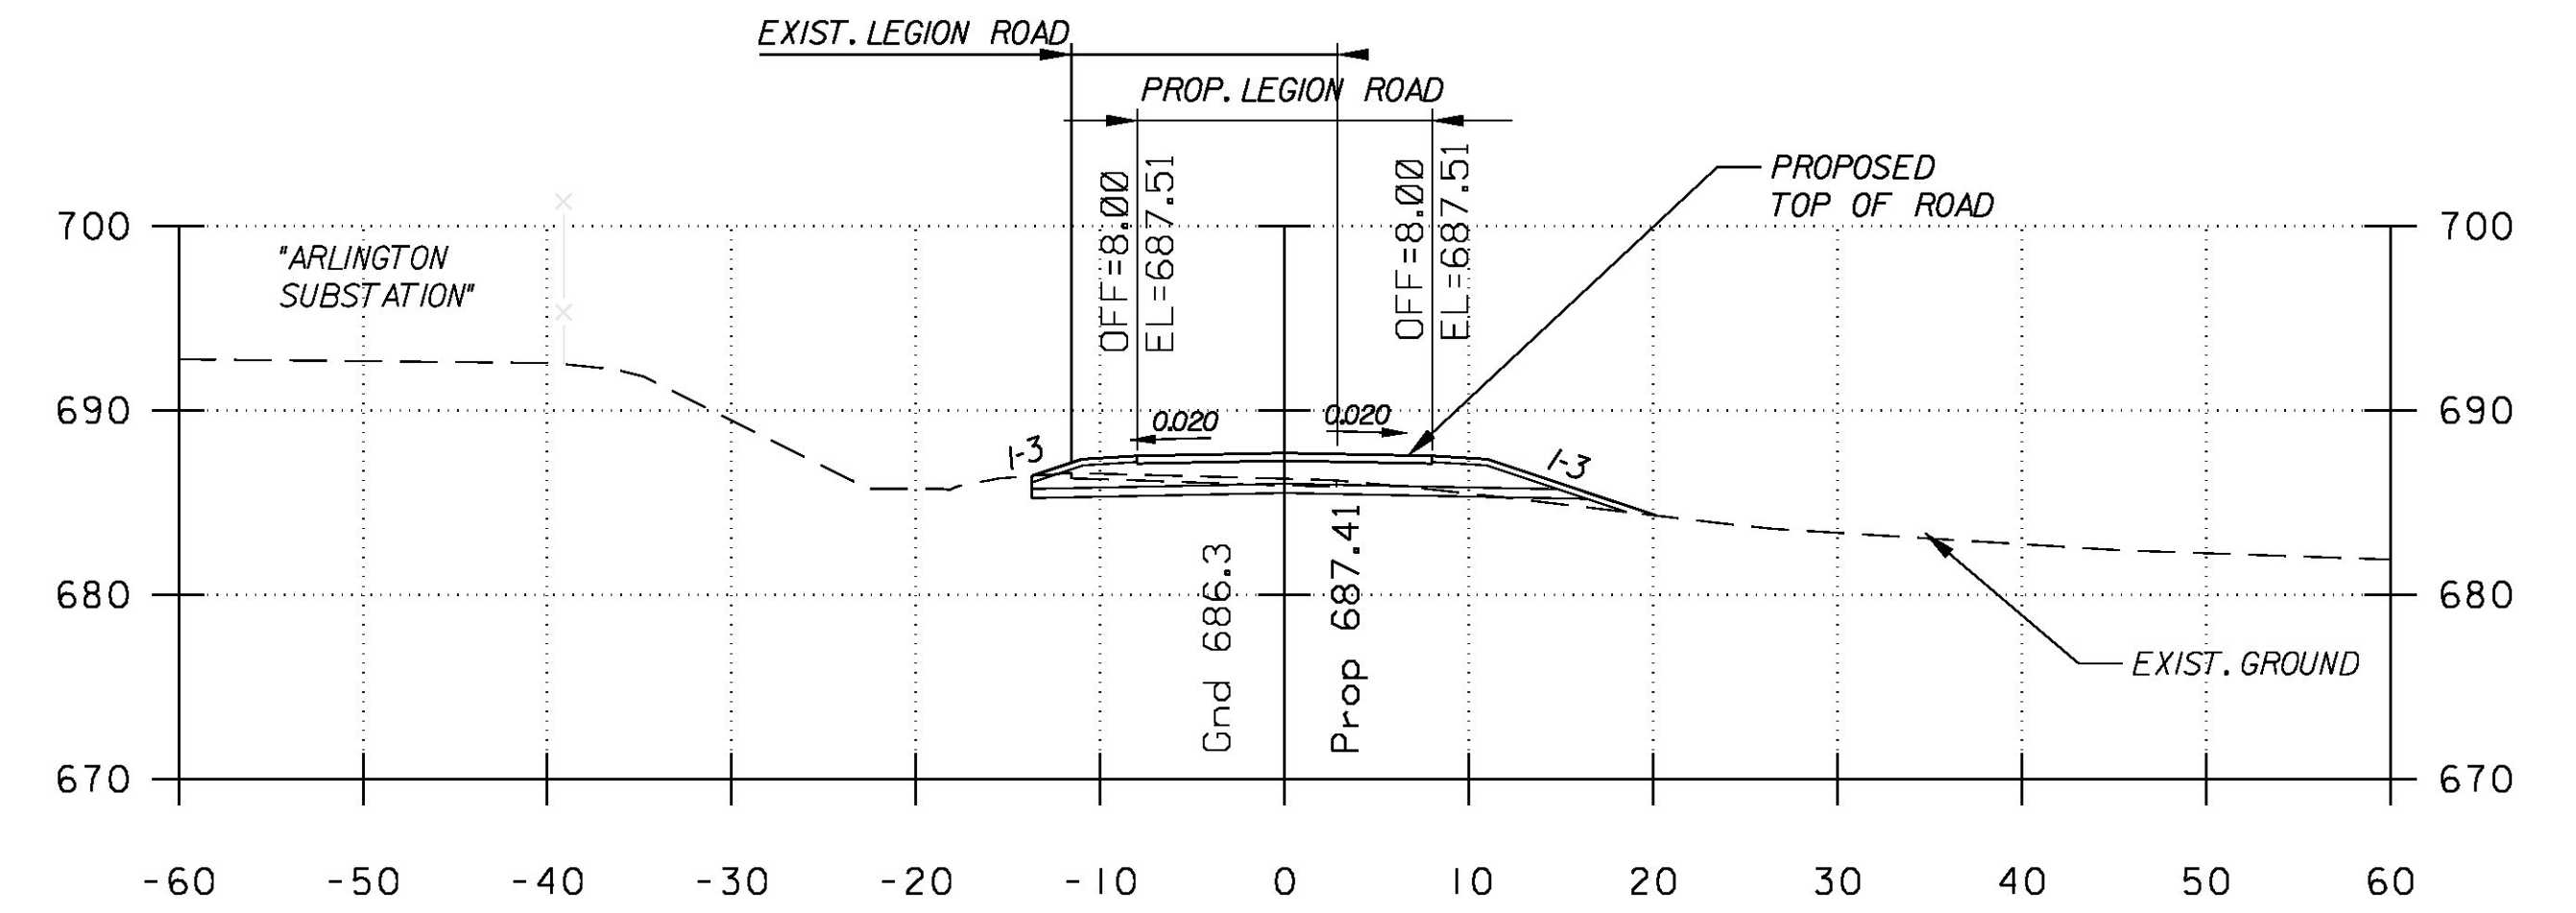


31+75

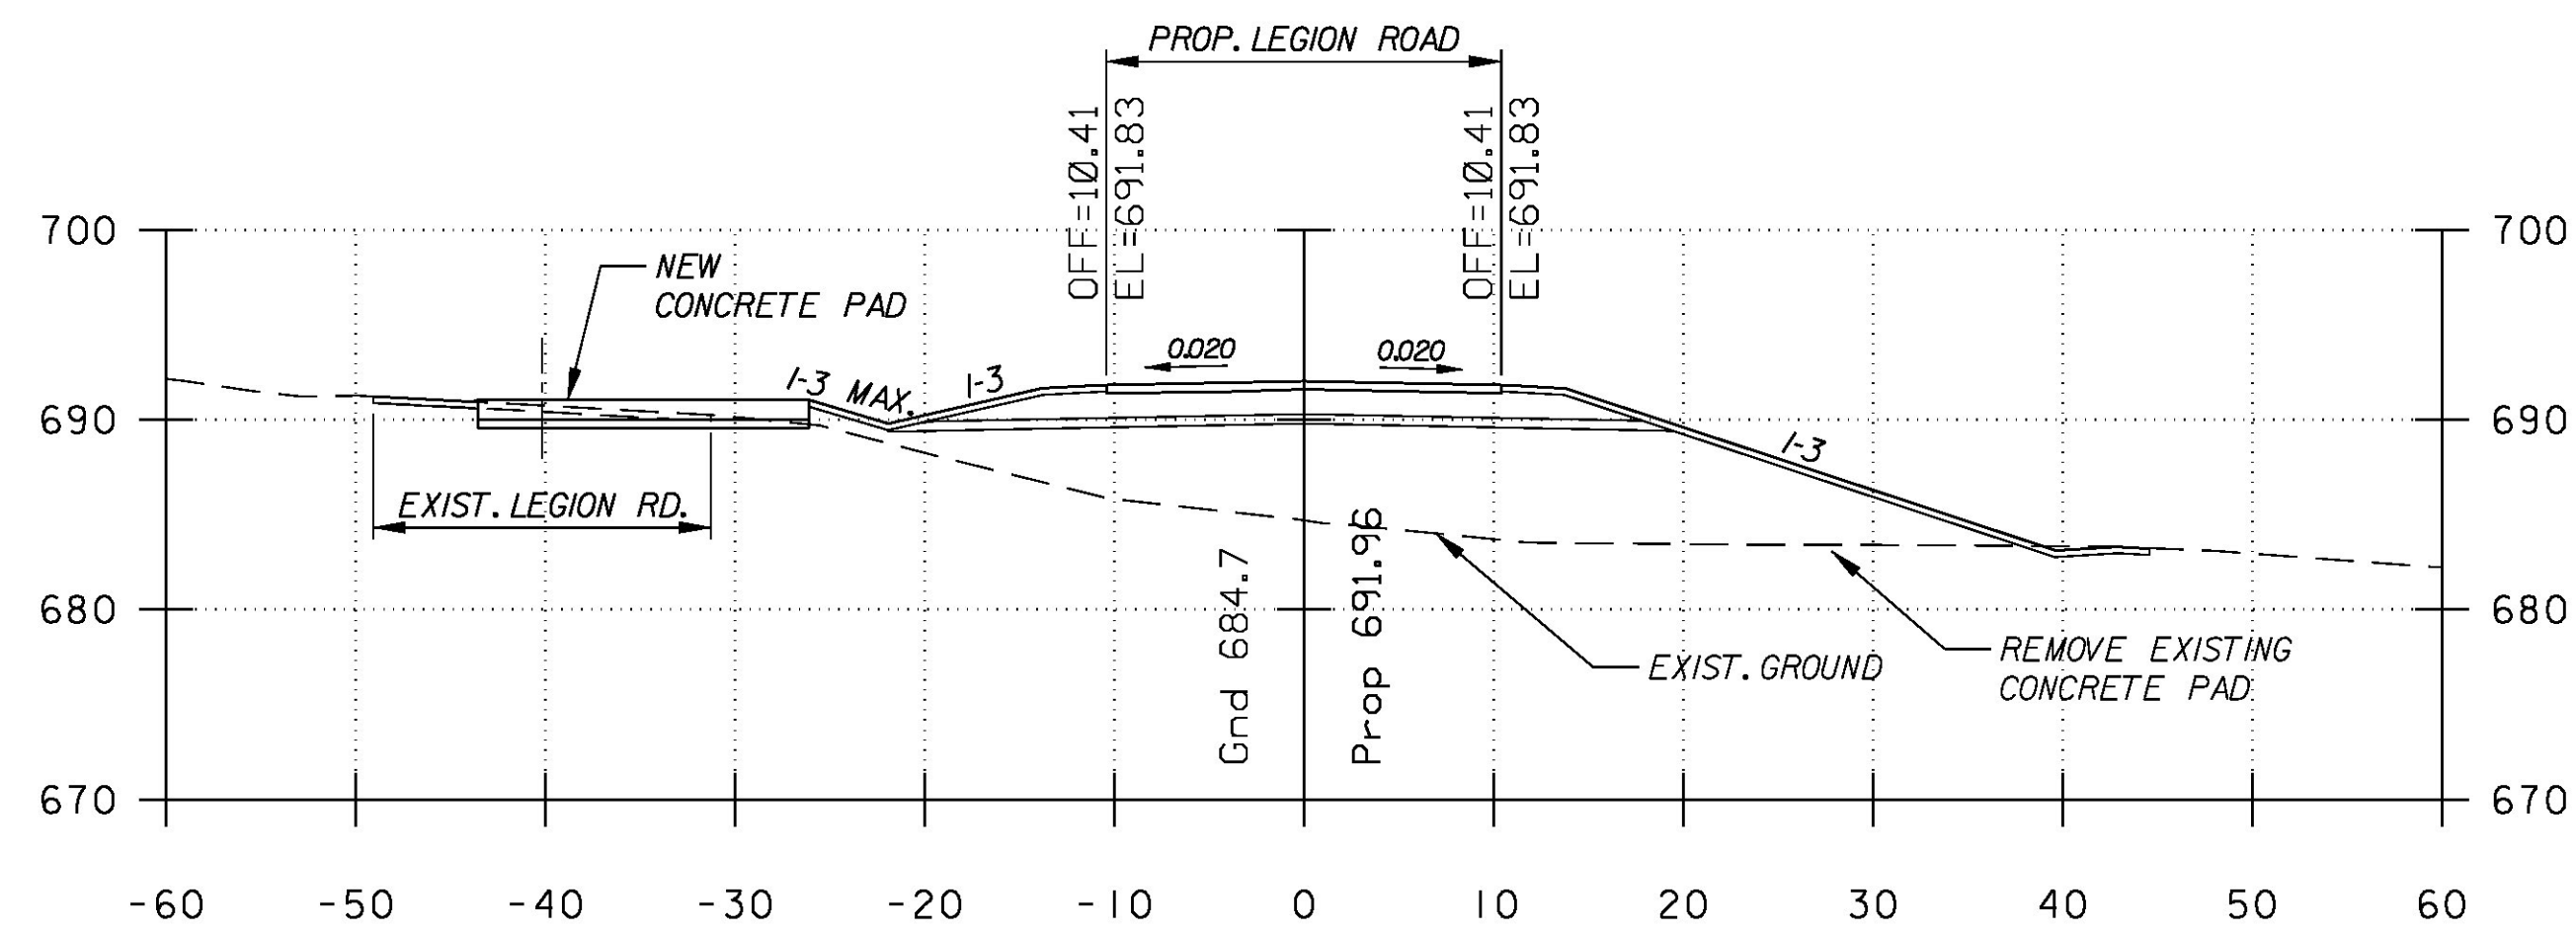


31+00

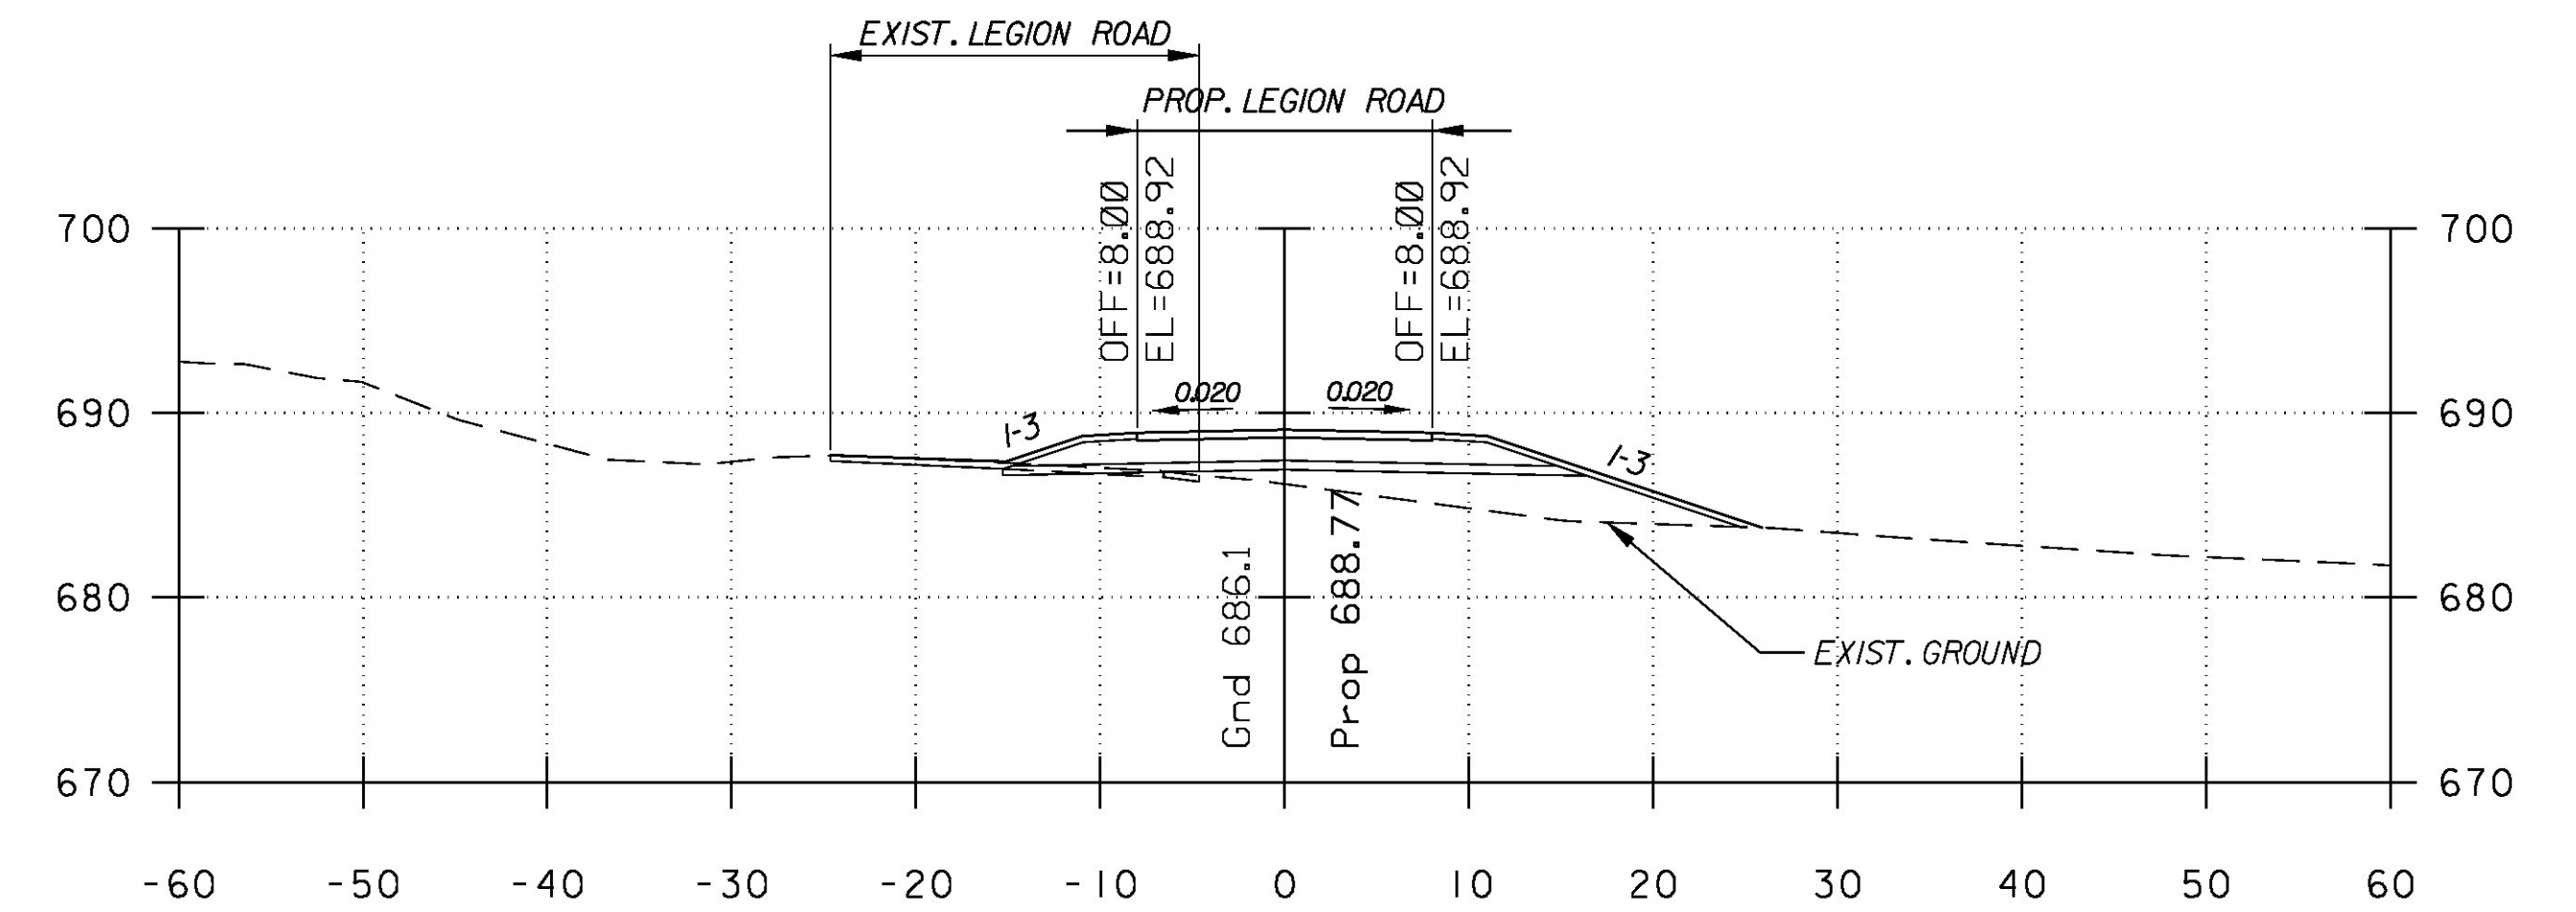

31+50

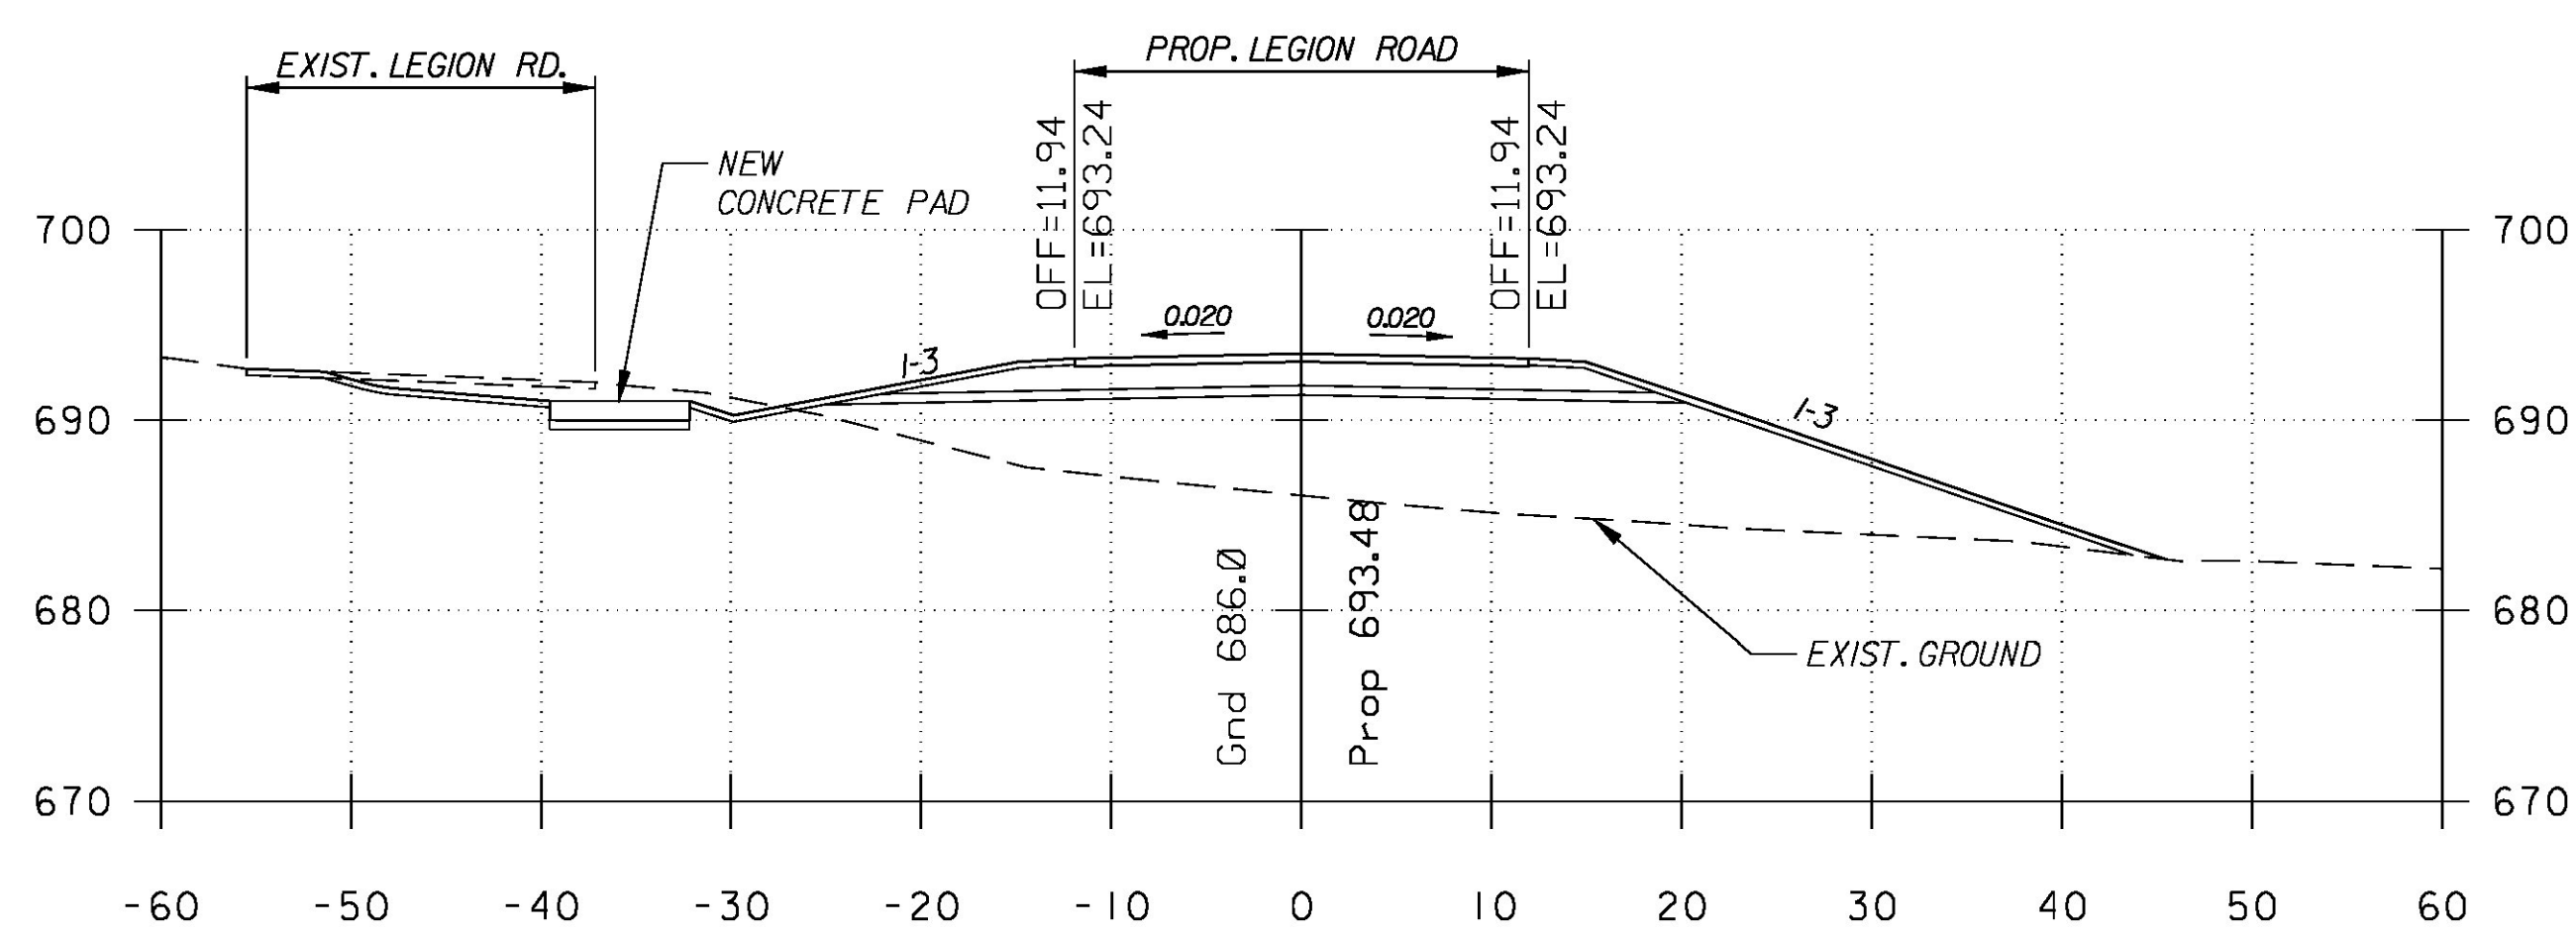

30+75

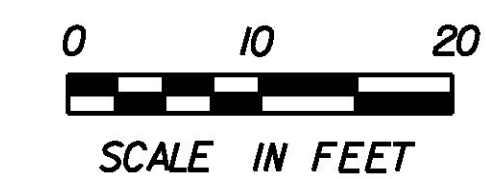

STA. 30+75 - 31+75

PROJECT NAME:	ARLINGTON	PLOT DATE:	2/5/2016
PROJECT NUMBER:	STP 0114 (4)	DRAWN BY:	LB
FILE NAME:	z09g052xsl.dgn	CHECKED BY:	J. READ
PROJECT LEADER:	J. READ	CROSS SECTIONS -	2
DESIGNED BY:	ABR	SHEET	22 OF 27