




32+25

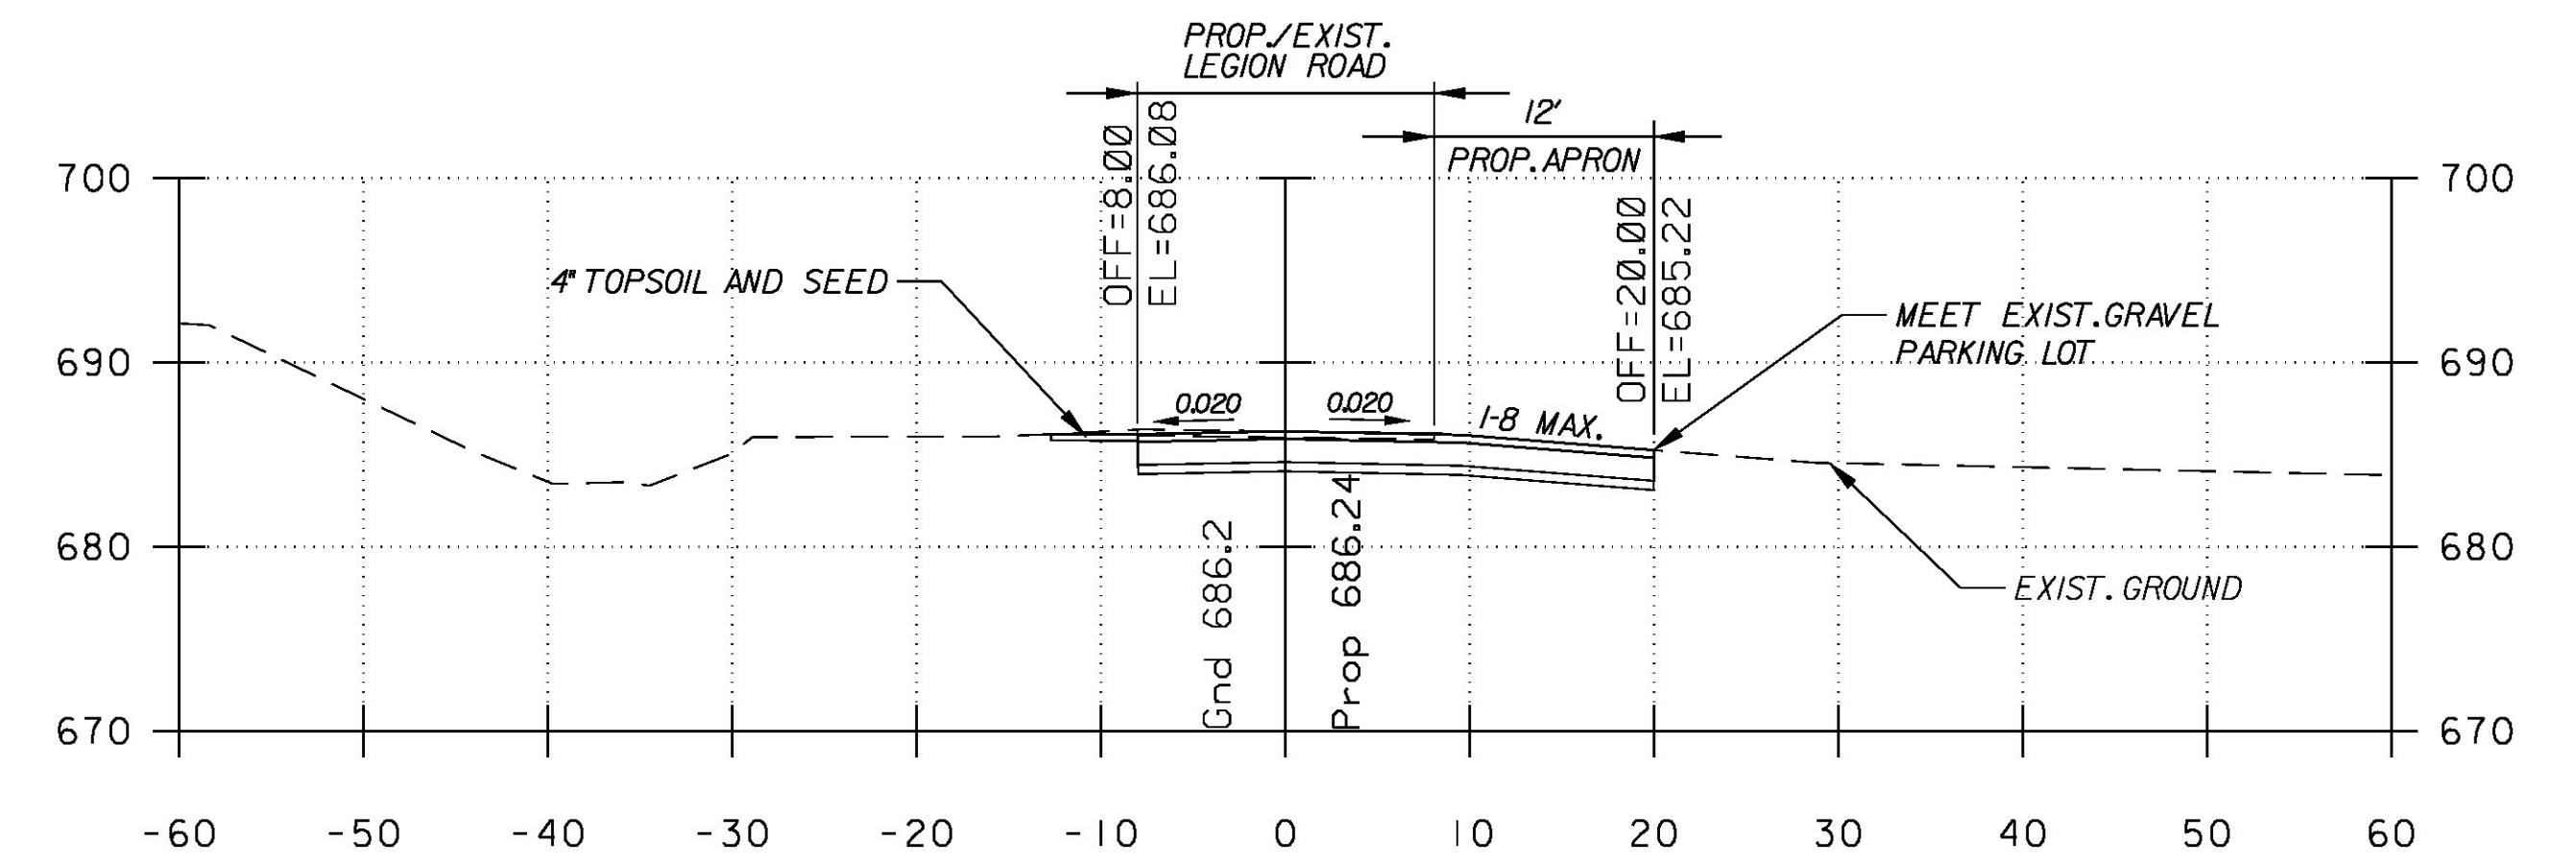


32+50 END PROJECT

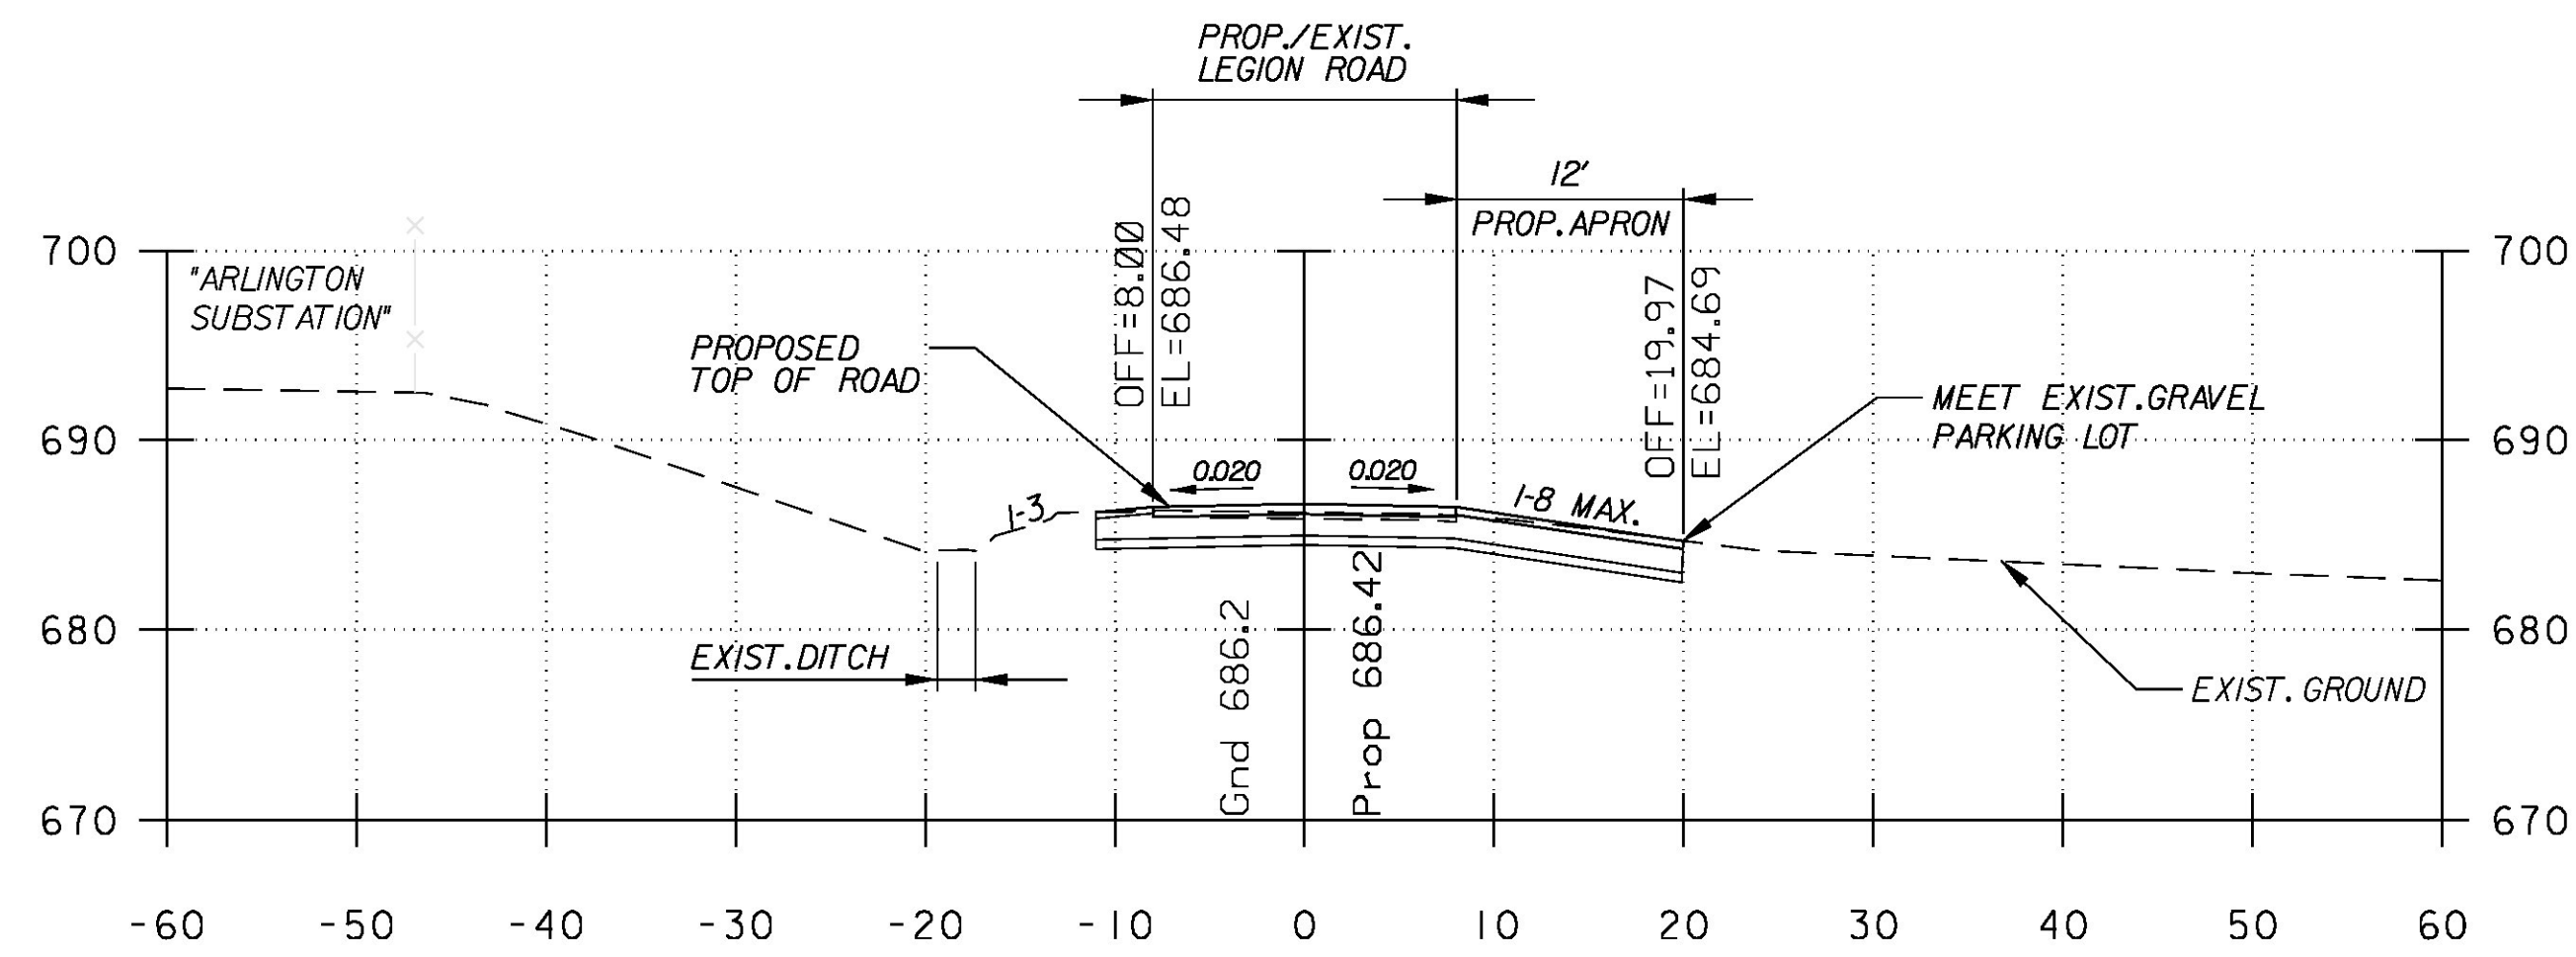

32+05

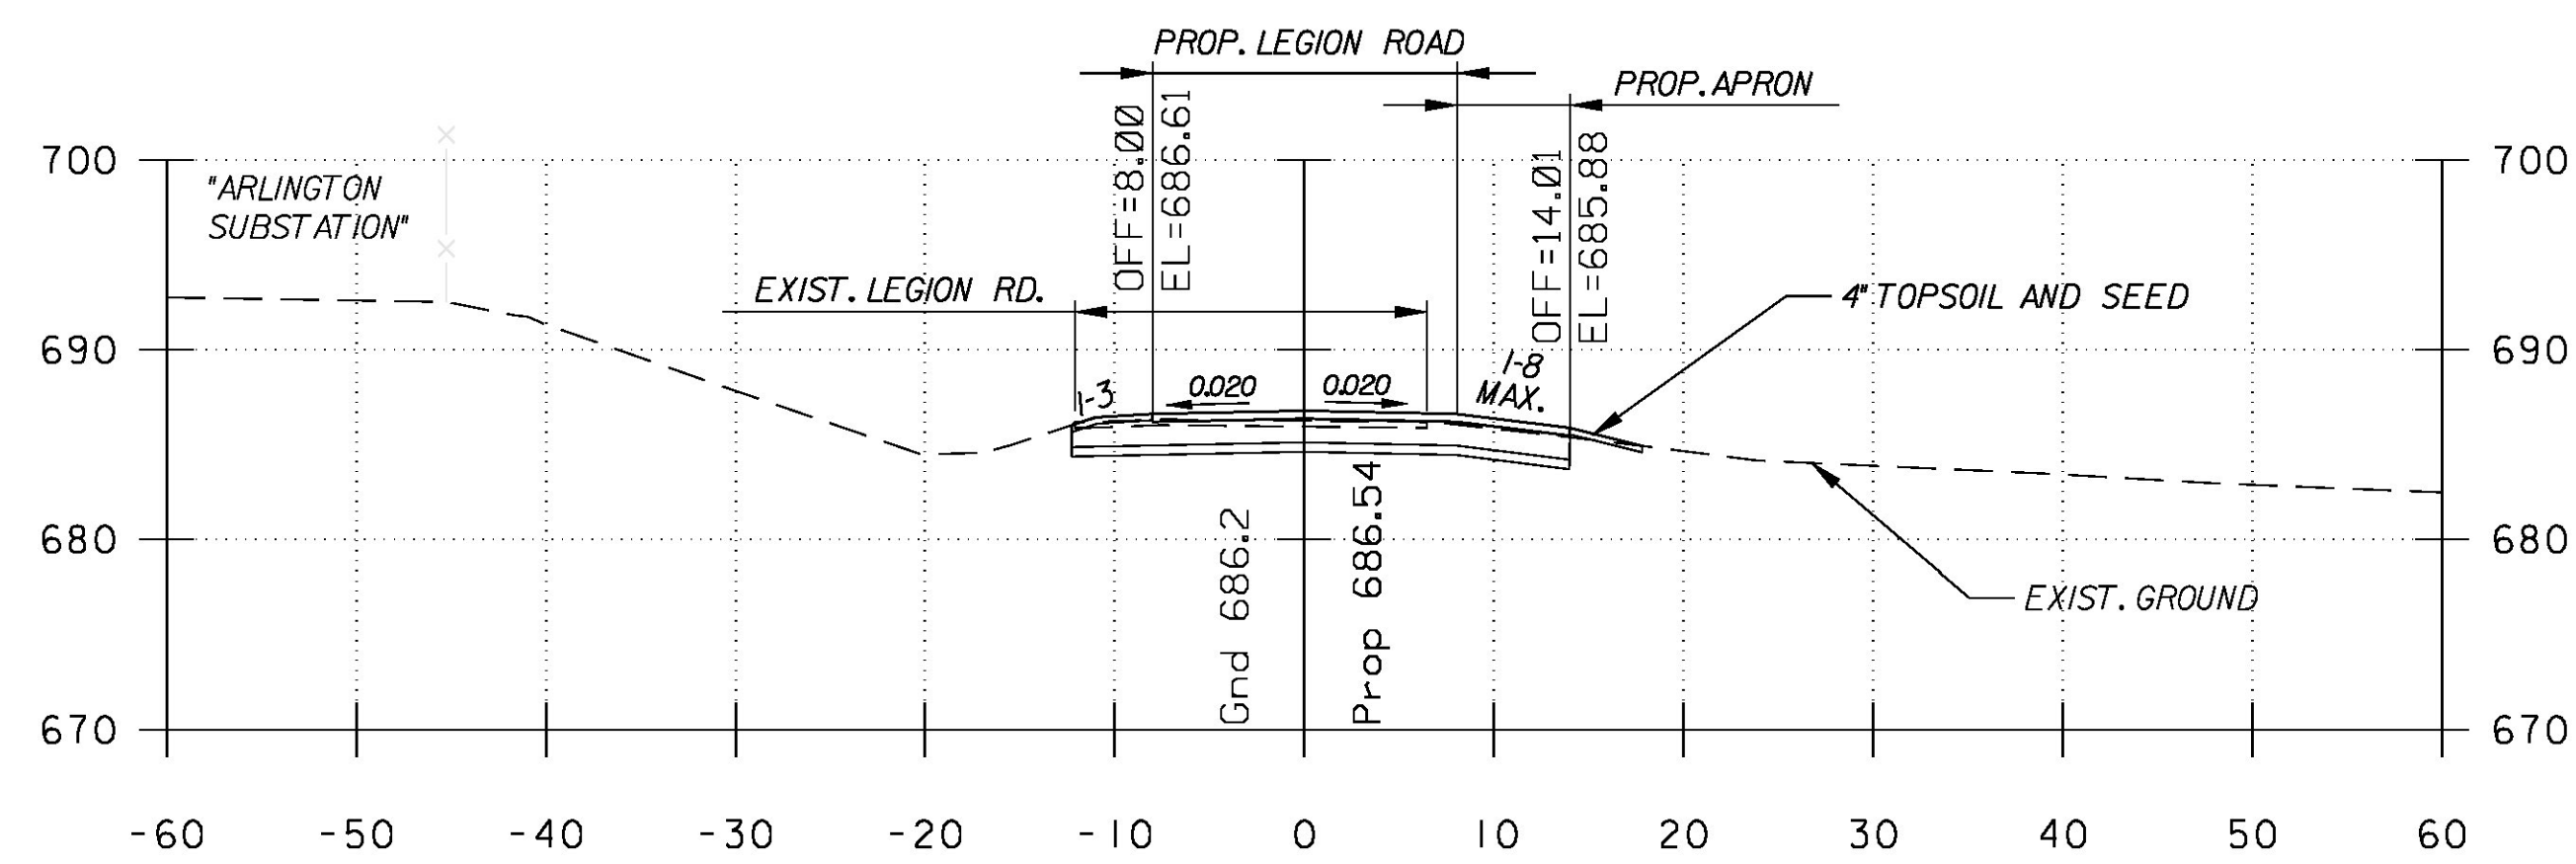

32+00

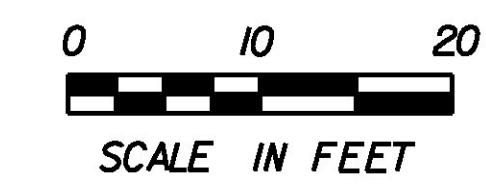

STA. 32+00 - 32+50

PROJECT NAME:	ARLINGTON	PLOT DATE:	2/5/2016
PROJECT NUMBER:	STP 0114 (4)	DRAWN BY:	LB
FILE NAME:	z09g052xsl.dgn	CHECKED BY:	J. READ
PROJECT LEADER:	J. READ	CROSS SECTIONS -	3
DESIGNED BY:	ABR	SHEET	23 OF 27