



STATE OF VERMONT AGENCY OF TRANSPORTATION

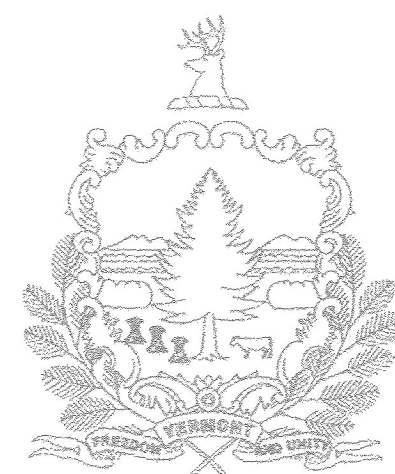

PROPOSED IMPROVEMENT COUNTY OF BENNINGTON TOWN OF ARLINGTON

TH#1, CL.2 AND TH#46, CL.3 (7-RURAL MAJOR COLLECTOR)

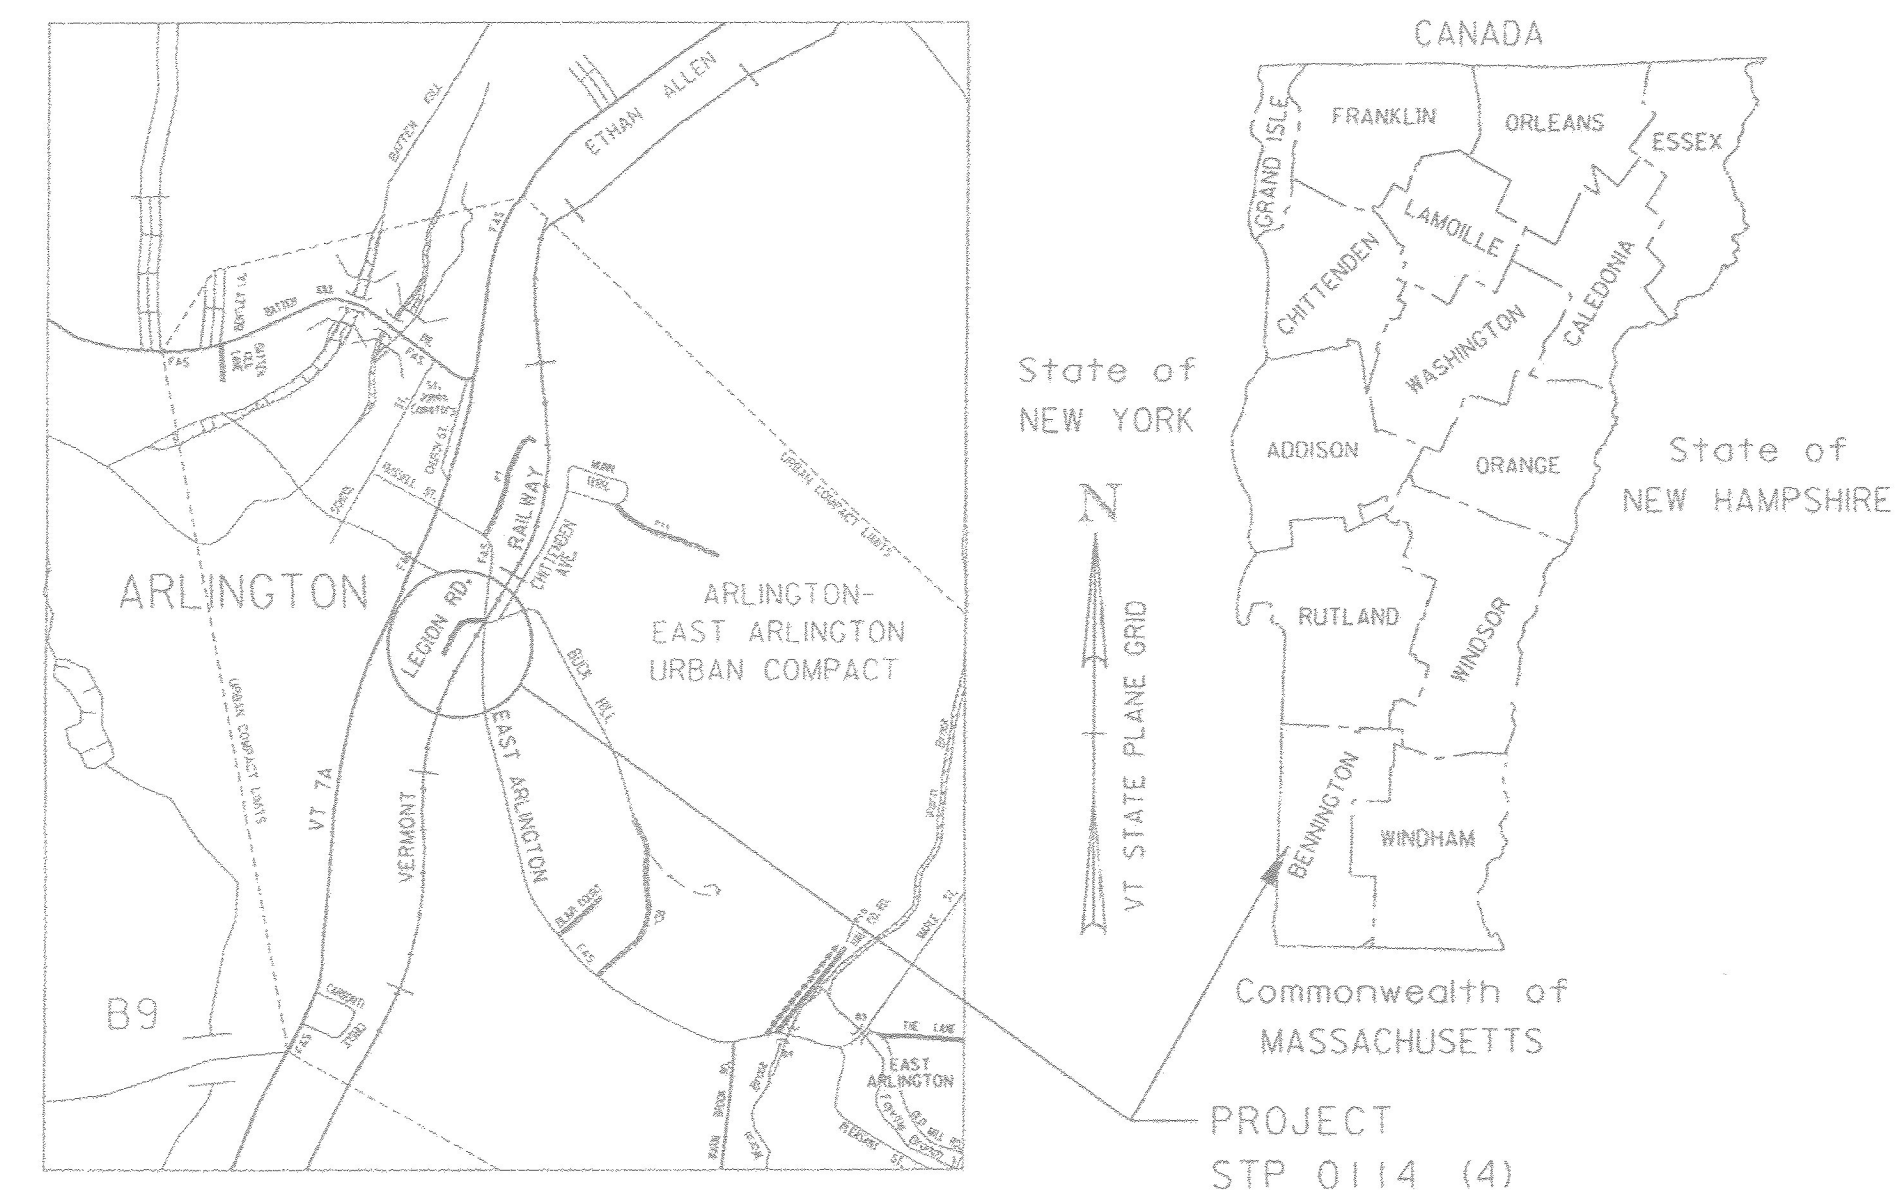

RECORD PLANS	
CONTRACTOR:	DELSIGNORE BLACKTOP PAVING, INC. - TROY, NY
RESIDENT ENGINEER:	RON LEMAIRE
CONSTRUCTION BEGAN:	JULY 25, 2016
CONSTRUCTION COMPLETE:	SEPTEMBER 12, 2016
RECORD PLANS BY:	RON LEMAIRE & AARON WEAVER
I HEREBY CERTIFY THAT ALL THE CONSTRUCTION REQUIRED BY THIS SET OF DRAWINGS HAS BEEN ACCOMPLISHED AS INDICATED HEREIN.	
<i>Ron Lemaire</i> FOR: RESIDENT ENGINEER	DATE May 29, 2018
NOTE: Any further information concerning final quantities, amounts or other details relative to this project may be found at Central Files in the electronic archives.	


E. ARLINGTON RD.: BEGINNING AT A POINT ON E. ARLINGTON RD. SAID POINT BEING APPROXIMATELY 1000 ft SOUTHEASTERLY FROM ITS INTERSECTION WITH STATE ROUTE 7A AND EXTENDING SOUTHEASTERLY TO INCLUDE GRADE CROSSING 851-184B.
 LEGION RD. RELOCATED: BEGINNING AT A POINT ON LEGION ROAD RELOCATED 7.00 ft WESTERLY OF ITS INTERSECTION WITH EAST ARLINGTON ROAD AND EXTENDING SOUTHWESTERLY 243.00 ft.
 WORK TO BE PERFORMED UNDER THIS PROJECT WILL INCLUDE THE RELOCATION OF EXISTING LEGION ROAD AND THE RECONSTRUCTION OF EAST ARLINGTON ROAD RR CROSSING SIGNAL SYSTEM INCLUDING NEW SIGNALS, PAVEMENT MARKINGS, AND SIGNAGE.

TRAFFIC DATA

RAILROAD:
 PASSENGER DESIGN SPEED = 30 MPH
 FREIGHT DESIGN SPEED = 25 MPH

LEGION ROAD:
 DESIGN SPEED = 15 MPH (ASSUMED)
 AADT= NO DATA AVAILABLE
 ASSUMED < 100

E. ARLINGTON ROAD:
 DESIGN SPEED = 25 MPH (POSTED)
 AADT (2011) = 2200 E

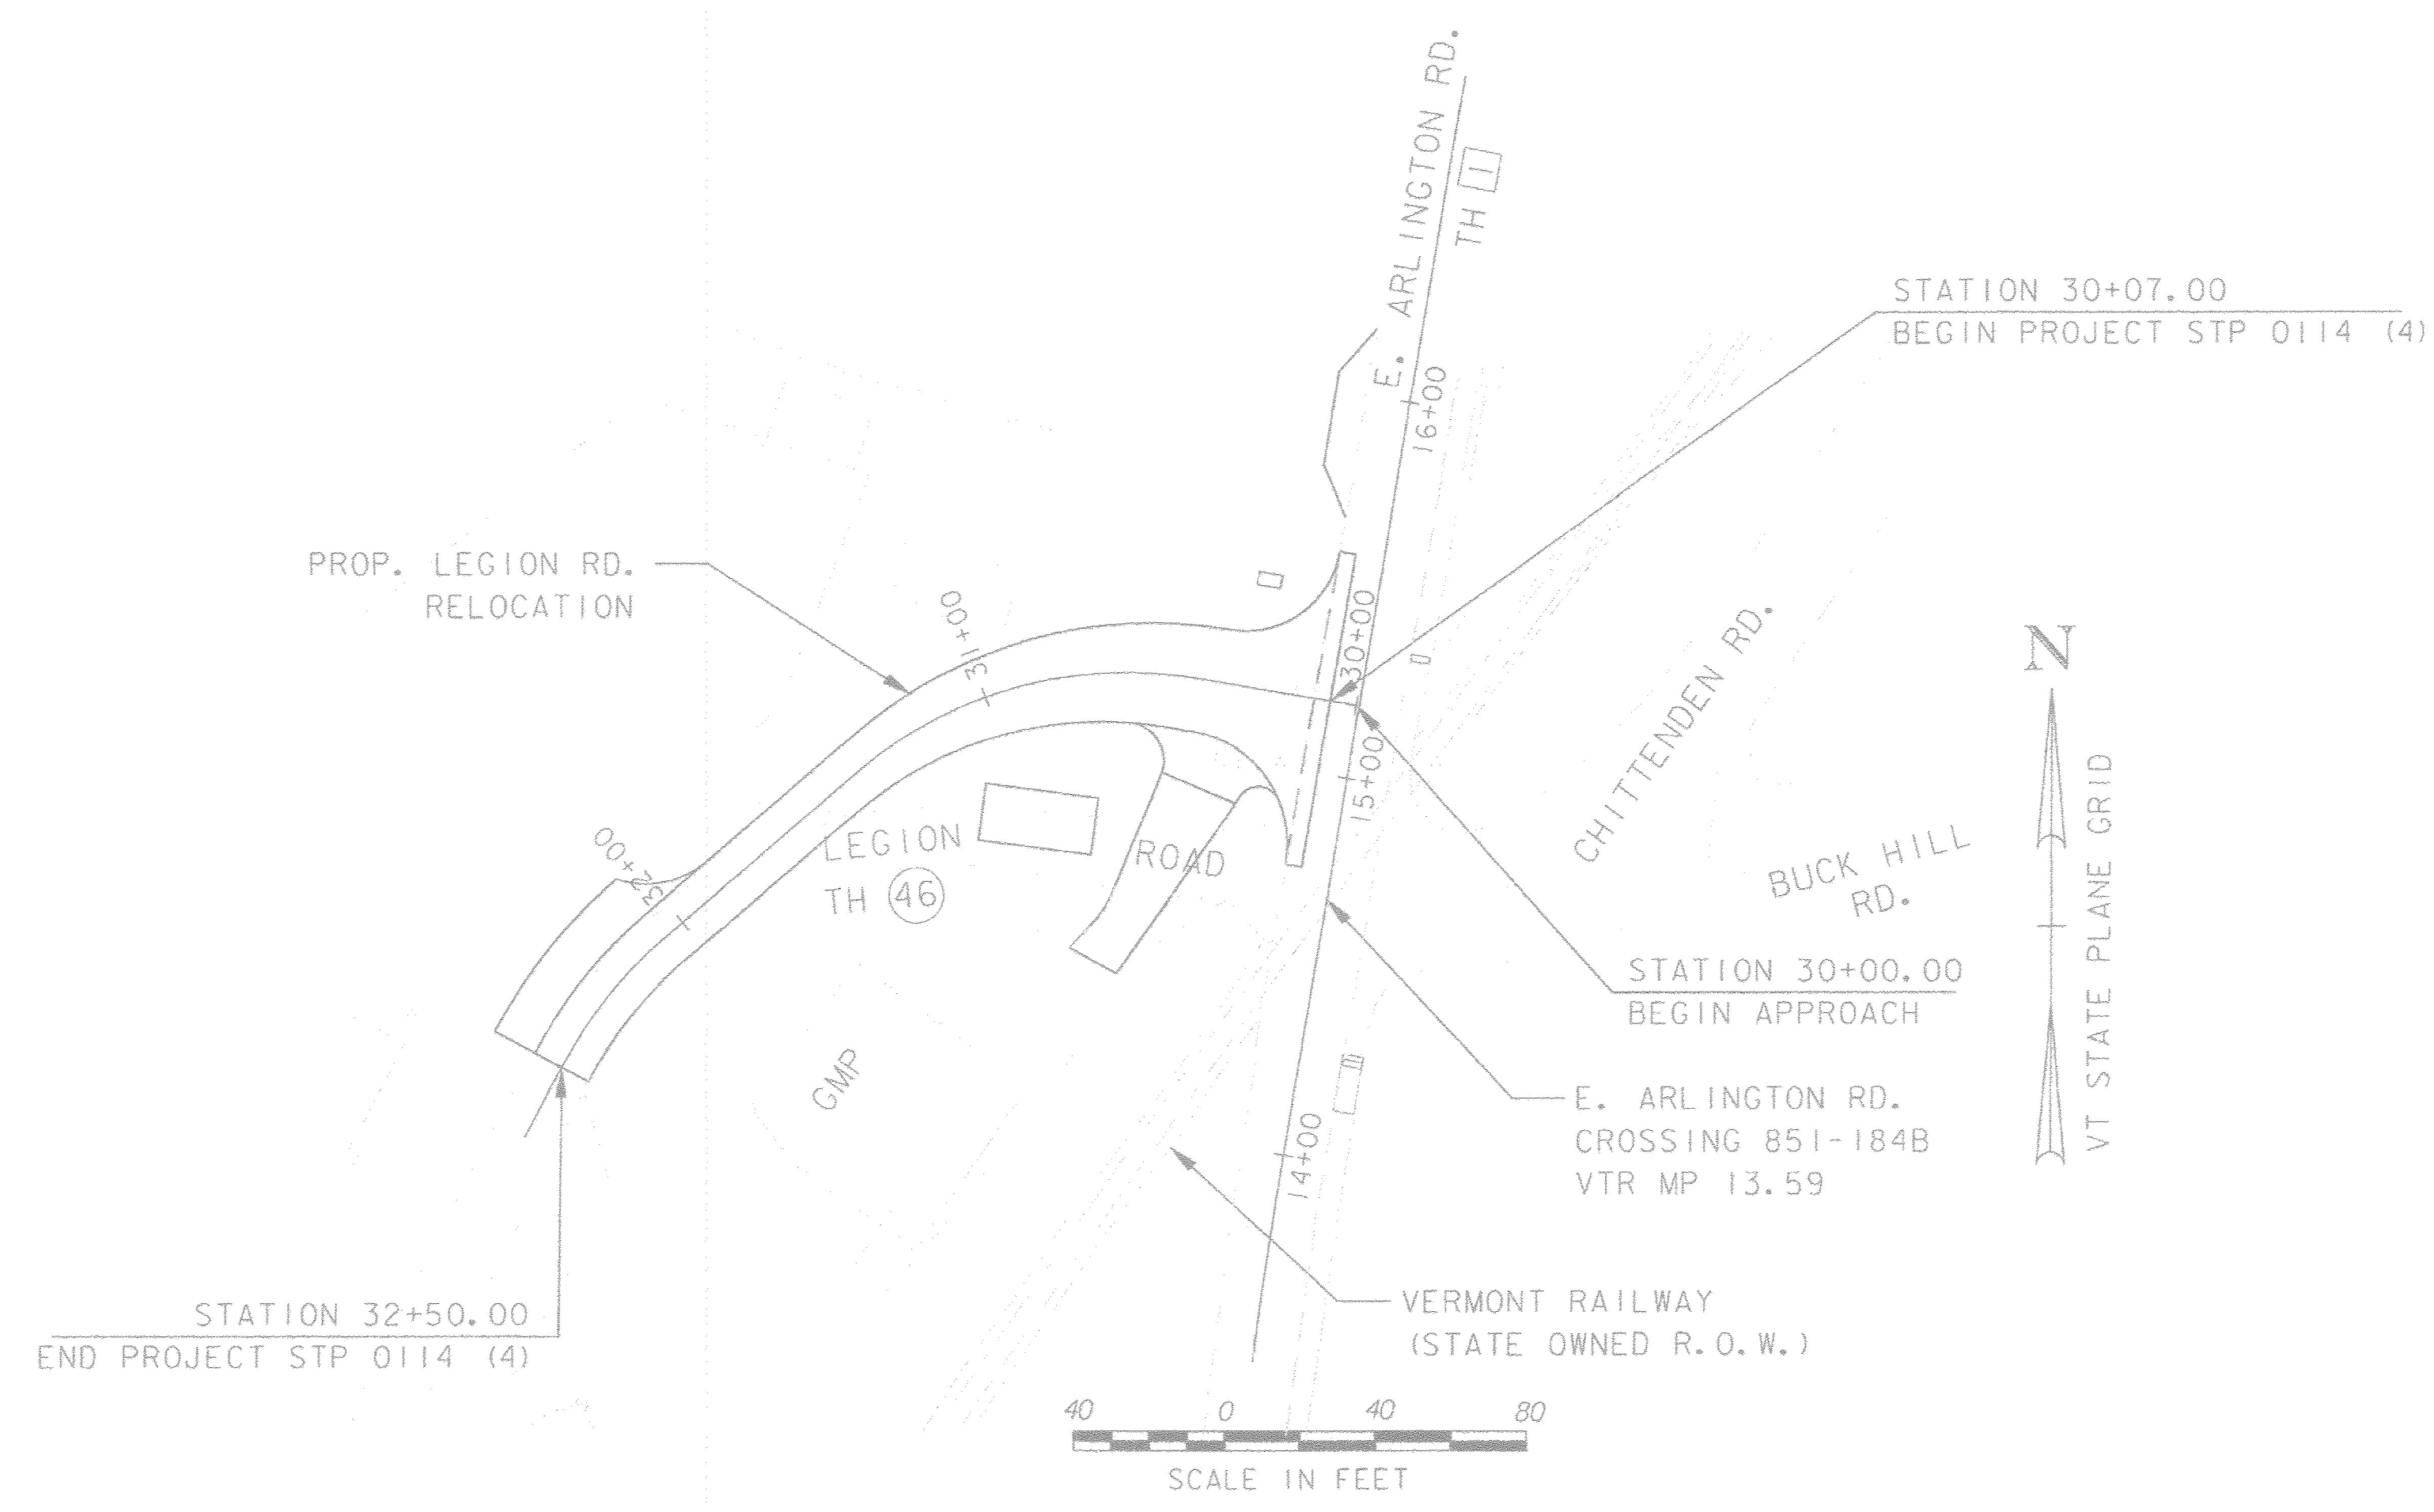

THESE PLANS ARE SUBJECT TO SUCH ENGINEERING CHANGES AS MAY BE REQUIRED BY THE FEDERAL HIGHWAY ADMINISTRATION OR THE DIRECTOR OF PROGRAM DEVELOPMENT.
 CONSTRUCTION IS TO BE CARRIED ON IN ACCORDANCE WITH THESE PLANS AND THE STANDARD SPECIFICATIONS FOR CONSTRUCTION DATED 2011, AS APPROVED BY THE FEDERAL HIGHWAY ADMINISTRATION ON JULY 20, 2011 FOR USE ON THIS PROJECT, INCLUDING ALL SUBSEQUENT REVISIONS AND SUCH REVISED SPECIFICATIONS AND SPECIAL PROVISIONS AS ARE INCORPORATED IN THESE PLANS.

QUALITY ASSURANCE PROGRAM : LEVEL 3	
SURVEYED BY :	VTRANS
SURVEYED DATE :	JAN. 2004
DATUM	
VERTICAL	NAVD 88
HORIZONTAL	NAD 83 (96)

Note:
 ROW sheets 26 and 27 of this plan set have been prepared by Stantec, South Burlington, Vermont.

	RAIL PROGRAM DIRECTOR
	APPROVED <i>[Signature]</i> DATE <u>2/9/16</u>
	PROJECT MANAGER : KYLE WELLS
	PROJECT NAME : ARLINGTON PROJECT NUMBER : STP 0114 (4)
SHEET 1 OF 27 SHEETS	

PT0120063

<u>INDEX OF SHEETS</u>	
1	TITLE SHEET
2	INDEX SHEET
3-4	QUANTITY SHEETS
5	ITEM DETAIL AND DRAINAGE SHEET
6	EARTHWORKS SHEET
7	CONVENTIONAL SYMBOLOGY - LEGEND
8	TYPICAL SECTIONS
9-10	EPSC DETAIL SHEETS
11	TIE SHEET
12	ROADWAY LAYOUT
13	PROJECT SURVEY/COORDINATE DATA
14	PROFILE
15	RAILROAD SIGNAL LAYOUT
16	TRAFFIC SIGNS AND PAVEMENT MARKINGS
17	TRAFFIC SIGN SUMMARY SHEET
18	RAILROAD SIGNAL DETAILS
19	SIGN DETAILS
20	CONCRETE PAD DETAILS
21-23	CROSS SECTIONS
24-25	STAGE CONSTRUCTION
26	RIGHT-OF-WAY DETAIL SHEET
27	RIGHT-OF-WAY LAYOUT SHEET

<u>ABBREVIATIONS</u>	
EXIST.	EXISTING
PROP.	PROPOSED
BEG.	BEGINNING
BIT. CONC.	BITUMINOUS CONCRETE
PCC	PORTLAND CEMENT CONCRETE
RCP	REINFORCED CONCRETE PIPE
(N)	NEW SIGN
DYCL	DOUBLE YELLOW CENTER LINE
STA.	STATION
ELEV.	ELEVATION

	<u>DESCRIPTION</u>	<u>DATE</u>
A-76	STANDARDS FOR TOWN AND DEVELOPMENT ROADS	MAR. 03, 2003
B-5	SLOPE GRADING, EMBANKMENTS, MUCK	JUN. 01, 1994
B-71	STANDARD FOR RESIDENTIAL AND COMMERCIAL DRIVES	JUL. 08, 2005
C-3B	SIDEWALK RAMPS AND MEDIAN ISLANDS	MAR. 10, 2008
D-4	VARIOUS DRAINAGE DETAILS	AUG. 13, 2007
D-11	STEEL GRATE; CAST IRON GRATE TYPE A; CAST IRON COVER	JUN. 01, 1994
D-15	PRECAST REINFORCED CONCRETE CATCH BASIN W/ CAST IRON GRATE; PRECAST REINFORCED CONCRETE MANHOLE W/ CAST IRON COVER; CAST IRON GRATE WITH FRAME, TYPE D; CAST IRON GRATE WITH FRAME, TYPE E	JUN. 01, 1994
D-16	PRECAST REINFORCED CONCRETE CURB DROP INLET WITH CAST IRON GRATE; CAST IRON GRATE, TYPE B; CAST IRON GRATE, TYPE C; UNDERDRAIN RISER; REINFORCED CONCRETE PIPE AND SECTION; ENERGY DISSIPATER FOR CULVERT	JUN. 01, 1994
E-121	STANDARD SIGN PLACEMENT - CONVENTIONAL ROAD	AUG. 08, 1995
E-143	REGULATORY SIGN DETAILS	JUN. 15, 2004
E-153B	WARNING SIGN DETAILS	MAY 30, 2003
E-175	POWER DROP STANCHIONS	JUN. 08, 2009
E-190	RAILROAD CROSSING SIGNS AND PAVEMENT MARKINGS	JUN. 30, 2003
E-193	PAVEMENT MARKINGS DETAILS	AUG. 18, 1995
J-3	MAIL BOX SUPPORT DETAILS	AUG. 07, 1995
T-1	TRAFFIC CONTROL GENERAL NOTES	AUG. 06, 2012
T-10	CONVENTIONAL ROADS CONSTRUCTION APPROACH SIGNING	AUG. 06, 2012
T-17	TRAFFIC CONTROL MISCELLANEOUS DETAILS	AUG. 06, 2012
T-24	TRAFFIC CONTROL FOR MAINT. PAVEMENT MARKING OPERATION	AUG. 06, 2012
T-28	CONSTRUCTION SIGN DETAILS	AUG. 06, 2012
T-29	CONSTRUCTION SIGN DETAILS	AUG. 06, 2012
T-35	CONSTRUCTION ZONE LONGITUDINAL DROP-OFFS	AUG. 06, 2012
T-36	CONSTRUCTION ZONE LONGITUDINAL DROP-OFFS FOR PAVING	AUG. 06, 2012
T-45	SQUARE TUBE SIGN POST AND ANCHOR	JAN. 02, 2013

PROJECT NAME: ARLINGTON
PROJECT NUMBER: STP 0114 (4)

FILE NAME: z09g052Index.dgn	PLOT DATE: 2/5/2016
PROJECT LEADER: J. READ	DRAWN BY: NSB
DESIGNED BY: ABR	CHECKED BY: ABR
INDEX SHEET	SHEET 2 OF 27

QUANTITY SHEET 1

SUMMARY OF ESTIMATED QUANTITIES										TOTALS		DESCRIPTIONS				DETAILED SUMMARY OF QUANTITIES			
								ROADWAY	EC	RAILROAD	GRAND TOTAL	FINAL	UNIT	ITEMS	ITEM NUMBER	ROUND	QUANTITIES	UNIT	ITEMS
								1			1		LS	CLEARING AND GRUBBING, INCLUDING INDIVIDUAL TREES AND STUMPS	201.10				
								292			292		CY	UNCLASSIFIED EXCAVATION	203.17	0.59			
								125			125		CY	EXCAVATION OF SURFACES AND PAVEMENTS	203.28	1.11			
								691			691		CY	EARTH BORROW	203.30				
								167			167		CY	SAND BORROW	203.31	0.78			
								80			80		CY	TRENCH EXCAVATION OF EARTH	204.20	0.04			
								1			1		CY	TRENCH EXCAVATION OF EARTH, EXPLORATORY (N.A.B.I.)	204.22				
								562			562		CY	SUBBASE OF DENSE GRADED CRUSHED STONE	301.35	5.06			
								9			9		CY	AGGREGATE SURFACE COURSE	401.10	0.08			
								1			1		LU	PRICE ADJUSTMENT, ASPHALT CEMENT (N.A.B.I.)	406.50				
								970			970		LB	REINFORCING STEEL, LEVEL I	507.11	8.88			
								324			324		LF	JOINT SEALER, HOT POURED	524.11	3			
								16.8			16.8		CY	CONCRETE, CLASS B	541.25	0.13			
								28			28		LF	12" CSP .064 (2-2/3 X 1/2)	601.0005	0.07			
								44			44		LF	18" RCP CLASS IV	601.0816	0.31			
								1			1		EACH	18" RCPE CLASS III	601.6815				
								1			1		EACH	PRECAST REINFORCED CONCRETE MANHOLE WITH CAST IRON COVER	604.21				
								9			9		MGAL	DUST CONTROL WITH WATER	609.10	0.07			
								1.1			1.1		TON	DUST AND ICE CONTROL WITH CALCIUM CHLORIDE	609.15	0.002			
								1.45			1.45		CY	STONE FILL, TYPE II	613.11	0.01			
								15			15		LF	VERTICAL GRANITE CURB	616.21				
								15			15		LF	REMOVAL OF EXISTING CURB	616.41				
								1			1		EACH	RELOCATE MAILBOX, SINGLE SUPPORT	617.10				
								7.5			7.5		SY	PORTLAND CEMENT CONCRETE SIDEWALK, 5 INCH	618.10				
								16			16		SF	DETECTABLE WARNING SURFACE	618.30				
								2			2		EACH	STEEL MARKER POSTS	619.16				
								161			161		LF	SEAMLESS COPPER WATER TUBE (1 INCH DIA.)	629.23				
								1			1		EACH	EXTENSION SERVICE BOX AND CURB STOP (1 INCH DIA.)	629.25				
								150			150		HR	UNIFORMED TRAFFIC OFFICERS	630.10				
								540			540		HR	FLAGGERS	630.15				
								1			1		LS	MOBILIZATION/DEMOBILIZATION	635.11				
								1200			1200		LF	DURABLE 4 INCH YELLOW LINE, THERMOPLASTIC	646.412	10			
								24			24		LF	DURABLE 24 INCH STOP BAR, THERMOPLASTIC	646.482				
								103			103		LF	DURABLE CROSSWALK MARKING, THERMOPLASTIC	646.502				
								3			3		EACH	DURABLE RAILROAD CROSSING SYMBOL, THERMOPLASTIC	646.512				
								915			915		SF	REMOVAL OF EXISTING PAVEMENT MARKINGS	646.85	1.02			
									186		186		SY	GEOTEXTILE FOR SILT FENCE, WOVEN WIRE REINFORCED	649.515	0.67			
									16		16		LB	SEED	651.15	0.7			
									96		96		LB	FERTILIZER	651.18	0.38			
									0.21		0.21		TON	AGRICULTURAL LIMESTONE	651.20				

PROJECT NAME: ARLINGTON
PROJECT NUMBER: STP 0114 (4)
FILE NAME: Z09G0520S.DGN
PROJECT LEADER: J.READ
DESIGNED BY: LB
QUANTITY SHEET #1
PLOT DATE: 2/22/2016
DRAWN BY: LB
CHECKED BY: ABR
SHEET 3 OF 27

QUANTITY SHEET 2

SUMMARY OF ESTIMATED QUANTITIES										TOTALS		DESCRIPTIONS				DETAILED SUMMARY OF QUANTITIES		
							ROADWAY	EC	RAILROAD	GRAND TOTAL	FINAL	UNIT	ITEMS	ITEM NUMBER	ROUND	QUANTITIES	UNIT	ITEMS
								0.39		0.39		TON	HAY MULCH	651.25	0.01			
								129		129		CY	TOPSOIL	651.35	0.45			
								930		930		SY	TEMPORARY EROSION MATTING	653.20	4.44			
								19		19		CY	TEMPORARY STONE CHECK DAM, TYPE I	653.25	0.04			
								2		2		EACH	INLET PROTECTION DEVICE, TYPE I	653.40				
							635			635		LF	PROJECT DEMARCATION FENCE	653.55	2			
							115.7			115.7		SF	TRAFFIC SIGNS, TYPE A	675.20				
							270			270		LF	SQUARE TUBE SIGN POST AND ANCHOR	675.341				
							10			10		EACH	REMOVING SIGNS	675.50				
							1			1		EACH	ERECTING SALVAGED SIGNS	675.60				
							1			1		EACH	SETTING SALVAGED POSTS	675.61				
							138			138		LF	SPECIAL PROVISION (HORIZONTAL DIRECTIONAL DRILLING) (6" CASING PIPE)	900.640				
							1			1		LS	SPECIAL PROVISION (MILITARY TANK REMOVED AND RELOCATED)	900.645				
									1	1		LS	SPECIAL PROVISION (RAIL-HIGHWAY CROSSING ACTIVE WARNING SYSTEM) (AARDOT 240-947A)	900.645				
									1	1		LS	SPECIAL PROVISION (TRAFFIC CONTROL, RAIL-HIGHWAY CROSSING)	900.645				
							1			1		LU	SPECIAL PROVISION (LEGION SIGN REMOVED AND RELOCATED)	900.650				
									1	1		LU	SPECIAL PROVISION (MAINTENANCE OF RAIL TRAFFIC) (N.A.B.I.)	900.650				
							1			1		LU	SPECIAL PROVISION (MAT DENSITY PAY ADJUSTMENT, SMALL QUANTITY) (N.A.B.I.)	900.650				
							1			1		LU	SPECIAL PROVISION (MIXTURE PAY ADJUSTMENT) (N.A.B.I.)	900.650				
							201			201		TON	SPECIAL PROVISION (BITUMINOUS CONCRETE PAVEMENT, SMALL QUANTITY)	900.680				
							2.41			2.41		CWT	SPECIAL PROVISION (EMULSIFIED ASPHALT) (RS-1H OR CRS-1H)	900.683				

PROJECT NAME: ARLINGTON
 PROJECT NUMBER: STP 0114 (4)
 FILE NAME: Z09G052QS.DGN
 PROJECT LEADER: J.READ
 DESIGNED BY: LB
 QUANTITY SHEET #2
 PLOT DATE: 2/22/2016
 DRAWN BY: LB
 CHECKED BY: ABR
 SHEET 4 OF 27

GENERAL INFORMATION

SYMBOLGY LEGEND NOTE

THE SYMBOLGY ON THIS SHEET IS INTENDED TO COVER STANDARD CONVENTIONAL SYMBOLGY. THE SYMBOLGY IS USED FOR EXISTING & PROPOSED FEATURES WITH HEAVIER LINEWEIGHT, IN COMBINATION WITH PROJECT ANNOTATION, AS NOTED ON PROJECT PLAN SHEETS. THIS LEGEND SHEET COVERS THE BASICS. SYMBOLGY ON PLANS MAY VARY, PLAN ANNOTATIONS AND NOTES SHOULD BE USED TO CLARIFY AS NEEDED.

R. O. W. ABBREVIATIONS (CODES) & SYMBOLS

POINT CODE	DESCRIPTION	
CH	CHANNEL EASEMENT	
CONST	CONSTRUCTION EASEMENT	
CUL	CULVERT EASEMENT	
D&C	DISCONNECT & CONNECT	
DIT	DITCH EASEMENT	
DR	DRAINAGE EASEMENT	
DRIVE	DRIVEWAY EASEMENT	
EC	EROSION CONTROL	
HWY	HIGHWAY EASEMENT	
I&M	INSTALL & MAINTAIN EASEMENT	
LAND	LANDSCAPE EASEMENT	
R&RES	REMOVE & RESET	
R&REP	REMOVE & REPLACE	
SR	SLOPE RIGHT	
UE	UTILITY EASEMENT	
(P)	PERMANENT EASEMENT	
(T)	TEMPORARY EASEMENT	
■	BDNS	BOUND SET
□	BDNS	BOUND TO BE SET
●	IPNS	IRON PIN SET
⊙	IPNS	IRON PIN TO BE SET
⊗	CALC	EXISTING ROW POINT
○	PROW	PROPOSED ROW POINT
[LENGTH]		LENGTH CARRIED ON NEXT SHEET

COMMON TOPOGRAPHIC POINT SYMBOLS

POINT CODE	DESCRIPTION	
※	APL	BOUND APPARENT LOCATION
◦	BM	BENCH MARK
◻	BND	BOUND
⊠	CB	CATCH BASIN
⊕	COMB	COMBINATION POLE
⊞	DITHR	DROP INLET THROATED DNC
⊗	EL	ELECTRIC POWER POLE
◦	FPOLE	FLAGPOLE
⊙	GASFIL	GAS FILLER
⊙	GP	GUIDE POST
×	GSO	GAS SHUT OFF
◦	GUY	GUY POLE
◦	GUYW	GUY WIRE
×	GV	GATE VALUE
⊗	H	TREE HARDWOOD
△	HCTRL	CONTROL HORIZONTAL
▲	HVCTRL	CONTROL HORIZ. & VERTICAL
◇	HYD	HYDRANT
◦	IP	IRON PIN
◦	IPIPE	IRON PIPE
⊕	LI	LIGHT - STREET OR YARD
⊗	MB	MAILBOX
◦	MH	MANHOLE (MH)
◻	MM	MILE MARKER
◦	PM	PARKING METER
◻	PMK	PROJECT MARKER
◦	POST	POST STONE/WOOD
⊗	RRSIG	RAILROAD SIGNAL
⊗	RRSL	RAILROAD SWITCH LEVER
⊗	S	TREE SOFTWOOD
⊗	SAT	SATELLITE DISH
⊗	SHRUB	SHRUB
⊗	SIGN	SIGN
⊗	STUMP	STUMP
⊗	TEL	TELEPHONE POLE
◦	TIE	TIE
⊗	TSIGN	SIGN W/DOUBLE POST
⊗	VCTRL	CONTROL VERTICAL
◦	WELL	WELL
×	WSO	WATER SHUT OFF

THESE ARE COMMON VAOT SURVEY POINT SYMBOLS FOR EXISTING FEATURES, ALSO USED FOR PROPOSED FEATURES WITH HEAVIER LINEWEIGHT, IN COMBINATION WITH PROPOSED ANNOTATION.

PROPOSED GEOMETRY CODES

CODE	DESCRIPTION
PC	POINT OF CURVATURE
PI	POINT OF INTERSECTION
CC	CENTER OF CURVE
PT	POINT OF TANGENCY
PCC	POINT OF COMPOUND CURVE
PRC	POINT OF REVERSE CURVE
POB	POINT OF BEGINNING
POE	POINT OF ENDING
STA	STATION PREFIX
AH	AHEAD STATION SUFFIX
BK	BACK STATION SUFFIX
D	CURVE DEGREE OF (100FT)
R	CURVE RADUIS OF
T	CURVE TANGENT LENGTH
L	CURVE LENGTH OF
E	CURVE EXTERNAL DISTANCE

UTILITY SYMBOLGY

UNDERGROUND UTILITIES

— UT —	TELEPHONE
— UE —	ELECTRIC
— UC —	CABLE (TV)
— UEC —	ELECTRIC+CABLE
— UET —	ELECTRIC+TELEPHONE
— UCT —	CABLE+TELEPHONE
— UECT —	ELECTRIC+CABLE+TELEP.
— G —	GAS LINE
— W —	WATER LINE
— S —	SANITARY SEWER (SEPTIC)

ABOVE GROUND UTILITIES (AERIAL)

— T —	TELEPHONE
— E —	ELECTRIC
— C —	CABLE (TV)
— EC —	ELECTRIC+CABLE
— ET —	ELECTRIC+TELEPHONE
— AER E&T —	ELECTRIC+TELEPHONE
— CT —	CABLE+TELEPHONE
— ECT —	ELECTRIC+CABLE+TELEP.
—	UTILITY POLE GUY WIRE

PROJECT CONSTRUCTION SYMBOLGY

PROJECT DESIGN & LAYOUT SYMBOLGY

— CZ —	CLEAR ZONE
—	PLAN LAYOUT MATCHLINE

PROJECT CONSTRUCTION FEATURES

▲	TOP OF CUT SLOPE
○	TOE OF FILL SLOPE
⊗	STONE FILL
—	BOTTOM OF DITCH
—	CULVERT PROPOSED
—	STRUCTURE SUBSURFACE
PDF	PROJECT DEMARCATION FENCE
BF	BARRIER FENCE
XXXXXX	TREE PROTECTION ZONE (TPZ)
////	STRIPING LINE REMOVAL
~~~~	SHEET PILES

**CONVENTIONAL BOUNDARY SYMBOLGY**

**BOUNDARY LINES**

— TOWN LINE —	TOWN BOUNDARY LINE
— COUNTY LINE —	COUNTY BOUNDARY LINE
— STATE LINE —	STATE BOUNDARY LINE
—	PROPOSED STATE R.O.W. (LIMITED ACCESS)
—	PROPOSED STATE R.O.W.
—	STATE ROW (LIMITED ACCESS)
—	STATE ROW
—	TOWN ROW
—	PERMANENT EASEMENT LINE (P)
—	TEMPORARY EASEMENT LINE (T)
+	SURVEY LINE
P L	PROPERTY LINE (P/L)
SR	SLOPE RIGHTS
6f	6F PROPERTY BOUNDARY
4f	4F PROPERTY BOUNDARY
HAZ	HAZARDOUS WASTE

**EPSC LAYOUT PLAN SYMBOLGY**

**EPSC MEASURES**

○	FILTER CURTAIN
—	SILT FENCE
—	SILT FENCE WOVEN WIRE
—	CHECK DAM
—	DISTURBED AREAS REQUIRING RE-VEGETATION
—	EROSION MATTING

**ENVIRONMENTAL RESOURCES**

—	WETLAND BOUNDARY
—	RIPARIAN BUFFER ZONE
—	WETLAND BUFFER ZONE
—	SOIL TYPE BOUNDARY
— T&E —	THREATENED & ENDANGERED SPECIES
— HAZ — HAZ	HAZARDOUS WASTE AREA
— AG —	AGRICULTURAL LAND
— HABITAT —	FISH & WILDLIFE HABITAT
— FLOOD PLAIN —	FLOOD PLAIN
— OHW —	ORDINARY HIGH WATER (OHW)
—	STORM WATER
—	USDA FOREST SERVICE LANDS
—	WILDLIFE HABITAT SUIT/CONN

**ARCHEOLOGICAL & HISTORIC**


— ARCH —	ARCHEOLOGICAL BOUNDARY
— HISTORIC DIST —	HISTORIC DISTRICT BOUNDARY
— HISTORIC —	HISTORIC AREA
Ⓜ	HISTORIC STRUCTURE

**CONVENTIONAL TOPOGRAPHIC SYMBOLGY**

**EXISTING FEATURES**

—	ROAD EDGE PAVEMENT
—	ROAD EDGE GRAVEL
—	DRIVEWAY EDGE
—	DITCH
—	FOUNDATION
—	FENCE (EXISTING)
—	FENCE WOOD POST
—	FENCE STEEL POST
—	GARDEN
—	ROAD GUARDRAIL
—	RAILROAD TRACKS
—	CULVERT (EXISTING)
—	STONE WALL
—	WALL
—	WOOD LINE
—	BRUSH LINE
—	HEDGE
—	BODY OF WATER EDGE
—	LEDGE EXPOSED

PROJECT NAME:	ARLINGTON
PROJECT NUMBER:	STP 0114 (4)
FILE NAME:	r09g052Legend.dgn
PROJECT LEADER:	J. READ
DESIGNED BY:	LB
CONVENTIONAL SYMBOLGY - LEGEND	
PLOT DATE:	2/5/2016
DRAWN BY:	LB
CHECKED BY:	RWH
SHEET	7 OF 27

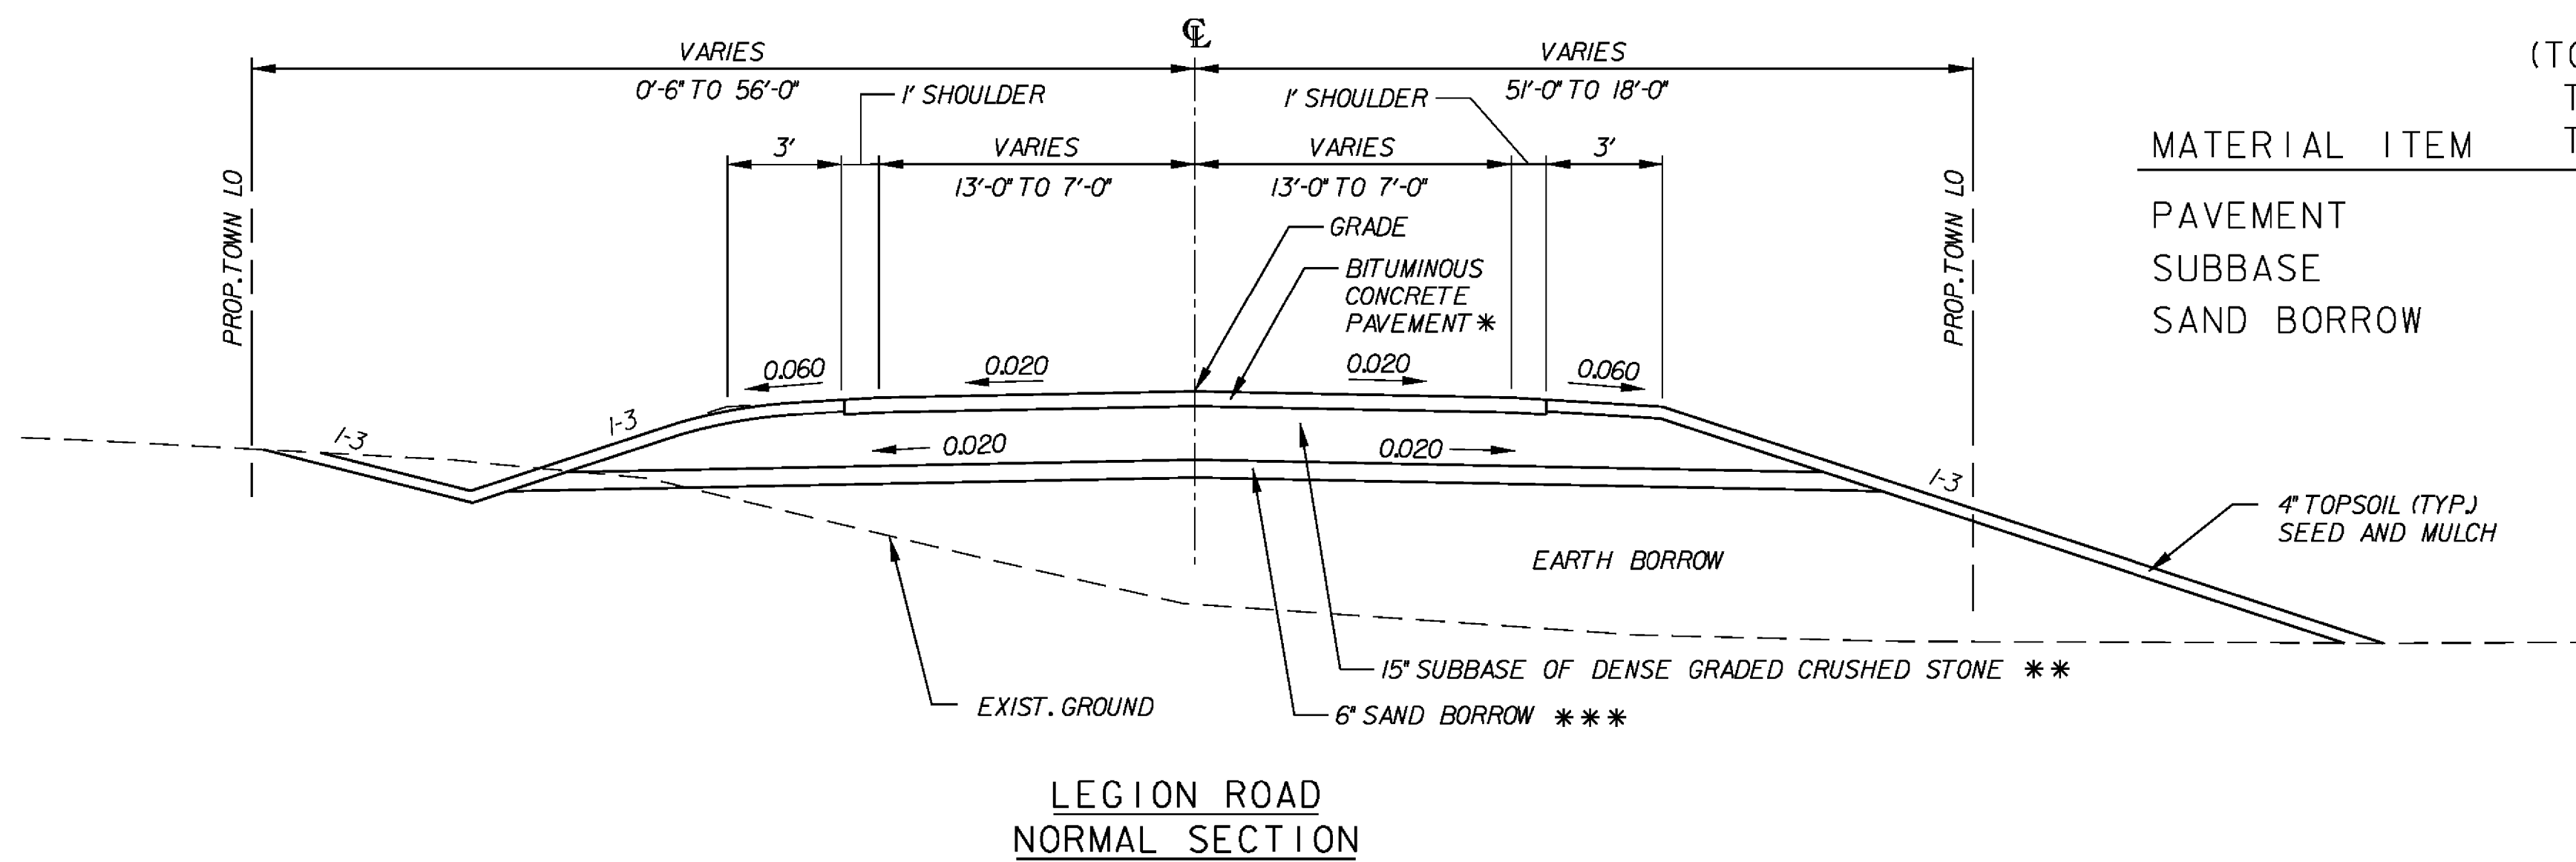



MATERIAL ITEM	(TOTAL DEPTH) THICKNESS TOLERANCE
PAVEMENT	(+/-) 1/4"
SUBBASE	(+/-) 1"
SAND BORROW	(+/-) 1"

**PAVEMENT NOTES**


- PROPOSED FULL DEPTH CONSTRUCTION:
- * 1 1/2" BITUMINOUS CONCRETE PAVEMENT (TYPE III S) (PG 58 - 28)
  - * 3 1/2" BITUMINOUS CONCRETE PAVEMENT (TYPE I S) (PG 58 - 28)
  - ** 15" SUBBASE OF DENSE GRADED CRUSHED STONE
  - *** 6" SAND BORROW

**NOTES:**

1. THE EMULSIFIED ASPHALT (RS-1H OR CRS-1H), SPECIAL PROVISION ITEM 900.683, SHALL BE APPLIED AT A RATE OF 0.03 GAL/SY JUST PRIOR TO THE PLACEMENT OF THE BITUMINOUS CONCRETE MIXTURE.
2. BITUMINOUS CONCRETE PAVEMENT WILL BE PAID UNDER ITEM 900.680 SPECIAL PROVISION (BITUMINOUS CONCRETE PAVEMENT, SMALL QUANTITY)


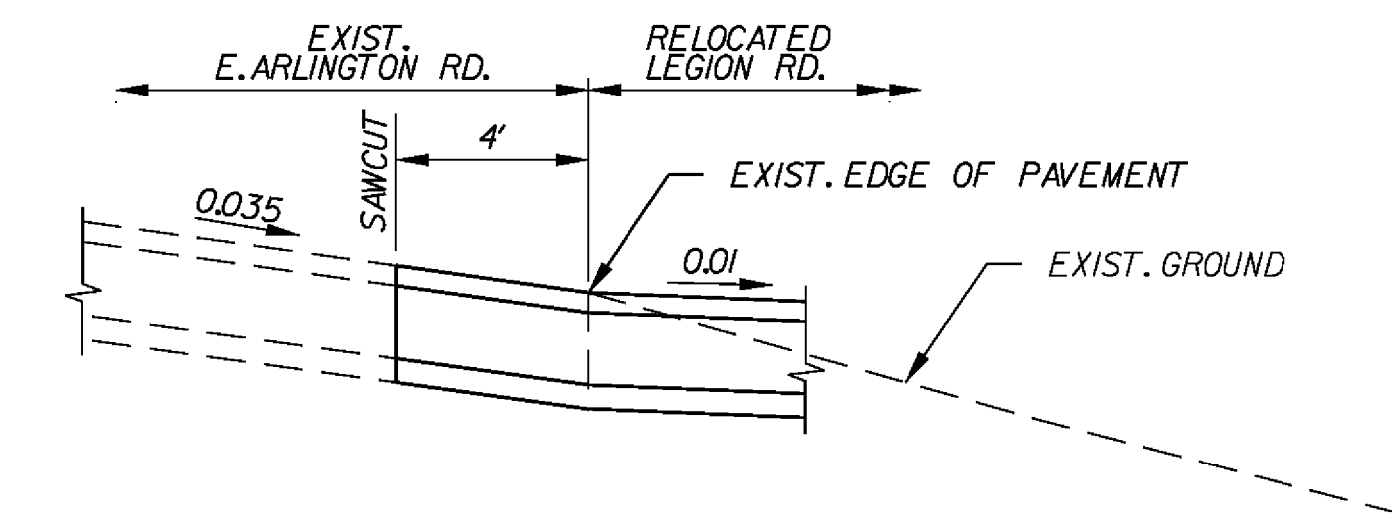
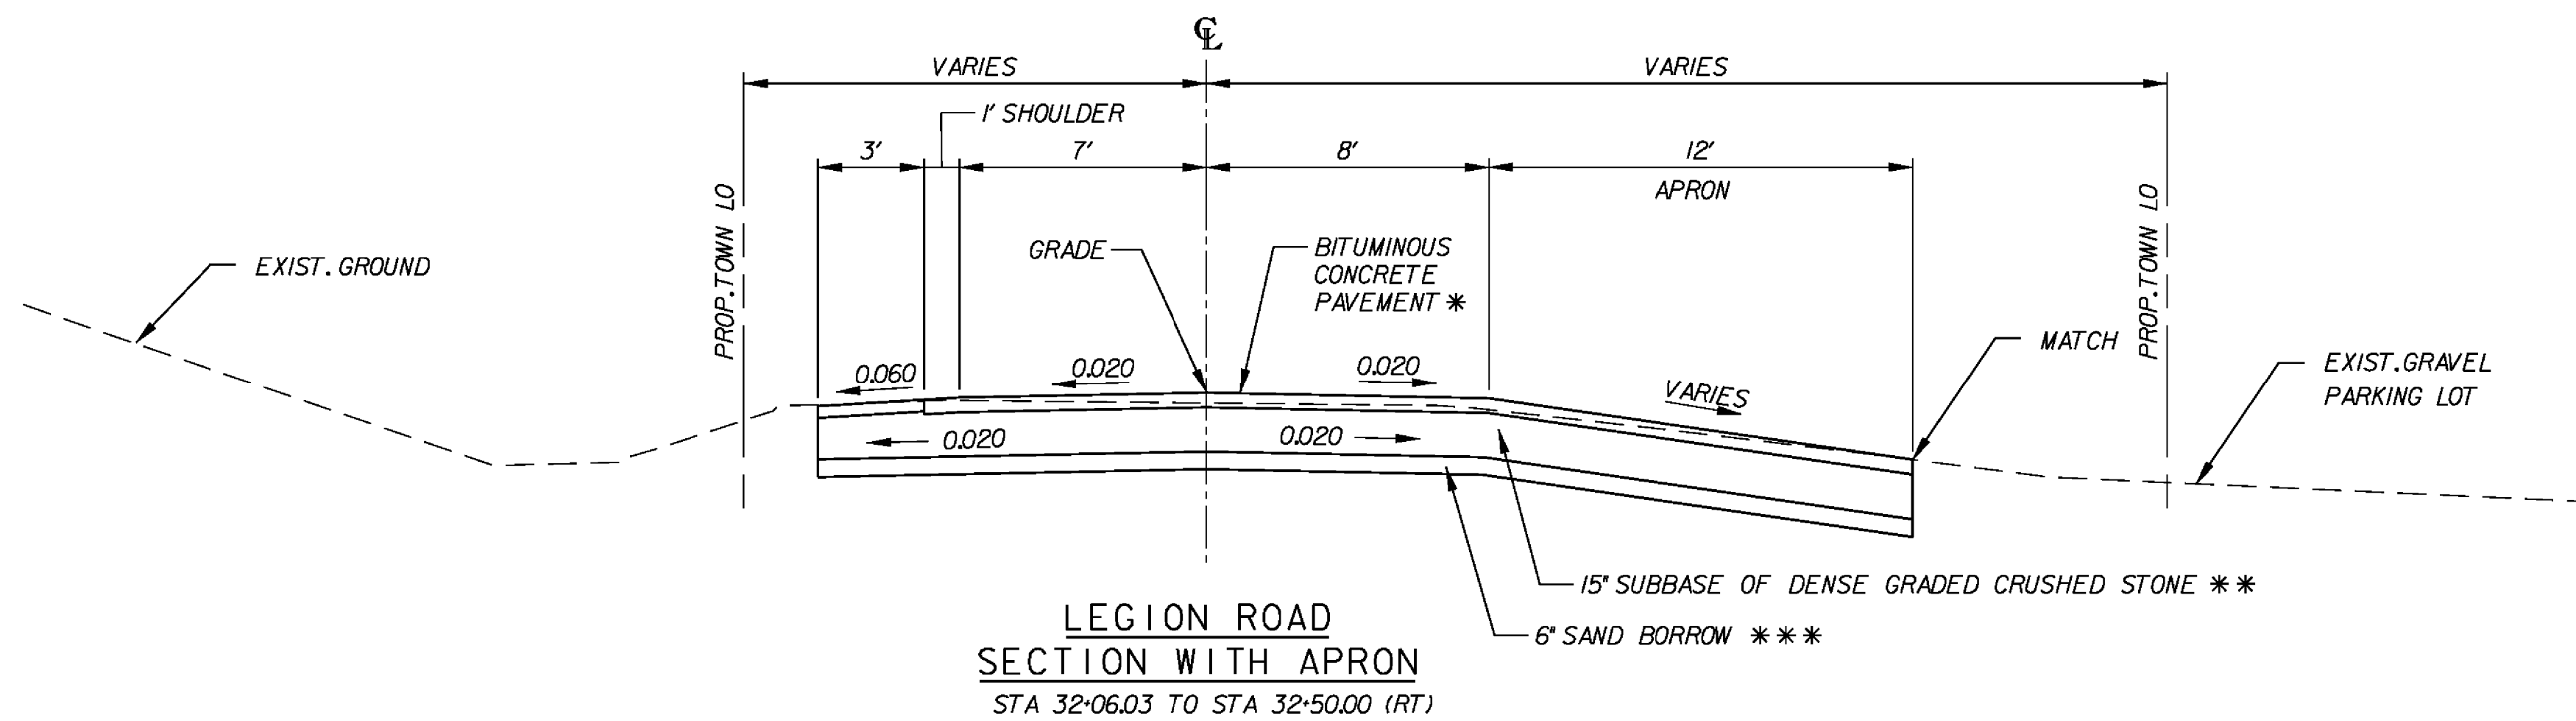


PAVEMENT TRANSITION DETAIL

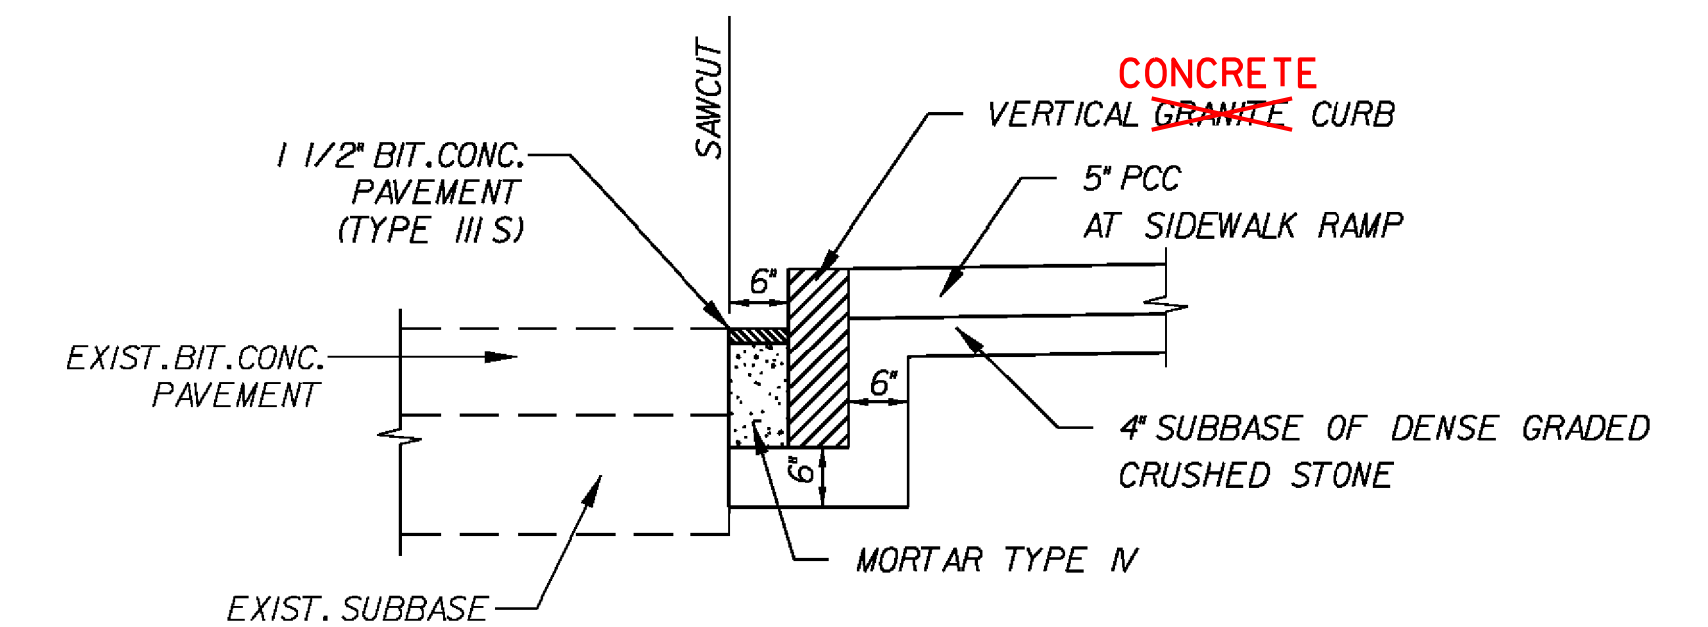

**NOTES:**


1. THIS PROCEDURE IS APPLICABLE ONLY IF CURB IS TO BE SET AFTER BASE AND/OR BINDER COURSES ARE IN PLACE.
2. CUT NEAT LINE 6" FROM CURB LINE AND REMOVE EXIST. BIT. CONC. PAVEMENT, REPLACE WITH MORTAR AND GRAVEL FOR SUBBASE.
3. PAYMENT FOR SAWCUT WILL BE INCLUDED IN ITEM 900.680 SPECIAL PROVISION (BITUMINOUS CONCRETE PAVEMENT, SMALL QUANTITY).

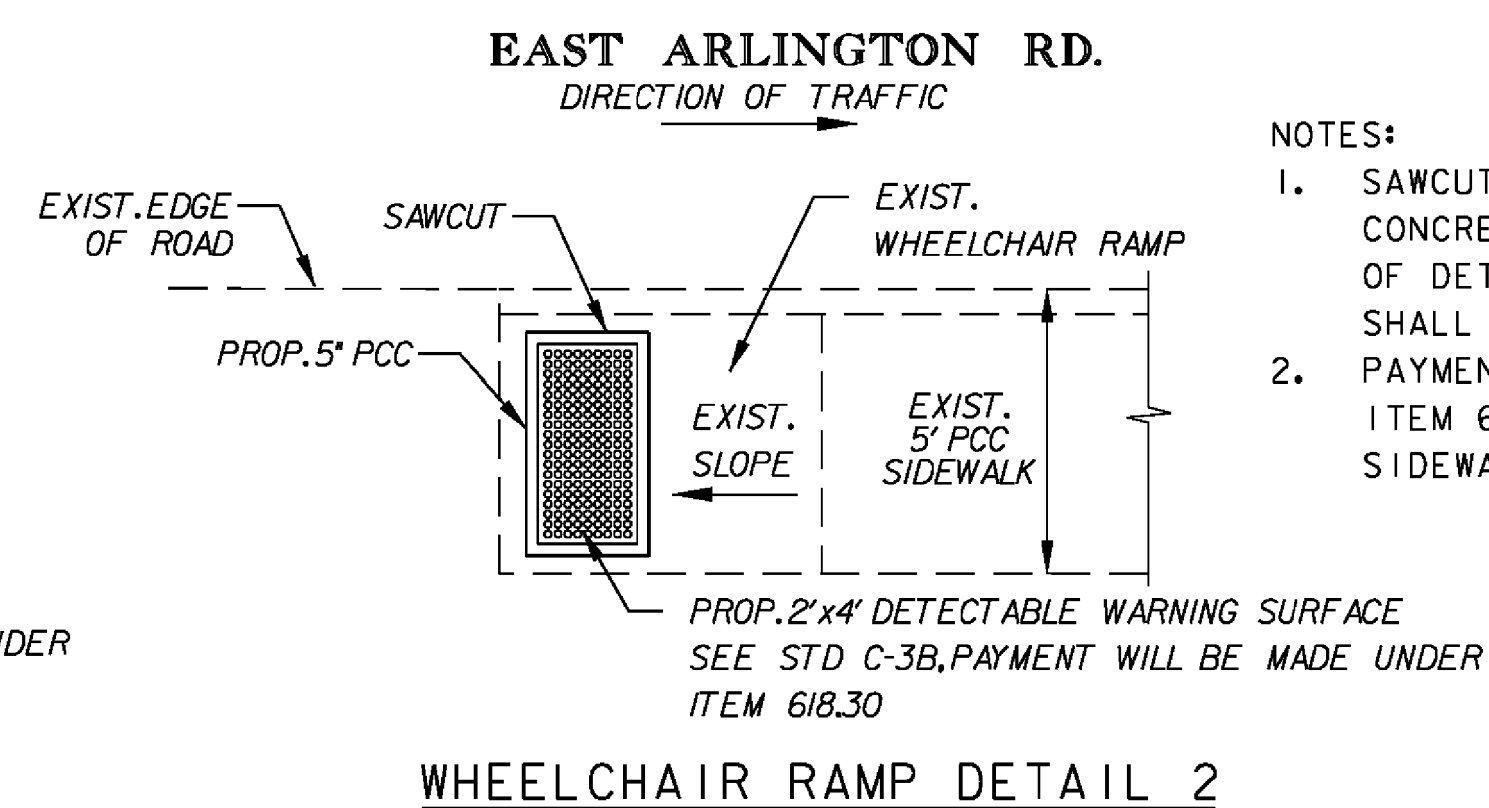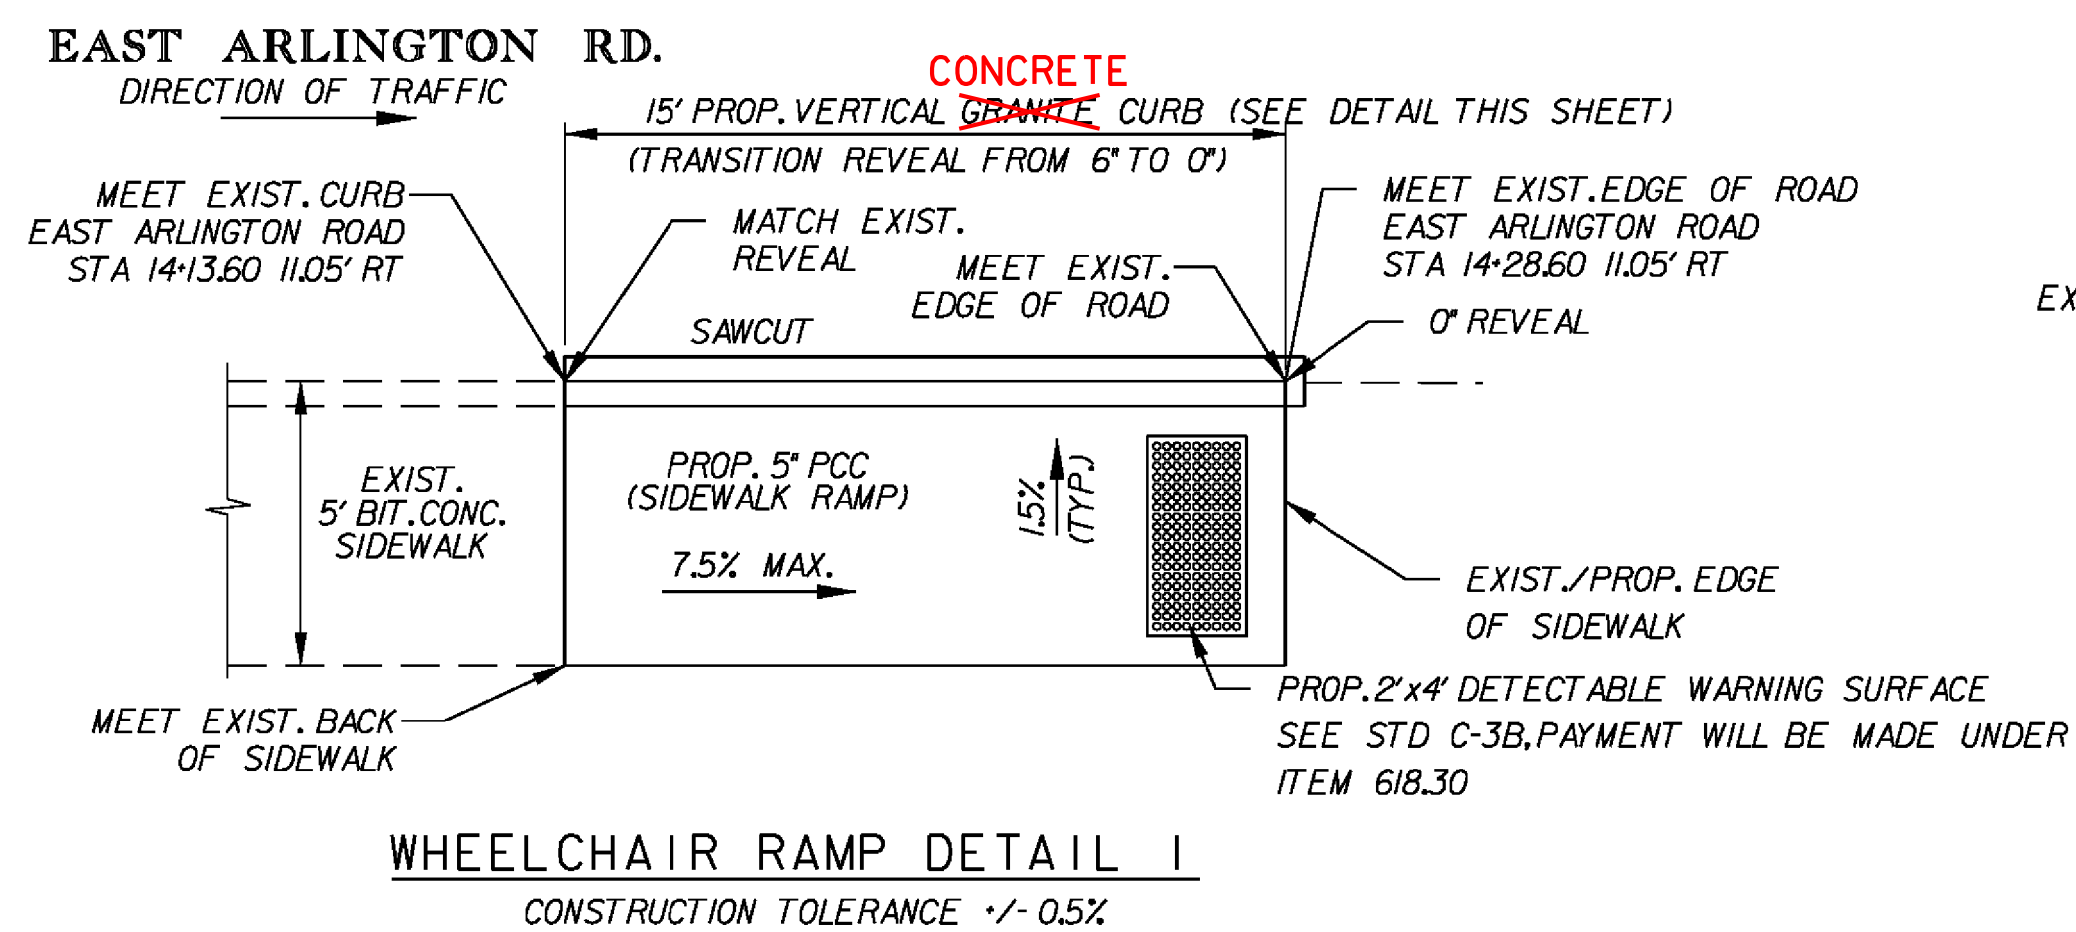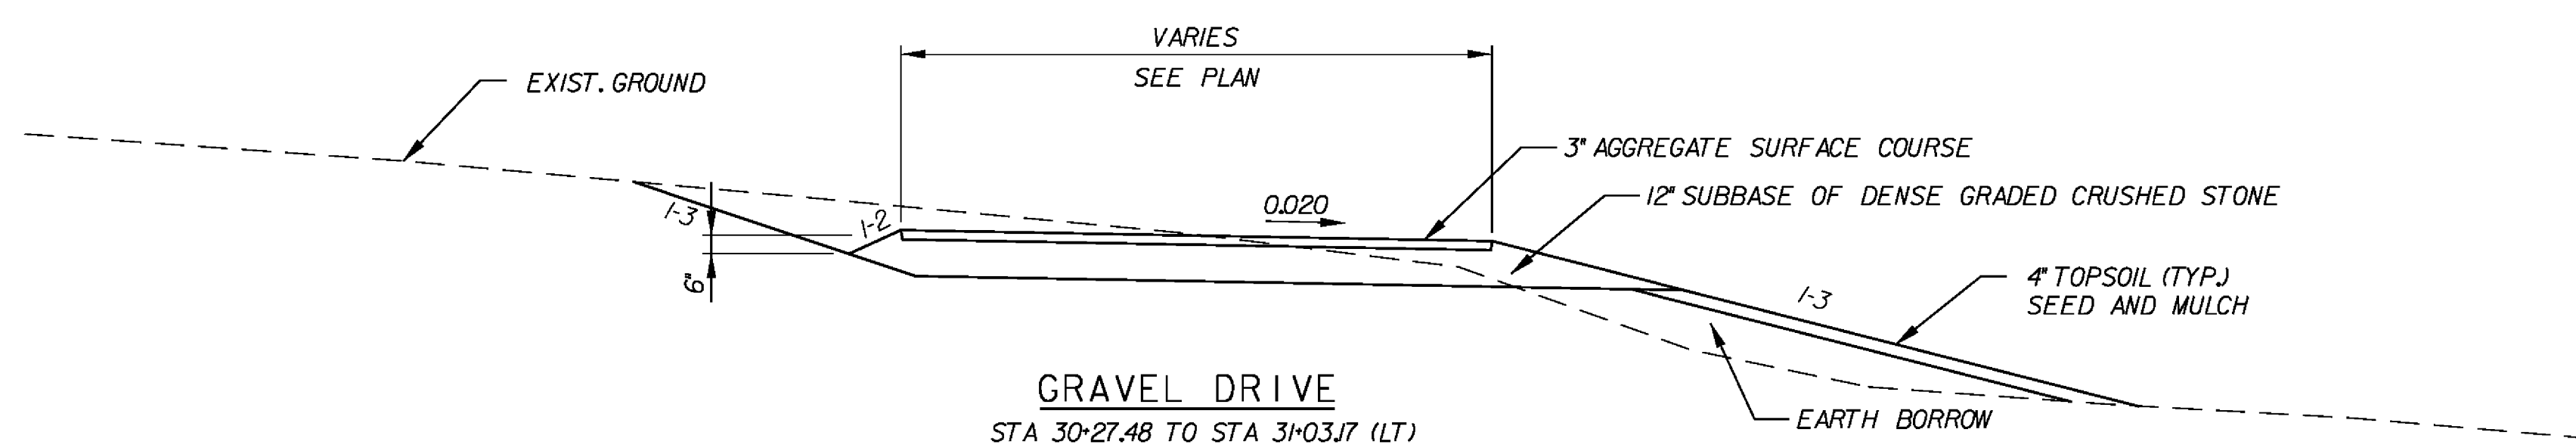

**NOTES:**

1. SAWCUT REQUIRED AREA OF EXISTING CONCRETE RAMP PRIOR TO INSTALLATION OF DETECTABLE WARNING PANEL. THE PANEL SHALL BE CAST IN PLACE.
2. PAYMENT FOR SAWCUT WILL BE INCLUDED IN ITEM 618.10 PORTLAND CEMENT CONCRETE SIDEWALK, 5 INCH.

PROJECT NAME:	ARLINGTON	PLOT DATE:	2/19/2016
PROJECT NUMBER:	STP 0114 (4)	DRAWN BY:	LB
FILE NAME:	z09g052xsl.dgn	CHECKED BY:	J. READ
PROJECT LEADER:	J. READ	SHEET	8 OF 27
DESIGNED BY:	ABR	TYPICAL SECTIONS	

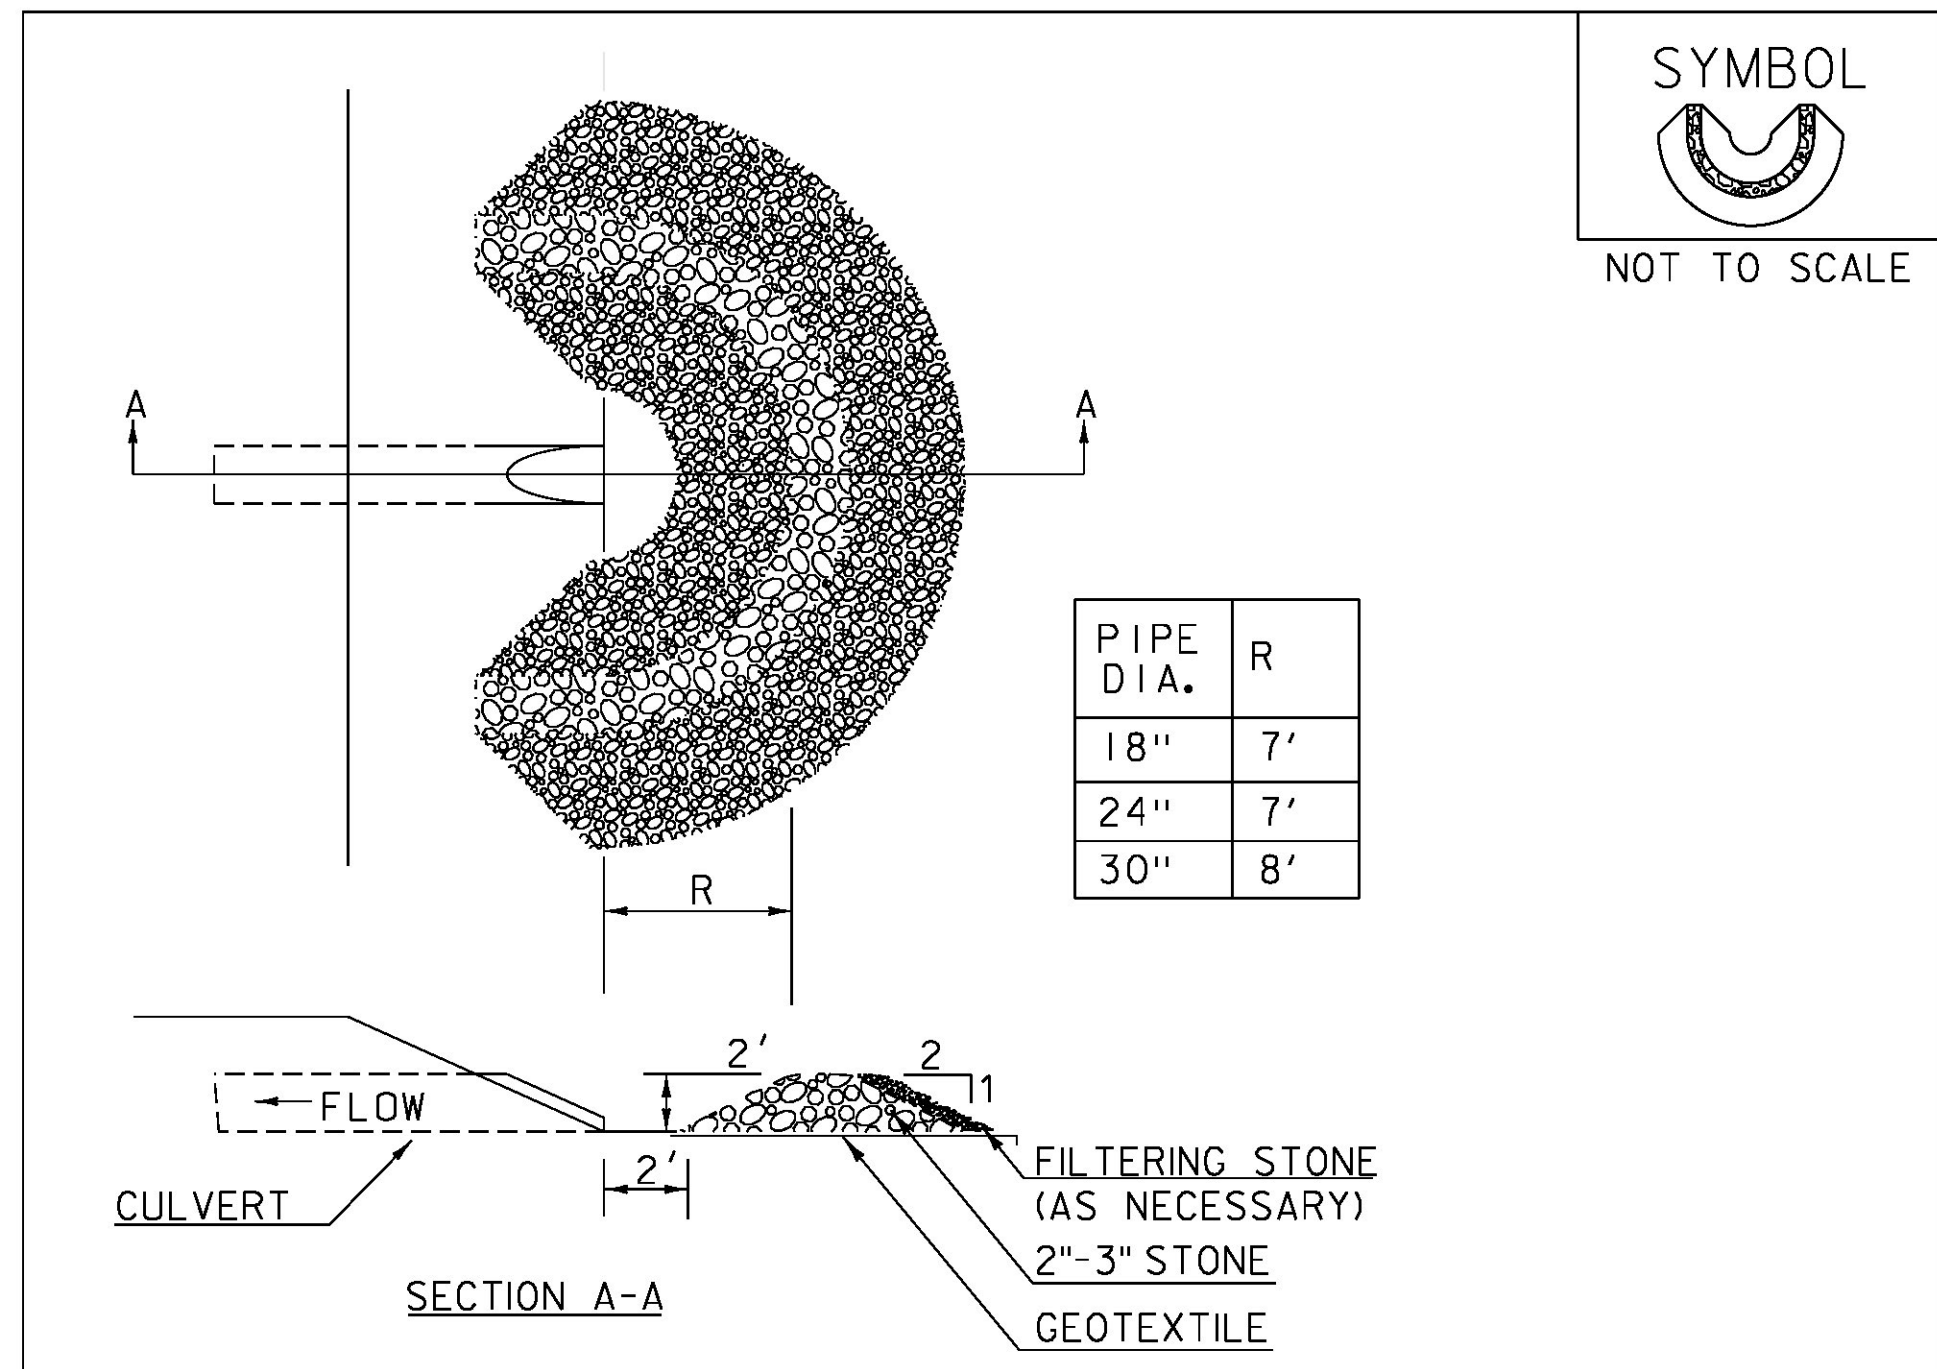

**CONSTRUCTION SPECIFICATIONS**



1. USE 2" TO 3" STONE. FILTERING STONE SHALL BE 3/4".
2. PLACE STONE OVER GEOTEXTILE.
3. ONCE THE AREAS UPSTREAM FROM THE CHECK DAM ARE STABILIZED WITH VEGETATION, THE SEDIMENT TRAPPED BEHIND THE DAM SHALL BE DISPOSED OF IN AN APPROVED WASTE AREA.
4. THE CHECK DAM(S) SHALL BE FLATTENED AND GRADED IN A MANNER WHICH PROTECTS THE AREA FROM EROSION AND CHANNEL BLOCKAGE. (GEOTEXTILE MUST BE REMOVED).
5. THE GEOTEXTILE MUST BE DISPOSED OF APPROPRIATELY.
6. THE AREA CONTRIBUTING TO THE CHECK DAM SHALL NOT EXCEED 4 ACRES.

ADAPTED FROM DETAILS PROVIDED BY: ILLINOIS USDA-NRCS  
ORIGINALLY DEVELOPED BY USDA-NRCS

**PIPE INLET PROTECTION**

THIS WORK SHALL BE PERFORMED IN ACCORDANCE WITH SECTION 653 FOR INLET PROTECTION DEVICE, TYPE I (PAY ITEM 653.40).

REVISIONS	
MARCH 6, 2008	WHF
JANUARY 13, 2009	WHF

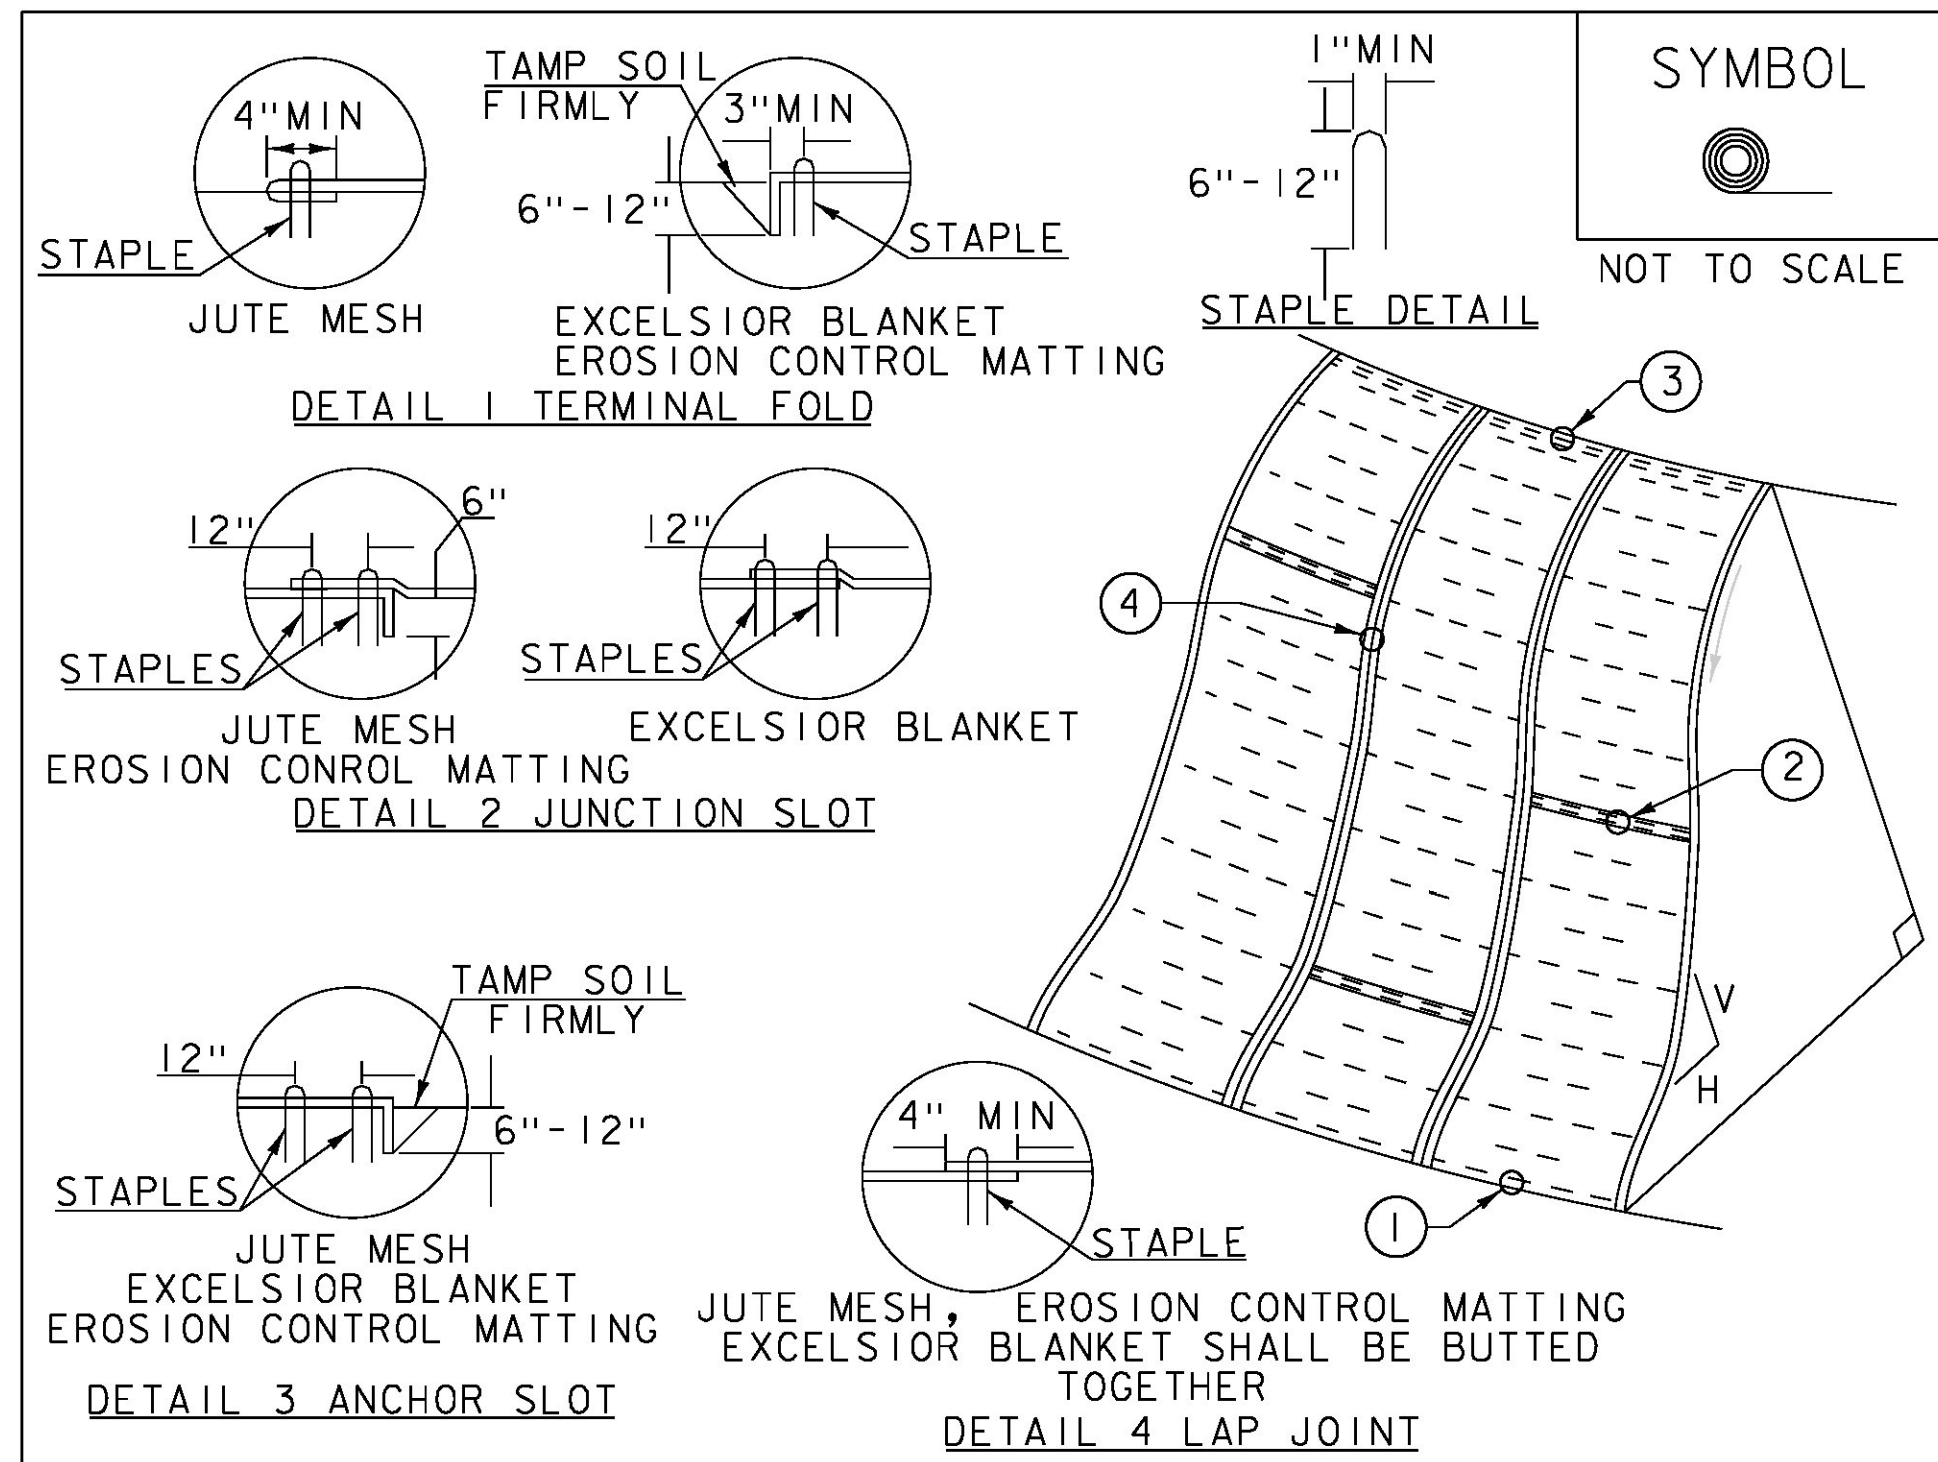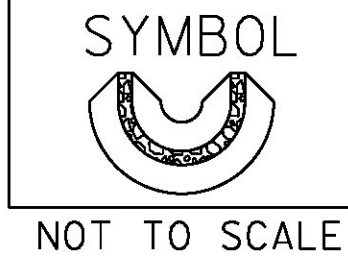

**CONSTRUCTION SPECIFICATIONS**

1. APPLY TO SLOPES GREATER THAN 3H:1V OR WHERE NECESSARY TO AID IN ESTABLISHING VEGETATION.
2. APPLY FERTILIZER, LIME SEED PRIOR TO PLACING MATTING.
3. STAPLES ARE TO BE PLACED ALTERNATELY, IN COLUMNS APPROXIMATELY 2' APART AND IN ROWS APPROXIMATELY 3' APART. APPROXIMATELY 175 STAPLES ARE REQUIRED PER 4' X 225' ROLL OF MATERIAL AND 125 STAPLES ARE REQUIRED PER 4' X 150' ROLL OF MATERIAL.
4. DISTURBED AREAS SHALL BE SMOOTHLY GRADED. EROSION CONTROL MATERIAL SHALL BE PLACED LOOSELY OVER GROUND SURFACE. DO NOT STRETCH.
5. ALL TERMINAL ENDS AND TRANSVERSE LAPS SHALL BE STAPLED AT APPROXIMATELY 12" INTERVALS.



ADAPTED FROM DETAILS PROVIDED BY: NEW YORK STATE DEC  
ORIGINALLY DEVELOPED BY USDA-NRCS  
VERMONT DEPARTMENT OF ENVIRONMENTAL CONSERVATION

**ROLLED EROSION CONTROL PRODUCT (RECP) SIDE SLOPE**

NOTES:  
REFER TO "THE VERMONT STANDARDS & SPECIFICATIONS FOR EROSION PREVENTION & SEDIMENT CONTROL -2006-" FROM THE VT AGENCY OF NATURAL RESOURCES FOR ADDITIONAL GUIDANCE.

THIS WORK SHALL BE PERFORMED IN ACCORDANCE WITH SECTION 653 AND AS SHOWN IN THE PLANS FOR TEMPORARY EROSION MATTING (PAY ITEM 653.20)

REVISIONS	
APRIL 16, 2007	JMF
JANUARY 13, 2009	WHF

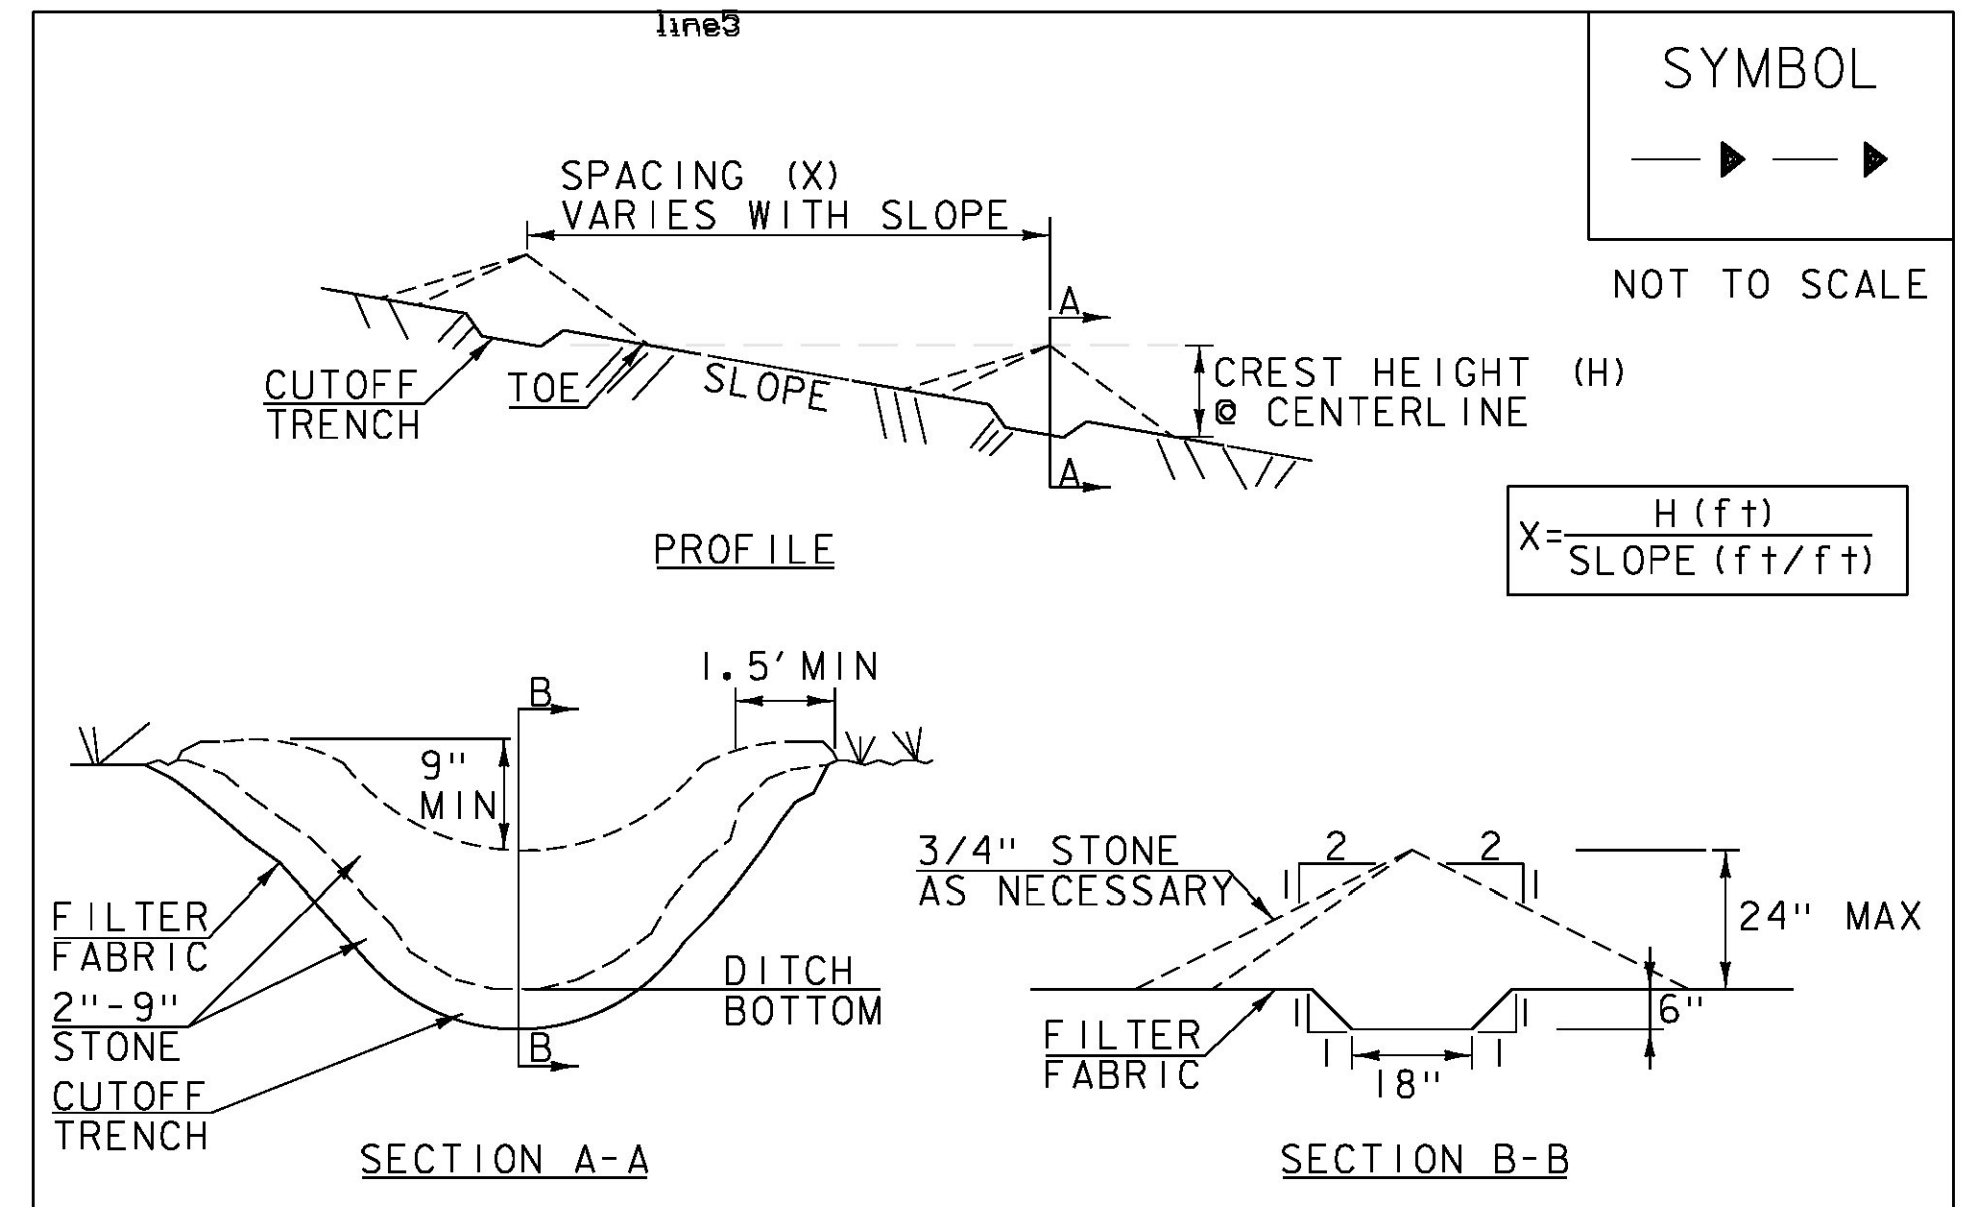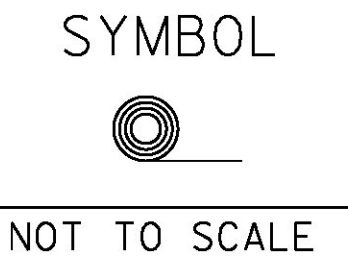

**CONSTRUCTION SPECIFICATIONS**

1. STONE WILL BE PLACED ON A FILTER FABRIC FOUNDATION.
2. CHECK DAMS SHALL BE SPACED SO THAT THE ELEVATION OF THE CREST OF THE DOWNSTREAM DAM IS AT THE SAME ELEVATION AS THE TOE OF THE UPSTREAM DAM.
3. 3/4" FILTERING STONE MAY BE ADDED TO THE FACE OF THE CHECK DAM AS NECESSARY.
4. EXTEND THE STONE A MINIMUM OF 1.5' BEYOND THE DITCH BANKS TO PREVENT CUTTING AROUND THE DAM.
5. PROTECT CHANNEL DOWNSTREAM OF THE LOWEST CHECK DAM FROM SCOUR AND EROSION WITH STONE OR LINER AS APPROPRIATE.
6. ENSURE THAT CHANNEL APPURTENANCES SUCH AS CULVERT ENTRANCES BELOW CHECK DAMS ARE NOT SUBJECT TO DAMAGE OR BLOCKAGE FROM DISPLACED STONE.
7. MAXIMUM DRAINAGE AREA 2 ACRES.

ADAPTED FROM DETAILS PROVIDED BY: NEW YORK STATE DEC  
ORIGINALLY DEVELOPED BY USDA-NRCS  
VERMONT DEPARTMENT OF ENVIRONMENTAL CONSERVATION

**CHECK DAM**


NOTES:  
REFER TO "THE VERMONT STANDARDS & SPECIFICATIONS FOR EROSION PREVENTION & SEDIMENT CONTROL -2006-" FROM THE VT AGENCY OF NATURAL RESOURCES FOR ADDITIONAL GUIDANCE.

THIS WORK SHALL BE PERFORMED IN ACCORDANCE WITH SECTION 653 FOR TEMPORARY STONE CHECK DAM, TYPE I (PAY ITEM 653.25)

REVISIONS	
MARCH 21, 2008	WHF
JANUARY 8, 2009	WHF

**NTS**

PROJECT NAME: ARLINGTON	PLOT DATE: 2/5/2016
PROJECT NUMBER: STP 0114 (4)	DRAWN BY: NSB
FILE NAME: z09g052erodef.dgn	CHECKED BY: ABR
PROJECT LEADER: J. READ	SHEET 9 OF 27
DESIGNED BY: ABR	
EPSC DETAILS SHEET - I	

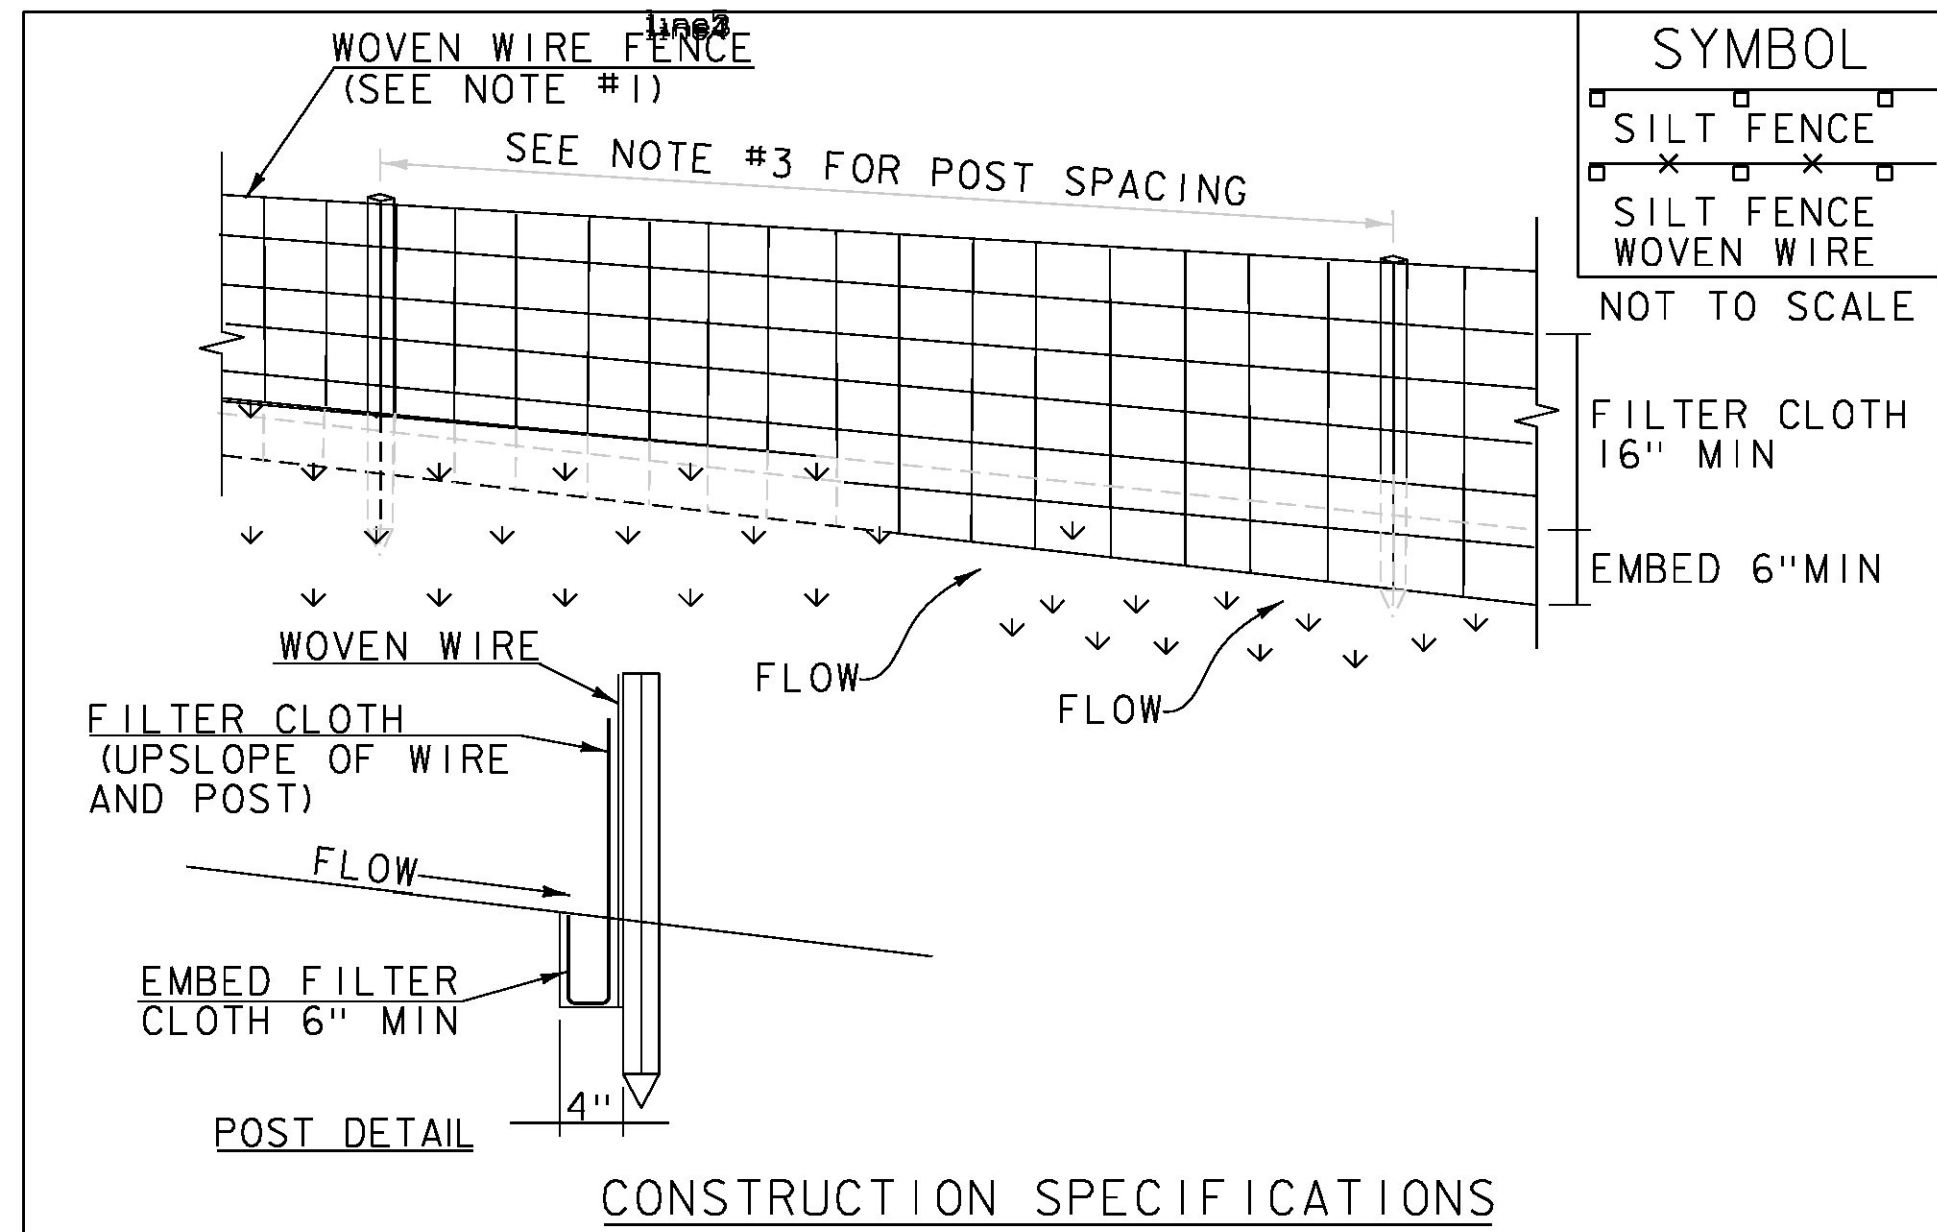

1. WOVEN WIRE REINFORCED FENCE IS REQUIRED WITHIN 100' UPSLOPE OF RECEIVING WATERS WHEN THE PROJECT FALLS UNDER A CONSTRUCTION STORMWATER PERMIT. WOVEN WIRE SHALL BE A MIN. 14 GAUGE WITH A 6" MAX. MESH OPENING.
2. FILTER CLOTH SHALL BE EITHER FILTER X, MIRAF1100X, STABILINKA T140N OR APPROVED EQUIVALENT.
3. POST SPACING FOR WIRE-BACKED FENCE SHALL BE 10' MAXIMUM. FOR FILTER-CLOTH FENCE, WHEN ELONGATION IS >50%, POST SPACING SHALL NOT EXCEED 4' AND WHEN ELONGATION IS <50%, POST SPACING SHALL NOT EXCEED 6'.
4. WOVEN WIRE FENCE IS TO BE FASTENED SECURELY TO FENCE POSTS WITH WIRE TIES. FILTER CLOTH IS TO BE FASTENED SECURELY TO WOVEN WIRE FENCE WITH TIES SPACED EVERY 24" AT TOP AND MID SECTION.
5. WHEN TWO SECTIONS OF FILTER CLOTH ADJOIN EACH OTHER THEY SHALL BE OVER-LAPPED BY 6" AND FOLDED.
6. MAINTENANCE SHALL BE PERFORMED AS NEEDED AND MATERIAL REMOVED WHEN SEDIMENT REACHES HALF OF FABRIC HEIGHT.

ADAPTED FROM DETAILS PROVIDED BY: NEW YORK STATE DEC  
ORIGINALLY DEVELOPED BY USDA-NRCS  
VERMONT DEPARTMENT OF ENVIRONMENTAL CONSERVATION

**SILT FENCE**

**NOTES:**  
REFER TO "THE VERMONT STANDARDS & SPECIFICATIONS FOR EROSION PREVENTION & SEDIMENT CONTROL -2006-" FROM THE VT AGENCY OF NATURAL RESOURCES FOR ADDITIONAL GUIDANCE.

REVISIONS	
MARCH 21, 2008	WHF
DECEMBER 11, 2008	WHF
JANUARY 13, 2009	WHF

THIS WORK SHALL BE PERFORMED IN ACCORDANCE WITH SECTION 649 AND AS SHOWN IN THE PLANS FOR GEOTEXTILE FOR SILT FENCE, WOVEN WIRE REINFORCED (PAY ITEM 649.515).

**VAOT RURAL AREA MIX**

% WEIGHT	LBS/AC		NAME	GERM %	PURITY %
	BROADCAST	HYDROSEED			
37.5 %	22.5	45	CREeping RED FESCUE	85 %	98 %
37.5 %	22.5	45	TALL FESCUE	90 %	95 %
5.0 %	3	6	RED TOP	90 %	95 %
15.0 %	9	18	BIRDSFOOT TREFOIL	85 %	98 %
5.0 %	3	6	ANNUAL RYE GRASS	85 %	95 %
100 %	60	120			

**VAOT URBAN AREA MIX**

% WEIGHT	LBS/AC		NAME	GERM %	PURITY %
	BROADCAST	HYDROSEED			
42.5 %	34	68	CREeping RED FESCUE	85 %	98 %
10.0 %	8	16	PERENNIAL RYE GRASS	90 %	95 %
42.5 %	34	68	KENTUCKY BLUE GRASS	85 %	85 %
5.0 %	4	8	ANNUAL RYE GRASS	85 %	95 %
100 %	80	160			


**GENERAL GUIDANCE**

FERTILIZER		LIME	
BROADCAST	HYDROSEED	BROADCAST	HYDROSEED
10/20/10	19-19-19	PELLETIZED	LIQUID
500LBS/AC		2 TONS/AC	4.4 GAL/AC

- CONSTRUCTION GUIDANCE**
1. RURAL SEED MIX: USE AS INDICATED IN THE PLANS AND/OR FOR ALL ESTABLISHED UPLAND (NON WETLAND) AREAS DISTURBED BY THE CONTRACTOR.
  2. URBAN SEED MIX: USE AS INDICATED IN THE PLANS AND/OR FOR ALL ESTABLISHED LAWN AREAS DISTURBED BY THE CONTRACTOR.
  3. ALL SEED MIXTURES: SHALL NOT HAVE A WEED CONTENT EXCEEDING 0.40% BY WEIGHT AND SHALL BE FREE OF ALL NOXIOUS SEED.
  4. FERTILIZER AND LIMESTONE: SHALL FOLLOW RATES SHOWN ON PLAN OR AS DIRECTED BY THE ENGINEER
  5. HAY MULCH: TO BE PLACED ON EARTH SLOPES AT THE RATE OF 2 TONS/ACRE, ACHIEVE 90% GROUND COVER OR AS DIRECTED BY THE ENGINEER.
  6. TOPSOIL: TO BE USED WITH SEED AS INDICATED ON THE PLANS, OR AS DIRECTED BY THE ENGINEER.
  7. HYDROSEEDING: ALTHOUGH GUIDANCE IS GIVEN ABOVE THE SITE CONDITIONS AND THE TYPE OF HYDROSEED WILL ULTIMATELY DICTATE THE AMOUNTS AND TYPES OF SOIL AMENDMENTS TO BE APPLIED
  8. TURF ESTABLISHMENT: PLACING SEED, FERTILIZER, LIME AND MULCH PRIOR TO SEPTEMBER 15 AND AFTER APRIL 15 CAN BETTER ENSURE A VIGOROUS GROWTH OF GRASS.

**SEED**

THIS WORK SHALL BE PERFORMED IN ACCORDANCE WITH SECTION 651 FOR SEED (PAY ITEM 651.15)

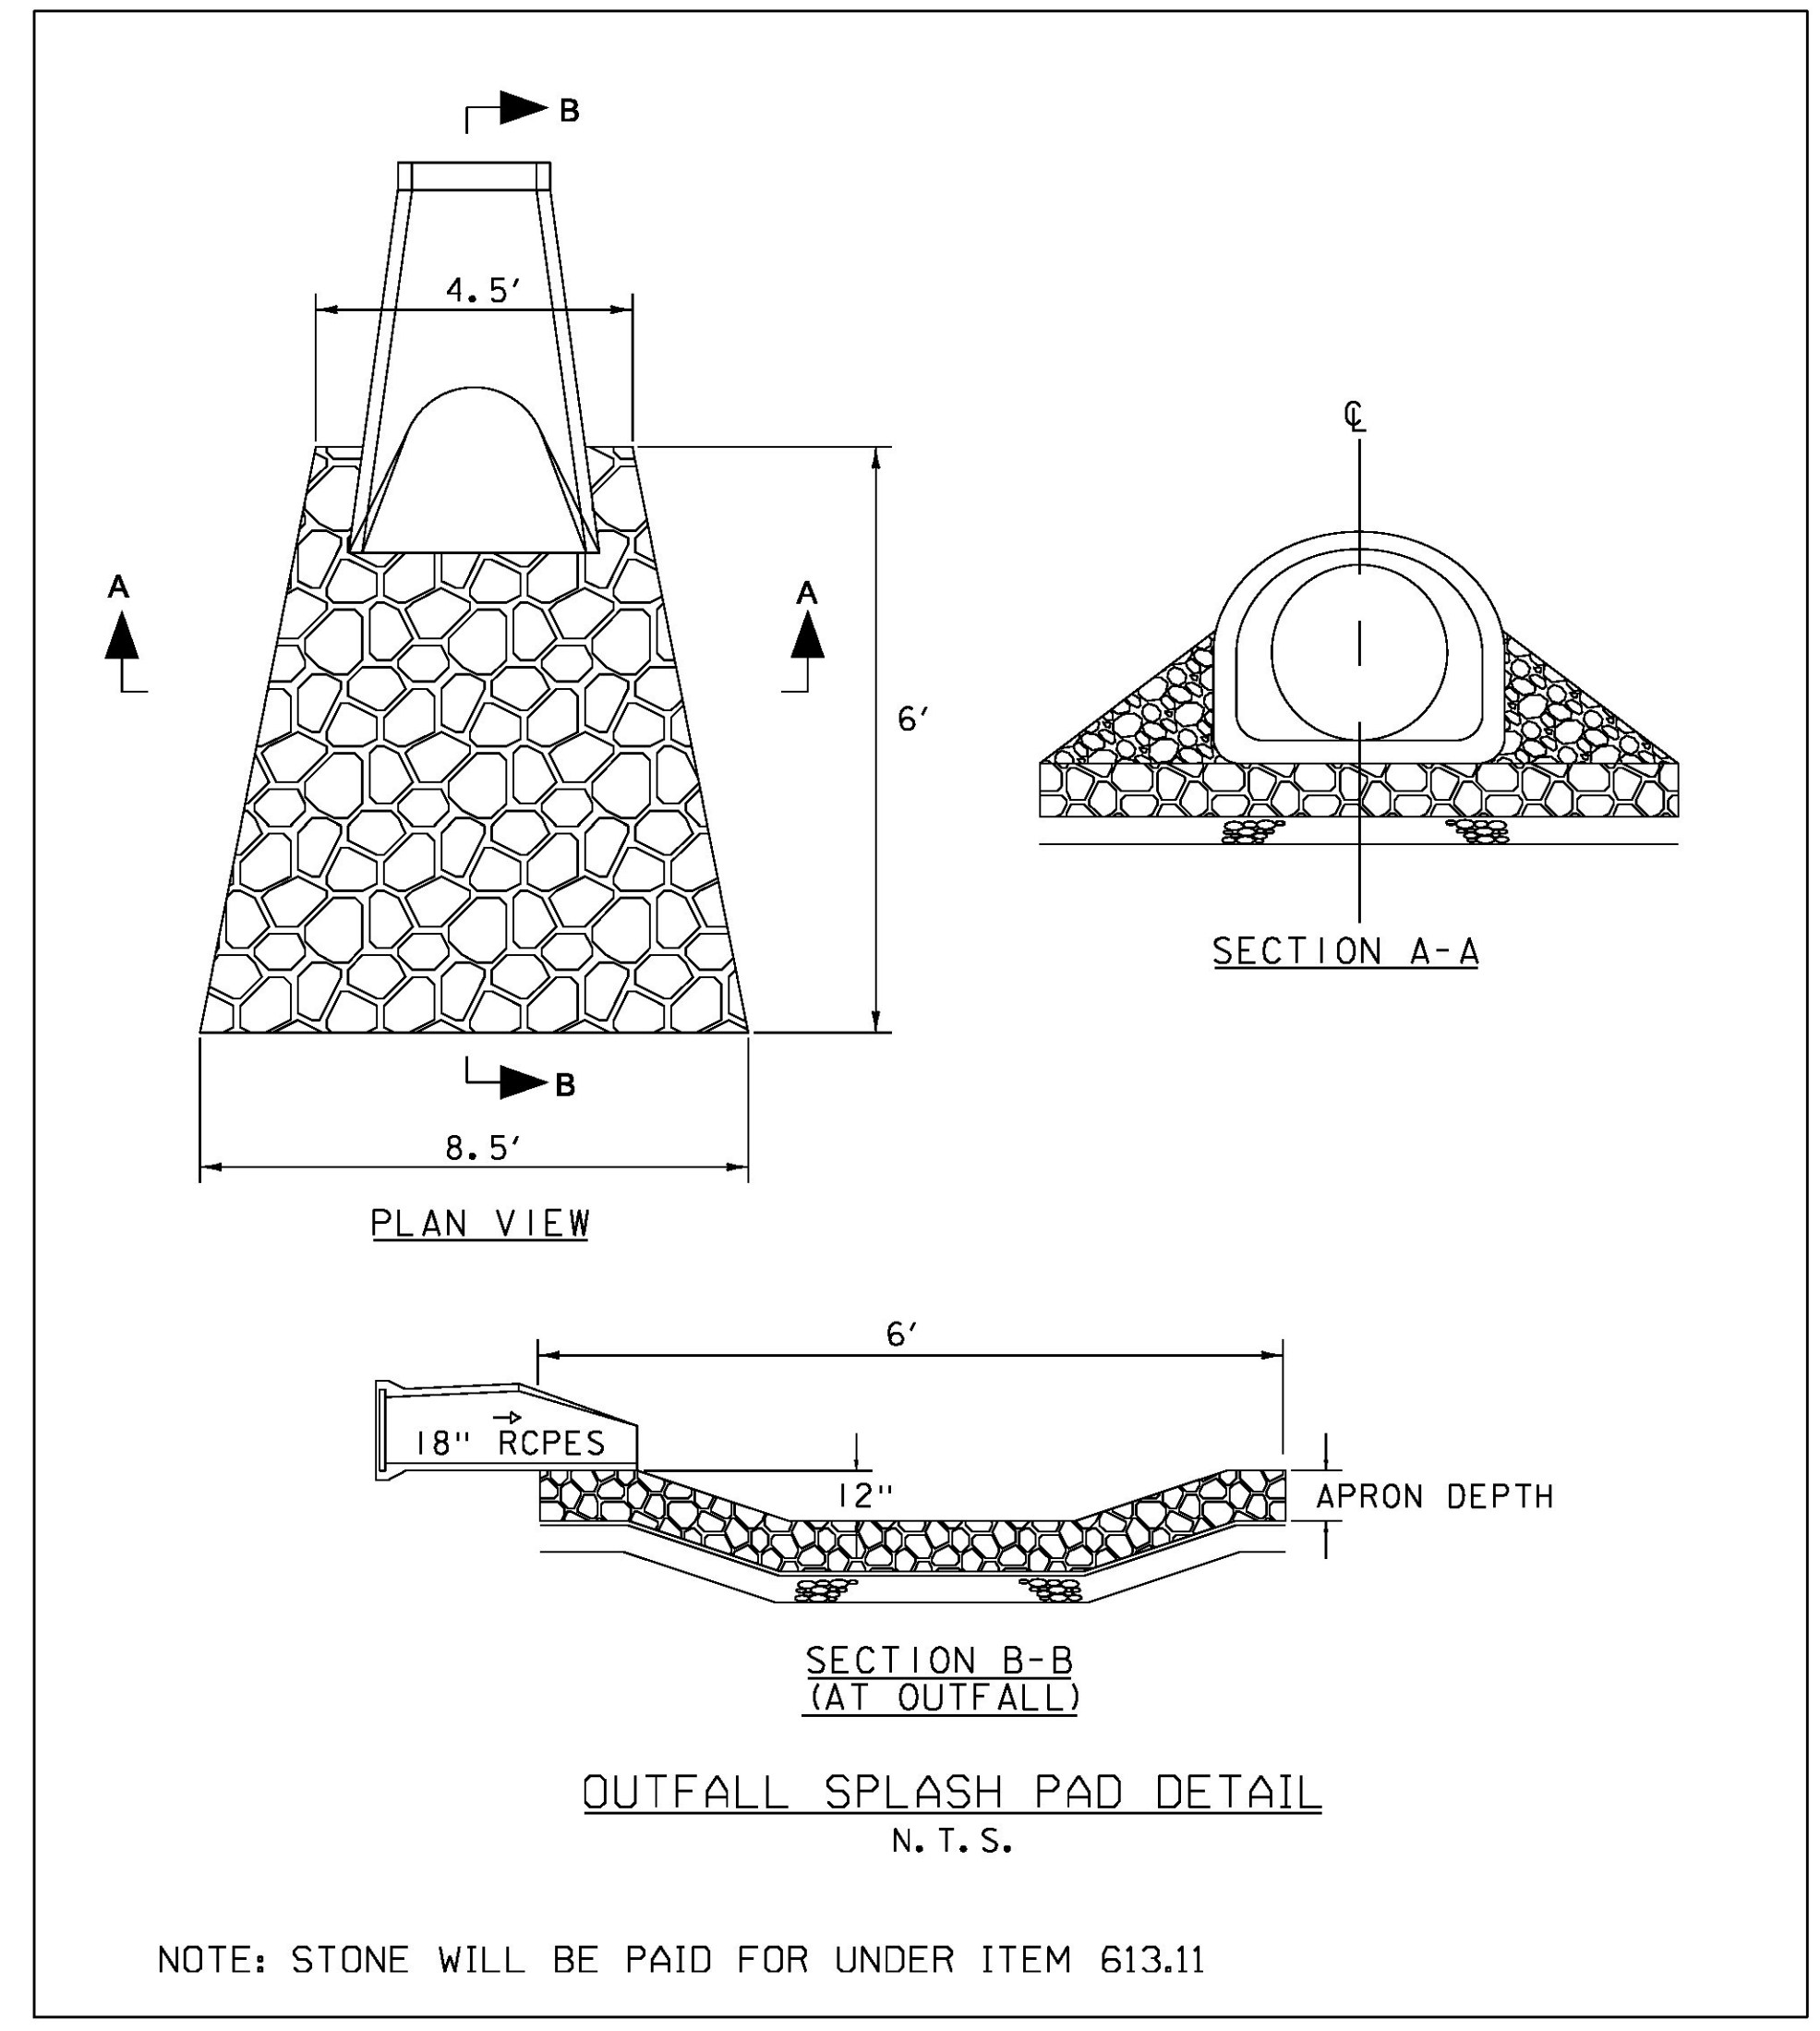

**NTS**

PROJECT NAME: ARLINGTON	PLOT DATE: 2/5/2016
PROJECT NUMBER: STP 0114 (4)	DRAWN BY: NSB
FILE NAME: z09g052erode1.dgn	CHECKED BY: ABR
PROJECT LEADER: J. READ	SHEET 10 OF 27
DESIGNED BY: ABR	
EPSC DETAILS SHEET - 2	

GPS CONTROL POINTS

## HVCTRL # 1

STANDARD DISK STAMPED  
 CHEESE 1998  
 N = 215703.2858  
 E = 1469176.0870  
 ELEV. = 635.82

GENERAL LOCATION ARLINGTON, VT. TO REACH FROM THE INTERSECTION OF VT. ROUTES 313 AND 7A IN ARLINGTON GO NORTH ALONG VT ROUTE 7A OR 1.2MI (1.9 KM) TO THE MARK ON THE RIGHT OPPOSITE THE CHEESE HOUSE. THE MARK IS SET FLUSH WITH THE GROUND SURFACE IN THE TOP OF A 30 CM DIAMETER CONCRETE MONUMENT SET 1.3 M (4.3 FT) DEEP. IT IS 2.0 M (6.6 FT) EAST OF AND ABOUT LEVEL WITH EAST EDGE OF PAVEMENT OF VT ROUTE 7A, 20.0 M (65.6 FT) WEST OF WEST RAIL OF VERMONT RAILROAD TRACK, 13.3 M (43.6 FT) SOUTH OF TRAFFIC SIGN WITH MILE MARKER 0071/0201/0521, AND 5.4 M (17.7 FT) NORTH OF POLE NO.3/54/53 AND FIBERGLASS WITNESS POST.




## HVCTRL # 2

STANDARD DISK STAMPED  
 CHEESE AZ  
 N = 213614.6778  
 E = 1468337.8900  
 ELEV. = 653.33

GENERAL LOCATION ARLINGTON, VT. TO REACH FROM THE INTERSECTION OF VT. ROUTES 313 AND 7A IN ARLINGTON GO NORTH ALONG VT. ROUTE 7A FOR 0.8 MI (1.3 KM) TO THE NORTH END OF THE BRIDGE OVER THE WARM BROOK AND THE MARK ON THE RIGHT. THE MARK IS SET IN THE ABUTMENT ON THE NORTHEAST CORNER OF THE BRIDGE IT IS 5.3 M (17.4 FT) EAST OF AND ABOUT 0.3 M (1.0 FT) HIGHER THAN THE CENTERLINE OF VT. ROUTE 7A, 23.8 M (78.1 FT) SOUTH OF THE CENTERLINE OF LAVER ROAD, 0.1 M (0.3 FT) WEST OF THE EAST FACE OF THE ABUTMENT, AND 7.7 M (25.3 FT) WEST OF POLE NO.38/38 AND A FIBERGLASS WITNESS POST.

• DESCRIPTION PROVIDED BY VERMONT AGENCY OF TRANSPORTATION GEODETIC SURVEY UNIT

TRAVERSE TIES

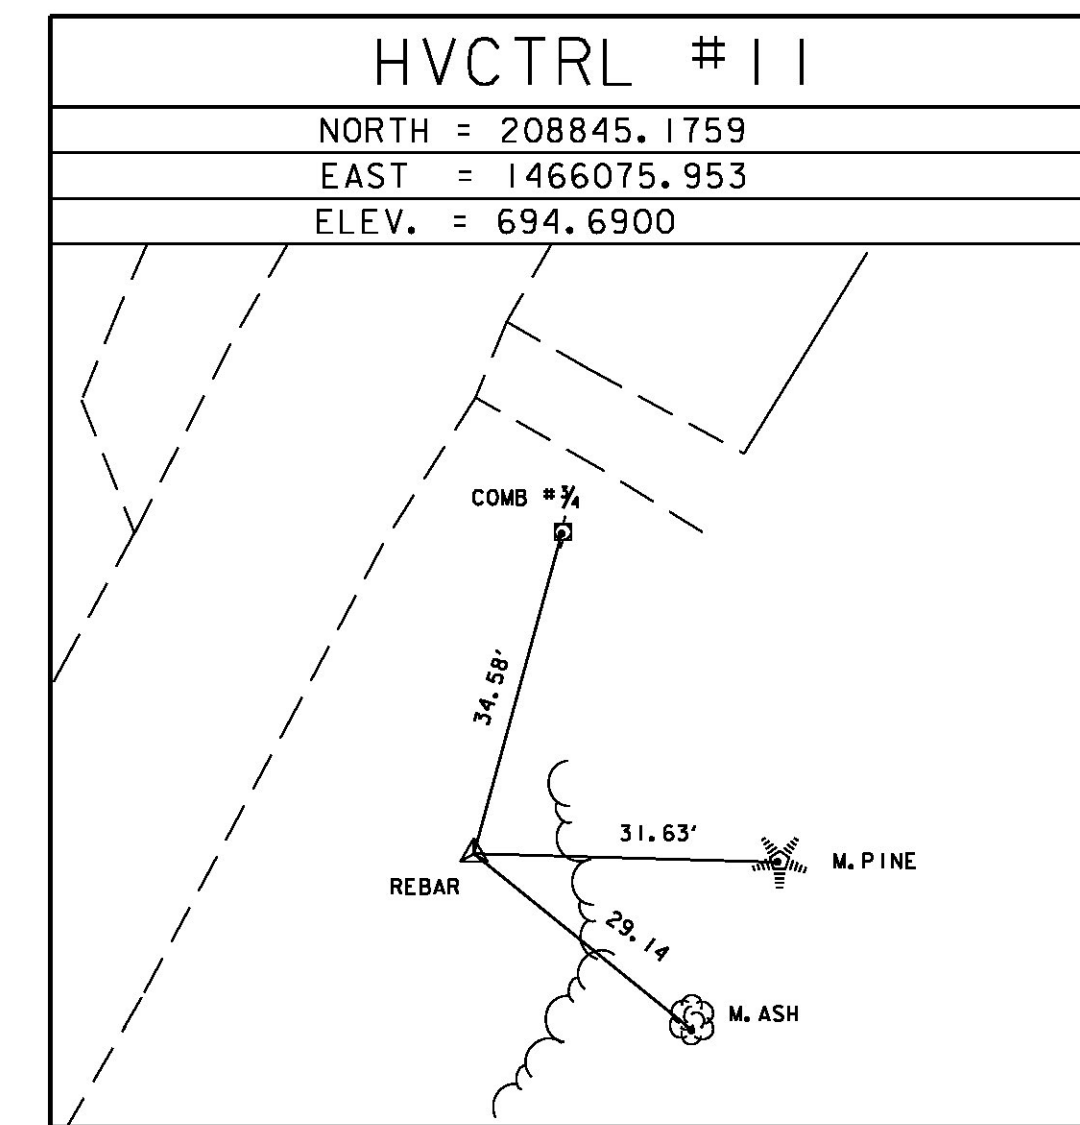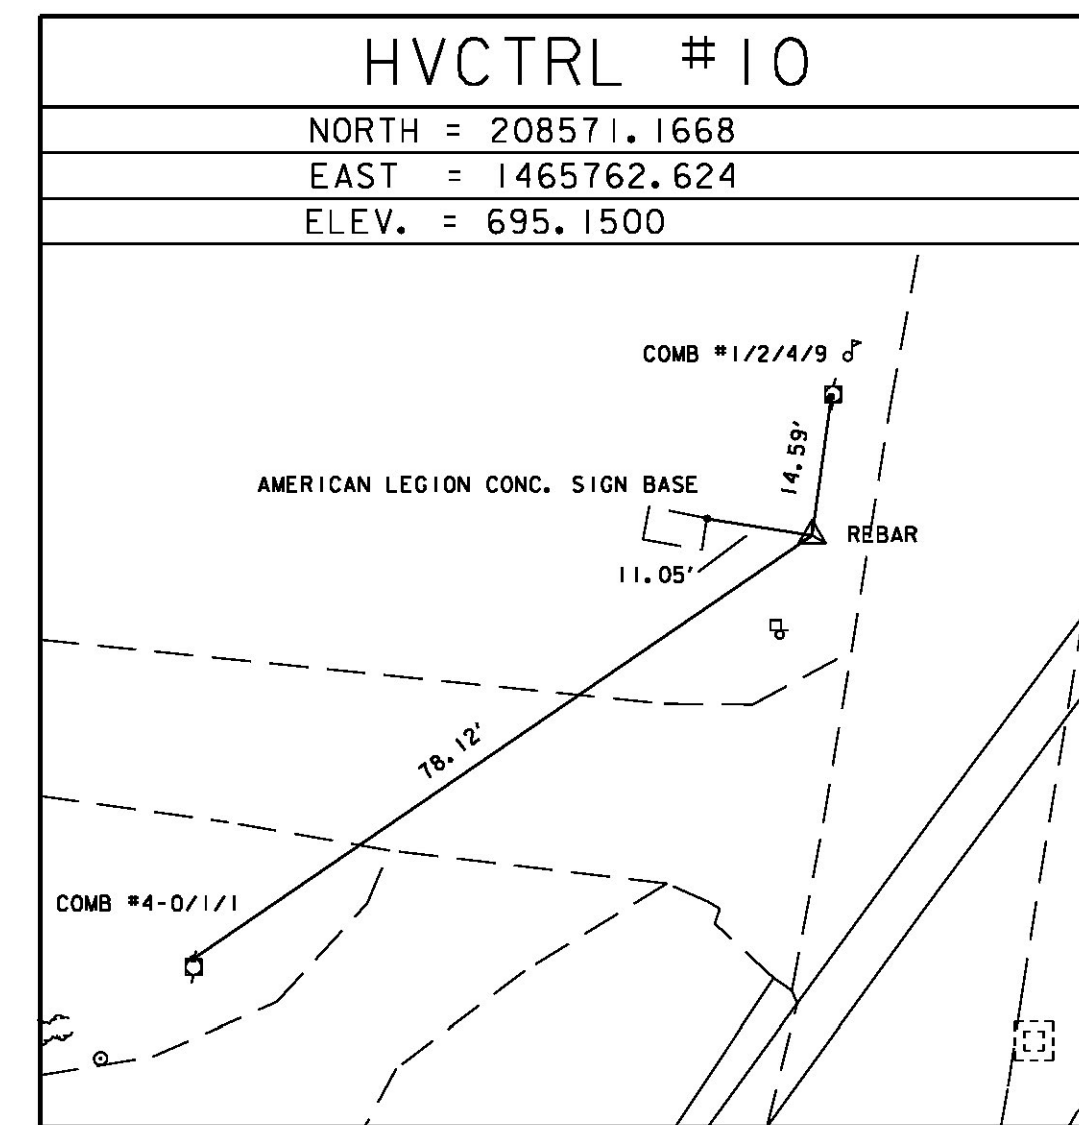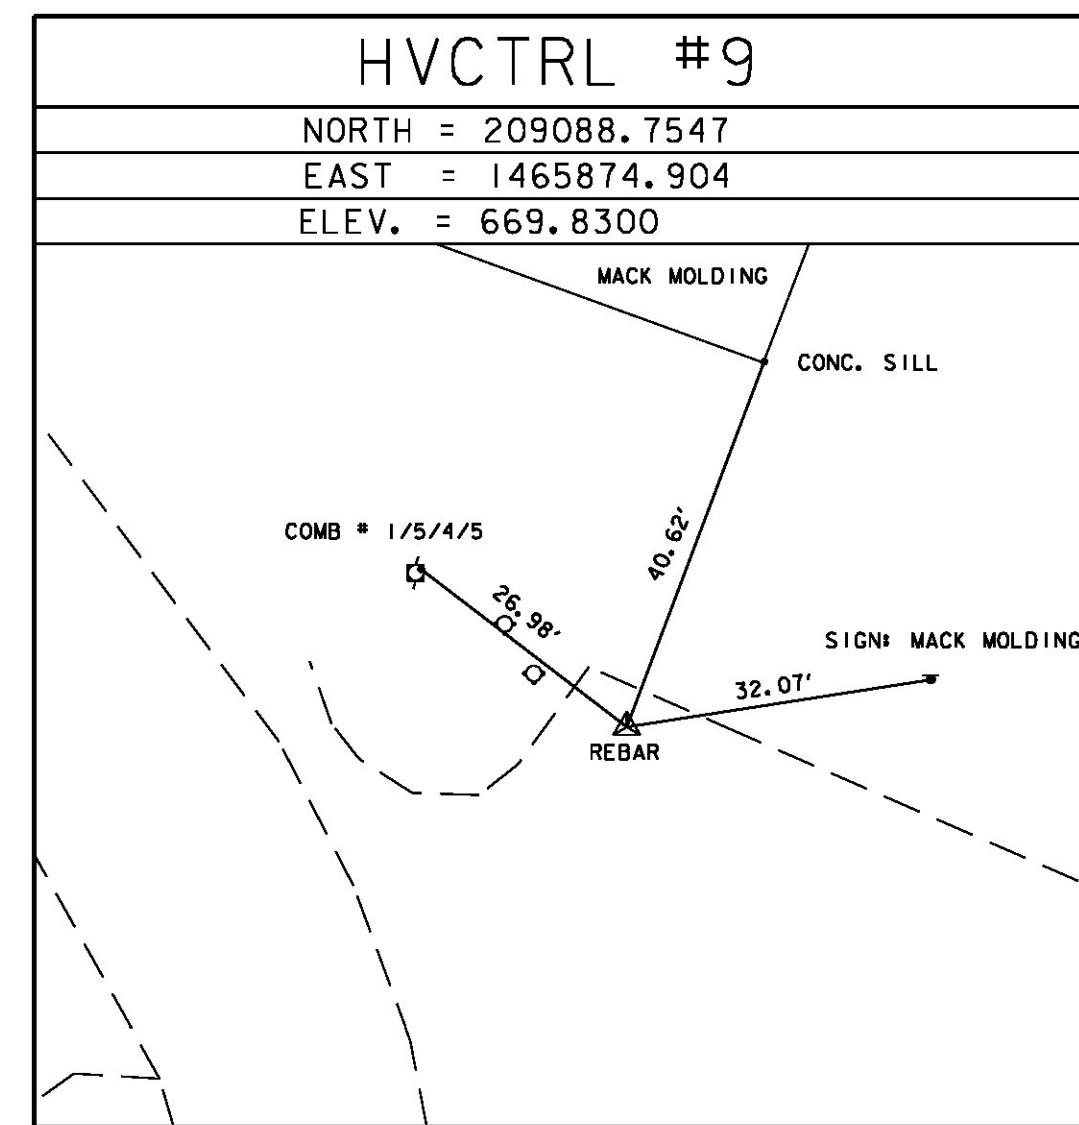

NORTH =
EAST =
ELEV. =

NORTH =
EAST =
ELEV. =

• MAIN TRAVERSE COMPLETED 02/28/04 by L. Orvis & C. HARDING

ALIGNMENT TIES

NORTH =
EAST =

NORTH =
EAST =

**DATUM**  
 VERTICAL NAVD 88  
 HORIZONTAL NAD 83 (96)  
 ADJUSTMENT COMPASS

PROJECT NAME: ARLINGTON  
 PROJECT NUMBER: STP 0114 (4)

FILE NAME: x01g066+1e.dgn	PLOT DATE: 2/5/2016
PROJECT LEADER: D. BUA	DRAWN BY: J. HULETT
DESIGNED BY:	CHECKED BY: P. HODGE
TIE SHEET	SHEET 11 OF 27

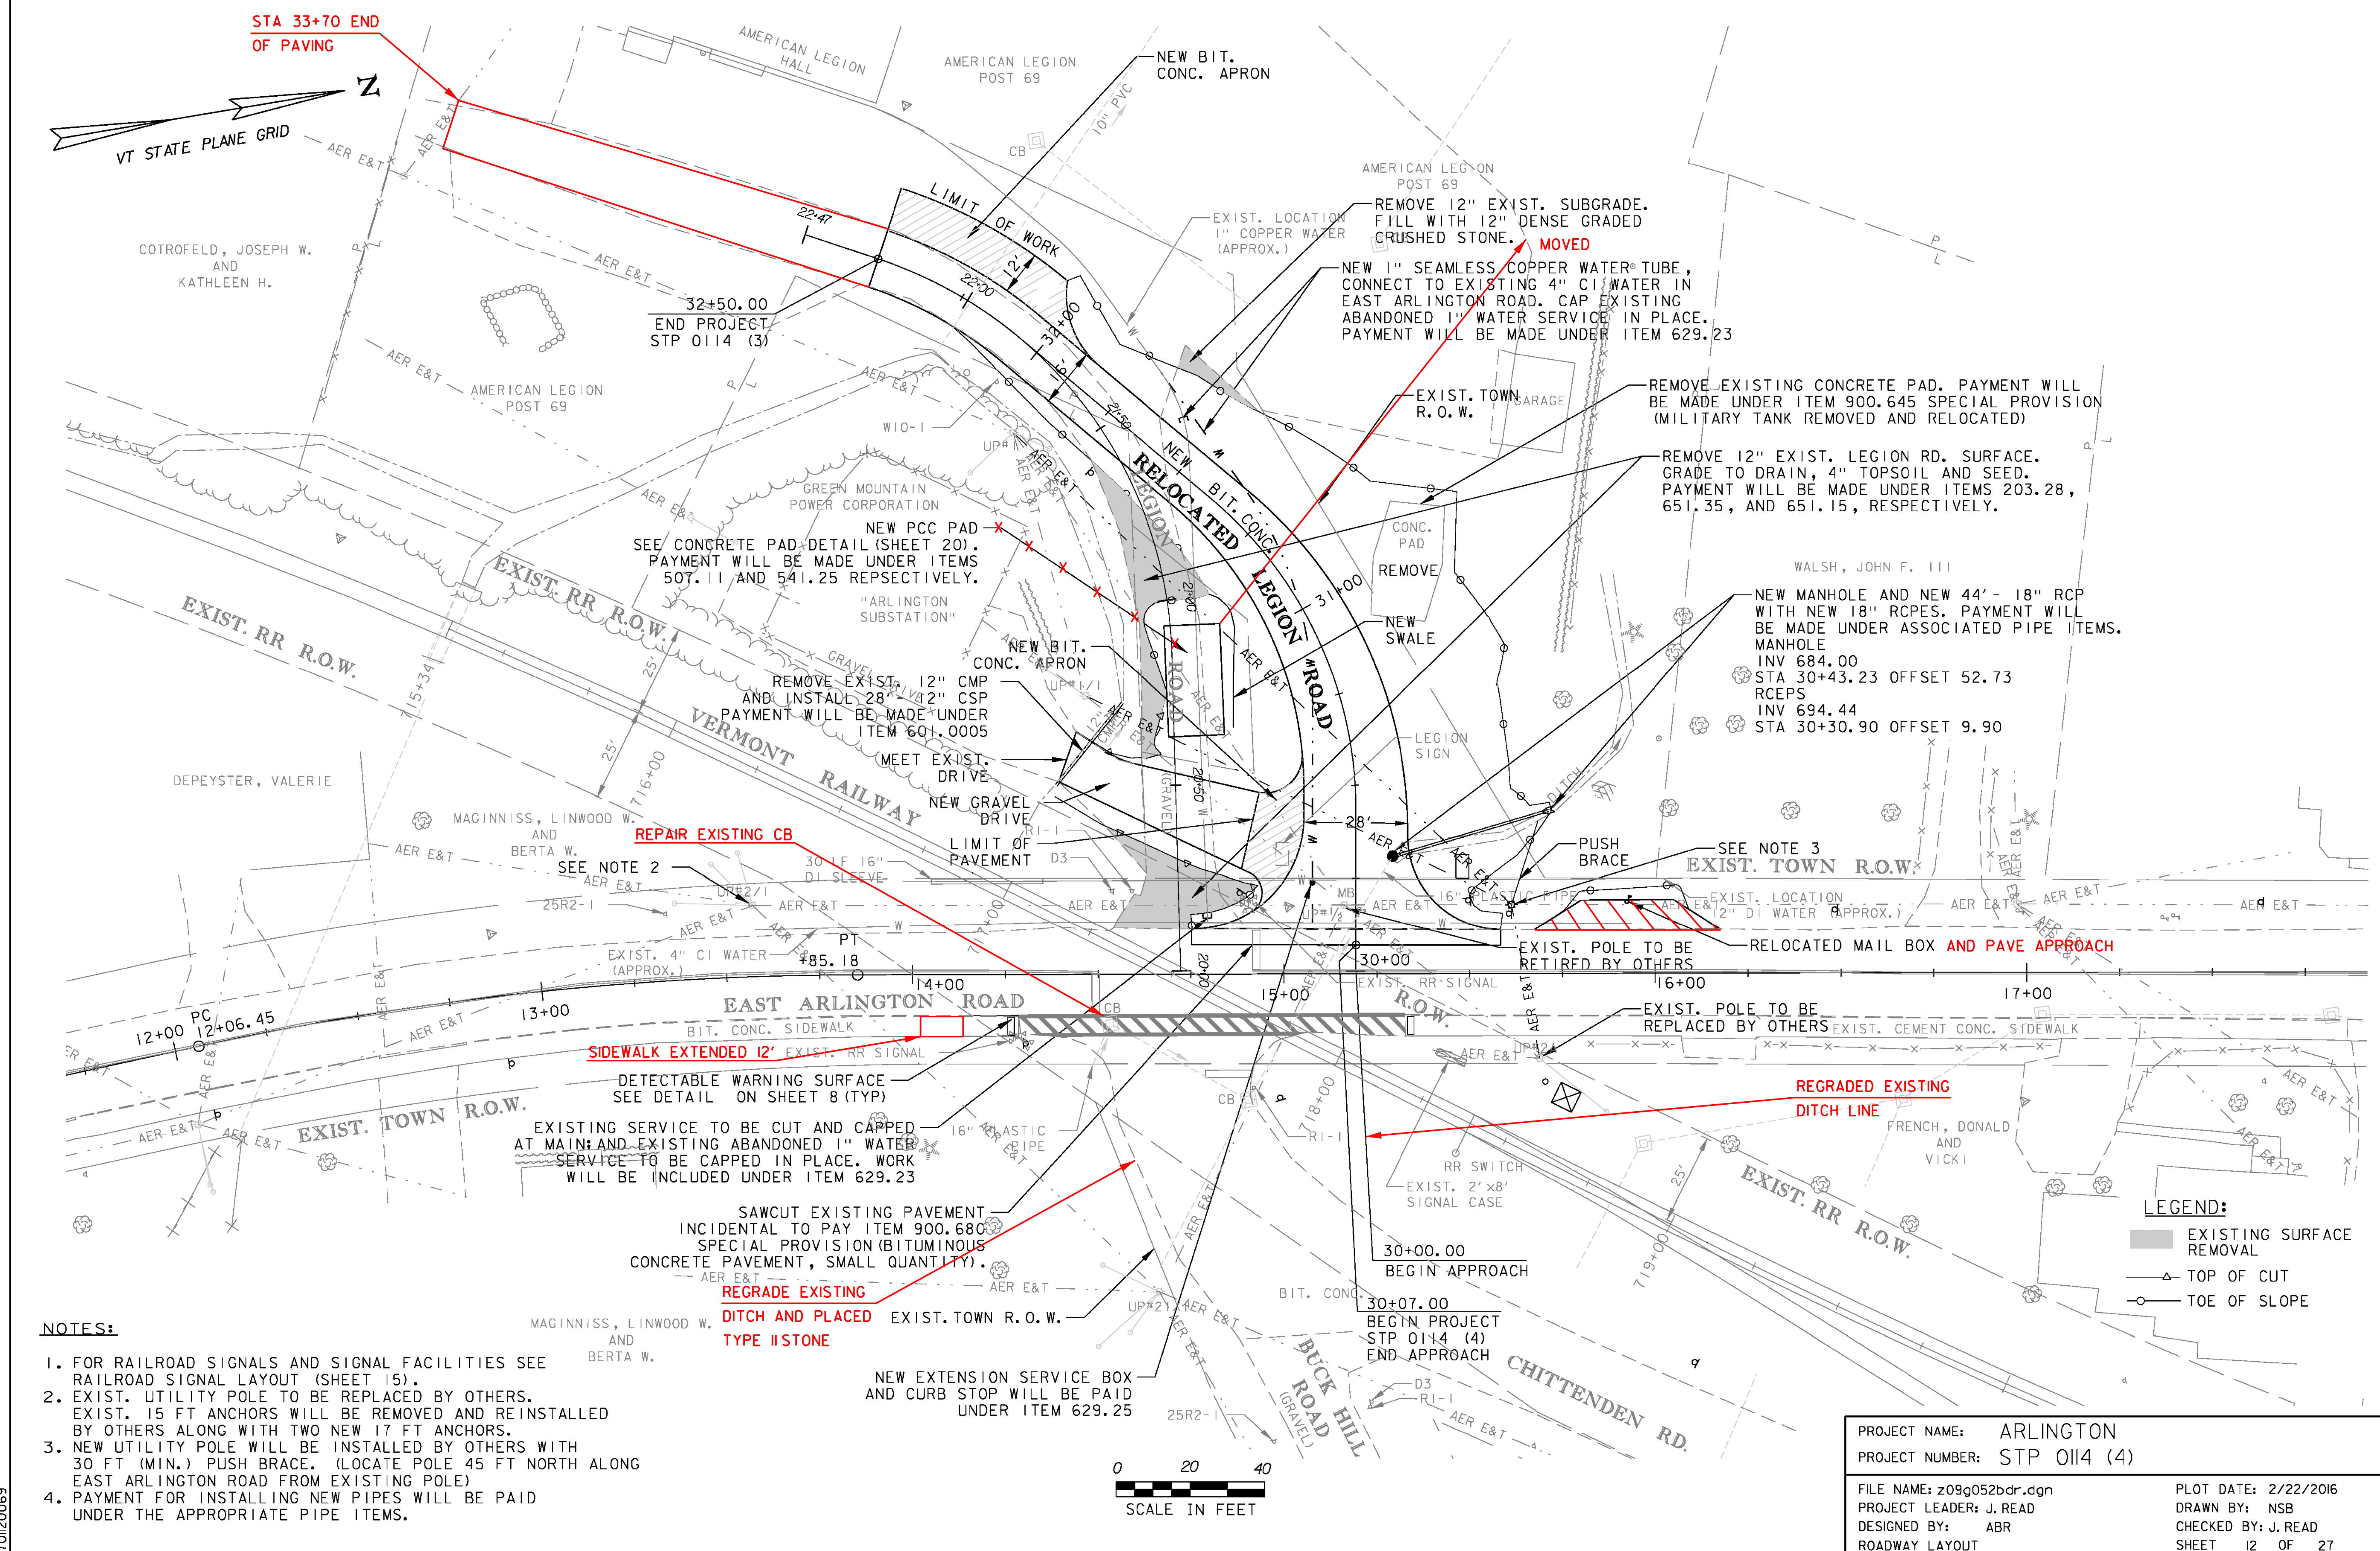

**NOTES:**


1. FOR RAILROAD SIGNALS AND SIGNAL FACILITIES SEE RAILROAD SIGNAL LAYOUT (SHEET 15).
2. EXIST. UTILITY POLE TO BE REPLACED BY OTHERS. EXIST. 15 FT ANCHORS WILL BE REMOVED AND REINSTALLED BY OTHERS ALONG WITH TWO NEW 17 FT ANCHORS.
3. NEW UTILITY POLE WILL BE INSTALLED BY OTHERS WITH 30 FT (MIN.) PUSH BRACE. (LOCATE POLE 45 FT NORTH ALONG EAST ARLINGTON ROAD FROM EXISTING POLE)
4. PAYMENT FOR INSTALLING NEW PIPES WILL BE PAID UNDER THE APPROPRIATE PIPE ITEMS.

EXISTING SERVICE TO BE CUT AND CAPPED AT MAIN AND EXISTING ABANDONED 1" WATER SERVICE TO BE CAPPED IN PLACE. WORK WILL BE INCLUDED UNDER ITEM 629.23

SAWCUT EXISTING PAVEMENT INCIDENTAL TO PAY ITEM 900.680 SPECIAL PROVISION (BITUMINOUS CONCRETE PAVEMENT, SMALL QUANTITY).

**REGRADE EXISTING DITCH AND PLACED TYPE II STONE**

NEW EXTENSION SERVICE BOX AND CURB STOP WILL BE PAID UNDER ITEM 629.25

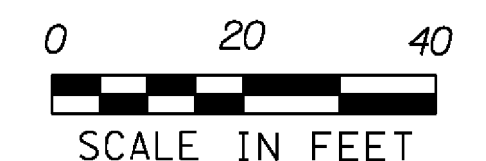

**LEGEND:**

	EXISTING SURFACE REMOVAL
	TOP OF CUT
	TOE OF SLOPE

PROJECT NAME:	ARLINGTON	PLOT DATE:	2/22/2016
PROJECT NUMBER:	STP 0114 (4)	DRAWN BY:	NSB
FILE NAME:	z09g052bdr.dgn	CHECKED BY:	J. READ
DESIGNED BY:	ABR	SHEET	12 OF 27
ROADWAY LAYOUT			

P701020069

LEGION ROAD ALIGNMENT DATA


PNTS	STATION	CURVE DATA	NORTHING	EASTING
POB	30+00.00		208586.15	1465782.75
TANGENT		N 80°28'09.86" W L = 43.27'		
PC	30+43.27	Δ = 50°-01'-58.77" LT	208593.32	1465740.08
PI	30+94.60	R = 110.00' T = 51.33'	208601.82	1465689.46
PT	31+39.32	L = 96.06' E = 11.39'	208568.48	1465650.43
TANGENT		S 49°29'51.37" W L = 66.81'		
PC	32+06.13	Δ = 21°-34'-08.76" LT	208525.09	1465599.63
PI	32+28.04	R = 115.00' T = 21.91'	208510.86	1465582.97
PT	32+49.43	L = 43.29' E = 2.07'	208491.51	1465572.71
TANGENT		S 27°55'42.61" W L = 21.27'		
POE	32+70.70		208472.65	1465562.71

PROJECT LIMITS


	STATION	NORTHING	EASTING
BEGIN PROJECT	30+07.00	208588.02	1465771.62
END PROJECT	32+50.00	208491.00	1465572.44

EDGE OF PAVEMENT LAYOUT DATA

PAVEMENT LEFT EDGE					PAVEMENT RIGHT EDGE				
PNTS	STATION	OFFSET	NORTHING	EASTING	PNTS	STATION	OFFSET	NORTHING	EASTING
PC	30+11.37	44.00' LT	208544.65	1465764.25	PC	30+11.21	39.04' RT	208626.52	1465778.16
	30+25.00	18.86' LT	208571.69	1465754.98		30+25.00	16.69' RT	208606.76	1465760.86
PT	30+41.37	14.00' LT	208579.20	1465739.63	PRC	30+36.46	14.00' RT	208606.00	1465749.11
PC	30+50.09	13.82' LT	208580.50	1465731.89		30+50.00	13.47' RT	208607.62	1465734.83
	30+75.00	12.37' LT	208581.74	1465709.98		30+75.00	11.94' RT	208605.87	1465707.01
	31+00.00	10.80' LT	208578.05	1465687.91		31+00.00	10.32' RT	208597.89	1465680.68
	31+25.00	9.17' LT	208569.36	1465666.89		31+25.00	8.70' RT	208584.34	1465657.15
PT	31+46.21	8.00' LT	208557.92	1465650.39	PT	31+32.89	8.20' RT	208579.05	1465650.48
	31+50.00	8.00' LT	208555.46	1465647.51		31+50.00	8.00' RT	208567.63	1465637.11
	31+75.00	8.00' LT	208539.22	1465628.49		31+75.00	8.00' RT	208551.39	1465618.10
	32+00.00	8.00' LT	208522.99	1465609.48		32+00.00	8.00' RT	208535.16	1465599.09
PC	32+06.12	8.00' LT	208519.01	1465604.83	PC	32+06.12	8.00' RT	208531.18	1465594.44
	32+25.00	8.00' LT	208506.56	1465592.46		32+25.00	8.00' RT	208516.87	1465580.23
PT	32+50.00	8.00' LT	208487.25	1465579.51	PT	32+50.00	8.00' RT	208494.75	1465565.37

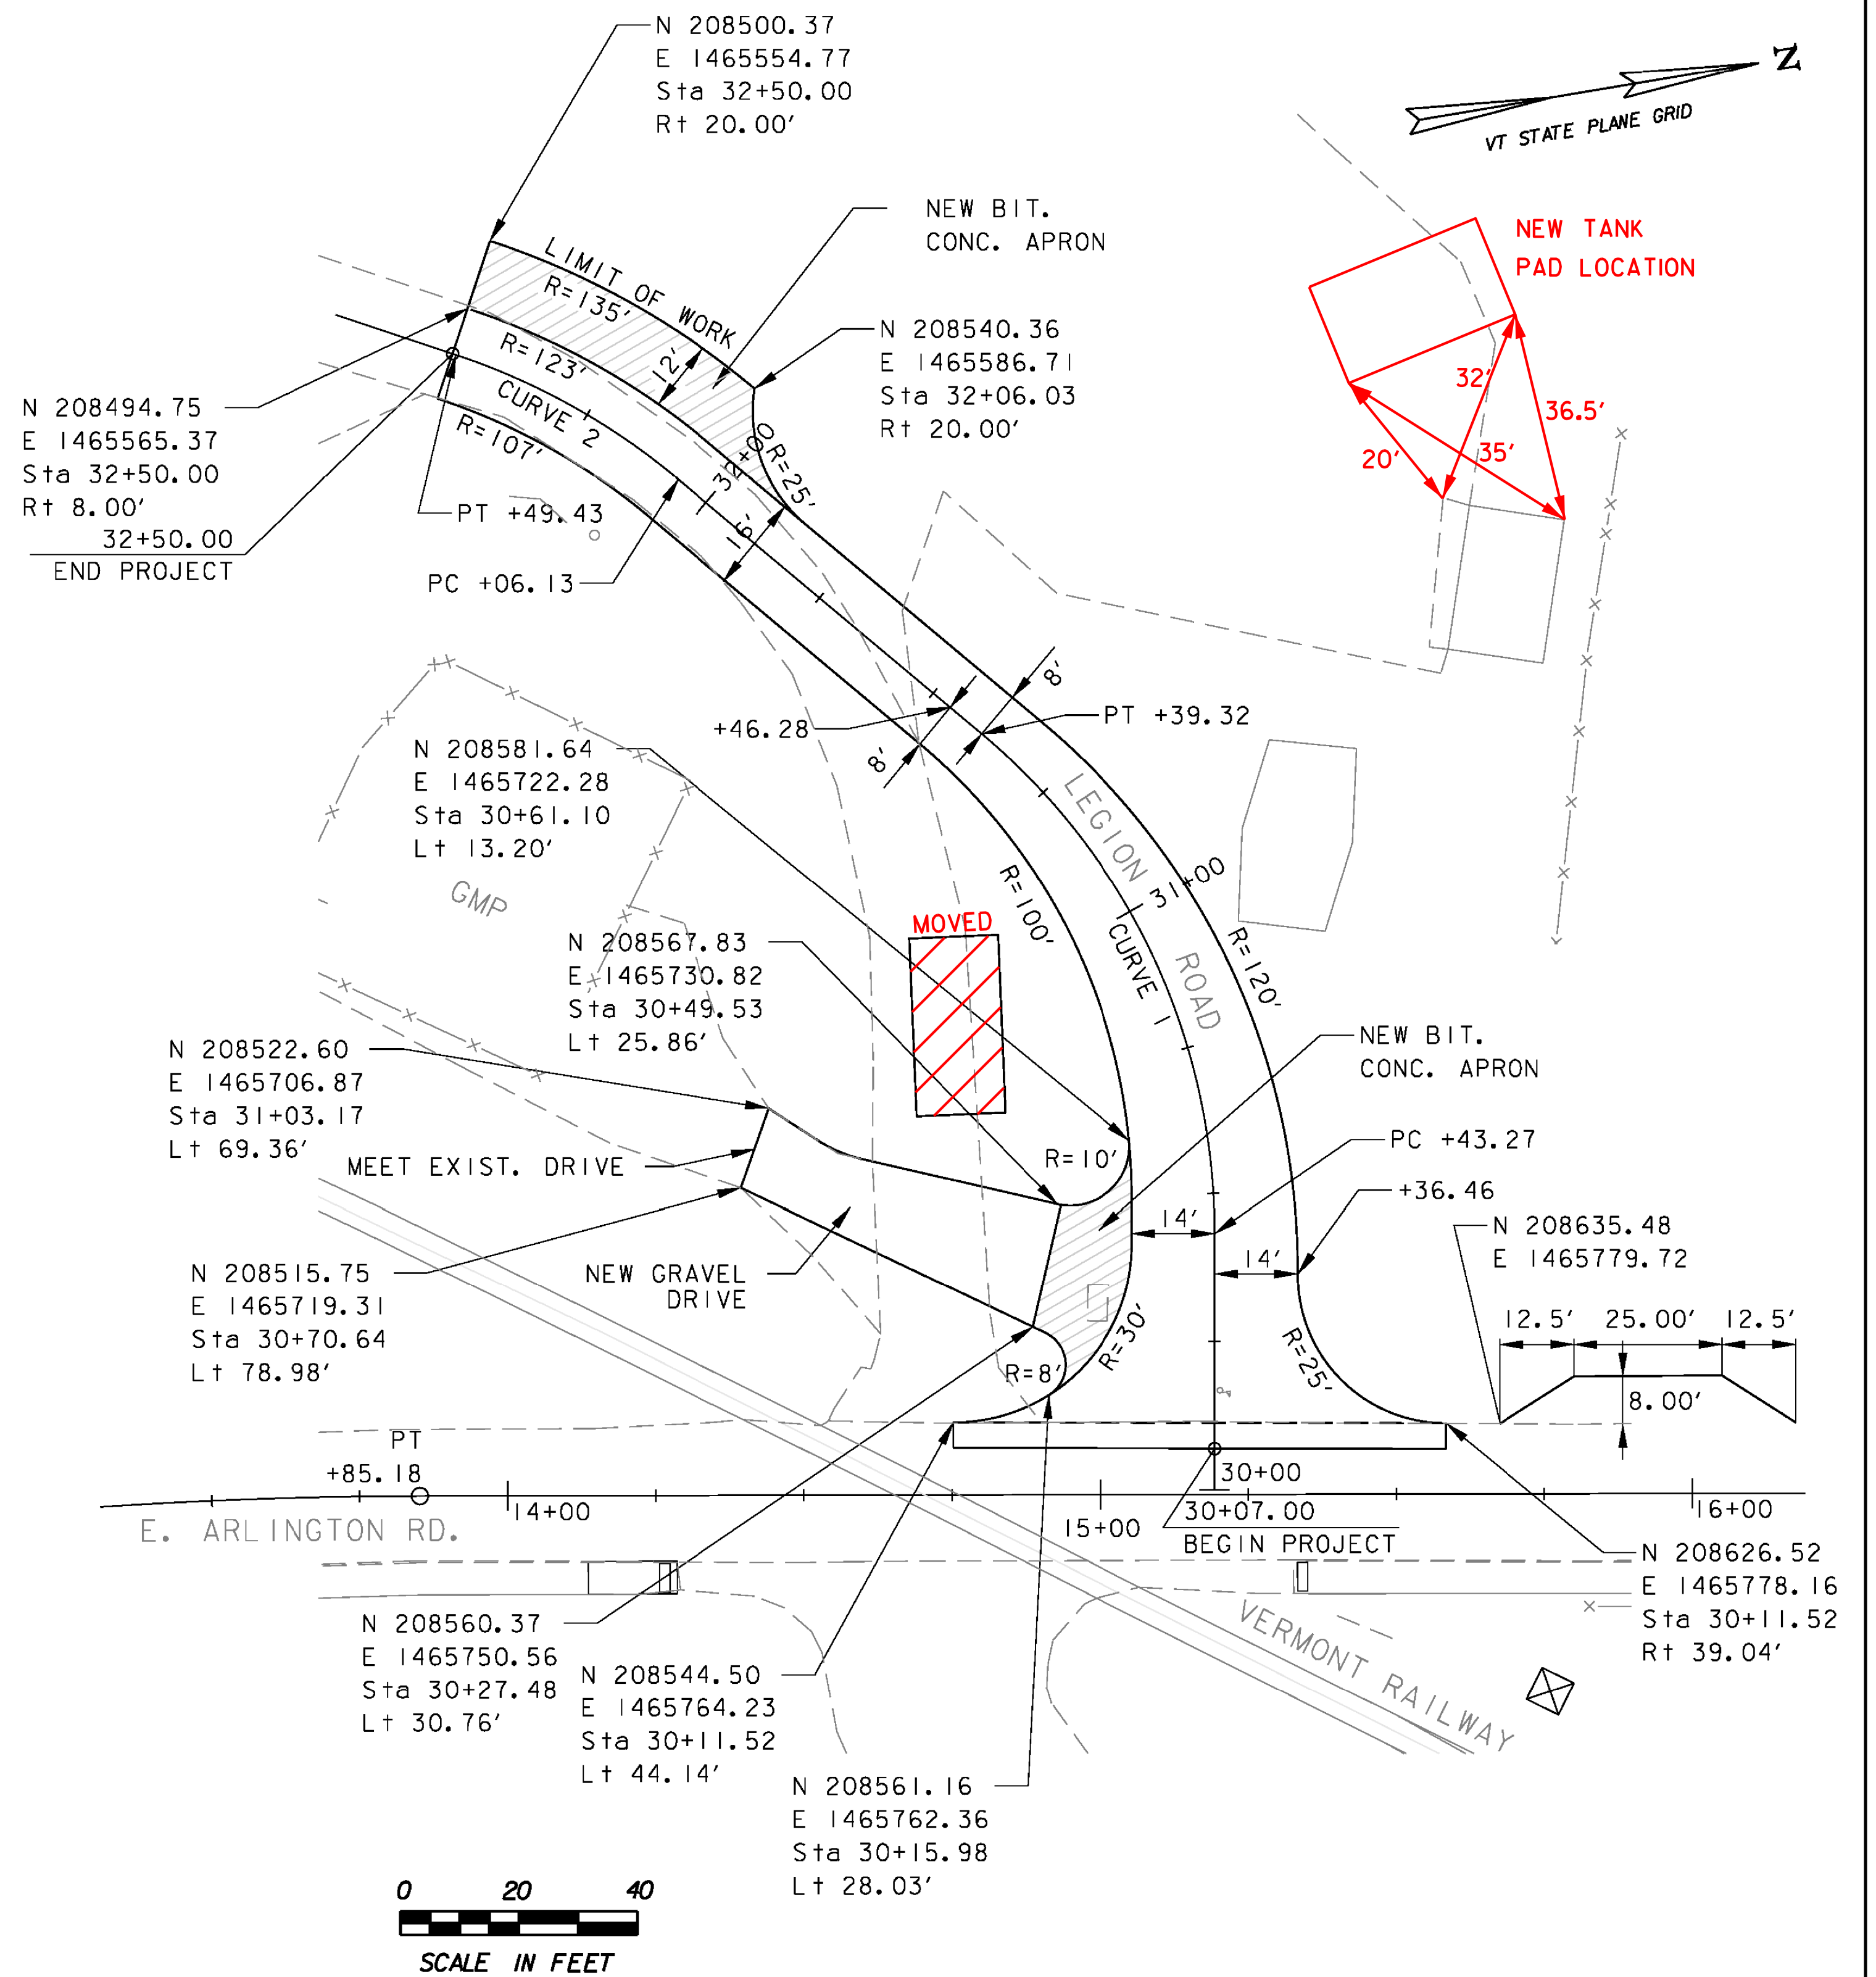


PROJECT NAME:	ARLINGTON	PLOT DATE:	2/5/2016
PROJECT NUMBER:	STP 0114 (4)	DRAWN BY:	NSB
FILE NAME:	z09g052data.dgn	CHECKED BY:	ABR
PROJECT LEADER:	J. READ	PROJECT SURVEY / COORDINATE DATA	SHEET 13 OF 27
DESIGNED BY:	ABR		

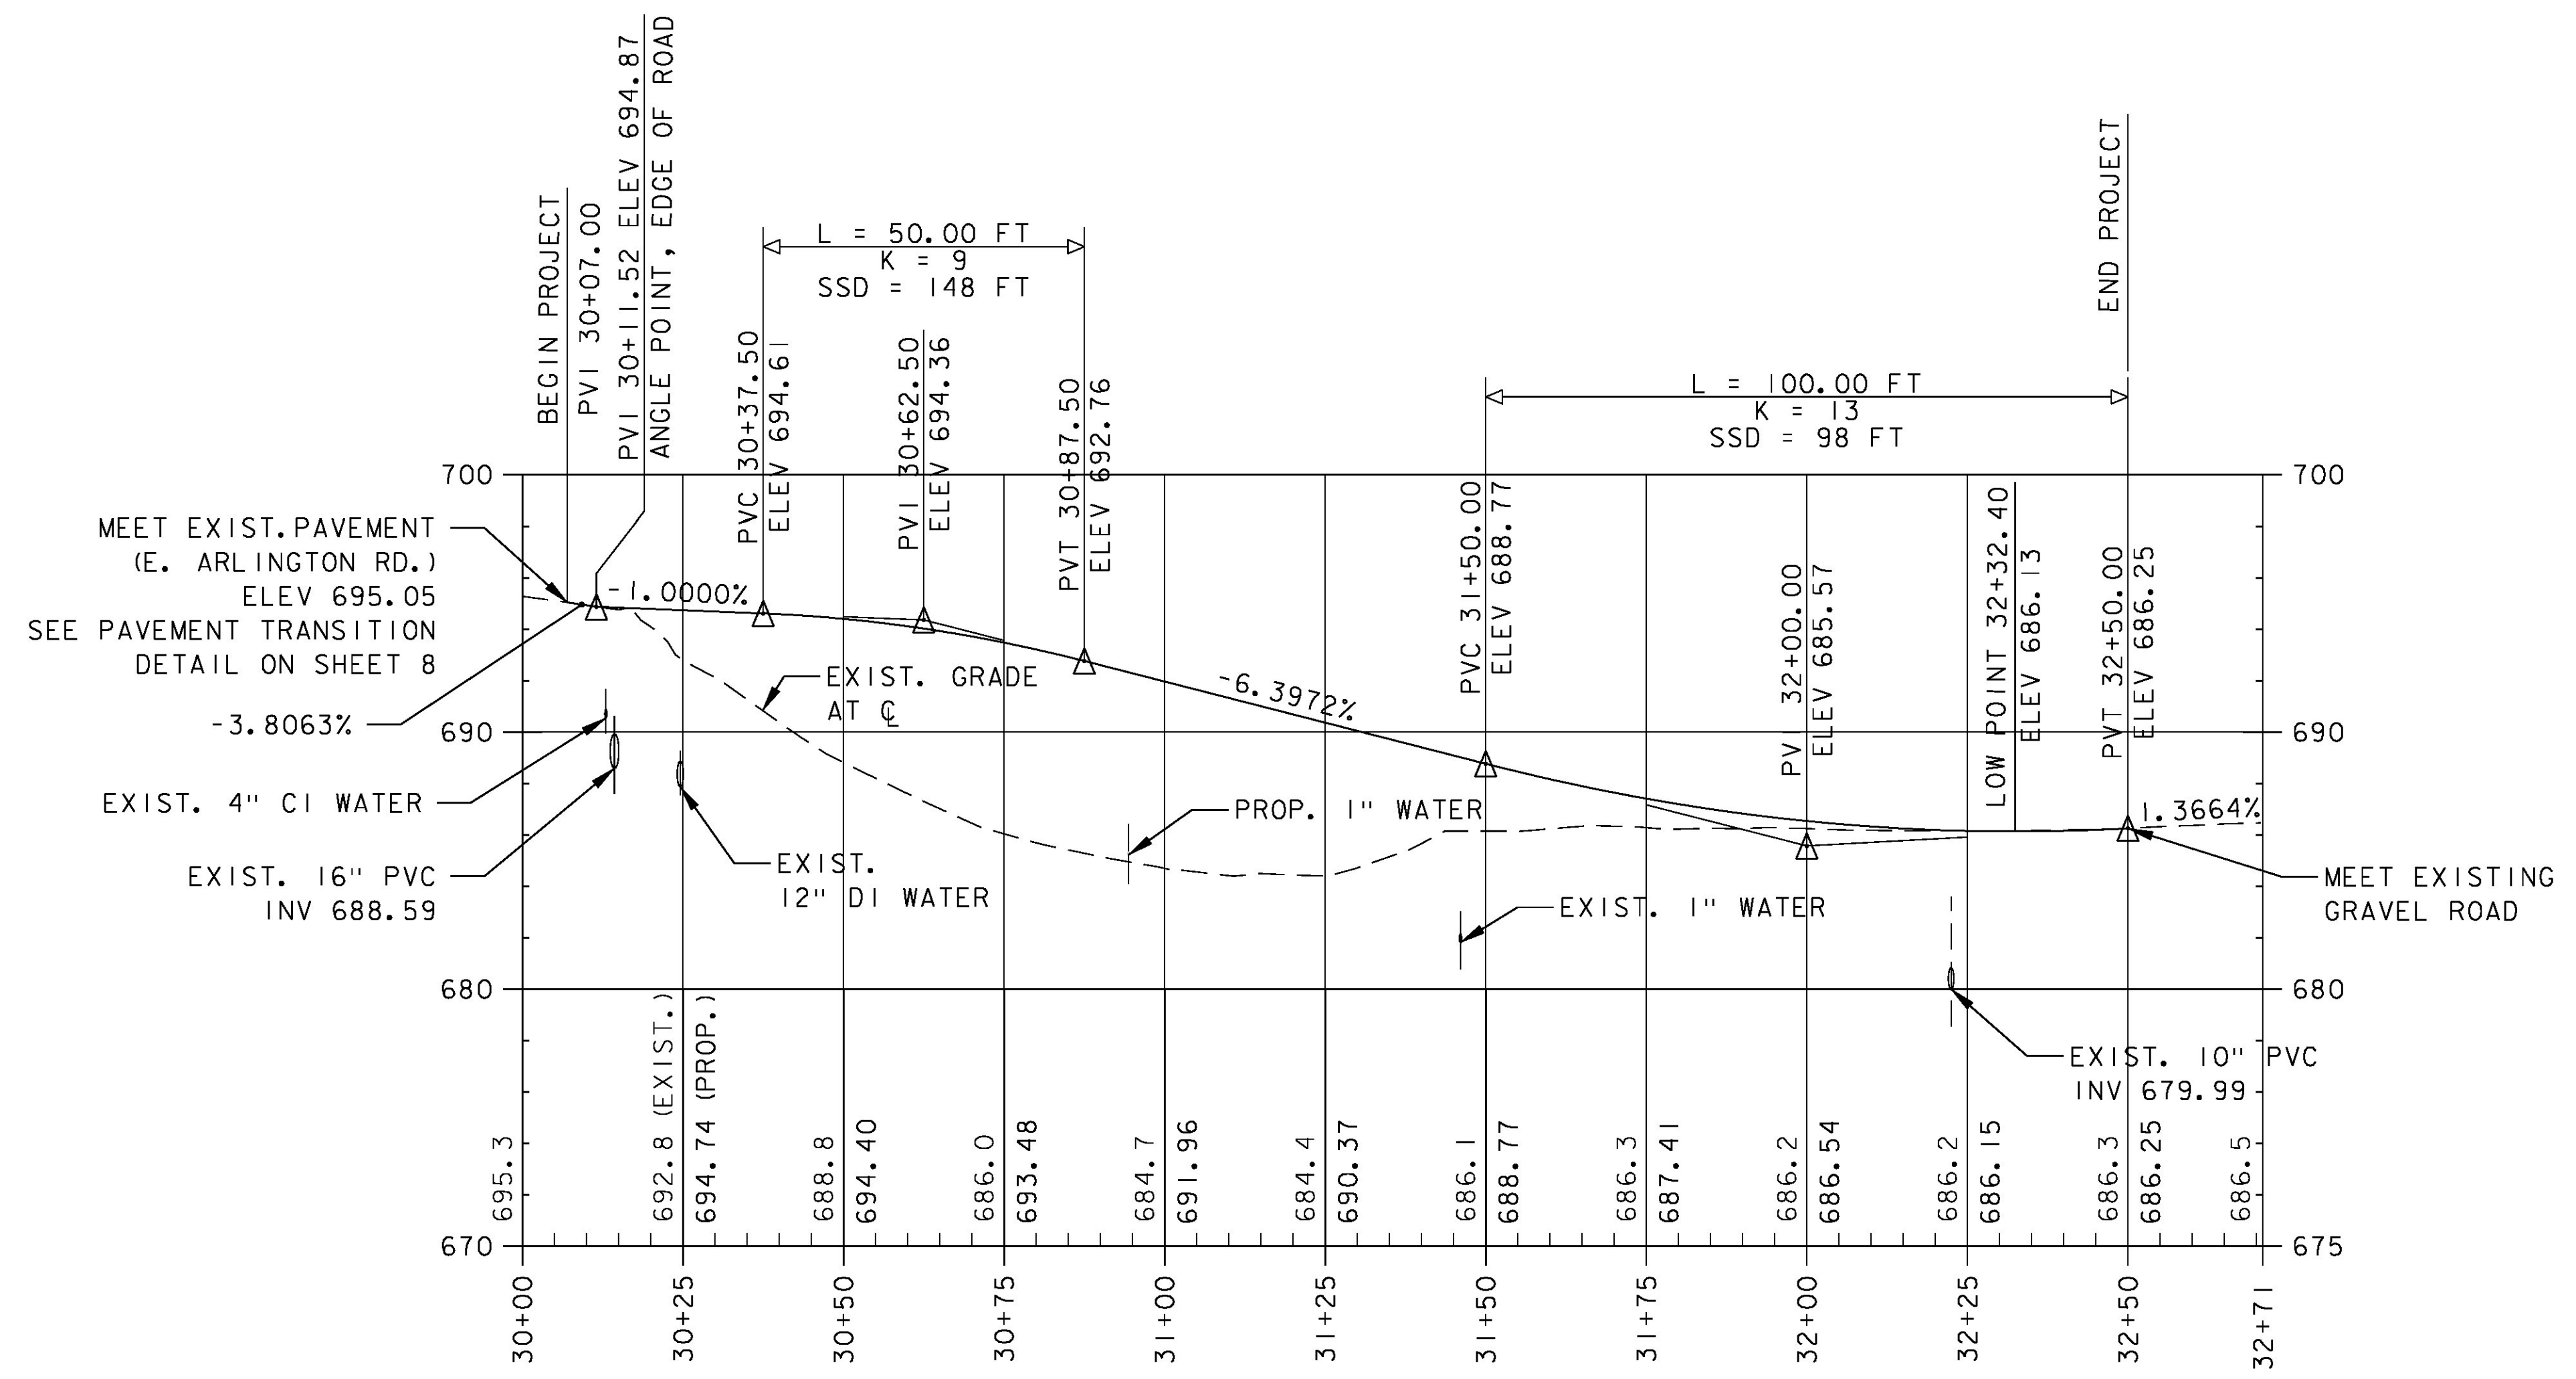

**PROPOSED LEGION ROAD  
PROFILE**


PROJECT NAME: ARLINGTON	PLOT DATE: 2/5/2016
PROJECT NUMBER: STP 0114 (4)	DRAWN BY: LB
FILE NAME: z09g052xsl.dgn	CHECKED BY: J. READ
PROJECT LEADER: J. READ	SHEET 14 OF 27
DESIGNED BY: ABR	
PROFILE	

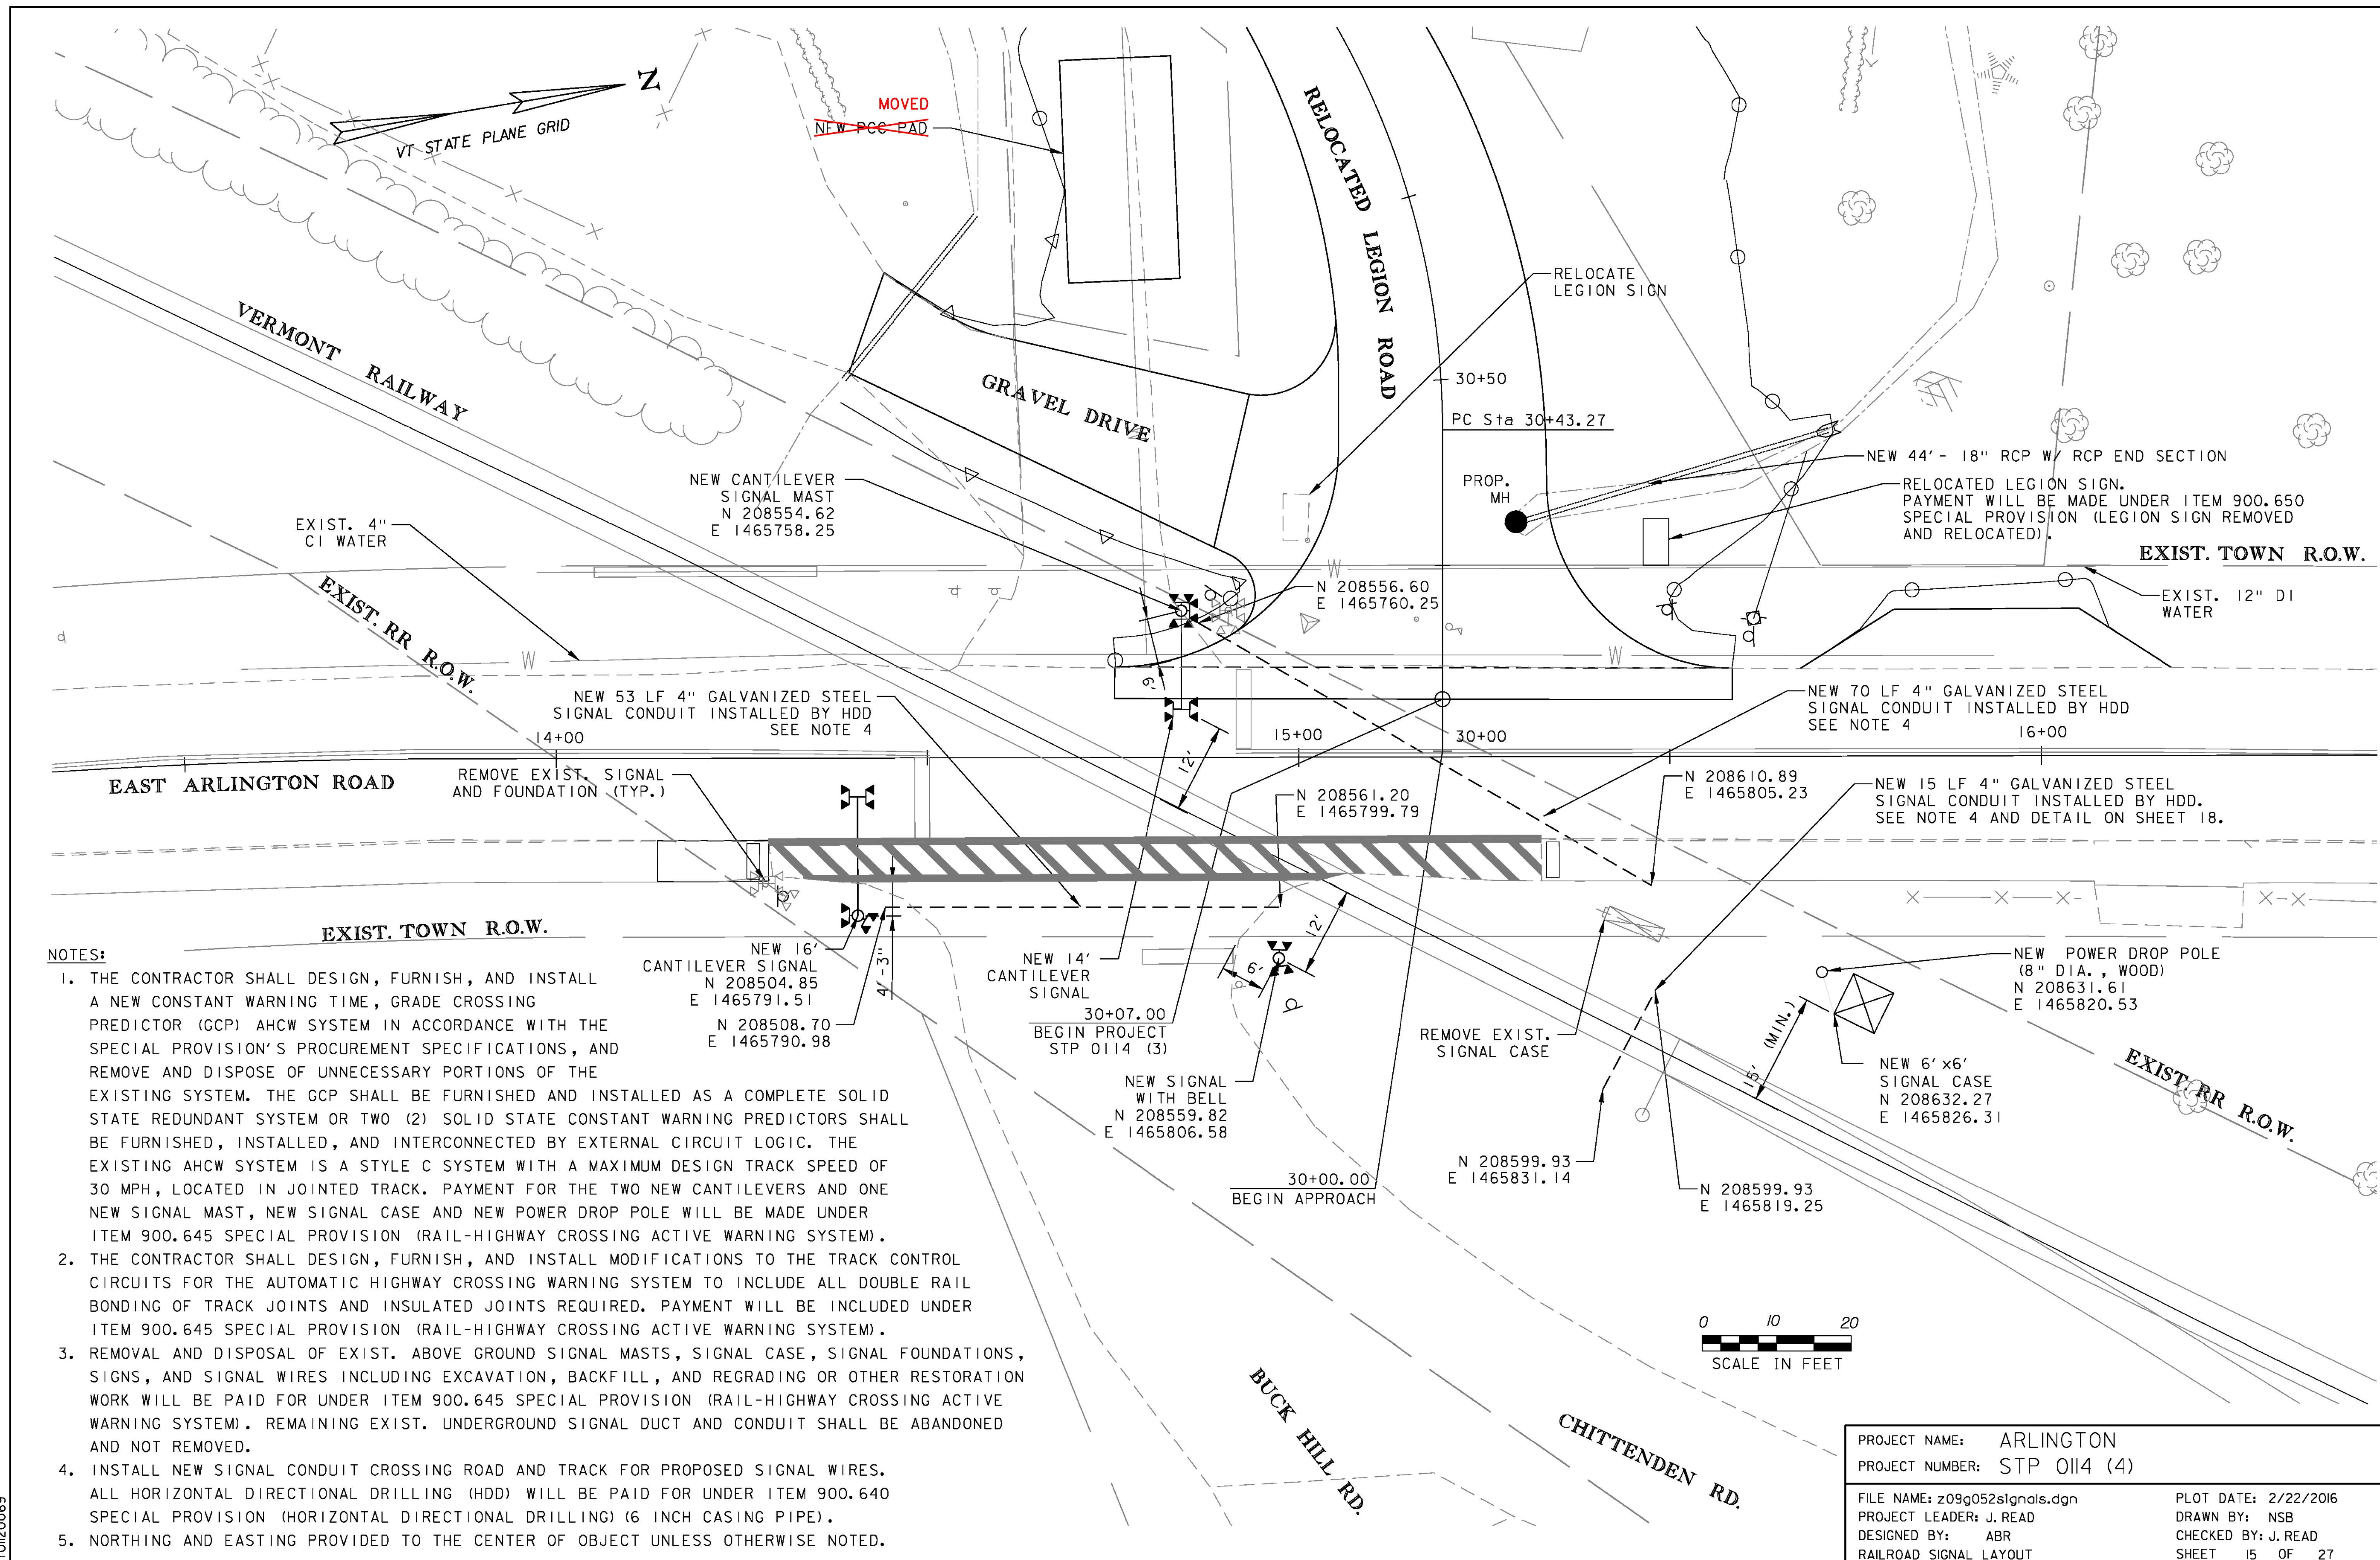

- NOTES:**
1. THE CONTRACTOR SHALL DESIGN, FURNISH, AND INSTALL A NEW CONSTANT WARNING TIME, GRADE CROSSING PREDICTOR (GCP) AHCW SYSTEM IN ACCORDANCE WITH THE SPECIAL PROVISION'S PROCUREMENT SPECIFICATIONS, AND REMOVE AND DISPOSE OF UNNECESSARY PORTIONS OF THE EXISTING SYSTEM. THE GCP SHALL BE FURNISHED AND INSTALLED AS A COMPLETE SOLID STATE REDUNDANT SYSTEM OR TWO (2) SOLID STATE CONSTANT WARNING PREDICTORS SHALL BE FURNISHED, INSTALLED, AND INTERCONNECTED BY EXTERNAL CIRCUIT LOGIC. THE EXISTING AHCW SYSTEM IS A STYLE C SYSTEM WITH A MAXIMUM DESIGN TRACK SPEED OF 30 MPH, LOCATED IN JOINTED TRACK. PAYMENT FOR THE TWO NEW CANTILEVERS AND ONE NEW SIGNAL MAST, NEW SIGNAL CASE AND NEW POWER DROP POLE WILL BE MADE UNDER ITEM 900.645 SPECIAL PROVISION (RAIL-HIGHWAY CROSSING ACTIVE WARNING SYSTEM).
  2. THE CONTRACTOR SHALL DESIGN, FURNISH, AND INSTALL MODIFICATIONS TO THE TRACK CONTROL CIRCUITS FOR THE AUTOMATIC HIGHWAY CROSSING WARNING SYSTEM TO INCLUDE ALL DOUBLE RAIL BONDING OF TRACK JOINTS AND INSULATED JOINTS REQUIRED. PAYMENT WILL BE INCLUDED UNDER ITEM 900.645 SPECIAL PROVISION (RAIL-HIGHWAY CROSSING ACTIVE WARNING SYSTEM).
  3. REMOVAL AND DISPOSAL OF EXIST. ABOVE GROUND SIGNAL MASTS, SIGNAL CASE, SIGNAL FOUNDATIONS, SIGNS, AND SIGNAL WIRES INCLUDING EXCAVATION, BACKFILL, AND REGRADING OR OTHER RESTORATION WORK WILL BE PAID FOR UNDER ITEM 900.645 SPECIAL PROVISION (RAIL-HIGHWAY CROSSING ACTIVE WARNING SYSTEM). REMAINING EXIST. UNDERGROUND SIGNAL DUCT AND CONDUIT SHALL BE ABANDONED AND NOT REMOVED.
  4. INSTALL NEW SIGNAL CONDUIT CROSSING ROAD AND TRACK FOR PROPOSED SIGNAL WIRES. ALL HORIZONTAL DIRECTIONAL DRILLING (HDD) WILL BE PAID FOR UNDER ITEM 900.640 SPECIAL PROVISION (HORIZONTAL DIRECTIONAL DRILLING) (6 INCH CASING PIPE).
  5. NORTHING AND EASTING PROVIDED TO THE CENTER OF OBJECT UNLESS OTHERWISE NOTED.

PROJECT NAME: ARLINGTON		PLOT DATE: 2/22/2016	
PROJECT NUMBER: STP 0114 (4)		DRAWN BY: NSB	
FILE NAME: z09g052signals.dgn		DESIGNED BY: ABR	
PROJECT LEADER: J. READ		CHECKED BY: J. READ	
RAILROAD SIGNAL LAYOUT		SHEET 15 OF 27	

P70120069

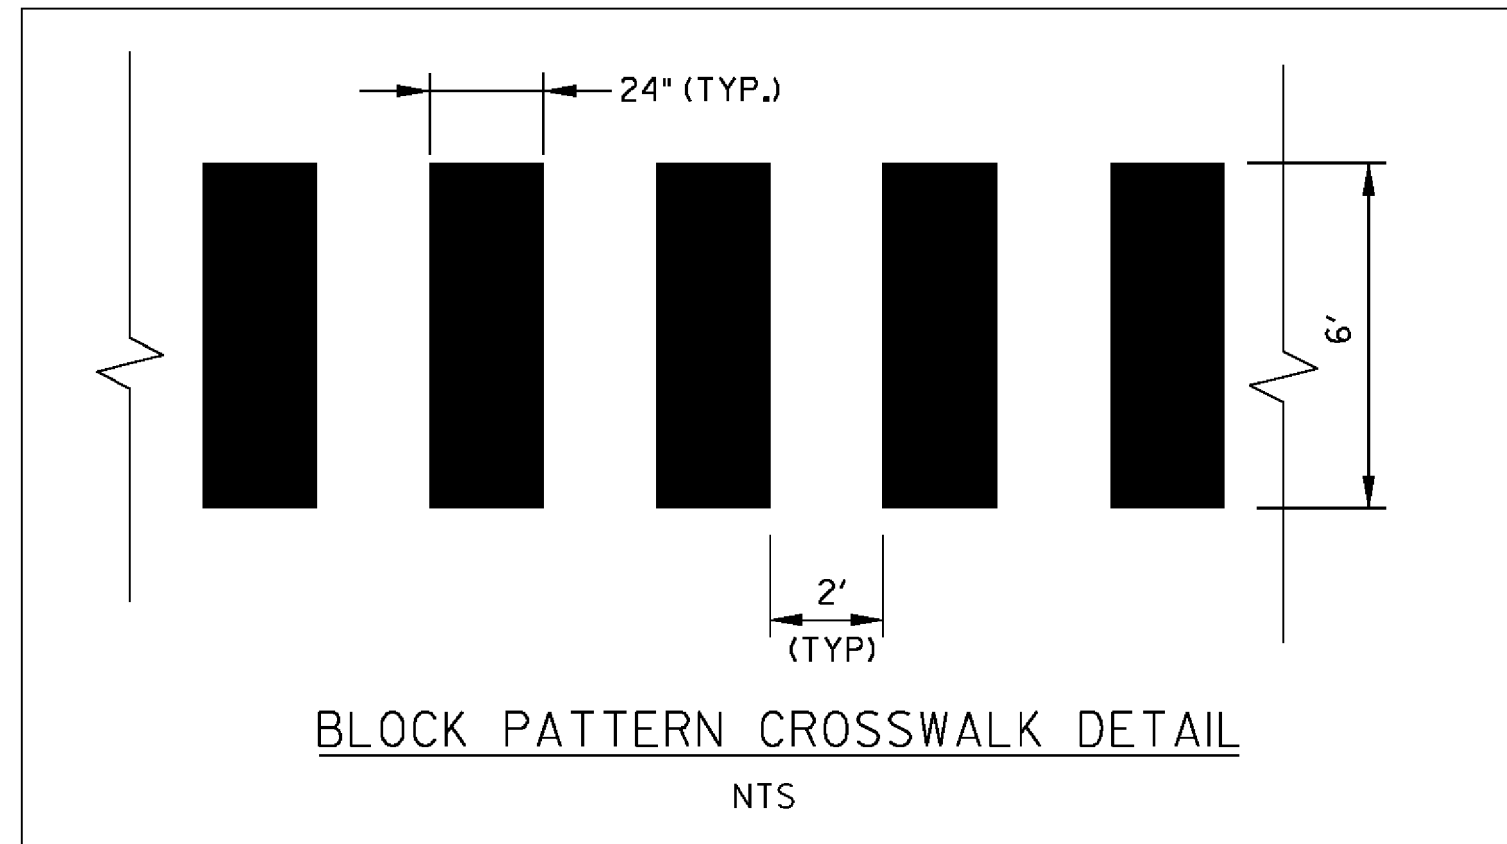

**NOTES:**

1. ALL EXISTING SIGNS NOT SHOWN SHALL BE RETAINED UNLESS DIRECTED OTHERWISE BY THE ENGINEER.
2. SEE VAOT STANDARD E-121 FOR STANDARD SIGN PLACEMENT.
3. REMOVE ALL CONFLICTING EXISTING PAVEMENT MARKINGS.
4. FOR ADDITIONAL SIGNAL LOCATION INFORMATION SEE SHEET 15.
5. FOR CONSTRUCTION STAGING AND TEMPORARY TRAFFIC CONTROL INFORMATION TO RELOCATE THE MILITARY TANK SEE SHEETS 24 AND 25.


**REMOVE EXIST. DYCL (DOUBLE YELLOW CENTER LINE) ITEM 646.85**  
 E. ARLINGTON RD STA 11+57 STA 14+50  
 E. ARLINGTON RD STA 14+92 STA 17+91

**4 INCH DYCL ITEM 646.412**  
 E. ARLINGTON RD STA 11+57 STA 14+31  
 E. ARLINGTON RD STA 15+60 STA 17+91  
 LEGION RD STA 30+17 STA 31+08

**24 INCH STOP BAR ITEM 646.482**  
 E. ARLINGTON RD STA 14+95.88 LT 18.19' STA 15+19.88 LT 18.14'

**RAILROAD CROSSING SYMBOL ITEM 646.512**  
 E. ARLINGTON RD STA 12+07 RT  
 E. ARLINGTON RD STA 17+63 LT  
 E. ARLINGTON RD STA 16+10 RT 115' (AT CHITTENDEN RD)

**CROSSWALK ITEM 646.502**  
 E. ARLINGTON RD STA 14+29 RT 11.26' STA 15+32 RT 11.26'

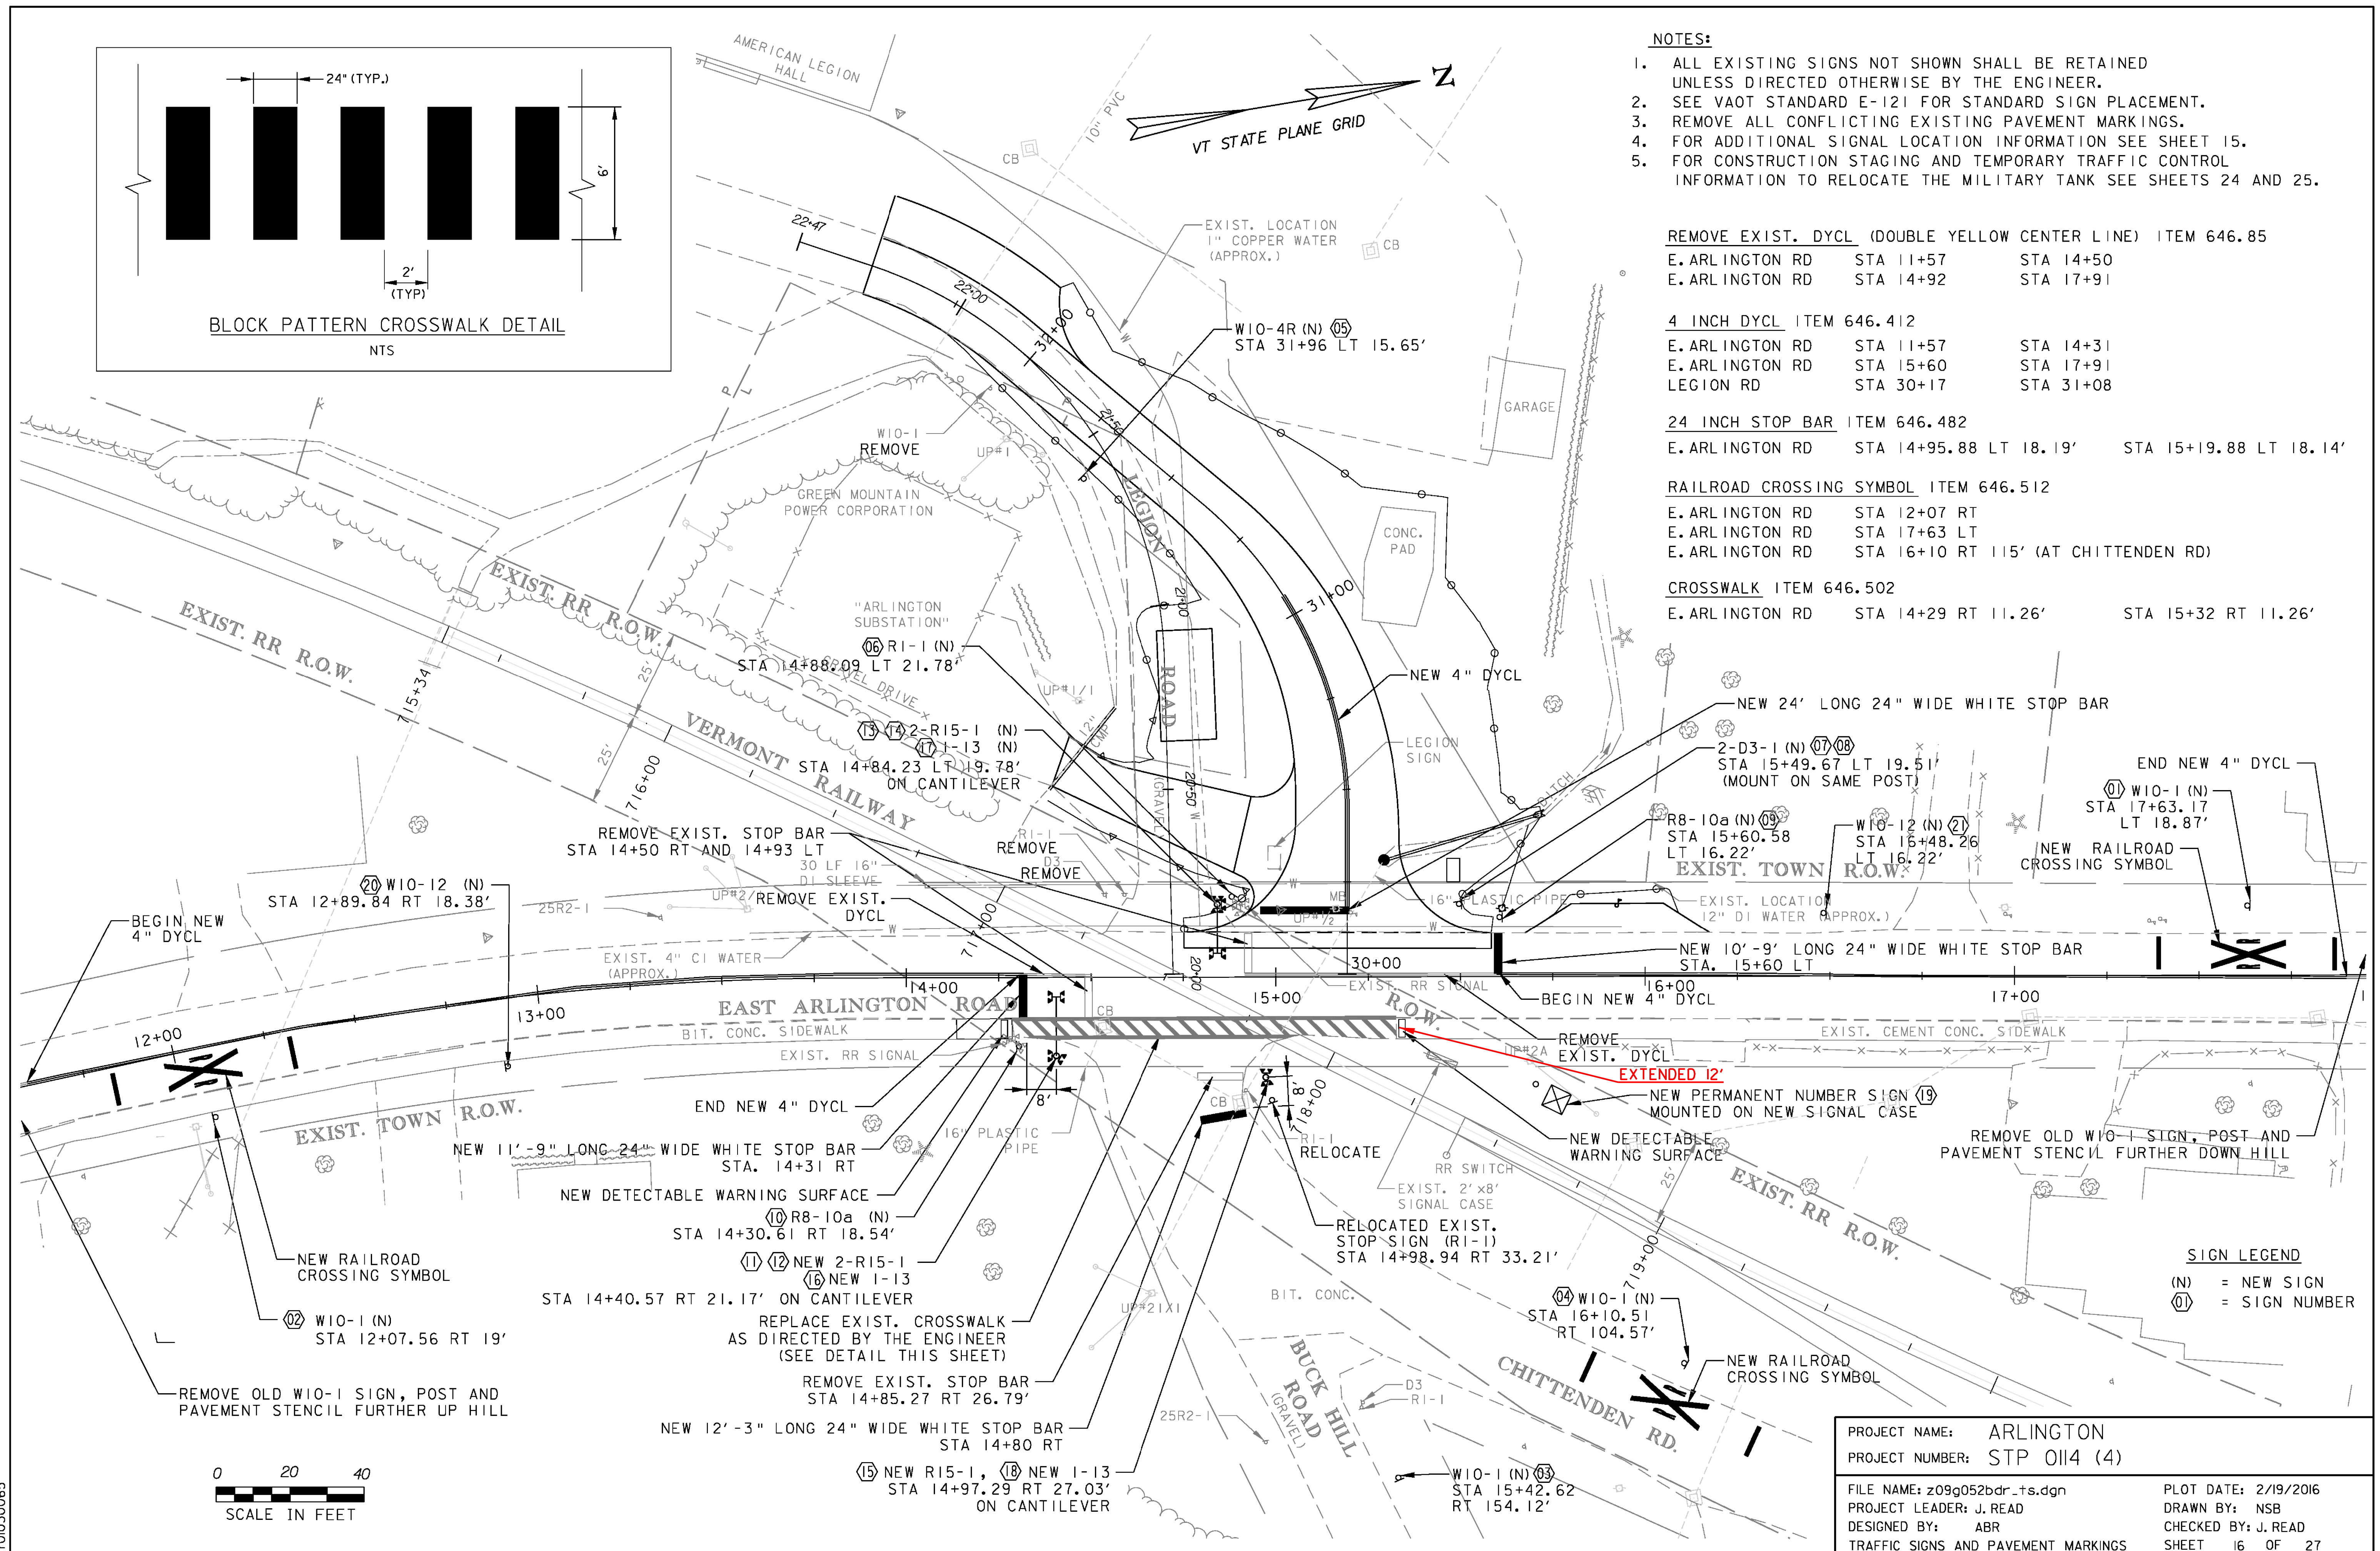


**SIGN LEGEND**  
 (N) = NEW SIGN  
 (1) = SIGN NUMBER

PROJECT NAME:	ARLINGTON	PLOT DATE:	2/19/2016
PROJECT NUMBER:	STP 0114 (4)	DRAWN BY:	NSB
FILE NAME:	z09g052bdr_ts.dgn	CHECKED BY:	J. READ
PROJECT LEADER:	J. READ	TRAFFIC SIGNS AND PAVEMENT MARKINGS	SHEET 16 OF 27
DESIGNED BY:	ABR		




P701030065




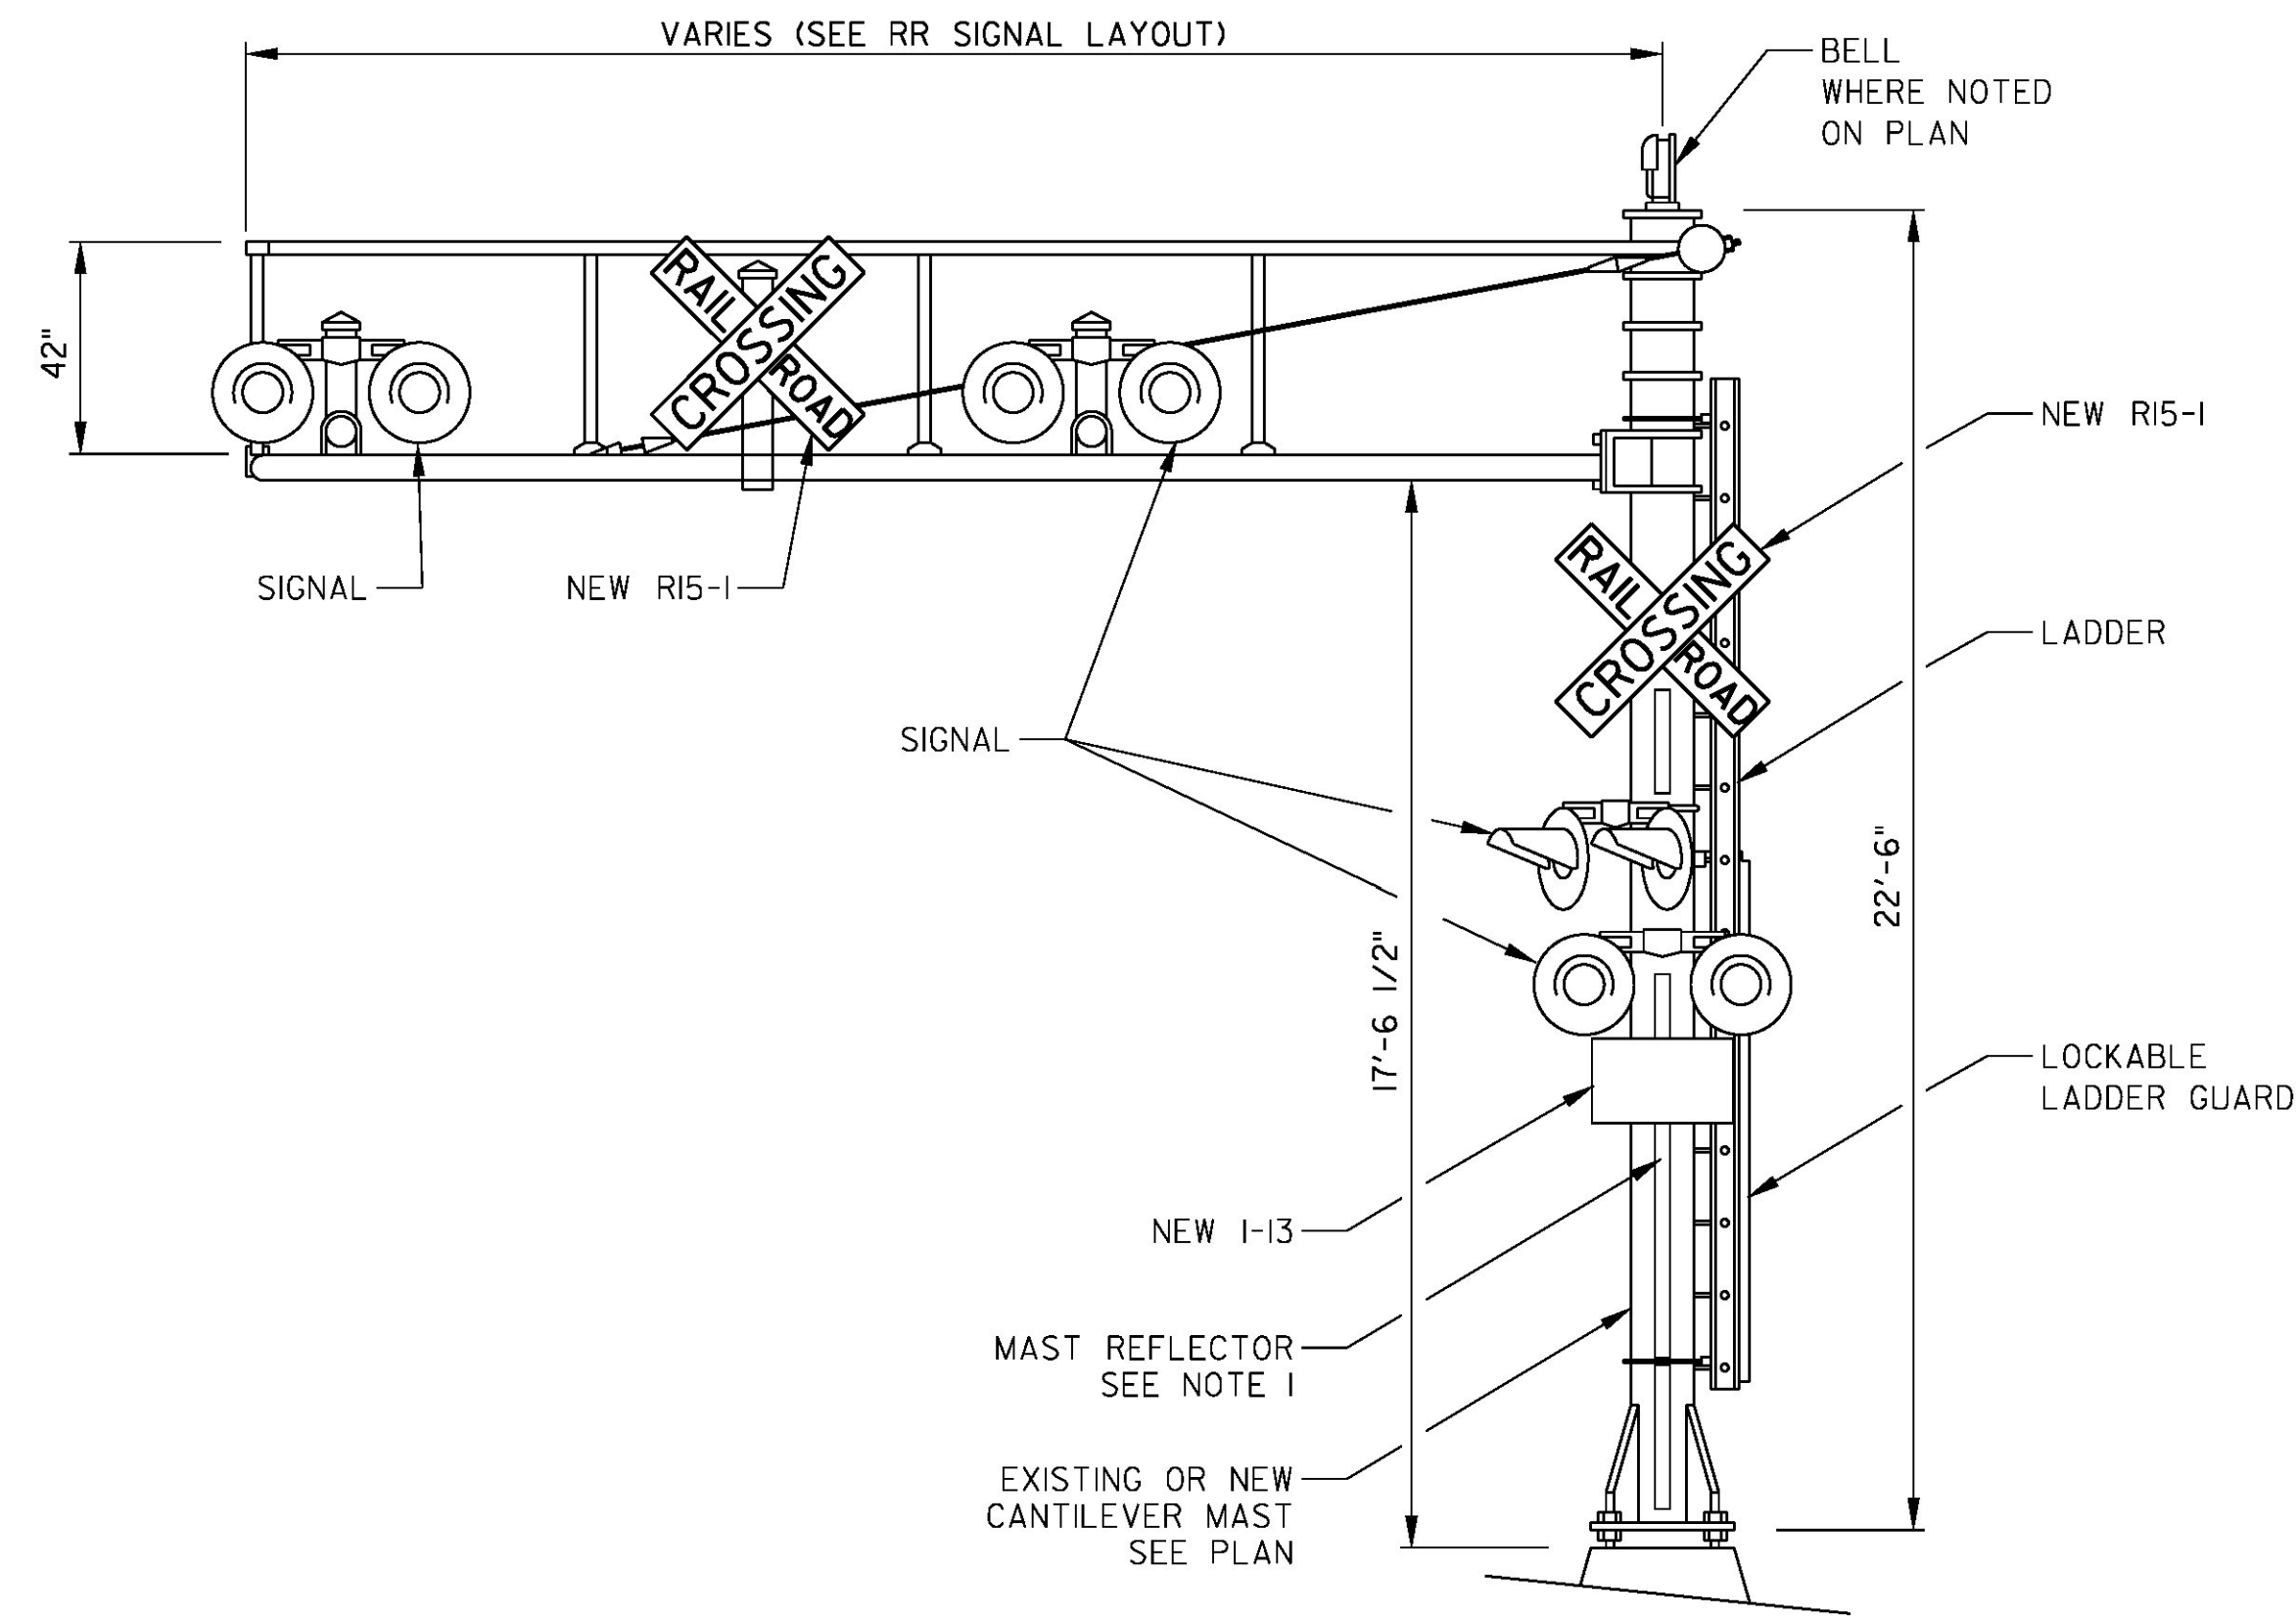


TYPICAL RAILROAD  
CANTILEVER SIGNAL DETAIL  
NTS

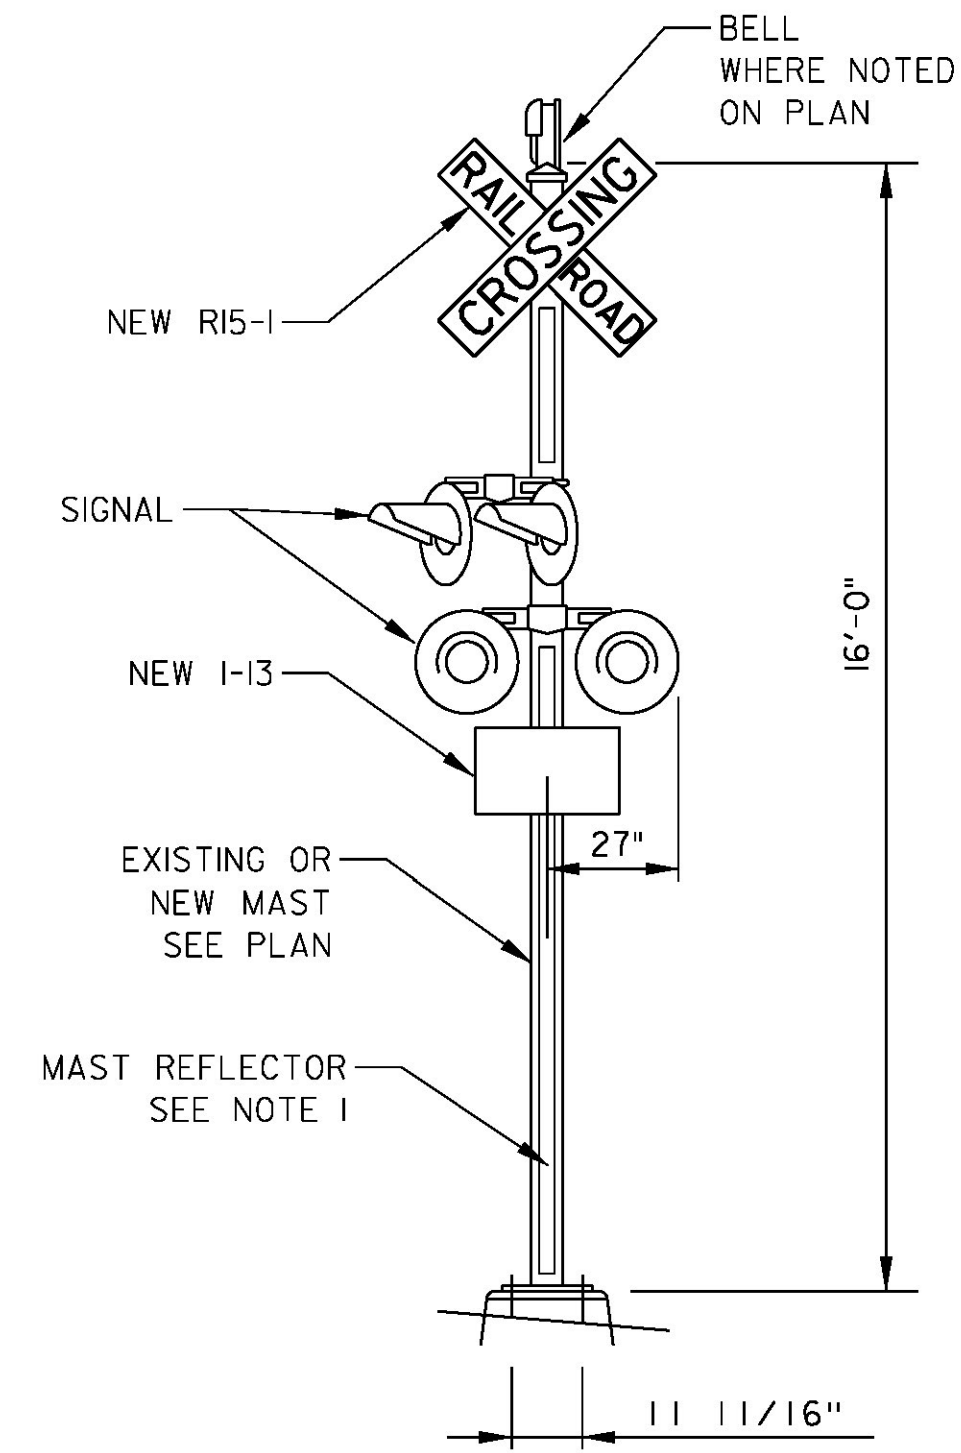

TYPICAL RAILROAD SIGNAL DETAIL  
NTS

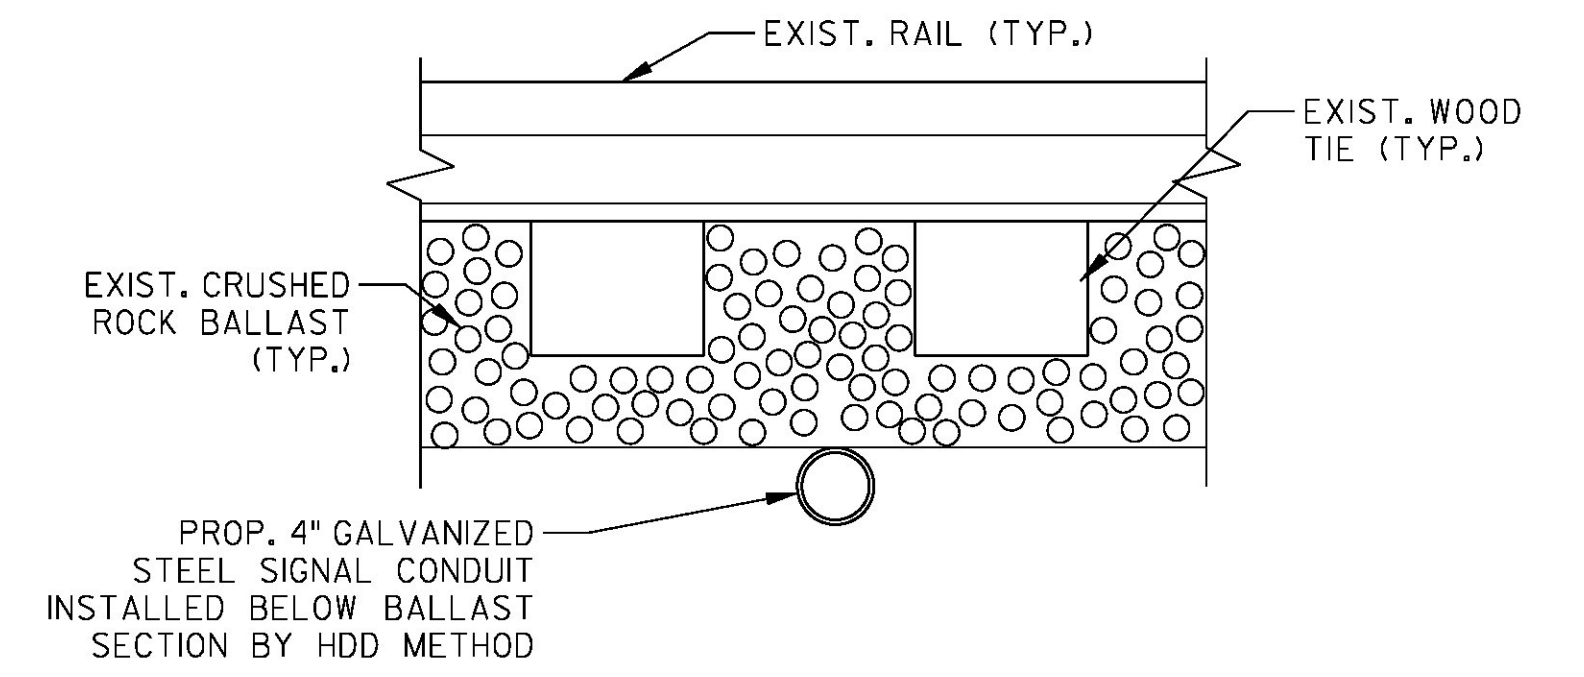


SIGNAL CONDUIT INSTALLATION BELOW TRACK  
NTS

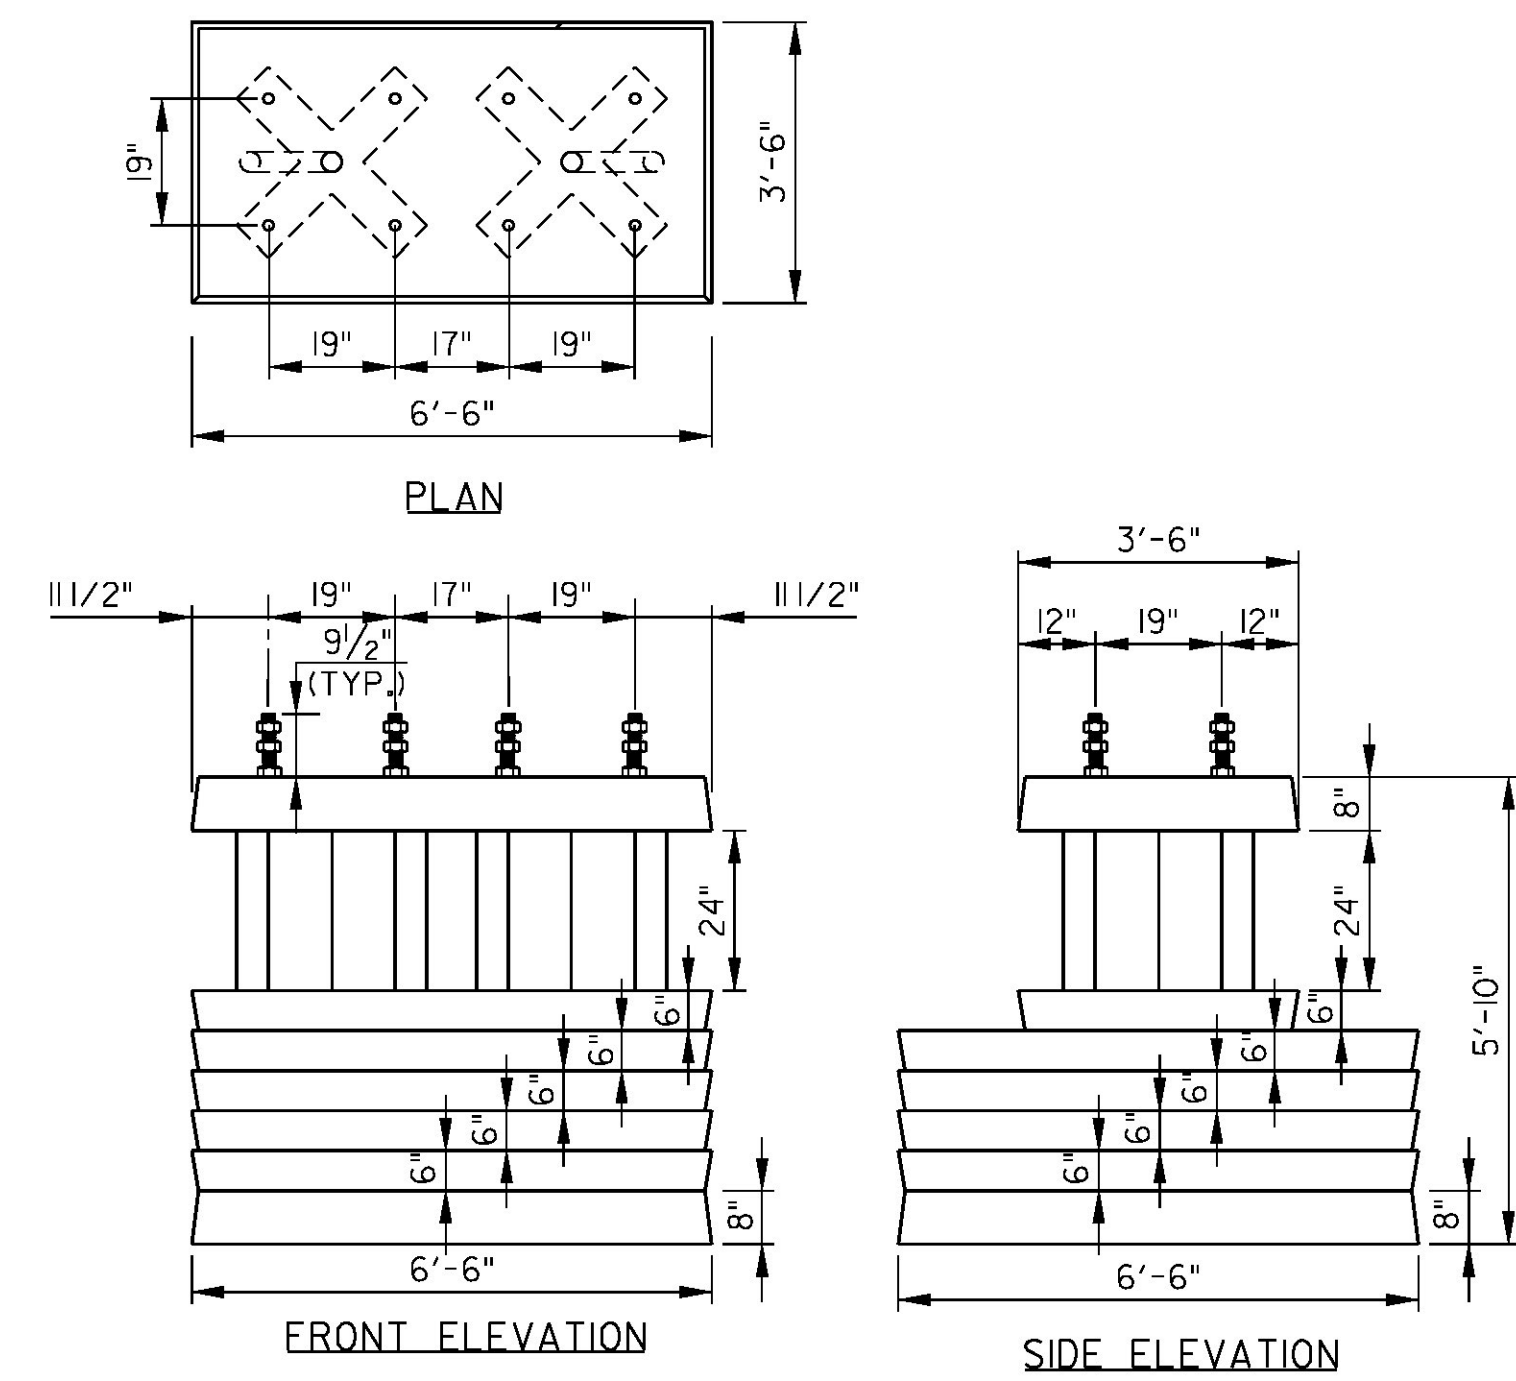

TYPICAL DOUBLE MAST FOUNDATION DETAIL  
NTS

NOTE:  
CONTACTOR MAY ELECT TO SUBSTITUTE  
POURED IN PLACE REINFORCED CONCRETE FOUNDATIONS  
WITH PROPER SIZE AND LENGTH ANCHOR BOLTS DESIGNED  
BY THE SIGNAL MANUFACTURER.

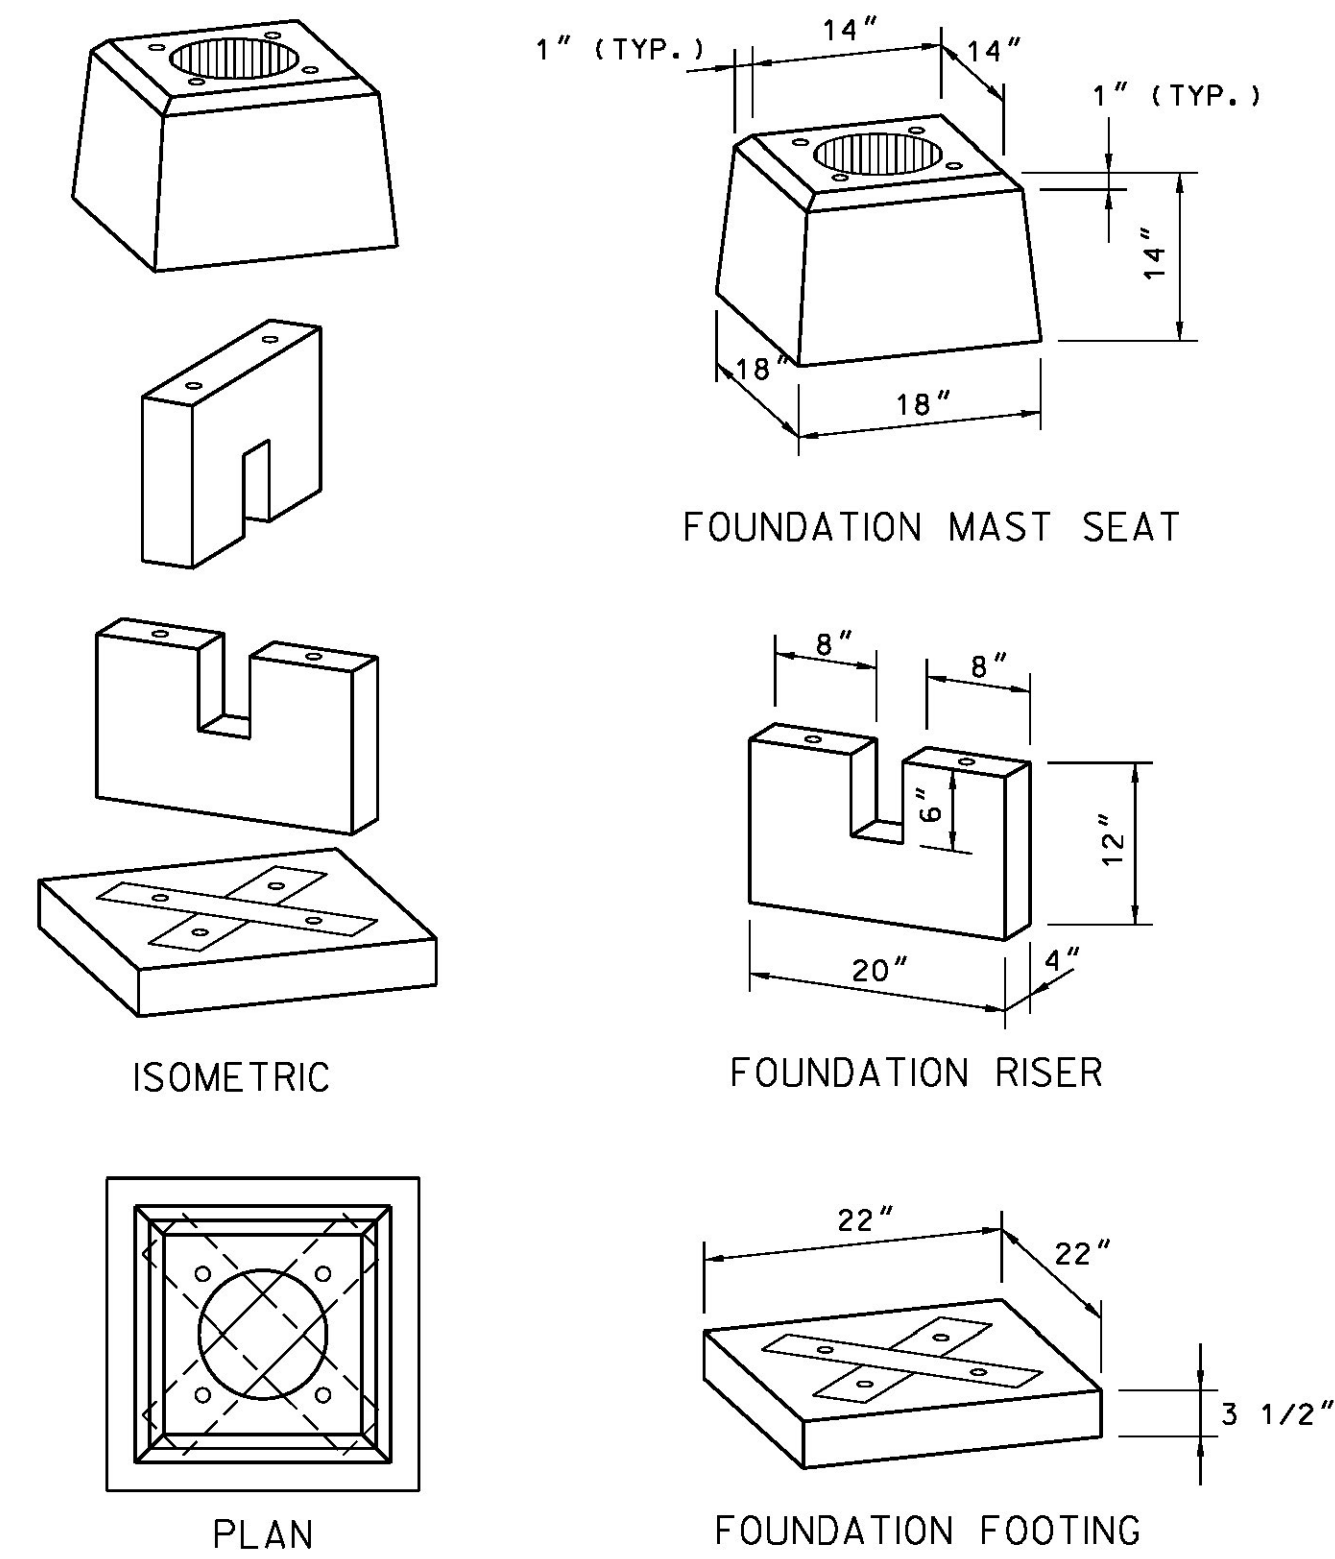

TYPICAL FOUNDATION DETAIL  
NTS

NOTES:

1. A STRIP OF ASTM TYPE III MIN. RETROREFLECTIVE WHITE MATERIAL NOT LESS THAN 2 INCHES IN WIDTH, SHALL BE USED ON EACH SUPPORT AT HIGHWAY-RAIL GRADE CROSSING FOR THE FULL LENGTH OF THE FRONT AND BACK OF THE SUPPORT FROM THE CROSSBUCK SIGN OR NUMBER OF TRACKS SIGN TO NEAR GROUND LEVEL.
2. PLACE THREE I-13 SIGNS, ONE AT EACH CROSSING APPROACH, MOUNTED TO THE SIGNAL MAST.
3. FLASHING LIGHT SIGNAL EQUIPMENT SHALL BE 12" LED FLASHING LIGHT UNITS.
4. PAYMENT FOR FURNISHING AND INSTALLING THE NEW FOUNDATIONS, SIGNAL MASTS, AND 12" LED FLASHING LIGHT UNITS AS SHOWN ON SHEET I5 WILL BE MADE UNDER PAY ITEM 900.645 SPECIAL PROVISION (RAIL-HIGHWAY CROSSING ACTIVE WARNING SYSTEM.)

PROJECT NAME: ARLINGTON  
PROJECT NUMBER: STP 0114 (4)

FILE NAME: z09g052rrdetails.dgn  
PROJECT LEADER: A. RIEGER  
DESIGNED BY: ABR  
RAILROAD SIGNAL DETAILS



PLOT DATE: 2/19/2016  
DRAWN BY: NSB  
CHECKED BY: J. READ  
SHEET 18 OF 27



PERMANENT NUMBER SIGN  
NTS

PERMANENT NUMBER SIGN NOTES:

- PERMANENT NUMBER SIGN PLATE SHALL BE MADE UP OF 0.032 GAGE ALUMINUM WITH RAISED NUMBERS AND LETTERS. SEE SPECIFICATIONS ITEM 900.645 SPECIAL PROVISION (RAIL-HIGHWAY CROSSING ACTIVE WARNING SYSTEM)

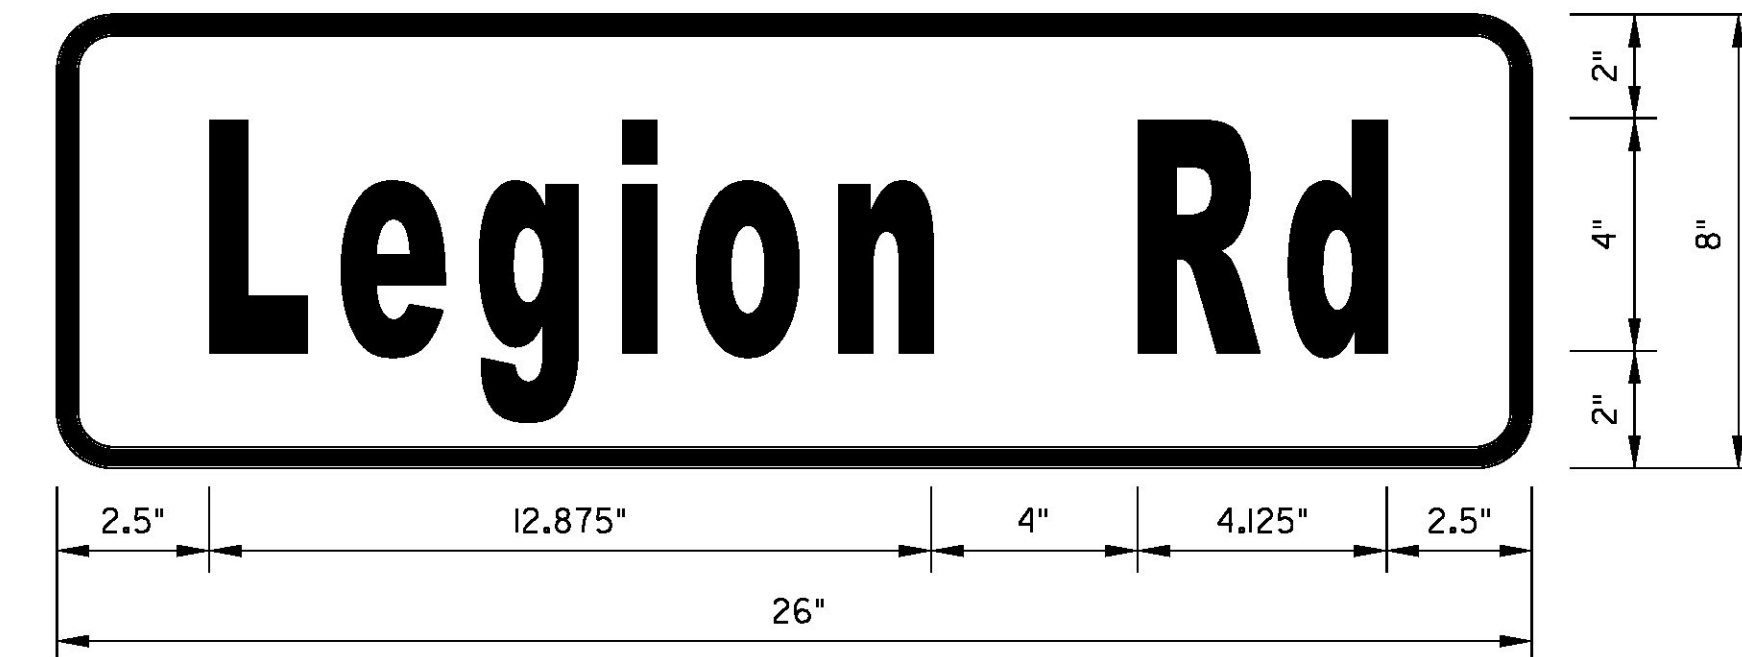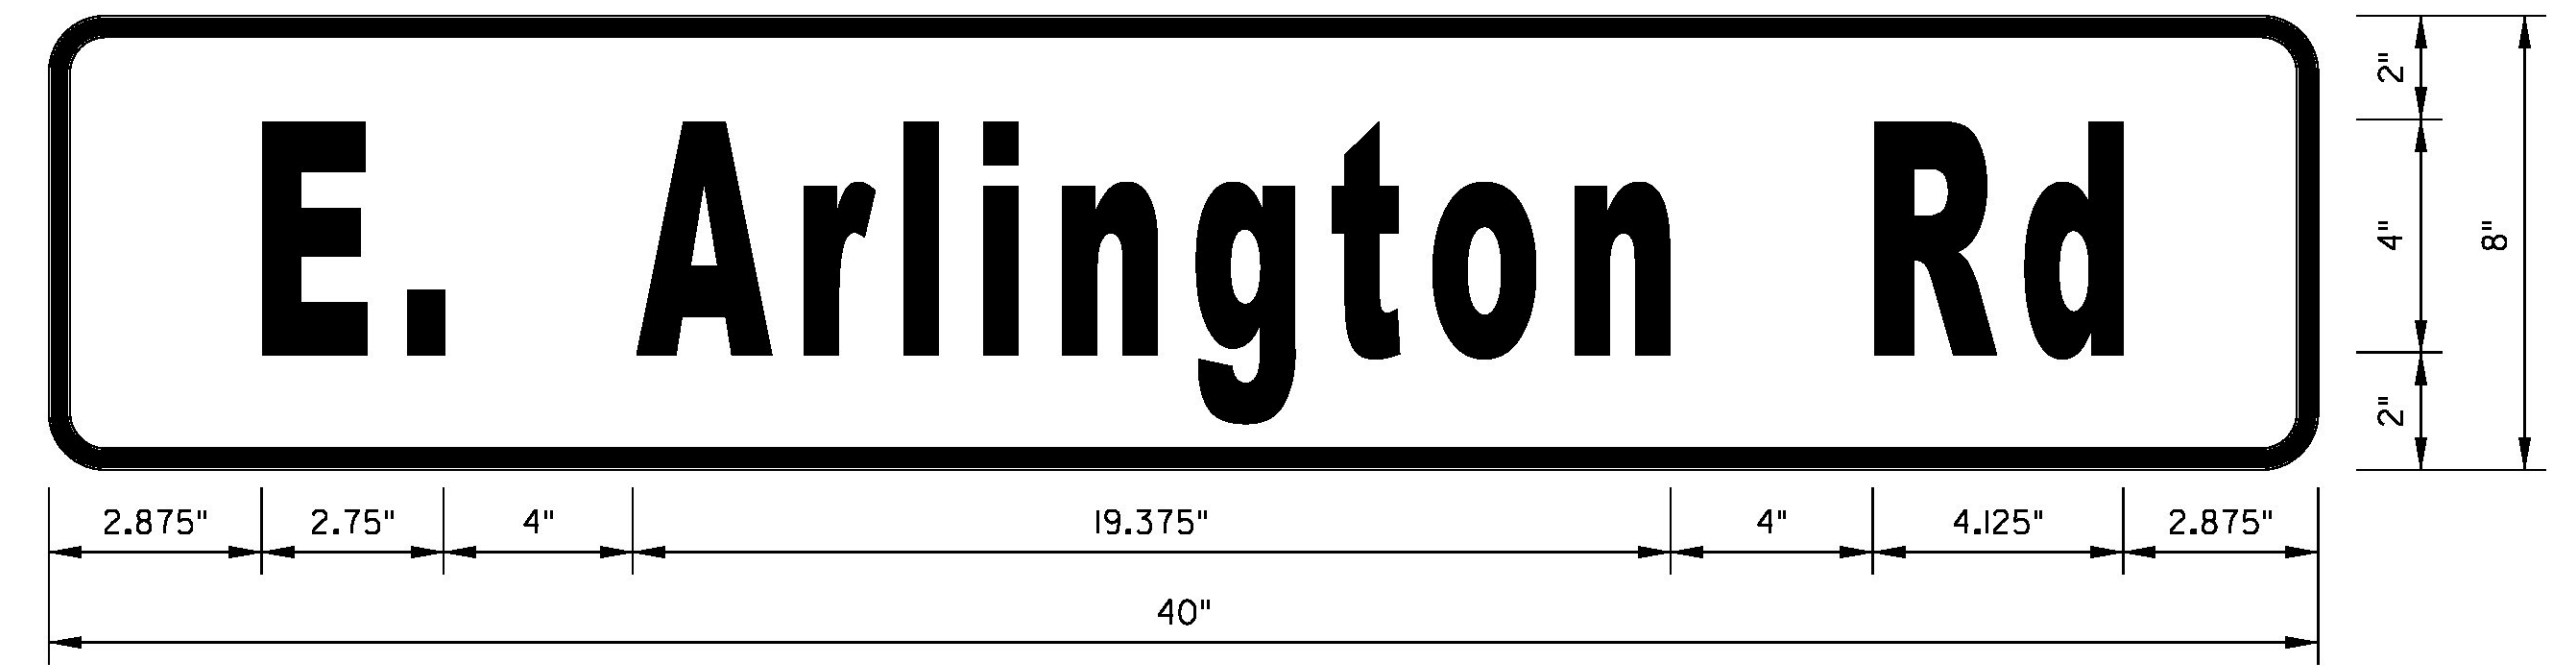


D3-1 SIGNS

NTS

<b>COLORS:</b>	ROAD NAME	WHITE	(RETROREFLECTIVE)
	BACKGROUND	GREEN	(RETROREFLECTIVE)
	BORDER	WHITE	(RETROREFLECTIVE)

D3-1 SIGN NOTES:

- BORDER THICKNESS IS 0.375" WITH 1" RADIUS AT CORNERS.

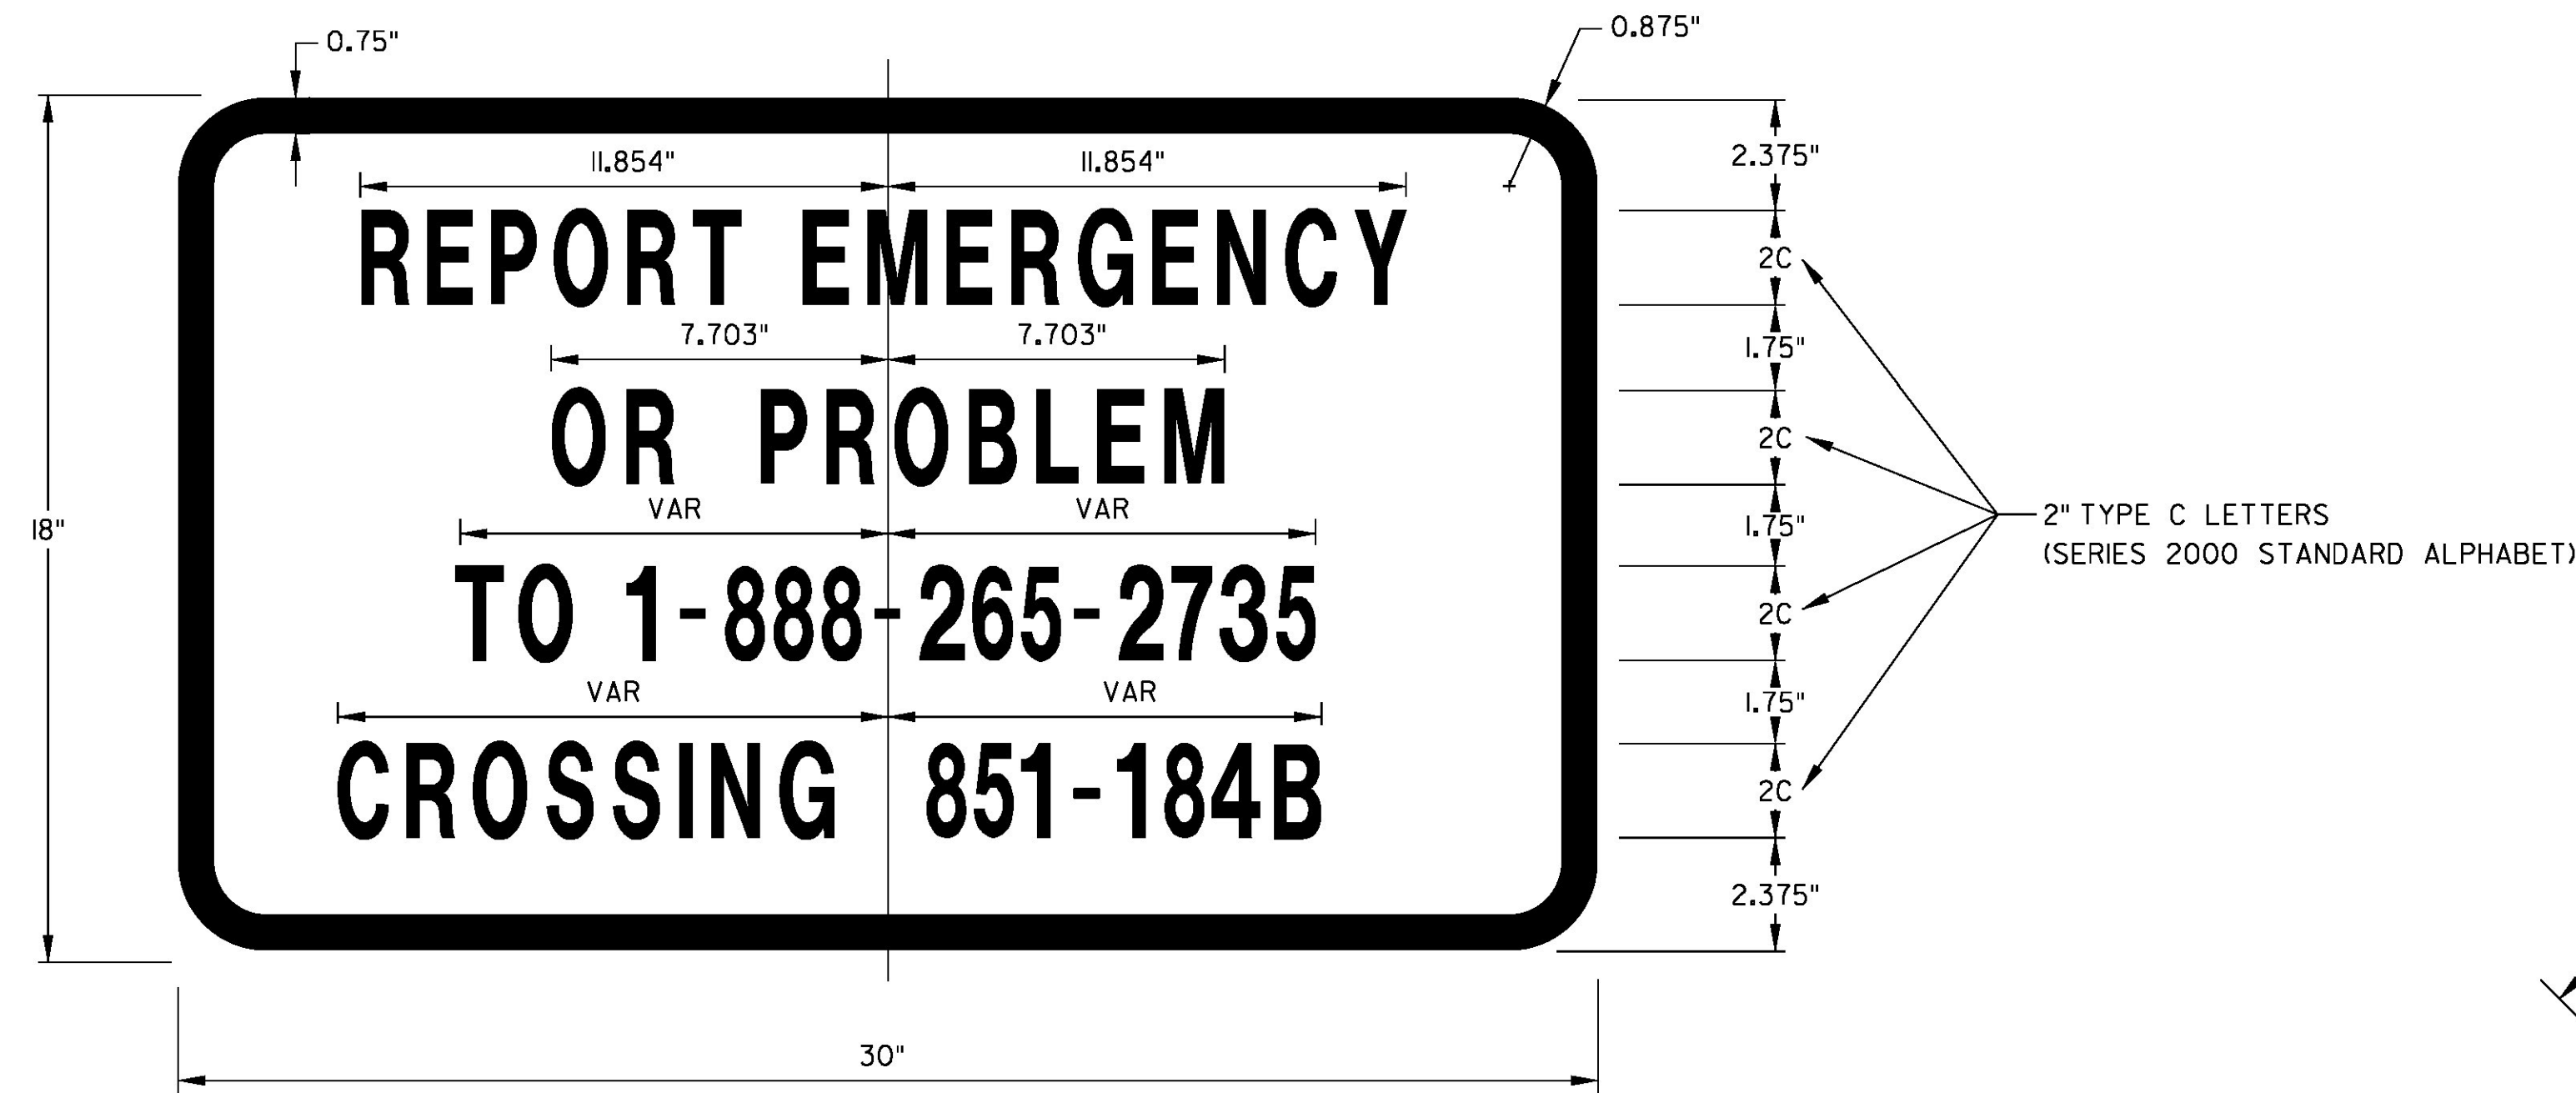


I-13 SIGN

<b>COLORS:</b>	LEGEND	WHITE	(RETROREFLECTIVE)
	BACKGROUND	BLUE	(RETROREFLECTIVE)

NOTES:

- THE EMERGENCY CONTACT TELEPHONE NUMBER IS 1-888-265-2735, THE CROSSING NUMBER IS 851-184B ON E. ARLINGTON ROAD.
- PLACE THREE I-13 SIGNS AT EACH CROSSING, ONE ON EACH SIDE OF THE CROSSING AND ONE ON THE SIGNAL CASE OR HOUSE.

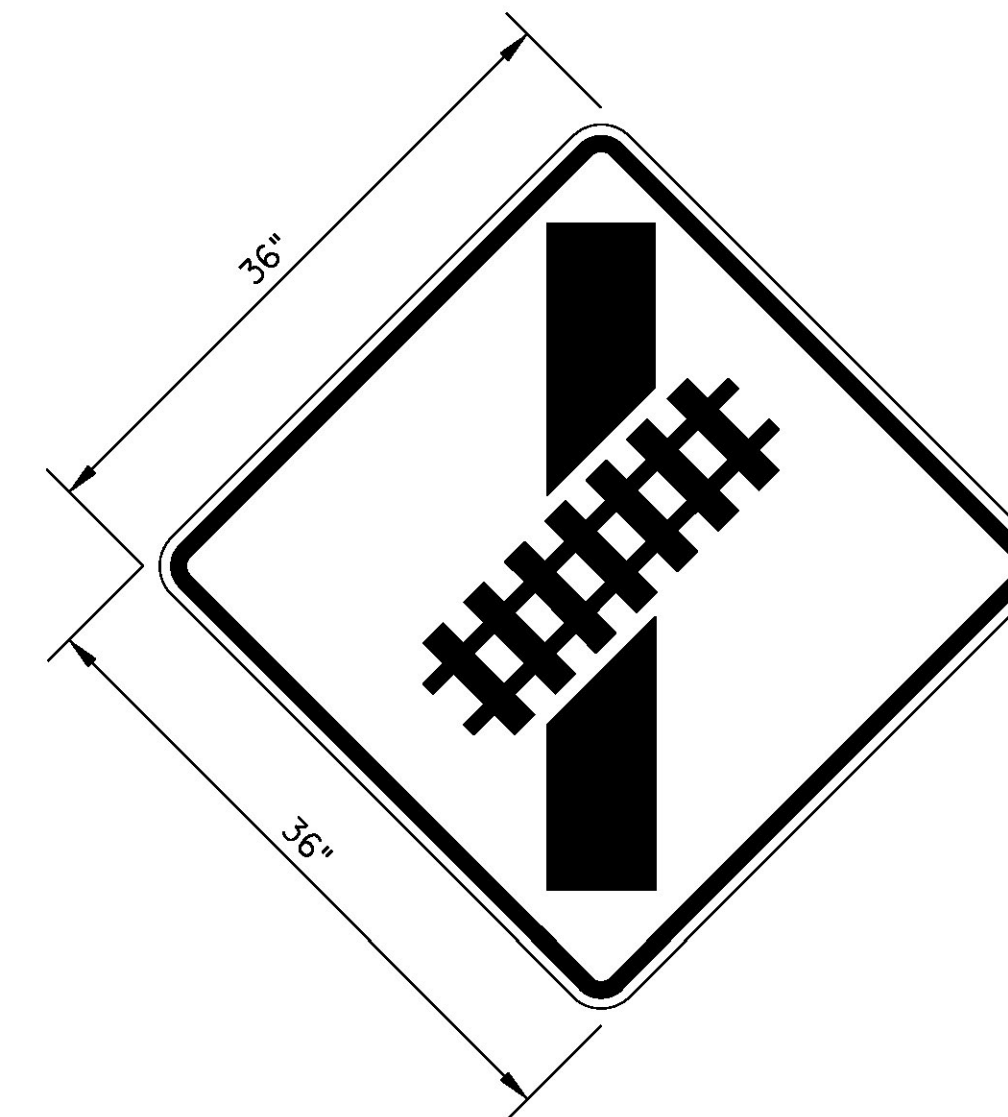


W10-12 SIGN

NTS


<b>COLORS:</b>	LEGEND	BLACK
	BACKGROUND	YELLOW (RETROREFLECTIVE)

PROJECT NAME: ARLINGTON  
PROJECT NUMBER: STP 0114 (4)


FILE NAME: z09g052rrdetails.dgn	PLOT DATE: 2/5/2016
PROJECT LEADER: J. READ	DRAWN BY: LB
DESIGNED BY: ABR	CHECKED BY: J. READ
SIGN DETAILS	SHEET 19 OF 27

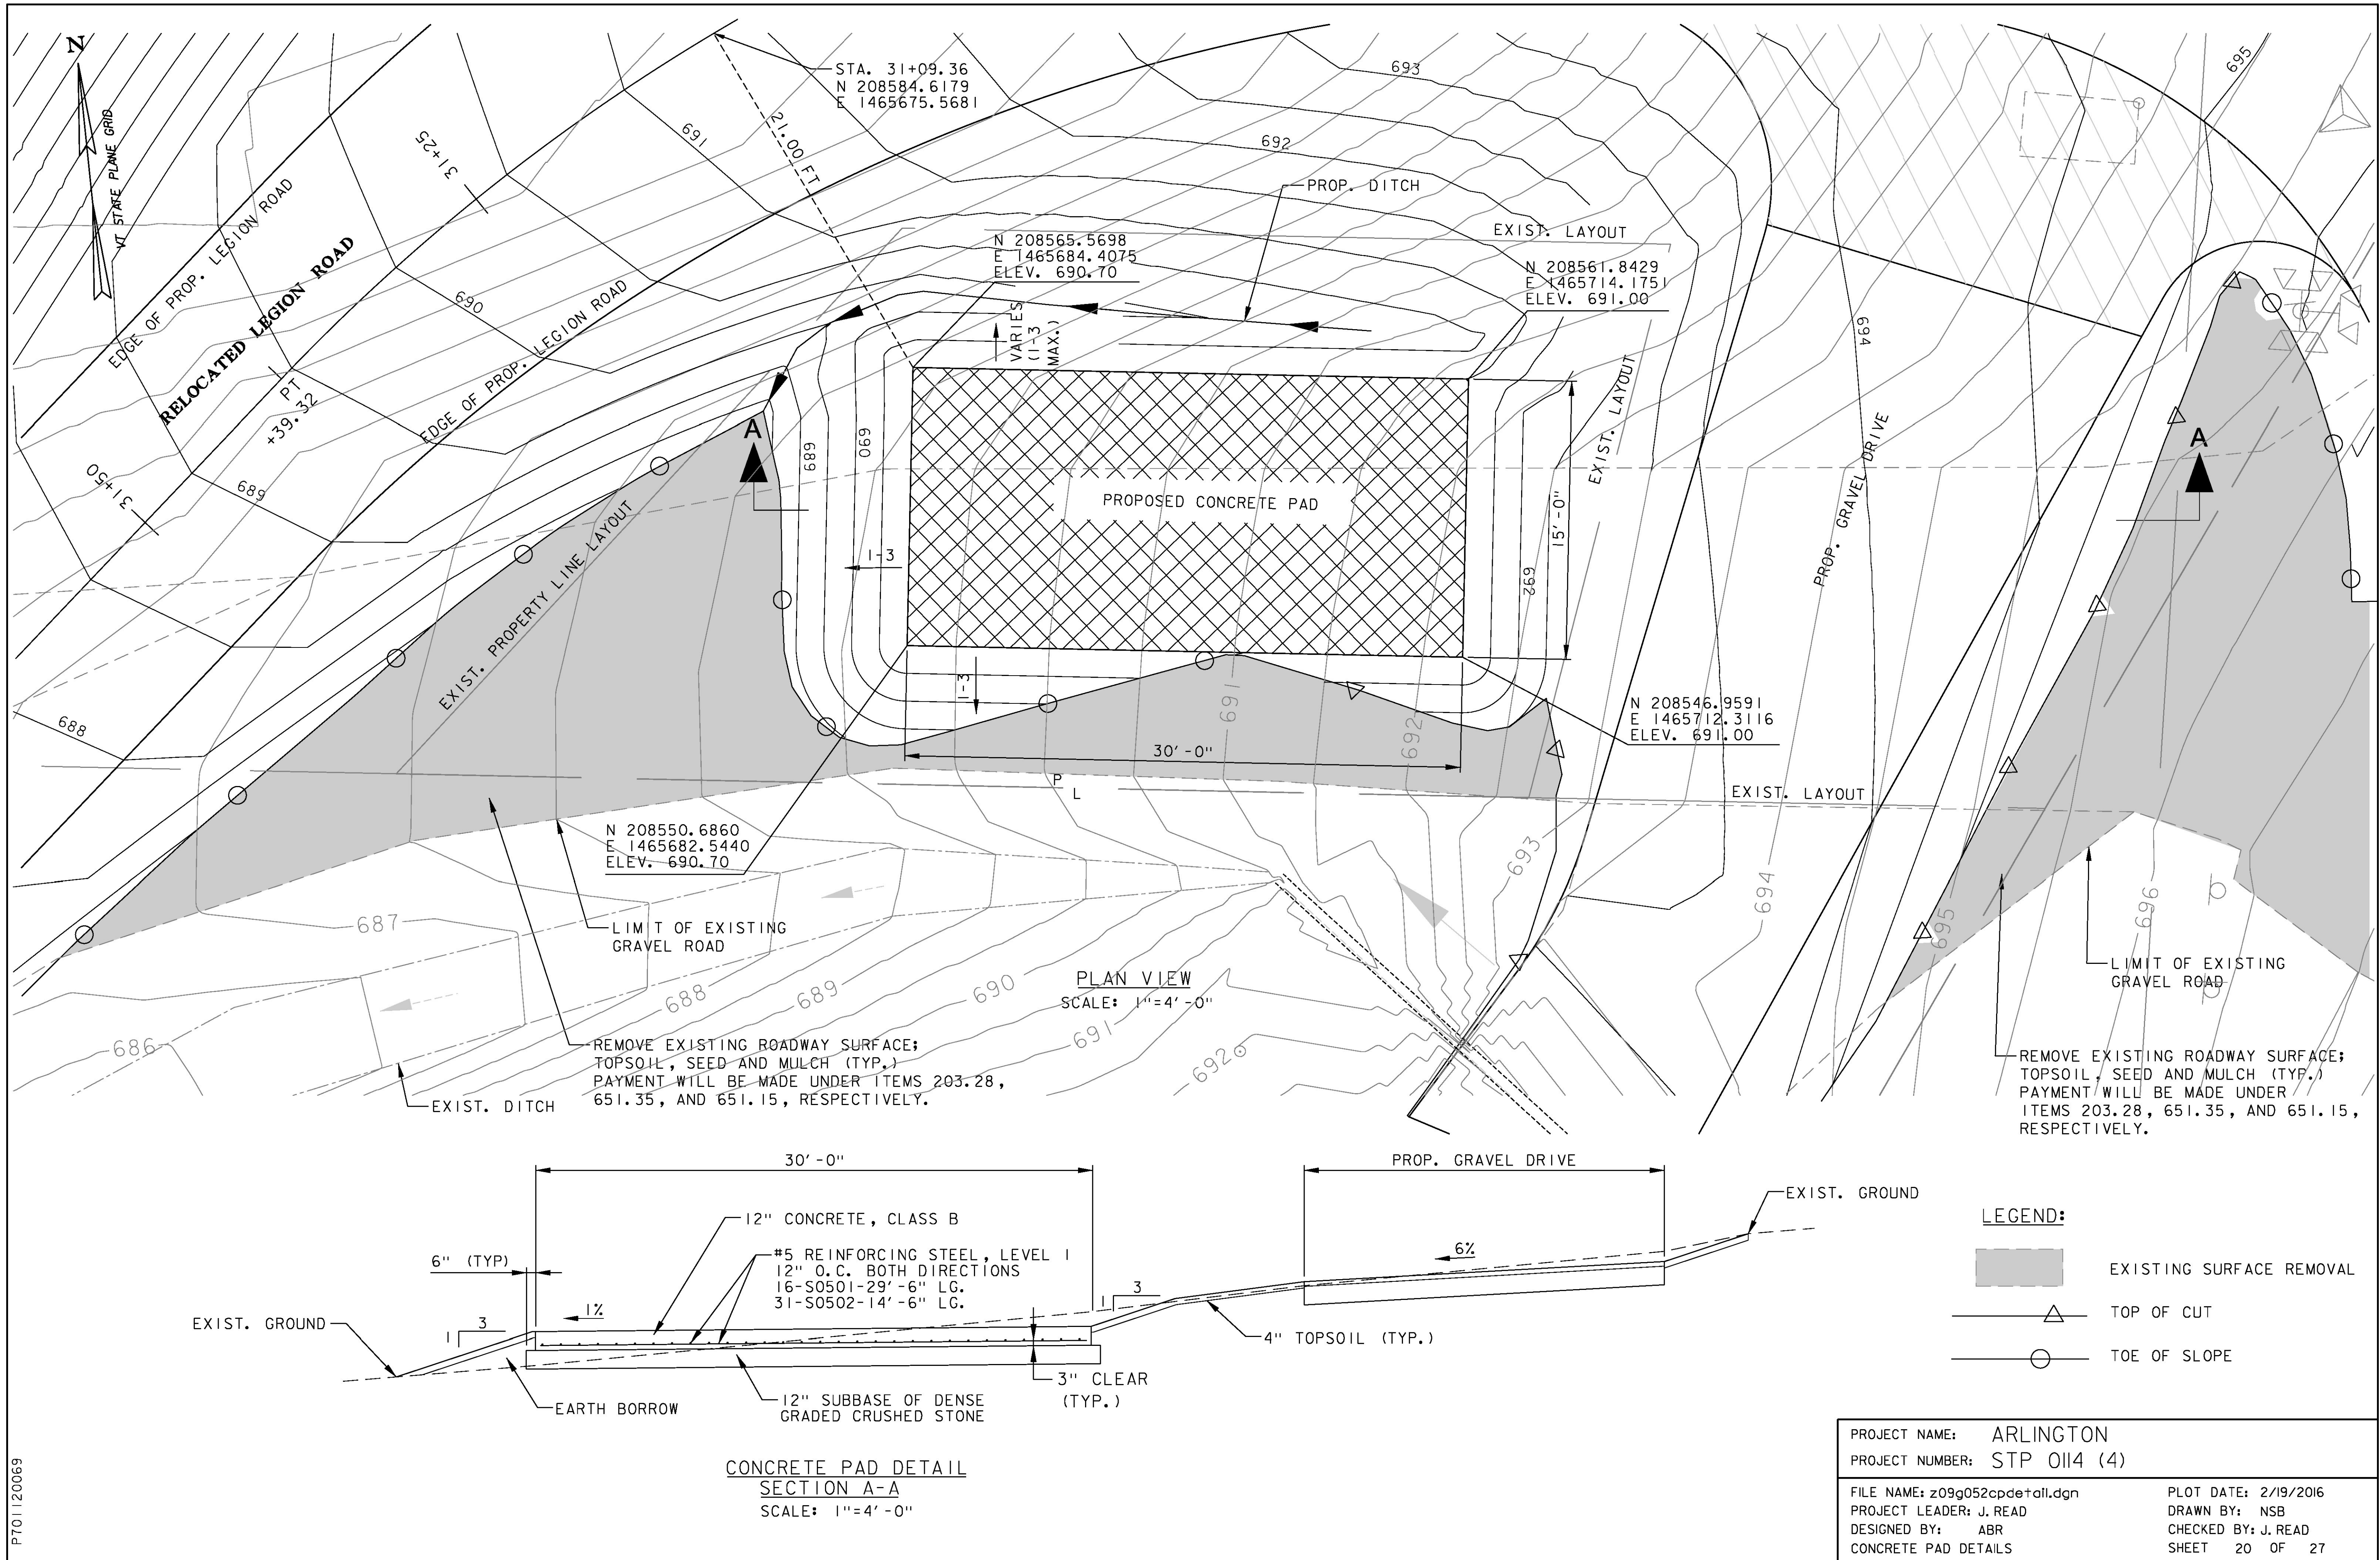


P701120069

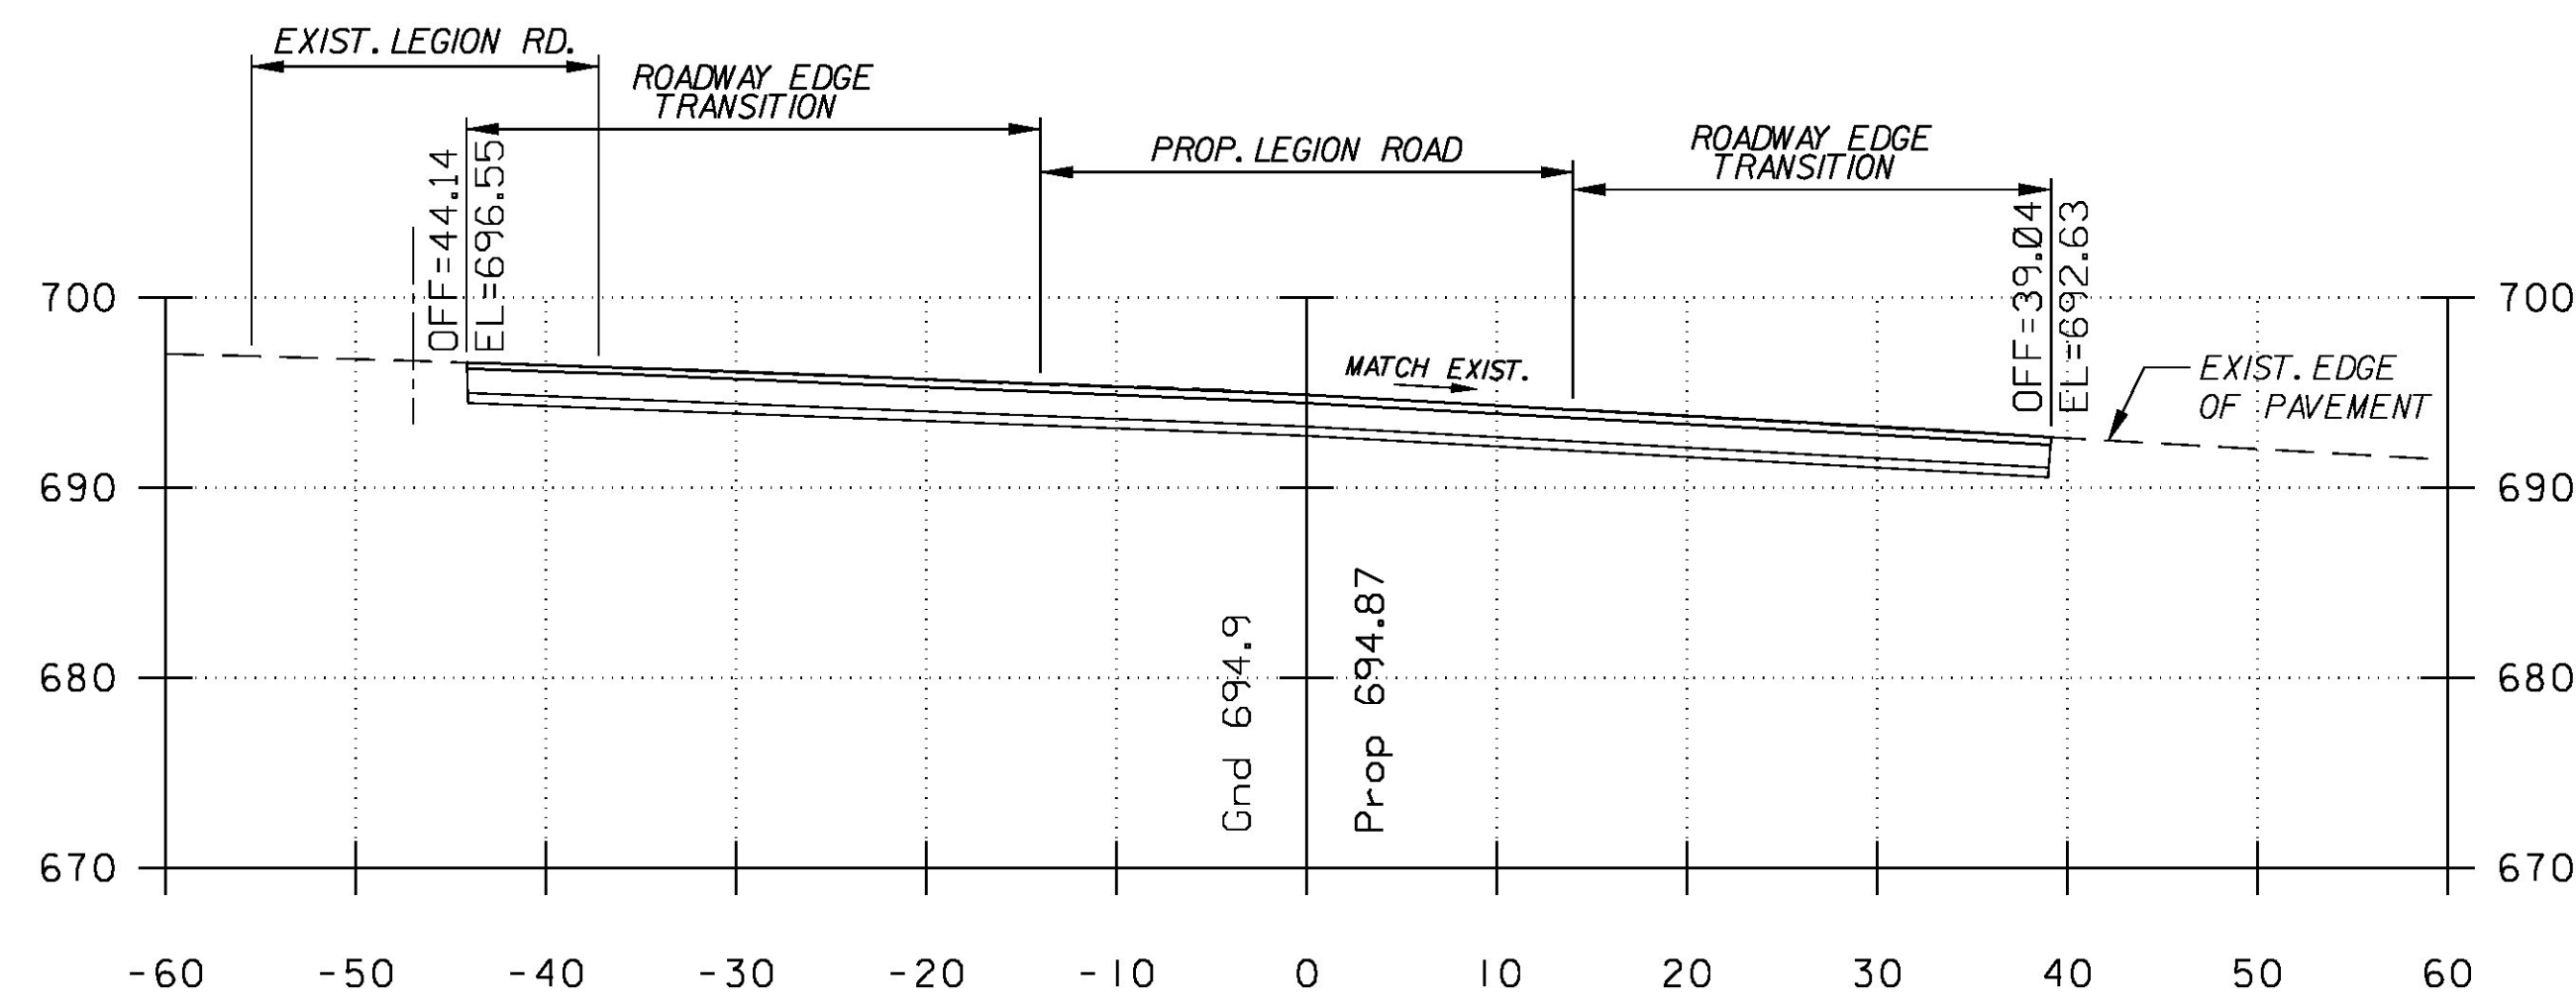


30+11.52 EDGE OF E. ARLINGTON ROAD

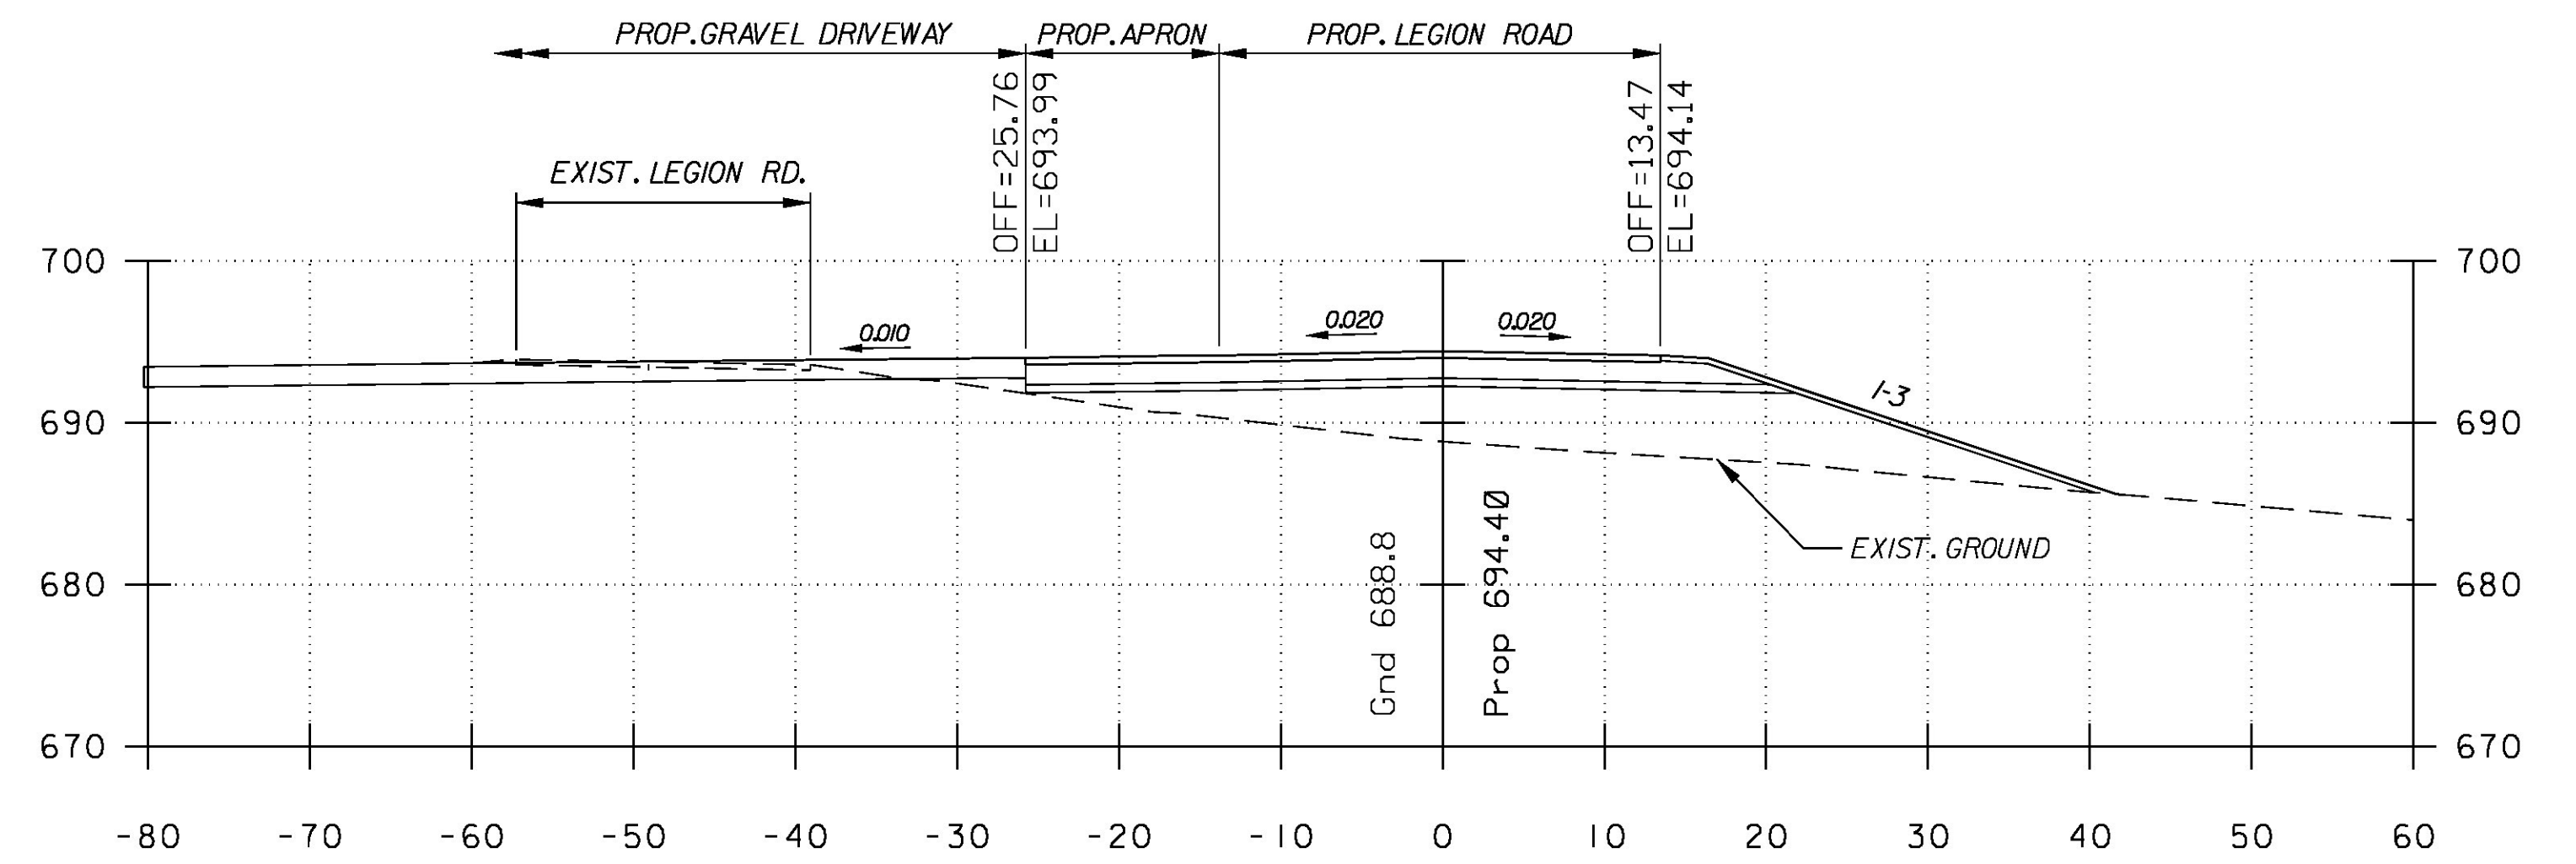


30+50

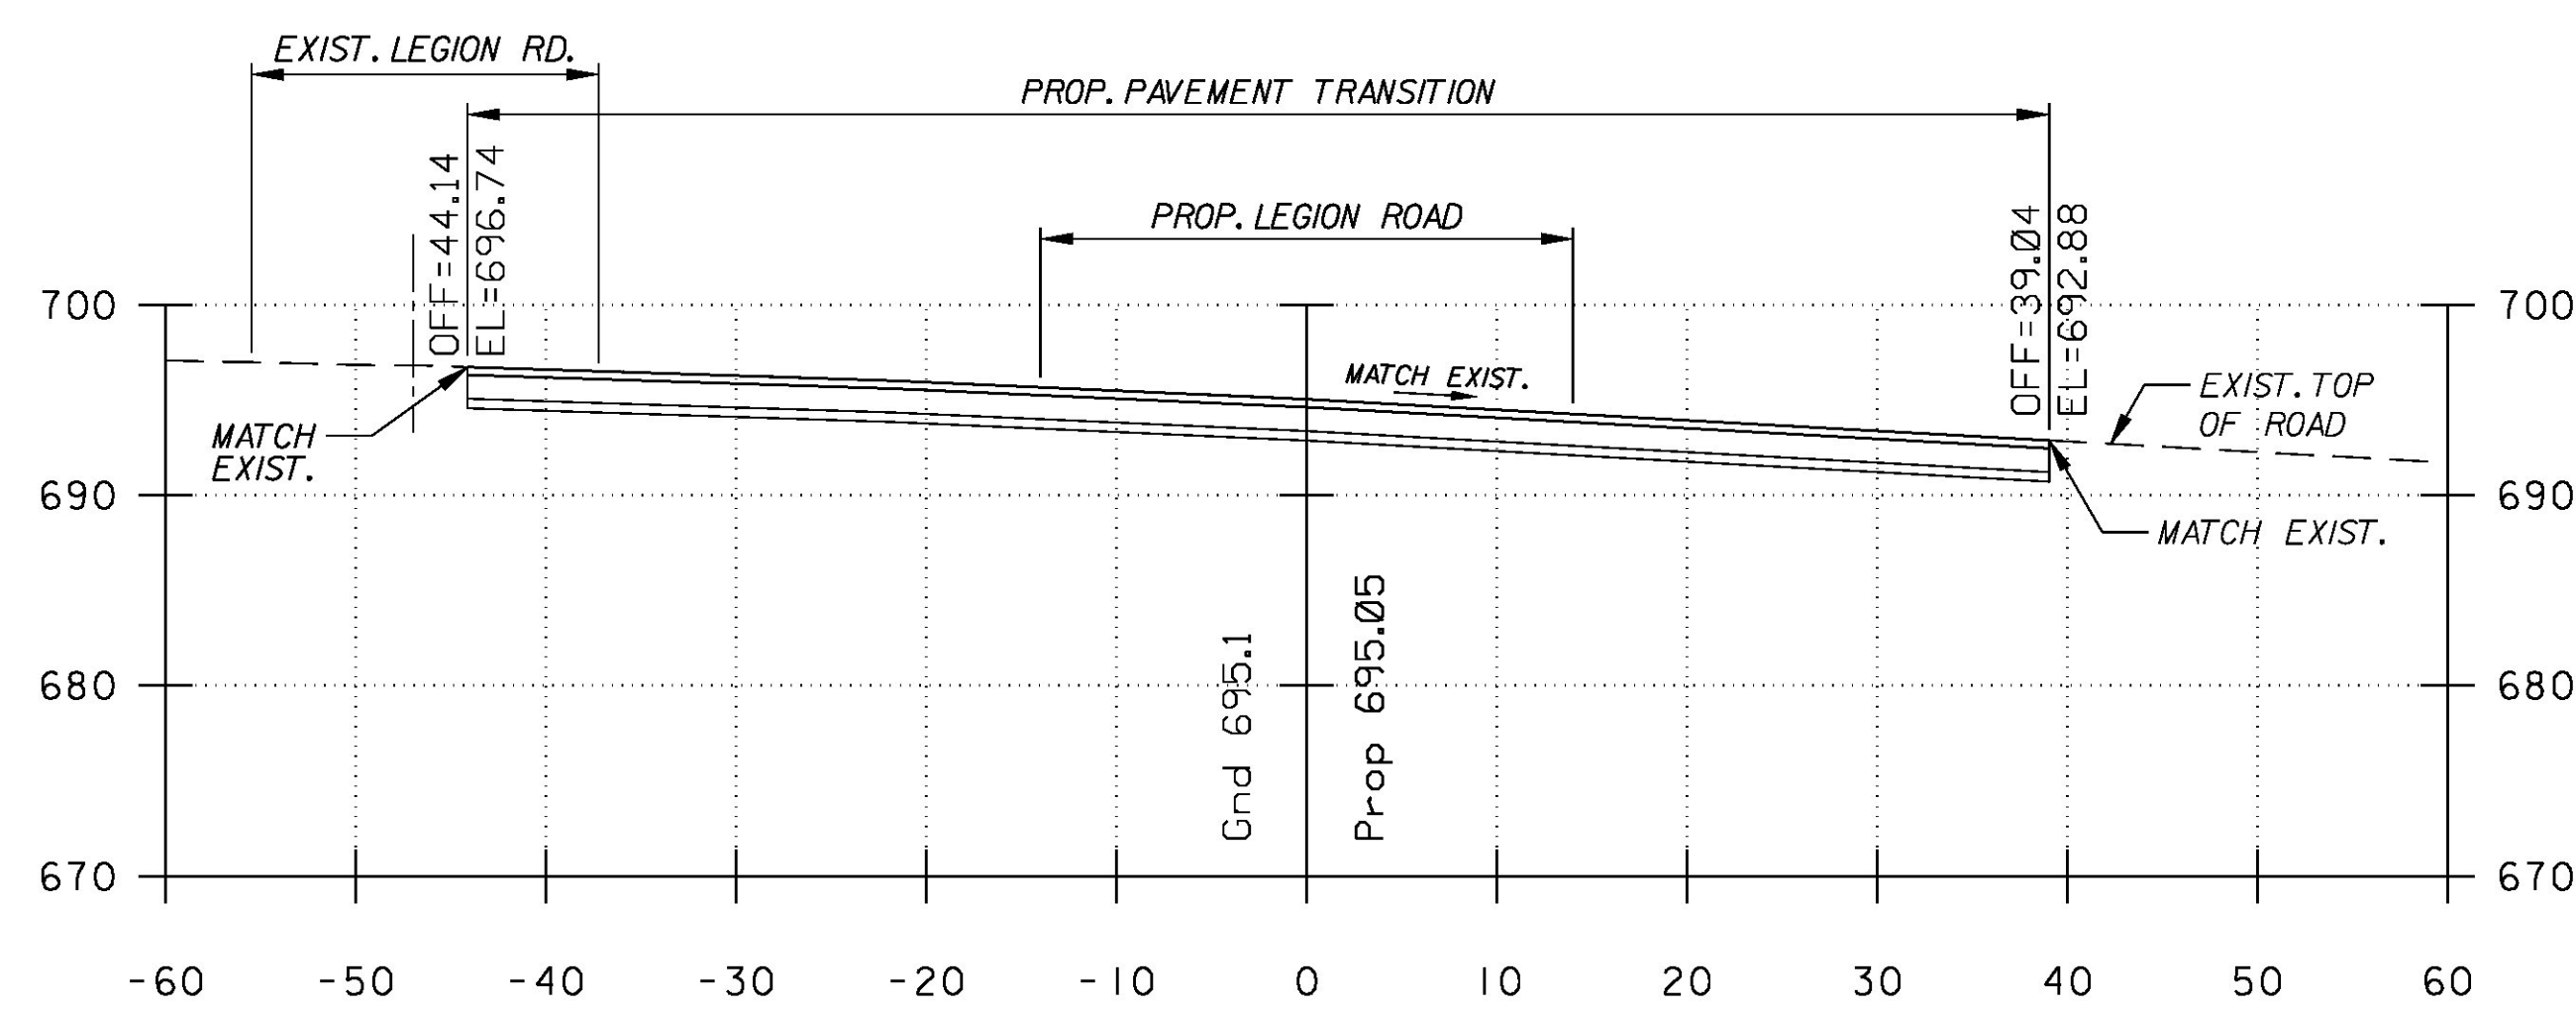


30+07 BEGIN PROJECT

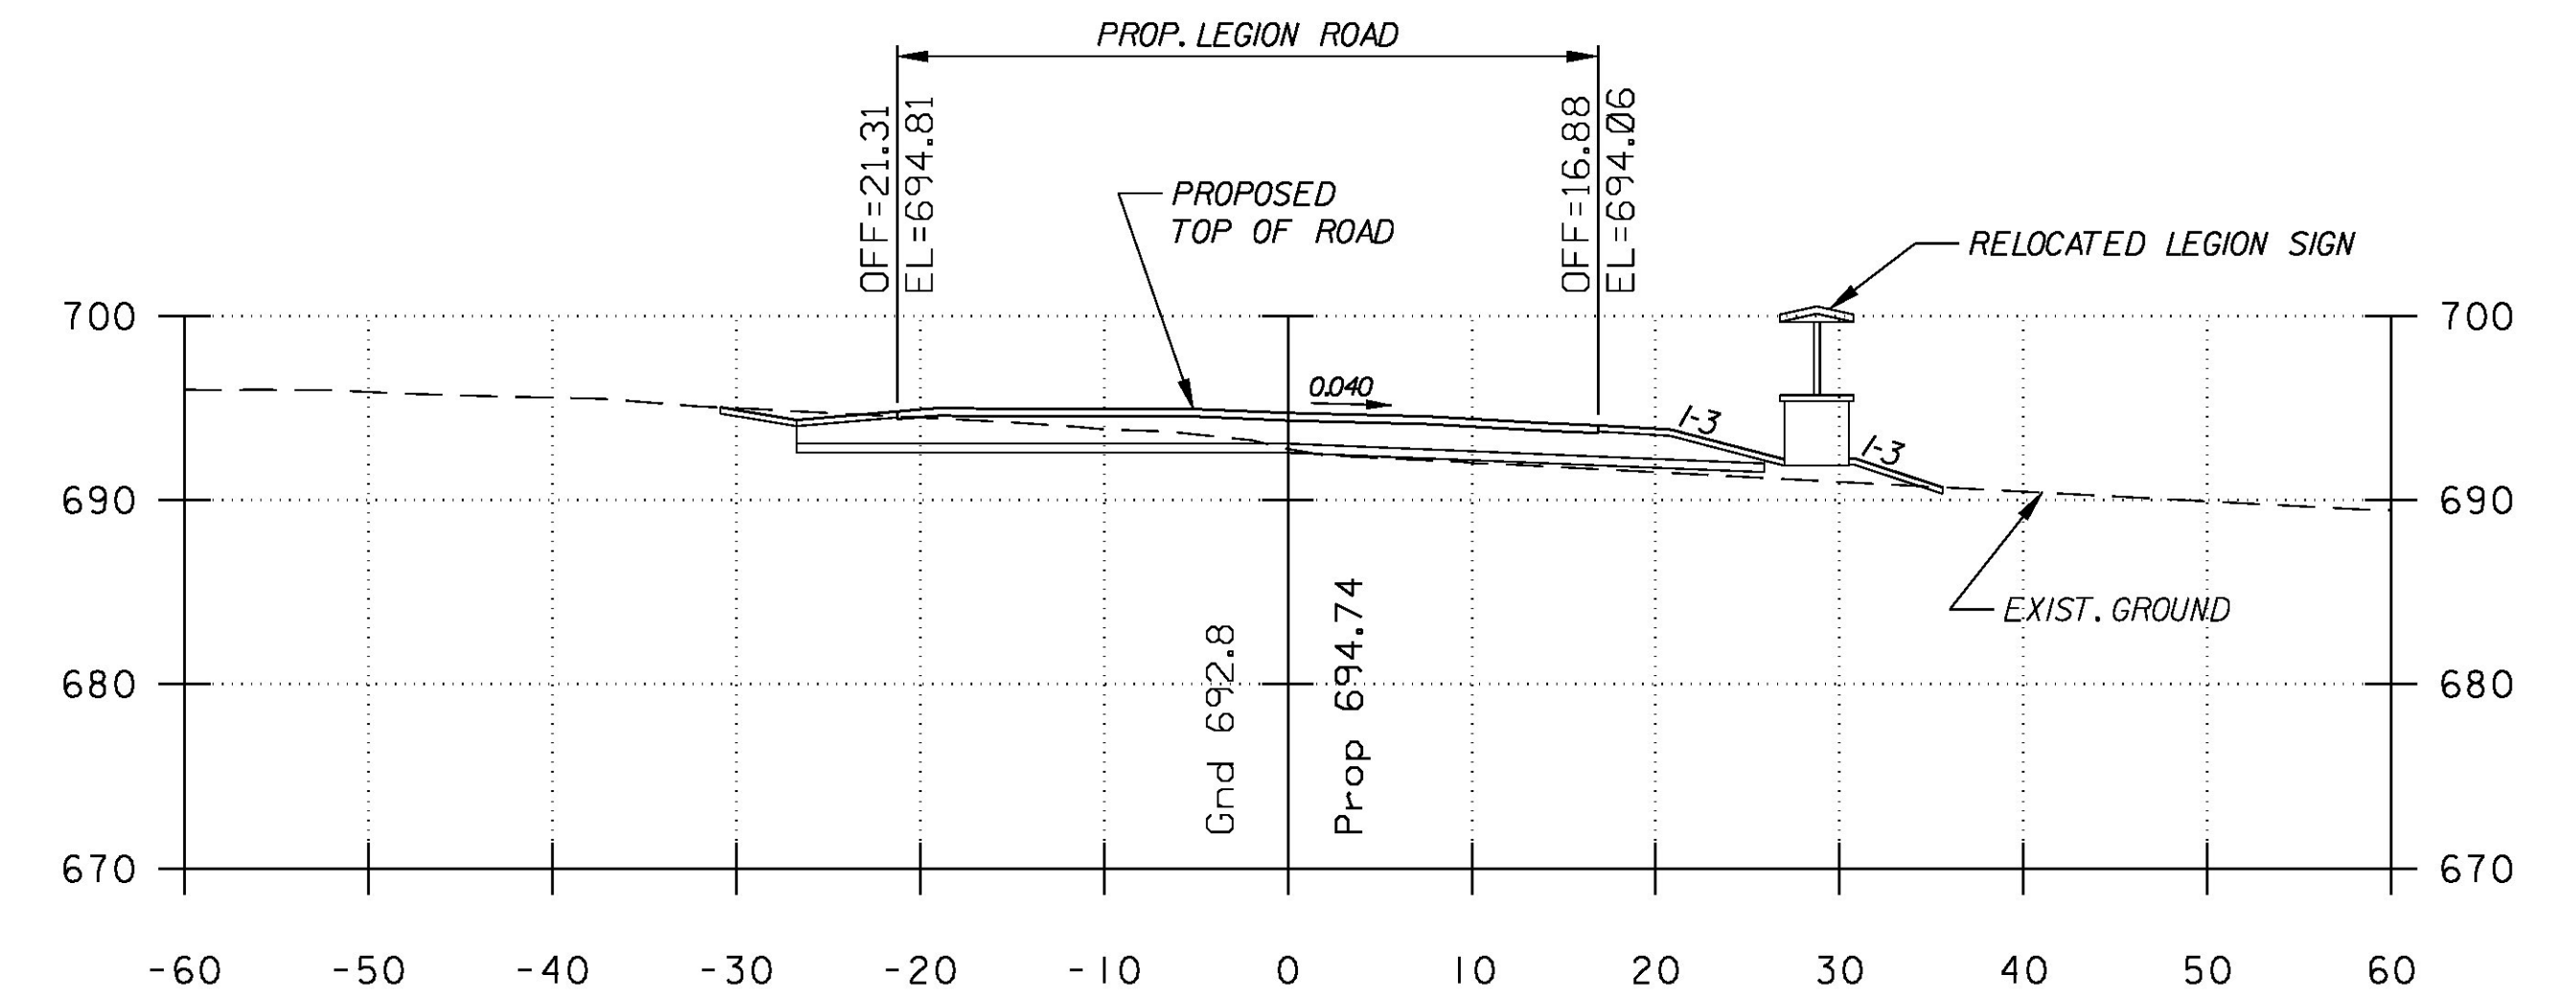

30+25

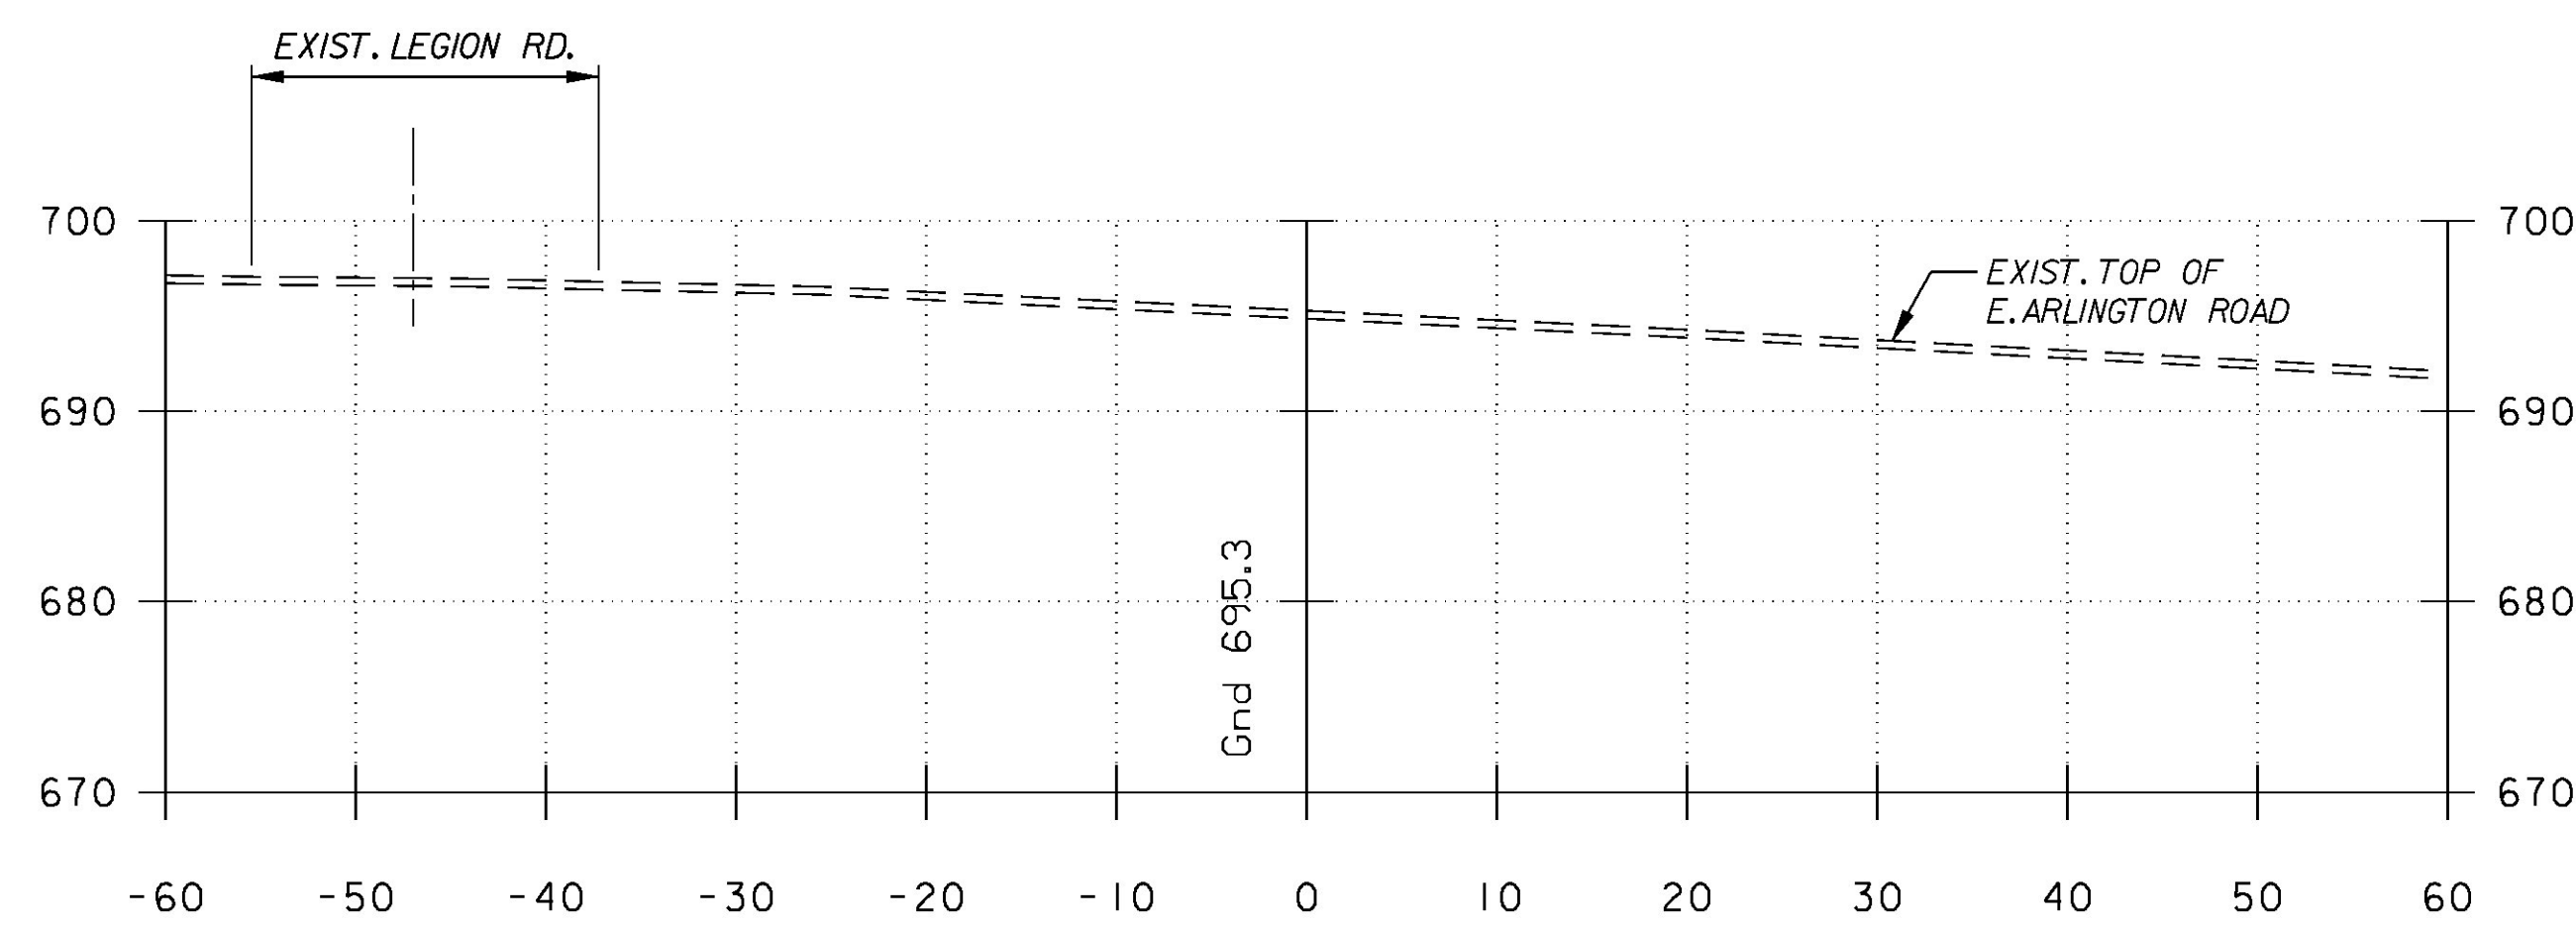

30+00 BEGIN APPROACH

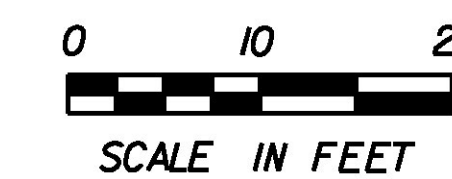


STA. 30+00 - 30+50


PROJECT NAME: ARLINGTON  
PROJECT NUMBER: STP 0114 (4)

FILE NAME: z09g052xsl.dgn  
PROJECT LEADER: A. RIEGER  
DESIGNED BY: LB  
CROSS SECTIONS - 1


PLOT DATE: 2/5/2016  
DRAWN BY: LB  
CHECKED BY: J. READ  
SHEET 21 OF 27

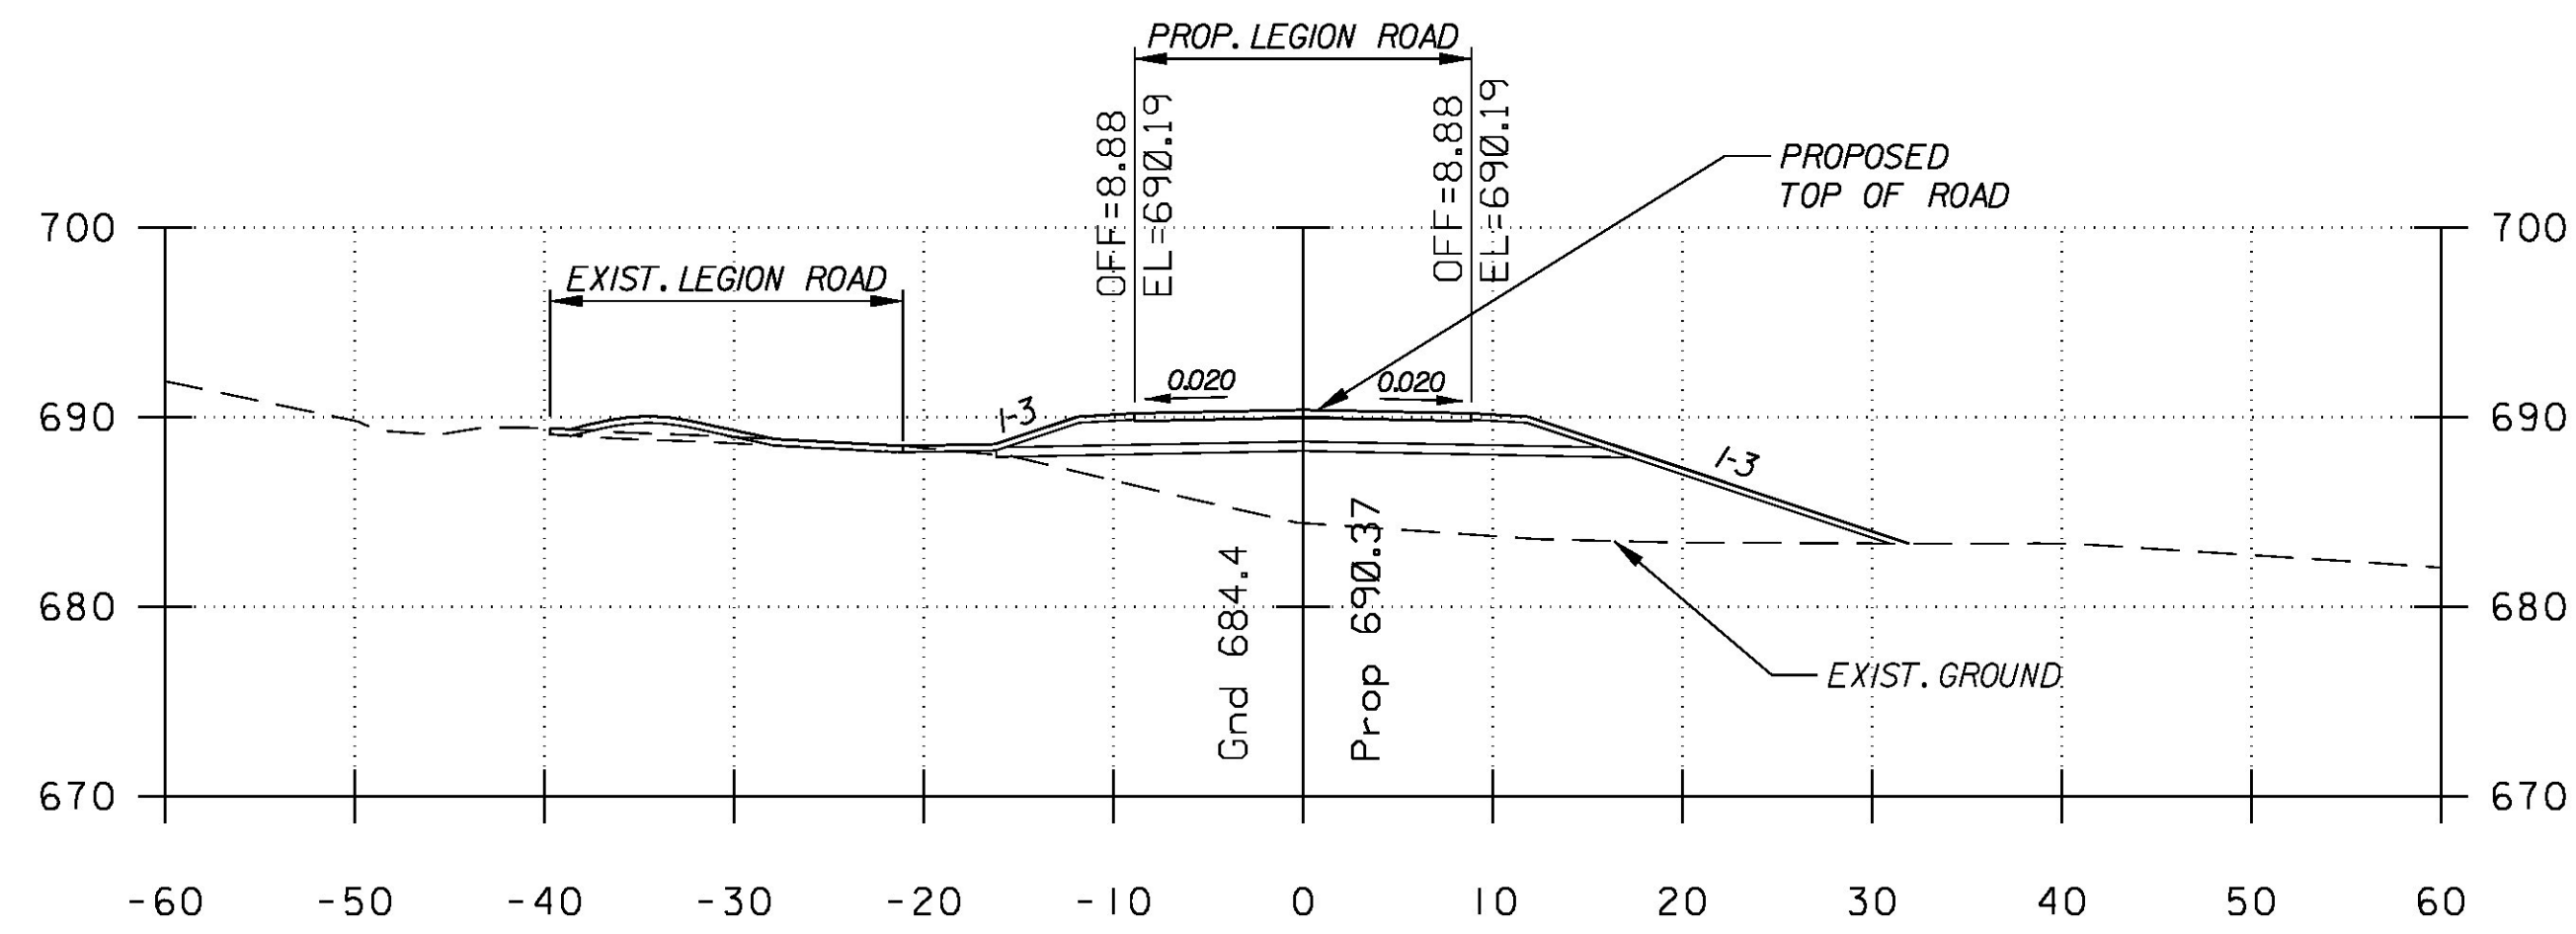


31+25

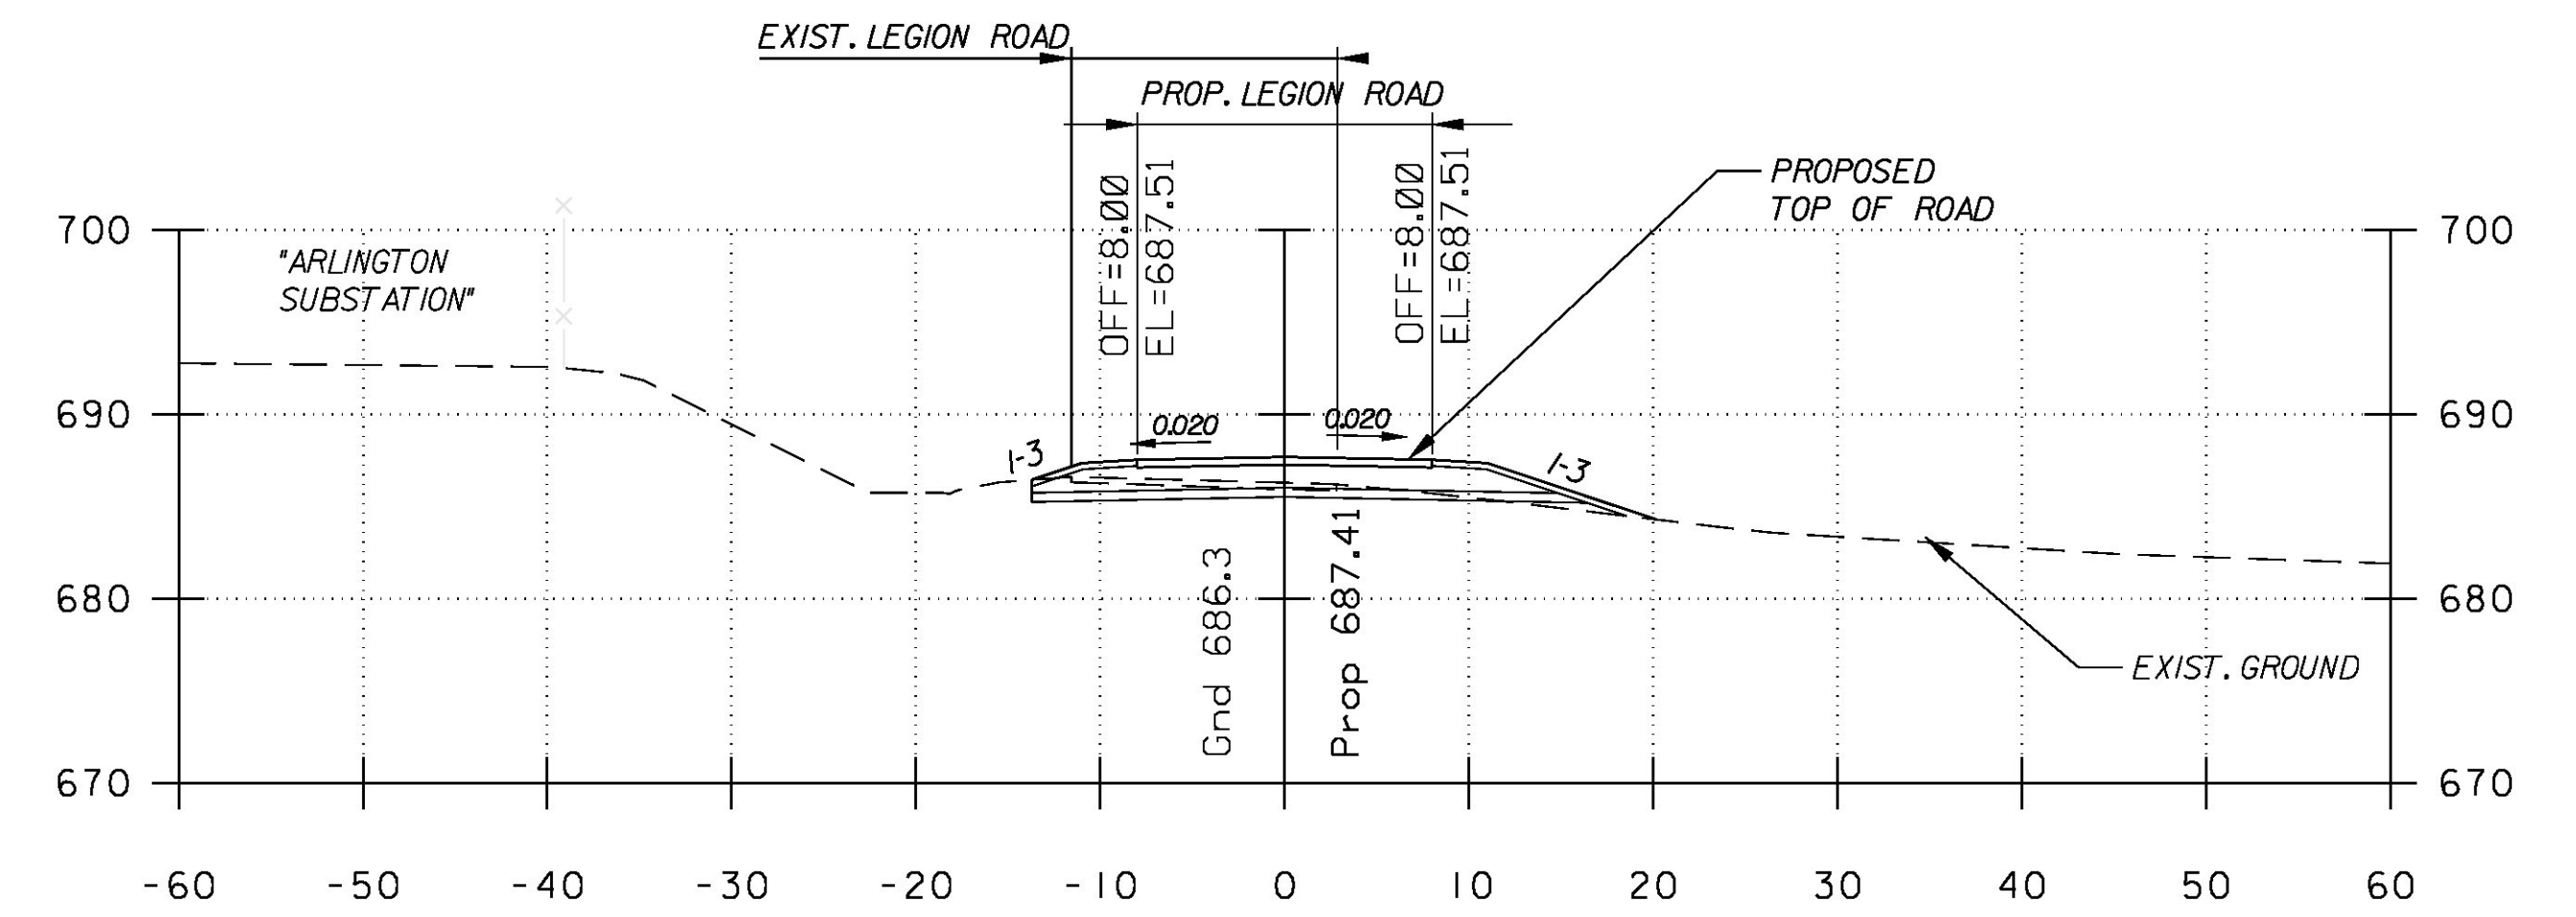


31+75

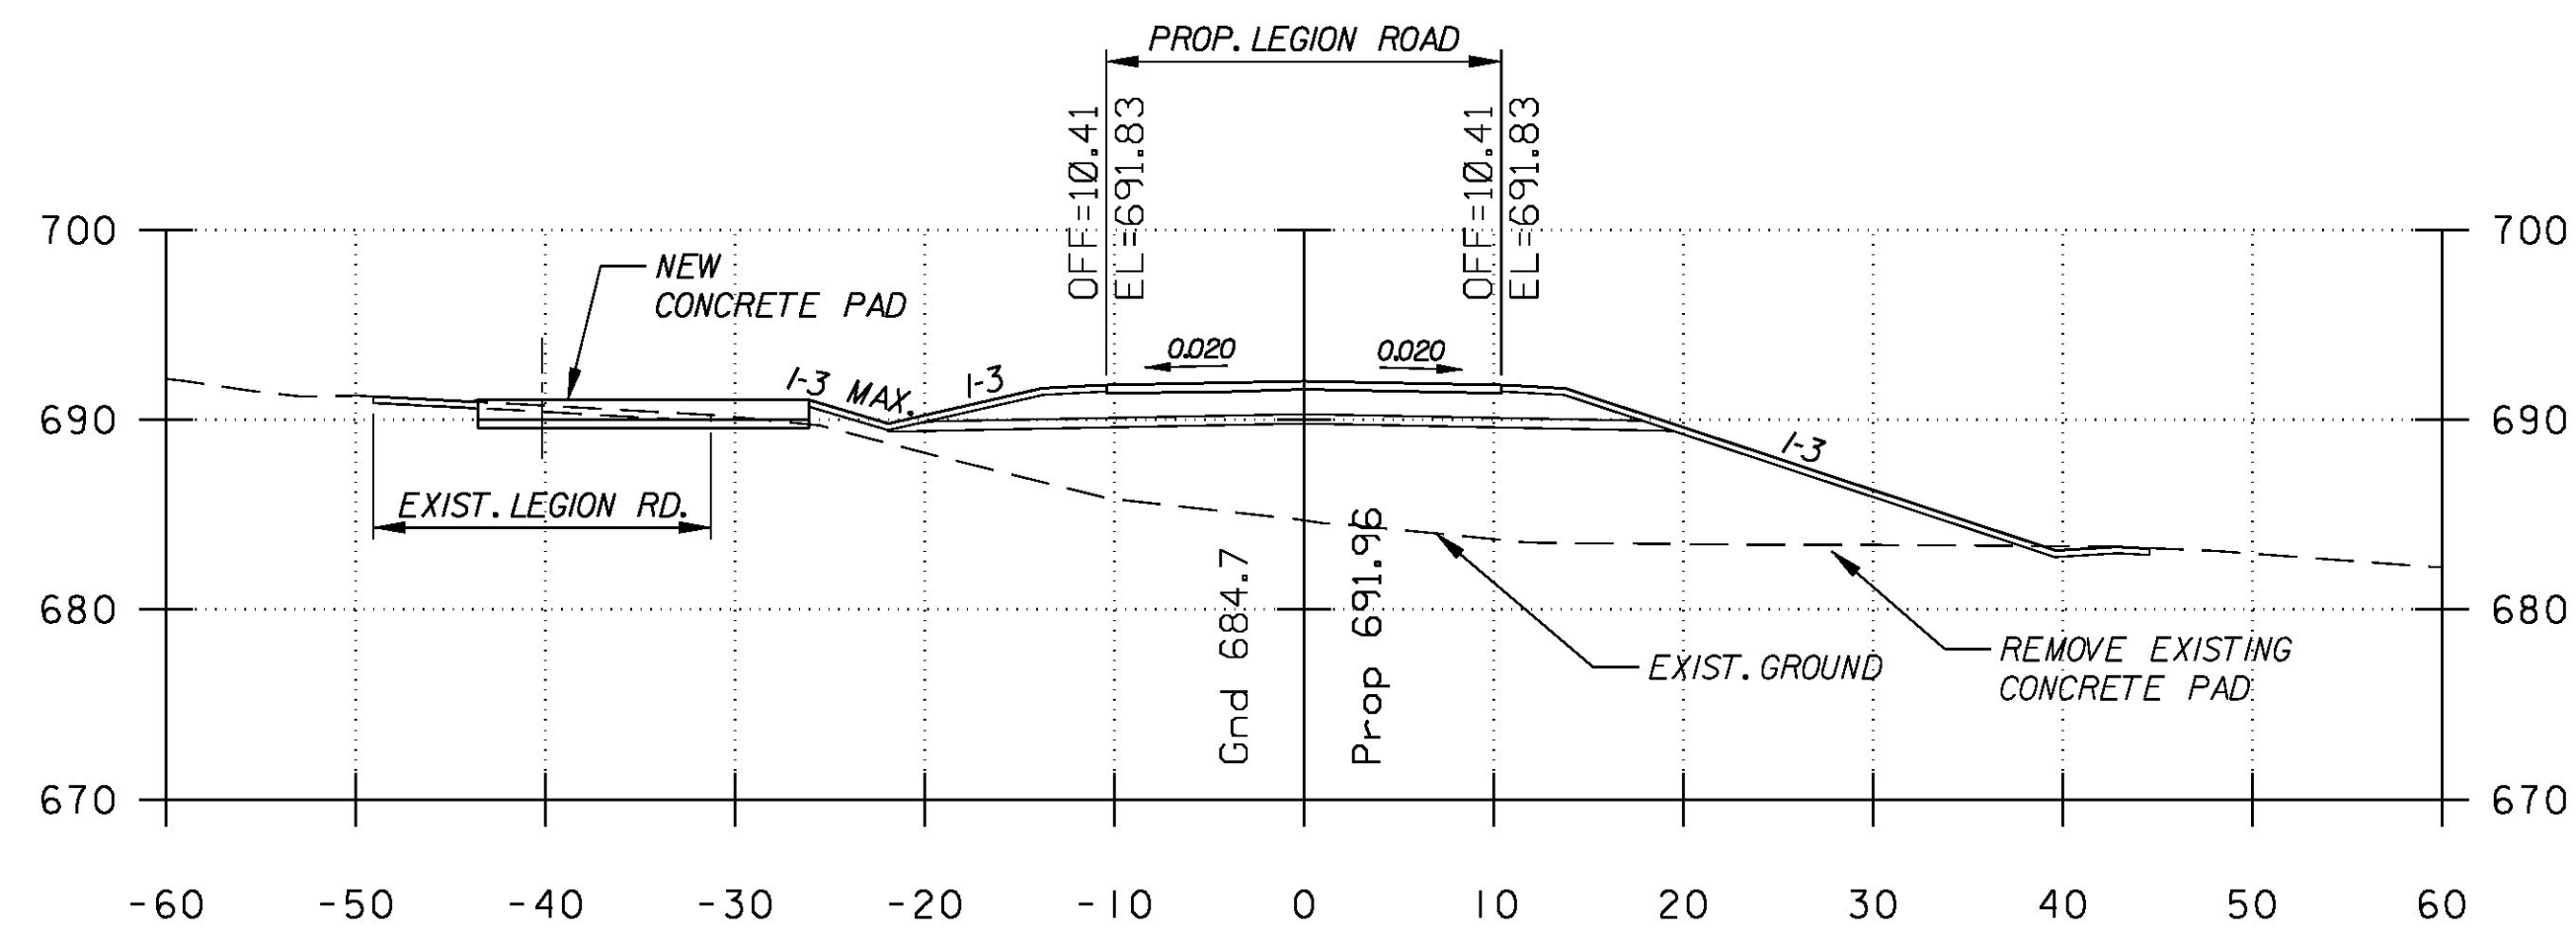


31+00

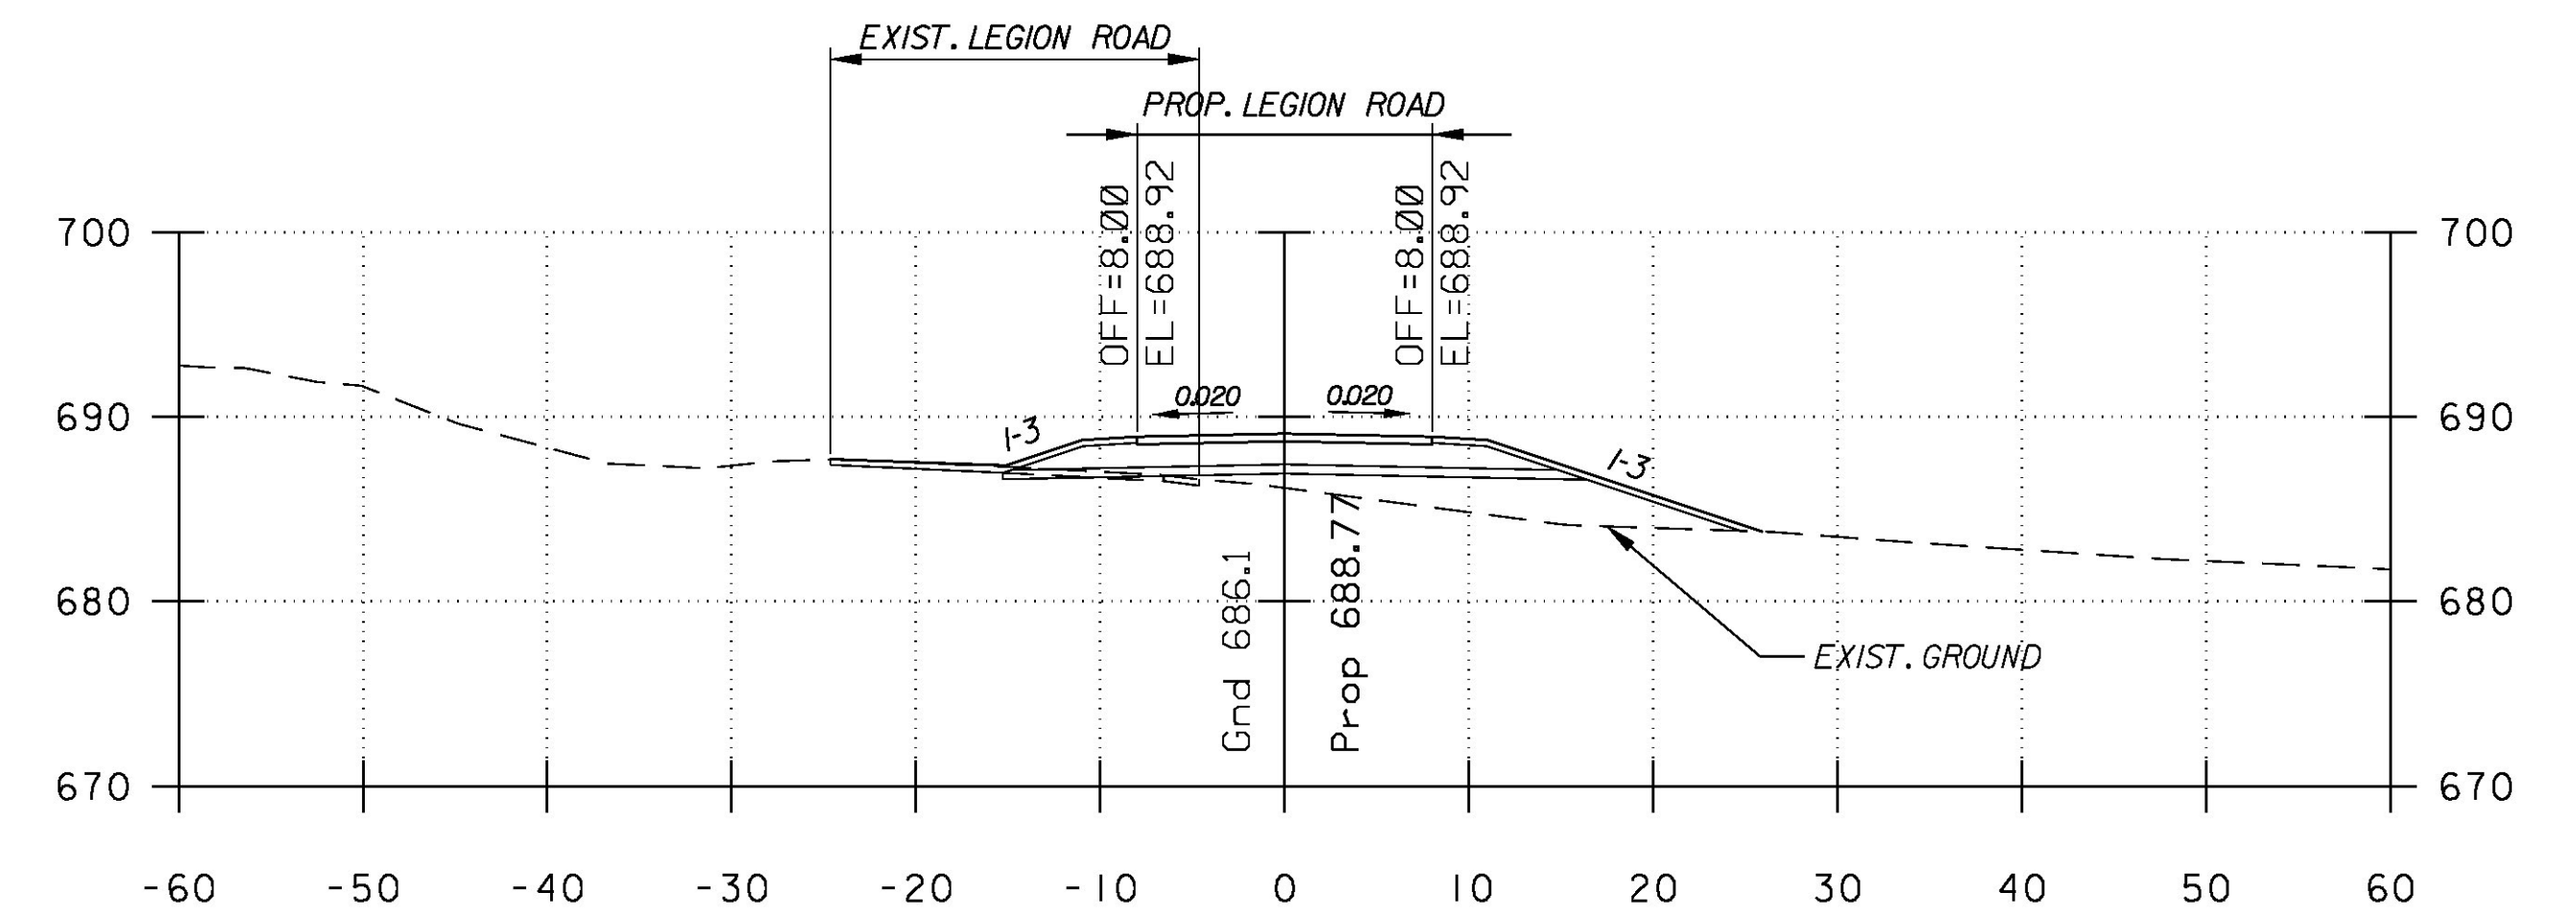

31+50

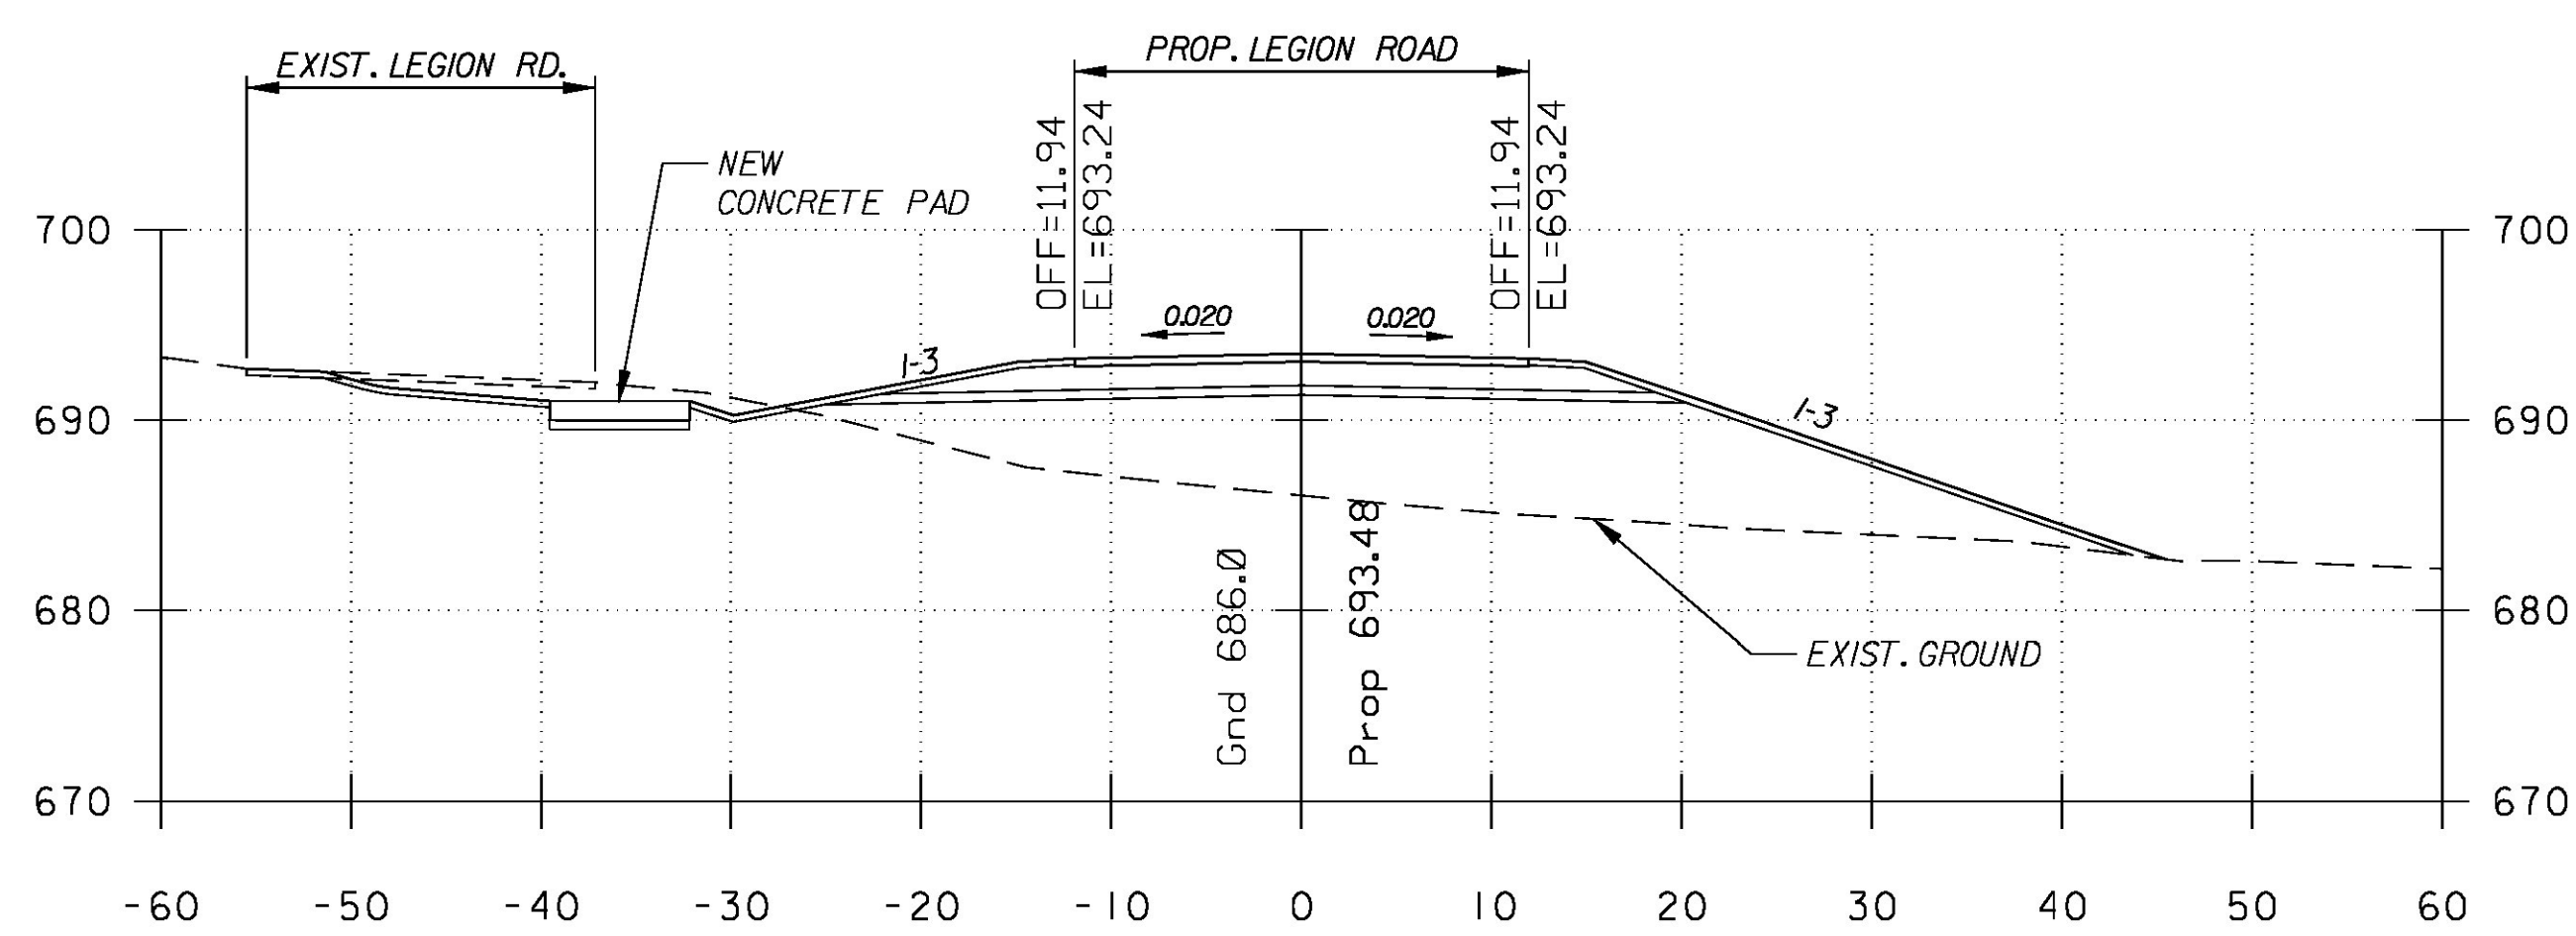


30+75

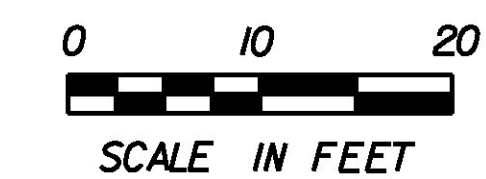


STA. 30+75 - 31+75


PROJECT NAME:	ARLINGTON	PLOT DATE:	2/5/2016
PROJECT NUMBER:	STP 0114 (4)	DRAWN BY:	LB
FILE NAME:	z09g052xsl.dgn	CHECKED BY:	J. READ
PROJECT LEADER:	J. READ	CROSS SECTIONS -	2
DESIGNED BY:	ABR	SHEET	22 OF 27

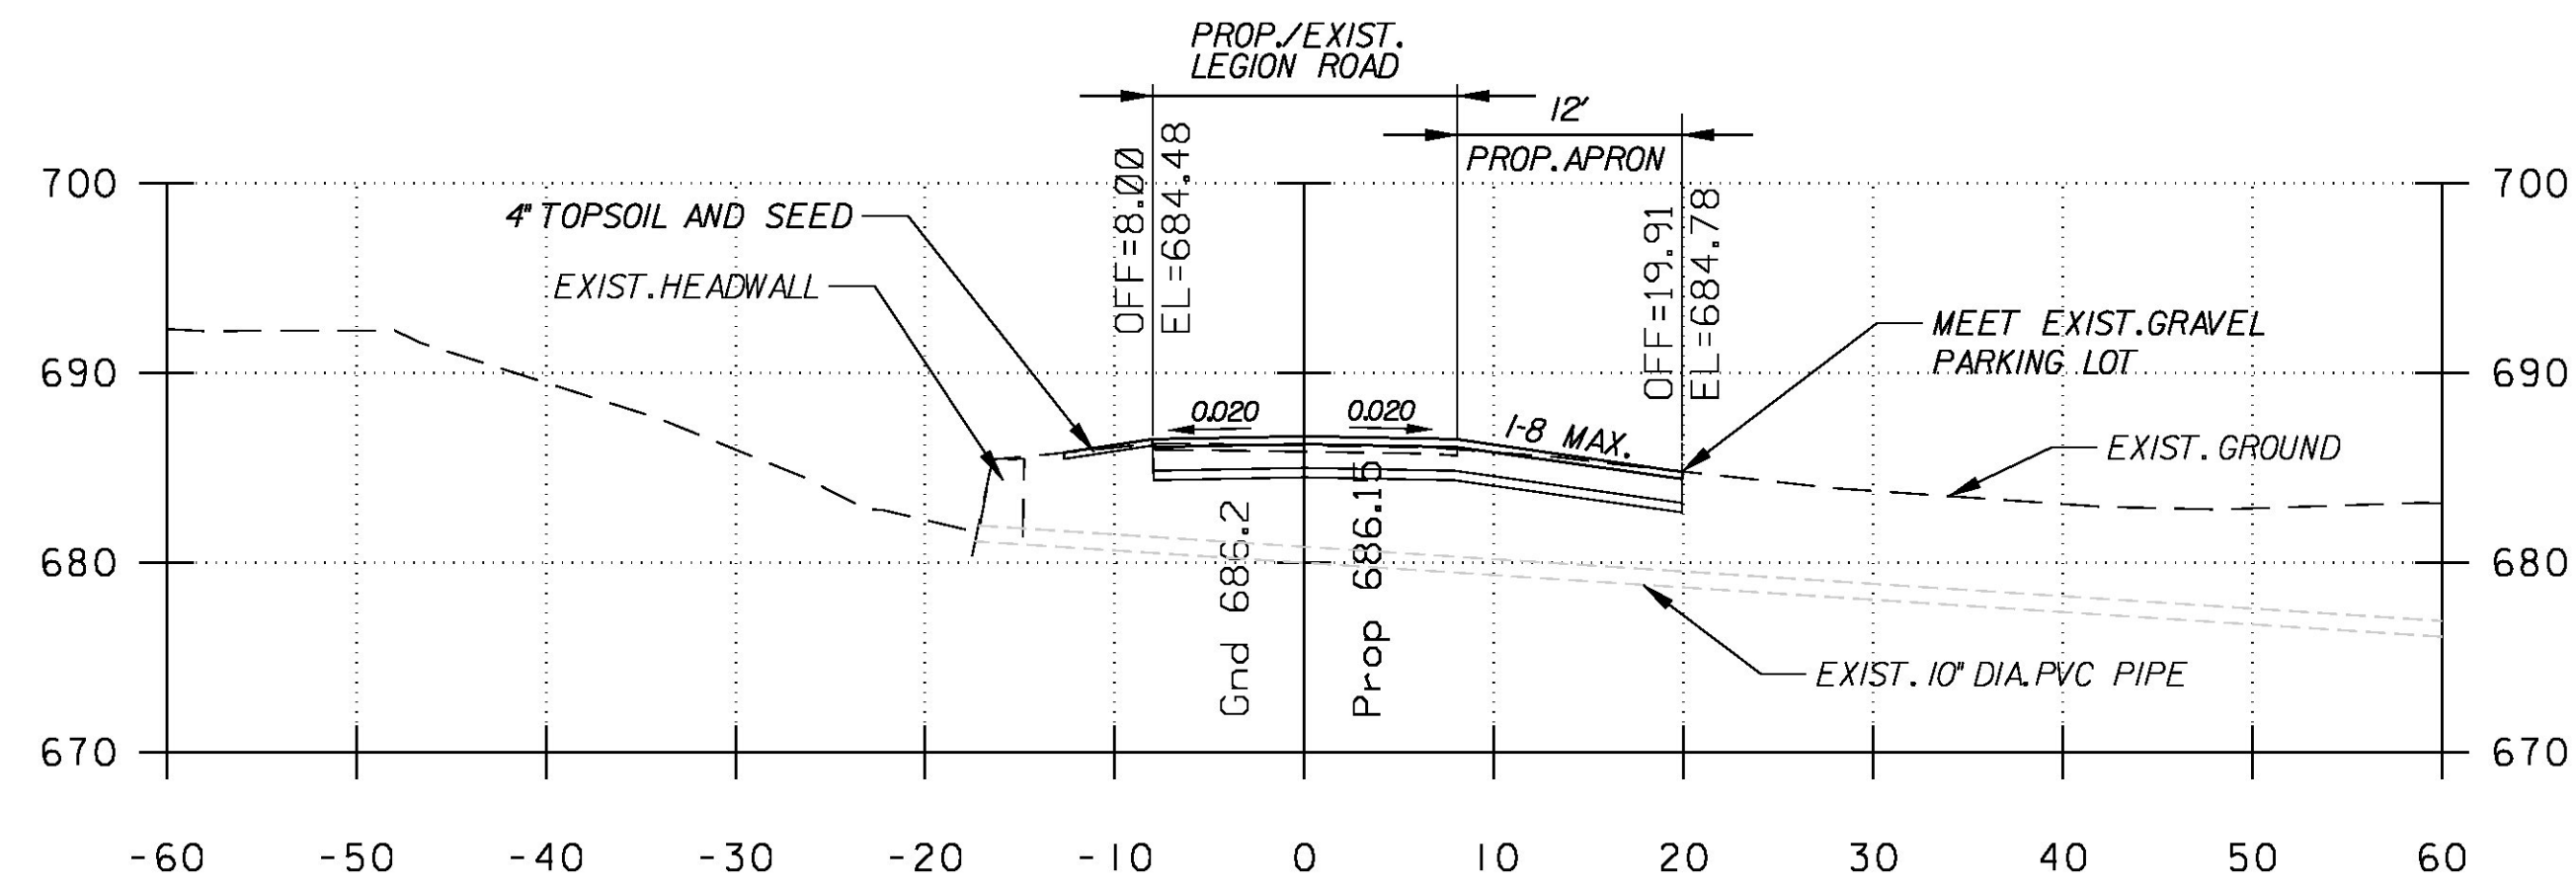


32+25

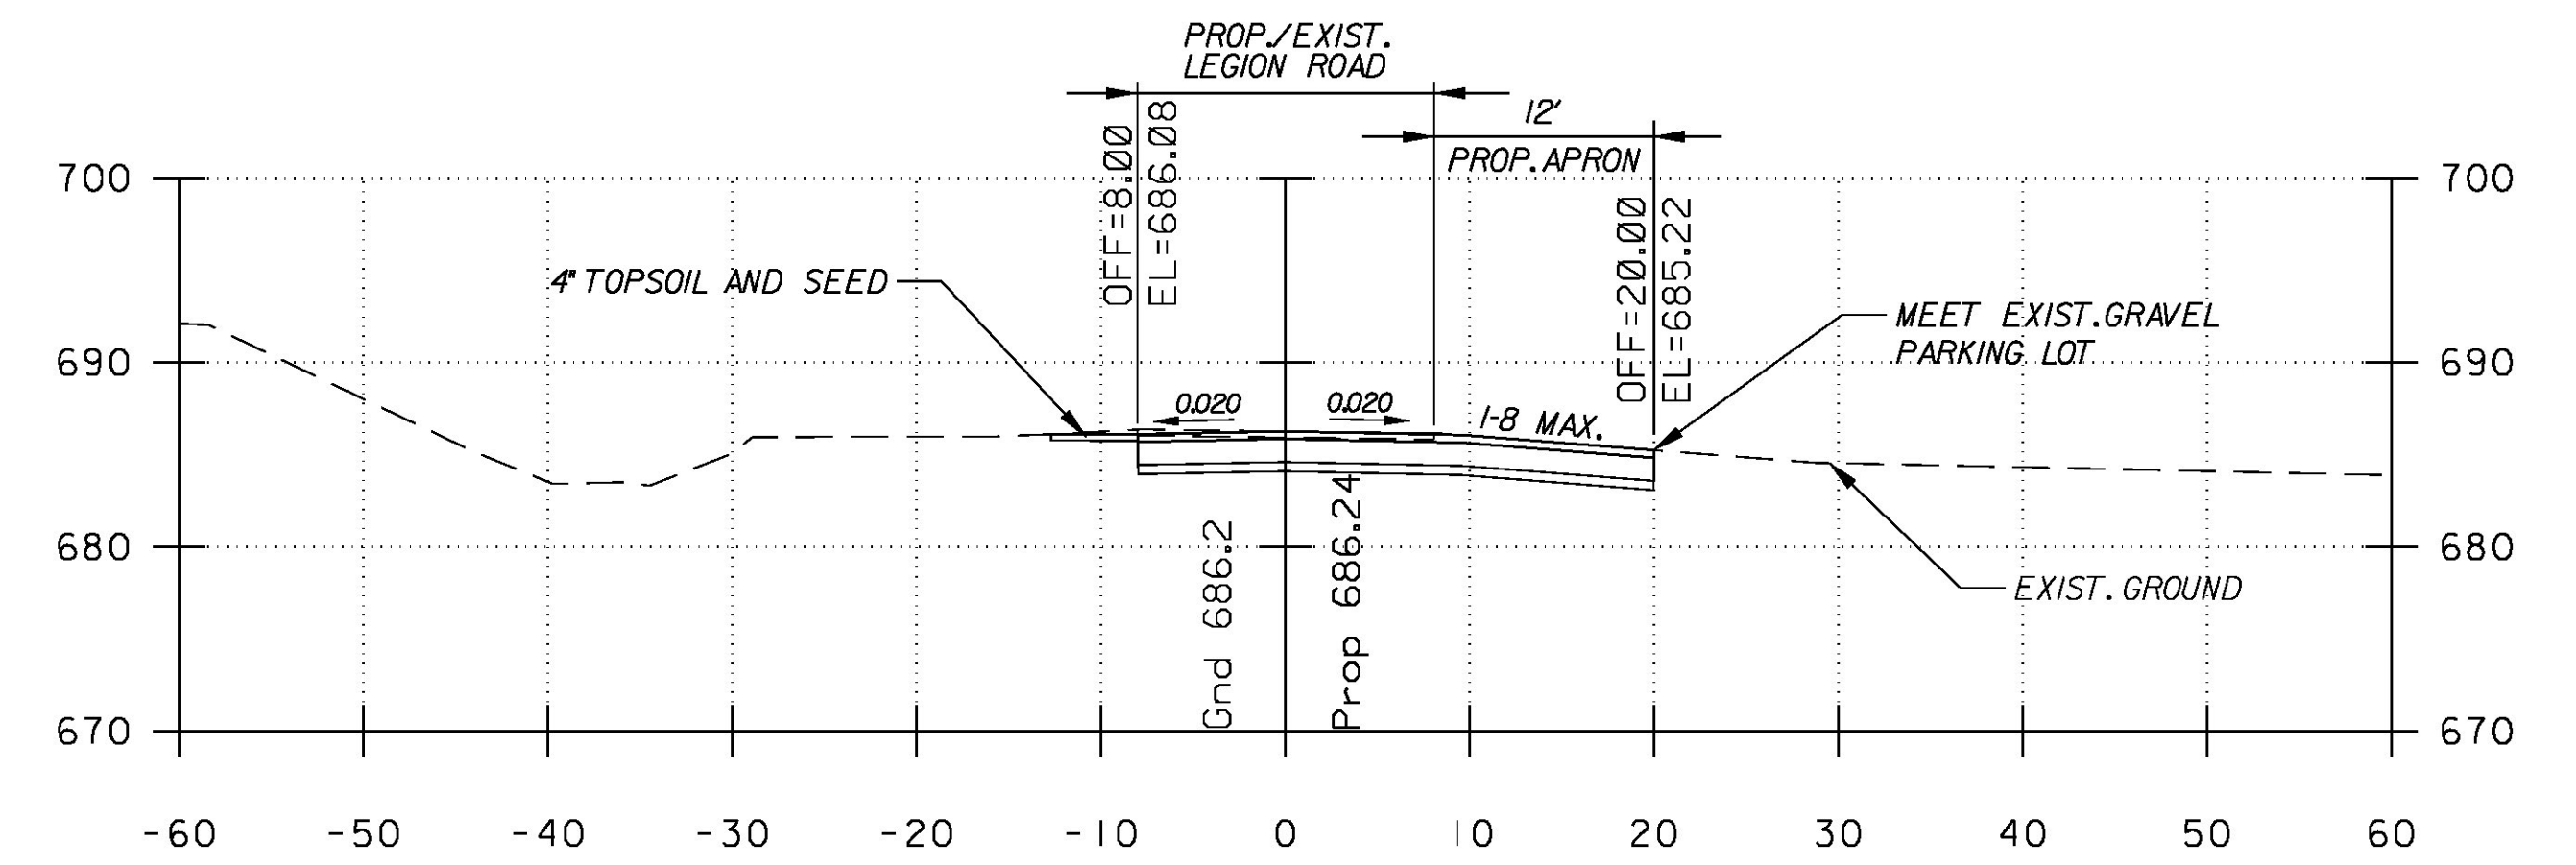


32+50 END PROJECT

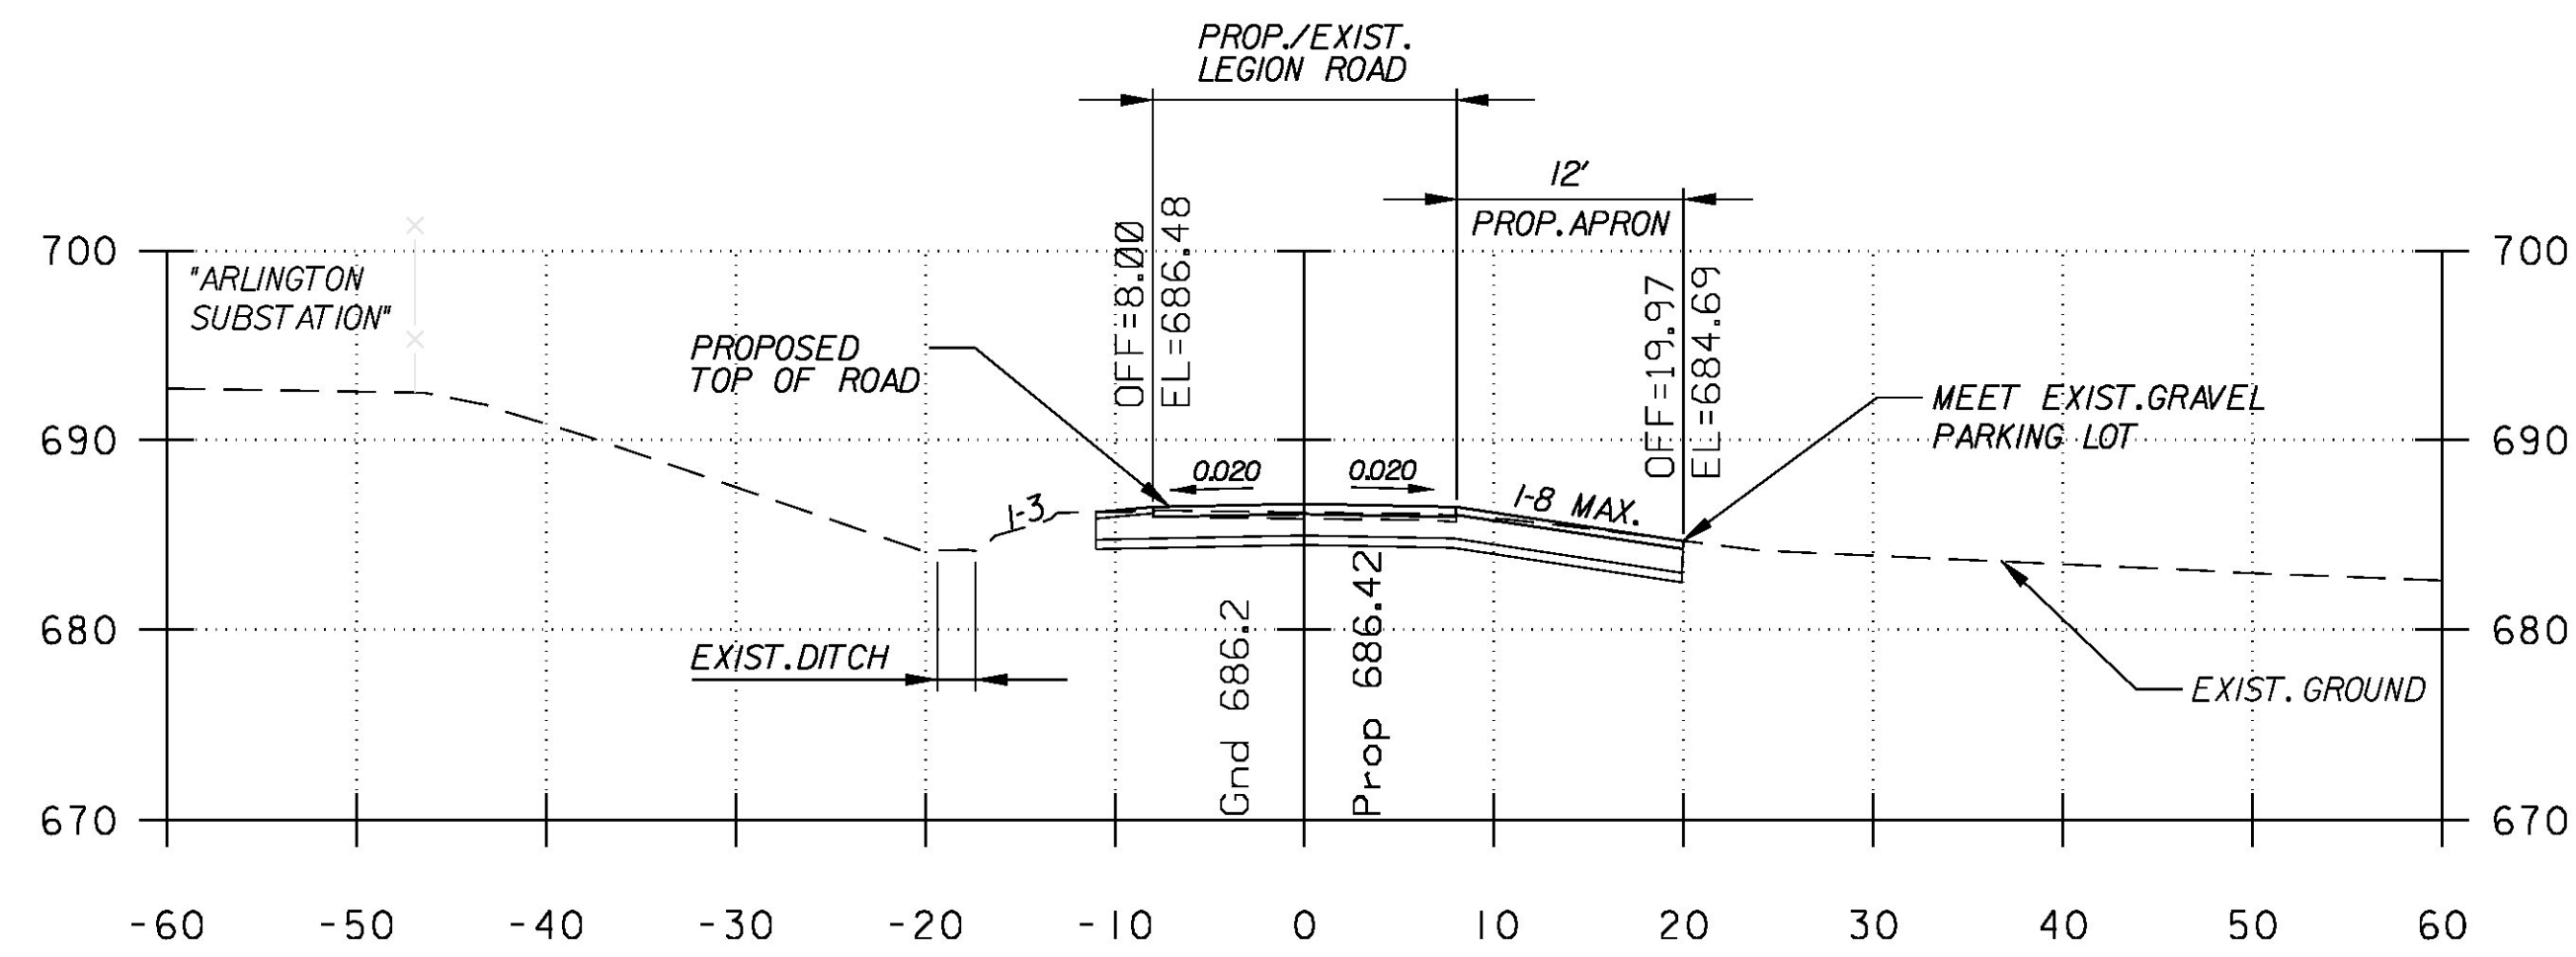

32+05

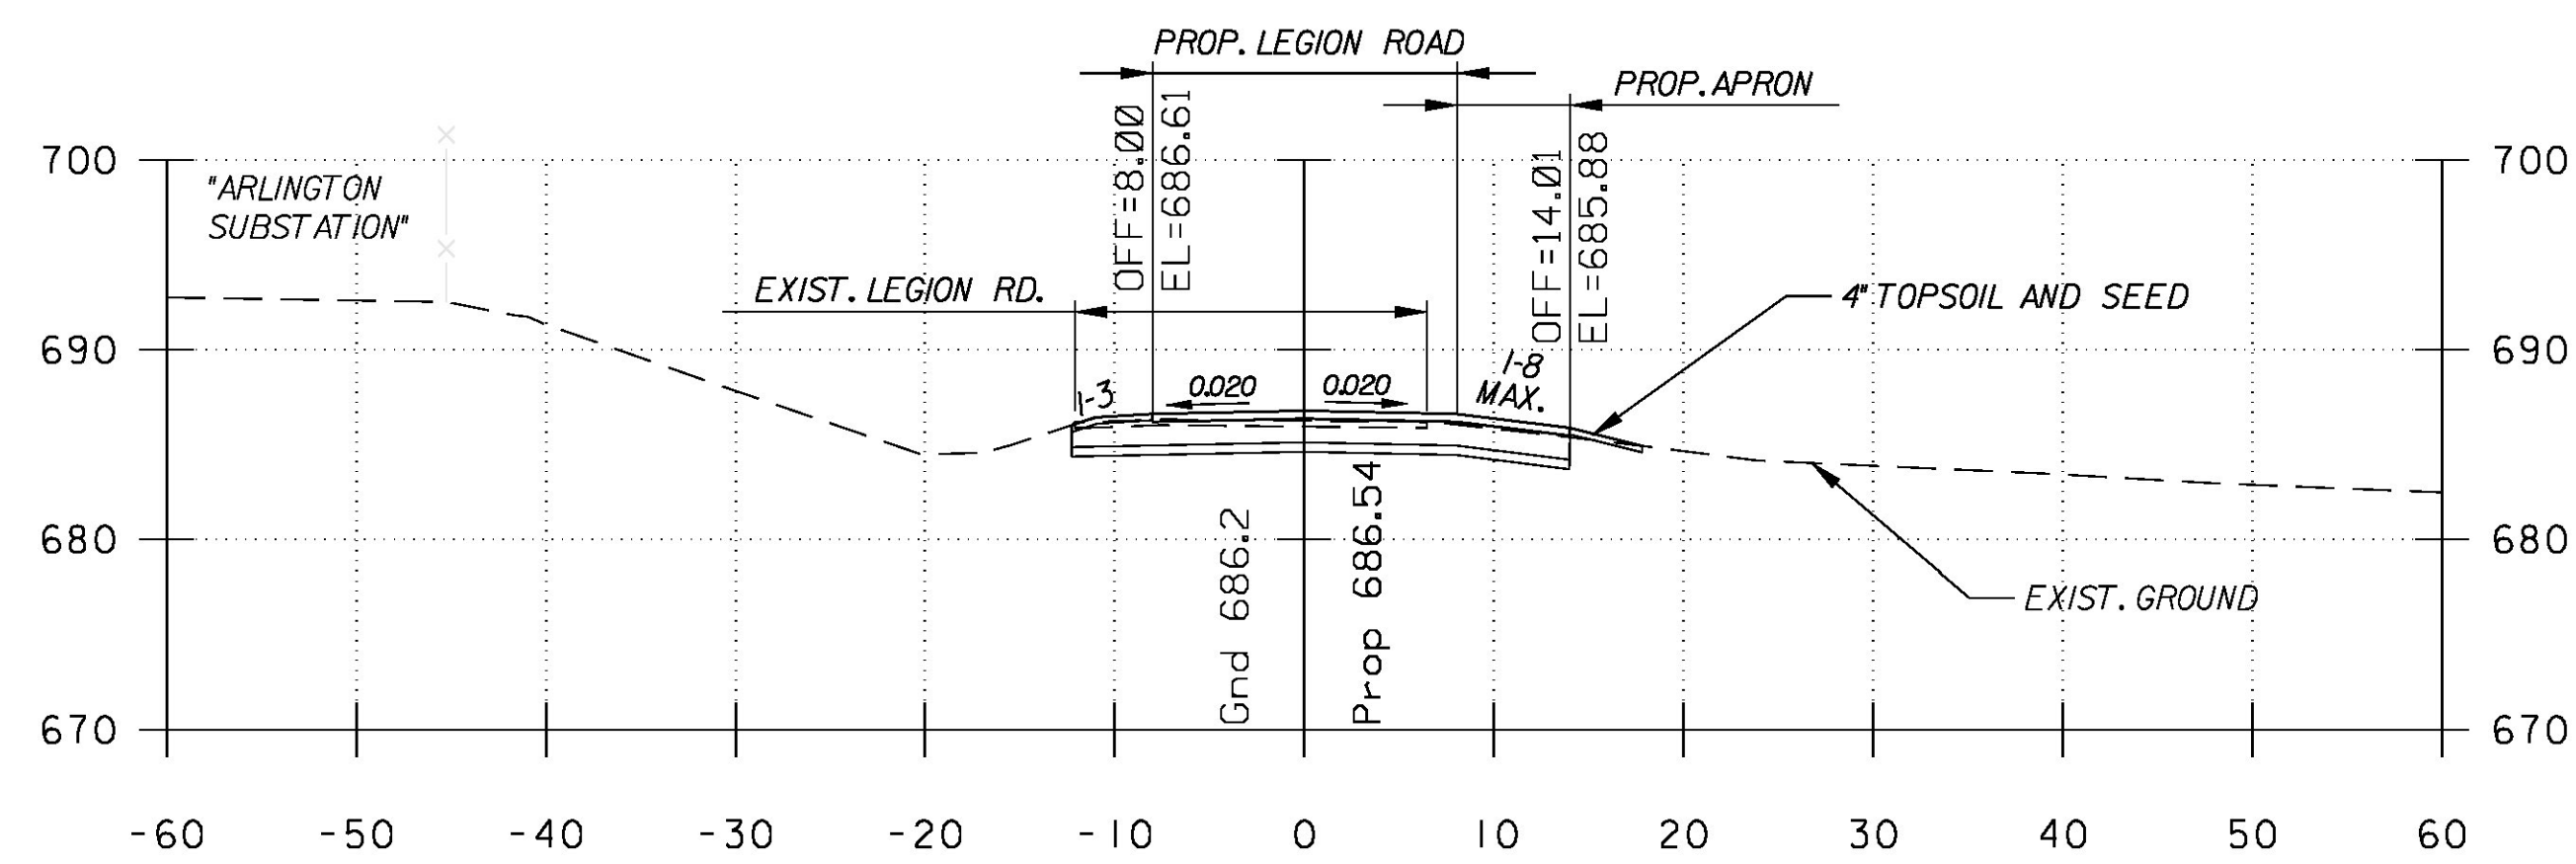

32+00

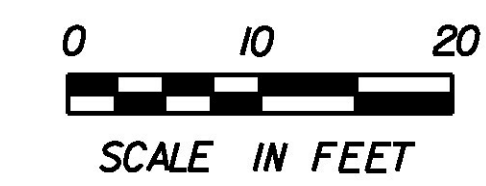

STA. 32+00 - 32+50

PROJECT NAME:	ARLINGTON	PLOT DATE:	2/5/2016
PROJECT NUMBER:	STP 0114 (4)	DRAWN BY:	LB
FILE NAME:	z09g052xsl.dgn	CHECKED BY:	J. READ
PROJECT LEADER:	J. READ	CROSS SECTIONS -	3
DESIGNED BY:	ABR	SHEET	23 OF 27

**STAGE I**



1. INSTALL TEMPORARY EROSION CONTROL AND TRAFFIC CONTROL MEASURES.
2. CONSTRUCT RELOCATED WATERLINE, ROADWAY AND DRAINAGE SYSTEM MODIFICATIONS.
3. CONSTRUCT TEMPORARY WIDENED GRAVEL SURFACE ROADWAY (6" SAND AND 15" DENSE GRADED CRUSHED STONE).
4. RELOCATE EXISTING LEGION SIGN STRUCTURE.
5. RECONSTRUCT WHEELCHAIR RAMP (E. ARLINGTON ROAD STA 14+13.60 RT).
6. HORIZONTAL DIRECTIONAL DRILL CONDUITS FOR NEW AUTOMATIC WARNING SYSTEM (AWS), EXISTING AWS TO REMAIN IN PLACE AND OPERATIONAL.
7. RAILROAD FLAGGER IS REQUIRED FOR WORK WITHIN RAILROAD RIGHT OF WAY.
8. RAILROAD TRAFFIC SHALL BE MAINTAINED AT ALL TIMES.
9. DURING WORK HOURS, MAINTAIN ALTERNATING TWO-WAY TRAFFIC ON EAST ARLINGTON ROAD. DURING NON-WORKING HOURS, RESTORE TWO-WAY TRAFFIC ON EAST ARLINGTON ROAD. REMOVE BARRIERS AND DRUMS; COVER OR REMOVE W20-4 AND W20-7 SIGNS.
10. ACCESS SHALL BE MAINTAINED TO THE GMP SUBSTATION AT ALL TIMES.

**GENERAL NOTES - ALL PHASES:**

1. FOR GENERAL NOTES SEE VAOT STANDARD T-1.
2. PAYMENT FOR TRAFFIC CONTROL WORK WILL BE MADE UNDER ITEM 900.645 SPECIAL PROVISION (TRAFFIC CONTROL, RAIL-HIGHWAY CROSSING).
3. THE CONTRACTOR MAY PROPOSE TO USE THEIR OWN SITE SPECIFIC TRAFFIC CONTROL PLAN WHILE MAINTAINING THE PHASES OF CONSTRUCTION, CONSTRUCTION REQUIREMENTS, AND ALLOWABLE WORK TIMES AS STATED ABOVE AND IN THE SPECIAL PROVISIONS.

**LEGEND:**

- LIMITS OF STAGE I ROADWAY CONSTRUCTION
- LIMIT OF TEMPORARY GRAVEL SURFACE ROADWAY WIDENING TO FACILITATE STAGE II CONSTRUCTION.
- INLET PROTECTION DEVICE, TYPE I
- TEMPORARY STONE CHECK DAM, TYPE I
- PROJECT DEMARCATION FENCE
- GEOTEXTILE FOR SILT FENCE, WOVEN WIRE REINFORCED
- TEMPORARY EROSION MATTING
- REFLECTORIZED DRUM
- FLAGGER
- POLICE OFFICER
- DIRECTION OF TRAFFIC

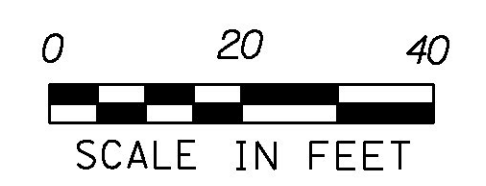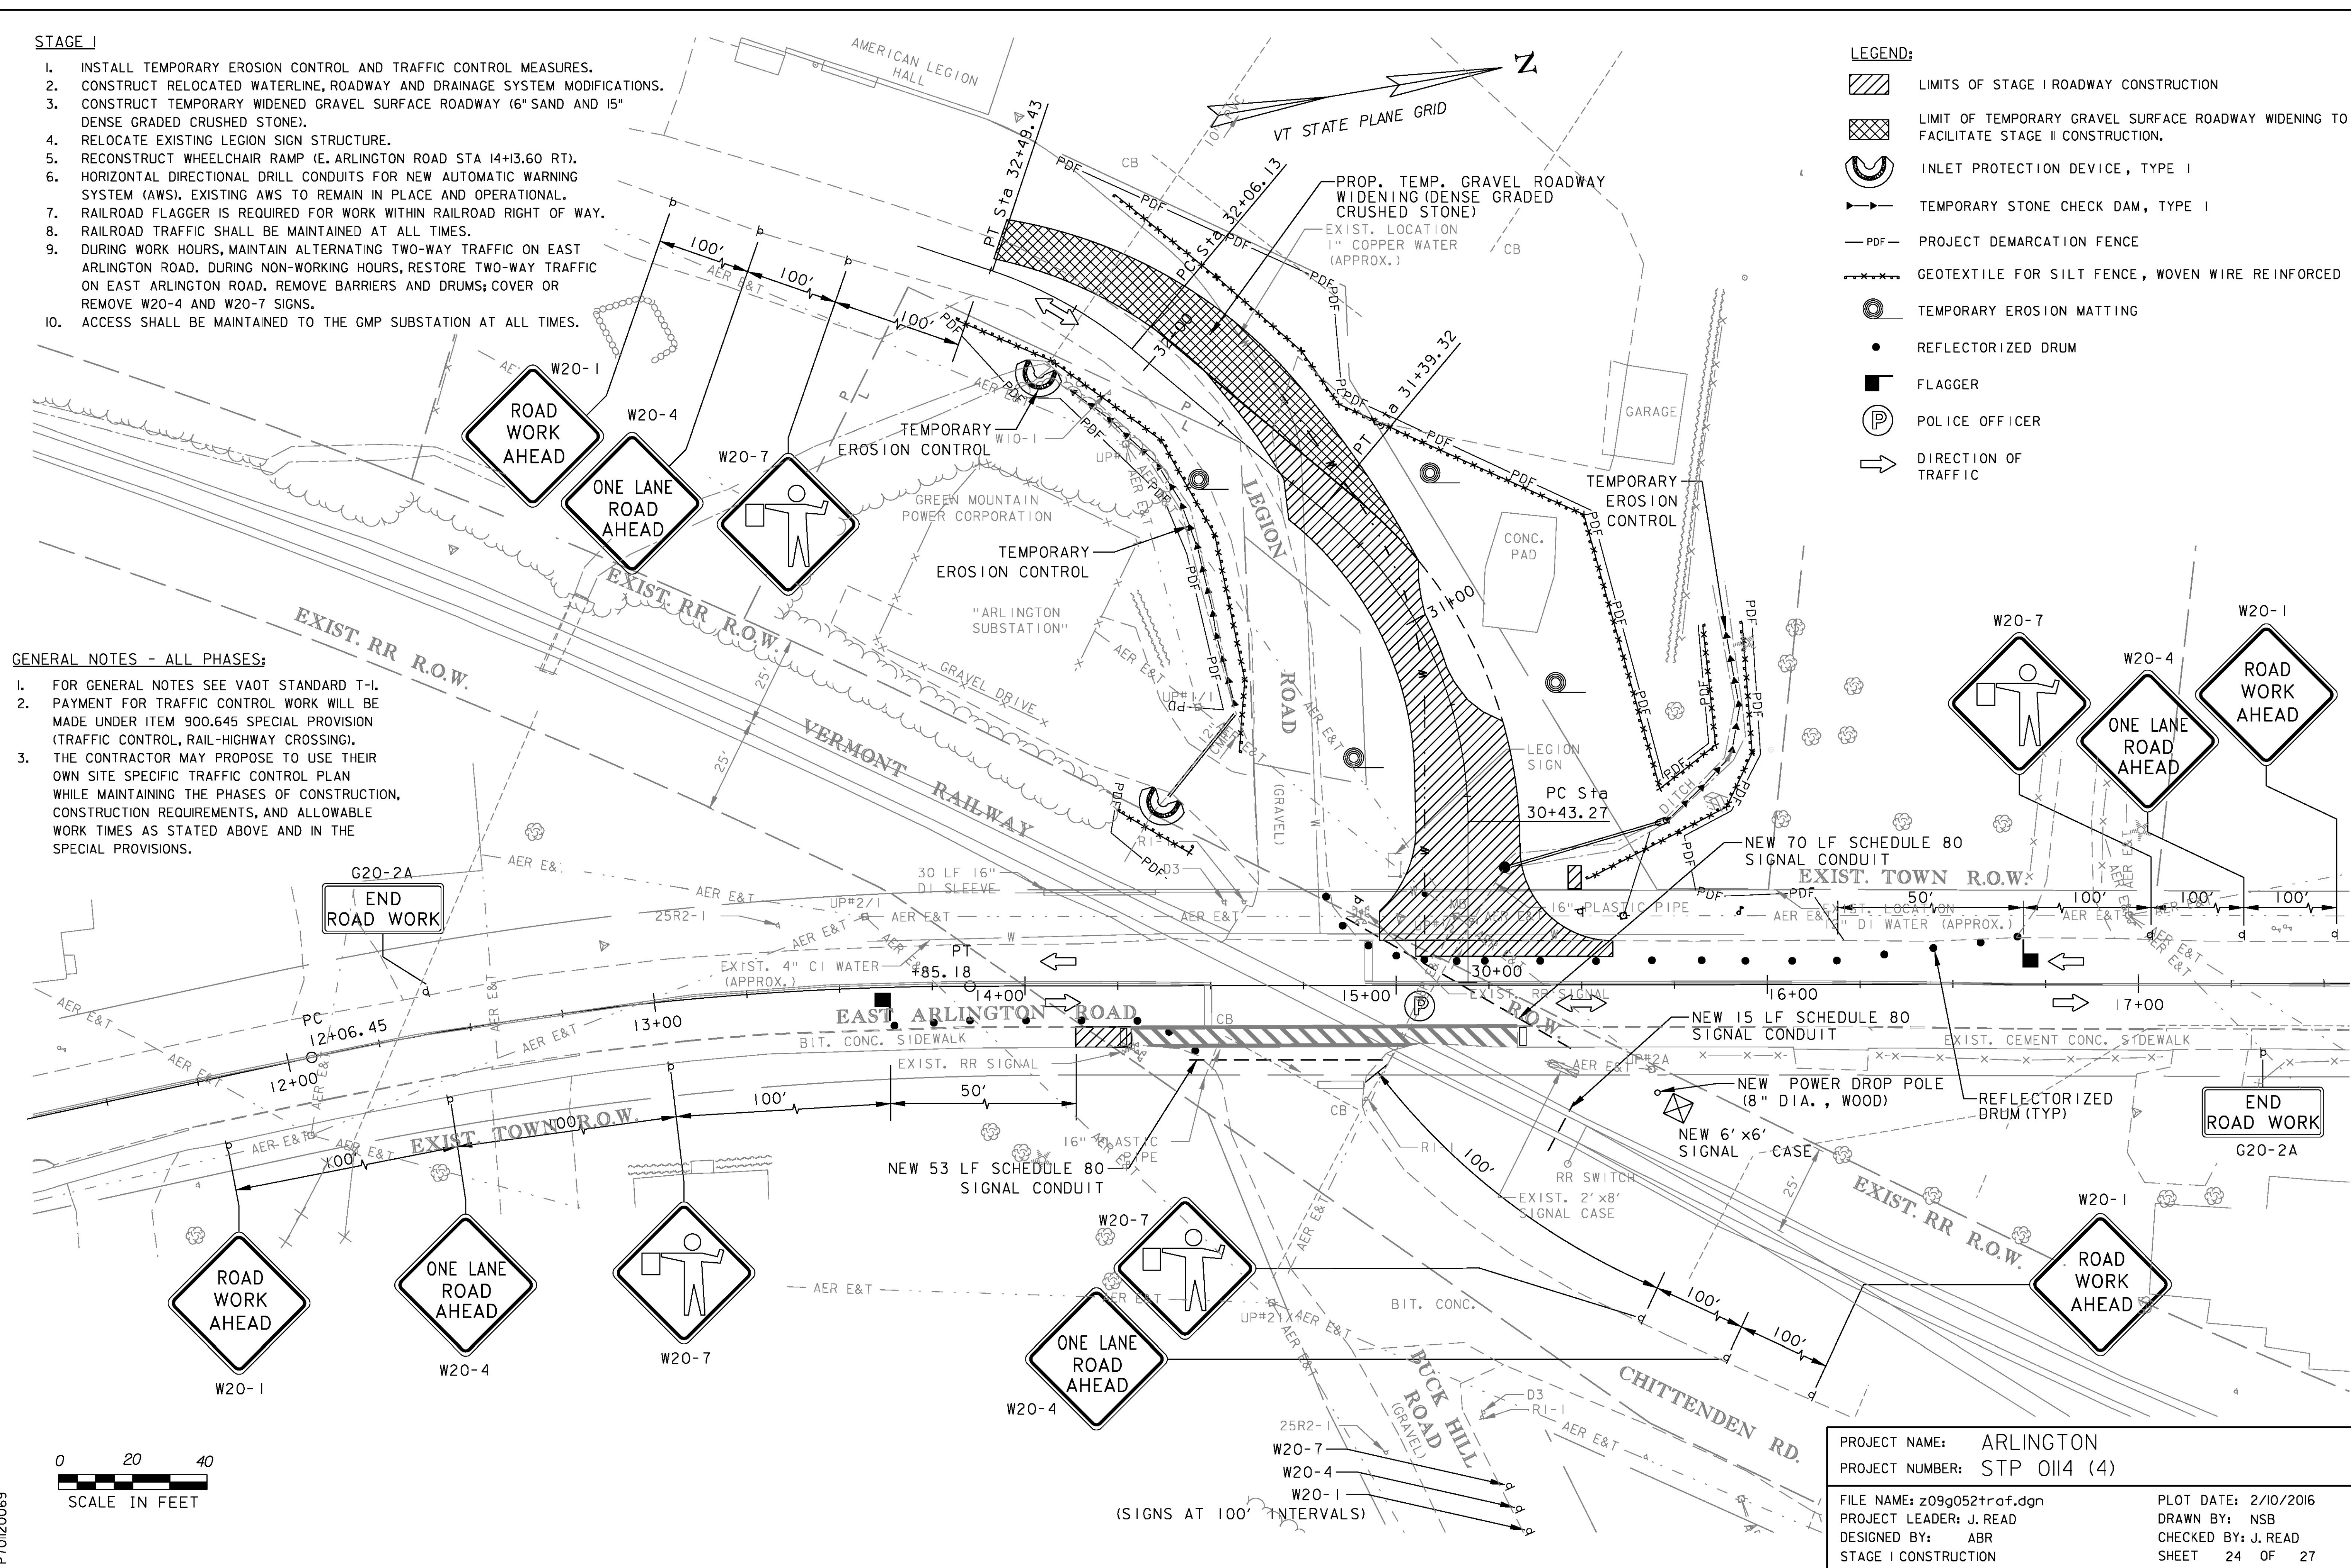

PROJECT NAME: ARLINGTON  
 PROJECT NUMBER: STP 0114 (4)  
 FILE NAME: z09g052traf.dgn  
 PROJECT LEADER: J. READ  
 DESIGNED BY: ABR  
 STAGE I CONSTRUCTION

PLOT DATE: 2/10/2016  
 DRAWN BY: NSB  
 CHECKED BY: J. READ  
 SHEET 24 OF 27

P70120069




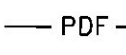
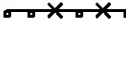






**STAGE II**


1. OPEN NEWLY CONSTRUCTED ROADWAY TO A MINIMUM OF ONE LANE OF THROUGH TRAFFIC. DURING WORK HOURS, MAINTAIN ALTERNATING TWO-WAY TRAFFIC ON LEGION ROAD AND EAST ARLINGTON ROAD. DURING NON-WORKING HOURS, RESTORE TWO-WAY TRAFFIC ON EAST ARLINGTON ROAD. REMOVE BARRIERS AND DRUMS; COVER OR REMOVE W20-4 AND W20-7 SIGNS.
2. CONSTRUCT GMP SUBSTATION DRIVEWAY EXTENSION.
3. CONSTRUCT PROPOSED CONCRETE TANK PAD.
4. THE CONTRACTOR SHALL SUBMIT FOR THE ENGINEER'S REVIEW AND APPROVAL A DETAILED WORK PLAN OUTLINING THE PROCEDURE, EQUIPMENT AND SCHEDULE TO BE USED IN PERFORMING THE RELOCATION OF THE MILITARY TANK. THE DETAILED WORK PLAN SHALL INCLUDE CONSTRUCTION STAGING PLAN, CRANE LIFTING PLAN, CUT SHEETS, ETC. TO VERIFY THE CAPACITY OF THE EQUIPMENT AND MATERIALS TO BE USED IN PERFORMING THE MILITARY TANK RELOCATION.
5. REMOVE EXISTING TANK PAD, REGRADE SIDESLOPE AND COMPLETE ROADWAY CONSTRUCTION.
6. RELOCATE TRAFFIC ONTO COMPLETED LEGION ROAD.
7. REGRADE TEMPORARY WIDENED GRAVEL SURFACE ROADWAY (6" SAND AND 15" DENSE GRADED CRUSHED STONE), PLACE 4" TOPSOIL AND SEED WHERE SPECIFIED ON PLANS.
8. INSTALL DETECTABLE WARNING PANEL (E. ARLINGTON ROAD STA 15+33.30 RT).
9. RAILROAD FLAGGER IS REQUIRED FOR WORK WITHIN RAILROAD RIGHT OF WAY.
10. RAILROAD TRAFFIC SHALL BE MAINTAINED AT ALL TIMES.
11. AUTOMATIC WARNING SYSTEM (AWS) SHALL BE OPERATIONAL DURING ALL NON-WORKING HOURS.
12. CONSTRUCT NEW RAILROAD SIGNAL FOUNDATIONS AND INSTALL NEW AWS.
13. REMOVE REMAINING TRAFFIC CONTROL AND EROSION CONTROL MEASURES.

**GENERAL NOTES - ALL PHASES:**

1. FOR GENERAL NOTES SEE VAOT STANDARD T-1.
2. PAYMENT FOR TRAFFIC CONTROL WORK WILL BE MADE UNDER ITEM 900.645 SPECIAL PROVISION (TRAFFIC CONTROL, RAIL-HIGHWAY CROSSING).
3. THE CONTRACTOR MAY PROPOSE TO USE THEIR OWN SITE SPECIFIC TRAFFIC CONTROL PLAN WHILE MAINTAINING THE PHASES OF CONSTRUCTION, CONSTRUCTION REQUIREMENTS, AND ALLOWABLE WORK TIMES AS STATED ABOVE AND IN THE SPECIAL PROVISIONS.

**LEGEND:**

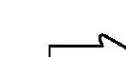
-  LIMITS OF STAGE II ROADWAY CONSTRUCTION
-  INLET PROTECTION DEVICE, TYPE I
-  TEMPORARY EROSION MATTING
-  PROJECT DEMARCATION FENCE
-  GEOTEXTILE FOR SILT FENCE, WOVEN WIRE REINFORCED
-  CLEAR ZONE
-  TEMPORARY STONE CHECK DAM, TYPE I
-  REFLECTORIZED DRUM
-  FLAGGER
-  POLICE OFFICER
-  DIRECTION OF TRAFFIC

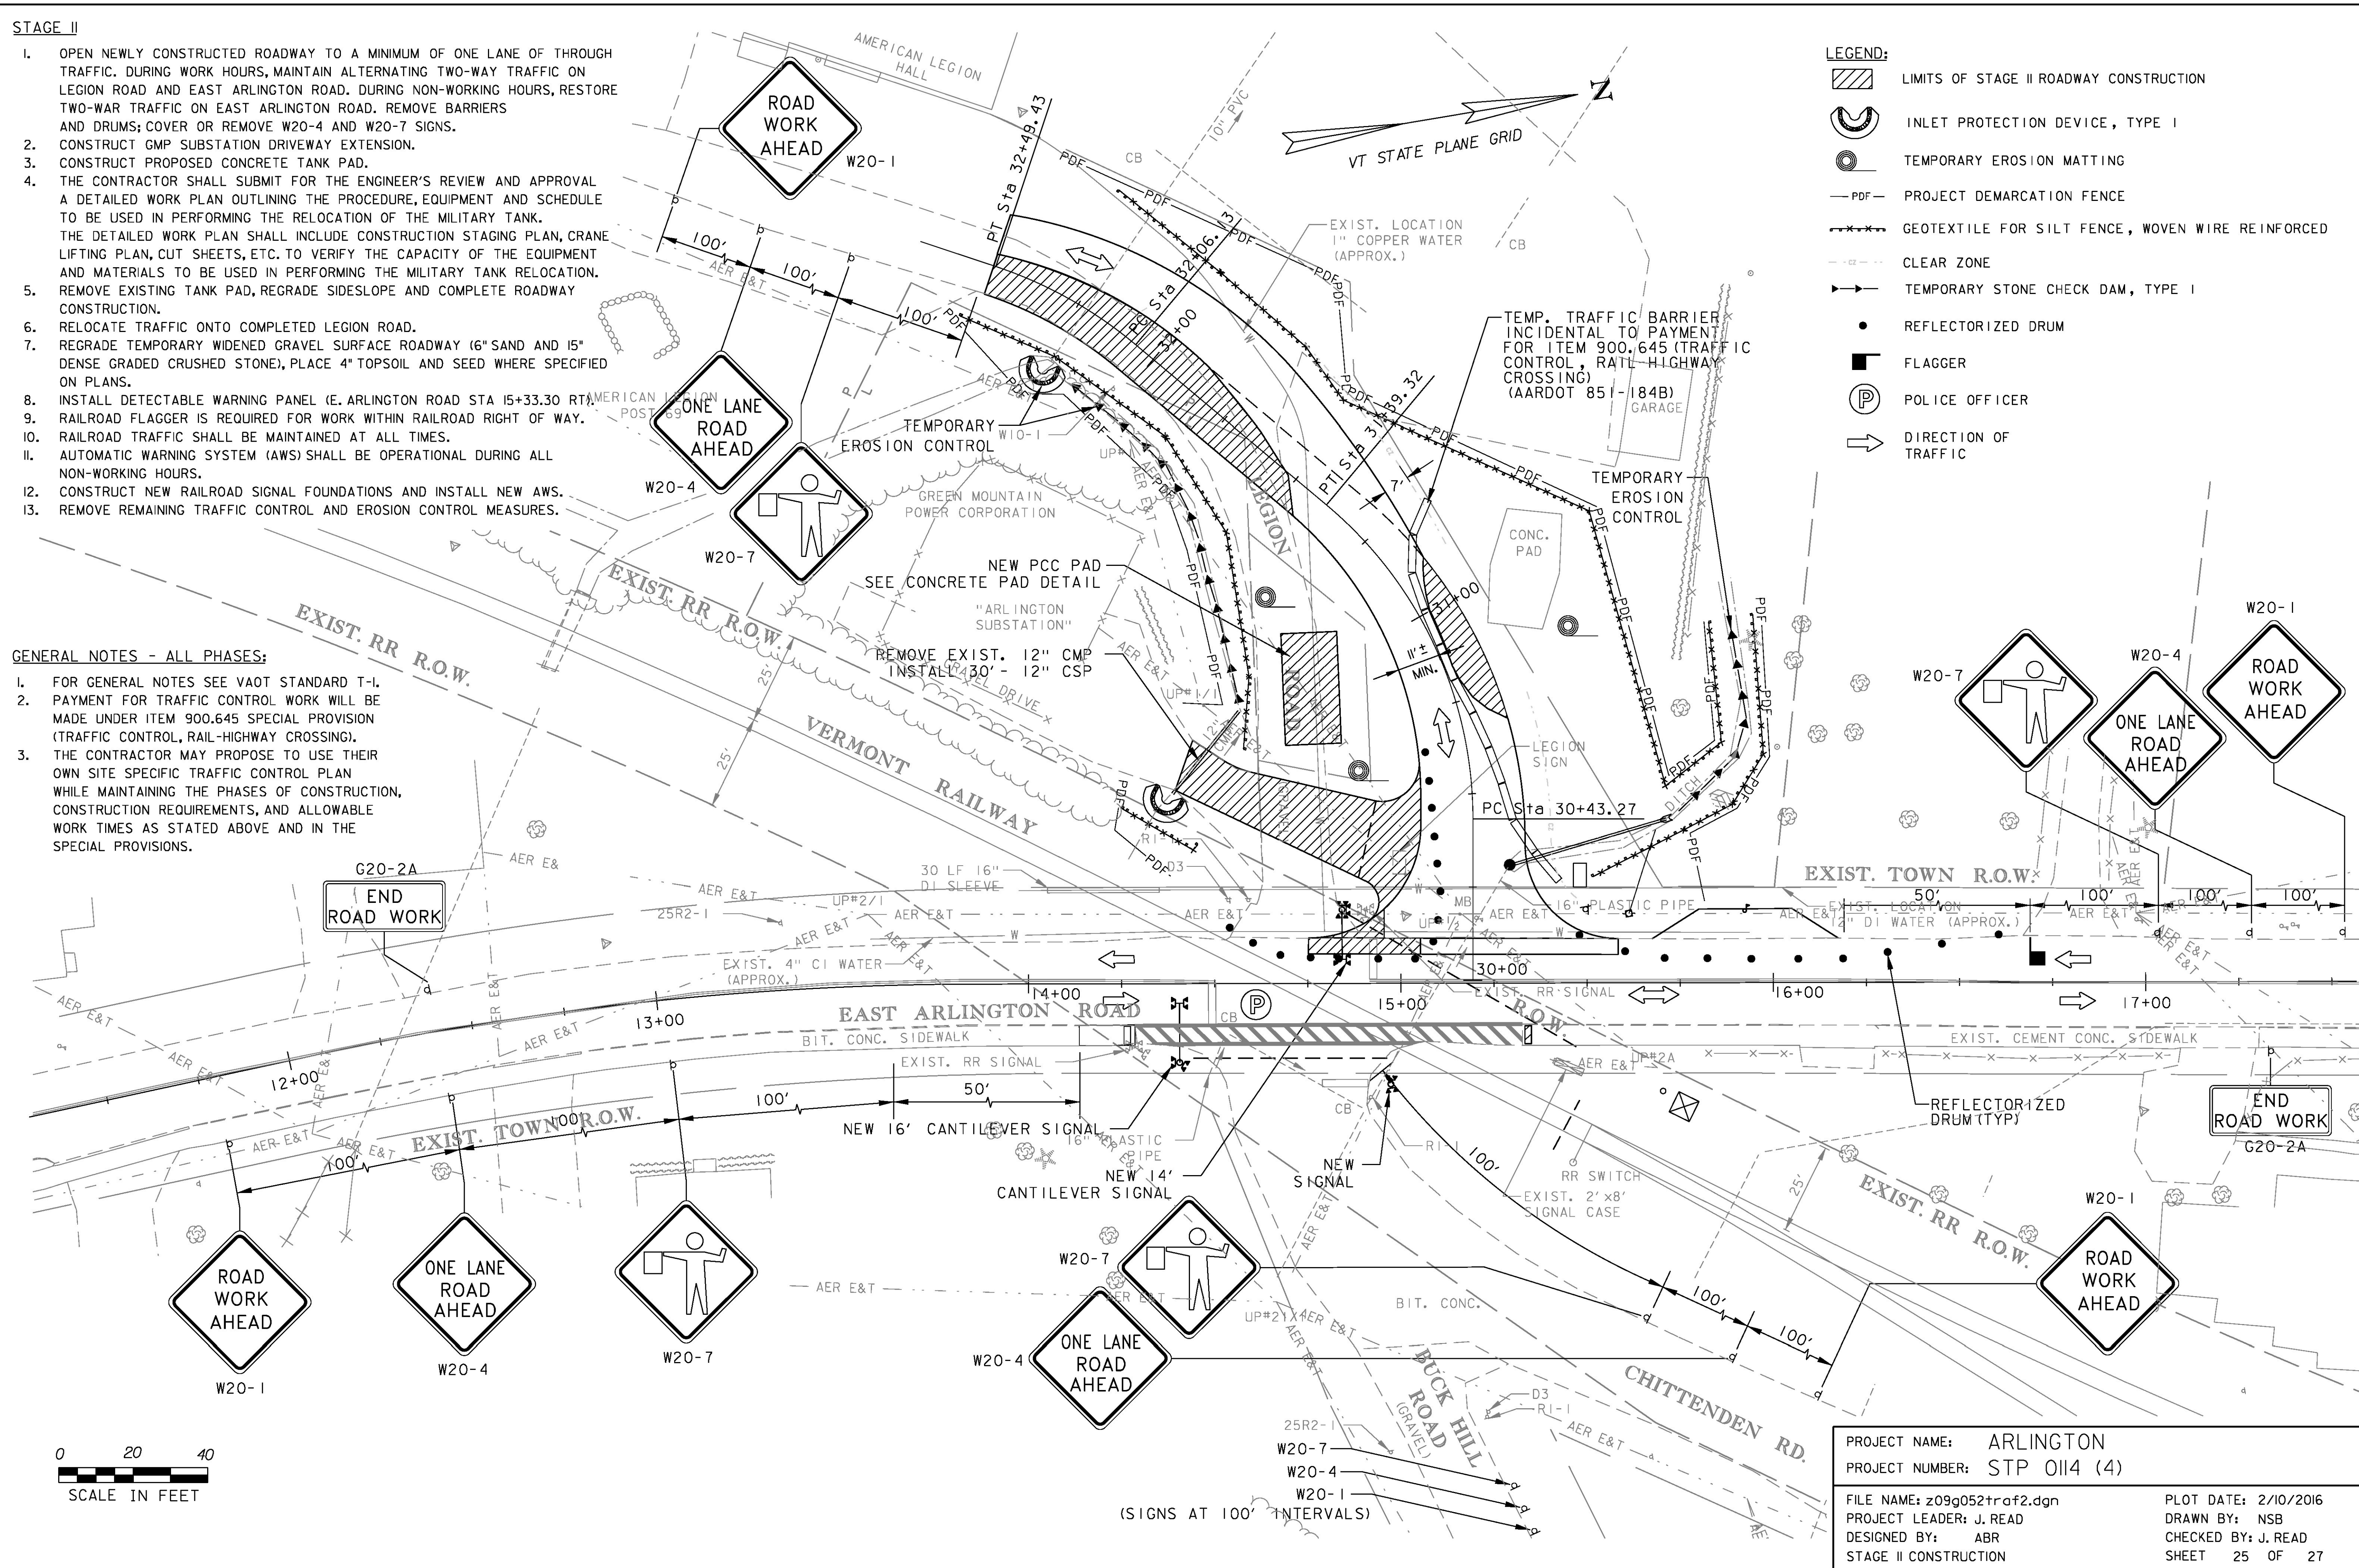

PROJECT NAME:	ARLINGTON	PLOT DATE:	2/10/2016
PROJECT NUMBER:	STP 0114 (4)	DRAWN BY:	NSB
FILE NAME:	z09g052traf2.dgn	CHECKED BY:	J. READ
PROJECT LEADER:	J. READ	STAGE II CONSTRUCTION	SHEET 25 OF 27
DESIGNED BY:	ABR		

P701120069



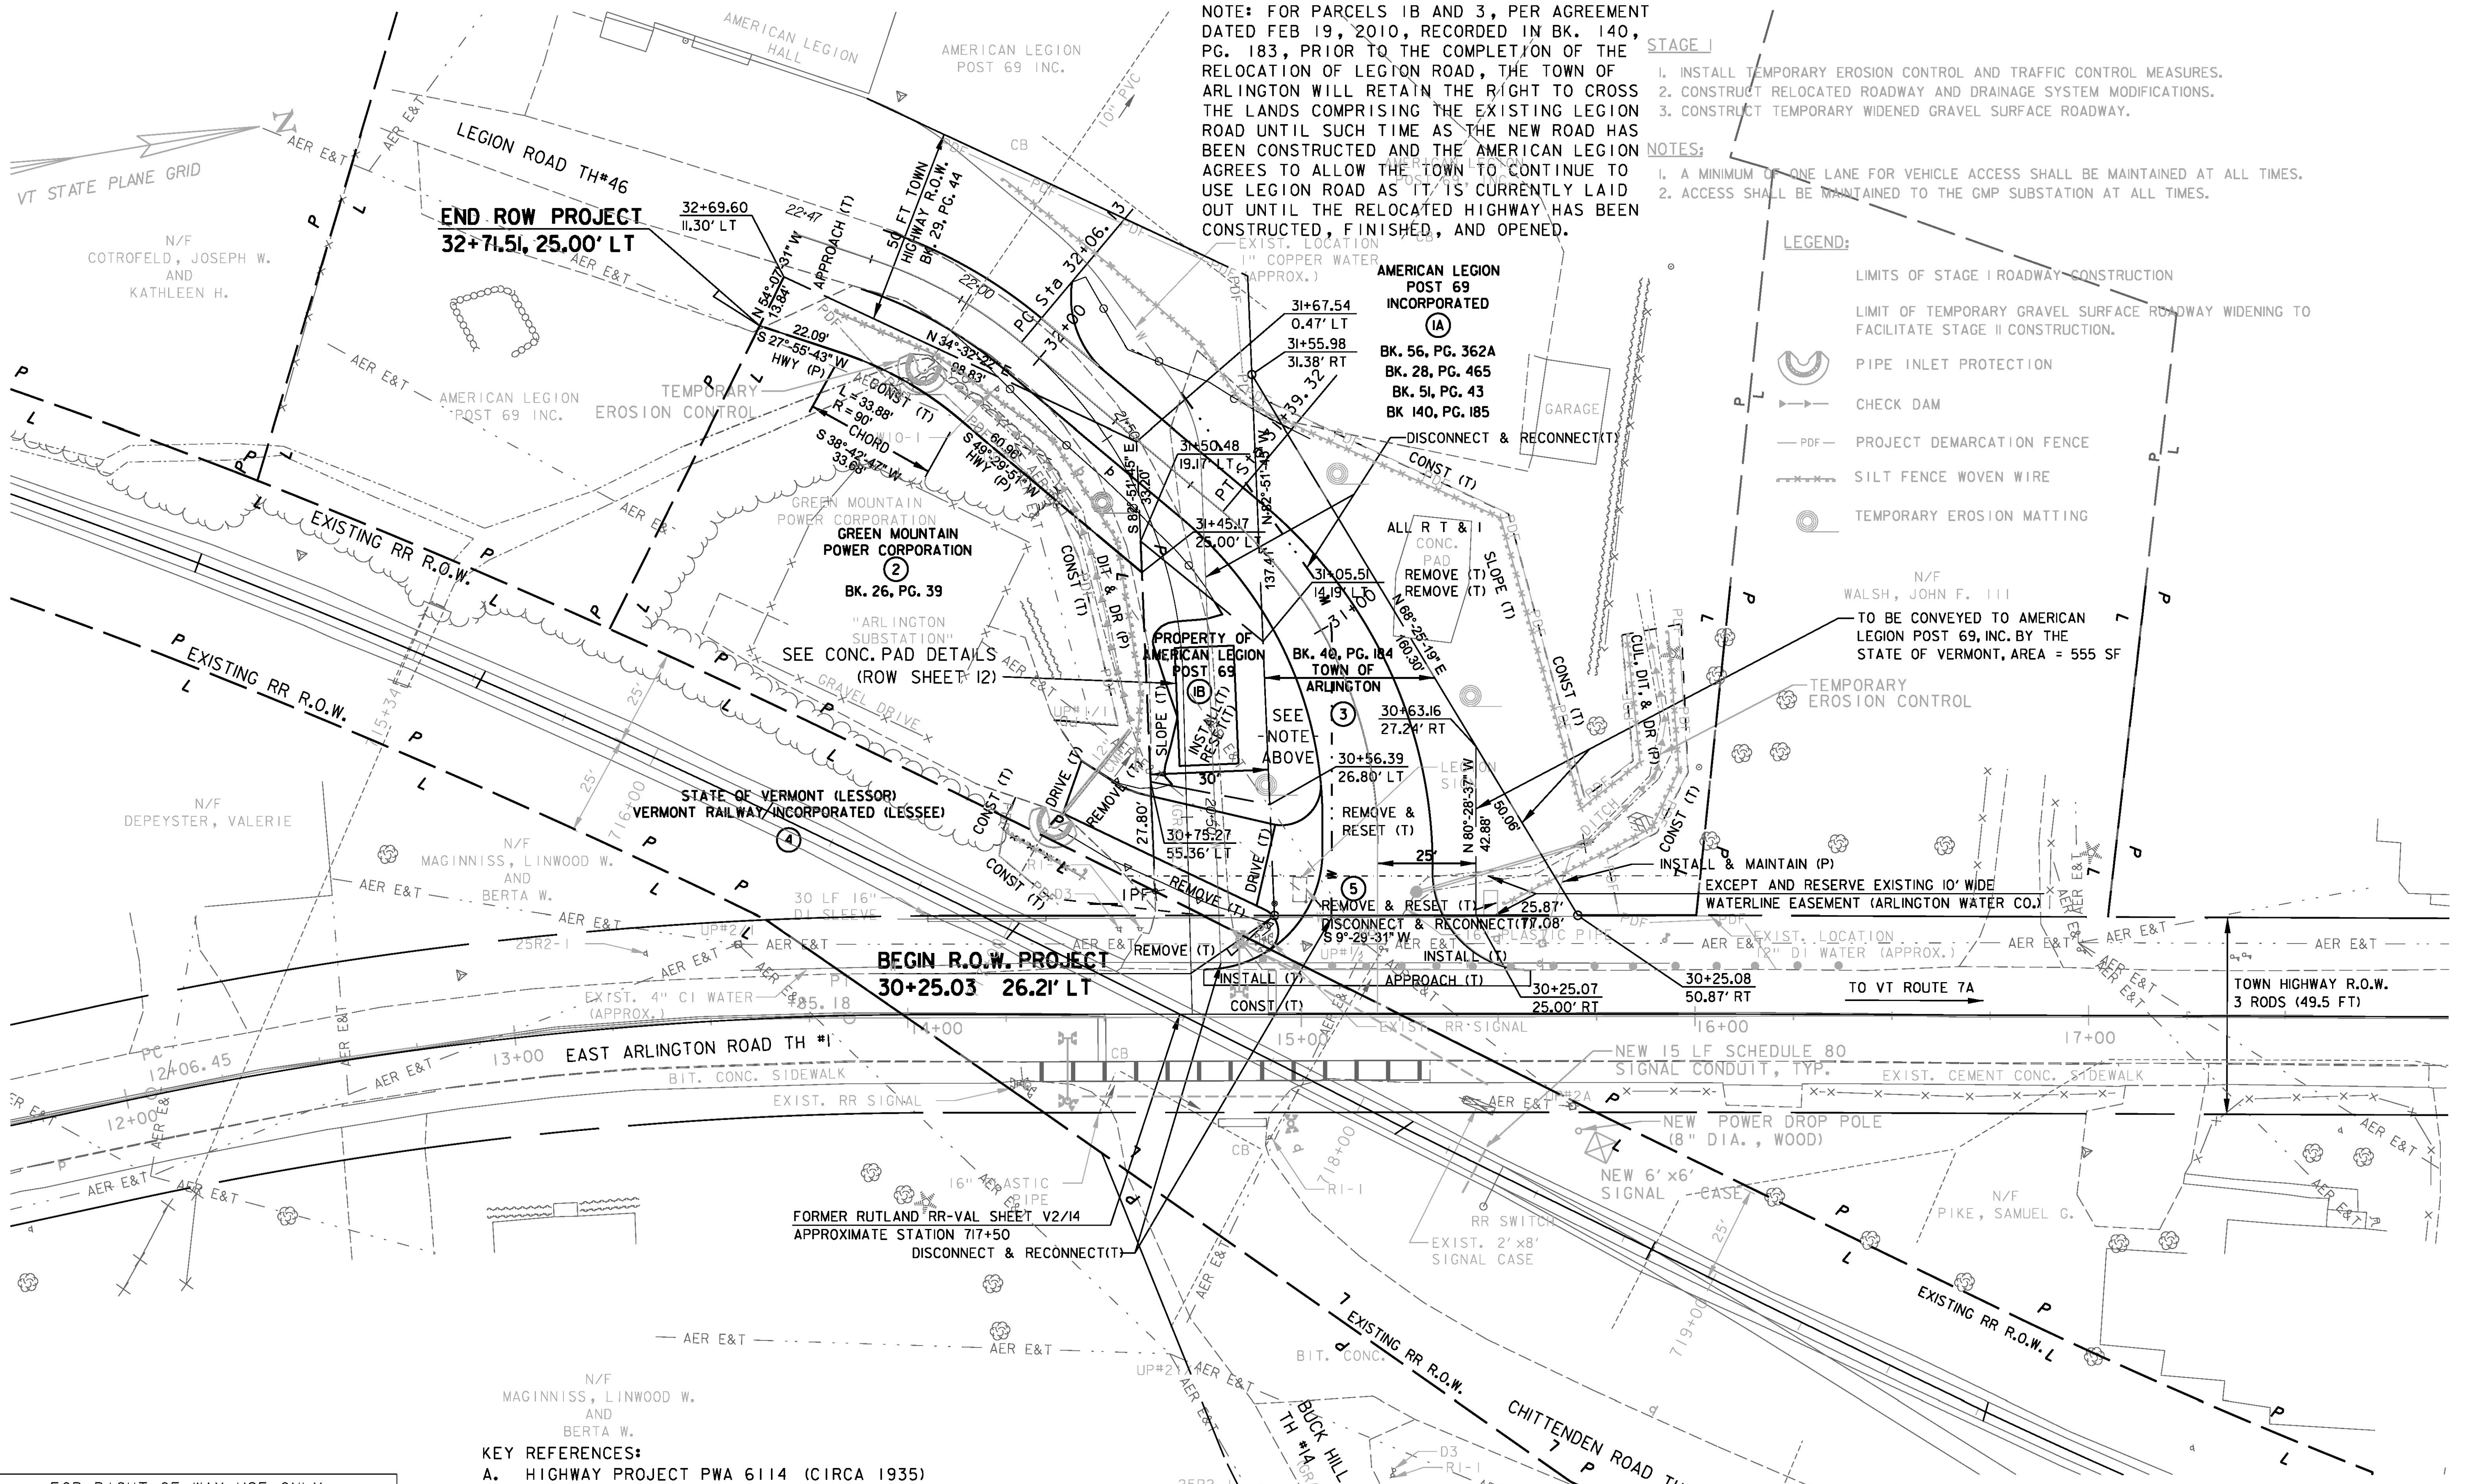

NOTE: FOR PARCELS 1B AND 3, PER AGREEMENT DATED FEB 19, 2010, RECORDED IN BK. 140, PG. 183, PRIOR TO THE COMPLETION OF THE RELOCATION OF LEGION ROAD, THE TOWN OF ARLINGTON WILL RETAIN THE RIGHT TO CROSS THE LANDS COMPRISING THE EXISTING LEGION ROAD UNTIL SUCH TIME AS THE NEW ROAD HAS BEEN CONSTRUCTED AND THE AMERICAN LEGION AGREES TO ALLOW THE TOWN TO CONTINUE TO USE LEGION ROAD AS IT IS CURRENTLY LAID OUT UNTIL THE RELOCATED HIGHWAY HAS BEEN CONSTRUCTED, FINISHED, AND OPENED.

- STAGE I**
1. INSTALL TEMPORARY EROSION CONTROL AND TRAFFIC CONTROL MEASURES.
  2. CONSTRUCT RELOCATED ROADWAY AND DRAINAGE SYSTEM MODIFICATIONS.
  3. CONSTRUCT TEMPORARY WIDENED GRAVEL SURFACE ROADWAY.
- NOTES:**
1. A MINIMUM OF ONE LANE FOR VEHICLE ACCESS SHALL BE MAINTAINED AT ALL TIMES.
  2. ACCESS SHALL BE MAINTAINED TO THE GMP SUBSTATION AT ALL TIMES.


- LEGEND:**
- LIMITS OF STAGE I ROADWAY CONSTRUCTION
  - LIMIT OF TEMPORARY GRAVEL SURFACE ROADWAY WIDENING TO FACILITATE STAGE II CONSTRUCTION.
  - PIPE INLET PROTECTION
  - CHECK DAM
  - PROJECT DEMARCATION FENCE
  - SILT FENCE WOVEN WIRE
  - TEMPORARY EROSION MATTING

FOR RIGHT OF WAY USE ONLY

LINES SHOWN ON THIS PLAN AS EXISTING PROPERTY LINES (P/L) ARE BELIEVED TO BE ACCURATE BUT SHOULD NOT BE RELIED UPON FOR PURPOSES UNRELATED TO THE STATE OF VERMONT'S ACQUISITION OF LAND AND RIGHTS FOR THIS PROJECT.

- KEY REFERENCES:**
- A. HIGHWAY PROJECT PWA 6114 (CIRCA 1935)
  - B. BOUNDARY SURVEY - ARLINGTON SUB PROPERTY - LANDS OF CENTRAL VERMONT PUBLIC SERVICE CORPORATION; DATED 4/12/1994.
  - C. RUTLAND RAILROAD VAL SHEET V2/14.
  - D. BOOK 29, PAGE 44 DATED 12/30/1952 - OJHL AND CRAMPTON TO TOWN OF ARLINGTON - ESTABLISHES LEGION ROAD AS TOWN RIGHT OF WAY.
  - E. BOOK 140, PAGE 184 AND BOOK 140, PAGE 185 - CONCERNING LAND CONVEYANCE FOR LEGION ROAD RELOCATION.

SHEET PREPARED BY STANTEC



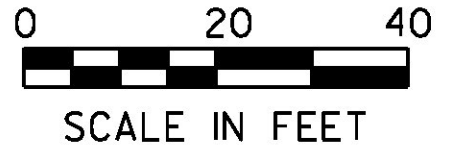


PROJECT NAME: ARLINGTON  
 PROJECT NUMBER: STP 0114 (4)  
 FILE NAME: z09g052plan_ROW.dgn  
 PROJECT LEADER: J. READ  
 DESIGNED BY: H. PETROVS  
 ROW LAYOUT SHEET

PLOT DATE: 5/28/2015  
 DRAWN BY: T. DUGUAY  
 CHECKED BY: H. PETROVS  
 SHEET 27 OF 27

# SALES DRAWING

TORQUE VALUES	
TORQUE VALUES FOR 18-8 S/S HARDWARE WITHOUT ANTI-SEIZE COMPOUND.	
1. 3/8"-16 BOLTS:	236 IN. LBS.
2. 1/2"-13 BOLTS:	517 IN. LBS.
3. 5/8"-11 BOLTS:	1110 IN. LBS.
4. 1"-8 BOLTS:	3440 IN. LBS.
TORQUE VALUES FOR 18-8 S/S HARDWARE WITH ANTI-SEIZE COMPOUND.	
1. 3/8"-16 BOLTS:	201 IN. LBS.
2. 1/2"-13 BOLTS:	439 IN. LBS.
3. 5/8"-11 BOLTS:	944 IN. LBS.
4. 1"-8 BOLTS:	2924 IN. LBS.

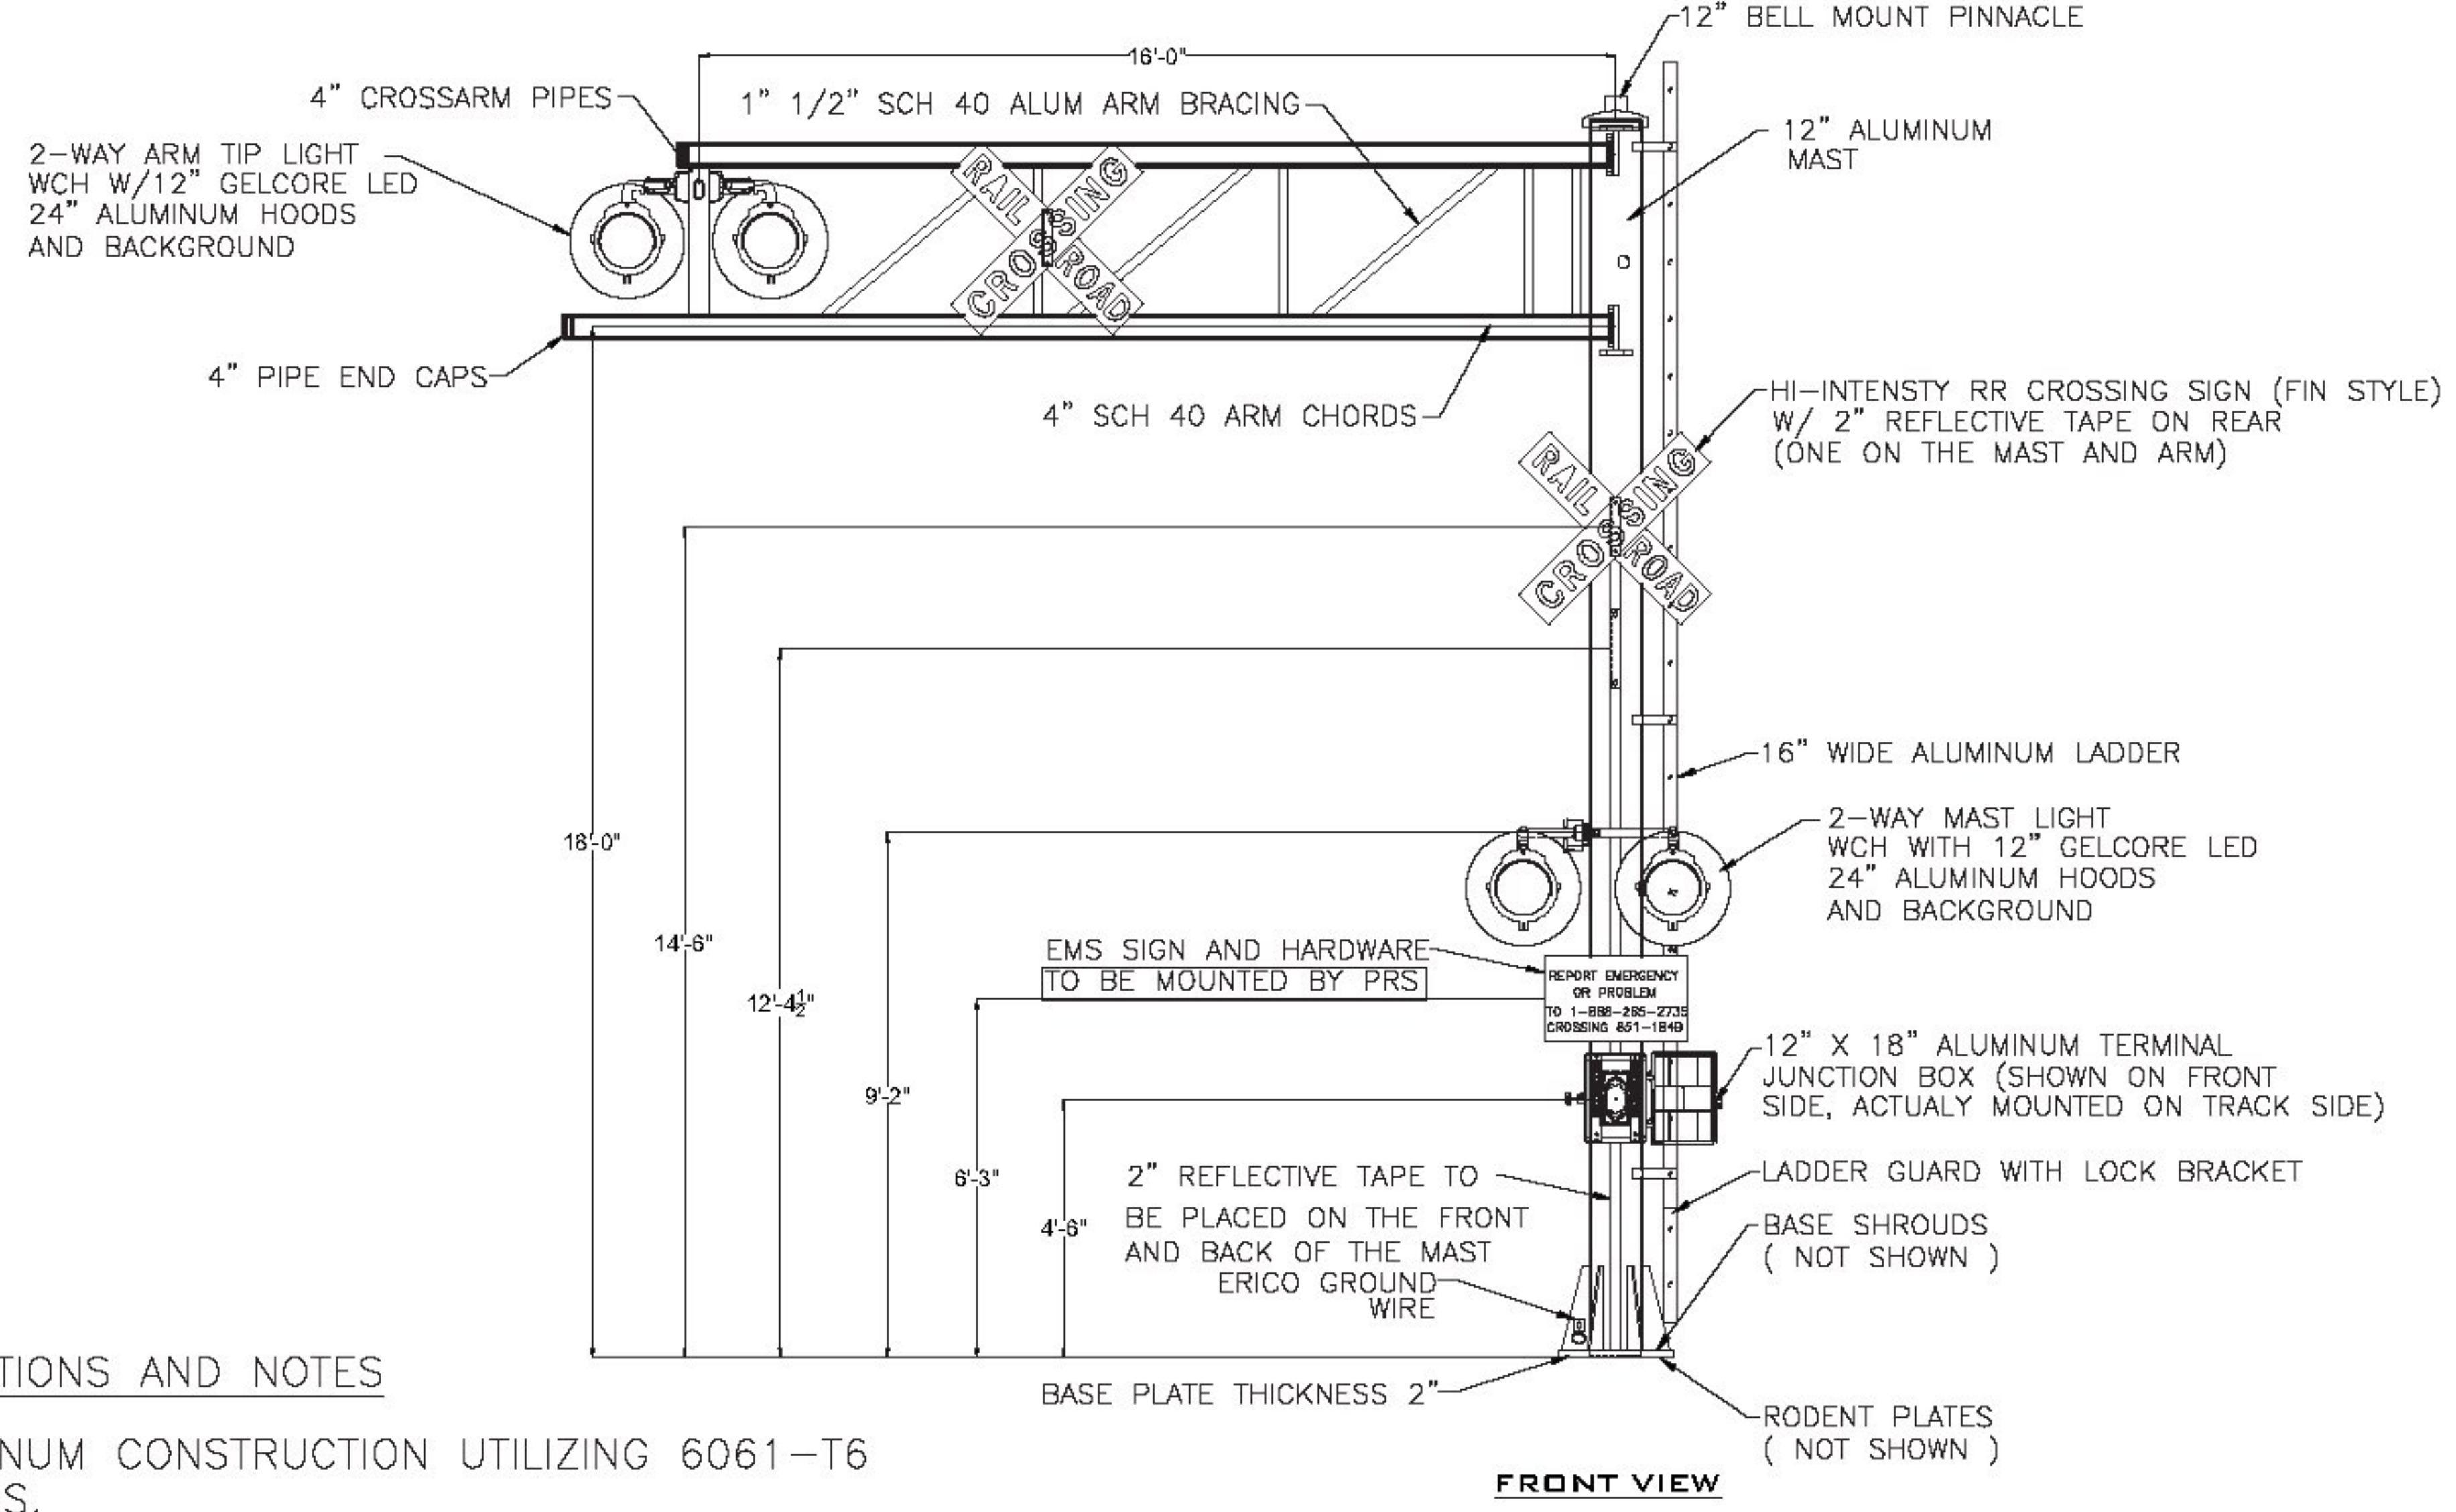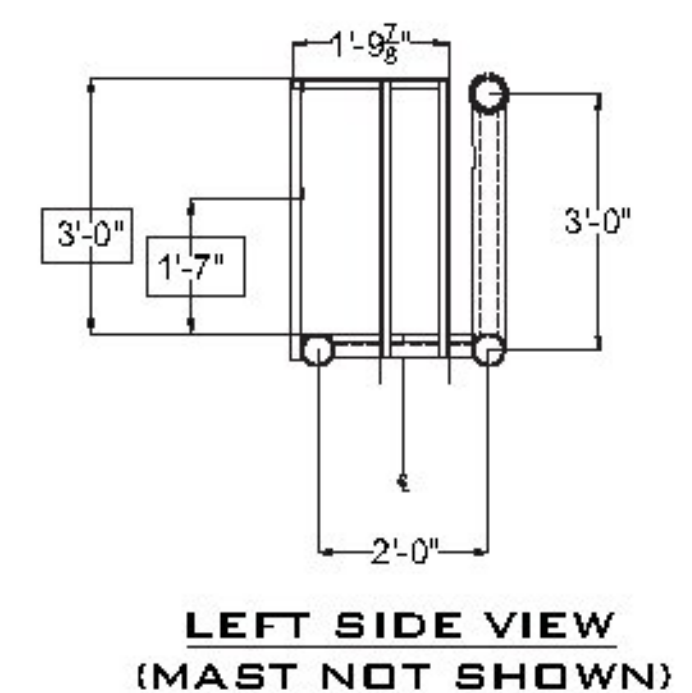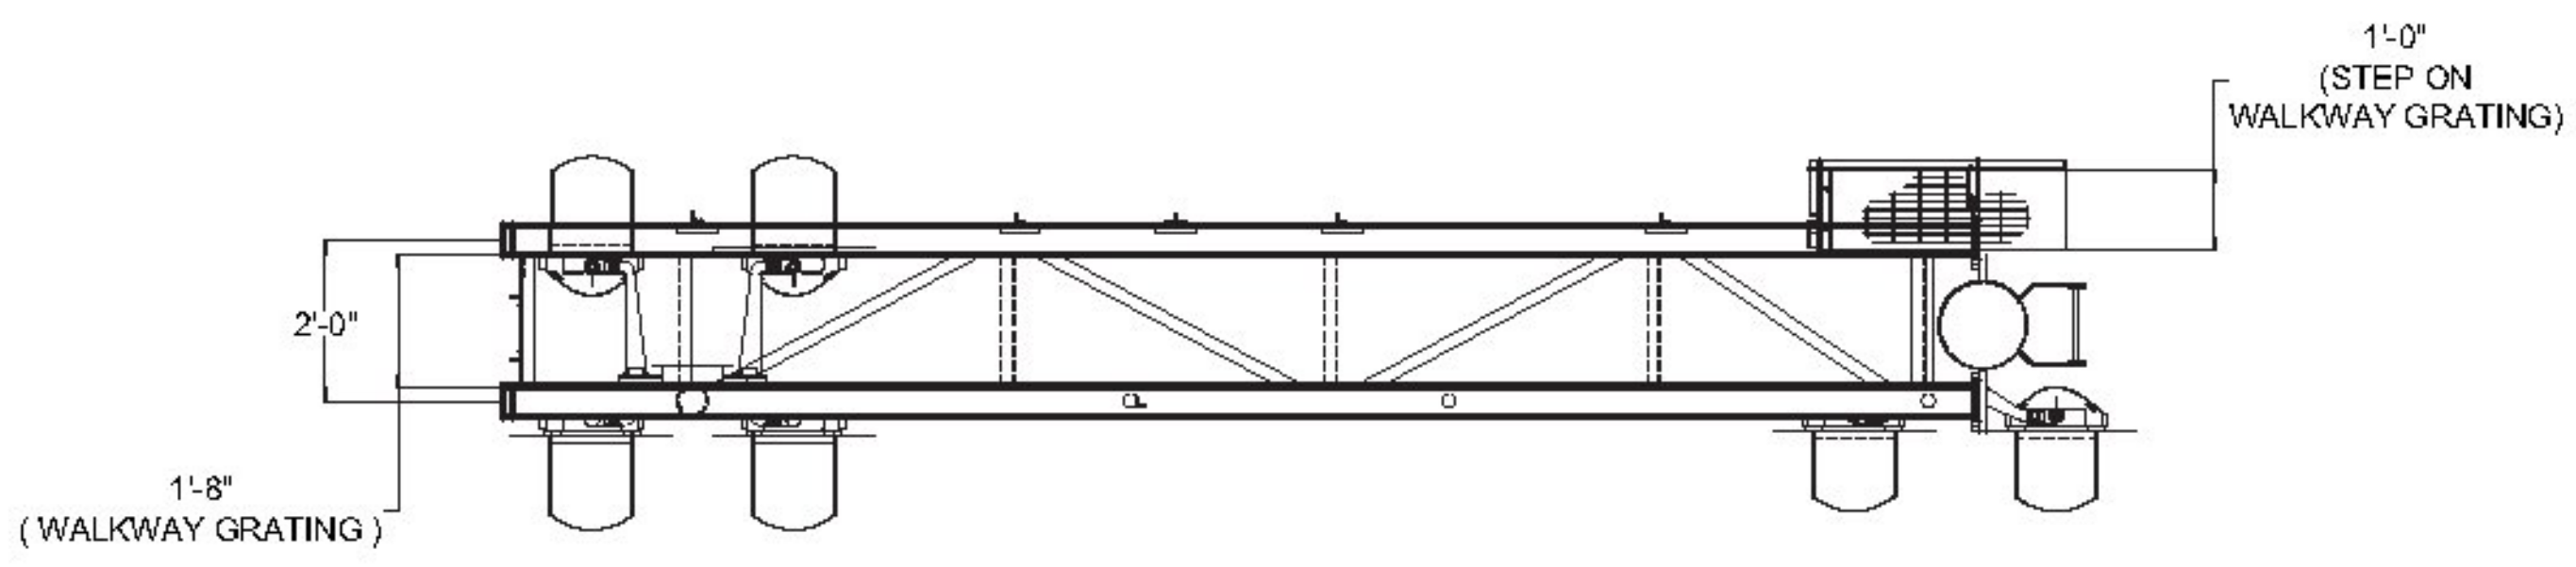


**INCLUDED:**

- * #10 OKONITE CABLE
- * PRECAST FOUNDATION (DP-4B)


**NOT INCLUDED:**

- * BELL
- * TRACK SIGN
- * STOP ON RED SIGN
- * SIDE STREET STANDOFF BRACKET
- * MALFUNCTION SIGN BRACKET
- * RESISTORS IN THE CROSSARMS
- * SEALTITE ENTRANCE CONDUIT
- * SEALTITE ENTRANCE CONNECTOR
- * LADDER CAGE
- * SURE CLIMB SAFETY CABLE ASSEMBLY
- * TOE KICK PLATE ON ARM

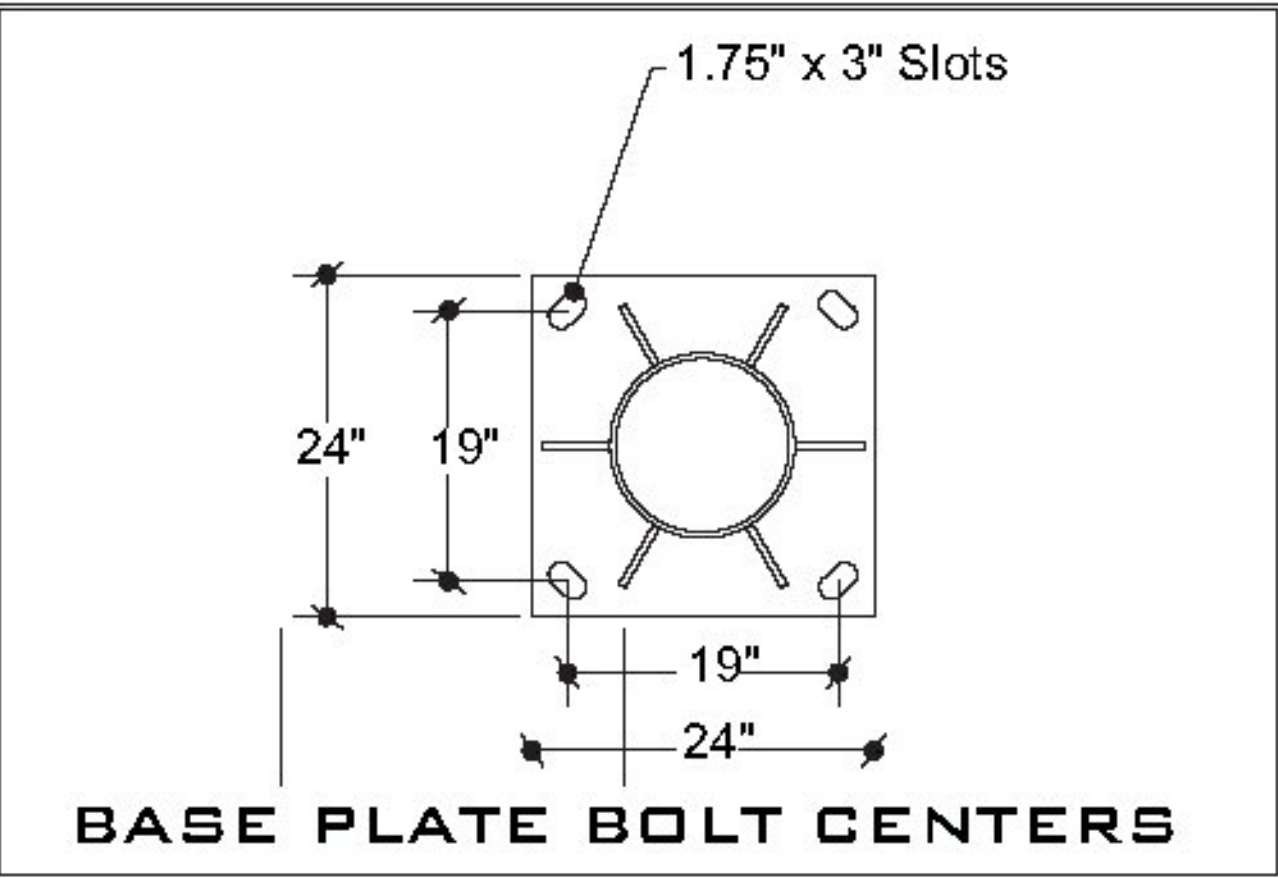


**SPECIFICATIONS AND NOTES**

1. ALL ALUMINUM CONSTRUCTION UTILIZING 6061-T6 EXTRUSIONS.
2. STAINLESS STEEL HARDWARE PROVIDED.
3. GMAW WELDING PROCESS UTILIZING 5356 ALUMINUM ALLOY FILLER MATERIAL.
4. CABLE IS ROUTED THROUGH MAST PIPE, ARM PIPE, OR FLEXIBLE CONDUIT.
5. ALL THREADED OPENINGS PLUGGED BEFORE SHIPMENT.
6. MEETS SPECIAL PROVISIONS FOR: ARLINGTON STP 0114(4) DATED FEBRUARY 24, 2016
7. DESIGN WIND SPEED = 100 MPH (AASHTO)

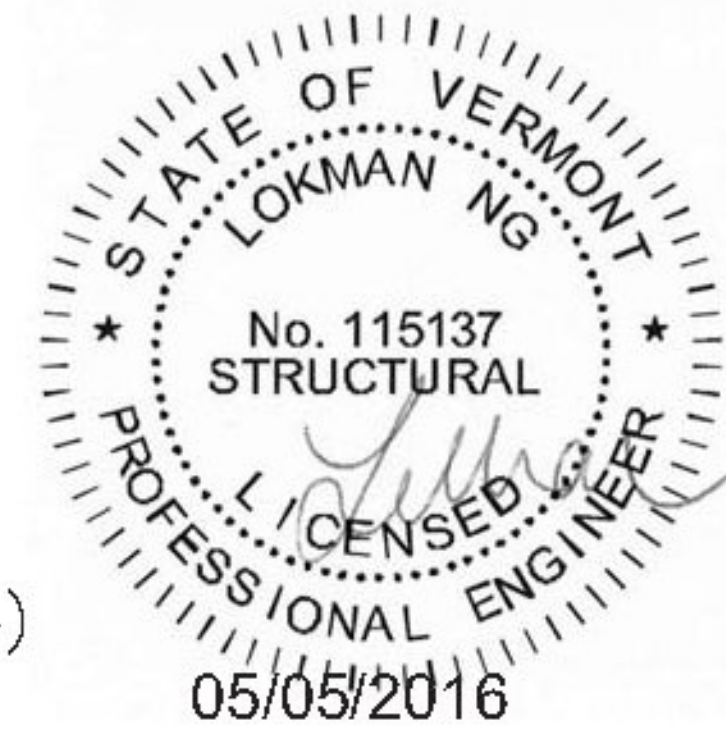

<b>PROGRESS P/N 94CANT1655M</b>			
JOB #	PRODUCTION ORDER		
THE DRAWING IS PROPRIETARY PROPERTY OF PROGRESS RAIL SERVICES		Louisville Signal Division	
DRAWN BY:	JEA	DATE:	04/11/16
CHECKED BY:	XXX	DATE:	00/00/00
UNLESS OTHERWISE SPECIFIED DIMENSIONS ARE IN INCHES		ARLINGTON, VT	
TOLERANCES		16' RH HIGHWAY CANTILEVER	
DECIMAL	FRACTIONS	DRAWING #:	<b>9454ST0102</b>
.0625"+	+ 1/16"	REV.	A
.0625"-	- 1/16"	DO NOT SCALE THIS DRAWING	



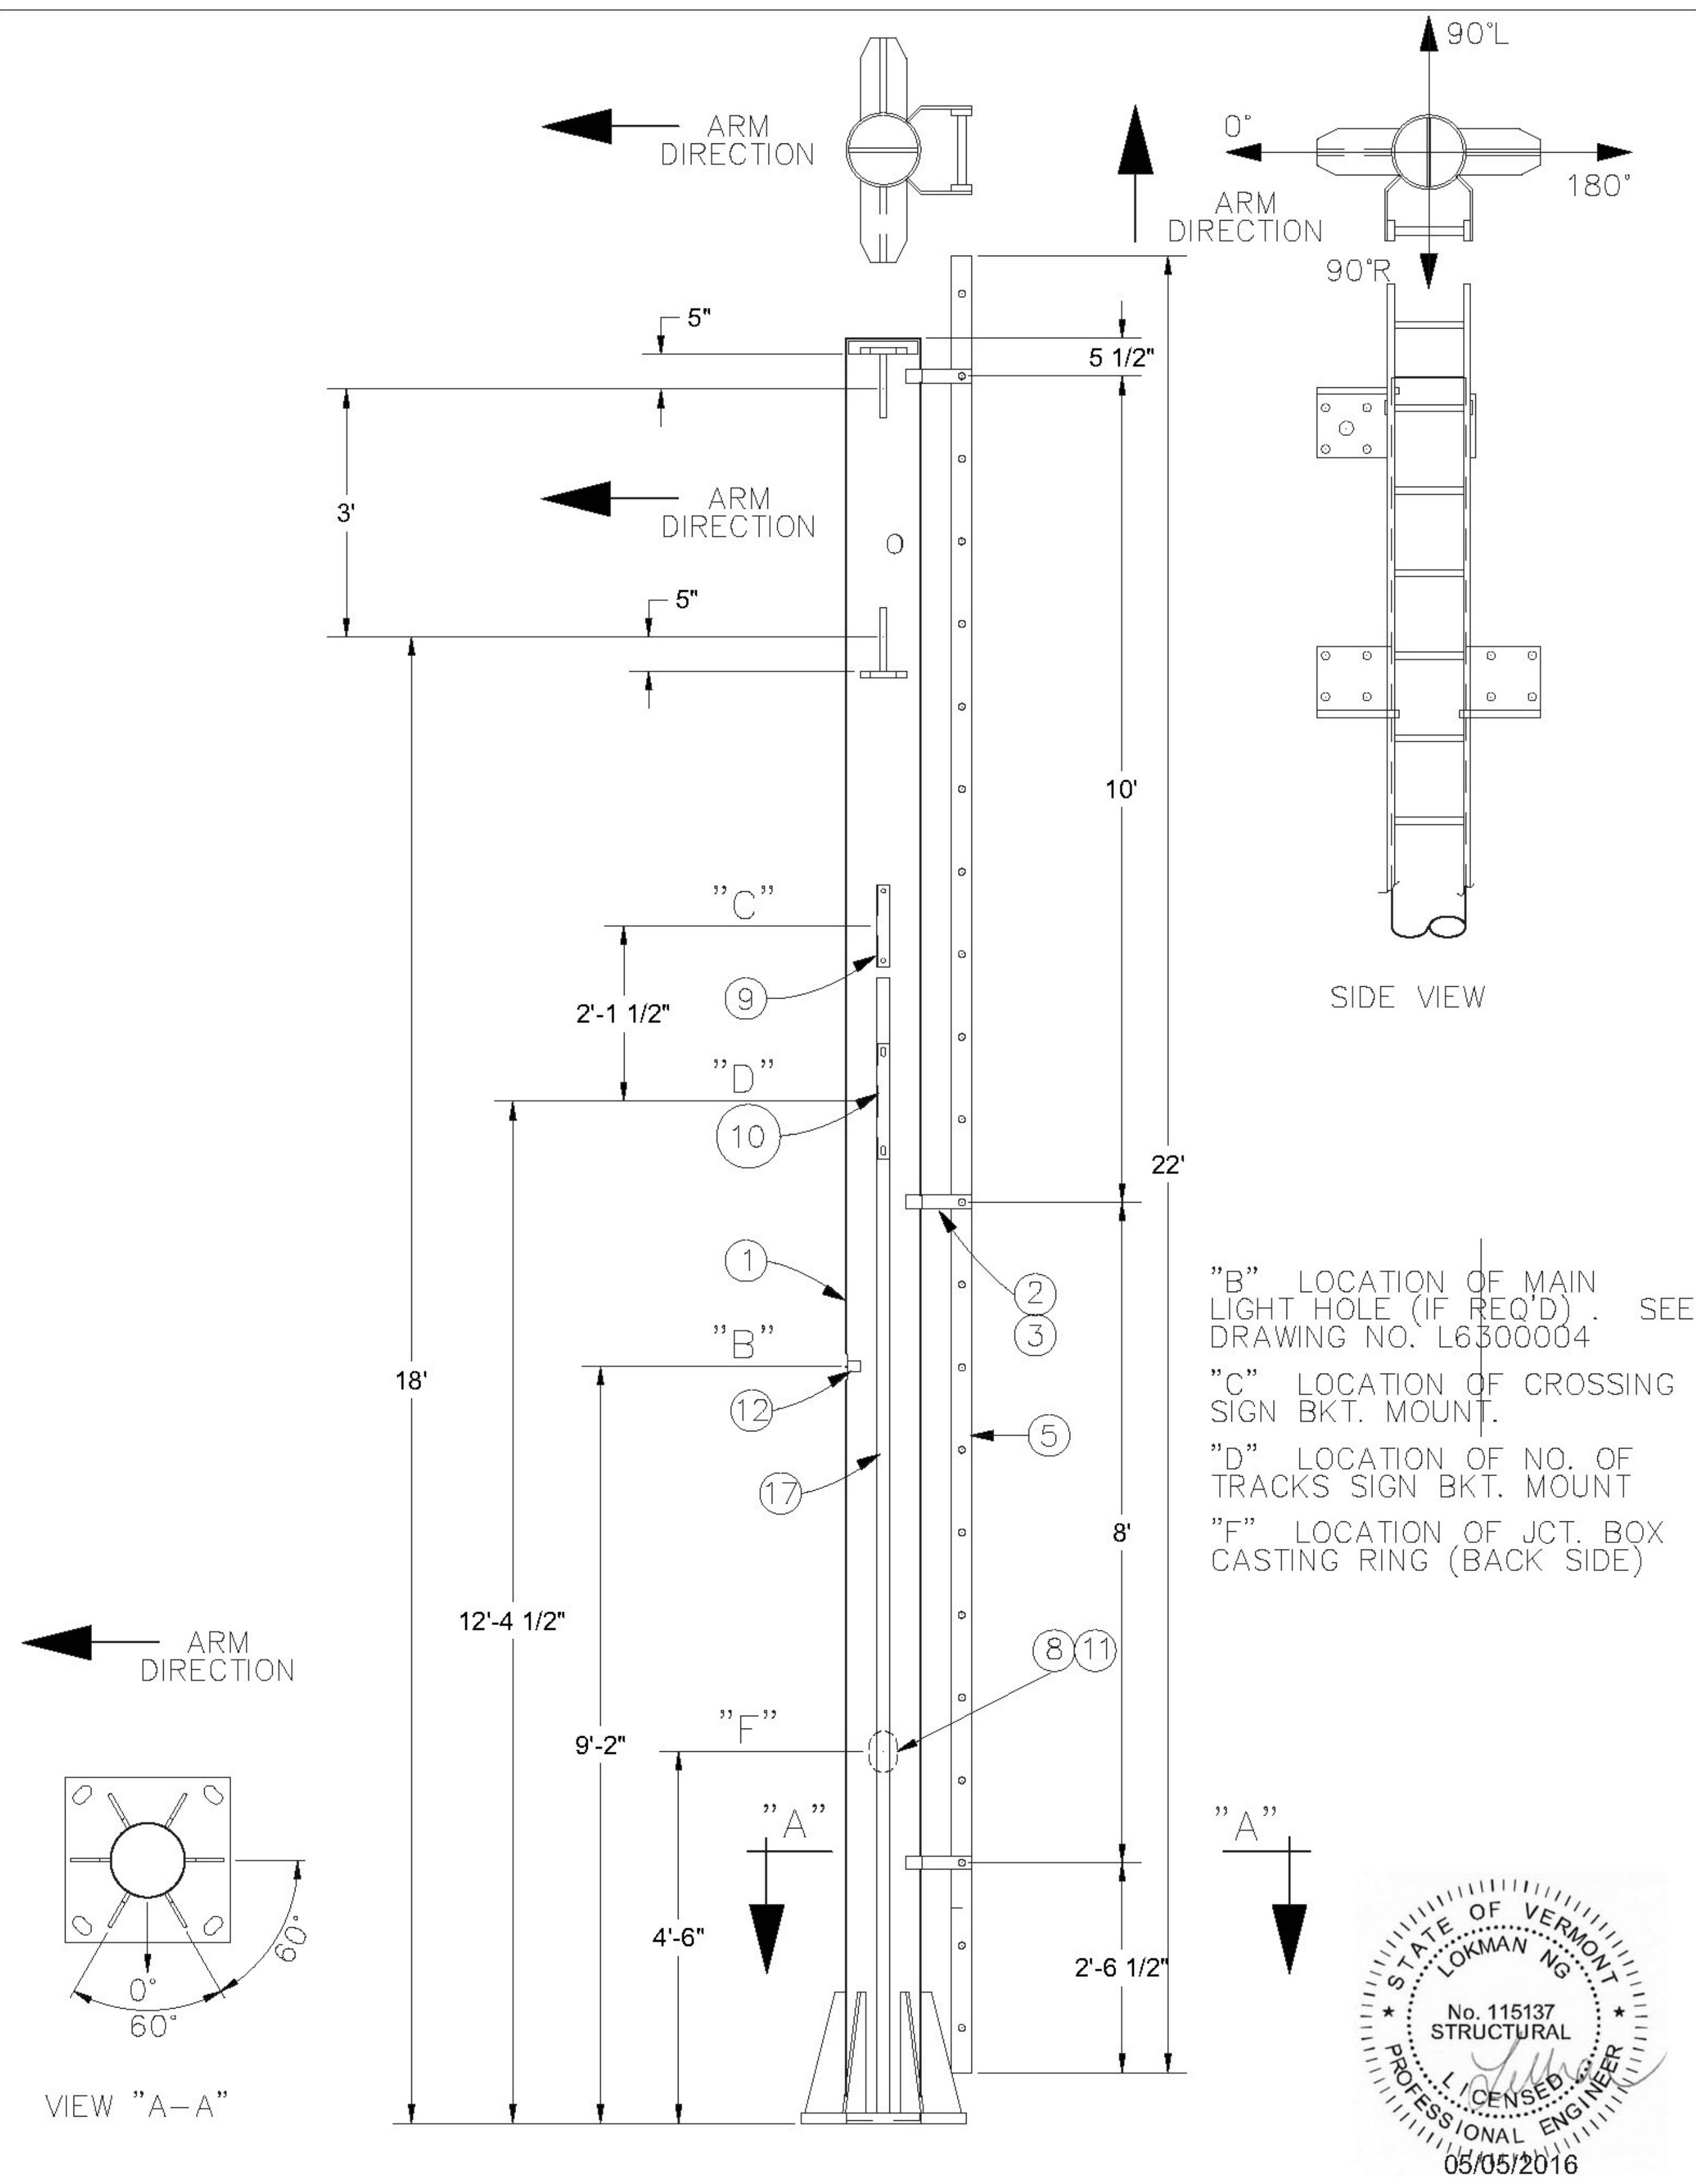

"B" LOCATION OF MAIN LIGHT HOLE (IF REQ'D) . SEE DRAWING NO. L6300004

"C" LOCATION OF CROSSING SIGN BKT. MOUNT.

"D" LOCATION OF NO. OF TRACKS SIGN BKT. MOUNT

"F" LOCATION OF JCT. BOX CASTING RING (BACK SIDE)

J					
I					
H					
G					
F					
E					
D					
C					
B					
A					
REV.	DESCRIPTION	REVISED BY	DATE	ENC'R APPROVALS	DATE
REVISIONS					

**PROGRESS P/N 9454ST0003**

JOB # PRODUCTION ORDER

**PROGRESS RAIL SERVICES**  
A Caterpillar Company

**Louisville Signal Division**

THE DRAWING IS PROPRIETARY PROPERTY OF PROGRESS RAIL SERVICES

UNLESS OTHERWISE SPECIFIED DIMENSIONS ARE IN INCHES

TOLERANCES  
DECIMAL      FRACTIONS  
.0625" +      + 1/16"  
.0625" -      - 1/16"  
DO NOT SCALE THIS DRAWING



DRAWN BY: JEA    DATE: 04/26/16    SCALE: NONE  
CHECKED BY: xxx    DATE: 00/00/00    SHEET: 1 OF 1

TYPICAL PHASE 2 CANT. MAST-12" MAST R.H. ASS'Y (MAST MOUNTED JUNCTION BOX)

DRAWING #: **9454ST0003**    REV. A

# SALES DRAWING

TORQUE VALUES	
TORQUE VALUES FOR 18-8 S/S HARDWARE WITHOUT ANTI-SEIZE COMPOUND.	
1. 3/8"-16 BOLTS:	236 IN. LBS.
2. 1/2"-13 BOLTS:	517 IN. LBS.
3. 5/8"-11 BOLTS:	1110 IN. LBS.
4. 1"-8 BOLTS:	3440 IN. LBS.
TORQUE VALUES FOR 18-8 S/S HARDWARE WITH ANTI-SEIZE COMPOUND.	
1. 3/8"-16 BOLTS:	201 IN. LBS.
2. 1/2"-13 BOLTS:	439 IN. LBS.
3. 5/8"-11 BOLTS:	944 IN. LBS.
4. 1"-8 BOLTS:	2924 IN. LBS.

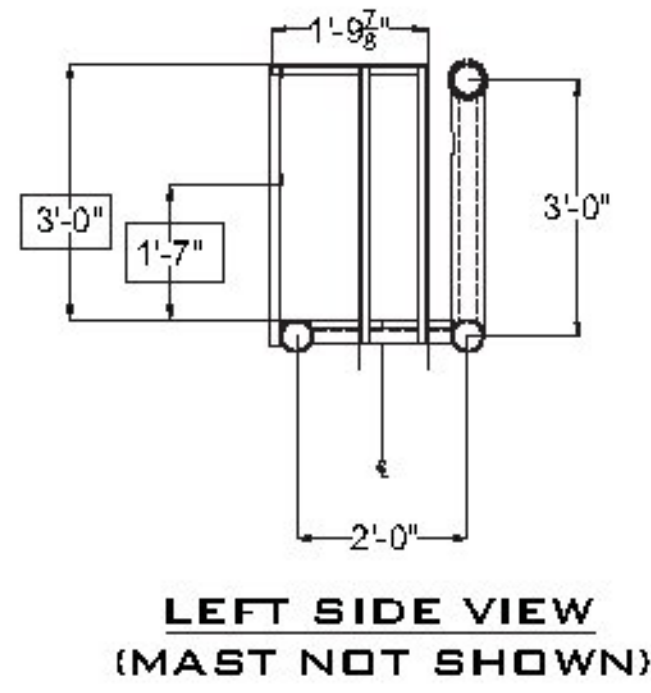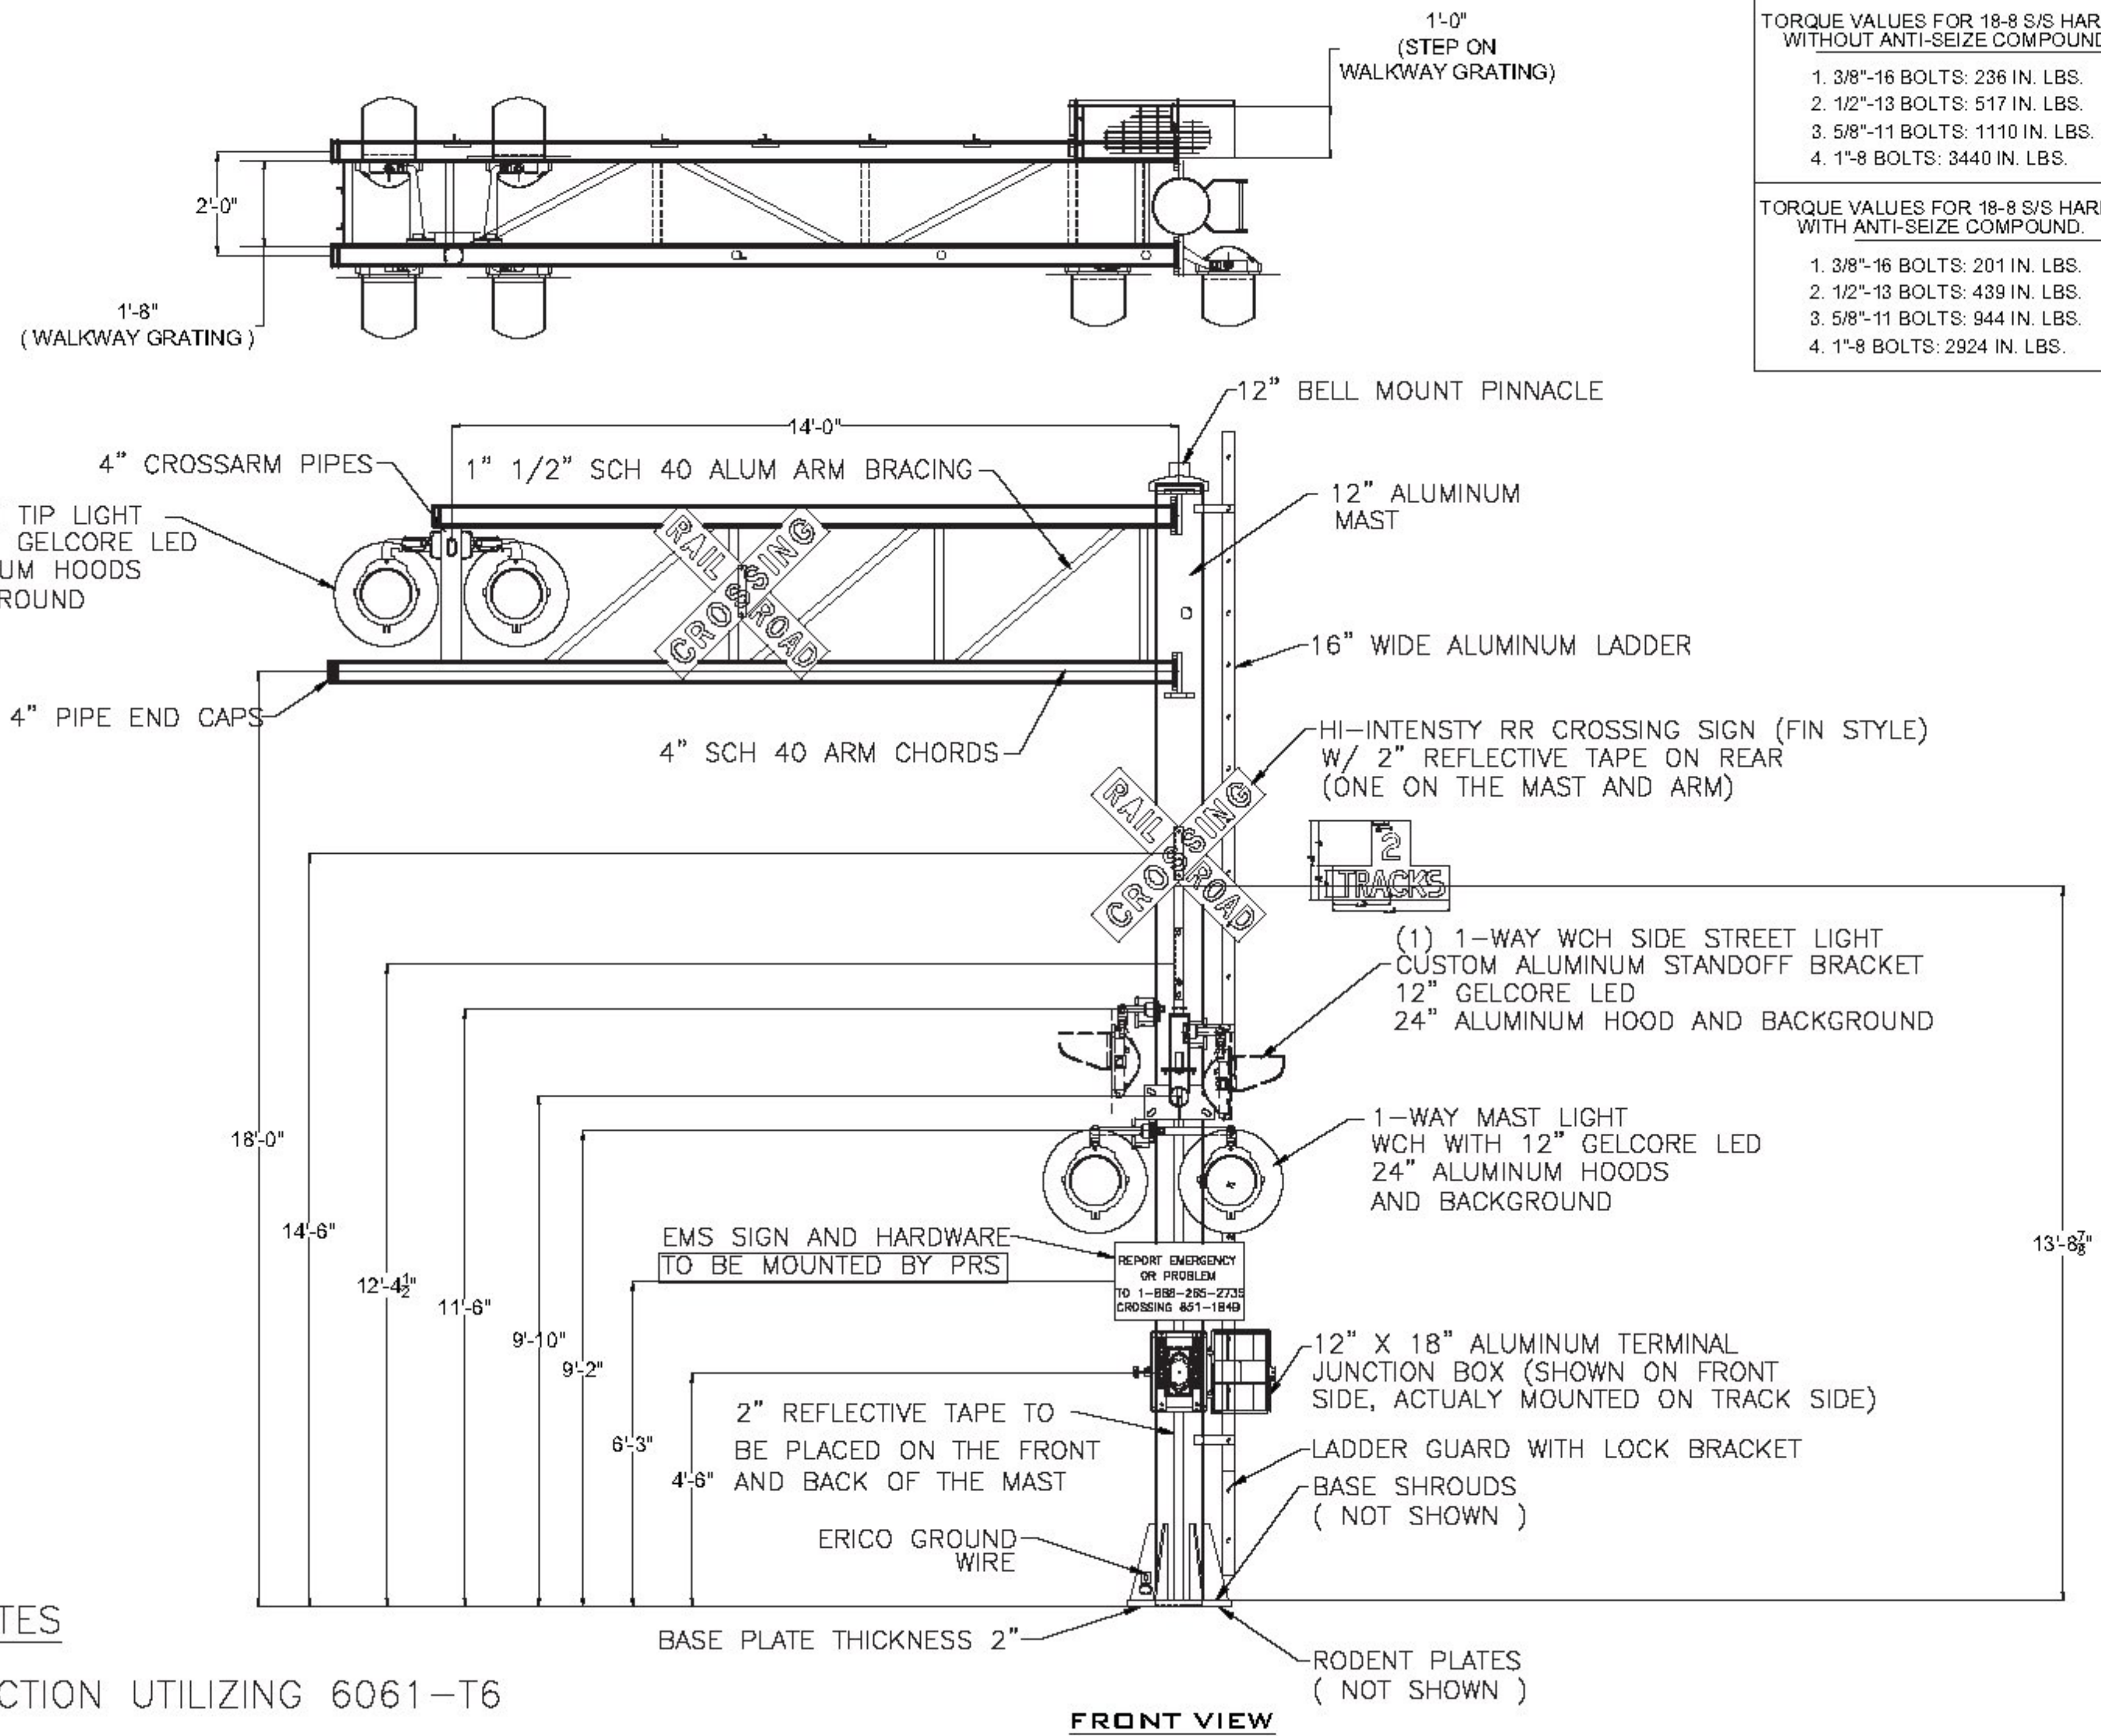

**INCLUDED:**


- * #10 OKONITE CABLE
- * PRECAST FOUNDATION (DP-4B)

**NOT INCLUDED:**

- * BELL
- * TRACK SIGN
- * STOP ON RED SIGN
- * MALFUNCTION SIGN BRACKET
- * RESISTORS IN THE CROSSARMS
- * SEALTITE ENTRANCE CONDUIT
- * SEALTITE ENTRANCE CONNECTOR
- * LADDER CAGE
- * SURE CLIMB SAFETY CABLE ASSEMBLY
- * TOE KICK PLATE ON ARM


**SPECIFICATIONS AND NOTES**

1. ALL ALUMINUM CONSTRUCTION UTILIZING 6061-T6 EXTRUSIONS.
2. STAINLESS STEEL HARDWARE PROVIDED.
3. GMAW WELDING PROCESS UTILIZING 5356 ALUMINUM ALLOY FILLER MATERIAL.
4. CABLE IS ROUTED THROUGH MAST PIPE, ARM PIPE, OR FLEXIBLE CONDUIT.
5. ALL THREADED OPENINGS PLUGGED BEFORE SHIPMENT.
6. MEET SPECIAL PROVISIONS FOR: ARLINGTON STP 0114(4) DATED FEBRUARY 24, 2016
7. DESIGN WIND SPEED = 100 MPH (AASHTO)

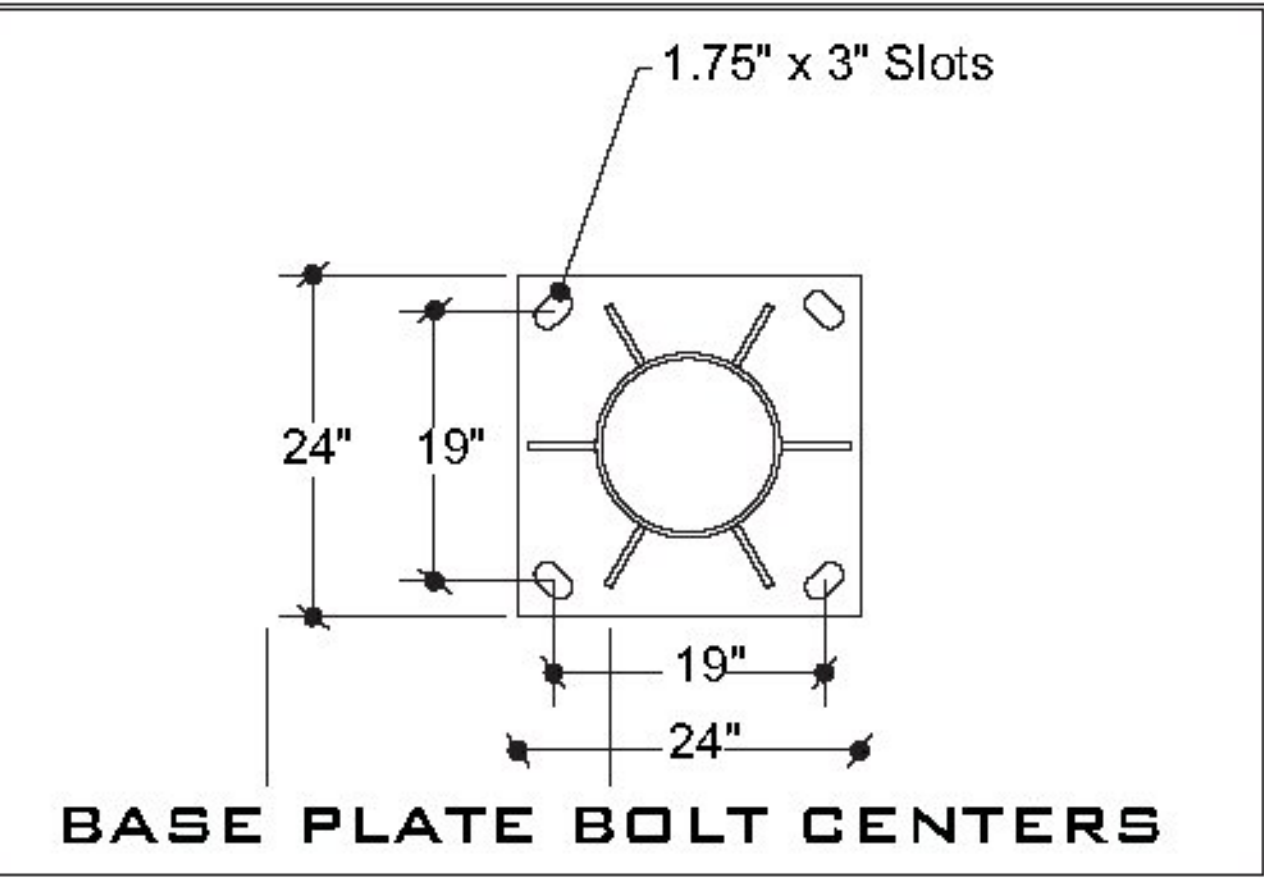

PROGRESS P/N 94CANT1654M			
JOB #	PRODUCTION ORDER	 <b>Louisville Signal Division</b>	
THE DRAWING IS PROPRIETARY PROPERTY OF PROGRESS RAIL SERVICES			
CHECKED BY:	XXX	DATE:	00/00/00
UNLESS OTHERWISE SPECIFIED DIMENSIONS ARE IN INCHES		ARLINGTON, VT	
TOLERANCES		14' RH HIGHWAY CANTILEVER	
DECIMAL	FRACTIONS	DRAWING #:	<b>9454ST0101</b>
.0625"+	+ 1/16"	REV.	C
.0625"-	- 1/16"	DO NOT SCALE THIS DRAWING	



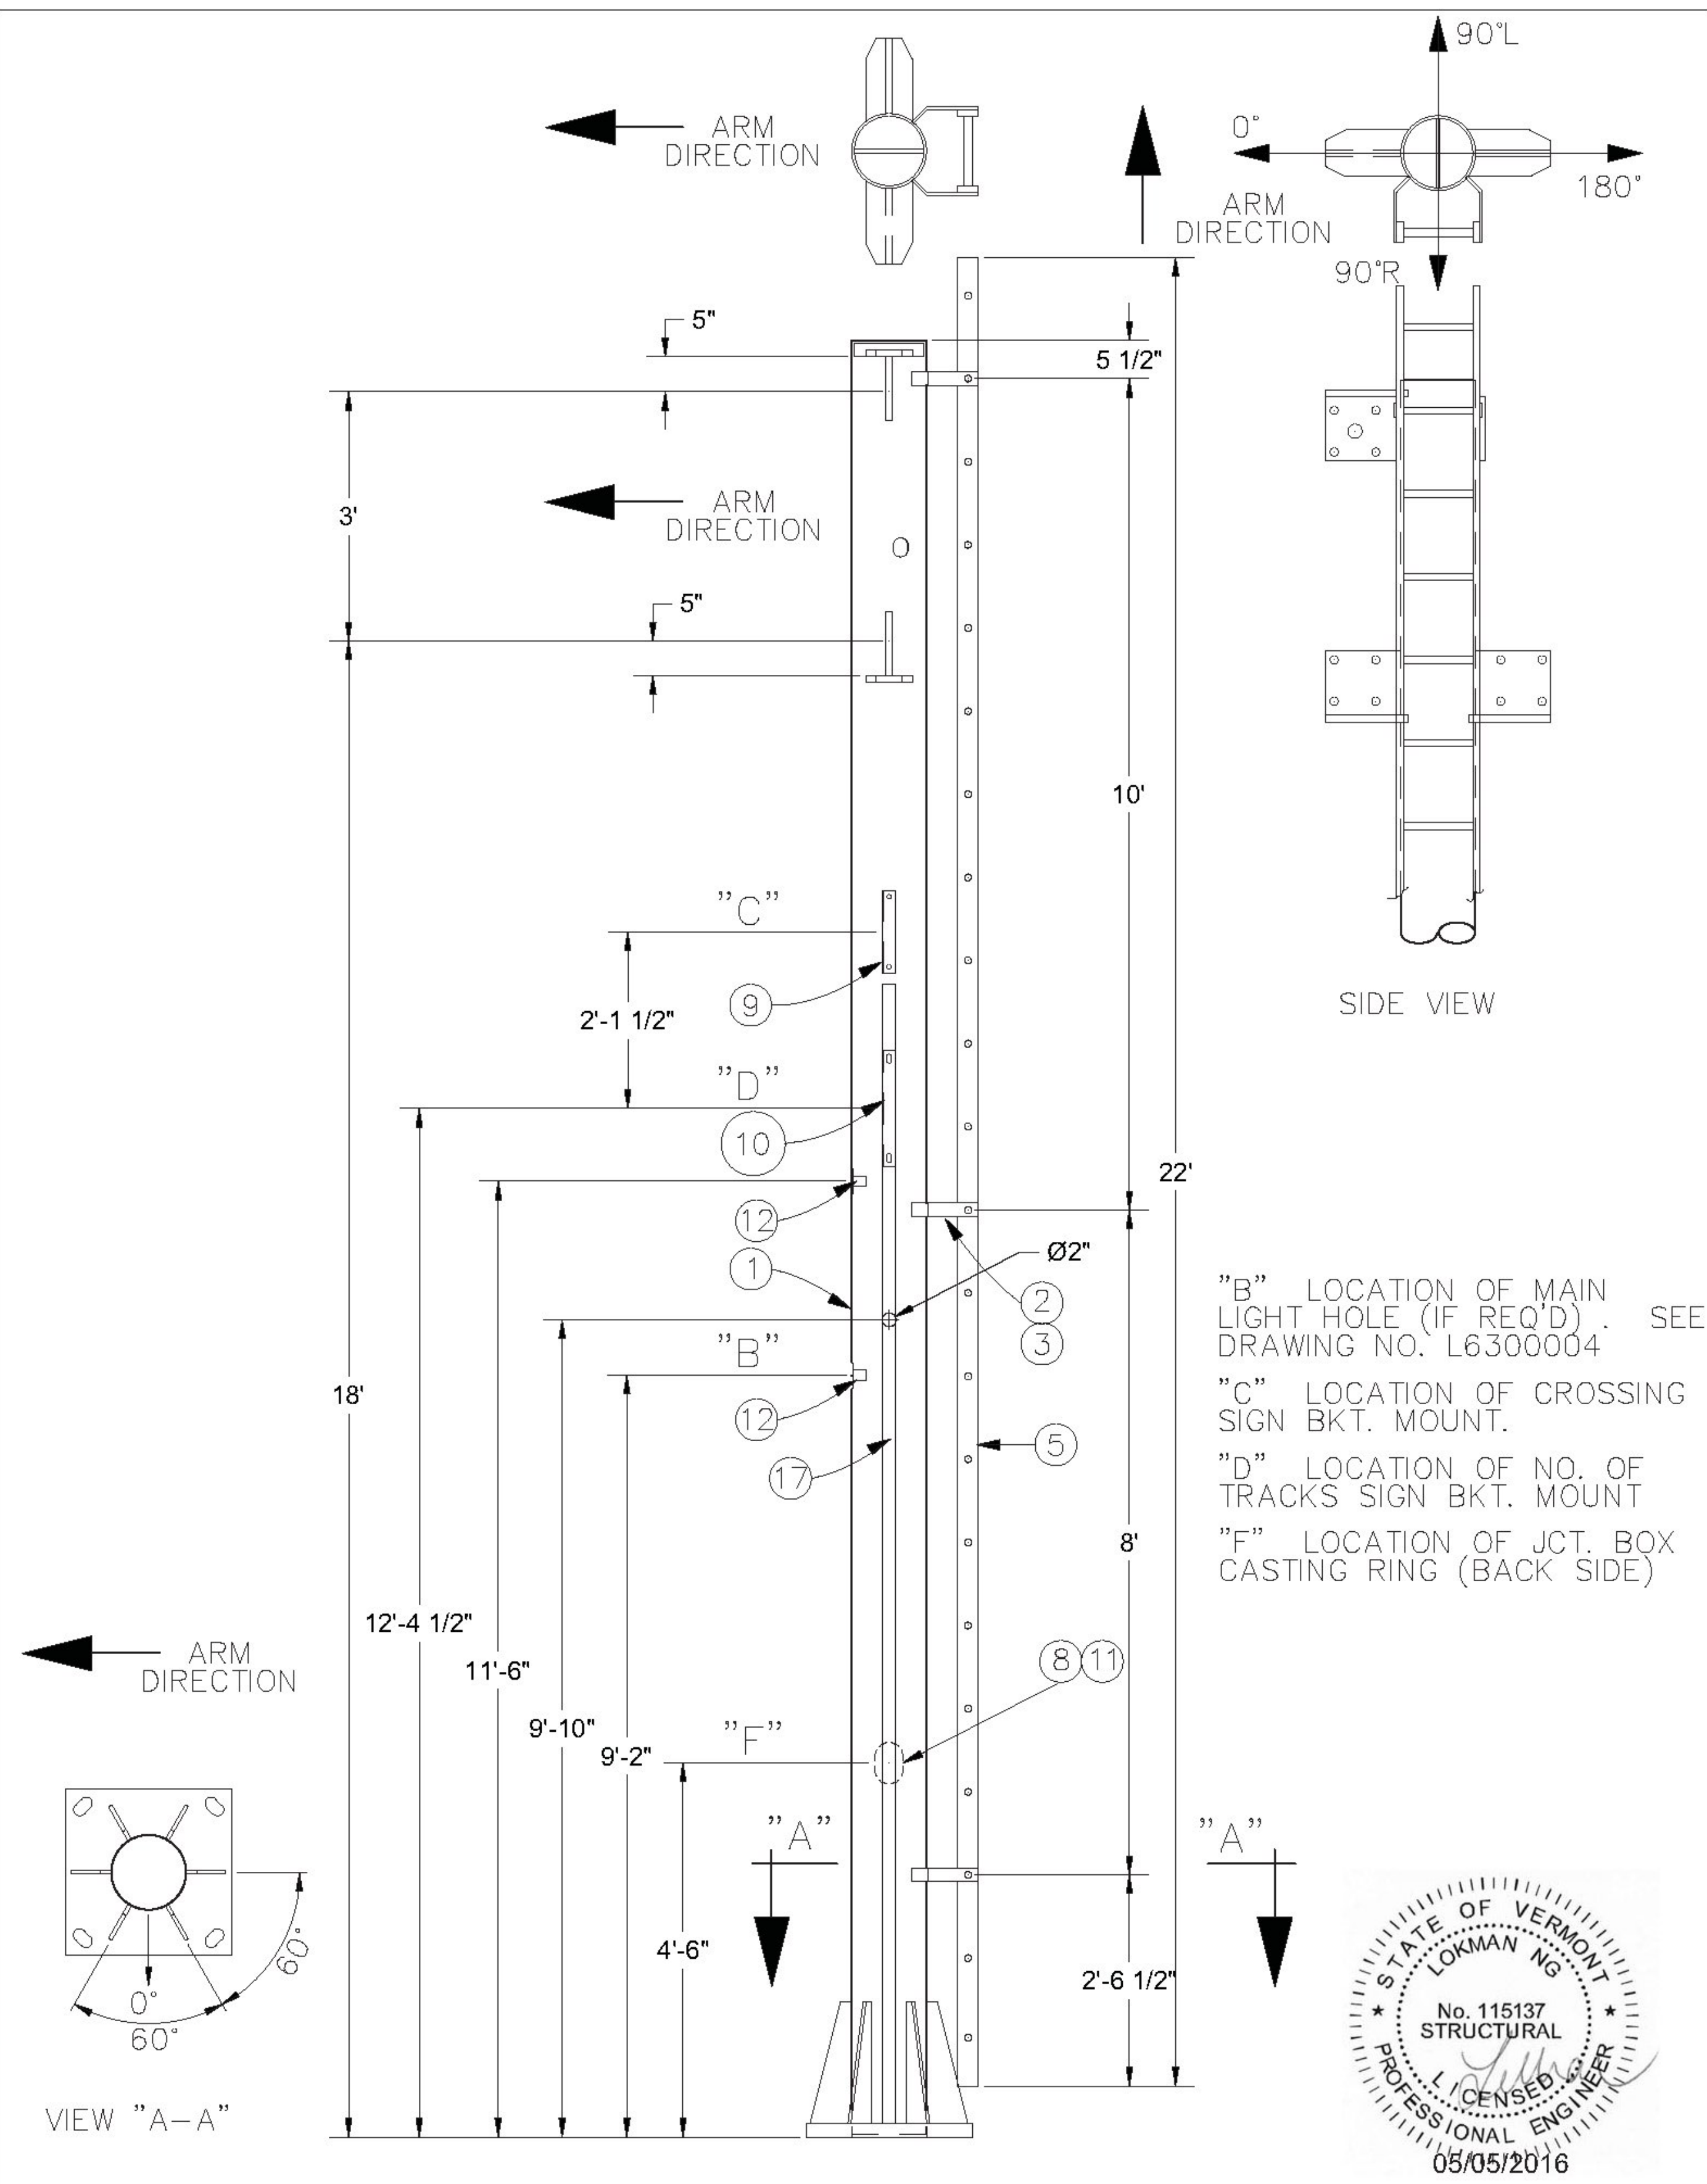

"B" LOCATION OF MAIN LIGHT HOLE (IF REQ'D) . SEE DRAWING NO. L6300004  
 "C" LOCATION OF CROSSING SIGN BKT. MOUNT.  
 "D" LOCATION OF NO. OF TRACKS SIGN BKT. MOUNT  
 "F" LOCATION OF JCT. BOX CASTING RING (BACK SIDE)



J					
I					
H					
G					
F					
E					
D					
C					
B					
A					
REV.	DESCRIPTION	REVISED BY	DATE	ENC'R APPROVALS	DATE
REVISIONS					

**PROGRESS P/N 9454ST0002**

JOB # PRODUCTION ORDER

**PROGRESS RAIL SERVICES**  
A Caterpillar Company

**Louisville Signal Division**





THE DRAWING IS PROPRIETARY PROPERTY OF PROGRESS RAIL SERVICES

UNLESS OTHERWISE SPECIFIED DIMENSIONS ARE IN INCHES

TOLERANCES  
 DECIMAL + 1/16  
 FRACTIONAL + 1/16  
 .0625" - 1/16"  
 DO NOT SCALE THIS DRAWING

DRAWN BY: JEA DATE: 04/26/16 SCALE: NONE  
 CHECKED BY: xxx DATE: 00/00/00 SHEET: 1 OF 1  
 TYPICAL PHASE 2 CANT. MAST-12" MAST R.H. ASS'Y (MAST MOUNTED JUNCTION BOX)

DRAWING #: **9454ST0002** REV. A

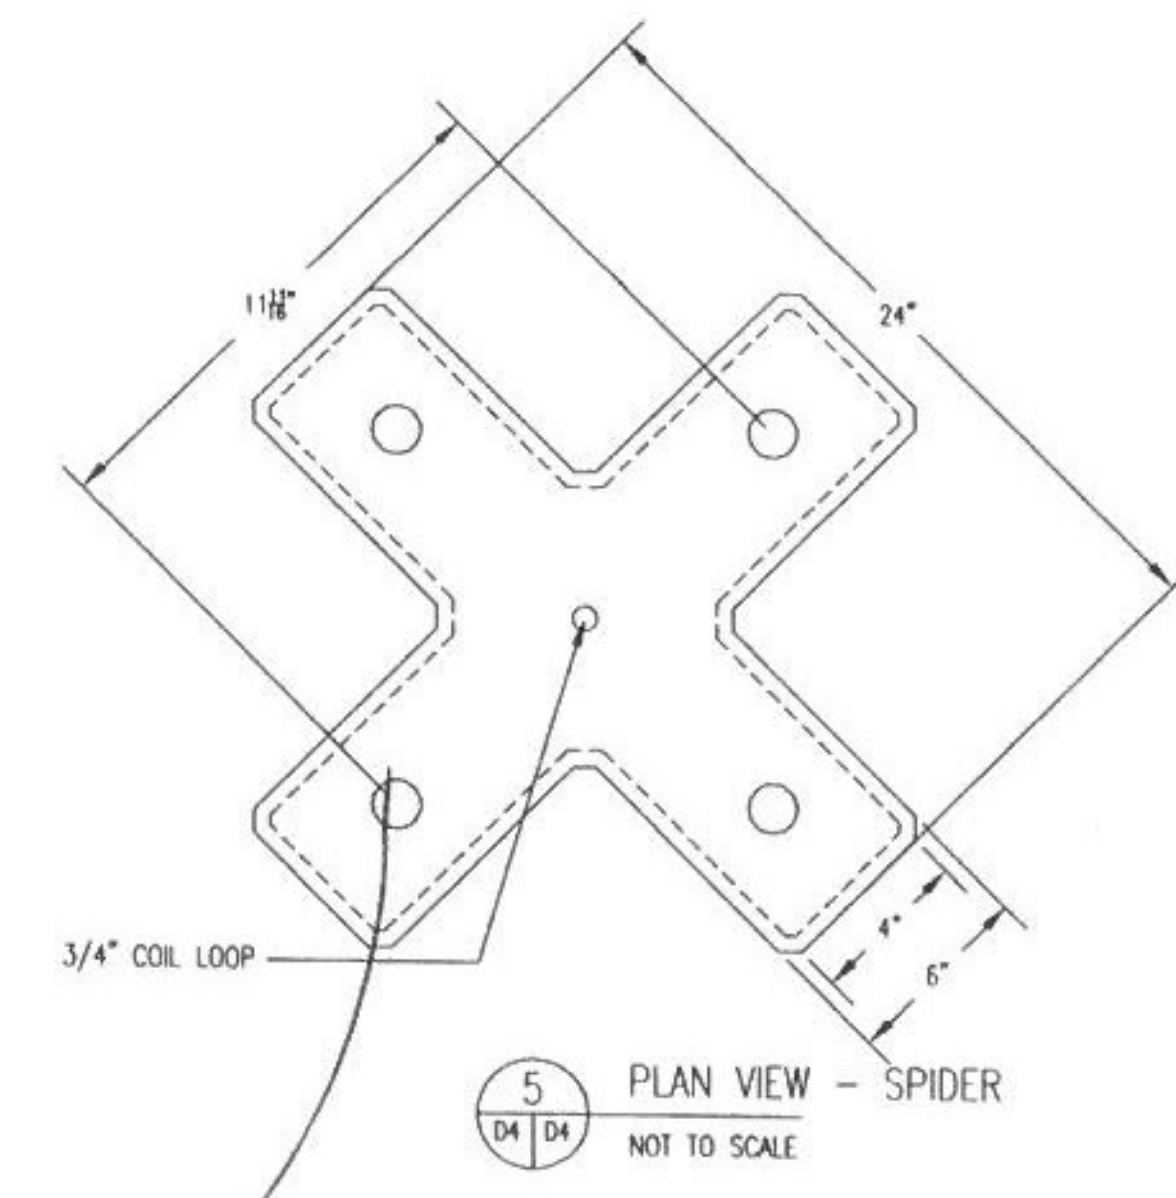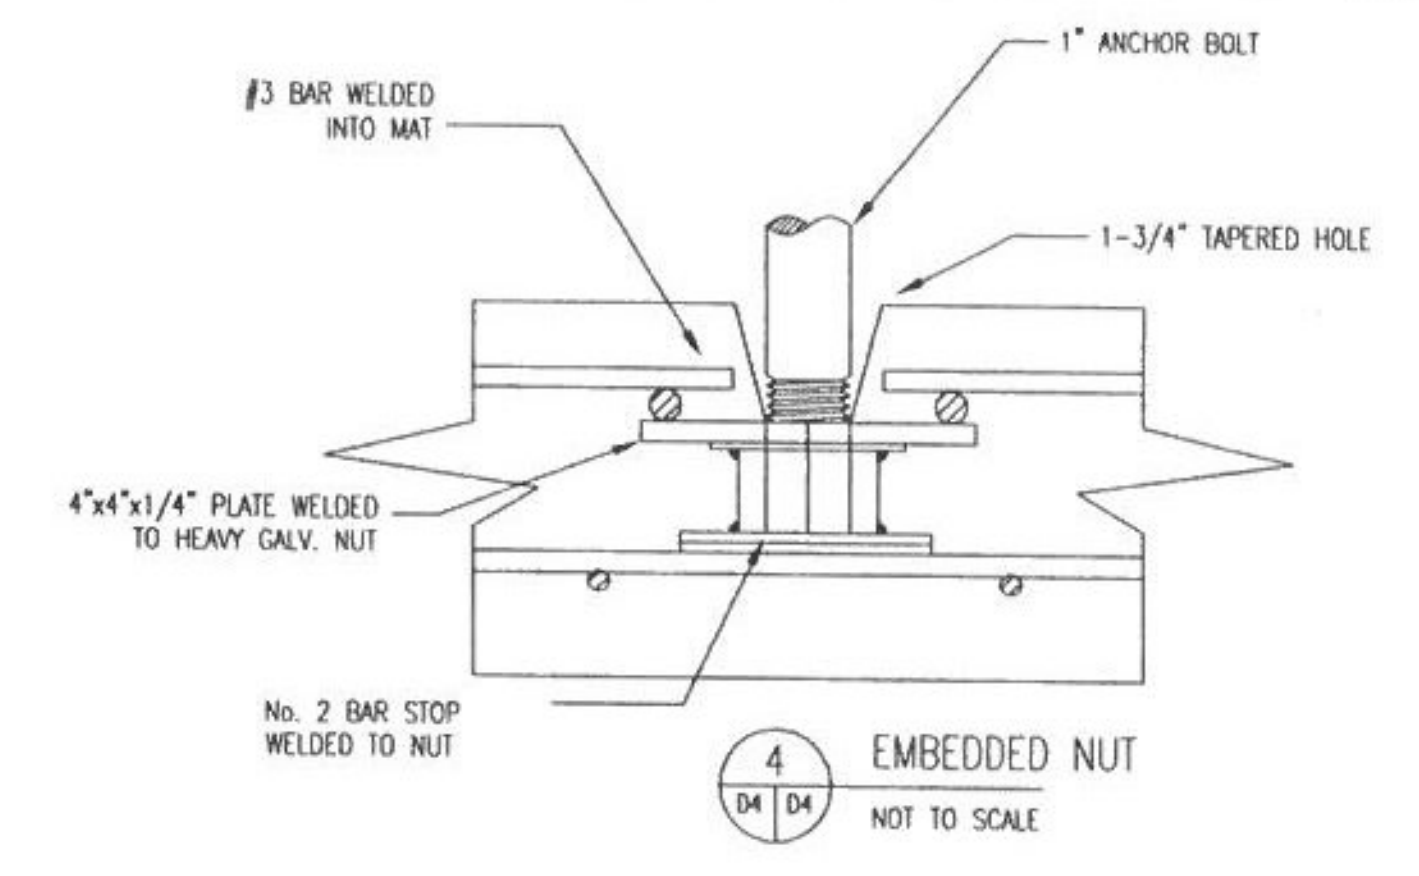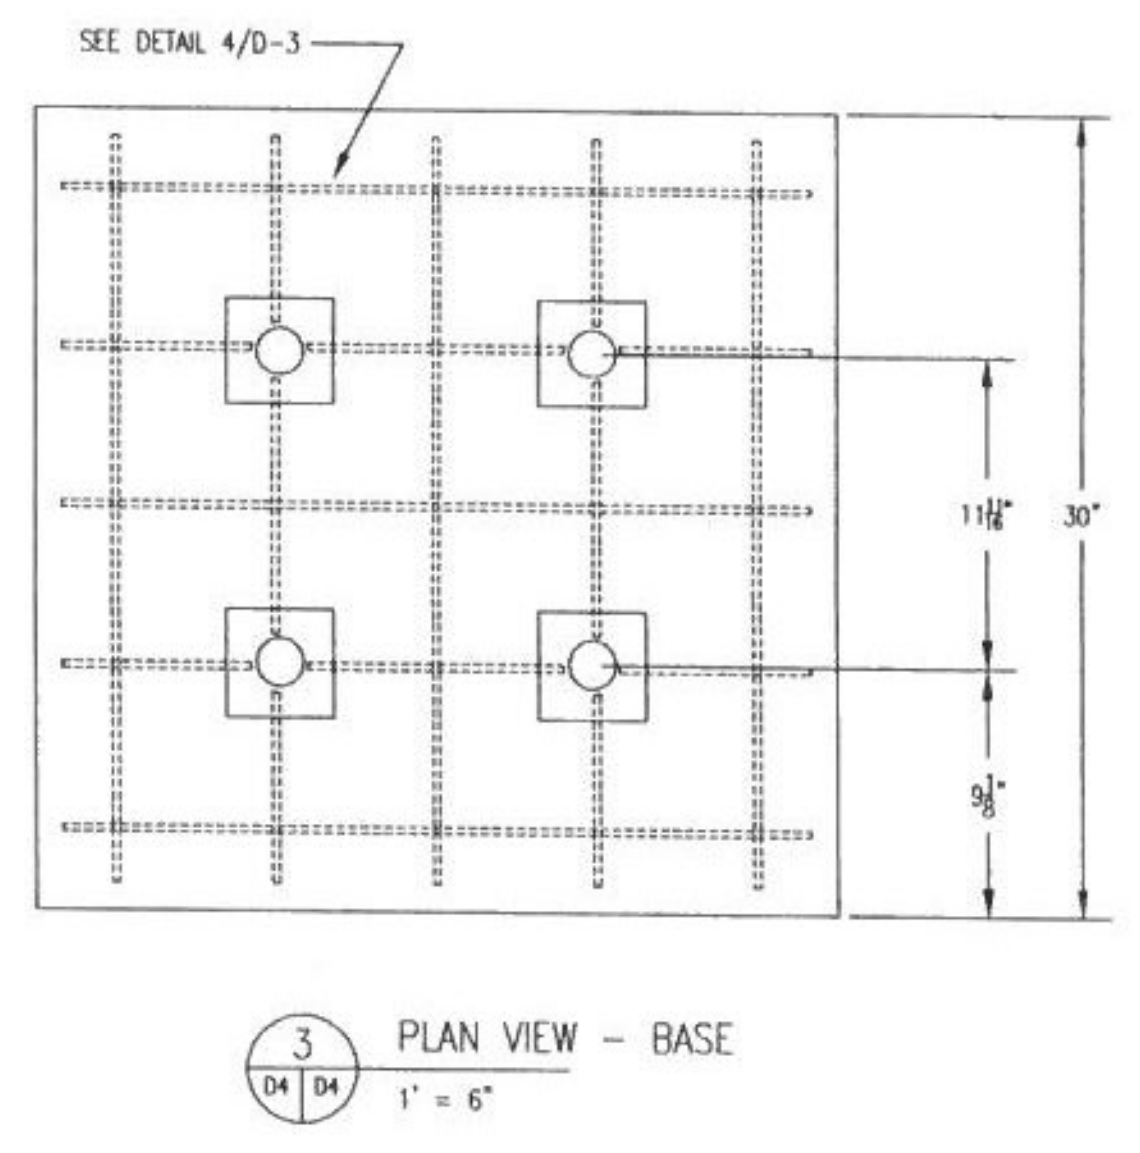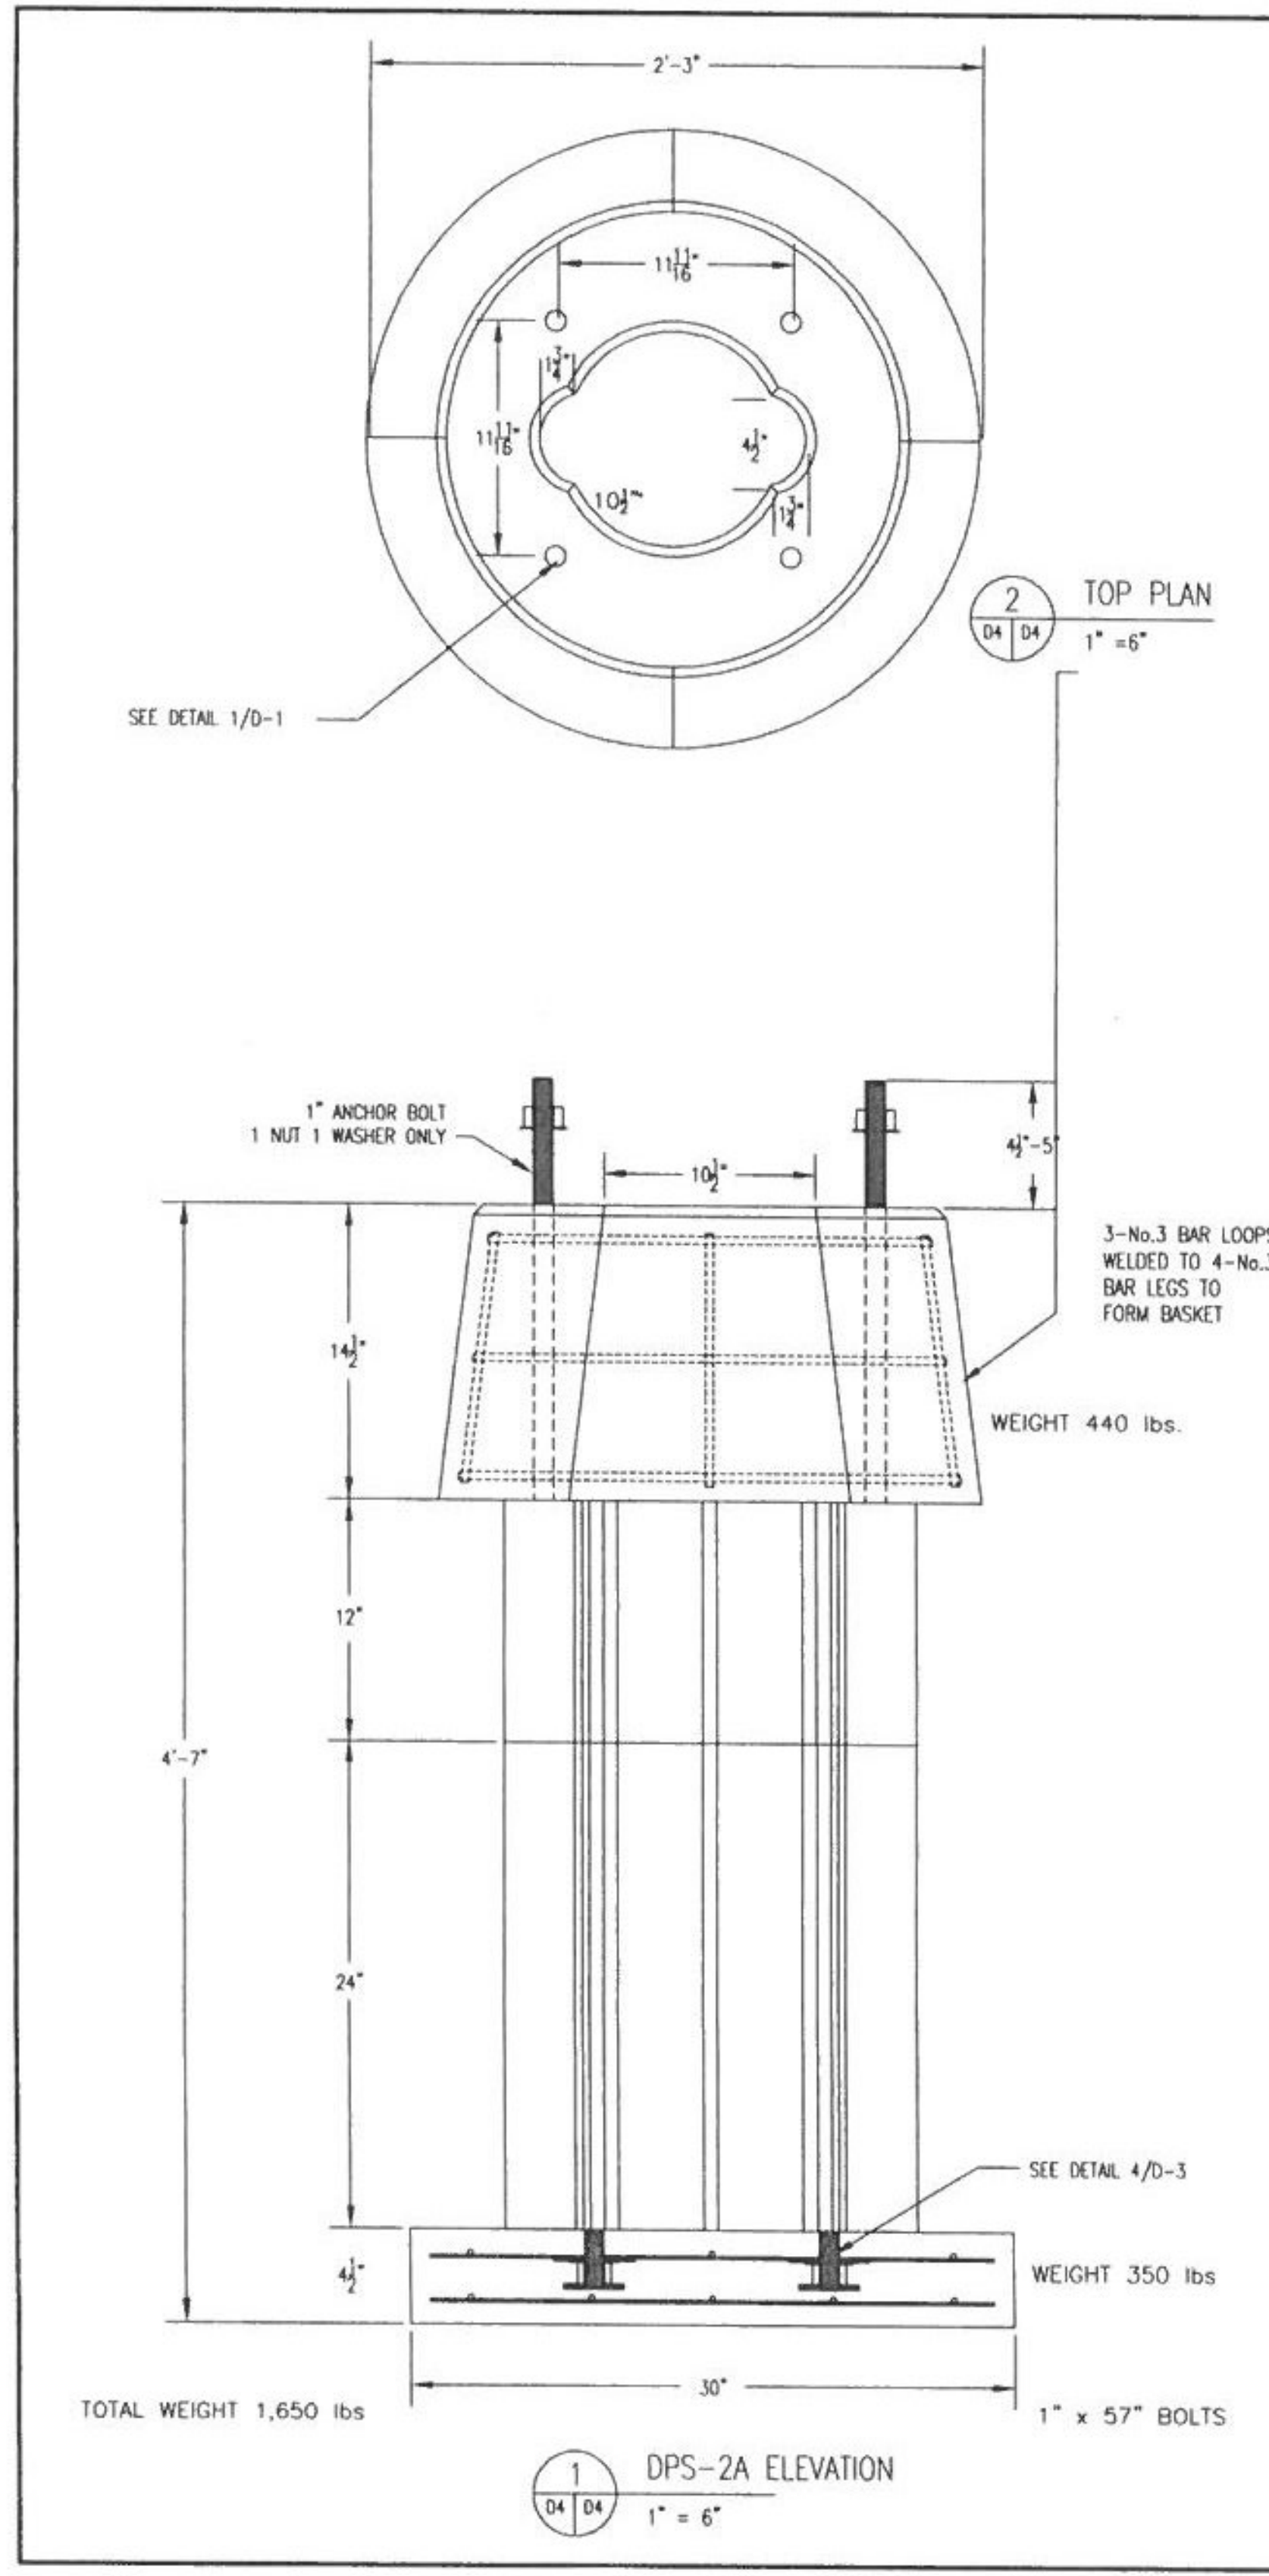

**Dixie Precast, Inc.**  
 2950 Argetlette Drive  
 Austell, Georgia 30106  
 770-944-1930 FAX: 770-944-9136  
 website: www.dixieprecast.com

DATE	BY	REVISION

PRODUCT IS COVERED BY ONE OR MORE OF THE FOLLOWING PATENTS


**DPS-2A**  
 PRECAST CONCRETE FOUNDATION FOR 4", 5" and 6" WAST

THIS PRINT REPRESENTS A PROPRIETARY PRODUCT AND IS OWNED BY DIXIE PRECAST, INC. FOR THE USE OF ITS CUSTOMERS. IS NOT TO BE COPIED, NOR COPIED BY ANY OTHER PARTY WITHOUT THE EXPRESS WRITTEN APPROVAL OF THE OWNER


D-4

PATENTED

E. ARLINGTON RD.  
TOWN OF ARLINGTON,  
BENNINGTON COUNTY  
VERMONT RAILWAY  
B&R SUBDIVISION  
DOT# 851.184B, MP 13.59

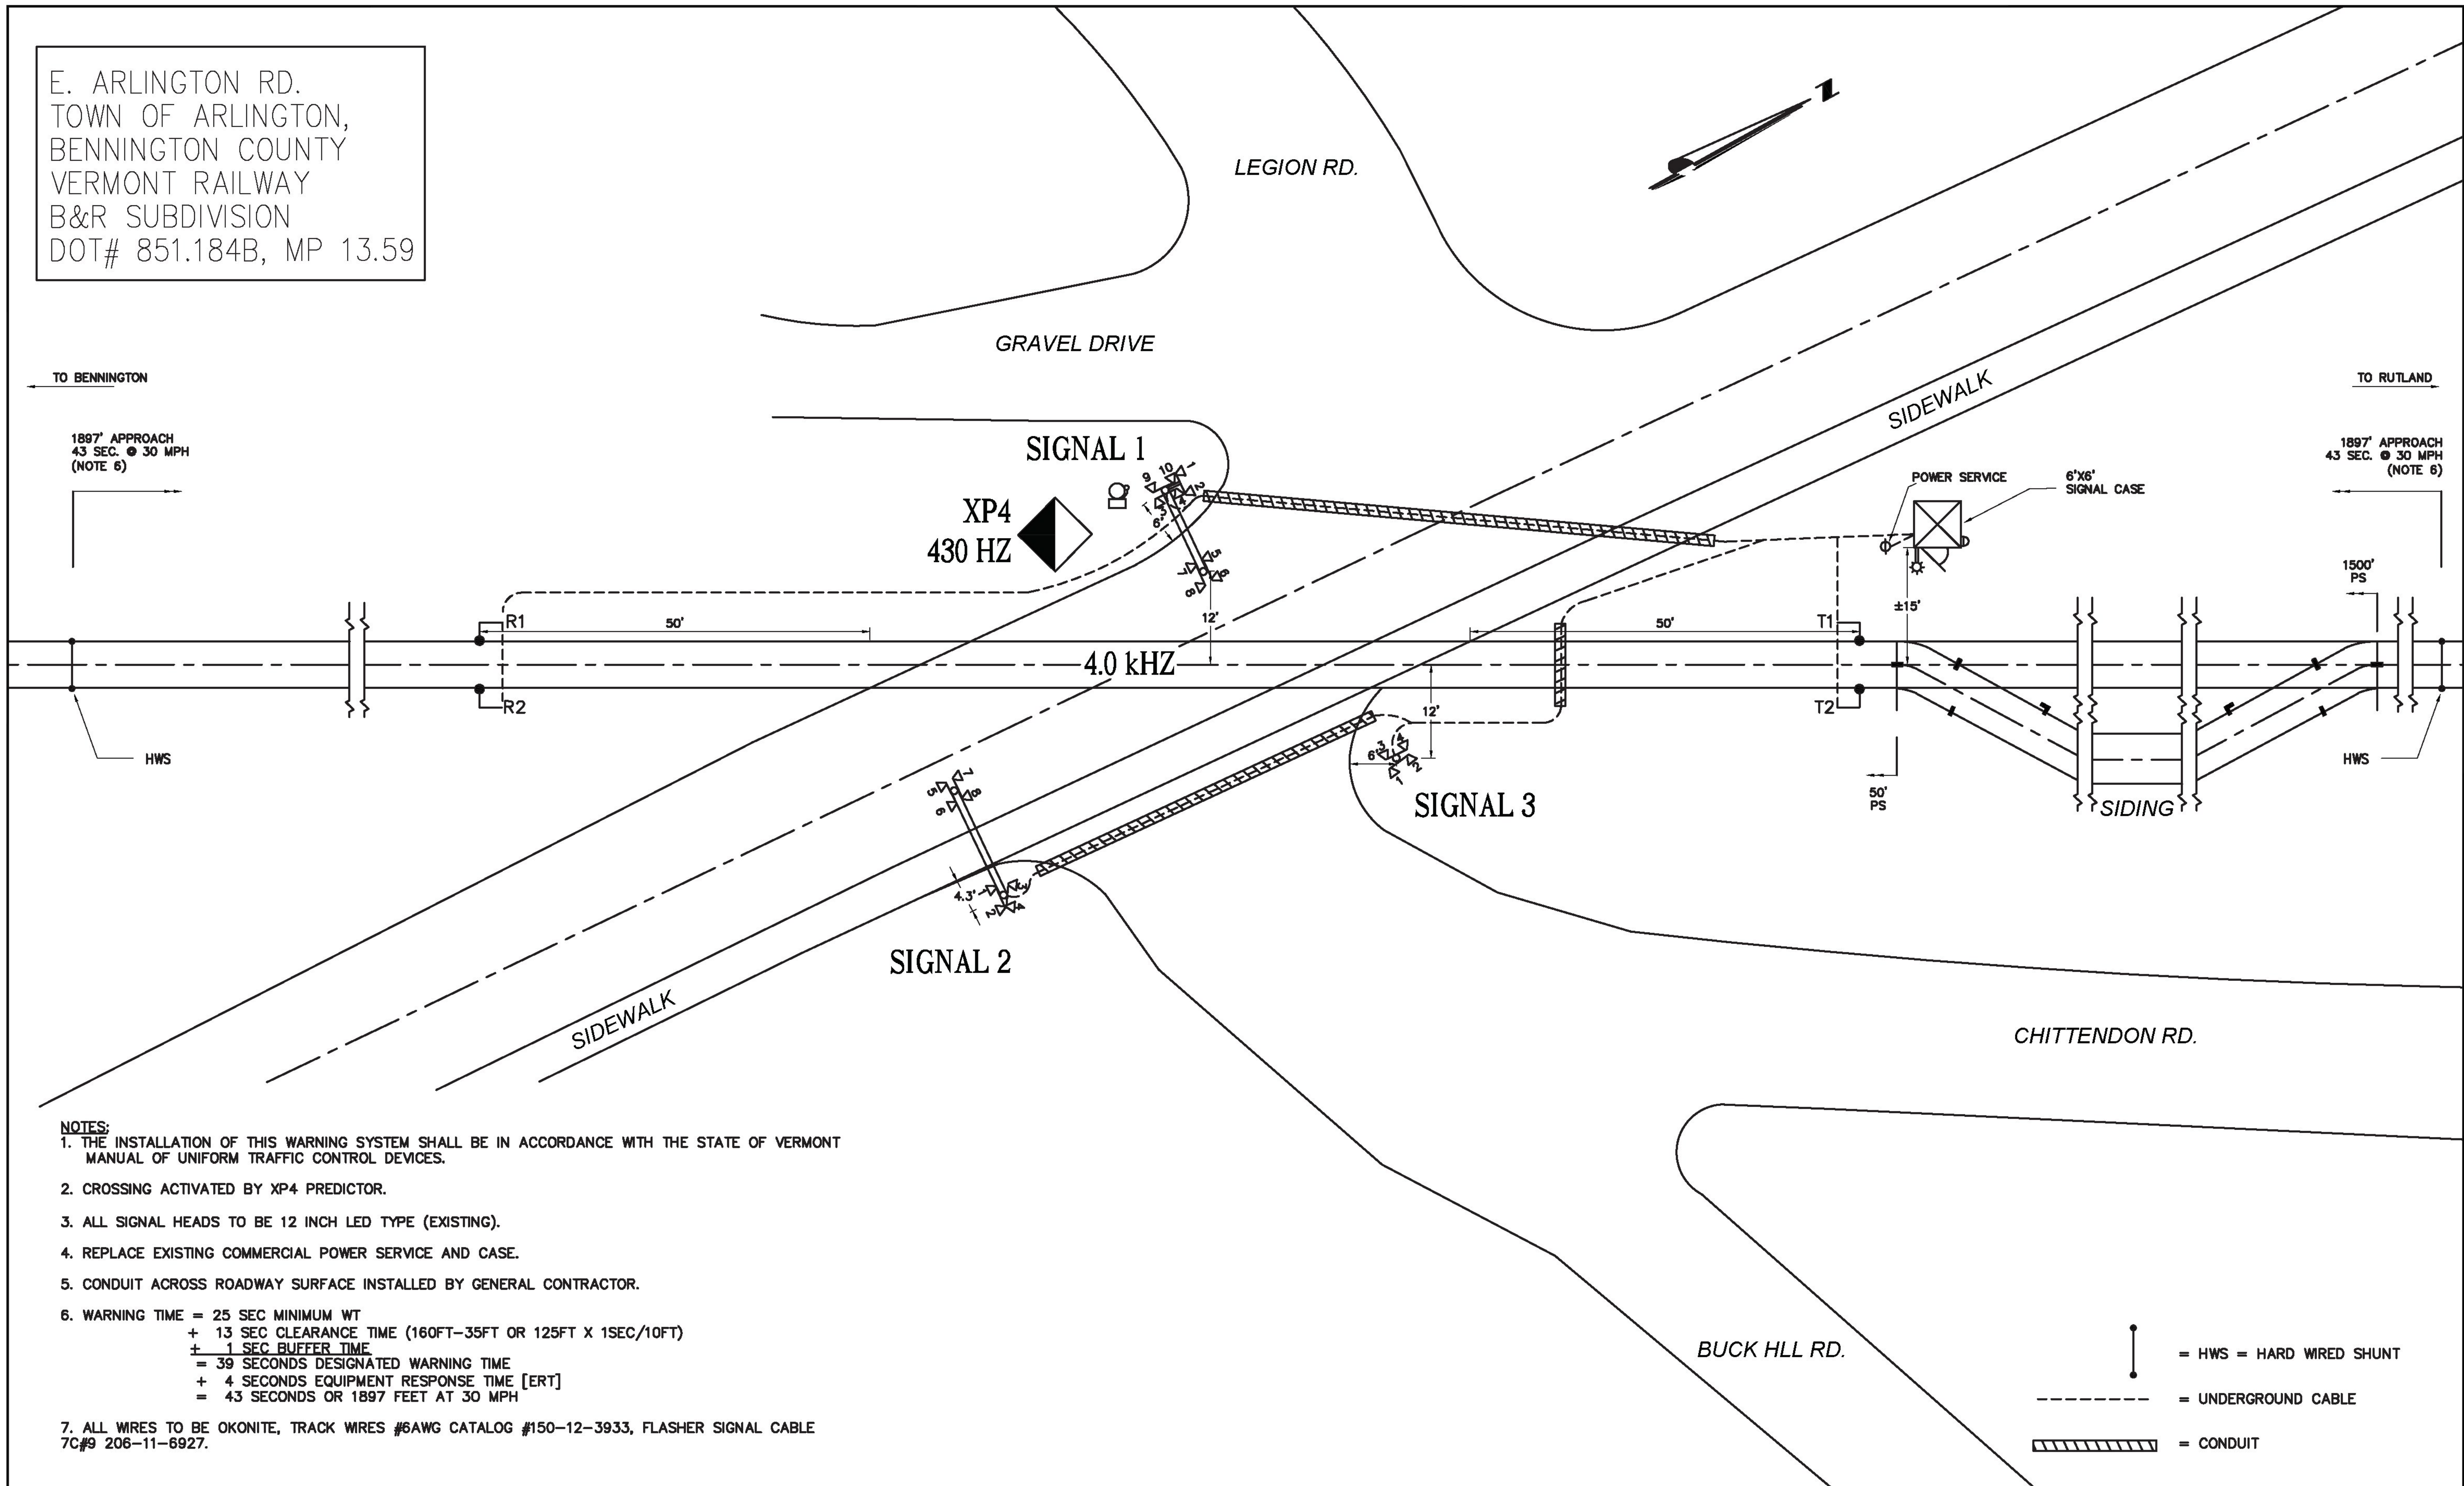


- NOTES:**
1. THE INSTALLATION OF THIS WARNING SYSTEM SHALL BE IN ACCORDANCE WITH THE STATE OF VERMONT MANUAL OF UNIFORM TRAFFIC CONTROL DEVICES.
  2. CROSSING ACTIVATED BY XP4 PREDICTOR.
  3. ALL SIGNAL HEADS TO BE 12 INCH LED TYPE (EXISTING).
  4. REPLACE EXISTING COMMERCIAL POWER SERVICE AND CASE.
  5. CONDUIT ACROSS ROADWAY SURFACE INSTALLED BY GENERAL CONTRACTOR.
  6. WARNING TIME = 25 SEC MINIMUM WT  
 + 13 SEC CLEARANCE TIME (160FT-35FT OR 125FT X 1SEC/10FT)  
 ± 1 SEC BUFFER TIME  
 = 39 SECONDS DESIGNATED WARNING TIME  
 + 4 SECONDS EQUIPMENT RESPONSE TIME [ERT]  
 = 43 SECONDS OR 1897 FEET AT 30 MPH
  7. ALL WIRES TO BE OKONITE, TRACK WIRES #8AWG CATALOG #150-12-3933, FLASHER SIGNAL CABLE 7C#9 206-11-6927.

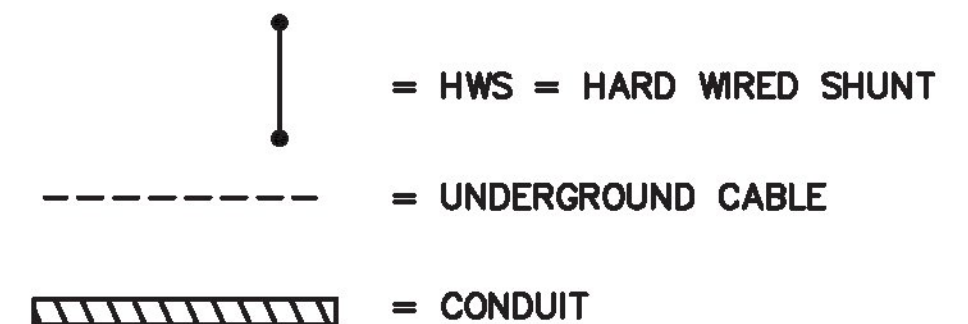

Revision:	Drawn By:	App'd. By:	Date:	Designed By:	Date:
				SLW	4/16
				SLW	4/16
				SLW	4/16

25 Cobble Hill Drive  
Wilton, NY 12831  
(518) 424-6794  
shvertans@earthlink.net  
www.saratogarailroad.com

**SARATOGA RAILROAD ENGINEERING PC**

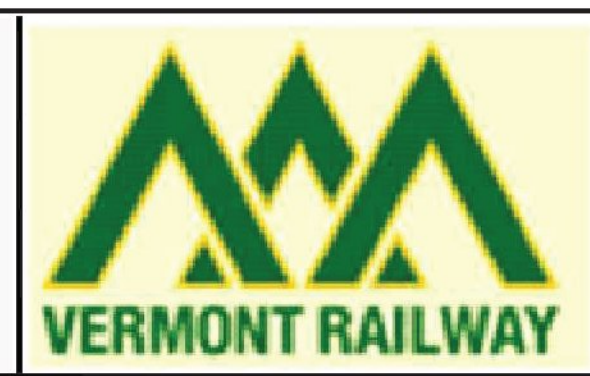


VERMONT RAILWAY  
ONE RAILWAY LANE  
BURLINGTON, VT  
05401

GRADE CROSSING WARNING SIGNALS  
LAYOUT PLAN

EAST ARLINGTON RD., ARLINGTON, VT.



SCALE: NONE      DATE: APRIL 2016

Drawing No.  
**PL-1**  
SHEET 1 OF 10

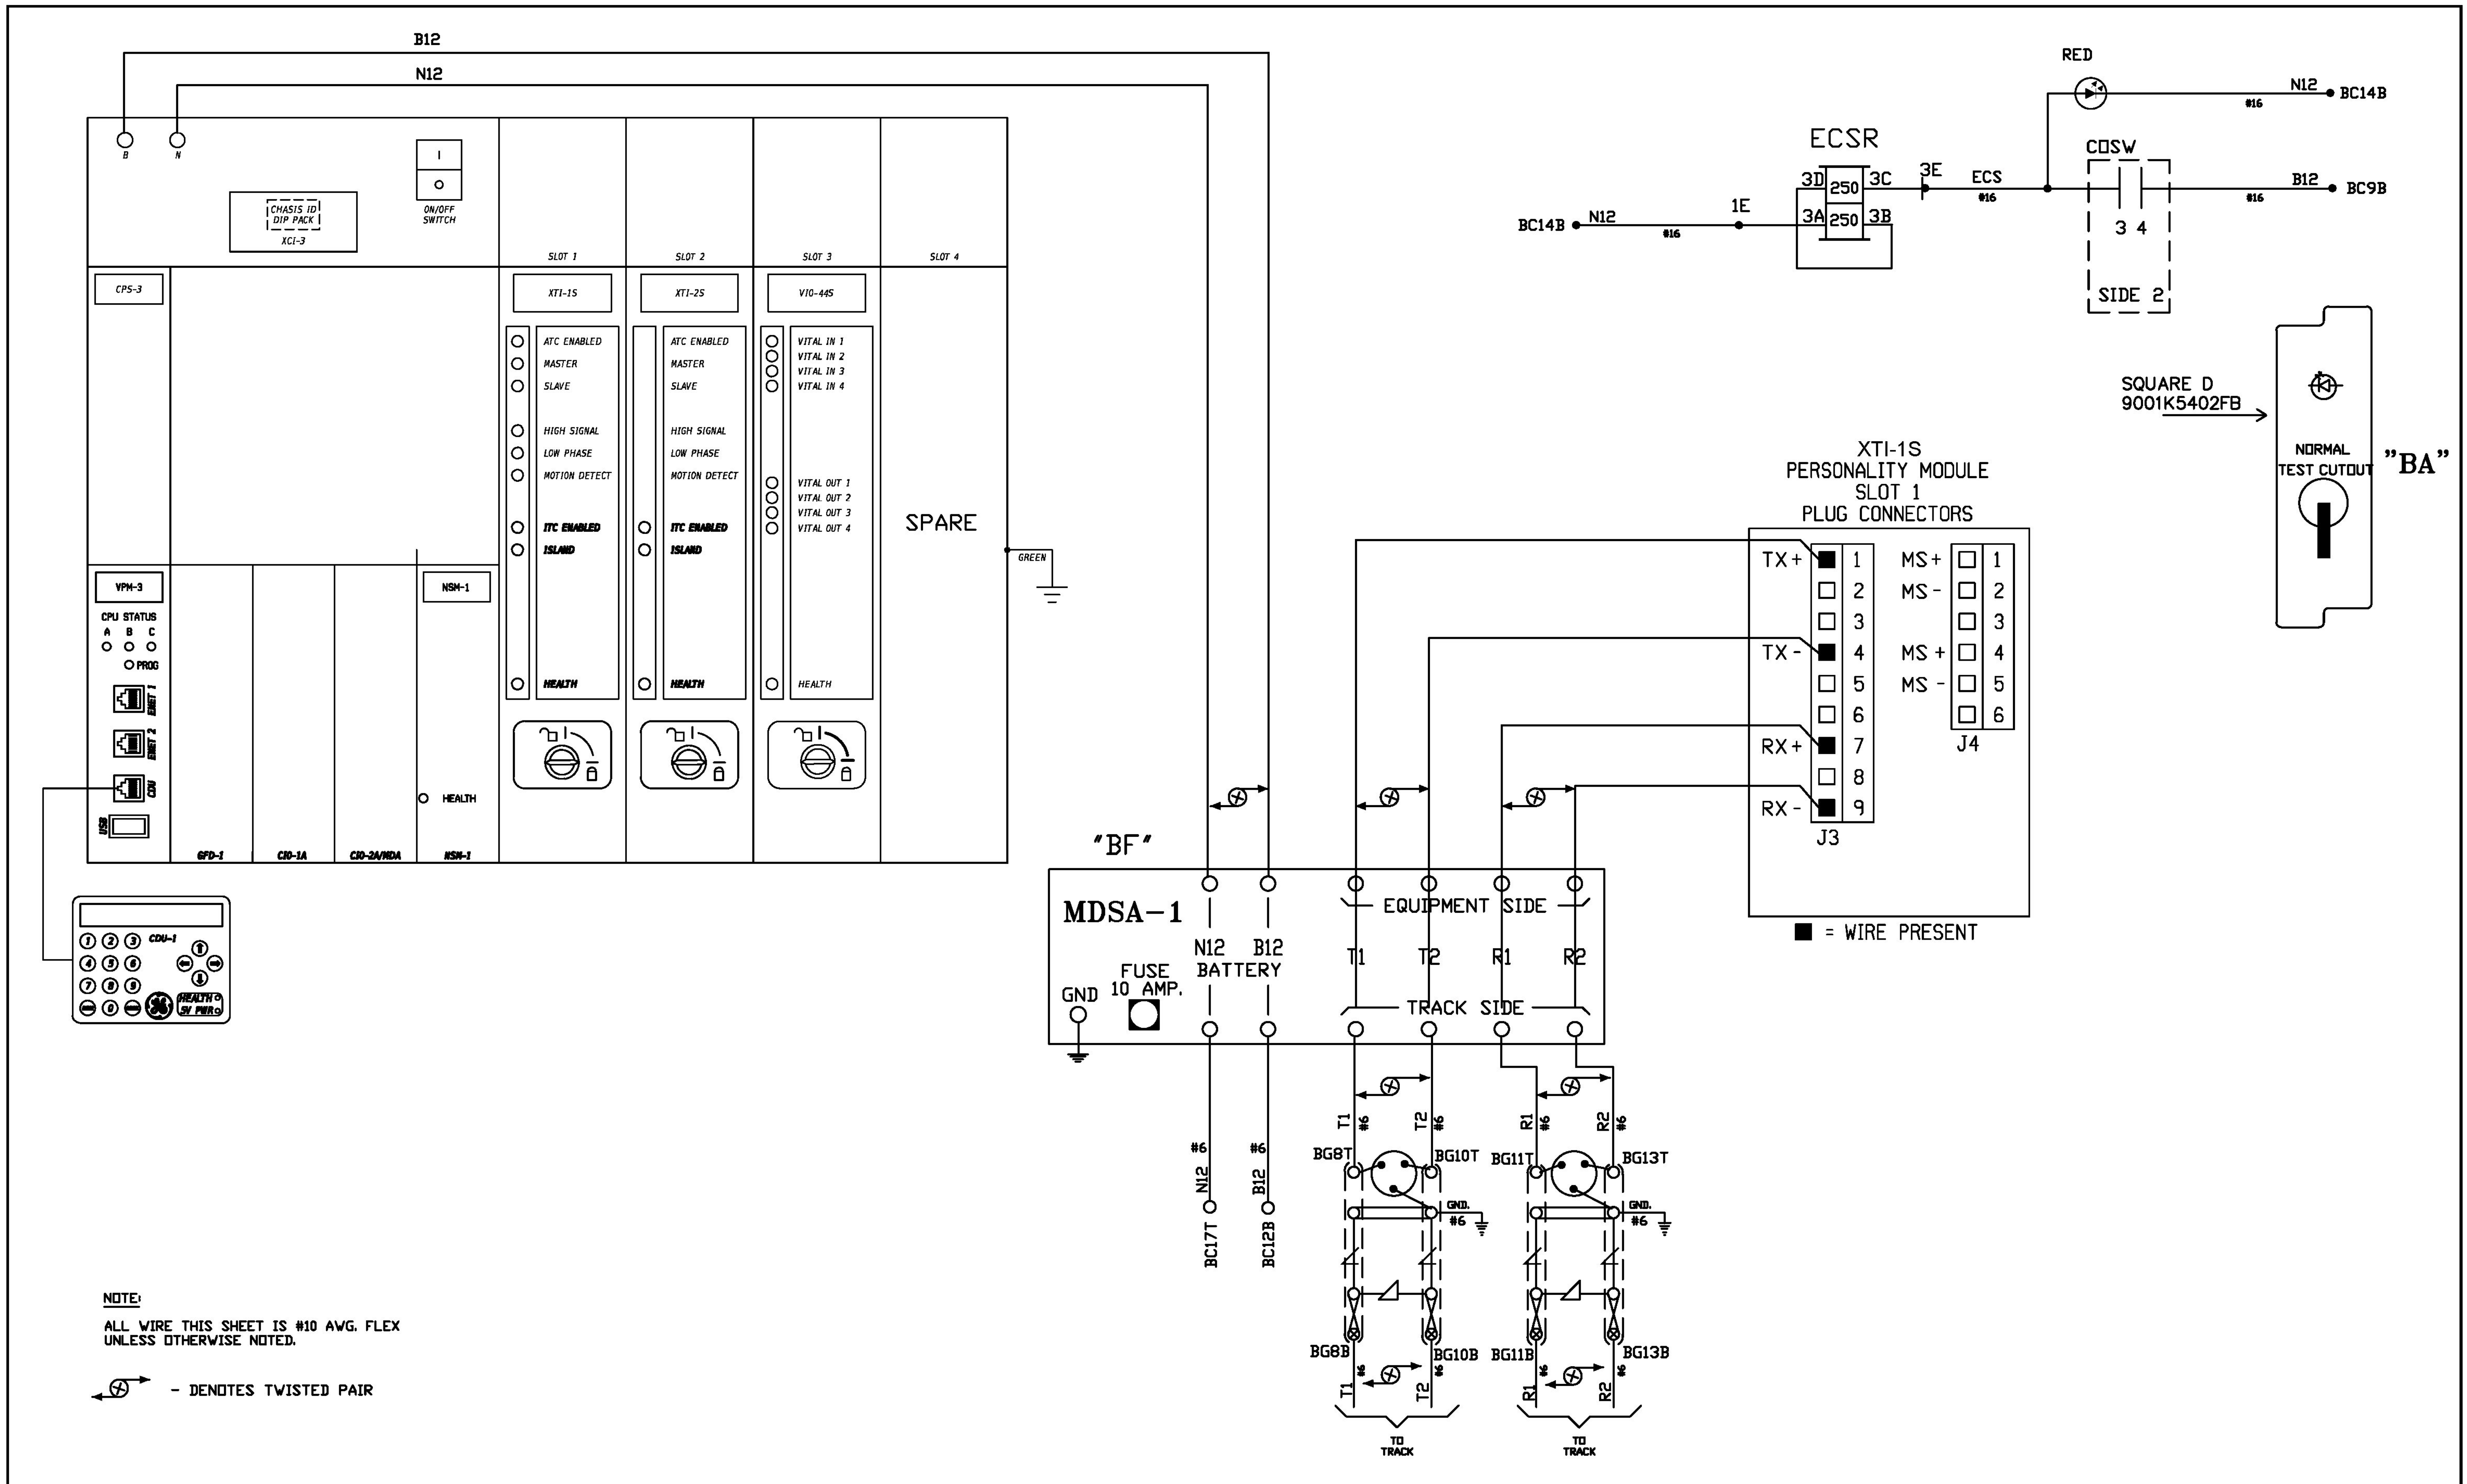

**NOTE:**  
 ALL WIRE THIS SHEET IS #10 AWG. FLEX  
 UNLESS OTHERWISE NOTED.

- DENOTES TWISTED PAIR

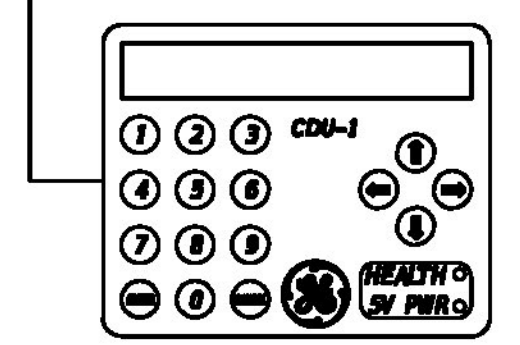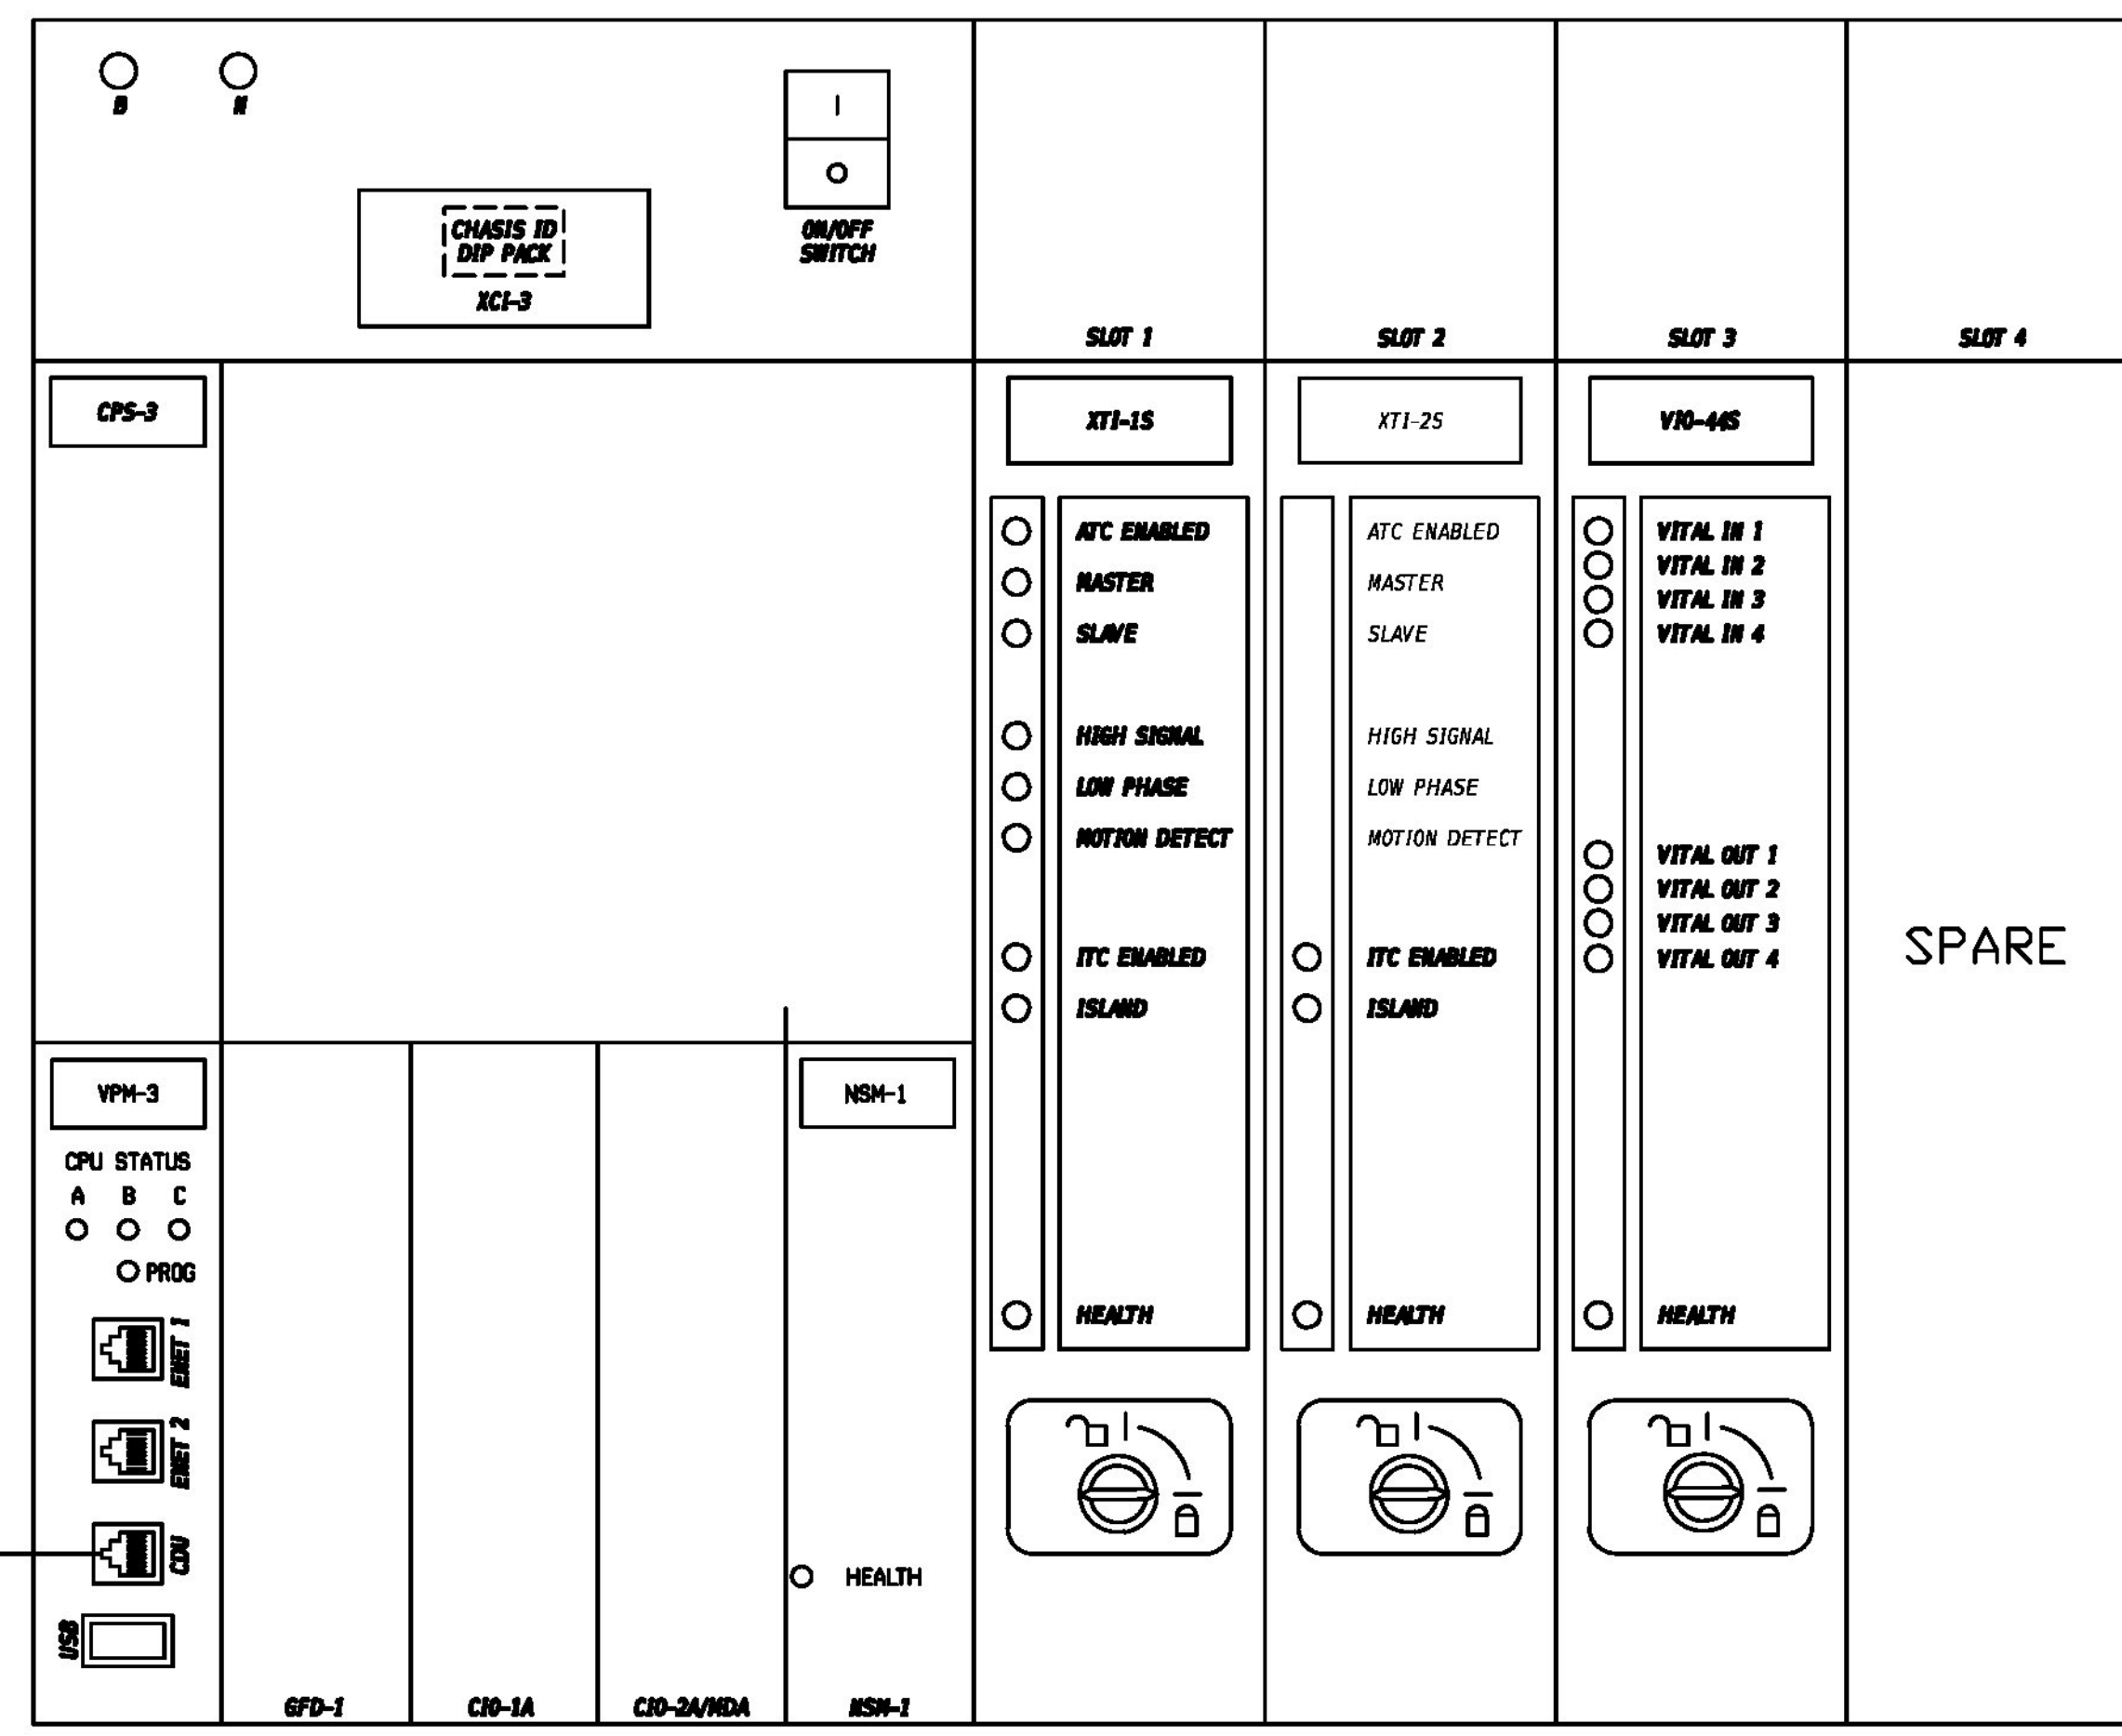

APPLICATION SOFTWARE INFORMATION	
NAME	1r_1_1l_0x_b
REV	0
CHECKSUM	DBD5
CRC	D321

CHASSIS ID DIP SHUNTS LOCATED ON BACKPLANE UNDERNEATH UCI-3 MODULE ID#27


1	2	3	4	5	6	7	8
---	---	---	---	---	---	---	---

○ = TAB INTACT (MADE - TRUE)  
● = TAB PUNCHED OUT (BROKEN - FALSE)


Track Parameters		TRACK #1
Basic Setup		
Frequency	FIELD SETTABLE	430
Master/Slave	M-S (MASTER)	M
Direction Mode	BI-UNI (BI)	BI
Approach Length	250-9999	1897
Advance Setup		
Motion Det Timer	MDEN	ENA-DIS
	MDTT	10-60(10)
False Shunt Timer	FSEN	ENA-DIS
	FSRX	0-80(0)
	FST	0-60(10)
Approach Release Timer	AREN	ENA-DIS
	ARRX	0-80(0)
	ART	0-60(10)
Loss of Shunt Timer		4-99(16)
IJ-LDS Timer		4-99(5)

MDR Parameters		MDR1
Warning Time	23-99(99)	43
CW/MD	MD-CW	CW
AP Time	0-99(30)	30
CWE-WT	0-80(30)	80
Aux Recvr Dly	0-99(0)	0
Track Assigned	Various	1
Offset Distance	0-9999(0)	0
MD Restart	0-99(0)	0
Sudden Shunt Zone	0-99(0)	0
Positive Start	PSEN	ENA-DIS
	PSRX	0-80(0)
	PST	0-80(0)
Post Joint Detect	PJEN	ENA-DIS
	PJRX	15-80(15)
	PJDT	4-99(15)


Island Parameters		Actual
Enable/Disable	Enable/Disable (Enable)	Enable
Frequency	4KHz-8KHz	4.0KHz
Loss of Shunt	.5-4	(2)
Fault Delay	1-2	1

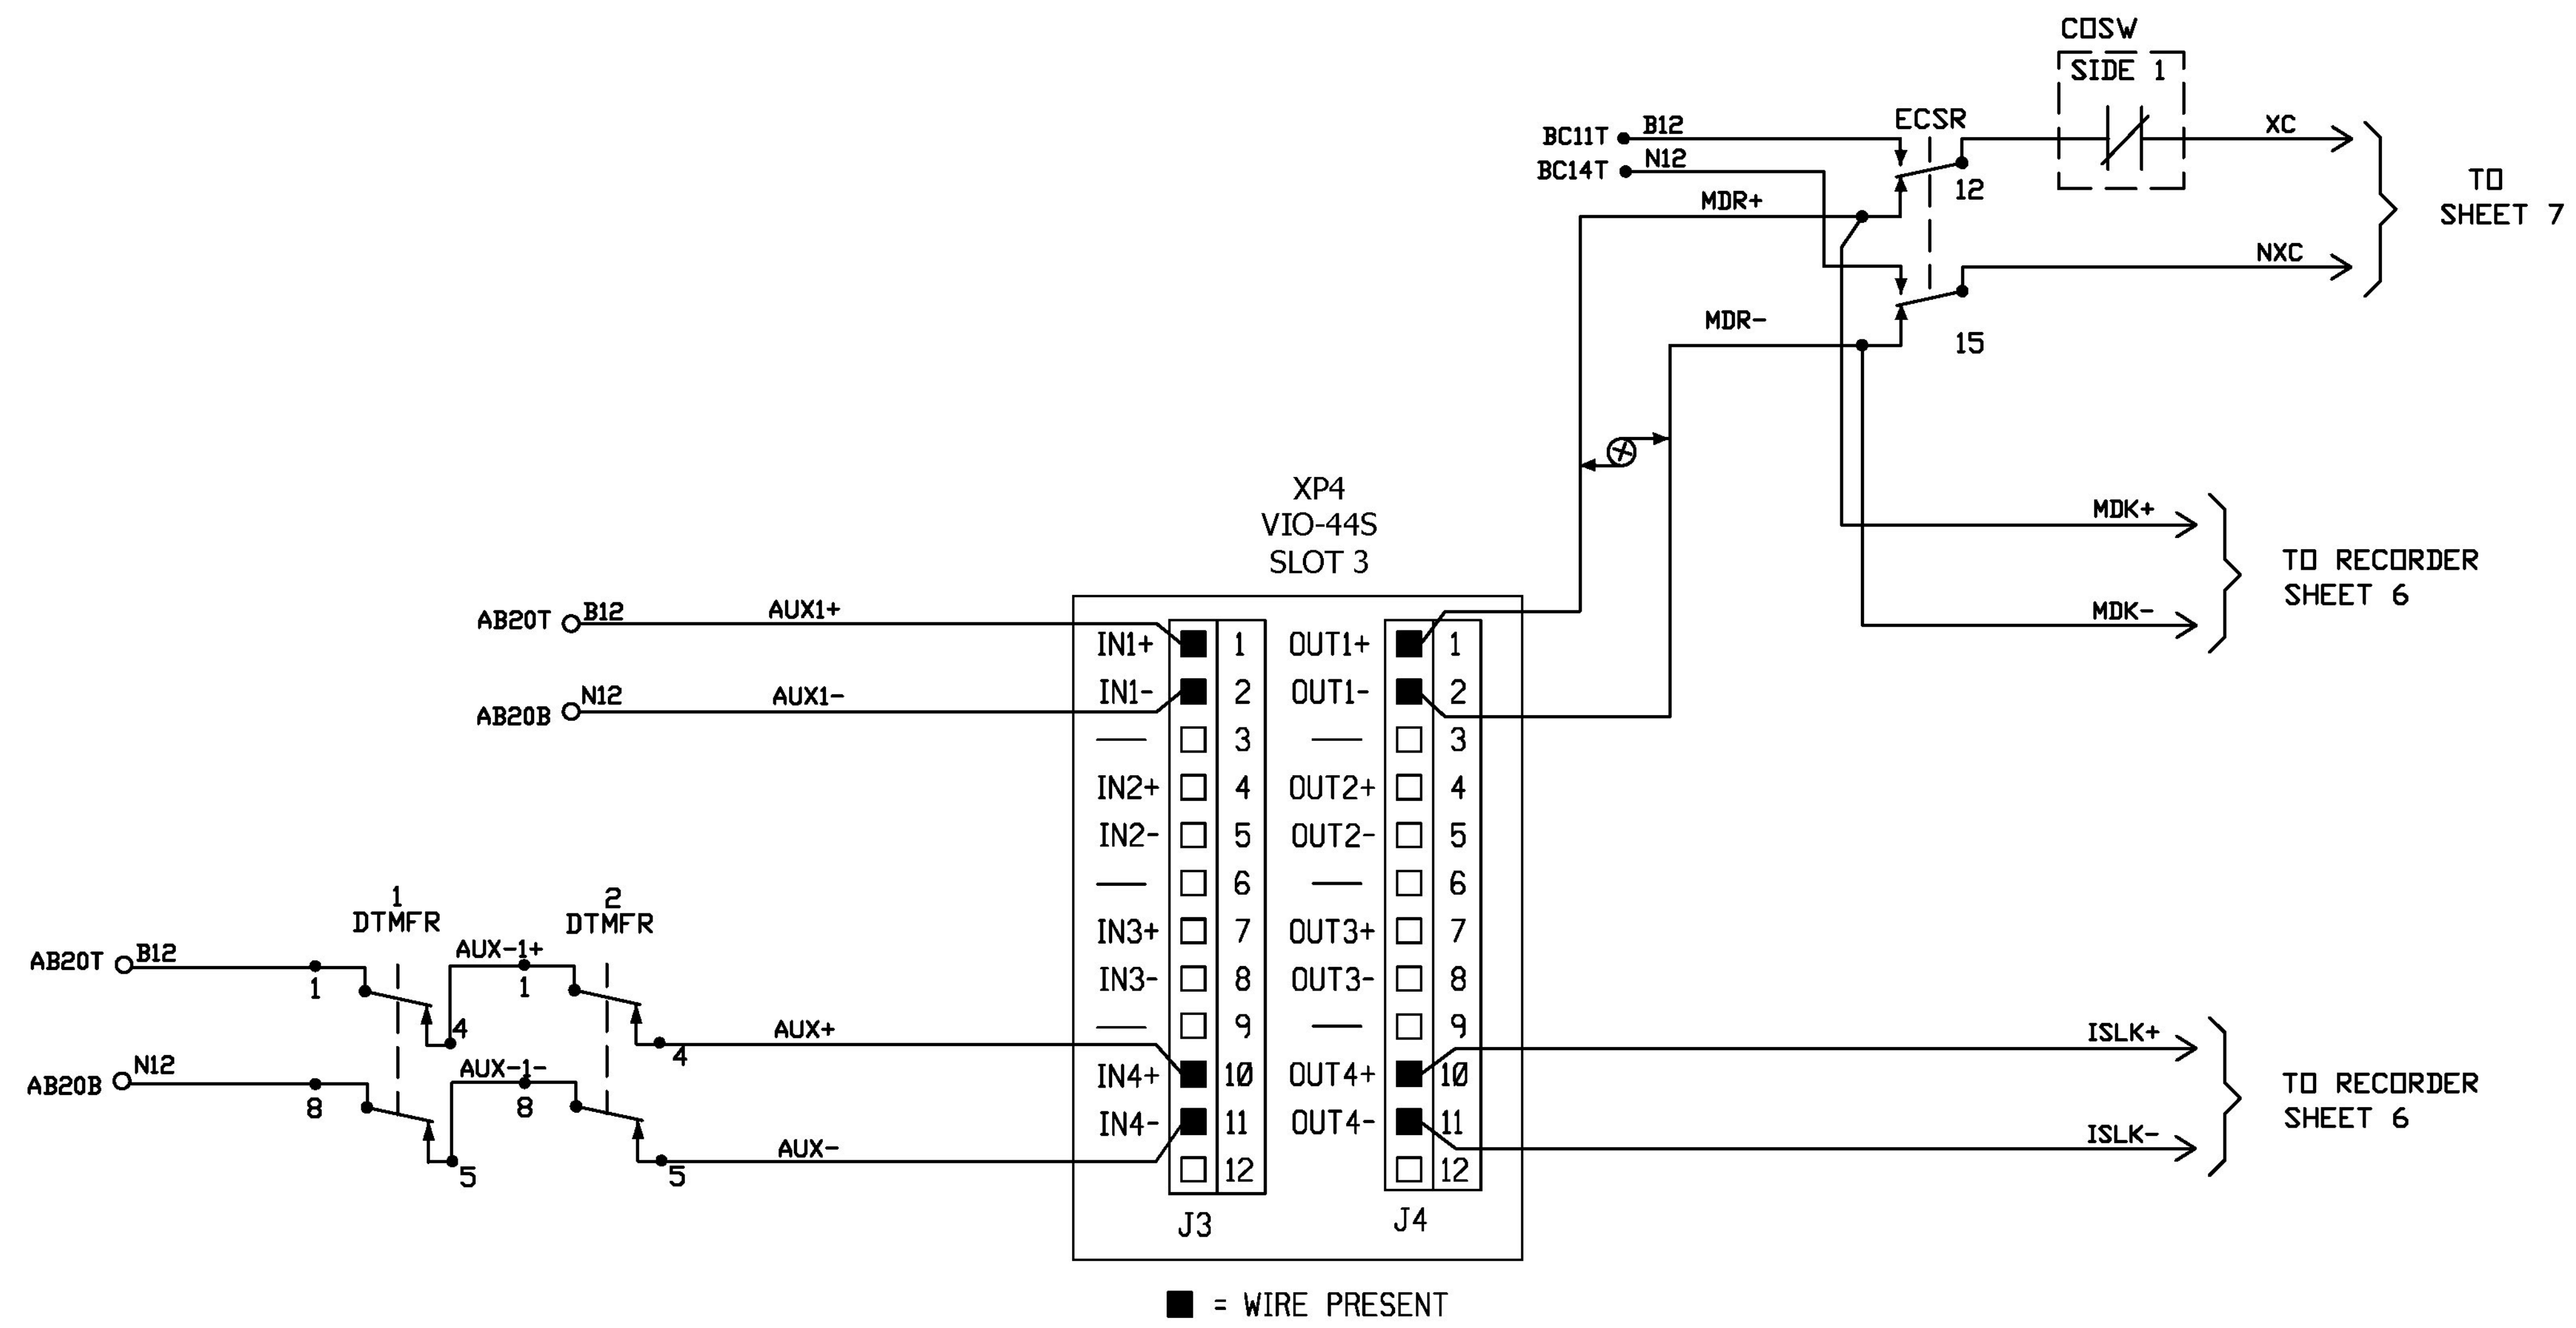

**NOTE:**  
 ALL WIRE THIS SHEET IS #16 AWG. FLEX  
 UNLESS OTHERWISE NOTED.


 - DENOTES TWISTED PAIR



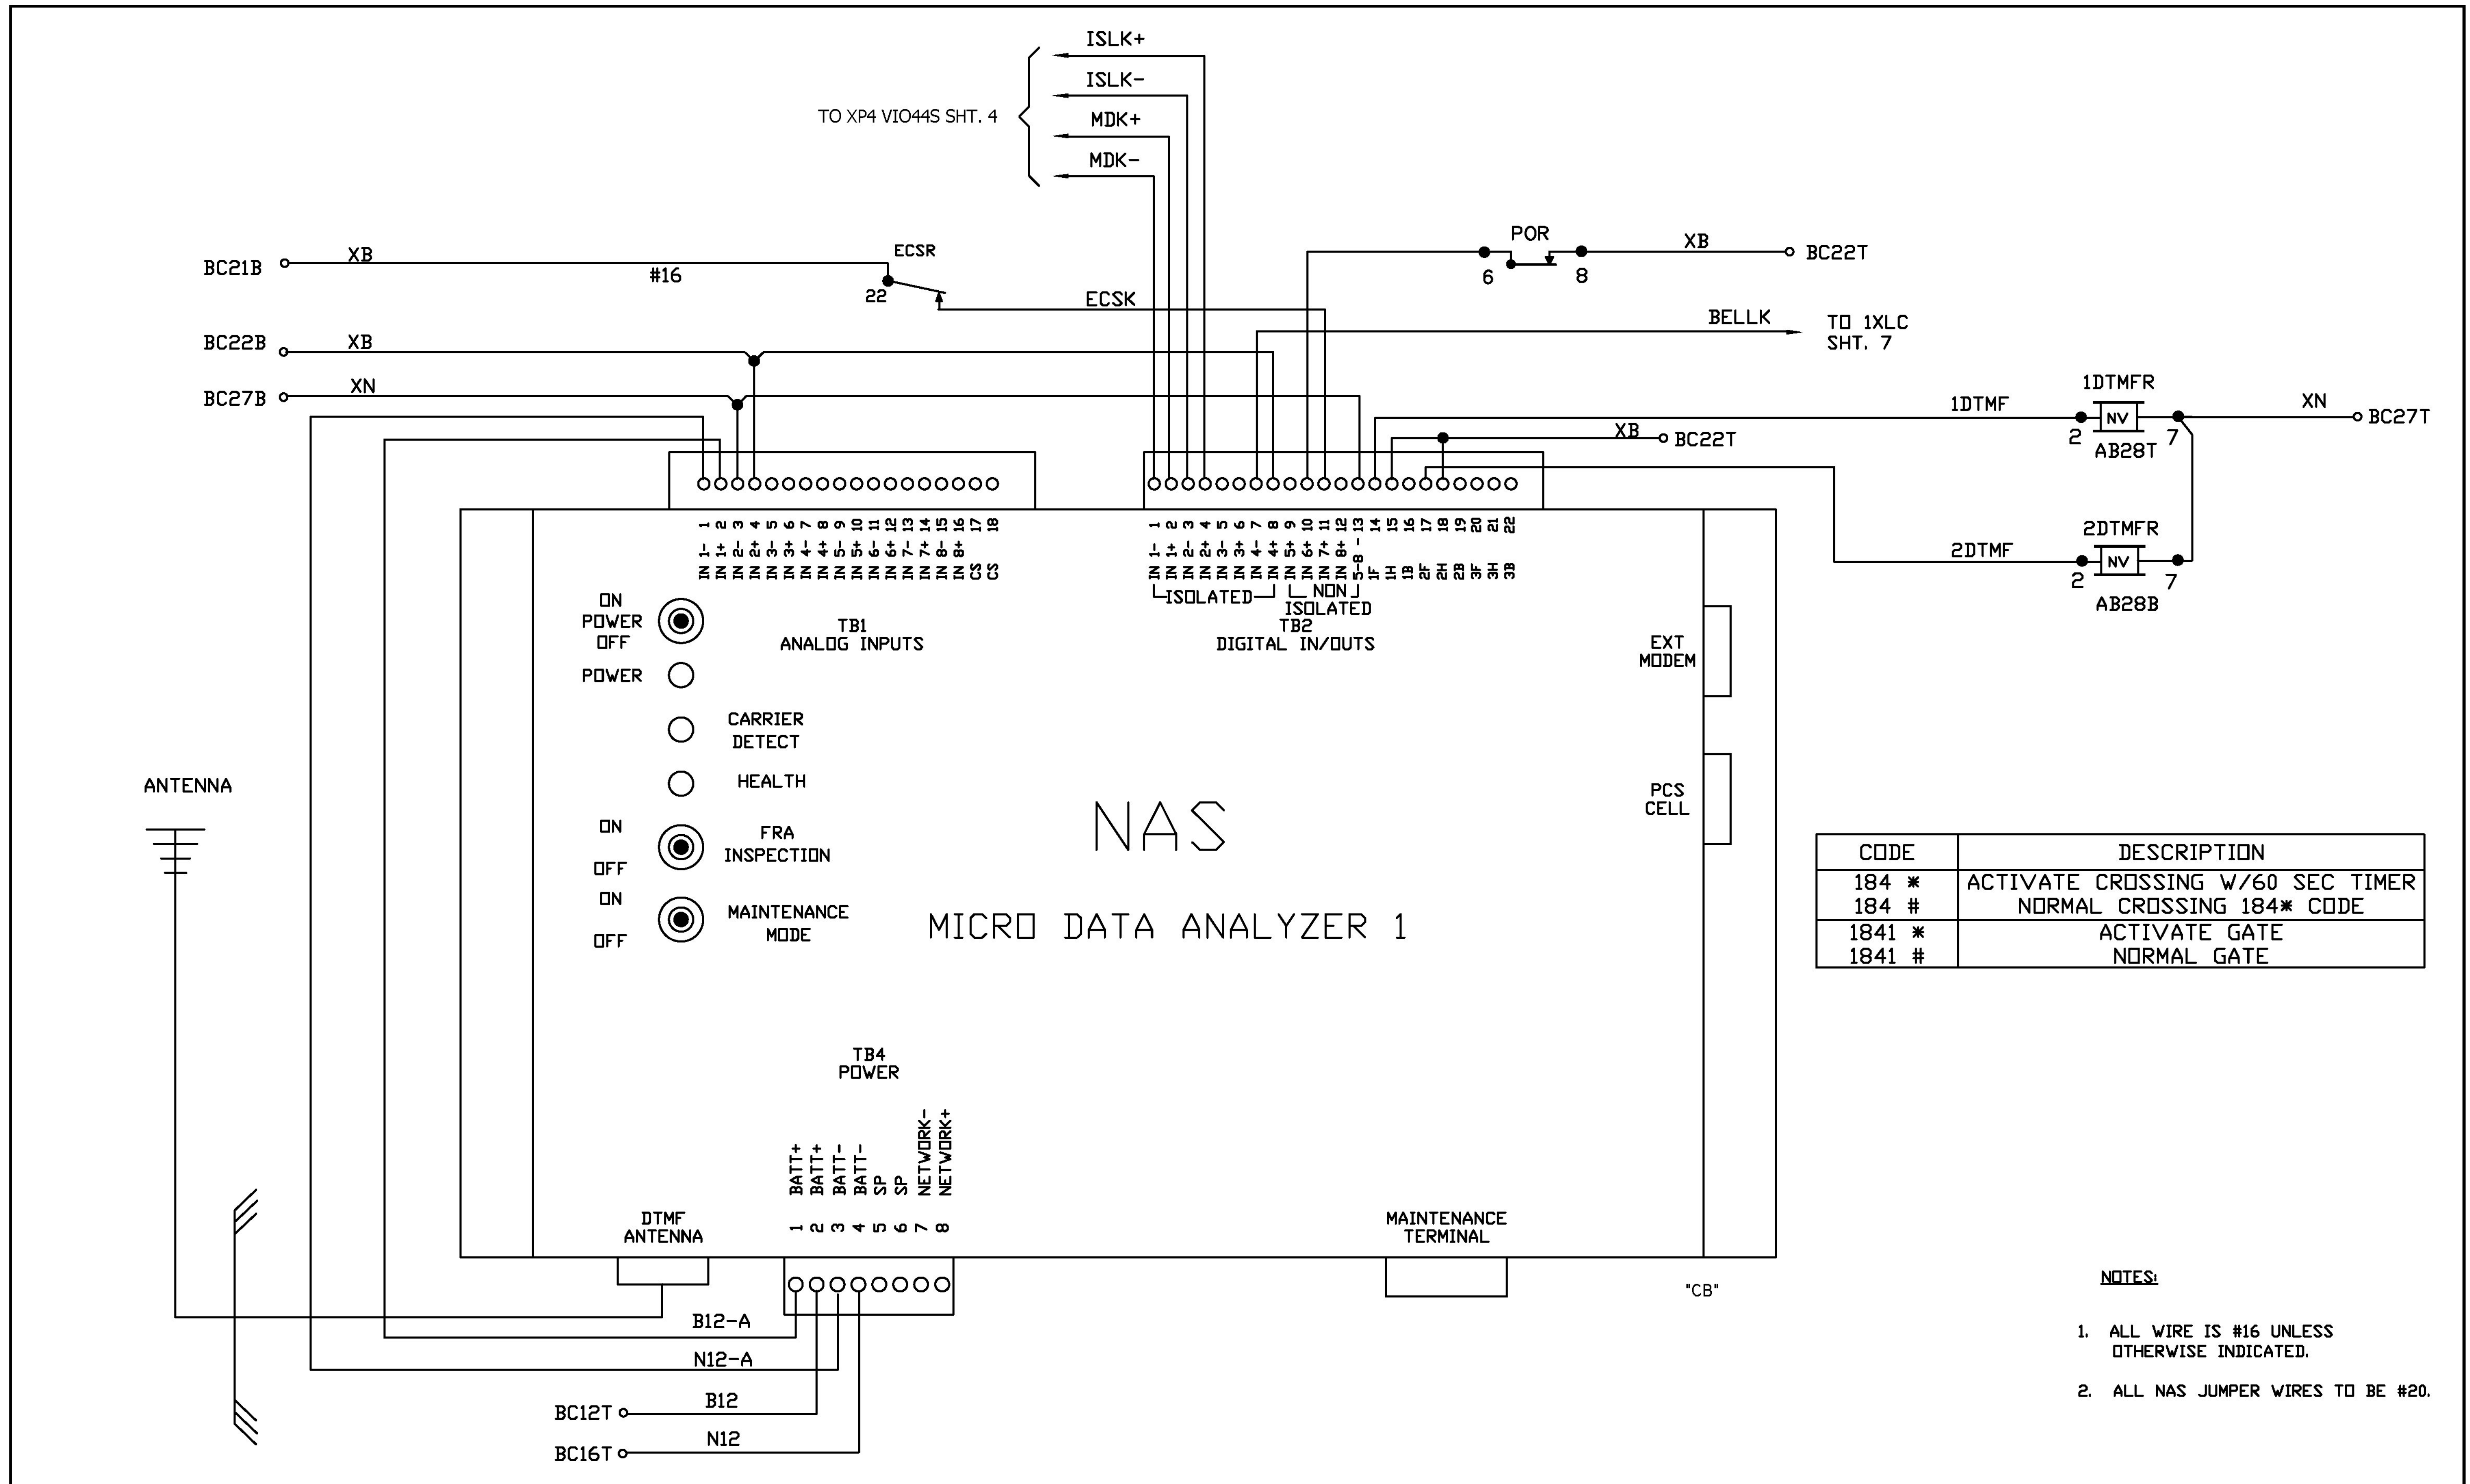

CODE	DESCRIPTION
184 *	ACTIVATE CROSSING W/60 SEC TIMER
184 #	NORMAL CROSSING 184* CODE
1841 *	ACTIVATE GATE
1841 #	NORMAL GATE

- NOTES:**
1. ALL WIRE IS #16 UNLESS OTHERWISE INDICATED.
  2. ALL NAS JUMPER WIRES TO BE #20.

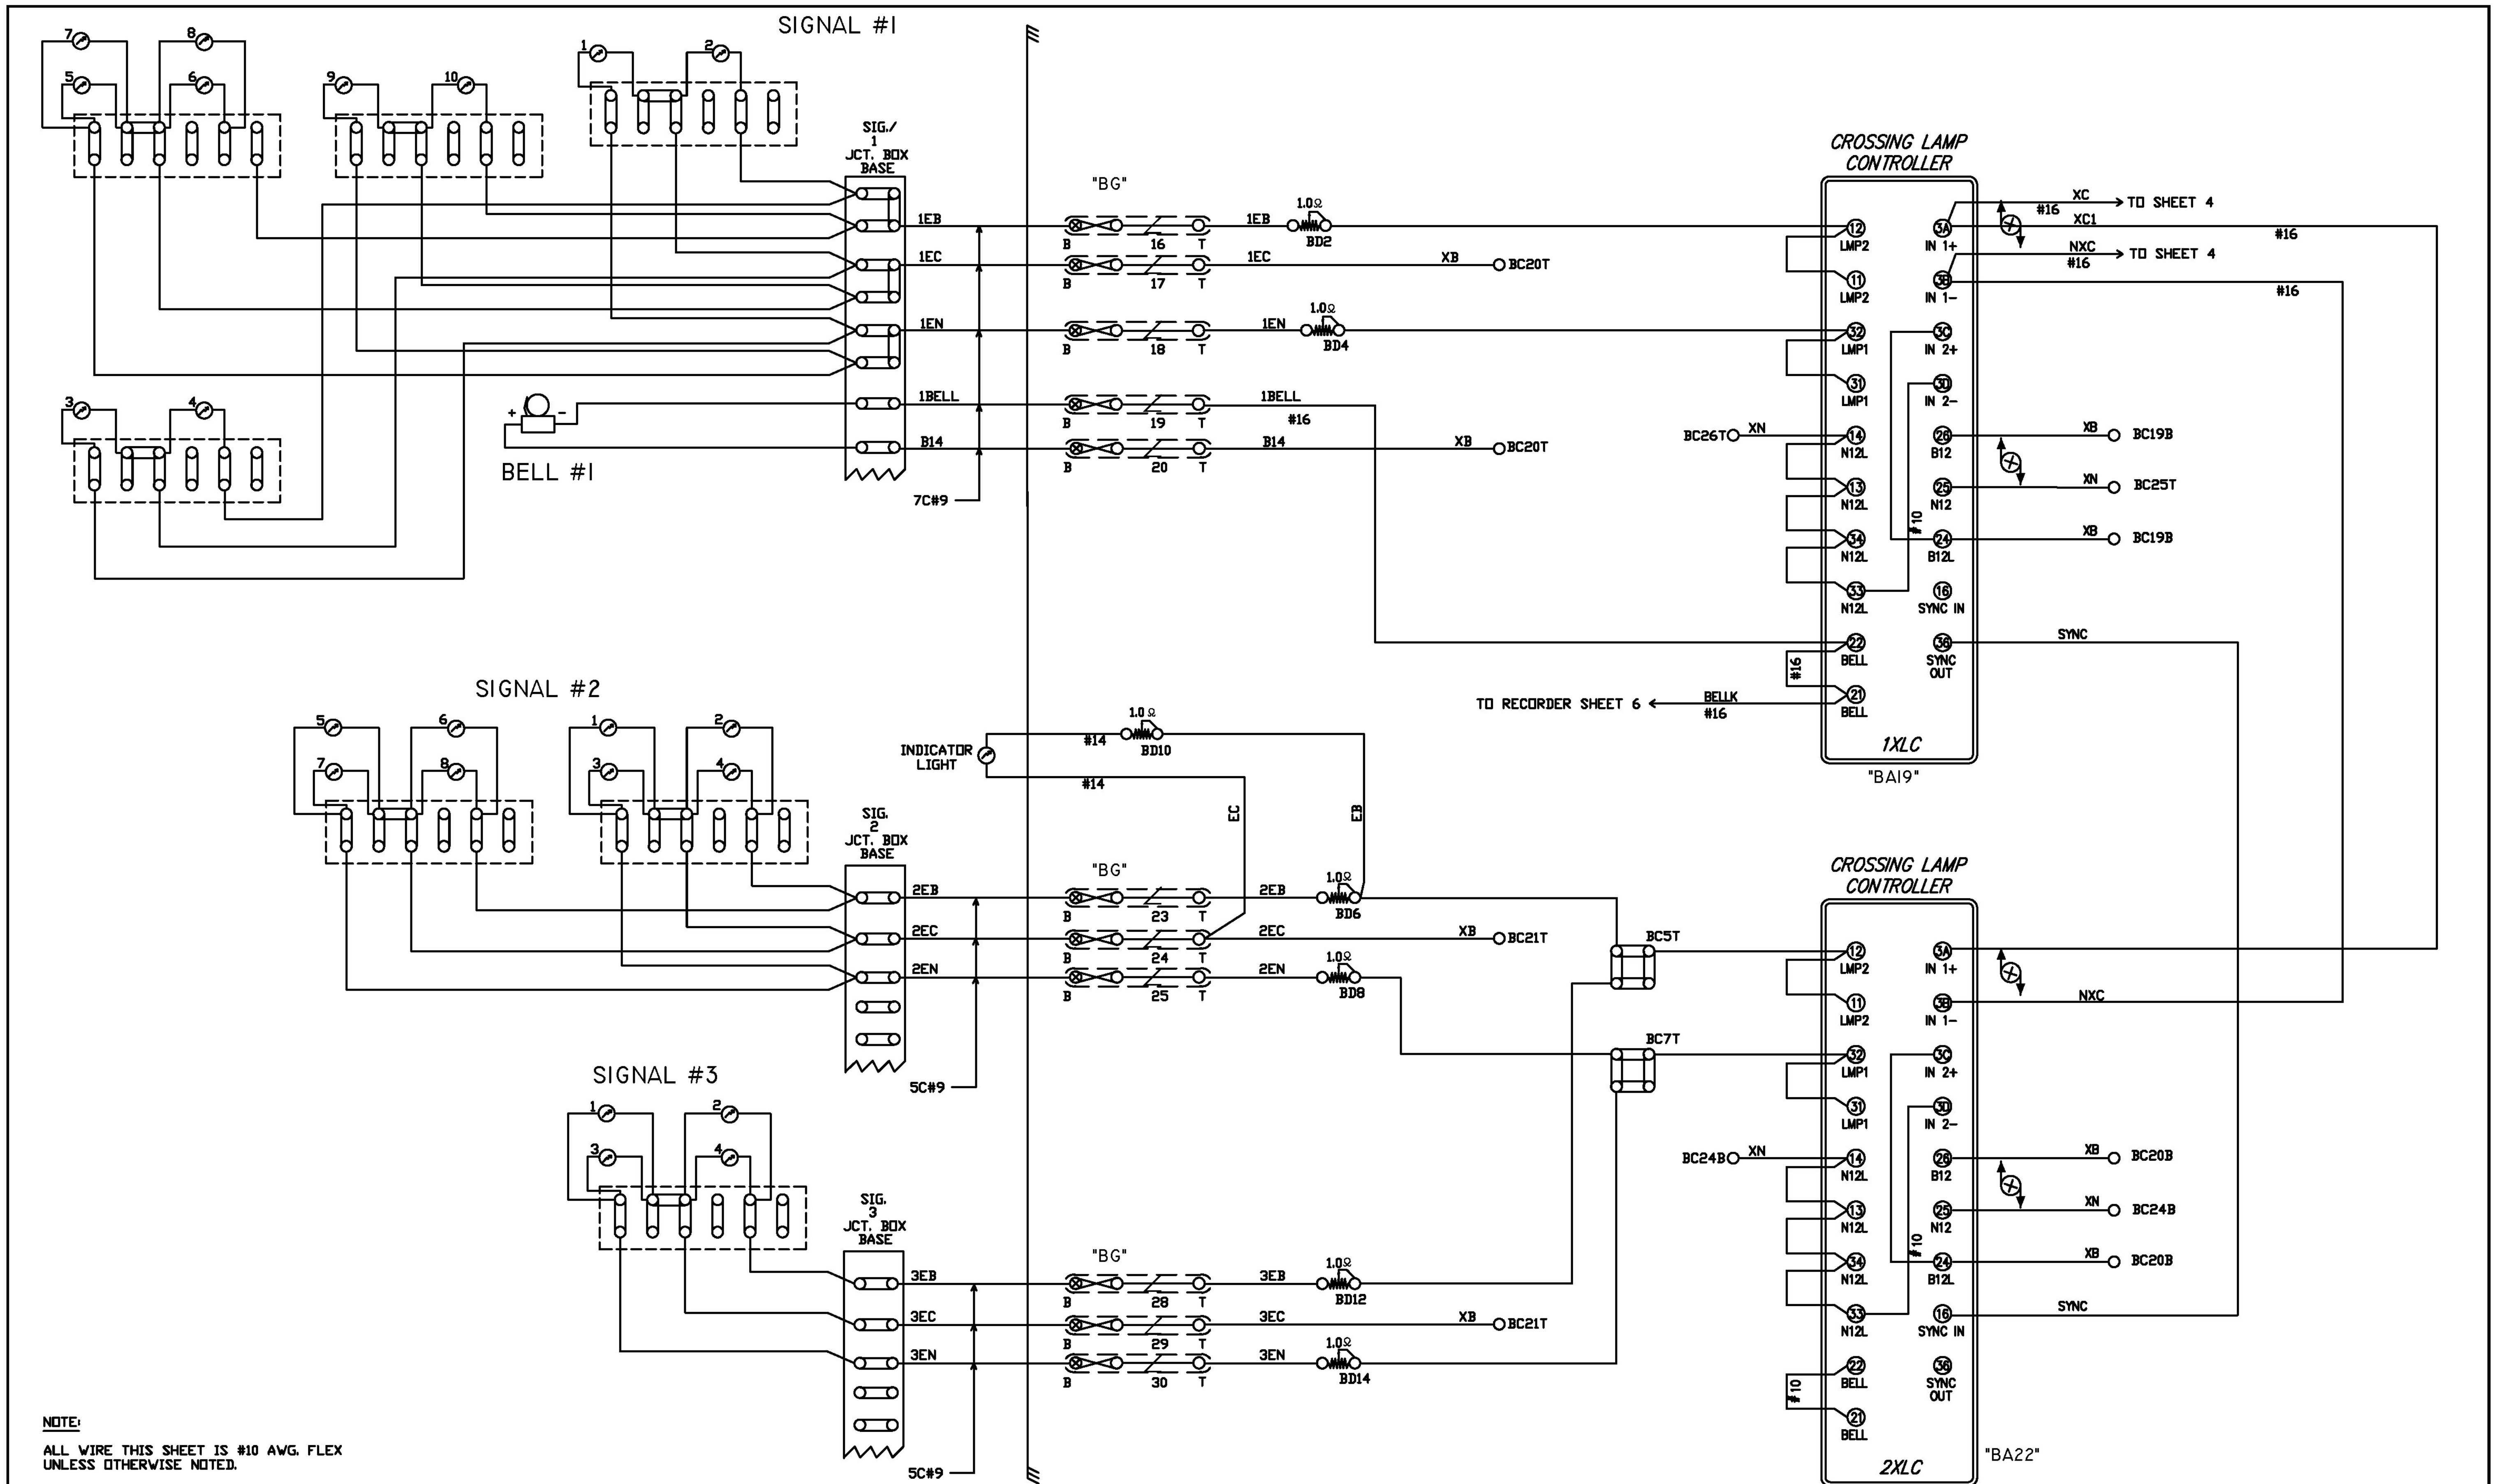


Revision:	Drawn By:	App'd. By:	Date:	Designed By:	Date:
	SLW			SLW	4/16
	SLW			SLW	4/16
	SLW			SLW	4/16

UNAUTHORIZED ALTERATION OR ADDITION TO THIS DOCUMENT IS A VIOLATION OF SECTION 7008 SUBDIVISION 2 OF THE NEW YORK STATE EDUCATION LAW

**SARATOGA RAILROAD ENGINEERING PC**

25 Cobble Hill Drive  
Wilton, NY 12831  
(518) 424-6794  
shvertans@earthlink.net  
www.saratogarailroad.com

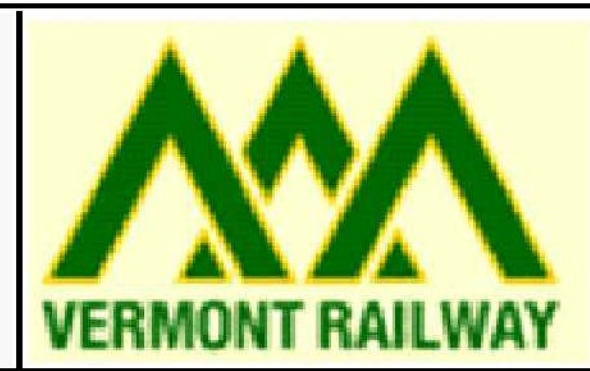

VERMONT RAILWAY  
ONE RAILWAY LANE  
BURLINGTON, VT  
05401

GRADE CROSSING WARNING SIGNALS  
LIGHTING CIRCUITS PLAN


EAST ARLINGTON RD., ARLINGTON, VT.

SCALE: NONE      DATE: APRIL 2016



Drawing No.  
**F-1**

SHEET 7 OF 10



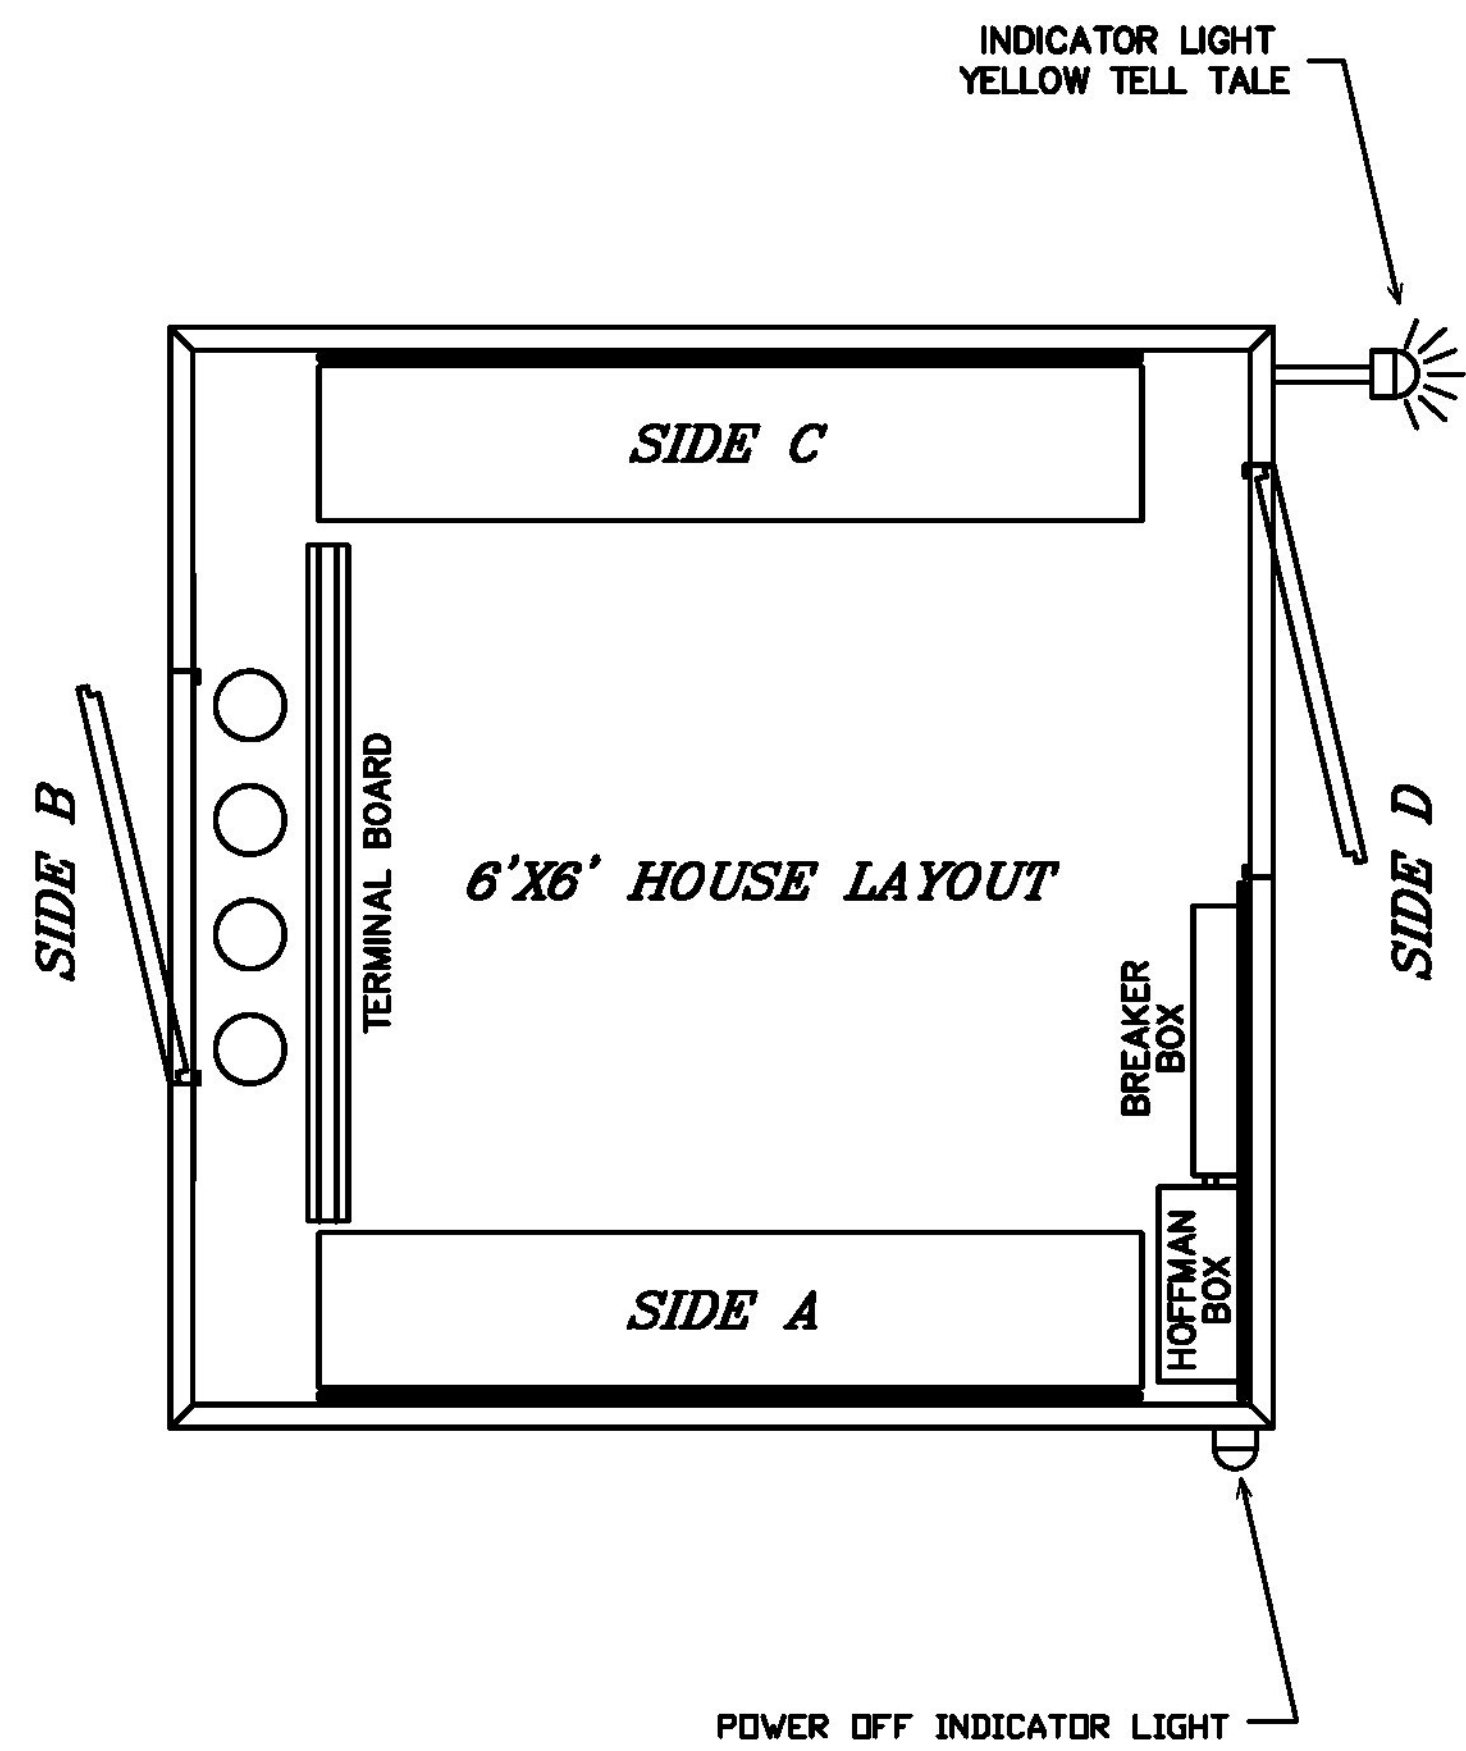


- = H.D. ARRESTOR (02615-2X)
- = H.D. EQUALIZER (022700-2X)
- = LIGHTNING PROTECTION (LPC-10560-51)
- = LIGHTNING PROTECTION (LPC-10593-9)
- = ADJUSTABLE RESISTOR

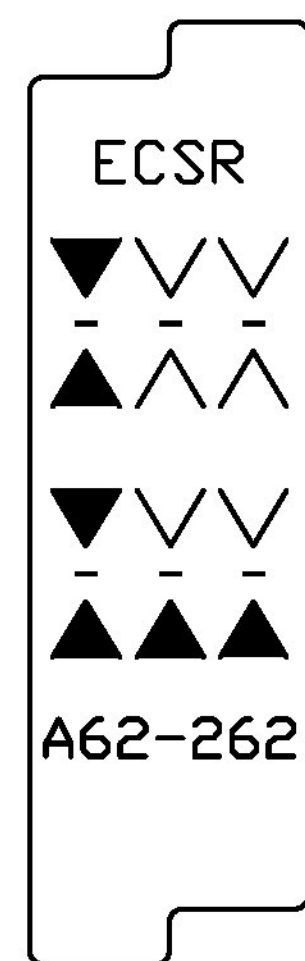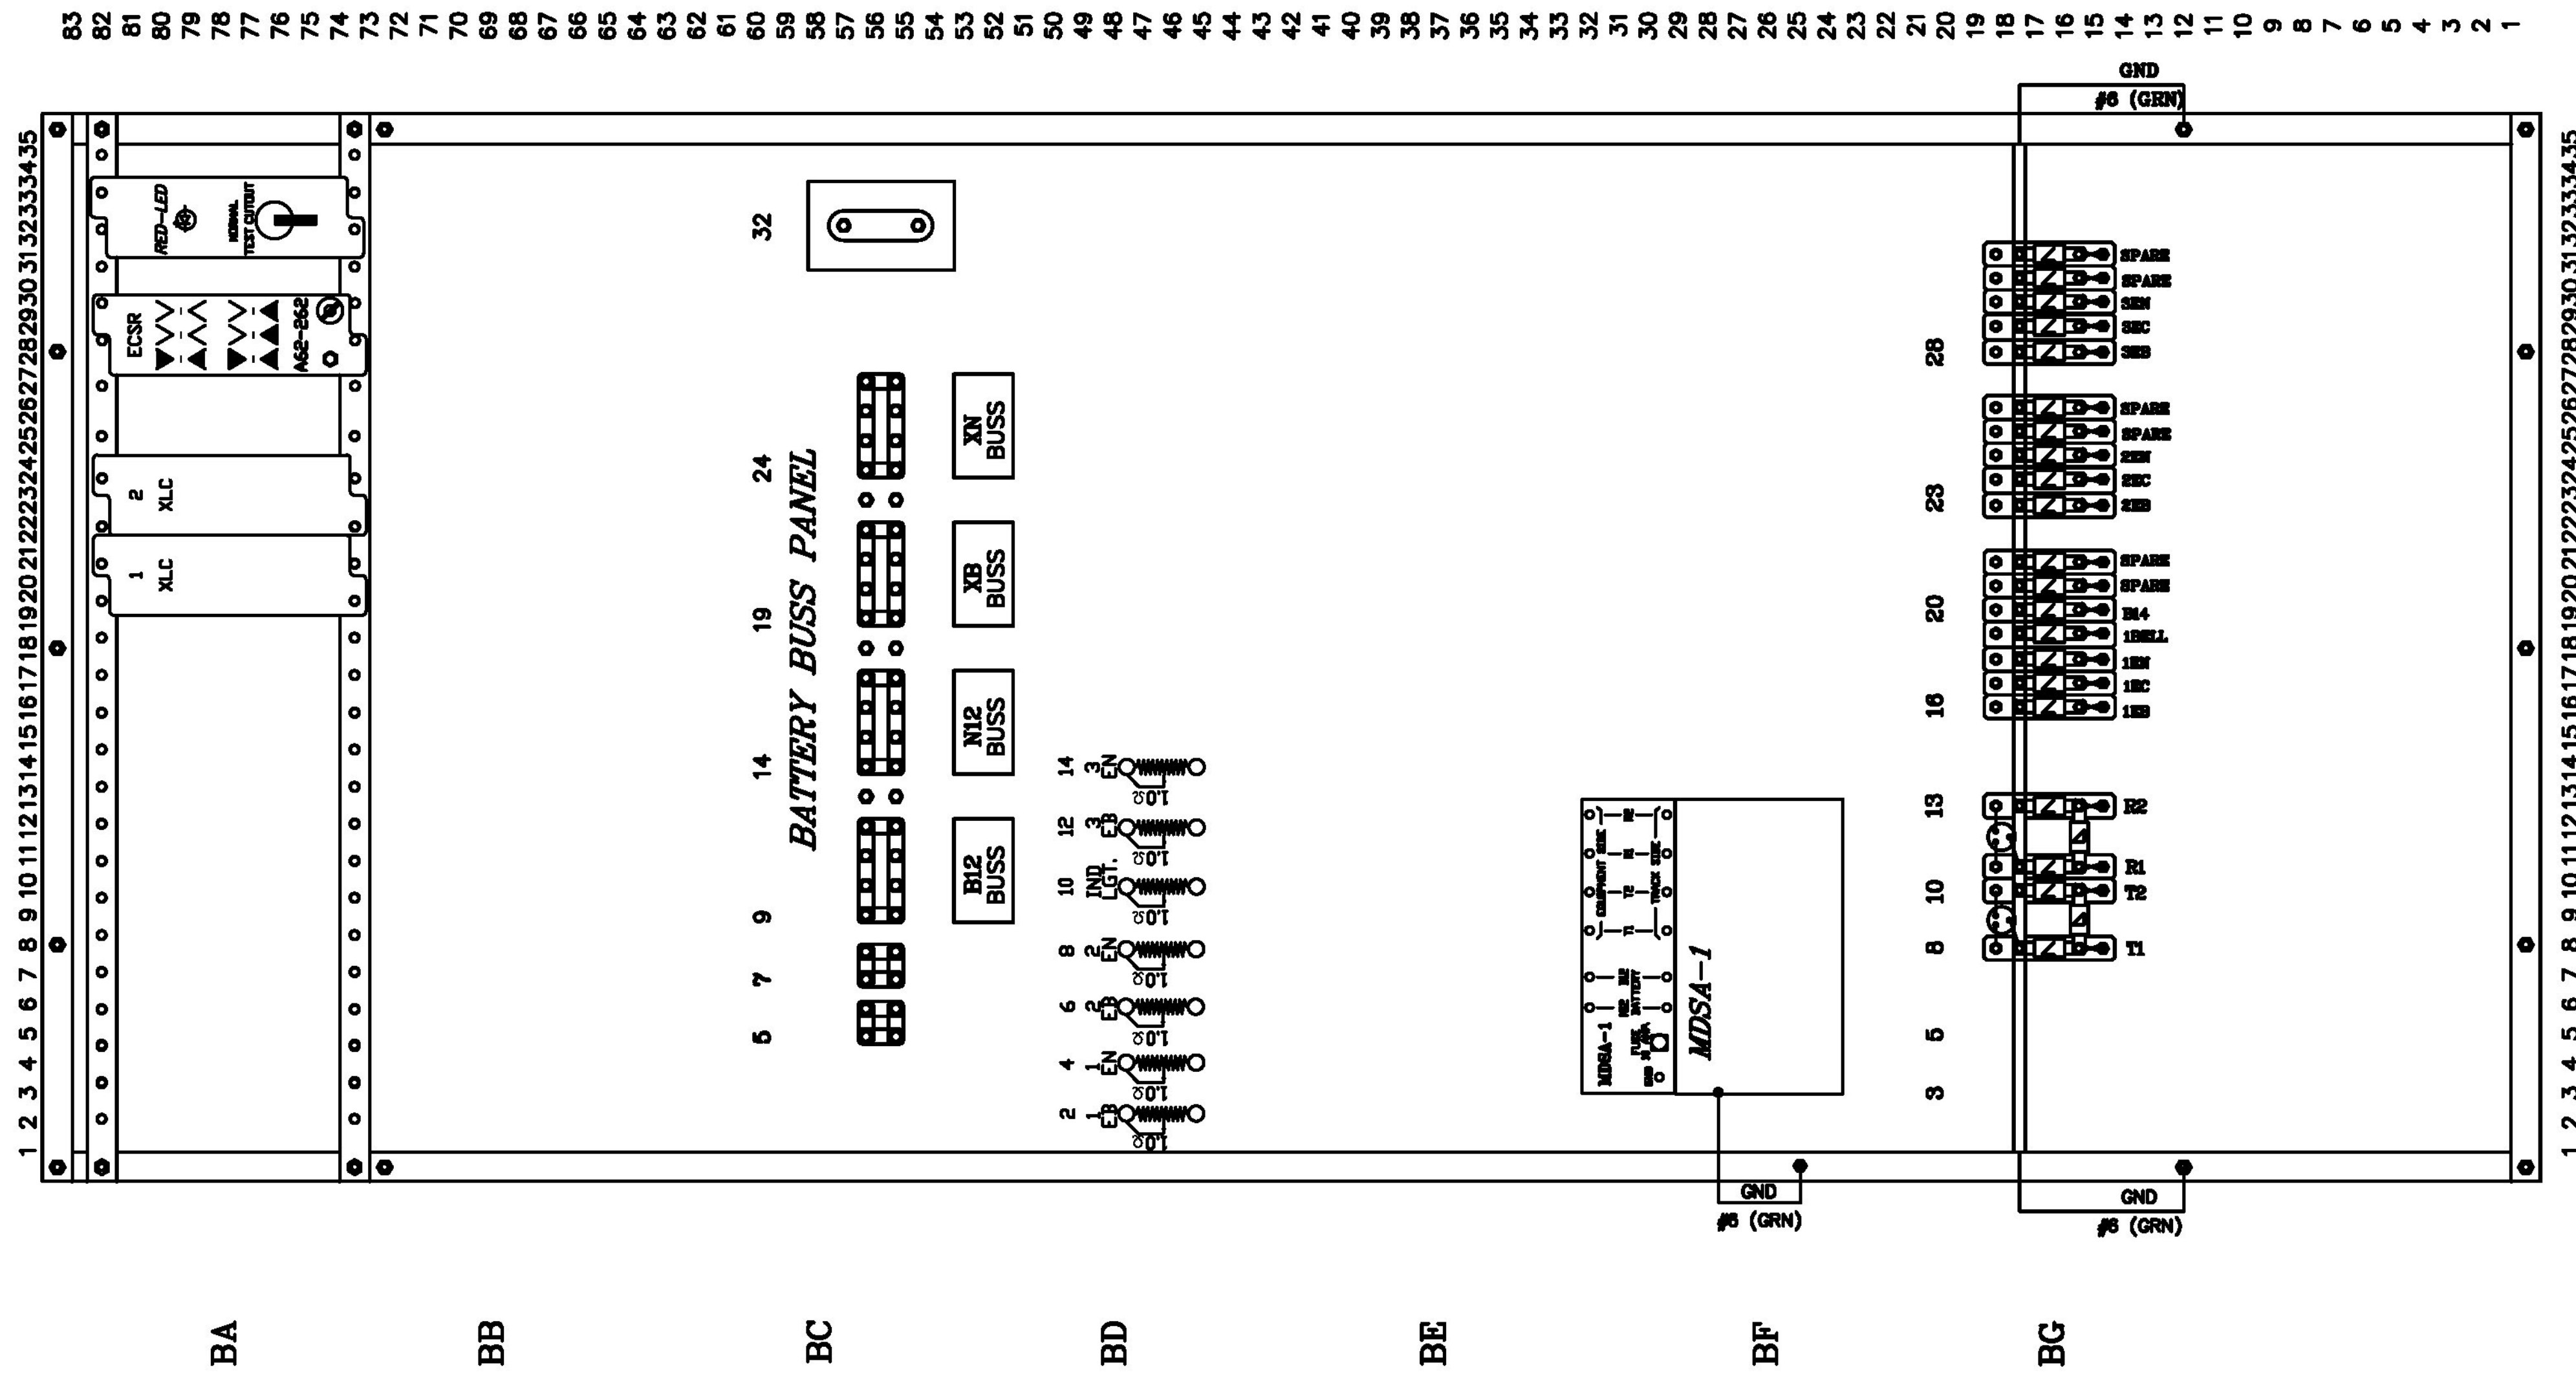

Revision:	Drawn By:	App'd. By:	Date:	Designed By:	Date:
	SLW			SLW	4/16
	SLW			SLW	4/16
	SLW			SLW	4/16

UNAUTHORIZED ALTERATION OR ADDITION TO THIS DOCUMENT IS A VIOLATION OF SECTION 7008 SUBDIVISION 2 OF THE NEW YORK STATE EDUCATION LAW

25 Cobble Hill Drive  
Wilton, NY 12831  
(518) 424-6794  
shvertans@earthlink.net  
www.saratogarailroad.com

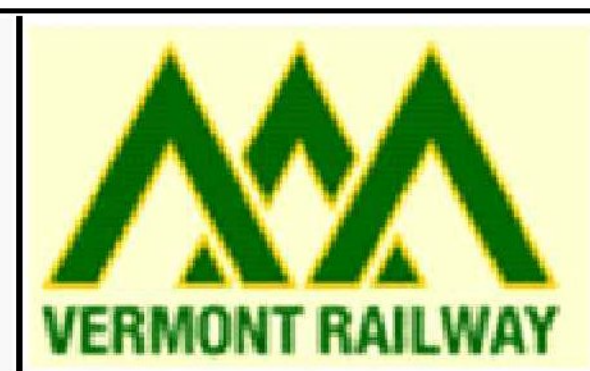

VERMONT RAILWAY  
ONE RAILWAY LANE  
BURLINGTON, VT  
05401

GRADE CROSSING WARNING SIGNALS  
TERMINAL BD LAYOUT PLAN  
EAST ARLINGTON RD., ARLINGTON, VT.  
SCALE: NONE      DATE: APRIL 2016

Drawing No.  
**L-1**  
SHEET 9 OF 10

