



# STATE OF VERMONT AGENCY OF TRANSPORTATION

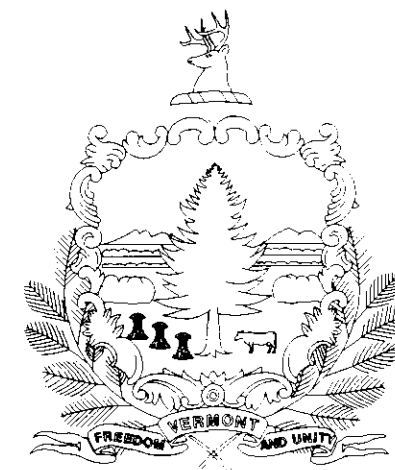

## PROPOSED IMPROVEMENT BRIDGE PROJECT TOWN OF RICHMOND COUNTY OF CHITTENDEN BRIDGE NO. 31 ON TOWN HIGHWAY NO. 1 (FAS 0209) RURAL MAJOR COLLECTOR




PROJECT LOCATION: BRIDGE STREET, APPROXIMATELY 0.25 MILES SOUTH OF THE INTERSECTION OF US ROUTE 2 AND BRIDGE STREET (T.H. 1) IN THE TOWN OF RICHMOND.

PROJECT DESCRIPTION: THIS PROJECT INVOLVES THE REHABILITATION OF EXISTING STEEL TRUSS BRIDGE, MINOR REPAIR OF EXISTING ABUTMENTS AND MINOR APPROACH RECONSTRUCTION.  
 LENGTH OF STRUCTURE: 235.02 FEET (0.045 MILES)  
 LENGTH OF ROADWAY: 129.98 FEET (0.028 MILES)  
 LENGTH OF PROJECT: 365 FEET (0.073 MILES)

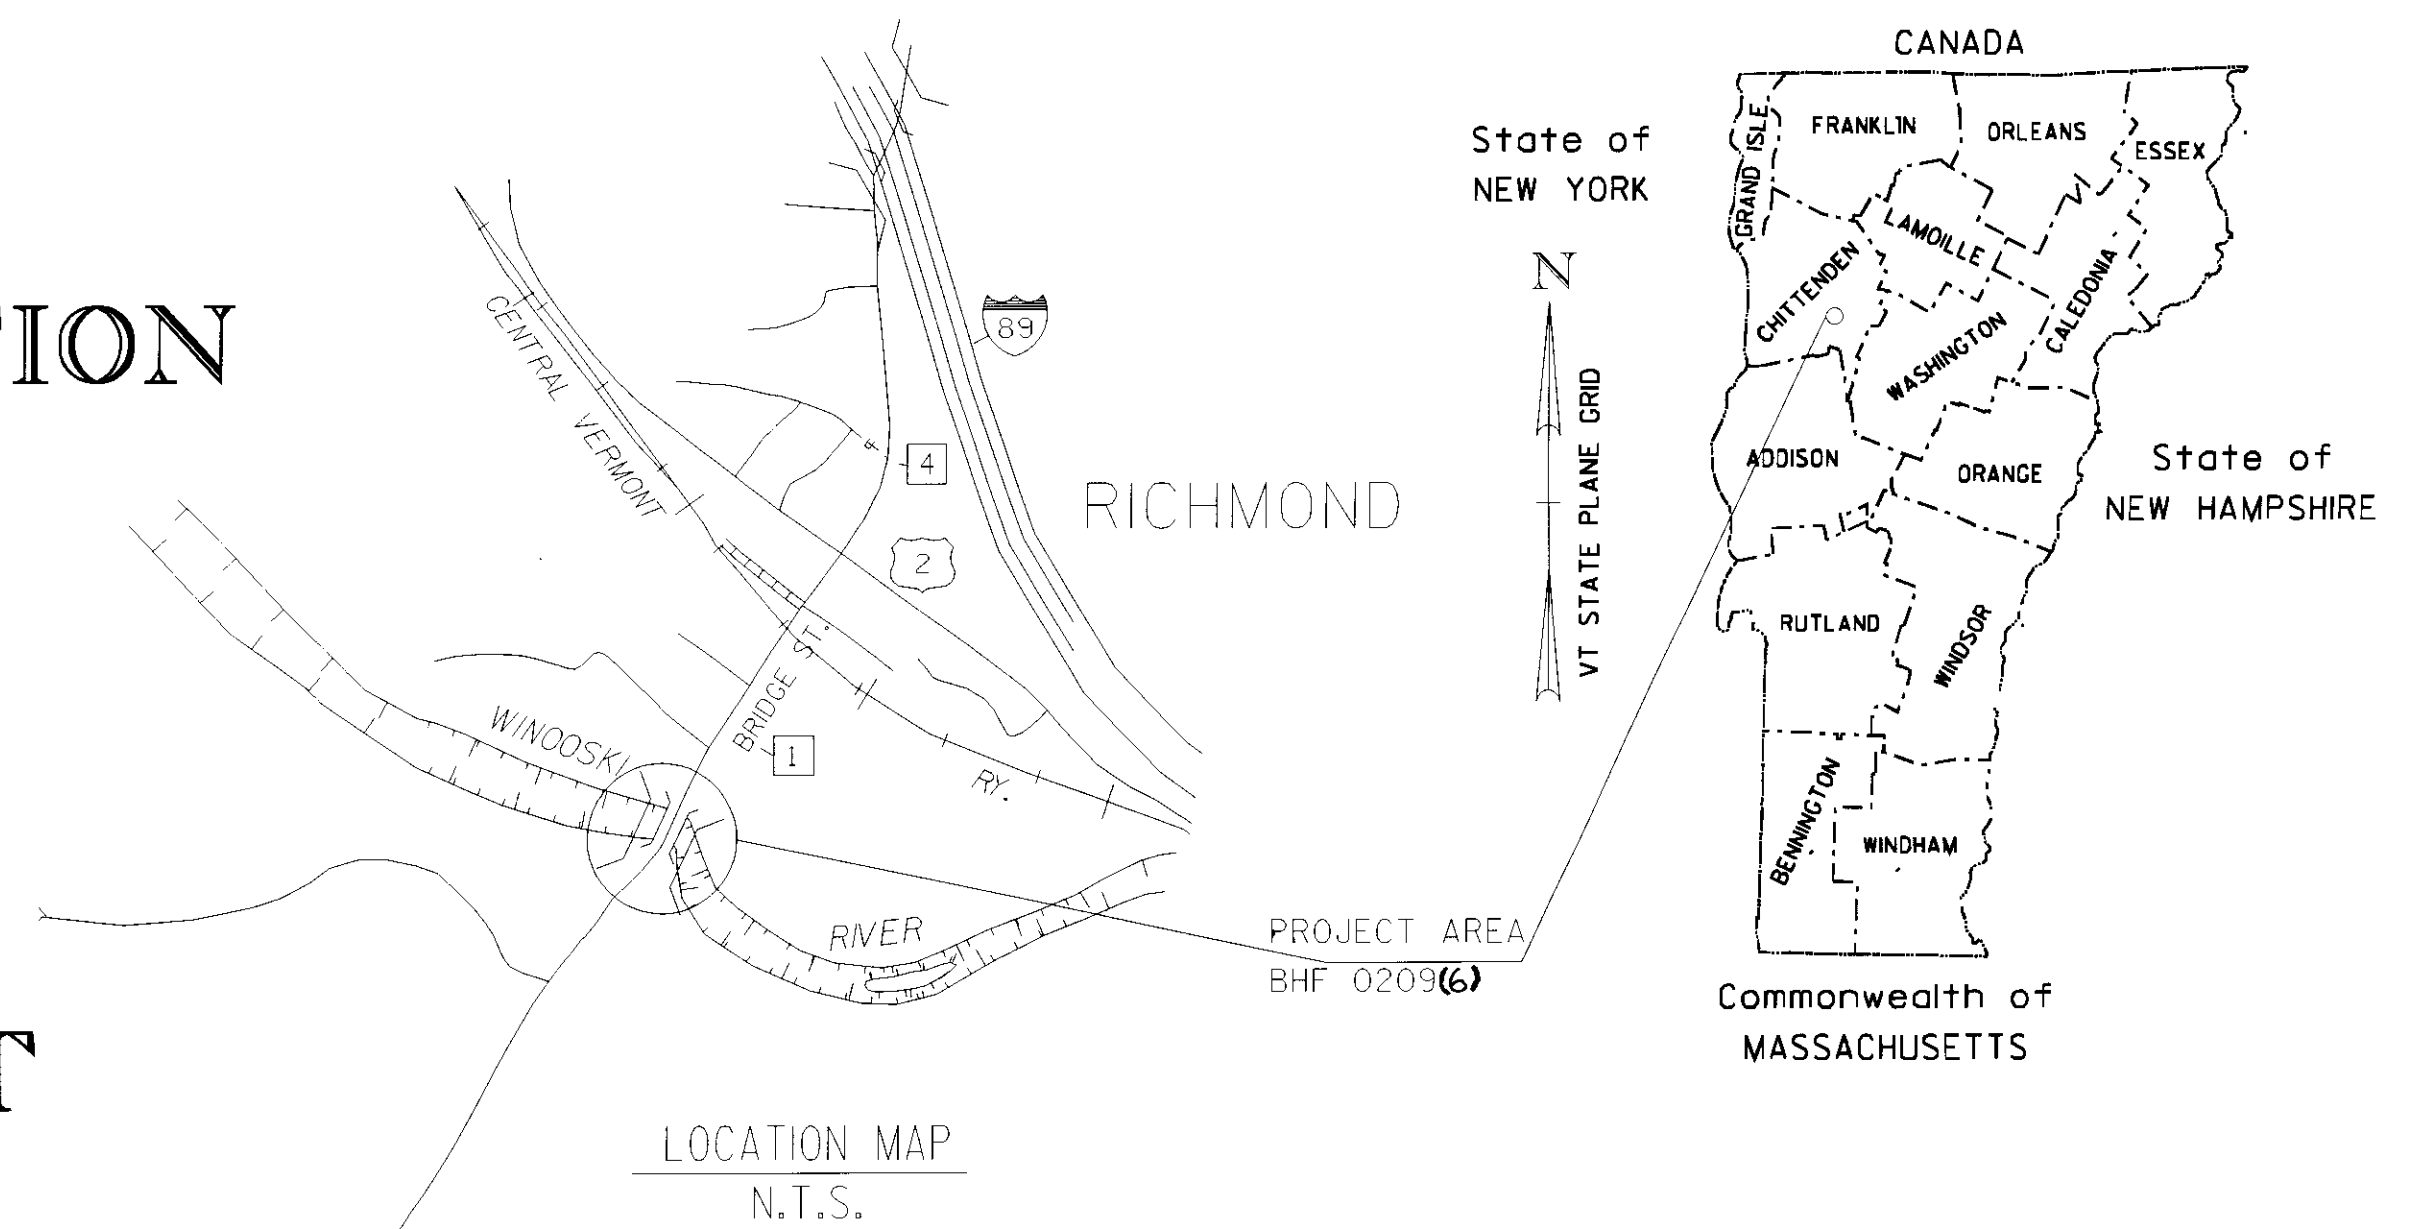


**SEE SHEET 2 FOR THE INDEX OF SHEETS**

RECORD PLANS	
CONTRACTOR:	T. BUCK CONSTRUCTION, INC. - AUBURN, ME
RESIDENT ENGINEER:	GREG WILCOX
CONSTRUCTION BEGAN:	MARCH 9, 2009
CONSTRUCTION COMPLETE:	AUGUST 28, 2009
RECORD PLANS BY:	GREG WILCOX & NICK GARBACIK
I HEREBY CERTIFY THAT ALL THE CONSTRUCTION REQUIRED BY THIS SET OF DRAWINGS HAS BEEN ACCOMPLISHED AS INDICATED HEREIN.	
BY:	<i>Greg Wilcox</i> RESIDENT ENGINEER
DATE:	3/31/11
NOTE: Any further information concerning final quantities, amounts or other details relative to this project may be found at Central Files in the electronic archives.	

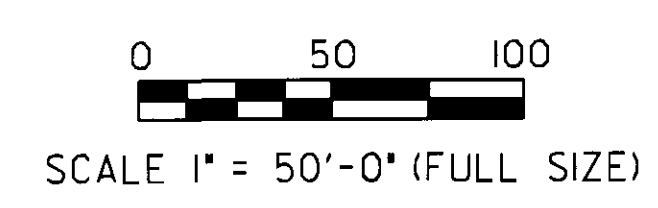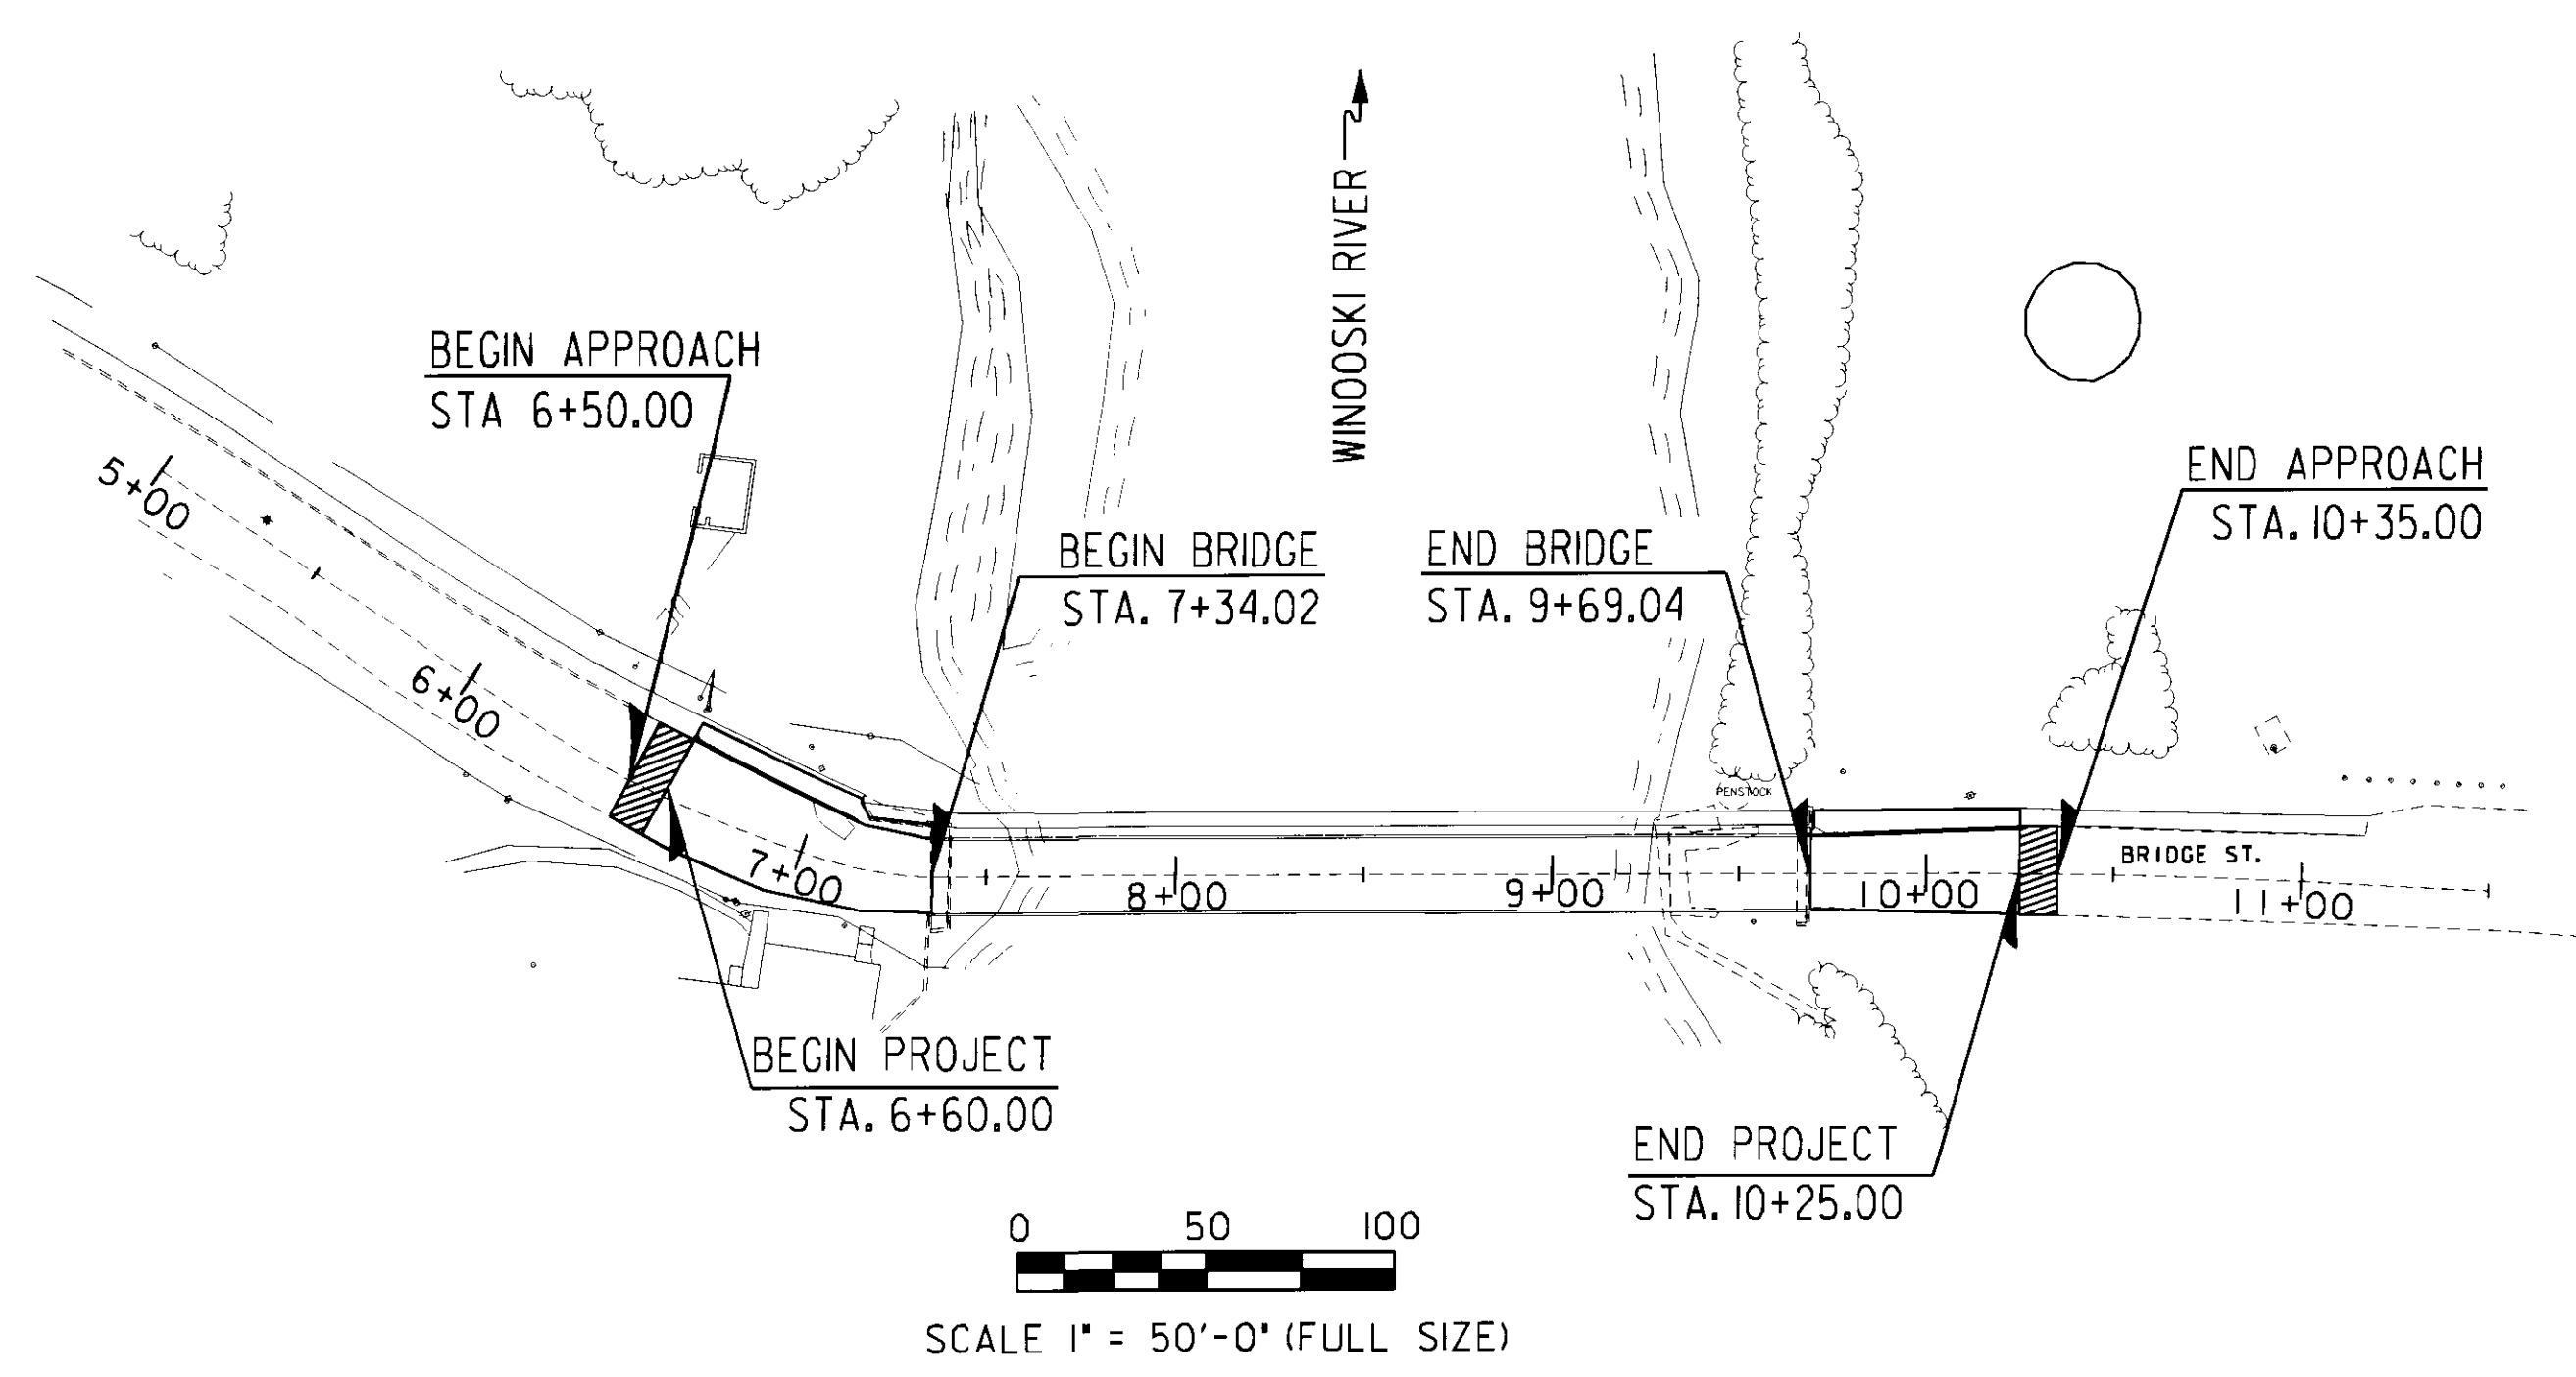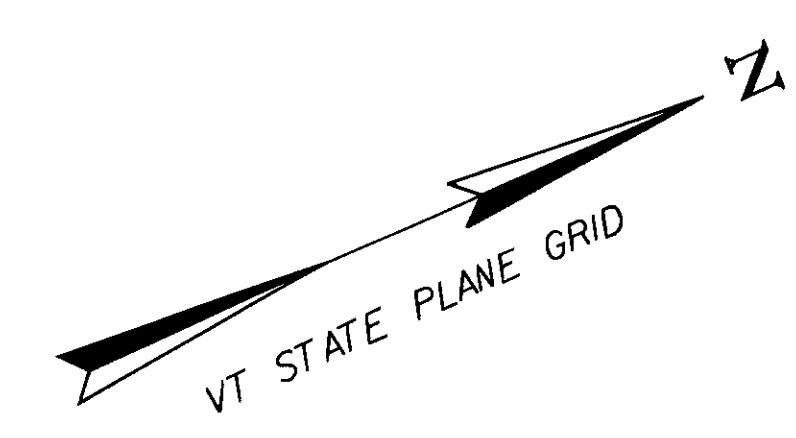

CONVENTIONAL SYMBOLS	
COUNTY LINE	
TOWN LINE	
LIMITS OF ACCESS	
POINT OF ACCESS	
FENCE LINE	
STONE WALL	
TRAVELED WAY	
GUARD RAIL	
RAILROAD	
SURVEY LINE	
CULVERT	
POWER POLE	
TELEPHONE POLE	
TREES	
CONTROL OF ACCESS	
PROPERTY LINE	
R.O.W. TAKING LINE	
SLOPE RIGHTS	
TOP OF CUT	
TOE OF SLOPE	

SURVEYED BY :	VERMONT SURVEY
SURVEYED DATE :	06/26/07
DATUM	
VERTICAL	NAVD88 (GeoId03)
HORIZONTAL	NAD 83 (CORS96) SPC (4400 VT)

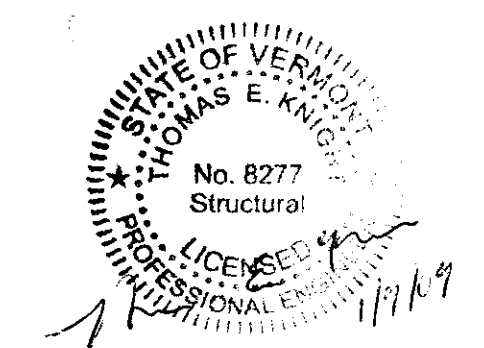

THESE PLANS ARE SUBJECT TO SUCH ENGINEERING CHANGES AS MAY BE REQUIRED BY THE FEDERAL HIGHWAY ADMINISTRATION OR THE DIRECTOR OF PROGRAM DEVELOPMENT.  
 CONSTRUCTION IS TO BE CARRIED ON IN ACCORDANCE WITH THESE PLANS AND THE STANDARD SPECIFICATIONS FOR CONSTRUCTION DATED 2006, AS APPROVED BY THE FEDERAL HIGHWAY ADMINISTRATION ON JUNE 15, 2006 FOR USE ON THIS PROJECT, INCLUDING ALL SUBSEQUENT REVISIONS AND SUCH REVISED SPECIFICATIONS AND SPECIAL PROVISIONS AS ARE INCORPORATED IN THESE PLANS.

Stantec Consulting Services Inc.  
 55 Green Mountain Drive  
 South Burlington VT U.S.A.  
 05403  
 Tel. 802.864.0223  
 Fax. 802.864.0665  
 www.stantec.com

DIRECTOR OF PROGRAM DEVELOPMENT	
APPROVED: <i>Chris Williams</i>	DATE: 1-6-09
PROJECT MANAGER : CHRIS WILLIAMS, P. E.	
PROJECT NAME :	RICHMOND
PROJECT NUMBER :	BHF 0209 (6)
SHEET 1	OF 50 SHEETS