


**ROADWAY TYPICAL SECTION  
SOUTH APPROACH**

NOT TO SCALE

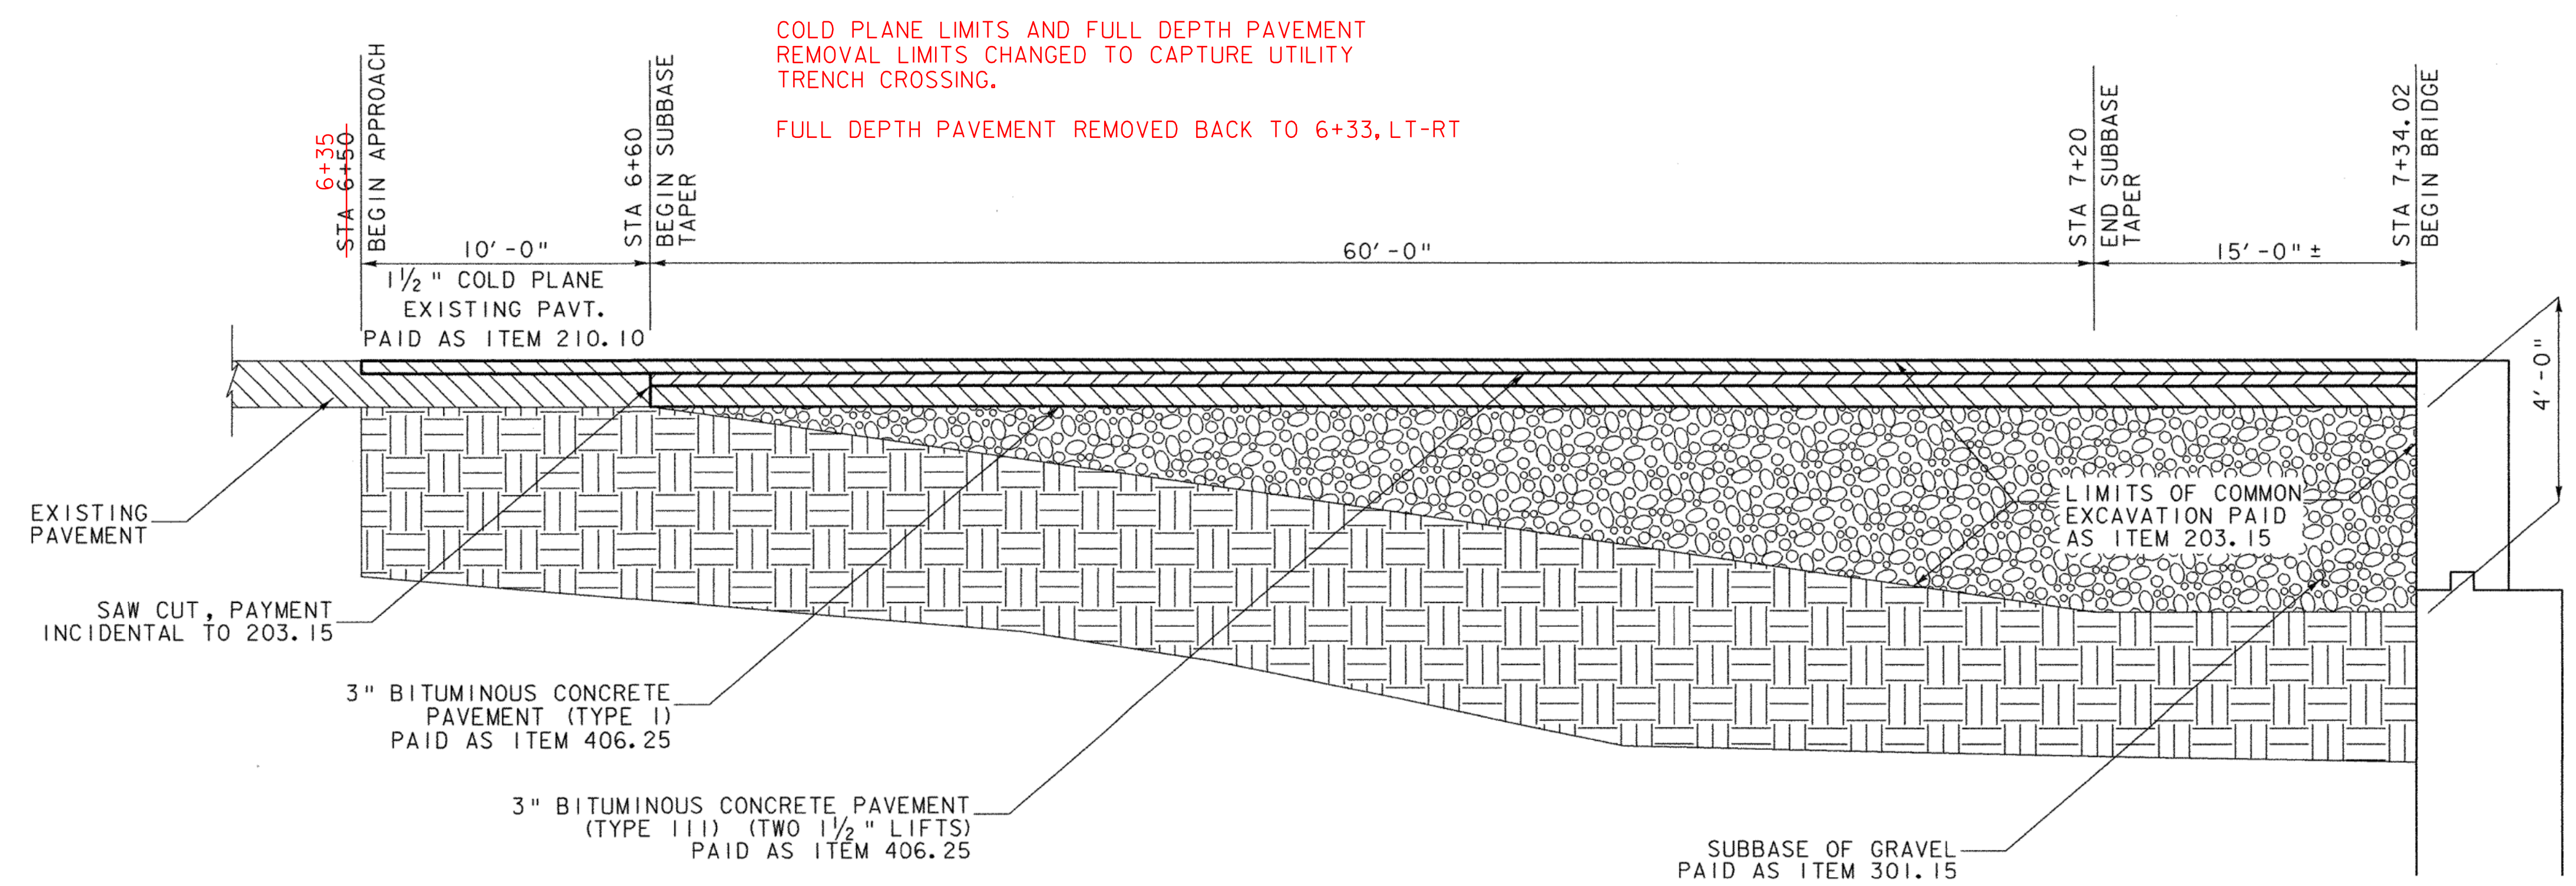

**TYPICAL APPROACH SECTION  
SOUTH APPROACH**

NOT TO SCALE

PROJECT NAME:	RICHMOND
PROJECT NUMBER:	BHF 0209(5)
FILE NAME:...	03-04 TypicalRoadway Sections.pPEOT DATE: 1/8/2009
PROJECT LEADER:	C. WILLIAMS
DESIGNED BY:	G. GOYETTE
DRAWN BY:	E. ALLING
CHECKED BY:	T. KNIGHT
<b>TYPICAL ROADWAY SECTIONS 2</b>	SHEET 4 OF 50

