

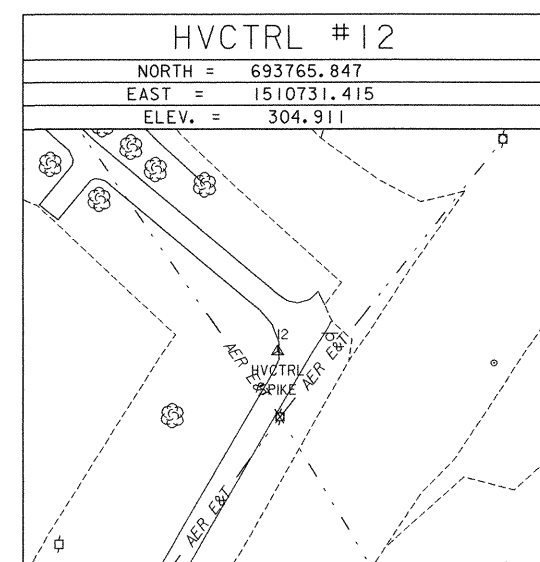
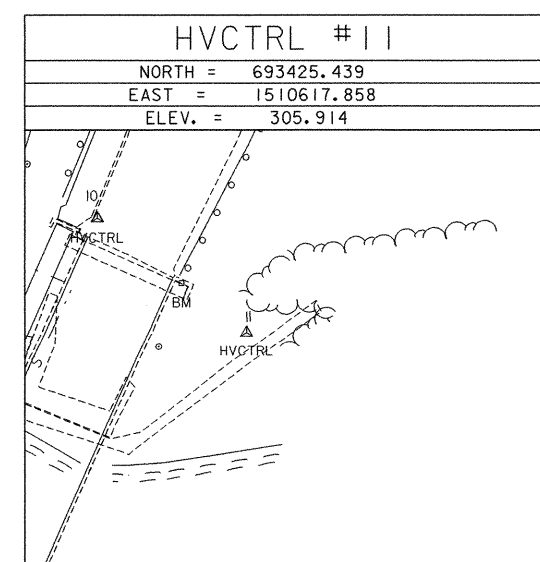


TRAVERSE TIES

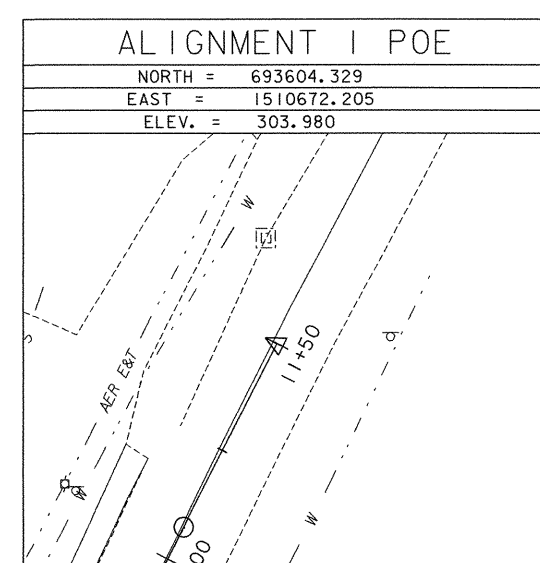

ALIGNMENT TIES

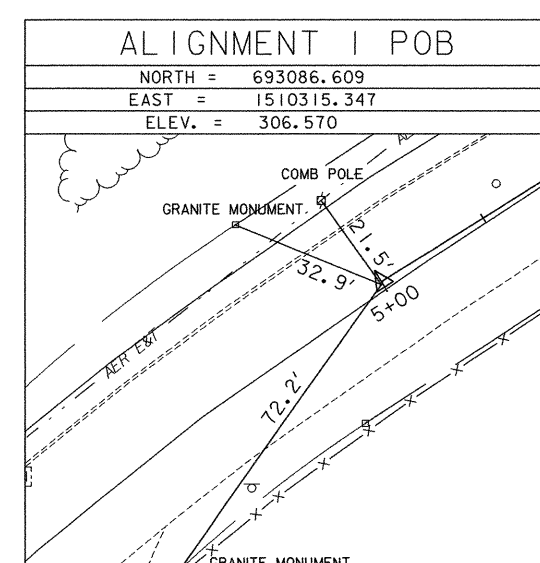

DATUM
 VERTICAL NAD 88
 HORIZONTAL NAD 83
 ADJUSTMENT



PROJECT NAME: RICHMOND
 PROJECT NUMBER: BHF 0209(5)
 FILE NAME: \p01 files\The Sheets.dwg
 PROJECT LEADER: C. WILLIAMS
 DESIGNED BY: G. GOYETTE
 TIE SHEET 2

PLOT DATE: 1/8/2009
 DRAWN BY: E. ALLING
 CHECKED BY: T. KNIGHT
 SHEET 8 OF 50