

BRESSOR, GARY T. & JEAN H.

PAVEMENT LIMITS EXTENDED TO CAPTURE UTILITY TRENCH.

BRESSOR, GARY T. & JEAN H.

CURVE 1 (COMPOUND)
 PI BK = 6+95.08
 PI AHD = 6+91.46
 $\Delta = 34^{\circ}01'25''$
 $D = 19^{\circ}05'55''$ (1) $D = 57^{\circ}17'45''$ (2)
 $R = 300.00'$ (1) $R = 100.00'$ (2)
 $T = 76.05'$ (1) $T = 46.14'$ (2)
 $L = 88.79'$ (1) $L = 29.78'$ (2)
 $E = 9.49'$

PCC STATION 7+07.82
 N = 693205.00
 E = 1510483.66
 ELEV = 316.11 FT

CAST-IN-PLACE CONCRETE CURB, TYPE B
 STA. 6+60, 17.5' LT - STA. 7+11, 12.8' LT
 STA. 9+70, 10.6' LT - STA. 10+25, 12.6' LT

SPECIAL PROVISION (BOX BEAM GUARDRAIL, TRUSS)
 STA. 7+24, 14.5' RT - STA. 7+36, 11.1' RT
 STA. 9+68, 10.8' RT - STA. 11+08, 19.1' RT
 STA. 9+68, 11.1' LT - STA. 10+28, 12.8' LT

SPECIAL PROVISION (BRIDGE RAILING, TRUSS)
 STA. 7+36, 10.6' RT - STA. 9+68, 10.6' RT
 STA. 7+36, 10.6' LT - STA. 9+68, 10.6' LT

PORTLAND CEMENT CONCRETE SIDEWALK, 5 INCH
 STA. 6+60, 17.5' LT - STA. 7+11, 12.8' LT
 STA. 9+70, 10.6' LT - STA. 10+25, 12.6' LT

REMOVE EXISTING SIDEWALK PER PAY ITEM SOLID ROCK EXCAVATION
 STA. 6+60, 17.5' LT - STA. 7+11, 12.8' LT
 STA. 9+70, 10.6' LT - STA. 10+25, 12.6' LT

REMOVAL OF EXISTING CURB
 STA. 9+70, 10.6' LT - STA. 10+26, 12.6' LT

REMOVAL AND DISPOSAL OF GUARDRAIL
 STA. 7+25, 14.5' RT - STA. 7+34, 11.1' RT
 STA. 9+70, 10.8' RT - STA. 11+06, 19.1' RT
 STA. 9+74, 18.0' LT - STA. 10+24, 19.0' LT


REMOVING AND RESETTING PROPERTY MARKERS
 STA. 6+23, 29.0' LT
 STA. 7+09, 35.3' LT

STATE OF VERMONT

LEGEND

- ▲-▲-▲ CONSTRUCTION LIMITS
- TEMPORARY CONSTRUCTION LIMITS
- TEMPORARY CONSTRUCTION LIMITS, IN-STREAM

1'-0" STONE FILL, TYPE 1
 STA. 9+69, 23.0' RT

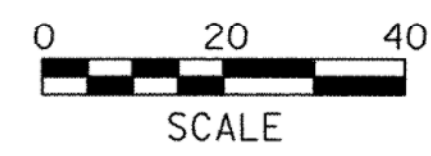

NOTES:

1. SEE TYPICAL ROADWAY SECTIONS SHEETS FOR BRIDGE APPROACH CONSTRUCTION DETAILS.
2. CONTRACTOR SHALL SHIELD EXISTING UTILITY POLES DURING CONSTRUCTION IN ACCORDANCE WITH THE SPECIAL PROVISIONS.
3. LOCATION OF WATER AND SEWER LINES OBTAINED FROM THE TOWN OF RICHMOND WATER RESOURCES DEPARTMENT AND ARE CONSIDERED APPROXIMATE. CONTRACTOR SHALL FIELD VERIFY LOCATION OF WATER AND SEWER LINE LOCATIONS PRIOR TO EARTH DISTURBANCE.
4. PROVIDE GEOTEXTILE UNDER STONE FILL IN ACCORDANCE WITH SECTION 649 OF THE STANDARD SPECIFICATIONS, COST INCIDENTAL TO ITEM 613.10.

PROJECT NAME:	RICHMOND
PROJECT NUMBER:	BHF 0209(5)
FILE NAME: ... \plot files \Layout Plan.pxf	PLOT DATE: 1/8/2009
PROJECT LEADER: C. WILLIAMS	DRAWN BY: E. ALLING
DESIGNED BY: G. GOYETTE	CHECKED BY: T. KNIGHT
LAYOUT PLAN	SHEET 9 OF 50

GIFFORD, GEORGE D. & VIRGINIA