


- NOTES:
1. ELEVATIONS SHOWN TO THE NEAREST TENTH ARE EXISTING GROUND ALONG CENTERLINE
 2. ELEVATIONS SHOWN TO THE NEAREST HUNDREDTH ARE FINISH GRADE ALONG CENTERLINE
 3. * INDICATES EXISTING ELEVATIONS UPDATED BASED ON SUPPLEMENTAL SURVEY COMPLETED BY T. KNIGHT & J. SOTER ON OCTOBER 8, 2008.
 4. ** ELEVATION BASED ON ASSUMED DECK THICKNESS OF 8". ELEVATION MAY VARY BASED ON ACTUAL DECK THICKNESS PROVIDED.

CAMBER NOTES

EXISTING CAMBER VERIFIED ON 3-14-09 @ 0.4625
 CAMBER @ CONCLUSION OF PROJECT = 0.43

SEE SHEET # 15

BRIDGE & APPROACH PROFILE

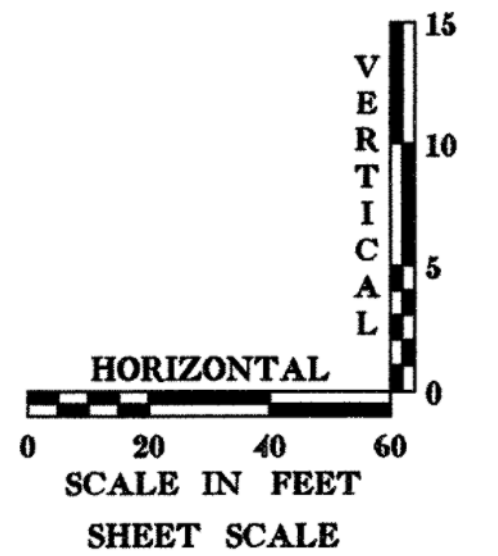

PROJECT NAME: RICHMOND
 PROJECT NUMBER: BHF 0209(5)

FILE NAME: ...plot files\10 Profile.ptf
 PROJECT LEADER: C. WILLIAMS
 DESIGNED BY: G. GOYETTE
PROFILE

PLOT DATE: 1/8/2009
 DRAWN BY: E. ALLING
 CHECKED BY: T. KNIGHT
 SHEET II OF 50