

BRESSOR, GARY T. & JEAN H.

NOTES:

1. ALL EXISTING SIGNS NOT SHOWN SHALL BE RETAINED AS DIRECTED BY THE ENGINEER.
2. FOR PAVEMENT MARKING DETAILS SEE VTRANS STANDARD SHEETS E-191 AND E-193.
3. FOR SIGN DETAILS SEE VTRANS STANDARD SHEETS E-154 AND E-155.
4. NEW SIGN POSTS SHALL BE SQUARE STEEL POSTS. SEE VTRANS STANDARD SHEETS E-121 AND E-164.
5. ALL REMOVED SIGNS SHALL BE RETURNED TO THE TOWN OF RICHMOND HIGHWAY DEPARTMENT.
6. SIGN DIMENSIONS SHALL BE STANDARD SIGN SIZES PER VTRANS STANDARDS


SIGN LEGEND

- N = NEW
- R = REMOVE
- R&S = REMOVE AND SALVAGE
- S = SALVAGE SIGN
- RET = RETAIN
- = EXISTING
- = PROPOSED

4" YELLOW LINE (DOUBLE)  
 STA. ~~6+50 TO STA. 10+35~~, SOLID LT. & RT.  
 7+34 TO 9+69  
 REMOVING SIGNS  
 3 - AS SHOWN

OBJECT MARKER ADDED ON EACH END OF BRIDGE  
 SIGNS ALL 36" x 12"  
 7+34 LT  
 7+34 RT  
 9+69 LT  
 9+69 RT

GIFFORD, GEORGE D. & VIRGINIA

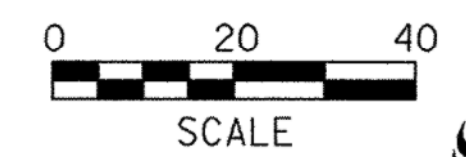

PROJECT NAME: RICHMOND	PLOT DATE: 1/9/2009
PROJECT NUMBER: BHF 0209(5)	DRAWN BY: E. ALLING
FILE NAME: ...Signs and Pvmt Mrkgs.ptf	CHECKED BY: T. KNIGHT
PROJECT LEADER: C. WILLIAMS	SHEET 12 OF 50
DESIGNED BY: G. GOYETTE	
<b>SIGN &amp; PAVEMENT MARKING PLAN</b>	