


**FRAMING PLAN**  
SCALE: 1/4" = 1'-0"  
10-2-11.8

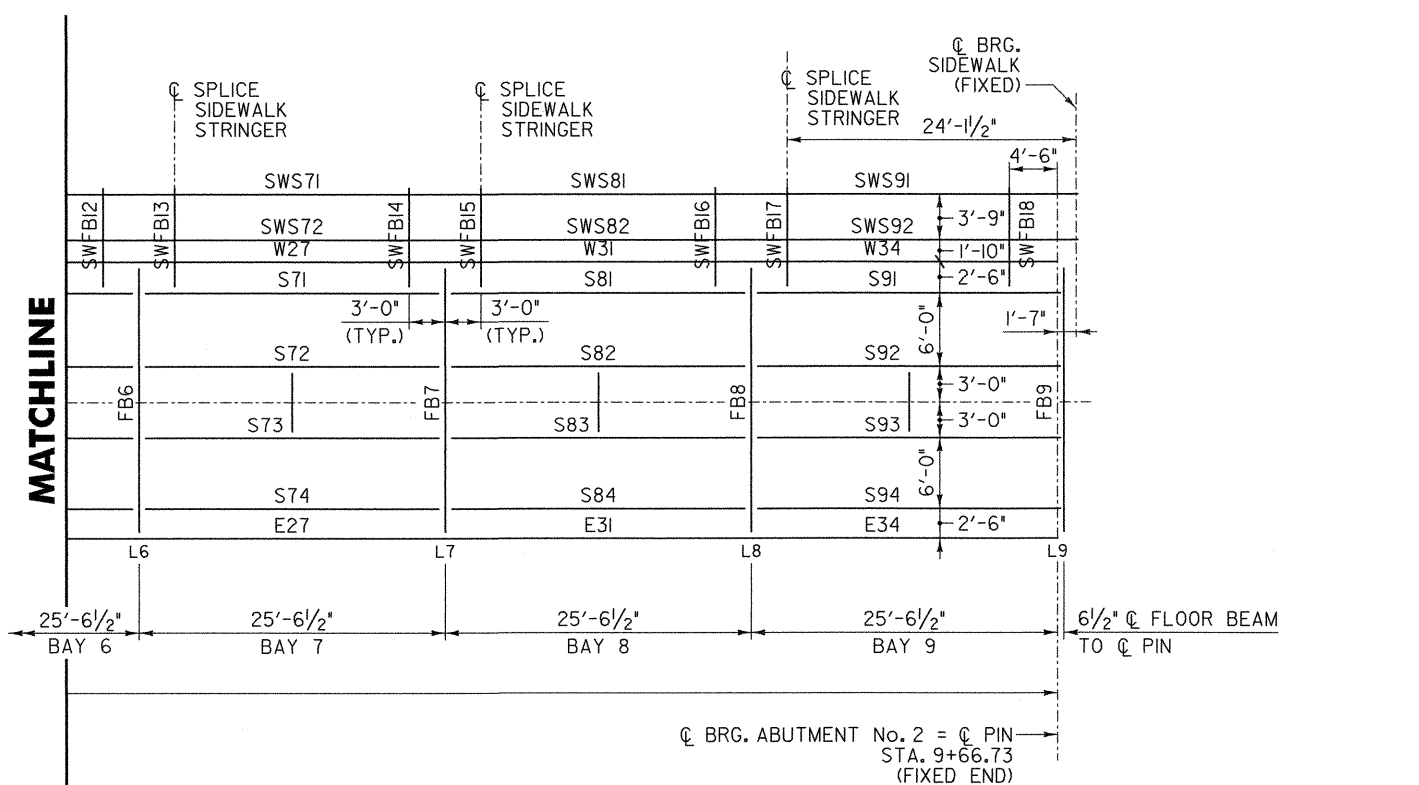

LEGEND	
L	= LOWER TRUSS JOINT
U	= UPPER TRUSS JOINT
S	= FLOOR STRINGER (NEW W24x55)
FB	= FLOOR BEAM (NEW W30x86)
E	= EAST TRUSS MEMBER
W	= WEST TRUSS MEMBER
SWS	= SIDEWALK STRINGER (NEW W12x35)
SWFB	= SIDEWALK FLOOR BEAM (NEW W12x35)
SWD	= SIDEWALK DIAPHRAGM (NEW C7x14)
T.B.O.A.	= TO BACK OF ANGLE (L3/2x3/2)

**STATE OF VERMONT  
AGENCY OF TRANSPORTATION**

Town Of	RICHMOND	Bridge No.	31
Highway No.	T.R. #1	Log Sta.	157+00.00
TOWN HIGHWAY #1 OVER WINDOSKI RIVER			
<b>FRAMING PLAN</b>			
Designed By	T.NIGHT	Drawn By	J.SOTER
Checked By	Date	Bridge Design Supervisor	Date
J.L.NIGHT	01/09	G. BOQUE	01/09
PROJECT	RICHMOND	PROJECT NO.	BHF 0209(5)
CAD Dwg	.../drawing/08332_FRM.dgn	Plot Date	1/8/2009
Bridge Sheet No.		Sheet	14 of 50

