



7+00

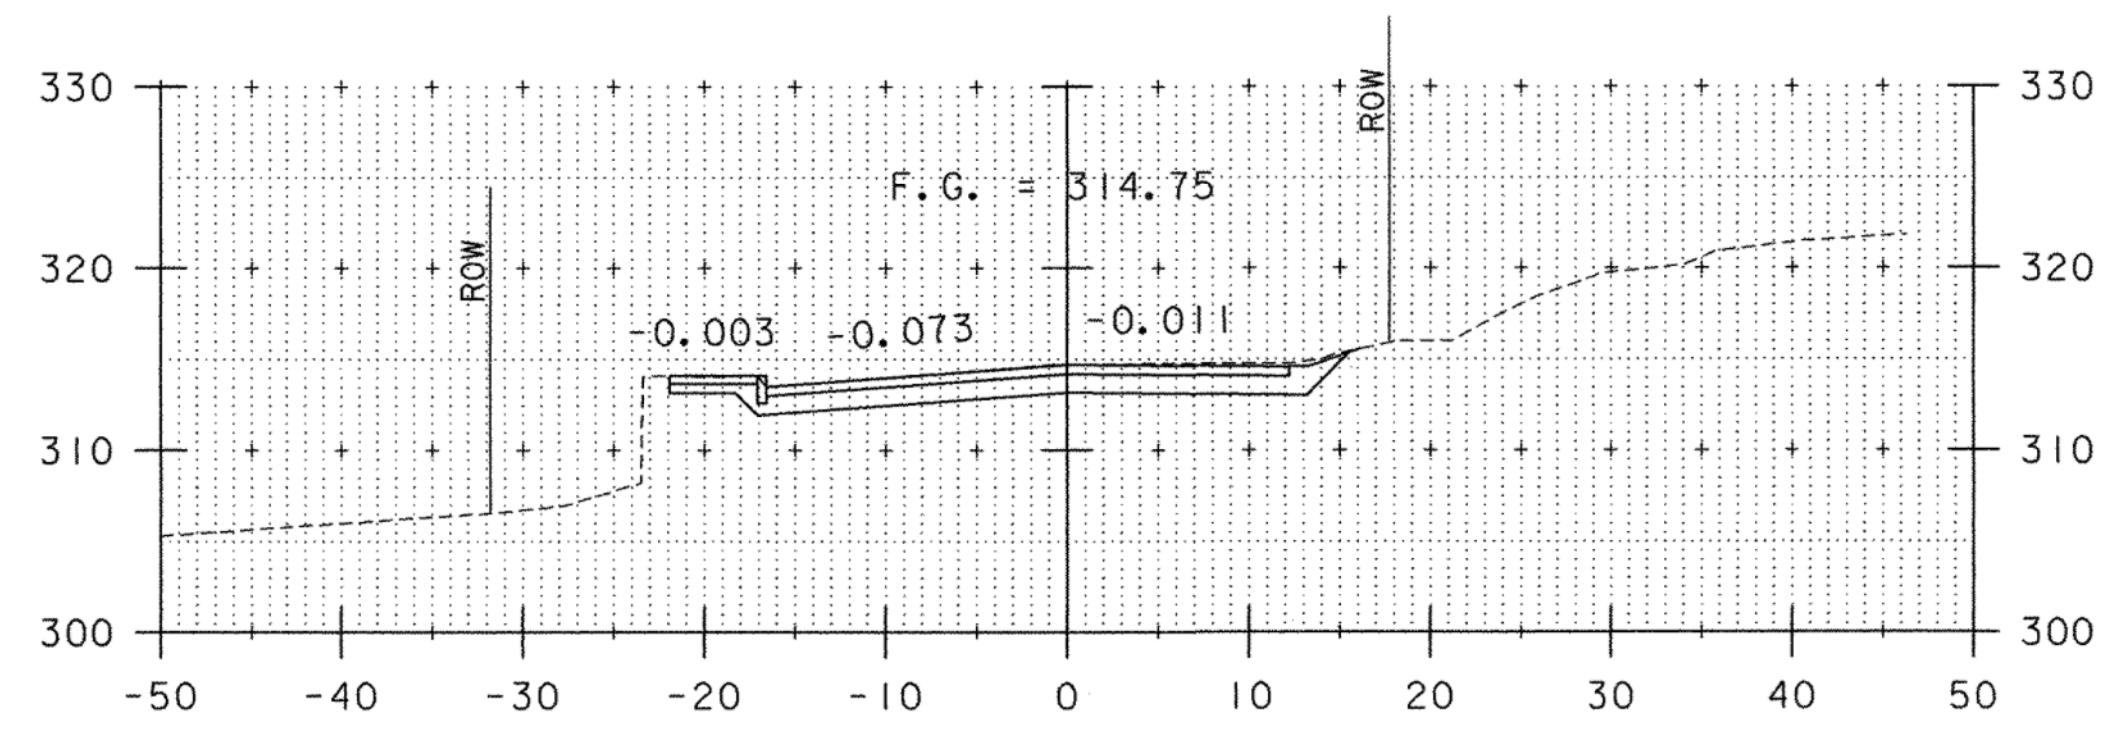

6+75


STA. 6+50  
BEGIN APPROACH

STA. 6+60  
BEGIN PROJECT

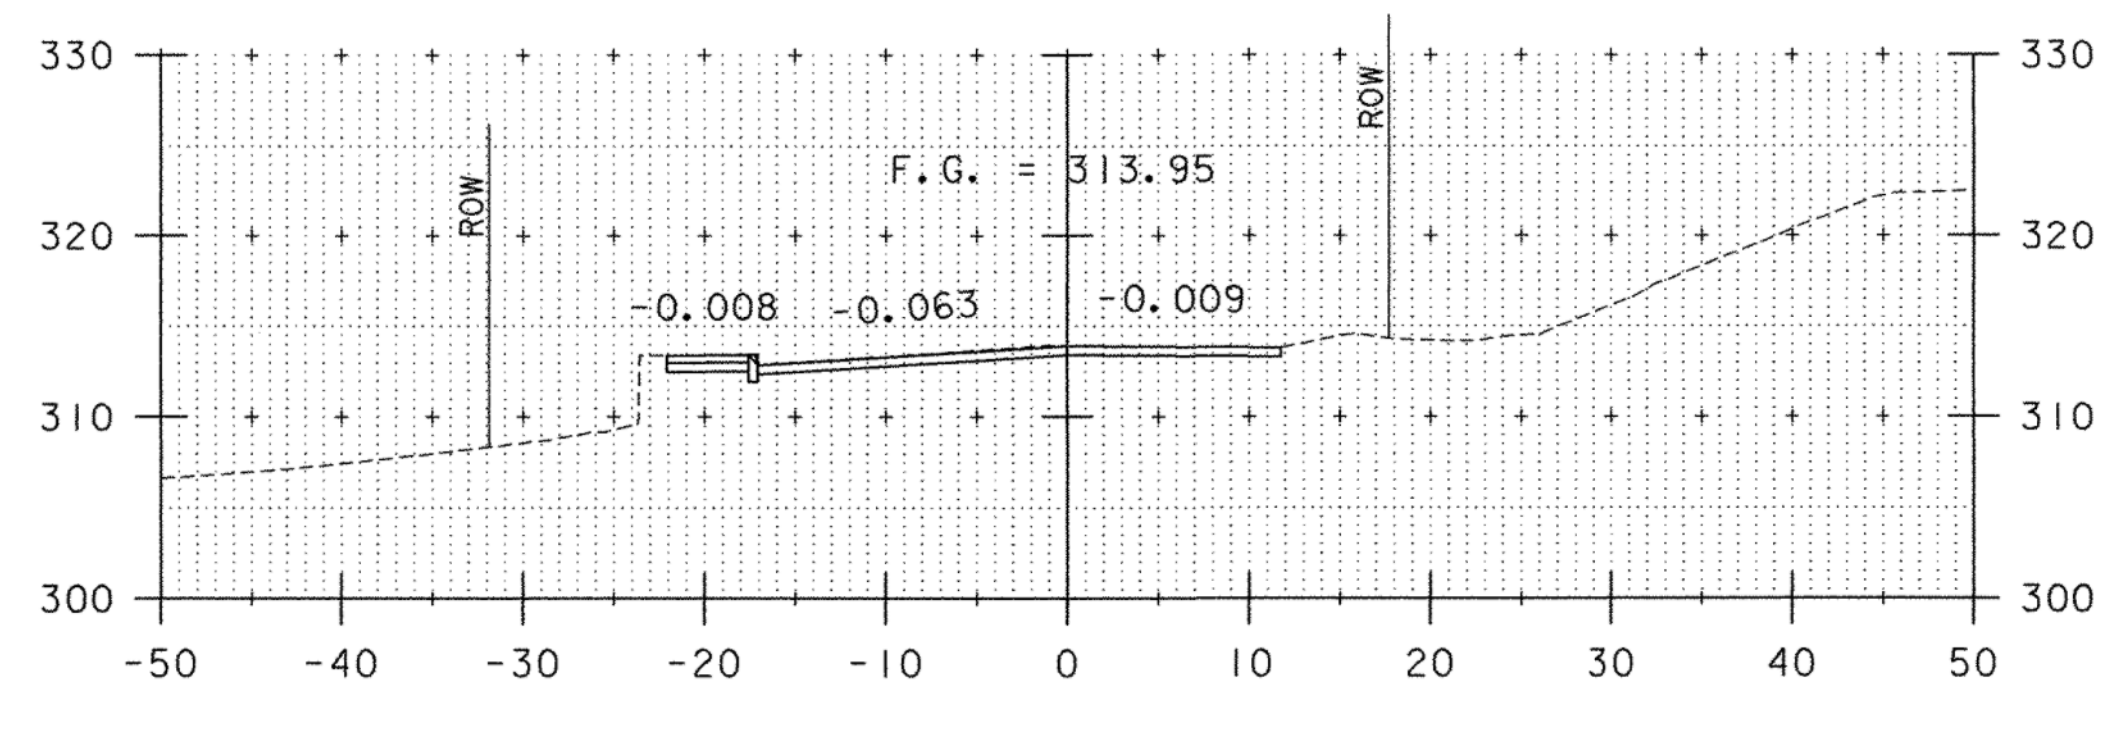


6+60


STA. 7+34.02  
BEGIN BRIDGE

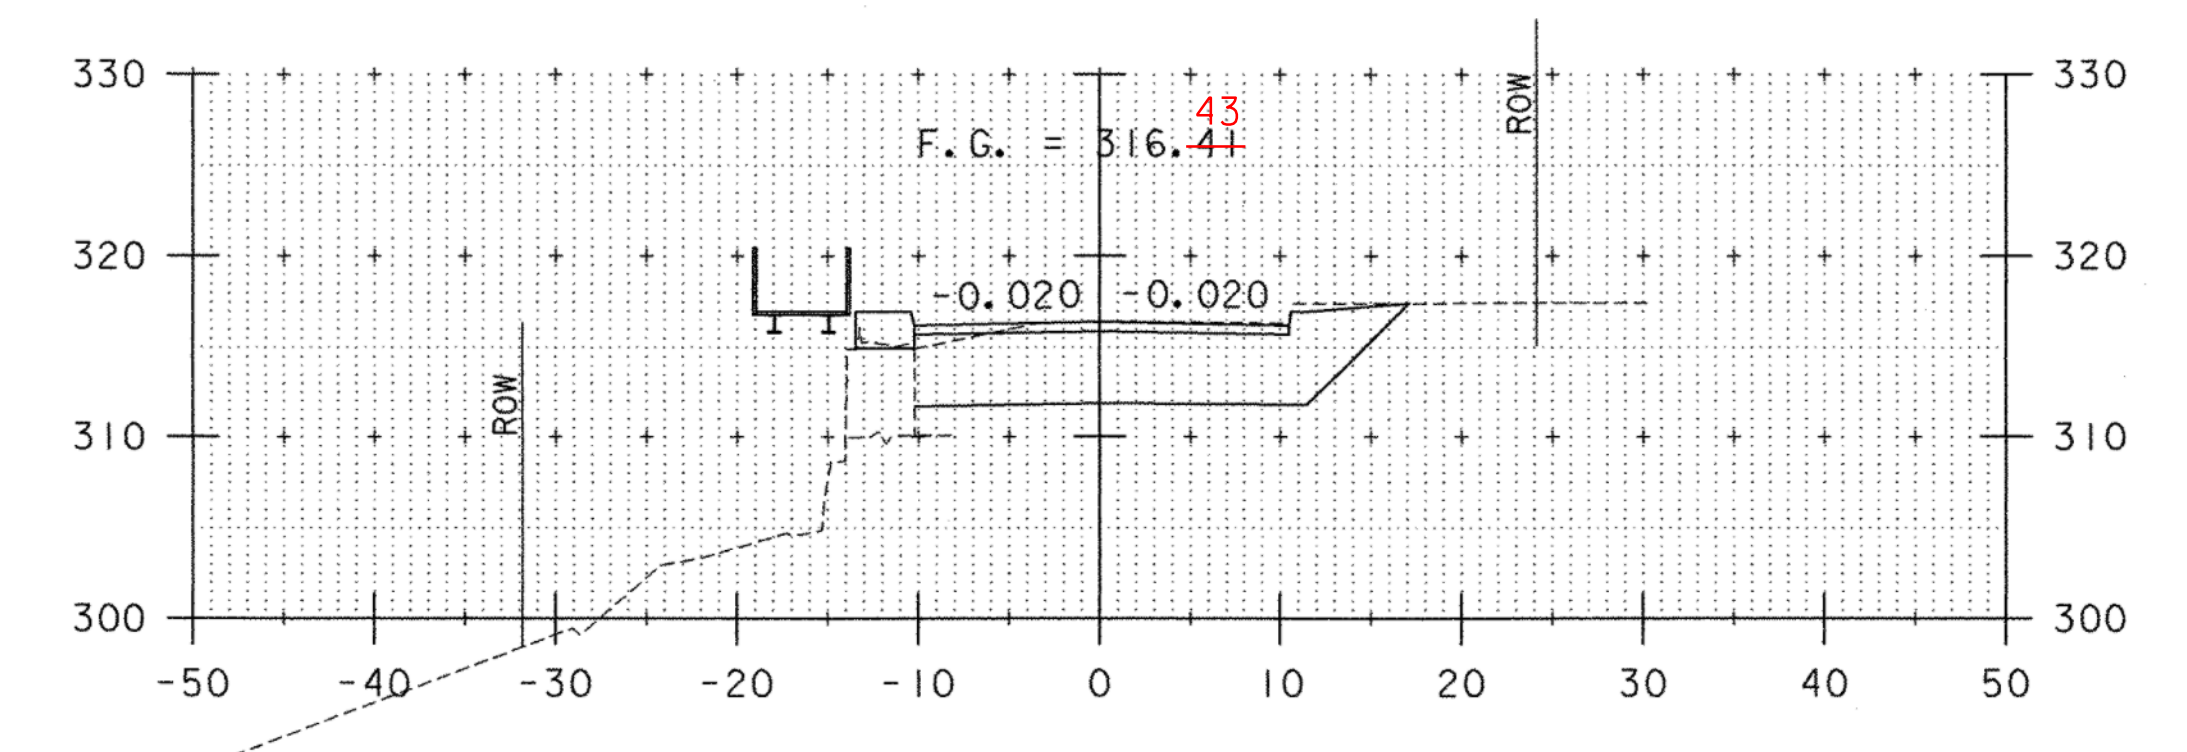

7+35

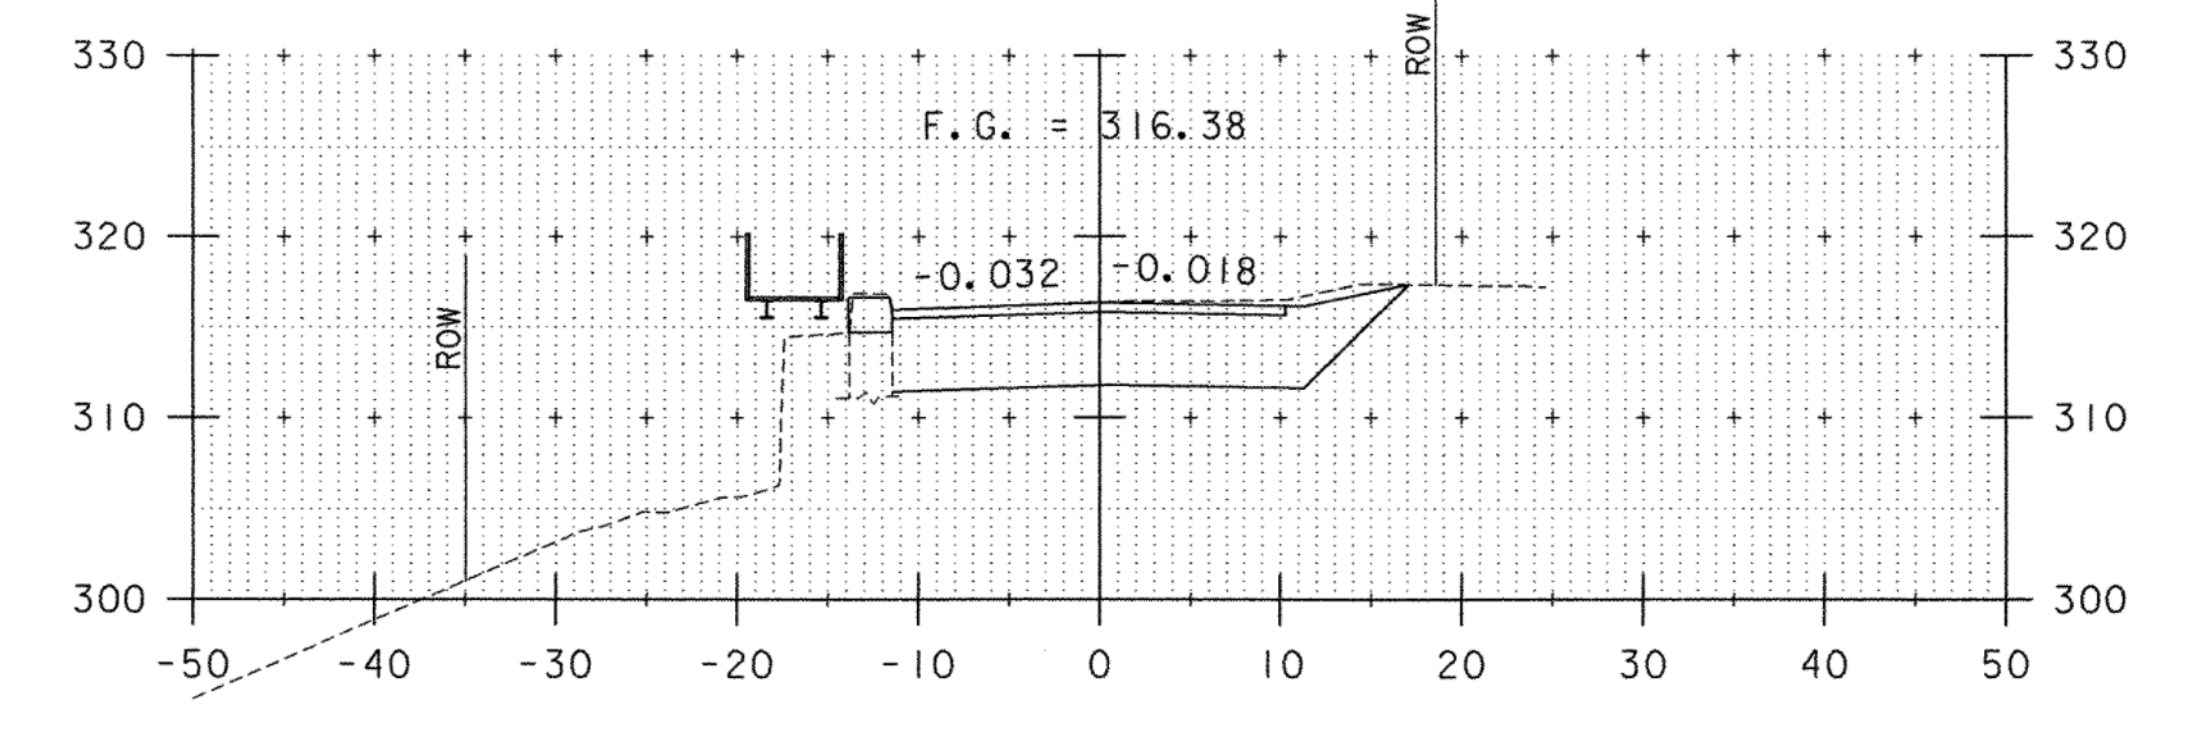

7+25

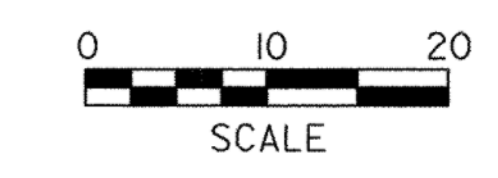

STA. 6+60 TO STA. 9+69



|                                      |                       |
|--------------------------------------|-----------------------|
| PROJECT NAME: RICHMOND               | PLLOT DATE: 1/9/2009  |
| PROJECT NUMBER: BHF 0209(5)          | DRAWN BY: E. ALLING   |
| FILE NAME: ...drawing\z08j32_xsl.dgn | CHECKED BY: T. KNIGHT |
| PROJECT LEADER: C. WILLIAMS          | SHEET 41 OF 50        |
| DESIGNED BY: G. GOYETTE              |                       |
| <b>ROADWAY CROSS SECTIONS 1</b>      |                       |