



10+00

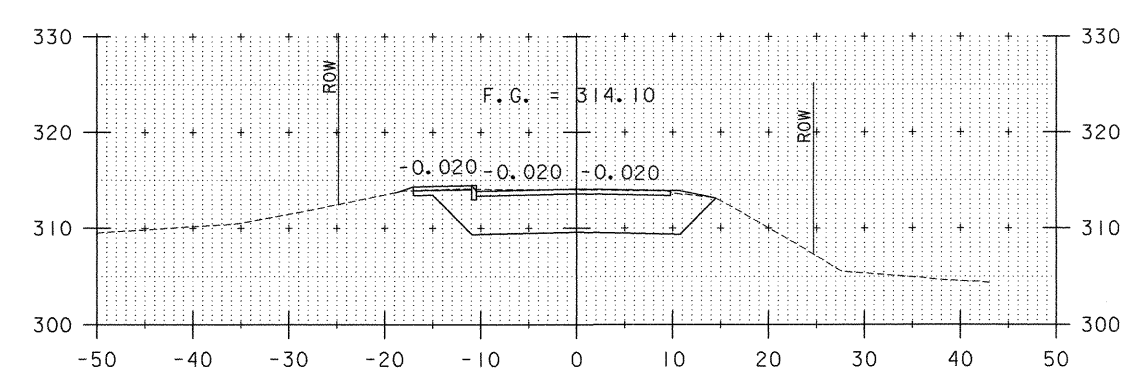

9+75


STA. 9+69.04  
END BRIDGE

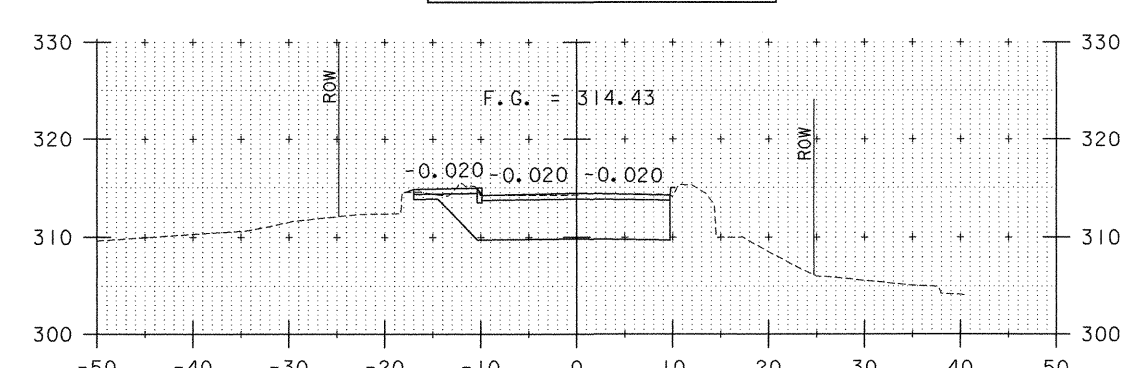


9+69

STA. 10+25  
END PROJECT

STA. 10+35  
END APPROACH

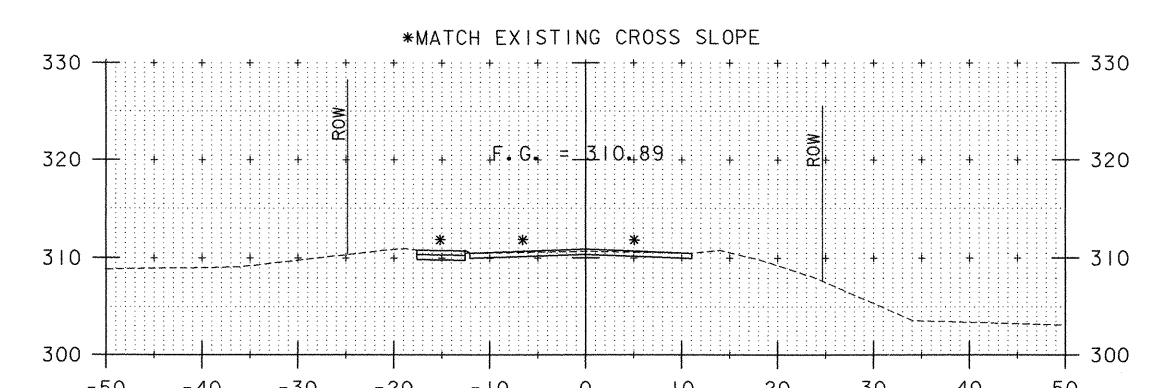

10+25

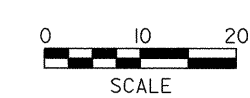

STA. 9+75 TO STA. 10+25



PROJECT NAME: RICHMOND  
 PROJECT NUMBER: BHF 02091(5)  
 FILE NAME: \\drawing\208332.xsl.dgn  
 PROJECT LEADER: C. WILLIAMS  
 DESIGNED BY: G. GOYETTE  
 ROADWAY CROSS SECTIONS 2

PLOT DATE: 1/9/2009  
 DRAWN BY: E. ALLING  
 CHECKED BY: T. KNIGHT  
 SHEET 42 OF 50