


STATE OF VERMONT AGENCY OF TRANSPORTATION



PROPOSED IMPROVEMENT TOWNS OF HARTFORD, NEWFANE, NORWICH, TOWNSHEND AND WINDSOR COUNTIES OF WINDSOR AND WINDHAM VARIOUS TOWN HIGHWAYS

INDEX OF SHEETS
SEE SHEET 2

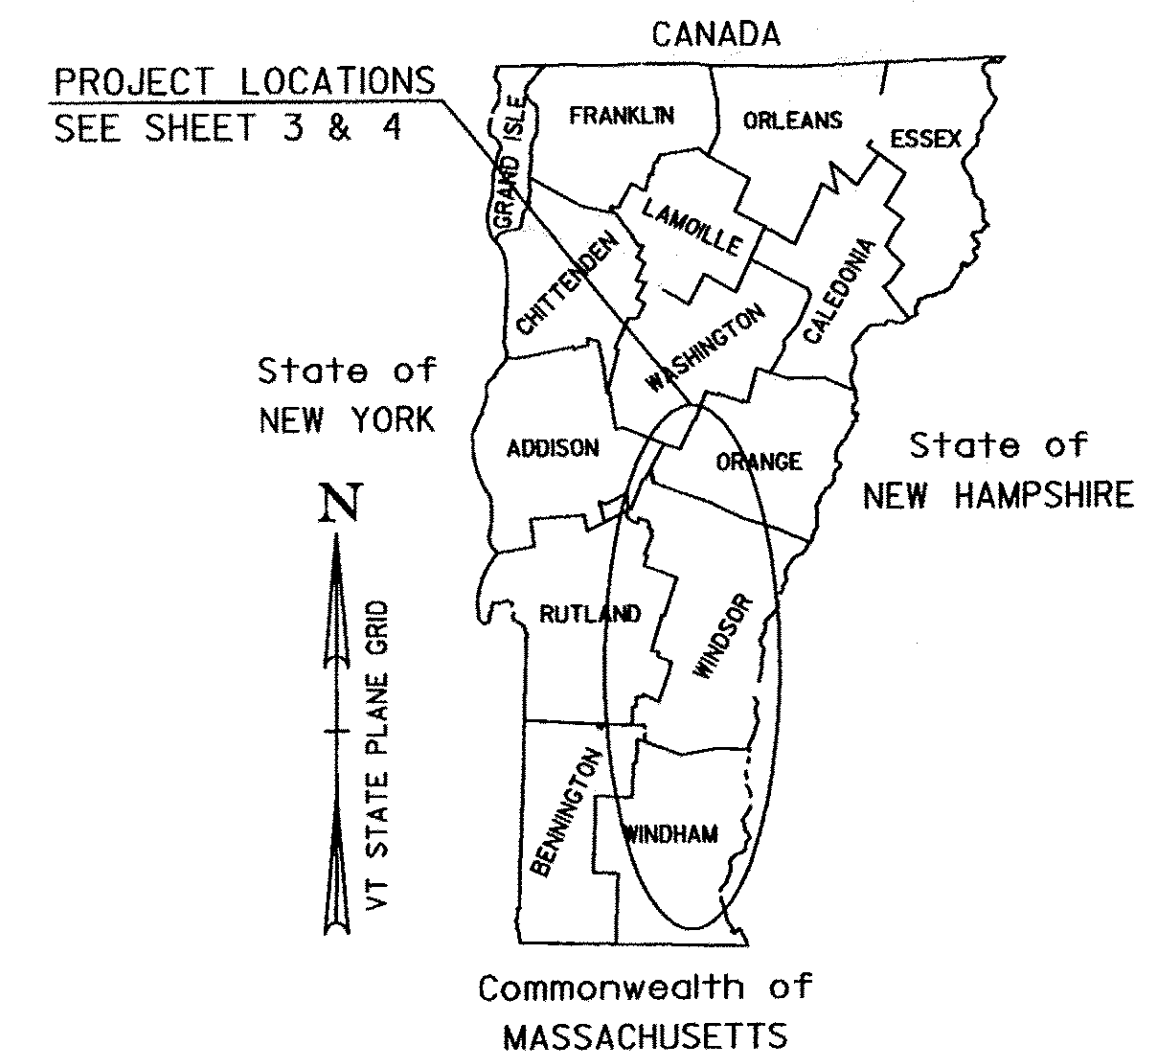

PROJECT DESCRIPTION: WORK TO BE PERFORMED UNDER THIS PROJECT INCLUDES THE REMOVAL OF EXISTING SIGNS & POSTS, AND GUARDRAIL, AND THE INSTALLATION OF NEW SIGNS & POSTS, PAVEMENT MARKINGS (CENTERLINE, EDGELINE, SYMBOLS AND LETTERS), GUARDRAIL AND OTHER RELATED ITEMS FOR THE DESCRIBED WORK.

PROJECT LOCATION:	TH	MM	DESCRIPTION
TH-10,	0.000 - 5.523,	HARTFORD (OLD RIVER ROAD)	
TH-15,	0.000 - 1.630,	NEWFANE (UPPER RIVER ROAD / RIVER ROAD)	
TH-12,	0.000 - 1.101,	NORWICH (TURNPIKE ROAD)	
TH-12,	0.000 - 0.097,	NORWICH (NEW BOSTON POST ROAD)	
TH-2,	4.894 - 5.283,	NORWICH (BEAVER MEADOW ROAD)	
TH-1,	0.000 - 3.500,	TOWNSHEND (GRAFTON ROAD)	
TH-1,	0.000 - 1.000,	TOWNSHEND (GRAFTON ROAD)	
TH-25,	0.000 - 0.100,	TOWNSHEND (EAST HILL ROAD)	
TH-2,	0.000 - 0.656,	WINDSOR (UNION STREET / ASCUTNEY STREET)	

PROJECT LENGTHS:	MILES	FEET
5.523	5.523	(29161.44 FT)
1.630	1.630	(8606.40 FT)
1.101	1.101	(5813.28 FT)
0.097	0.097	(512.16 FT)
0.389	0.389	(2053.92 FT)
3.500	3.500	(18480.00 FT)
1.000	1.000	(5280.00 FT)
0.100	0.100	(528.00 FT)
0.656	0.656	(3463.68 FT)
TOTAL LENGTH OF PROJECT:	13.996	(73898.88 FT)

RECORD PLANS	
CONTRACTOR:	F. R. LAFAYETTE, INC. - ESSEX JUNCTION, VT
RESIDENT ENGINEER:	MARK HAUGHWOUT
CONSTRUCTION BEGAN:	MAY 23, 2011
CONSTRUCTION COMPLETE:	JANUARY 23, 2012
RECORD PLANS BY:	M. HAUGHWOUT & J. HYDE
I HEREBY CERTIFY THAT ALL THE CONSTRUCTION REQUIRED BY THIS SET OF DRAWINGS HAS BEEN ACCOMPLISHED AS INDICATED HEREIN.	
BY:	<i>Mark Haughwout</i> RESIDENT ENGINEER
DATE:	1/30/13
NOTE: Any further information concerning final quantities, amounts or other details relative to this project may be found at Central Files in the electronic archives.	

QUALITY ASSURANCE PROGRAM: LEVEL

CONVENTIONAL SYMBOLS	
COUNTY LINE	
TOWN LINE	
LIMITS OF ACCESS	
POINT OF ACCESS	
FENCE LINE	
STONE WALL	
TRAVELED WAY	
GUARD RAIL	
RAILROAD	
SURVEY LINE	
CULVERT	
POWER POLE	
TELEPHONE POLE	
TREES	
CONTROL OF ACCESS	
PROPERTY LINE	
R.O.W. TAKING LINE	
SLOPE RIGHTS	
TOP OF CUT	
TOE OF SLOPE	

SURVEYED BY :	N/A
SURVEYED DATE :	N/A
DATUM	
VERTICAL	N/A
HORIZONTAL	N/A

THESE PLANS ARE SUBJECT TO SUCH ENGINEERING CHANGES AS MAY BE REQUIRED BY THE FEDERAL HIGHWAY ADMINISTRATION OR THE DIRECTOR OF PROGRAM DEVELOPMENT.
CONSTRUCTION IS TO BE CARRIED ON IN ACCORDANCE WITH THESE PLANS AND THE STANDARD SPECIFICATIONS FOR CONSTRUCTION DATED 2006, AS APPROVED BY THE FEDERAL HIGHWAY ADMINISTRATION ON JUNE 15, 2006 FOR USE ON THIS PROJECT, INCLUDING ALL SUBSEQUENT REVISIONS AND SUCH REVISED SPECIFICATIONS AND SPECIAL PROVISIONS AS ARE INCORPORATED IN THESE PLANS.

DIRECTOR OF PROGRAM DEVELOPMENT	
APPROVED: <i>Richard Tevaunt</i>	DATE: 6-4-10
PROJECT MANAGER :	JOSH SCHULTZ
PROJECT NAME :	STATEWIDE SOUTHEAST REGION
PROJECT NUMBER :	STP HRRR(6)
SHEET 1 OF 44 SHEETS	