








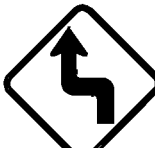





TRAFFIC SIGN SUMMARY SHEET 1 - HARTFORD

| DIRECTION | MILEMARKER, STATION, OR SIGN NUMBER | LOCATION | MANUAL ON UNIFORM TRAFFIC DEVICES OR STATE CODE | SIGN DIMENSIONS | | SHEETING REMARKS | SIGN LEGEND | NEW SIGNS | | EXISTING SIGNS | | | | EXISTING POST | | NO. OF NEW POSTS | SQUARE STEEL (In) | | | TUBULAR STEEL 0/(In) | | | | SIGN FRAME REQUIRED | REMARKS SHS = STANDARD HIGHWAY SIGN BOOK | SIGN DETAIL | | |
|--|-------------------------------------|----------|---|-----------------|--------|------------------|--|-------------|-----|----------------|--------------|------------|-----------|---------------|--------|------------------|-------------------|------|------|----------------------|------|------------------|---|---------------------|---|--|--|-----------------------|
| | | | | WIDTH | HEIGHT | | | "A" | "B" | RETAIN | SALVAGE FROM | SALVAGE TO | REMOVE | RETAIN | REMOVE | | lb/ft | | | lb/ft | | | | | | DETAIL IN SHS | DETAIL ON SHEET NUMBER | STANDARD SHEET NUMBER |
| | | | | | | | | | | | | | | | | | 1.75 | 2.00 | 2.50 | 3.00 | 3.50 | 4.00 | 5.00 | | | | | |
| SB | MM 0.016, LT | E/F | D3-I | 48 | 12 | | V.A. Cutoff Rd | 4.00 | | | | | | | | | | | | | | | INSTALL NEW SIGN ABOVE VA CUTOFF RD STREET NAME SIGN ON SAME POST AS STOP SIGN | | 8 | | | |
| | | G/H | D3-I | 42 | 12 | | Old River Rd | 3.50 | | | | | | | | | | | | | | | INSTALL NEW SIGN ABOVE STOP SIGN ON SAME POST | | 8 | | | |
| | | F | RI-I | 30 | 30 | |  | 6.25 | | | | | X | X | I | | X | | | | | | REMOVE SIGN AND POST AND INSTALL NEW SIGN AND POST AT THE SAME LOCATION | X | | | | |
| NB | MM 0.024, RT | A | VR-017 | 24 | 30 | |  | 5.00 | | | | | | | | | X | | | | | OLD SIGN REMOVED | INSTALL NEW SIGN AND POST 127 FT NORTH OF INTERSECTION WITH VA CUTOFF RD ON THE RIGHT SHOULDER FOR NORTHBOUND TRAFFIC | | 7 | | | |
| | | A | R2-I | 24 | 30 | |  | 5.00 | | | | | | | | | | | | | | | INSTALL NEW SIGN BENEATH LEGAL LOAD LIMIT SIGN ON SAME POST | X | | | | |
| NB | MM 0.050, RT | A | R2-I | 24 | 30 | |  | | | | | | X | X | | | | | | | | | REMOVE SIGN AND POST | | | | | |
| NB | MM 0.520, RT | A | R2-I | 24 | 30 | |  | | | | | | X | X | | | | | | | | | REMOVE SIGN AND POST | | | | | |
| | | A | WI-3 L | 30 | 30 | |  | 6.25 | | | | | | | | | X | | | | | | INSTALL NEW SIGN AND POST 16 FT SOUTH OF POLE WITH NO NUMBER AT CORNER OF FENCE | X | | | | |
| | | A | WI3-I | 18 | 18 | |  | 2.25 | | | | | | | | | | | | | | | INSTALL NEW SIGN PLAQUE BENEATH LEFT REVERSE TURN SIGN | X | | | | |
| NB | MM 0.570 0.559, RT | A | W10-I | 30 | 30 | |  | 4.91 | | | | | | | | | X | | | | | | INSTALL NEW SIGN AND POST 48' NORTH DIRECTLY SOUTH OF POLE* 3 DUE TO OPEN PARKING LOT | X | | | | |
| SB | MM 0.651 0.660, LT | F | W10-I | 30 | 30 | |  | 4.91 | | | | | | | | | X | | | | | | INSTALL NEW SIGN AND POST 21.69 FT NORTH OF POLE* 53-30/119240/225 | X | | | | |
| SB | MM 0.692, LT | F | WI-3 R L | 30 | 30 | |  | 6.25 | | | | | | | | | X | | | | | | INSTALL NEW SIGN AND POST 48 FT NORTH OF AND ACROSS FROM POLE* 23 | X | | | | |
| | | F | WI3-I | 18 | 18 | |  | 2.25 | | | | | | | | | | | | | | | INSTALL NEW SIGN PLAQUE BENEATH LEFT REVERSE TURN SIGN | X | | | | |
| SB | MM 0.732, LT | F | TOWN SIGN | 30 | 30 | |  | | | | | | X | X | | | | | | | | | REMOVE SIGN AND POST | | | | | |
| SB | MM 1.164, LT | F | R2-I | 24 | 30 | |  | 5.00 | | | | | X | X | I | | X | | | | | | INSTALL NEW SIGN AND POST 106 FT SOUTH OF AND ACROSS FROM POLE* 65/142/34 | X | | | | |
| FINAL POST LENGTHS ARE TO BE DETERMINED IN THE FIELD. POST SIZES ARE COMPUTED BASED ON INFORMATION FURNISHED ON THE STANDARD SHEETS AND THE VTRANS "SIGN POST DESIGN GUIDE". | | | SHEET SUBTOTALS | | | | | | | | SF 55.57 | SF | EA 5-8 | EA 5 | EA 7 | FT 105 | EA | LB | | | | | | | | | | | PROJECT NAME: STATEWIDE SOUTHEAST REGION PROJECT NUMBER: STP HRRR(6) FILE NAME: I0K020_wrk.dgn PROJECT LEADER: JLS DESIGNED BY: NLA HARTFORD TRAFFIC SIGN SUMMARY I | PLOT DATE: 04-JUN-2010 DRAWN BY: ITS CHECKED BY: JLS SHEET II OF 44 | |