






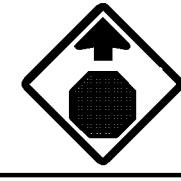


TRAFFIC SIGN SUMMARY SHEET 5 - HARTFORD

DIRECTION	MILEMARKER, STATION, OR SIGN NUMBER	LOCATION	MANUAL ON UNIFORM TRAFFIC DEVICES OR STATE CODE	SIGN DIMENSIONS		SHEETING REMARKS	SIGN LEGEND	NEW SIGNS		EXISTING SIGNS				EXISTING POST	NO. OF NEW POSTS	SQUARE STEEL (In)			TUBULAR STEEL 0/(In)				SIGN FRAME REQUIRED	REMARKS	SIGN DETAIL								
				WIDTH	HEIGHT			"A"	"B"	RETAIN	SALVAGE FROM	SALVAGE TO	REMOVE			RETAIN	REMOVE	1.75	2.00	2.50	FOUNDATION	3.00			3.50	4.00	5.00	DETAIL IN SHS	DETAIL ON SHEET NUMBER	STANDARD SHEET NUMBER			
																		lb/ft				lb/ft											
NB	MM 5.450, RT	A	W3-I	36	36			9.00															395438	INSTALL NEW SIGN ON 2-POSTS 185 FT SOUTH OF THE INTERSECTION WITH QUECHEE-W HARTFORD RD ON RIGHT SIDE OF OLD RIVER ROAD APPROACHING THE INTERSECTION	X								
SB	MM 5.488, LT	F	R2-I	24	30			5.00					X	X										INSTALL NEW SIGN AND POST 185 FT SOUTH OF THE INTERSECTION WITH QUECHEE - W HARTFORD RD ON LEFT SIDE OF OLD RIVER ROAD LEAVING THE INTERSECTION	X								
SB	MM 5.510, LT	G/H	D3-I	36	6																			REMOVE SIGN AND POST			8						
SB	MM 5.510, LT	G/H	D3-I	42	12			3.50 +3.50																INSTALL NEW SIGN ABOVE STOP SIGN ON SAME POST			8						
		E	RI-I	30	30			6.25						X	X									INSTALL NEW SIGN AND POST 69 FT SOUTH OF THE INTERSECTION WITH QUECHEE-WEST HARTFORD RD ON LEFT SIDE OF OLD RIVER ROAD LEAVING THE INTERSECTION ACROSS FROM STOP SIGN IN A POSITION	X								
NB	MM 5.511, RT	A	RI-I	30	30			6.25							X									INSTALL NEW SIGN AND POST 63 FT SOUTH OF THE INTERSECTION WITH QUECHEE-WEST HARTFORD RD ON RIGHT SIDE OF OLD RIVER ROAD APPROACHING THE INTERSECTION	X								
NB	MM 5.523, RT	A	RI-I	30	30									X	X									REMOVE SIGN AND POST INSTALLED INCORRECTLY ACROSS THE INTERSECTION FROM THE OLD RIVER ROAD INTERSECTION	X								
NB	MM 5.523, RT	A	WI-7	48	24			8.00																INSTALL NEW SIGN ON 2-POSTS DIRECTLY ACROSS FROM OLD RIVER ROAD INTERSECTION CENTERED WITH APPROACHING TRAFFIC	X								
							<p style="color: red; font-size: small;">* DURING A FIELD REVIEW BY N. AVERY, PROJECT MANAGER, THIS NEW SIGN WAS FOUND TO BE MISSING. IT WAS REPLACED ON 11-9-11 BY THE CONTRACTOR. THIS SIGN WAS STOLEN SO IT HAD TO BE REPLACED.</p>																										
<p style="font-size: small;">FINAL POST LENGTHS ARE TO BE DETERMINED IN THE FIELD. POST SIZES ARE COMPUTED BASED ON INFORMATION FURNISHED ON THE STANDARD SHEETS AND THE VTRANS "SIGN POST DESIGN GUIDE".</p>																																	
SHEET SUBTOTALS								SF 41.50 38.00	SF	EA 3	EA 3	EA 3	EA 3	EA 3	EA 3	EA 3	EA 7	EA	FT 105	FT 105	EA	LB	LB	LB	LB								

PROJECT NAME: STATEWIDE SOUTHEAST REGION
 PROJECT NUMBER: STP HRRR(6)
 FILE NAME: I0K020_wrk.dgn
 PROJECT LEADER: JLS
 DESIGNED BY: NLA
 HARTFORD TRAFFIC SIGN SUMMARY 5

PLOT DATE: 04-JUN-2010
 DRAWN BY: ITS
 CHECKED BY: JLS
 SHEET 15 OF 44