







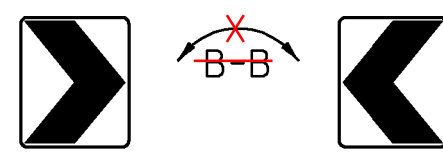


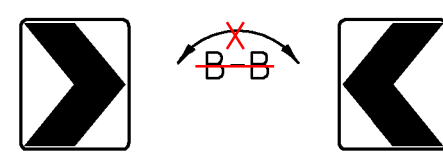





TRAFFIC SIGN SUMMARY SHEET 3 - TOWNSHEND

DIRECTION	MILEMARKER, STATION, OR SIGN NUMBER	LOCATION	MANUAL ON UNIFORM TRAFFIC DEVICES OR STATE CODE	SIGN DIMENSIONS		SHEETING REMARKS	SIGN LEGEND	NEW SIGNS		EXISTING SIGNS				EXISTING POST		NO. OF NEW POSTS	SQUARE STEEL (In)			TUBULAR STEEL (In)				SIGN FRAME REQUIRED	REMARKS <small>SHS = STANDARD HIGHWAY SIGN BOOK</small>	SIGN DETAIL															
				WIDTH	HEIGHT			"A"	"B"	RETAIN	SALVAGE FROM	SALVAGE TO	REMOVE	RETAIN	REMOVE		FOUNDA-TION	3.00		3.50		4.00				5.00		DETAIL IN SHS	DETAIL ON SHEET NUMBER	STANDARD SHEET NUMBER											
																		lb/ft	lb/ft	lb/ft	lb/ft	lb/ft	lb/ft			lb/ft	lb/ft														
NB	MM 1.218 1.380 , RT	A	WII-2	30	30	F-Y-G		6.25								1	X							INSTALL NEW SIGN AND POST ^{798'} ACROSS SOUTH OF FROM POLE #3/749	X																
		A	WII-2PB	24	18	F-Y-G		3.00																INSTALL NEW SIGN BELOW THE NEW WII-2	X																
SB	MM 1.599, LT	H	RI-I	30	30			6.25					X	X			X							REMOVE SIGN AND POST AND INSTALL NEW SIGN AND POST AT SAME LOCATION	X																
		E/F	D3-I	48	12			4.00					X											INSTALL ABOVE THE STOP SIGN			10														
SB	MM 1.605, LT	F	TOWN SIGN	30	30								X	X										REMOVE SIGN AND POST																	
SB	MM 1.946, LT	H	RI-I	30	30			6.25					X	X			X							REMOVE SIGN AND POST AND INSTALL NEW SIGN AND POST AT SAME LOCATION	X																
NB	MM 2.144, RT	A	WI-10L	36	36			9.00								2	X							INSTALL NEW SIGN AND POST ^{22'} SOUTH OF FROM POLE #NET/3/729	X																
		A	WI6-8P	30	8			1.67																INSTALL NEW SIGN BENEATH THE HORIZONTAL ALIGNMENT WARNING SIGN AT THE CORRECT SIGN HEIGHT			10														
NB	MM 2.206, RT	A B	WI-8 R WI-8 L	18 18	24 24			3.00 3.00								2 +	X							INSTALL BACK-TO-BACK ON A SIGN BRACKET ON A SINGLE POST ^{SEPARATE} SOUTH OF POLE* NET/5/70/3/727	X X																
SB	MM 2.212, LT	F	WII-2	30	30	F-Y-G		6.25								1	X							INSTALL NEW SIGN AND POST ACROSS FROM POLE #NET/5/70/3/727	X																
		F	WII-2PB	24	18	F-Y-G		3.00																INSTALL NEW SIGN BENEATH PEDESTRIAN SYMBOL WARNING SIGN ON THE SAME POST	X																
NB	MM 2.222, RT	A B	WI-8 R WI-8 L	18 18	24 24			3.00 3.00								2 +	X							INSTALL NEW SIGN BACK-TO-BACK ON A BRACKET AND A SINGLE POST ^{SEPARATE} 60 FT NORTH OF POLE* NET/5/70/3/727	X X																
NB	MM 2.248, RT	A	WI-6L	48	24			8.00								2	X							INSTALL NEW SIGN AND POSTS ON THE NORTH SIDE OF EAST HILL RD, IN LINE WITH THE NORTHBOUND DRIVERS' LINE OF SIGHT	X																
NB	MM 2.250, RT	A/B	D3-I	42	12			3.50					X	X			X							INSTALL NEW SIGN ABOVE STOP SIGN ON SAME POST			10														
		D	RI-I	30	30			6.25																INSTALL NEW STOP 36 FT SOUTH OF POLE* NET/5/71/3/76	X																
FINAL POST LENGTHS ARE TO BE DETERMINED IN THE FIELD. POST SIZES ARE COMPUTED BASED ON INFORMATION FURNISHED ON THE STANDARD SHEETS AND THE VTRANS "SIGN POST DESIGN GUIDE".																																									
SHEET SUBTOTALS								SF 75.42	SF	EA 5	EA 4	EA II	FT 165	EA	LB																										
																						PROJECT NAME: STATEWIDE SOUTHEAST REGION		PROJECT NUMBER: STP HRRR(6)		FILE NAME: I0K020_wrk.dgn		PLOT DATE: 04-JUN-2010		PROJECT LEADER: JLS		DRAWN BY: ITS		DESIGNED BY: NLA		CHECKED BY: JLS		TOWNSHEND TRAFFIC SIGN SUMMARY 3		SHEET 31 OF 44	