


# STATE OF VERMONT AGENCY OF TRANSPORTATION



## PROPOSED IMPROVEMENT TOWNS OF ARLINGTON, BRIDPORT, CASTLETON, KILLINGTON, MANCHESTER, POULTNEY, POWNAL, RUPERT AND SUNDERLAND COUNTIES OF ADDISON, RUTLAND AND BENNINGTON VARIOUS TOWN HIGHWAYS

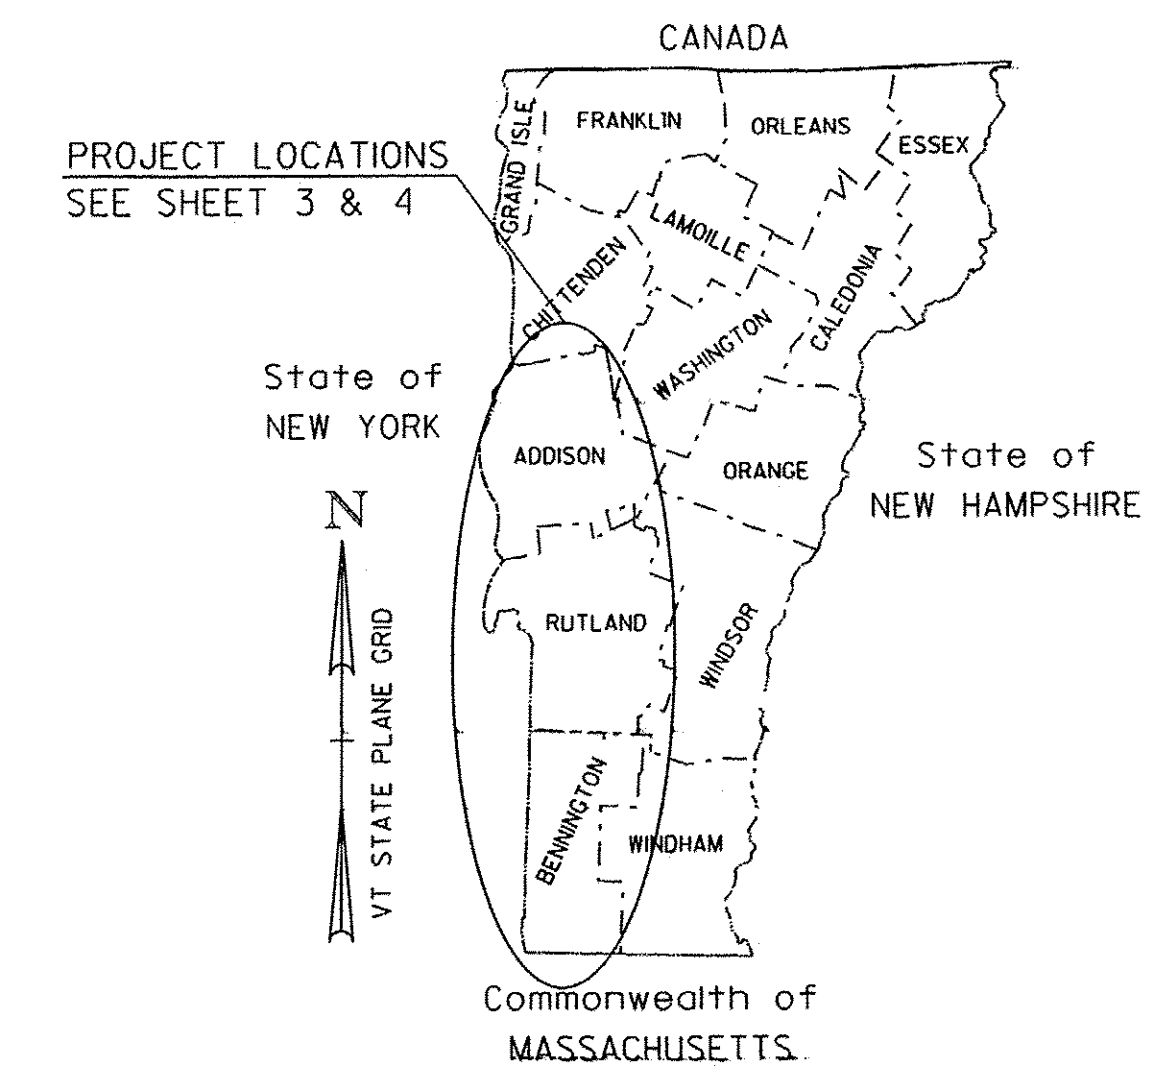

INDEX OF SHEETS  
SEE SHEET 2

RECORD PLANS	
CONTRACTOR:	F. R. LAFAYETTE, INC. - ESSEX JUNCTION, VT
RESIDENT ENGINEER:	ERIC FOSTER
CONSTRUCTION BEGAN:	MAY 02, 2011
CONSTRUCTION COMPLETE:	JUNE 16, 2011
RECORD PLANS BY:	ERIC FOSTER & JENNA HYDE
I HEREBY CERTIFY THAT ALL THE CONSTRUCTION REQUIRED BY THIS SET OF DRAWINGS HAS BEEN ACCOMPLISHED AS INDICATED HEREIN.	
BY <u>Eric Foster</u>	RESIDENT ENGINEER
DATE <u>1/10/13</u>	
NOTE: Any further information concerning final quantities, amounts or other details relative to this project may be found at Central Files in the electronic archives.	

PROJECT DESCRIPTION: WORK TO BE PERFORMED UNDER THIS PROJECT INCLUDES THE REMOVAL OF EXISTING SIGNS & POSTS, AND EXISTING GUARDRAIL AND THE INSTALLATION OF NEW SIGNS & SIGN POSTS, PAVEMENT MARKINGS (CENTERLINE, EDGELINE, SYMBOLS AND LETTERS), GUARDRAIL, AND OTHER RELATED ITEMS FOR THE DESCRIBED WORK.

PROJECT LOCATION:	PROJECT LENGTHS:
TH-8, MM 0.000 - 0.953, ARLINGTON (OLD WEST ROAD)	0.953 MILES (5031.84 FT)
TH-1, MM 0.195 - 1.825, BRIDPORT (CROWN POINT ROAD)	1.630 MILES (8606.40 FT)
VT ROUTE 4A, MM 3.135 - 3.352, CASTLETON (VT ROUTE 4A)	0.217 MILES (1145.76 FT)
TH-5, MM 0.000 - 0.193, CASTLETON (NORTH STREET)	0.193 MILES (1019.04 FT)
TH-4, MM 0.000 - 0.077, CASTLETON (SOUTH STREET)	0.077 MILES (406.56 FT)
TH-2, MM 0.000 - 3.077, KILLINGTON (KILLINGTON ACCESS ROAD)	3.077 MILES (16246.56 FT)
TH-10, MM 0.000 - 0.234, MANCHESTER (BARNUMVILLE ROAD)	0.234 MILES (1235.52 FT)
TH-6, MM 0.070 - 0.165, POULTNEY (DEPOT STREET/ YORK STREET TH-5)	0.095 MILES (501.60 FT)
TH-8, MM 0.172 - 0.241, POULTNEY (CHURCH STREET)	0.069 MILES (364.32 FT)
TH-2, MM 0.000 - 2.866, POWNAL (NORTH POWNAL ROAD)	2.866 MILES (15132.48 FT)
TH-1, MM 0.000 - 7.068, RUPERT (STATE NUMBER TOWN HIGHWAY 153)	7.068 MILES (37319.04 FT)
TH-2, MM 0.000 - 4.963, SUNDERLAND (SUNDERLAND HILL ROAD)	4.963 MILES (26204.64 FT)
	<b>TOTAL LENGTH OF PROJECT:</b> 21.442 MILES (113213.76 FT)

CONVENTIONAL SYMBOLS	
COUNTY LINE	
TOWN LINE	
LIMITS OF ACCESS	
POINT OF ACCESS	
FENCE LINE	
STONE WALL	
TRAVELED WAY	
GUARD RAIL	
RAILROAD	
SURVEY LINE	
CULVERT	
POWER POLE	
TELEPHONE POLE	
TREES	
CONTROL OF ACCESS	
PROPERTY LINE	
R.O.W. TAKING LINE	
SLOPE RIGHTS	
TOP OF CUT	
TOE OF SLOPE	

SURVEYED BY :	N/A
SURVEYED DATE :	N/A
DATUM	
VERTICAL	N/A
HORIZONTAL	N/A

THESE PLANS ARE SUBJECT TO SUCH ENGINEERING CHANGES AS MAY BE REQUIRED BY THE FEDERAL HIGHWAY ADMINISTRATION OR THE DIRECTOR OF PROGRAM DEVELOPMENT.  
CONSTRUCTION IS TO BE CARRIED ON IN ACCORDANCE WITH THESE PLANS AND THE STANDARD SPECIFICATIONS FOR CONSTRUCTION DATED 2006, AS APPROVED BY THE FEDERAL HIGHWAY ADMINISTRATION ON JUNE 15, 2006 FOR USE ON THIS PROJECT, INCLUDING ALL SUBSEQUENT REVISIONS AND SUCH REVISED SPECIFICATIONS AND SPECIAL PROVISIONS AS ARE INCORPORATED IN THESE PLANS.

DIRECTOR OF PROGRAM DEVELOPMENT	
APPROVED <u>Richard Schultz</u>	DATE <u>5-5-10</u>
PROJECT MANAGER :	JOSH SCHULTZ
PROJECT NAME :	STATEWIDE SOUTHWEST REGION
PROJECT NUMBER :	STP HRRR(7)
SHEET	1 OF 78 SHEETS