


SHEET NUMBER	DESCRIPTION	SHEET
1	TITLE SHEET	-
2-3	NOTES AND DETAILS SHEETS	NDS-1 TO NDS-2
4	QUANTITY SHEET	QTY-1
5	BARRE LAYOUT SHEET	LS-1
6	BURLINGTON LAYOUT SHEET	LS-2
7	MORETOWN LAYOUT SHEET	LS-3
8	NORTHFIELD LAYOUT SHEET	LS-4
9	POULTNEY WEST LAYOUT SHEET	LS-5
10	POULTNEY EAST LAYOUT SHEET	LS-6
11	RICHMOND LAYOUT SHEET	LS-7
12	RUTLAND LAYOUT SHEET	LS-8
13-17	RUTLAND DETAIL SHEETS	D-1 TO D-5
18	WAITSFIELD LAYOUT SHEET	LS-9
19	WARREN LAYOUT SHEET	LS-10
20	WEATHERSFIELD LAYOUT SHEET	LS-11
21-35	TRAFFIC SIGN SUMMARY SHEETS	TSS-1 TO TSS-15


STATE OF VERMONT AGENCY OF TRANSPORTATION

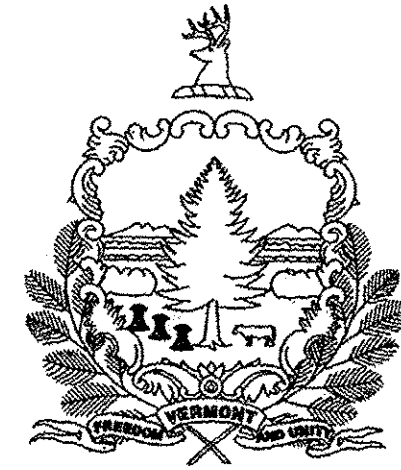

STATEWIDE SAFETY IMPROVEMENTS 2010 SELECTED SMALL-SCALE SAFE ROUTES TO SCHOOL PROJECTS STP SRIN (25)

THIS OVERALL PROJECT CONSISTS OF SAFETY IMPROVEMENTS LOCATED IN VARIOUS SCHOOL ZONES AROUND THE STATE AND INCLUDES A MIX OF BOTH LOCAL ROADS AND TOWN HIGHWAYS. IMPROVEMENTS INCLUDE CONVENTIONAL SIGNS, FLASHING BEACONS, RADAR SPEED FEEDBACK SIGNS (RSFS), PAVEMENT MARKINGS, GRANITE CURBING AND SIDEWALK RAMPS.

SCHOOL LOCATIONS IN CHITTENDEN COUNTY ARE CHAMPLAIN ELEMENTARY, CAMELS HUMP MIDDLE SCHOOL AND RICHMOND ELEMENTARY SCHOOL; WASHINGTON COUNTY LOCATIONS ARE MORETOWN ELEMENTARY SCHOOL, WAITSFIELD ELEMENTARY, WARREN SCHOOL, BARRE TOWN ELEMENTARY AND NORTHFIELD ELEMENTARY; LOCATIONS IN RUTLAND COUNTY ARE POULTNEY JR/SR. HIGH SCHOOL, POULTNEY ELEMENTARY SCHOOL, RUTLAND MIDDLE SCHOOL AND RUTLAND ELEMENTARY; THE WINDSOR COUNTY LOCATION IS WEATHERSFIELD ELEMENTARY.

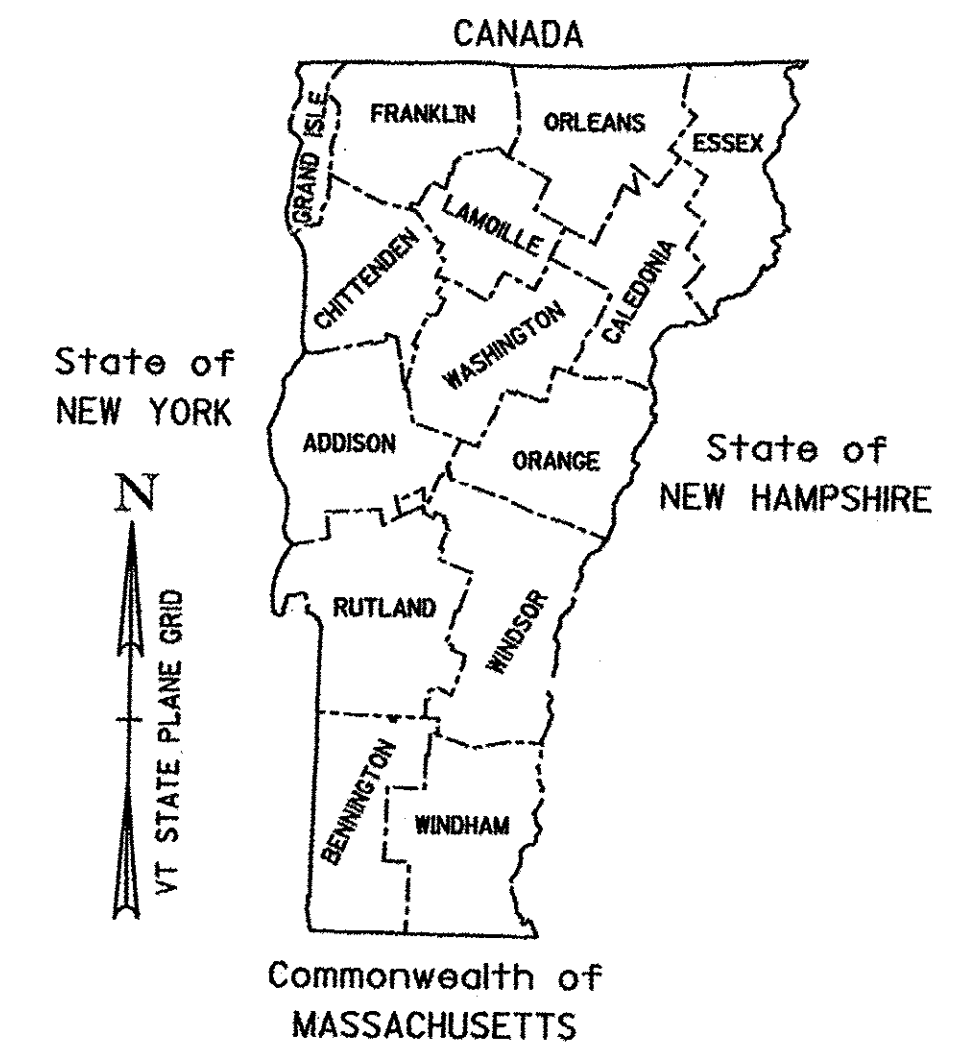

VTRANS STANDARDS FOR CONSTRUCTION

C-2A	PORTLAND CEMENT CONCRETE SIDEWALK DRIVE ENTRANCES WITH SIDEWALK ADJACENT TO CURB	10/14/05
C-3A	SIDEWALK RAMPS	03/10/08
C-3B	SIDEWALK RAMPS AND MEDIAN ISLANDS	03/10/08
C-10	CURBING	02/11/08
E-100	CONSTRUCTION APPROACH SIGNS	01/02/04
E-100A	SIDE ROAD CONSTRUCTION - APPROACH SIGNS	01/02/04
E-108	CONSTRUCTION ZONE LONGITUDINAL DROP OFFS	06/08/09
E-111	MINOR MAINTENANCE OPERATIONS	03/11/97
E-120	STANDARD SIGN PLACEMENT - EXPRESSWAY & FREEWAY	08/08/95
E-121	STANDARD SIGN PLACEMENT - CONVENTIONAL ROAD	08/08/95
E-163	TUBULAR STEEL SIGN POST	05/20/99
E-164	SQUARE STEEL SIGN POST	06/08/09
E-175	POWER DROP STANCHIONS	06/08/09

RECORD PLANS

CONTRACTOR: J. HUTCHINS, INC. - RICHMOND, VT

RESIDENT ENGINEER: JEFF COTA

CONSTRUCTION BEGAN: JUNE 27, 2013

CONSTRUCTION COMPLETE: AUGUST 23, 2013


RECORD PLANS BY: JEFF COTA & JENNA HYDE

I HEREBY CERTIFY THAT ALL THE CONSTRUCTION REQUIRED BY THIS SET OF DRAWINGS HAS BEEN ACCOMPLISHED AS INDICATED HEREIN.

BY: RESIDENT ENGINEER

DATE: 11/7/16

NOTE: Any further information concerning final quantities, amounts or other details relative to this project may be found at Central Files in the electronic archives.

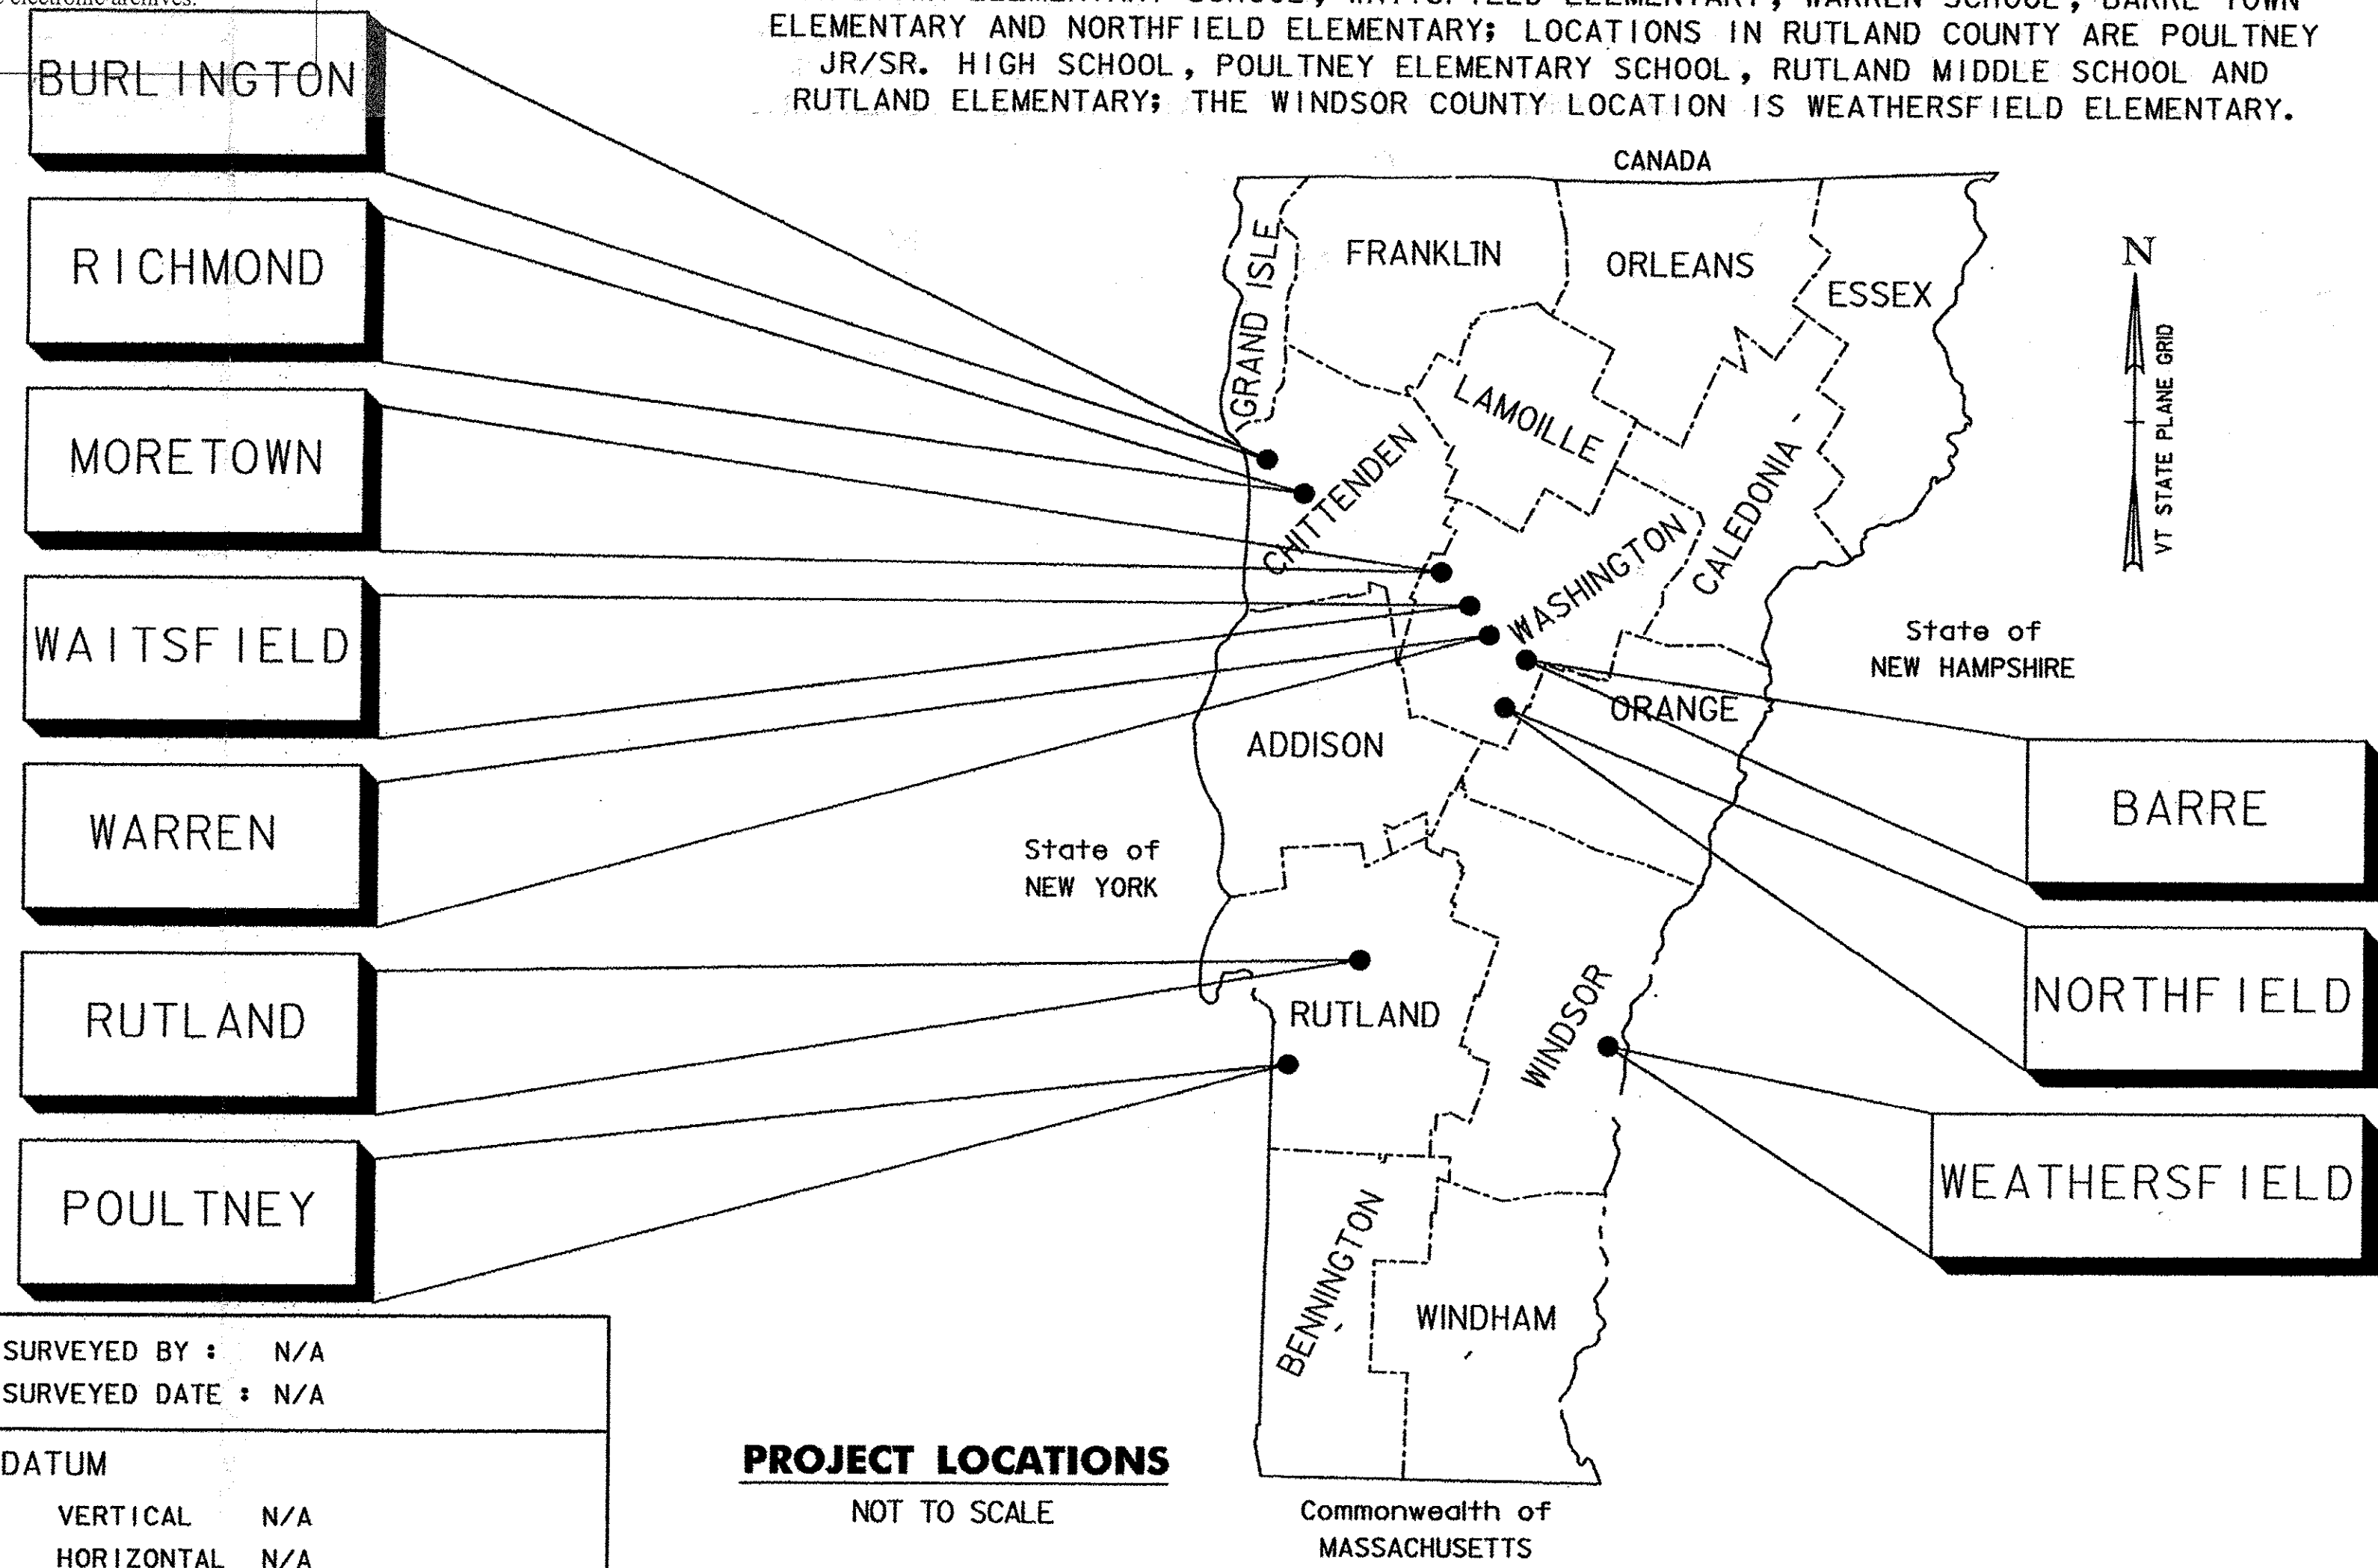

QUALITY ASSURANCE PROGRAM: LEVEL 3

CONVENTIONAL SYMBOLS

COUNTY LINE	
TOWN LINE	
LIMITS OF ACCESS	
POINT OF ACCESS	
FENCE LINE	
STONE WALL	
TRAVELED WAY	
GUARD RAIL	
RAILROAD	
SURVEY LINE	
CULVERT	
POWER POLE	
TELEPHONE POLE	
TREES	
CONTROL OF ACCESS	
PROPERTY LINE	
R.O.W. TAKING LINE	
SLOPE RIGHTS	
TOP OF CUT	
TOE OF SLOPE	

SURVEYED BY: N/A

SURVEYED DATE: N/A

DATUM

VERTICAL: N/A

HORIZONTAL: N/A


PROJECT LOCATIONS

NOT TO SCALE



THESE PLANS ARE SUBJECT TO SUCH ENGINEERING CHANGES AS MAY BE REQUIRED BY THE FEDERAL HIGHWAY ADMINISTRATION OR THE DIRECTOR OF PROGRAM DEVELOPMENT.

CONSTRUCTION IS TO BE CARRIED ON IN ACCORDANCE WITH THESE PLANS AND THE STANDARD SPECIFICATIONS FOR CONSTRUCTION DATED 2011, AS APPROVED BY THE FEDERAL HIGHWAY ADMINISTRATION ON JULY 20, 2011 FOR USE ON THIS PROJECT, INCLUDING ALL SUBSEQUENT REVISIONS AND SUCH REVISED SPECIFICATIONS AND SPECIAL PROVISIONS AS ARE INCORPORATED IN THESE PLANS.

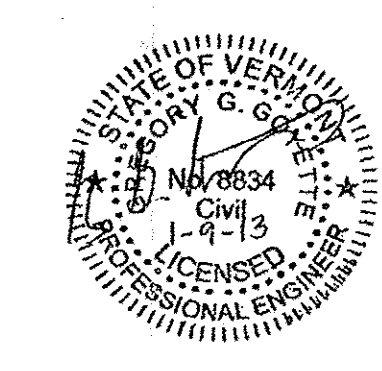

DIRECTOR OF PROGRAM DEVELOPMENT

APPROVED: DATE: 1-9-13

PROJECT MANAGER: JON KAPLAN, P.E.

PROJECT NAME: STATEWIDE SRIS PROJECTS

PROJECT NUMBER: STP SRIN (25)

SHEET 1 OF 35 SHEETS