


SIGN NUMBER	SIGN LEGEND	SIGN ACTIVITY	COMMENTS
1		RET RET	RETAIN SIGNS, POST AND FLASHING BEACON
2		R R&S, S R&S, S	REMOVE "SPEED LIMIT 30" SIGN RETAIN "NO PARKING" AND "BEGIN" SIGNS. RETAINED SIGNS TO BE MOVED UP TO THE TOP OF THE EXISTING POST.
3		RET RET	RETAIN SIGNS AND POST
4		RET RET	RETAIN SIGNS AND POST
5		R R&S, S R&S, S	REMOVE "SPEED LIMIT 30" SIGN RETAIN "NO PARKING" AND "BEGIN" SIGNS. RETAINED SIGNS TO BE MOVED UP TO THE TOP OF THE EXISTING POST.
6		RET RET	RETAIN SIGNS, POST AND FLASHING BEACON
7		N N	NEW SIGN ON A NEW POST LOCATED 100' NORTH OF EXISTING SIGN #2. NEW SOLAR-POWERED RSFS ASSEMBLY
8		N N	NEW SIGN ON A NEW POST LOCATED 100' NORTH OF EXISTING SIGN #5. NEW SOLAR-POWERED RSFS ASSEMBLY

NOTES:
 1. ALL OTHER SIGNS NOT SHOWN ARE TO REMAIN.
 2. SEE NOTES SHEET NDS-1 AND TRAFFIC SIGN SUMMARY SHEETS FOR ADDITIONAL INFORMATION.
 3. ROW WIDTH OF ROUTE 100B IS 49.5'.
 4. CLEAR ZONE ALONG VT ROUTE 100B IS 3 FEET.
 5. ALL SIGNS SHALL BE INSTALLED ON THE BACK SIDE OF THE EXISTING SIDEWALK

LEGEND		SIGN ACTIVITY	
1	PROPOSED SIGN	N	= NEW
2	EXISTING SIGN	R	= REMOVE
		R&S	= REMOVE & SALVAGE
		S	= SALVAGE SIGN
		RET	= RETAIN
		B-B	= BACK TO BACK

ITEM 675.50 REMOVING SIGNS
 AS SHOWN - ~~6~~ 4+2 (EX. FLASHING BEACONS)

ITEM 675.60 ERECTING SALVAGED SIGNS
 AS SHOWN - ~~4~~ 2+4 (RELOCATE SIGNS FROM FLASHING BEACONS)

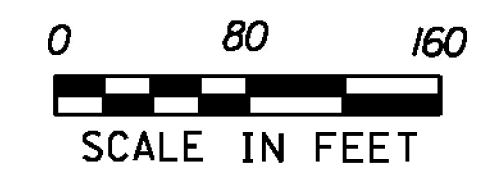

MORETOWN	
PROJECT NAME:	STATEWIDE SRTS PROJECTS
PROJECT NUMBER:	STP SRIN(25)
FILE NAME:	...\\Plotfiles\07 Moretown.dgn
PROJECT LEADER:	G. GOYETTE
DESIGNED BY:	K. RICHARDSON
MORETOWN LS-3	
PLOT DATE:	12/28/2012
DRAWN BY:	K. RICHARDSON
CHECKED BY:	G. GOYETTE
SHEET	7 OF 35