

SIGN NUMBER	SIGN LEGEND	SIGN ACTIVITY	COMMENTS
1		R&S	REMOVE AND SALVAGE SIGN
2		N	NEW SOLAR POWERED FLASHING BEACON WITH BREAKAWAY BASE.
		S	MOUNT SALVAGED SIGN FROM SIGN #1 ON A NEW POSTS LOCATED 10' SOUTH OF EXISTING UTILITY POLE
		N	NEW SOLAR POWERED FLASHING BEACON WITH BREAKAWAY BASE.
		S	MOUNT SALVAGED SIGN FROM SIGN #4 ON A NEW POSTS LOCATED 10' NORTH OF EXISTING UTILITY POLE
		N	NEW SOLAR POWERED FLASHING BEACON WITH BREAKAWAY BASE.
3		N	NEW SOLAR POWERED FLASHING BEACON WITH BREAKAWAY BASE.
		S	MOUNT SALVAGED SIGN FROM SIGN #4 ON A NEW POSTS LOCATED 10' NORTH OF EXISTING UTILITY POLE
4		R&S	REMOVE AND SALVAGE "SCHOOL ZONE" SIGN. RETAIN "POSTED BRIDGE" SIGN AND POSTS. MOVE "POSTED BRIDGE" SIGN TO THE TOP OF THE EXISTING POSTS.
		R&S, S	RETAIN "POSTED BRIDGE" SIGN AND POSTS. MOVE "POSTED BRIDGE" SIGN TO THE TOP OF THE EXISTING POSTS. DOES NOT EXIST
5		R	REMOVE SIGNS AND POST.
		R	REMOVE SIGNS AND POST.
6		N	NEW SIGN ON A NEW POST AT THE SAME LOCATION AS REMOVED SIGN #5.
		N	NEW SOLAR-POWERED RSFS ASSEMBLY WITH BREAKAWAY BASE.

- NOTES:
- ALL OTHER SIGNS NOT SHOWN ARE TO REMAIN.
 - SEE NOTES SHEET NDS-1 AND TRAFFIC SIGN SUMMARY SHEETS FOR ADDITIONAL INFORMATION.
 - ROW WIDTH OF JERICHO ROAD NORTH OF I-89 IS 115.5', AND SOUTH OF I-89 IS 49.5'.

SIGN ACTIVITY


- N = NEW
- R = REMOVE
- R&S = REMOVE & SALVAGE
- S = SALVAGE SIGN
- RET = RETAIN
- B-B = BACK TO BACK

LEGEND

- PROPOSED SIGN
- EXISTING SIGN

ITEM 675.50 REMOVING SIGNS
AS SHOWN - 5-1

ITEM 675.60 ERECTING SALVAGED SIGNS
AS SHOWN - 3-1

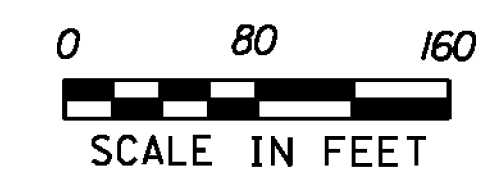

RICHMOND

PROJECT NAME: STATEWIDE SRTS PROJECTS

PROJECT NUMBER: STP SRIN(25)

FILE NAME: ...Plotfiles\Richmond.dgn

PROJECT LEADER: G. GOYETTE

DESIGNED BY: K. RICHARDSON

RICHMOND LS-7

PLOT DATE: 12/28/2012

DRAWN BY: K. RICHARDSON

CHECKED BY: G. GOYETTE

SHEET 11 OF 35