


SIGN NUMBER	SIGN LEGEND	SIGN ACTIVITY	COMMENTS
1		R R	REMOVE SIGNS AND POSTS
2		N N	NEW SIGN AND POSTS LOCATED AT THE SAME LOCATION AS REMOVED SIGN #3 NEW SOLAR-POWERED RSFS ASSEMBLY WITH BREAKAWAY BASE. NOTE SIZE OF RSFS DISPLAY ON SHEET TSS-12.
3		R	REMOVE SIGN AND POST
4		N N	NEW SIGNS AND POSTS AT THE SAME LOCATION AS REMOVED SIGN #1
5		R R	REMOVE SIGNS AND POSTS
6		N N	NEW SIGN AND POSTS LOCATED APPROXIMATELY 115' SOUTH OF REMOVED SIGN #5, NORTH OF THE EDGE OF AN EXISTING DRIVEWAY. NEW SOLAR-POWERED RSFS ASSEMBLY WITH BREAKAWAY BASE.
7		N N	NEW SIGNS AND POSTS LOCATED APPROXIMATELY 100' SOUTH OF SIGN #6
8		N N	NEW SIGN AND POSTS LOCATED AT THE SAME STATION AS THE CENTERLINE OF THE DRIVEWAY TO HOUSE #302, APPROXIMATELY 34' WEST OF AN EXISTING "HIDDEN DRIVE" SIGN. NEW SOLAR-POWERED RSFS ASSEMBLY WITH BREAKAWAY BASE. NOTE SIZE OF RSFS DISPLAY ON SHEET TSS-12.

ITEM 675.50 REMOVING SIGNS AS SHOWN - 5

- NOTES:
1. ALL OTHER SIGNS NOT SHOWN ARE TO REMAIN.
 2. SEE NOTES SHEET NDS-1 FOR ADDITIONAL INFORMATION.
 3. ROW WIDTH OF ROUTE 100 IS 49.5'.
 4. ROW WIDTH OF BRIDGE STREET IS 49.5'.

SIGN ACTIVITY

N	= NEW
R	= REMOVE
R&S	= REMOVE & SALVAGE
S	= SALVAGE SIGN
RET	= RETAIN
B-B	= BACK TO BACK

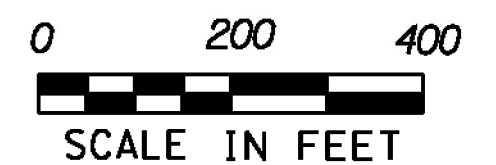

WAITSFIELD

PROJECT NAME:	STATEWIDE SRTS PROJECTS
PROJECT NUMBER:	STP SRIN(25)
FILE NAME:	...Plotfiles\13 Waitsfield.dgn
PROJECT LEADER:	G. GOYETTE
DESIGNED BY:	K. RICHARDSON
WAITSFIELD LS-9	
PLOT DATE:	12/28/2012
DRAWN BY:	K. RICHARDSON
CHECKED BY:	G. GOYETTE
SHEET	18 OF 35