


**INDEX OF SHEETS**

- 1 TITLE SHEET
- 2 QUANTITY SHEET
- 3 TRAFFIC CONTROL
- 4 PROJECT NOTES
- 5 DETAILS
- 6-23 REFERENCE PLANS

**VAOT STANDARD SHEETS**

E-100	CONSTRUCTION APPROACH SIGNS	01/02/04
E-100A	SIDE ROAD CONSTRUCTION - APPROACH SIGNS	01/02/04
E-101	CONSTRUCTION SIGN DETAILS	05/30/03
E-102	CONSTRUCTION SIGN DETAILS	06/30/03
E-102A	CONSTRUCTION SIGN DETAILS	05/01/04
E-106	TRAFFIC CONTROL- MISCELLANEOUS DETAILS	03/01/04
E-107	DELINEATION, BARRICADES AND DETOURS FOR CONSTRUCTION AREAS	06/30/03
E-107A	BREAKAWAY BARRICADE DETAILS	06/08/09
E-121	STANDARD SIGN PLACEMENT - CONVENTIONAL ROAD	08/08/95
E-123	GUIDE SIGN PLACEMENT - MISCELLANEOUS DETAILS	03/16/04
E-140	REGULATORY SIGN DETAILS	08/30/96
E-171A	TRAFFIC CONTROL SIGNALS GENERAL NOTES & DETAILS	08/09/95
E-172	VEHICLE LOOP DETAILS	08/09/95
E-191	PAVEMENT MARKING DETAILS	02/01/99
E-192	PAVEMENT MARKING DETAILS	10/12/00
E-193	PAVEMENT MARKING DETAILS	08/18/95

STATE OF VERMONT  
AGENCY OF TRANSPORTATION

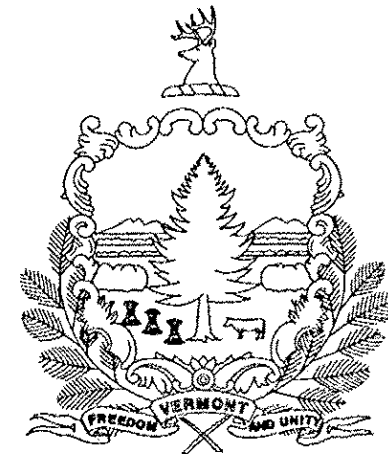


PROPOSED IMPROVEMENT

BRIDGE PROJECT  
TOWN OF RICHMOND  
COUNTY OF CHITTENDEN  
BRIDGE NO. 31 ON TOWN HIGHWAY NO. 1 (FAS 0209)  
RURAL MAJOR COLLECTOR


PROJECT LOCATION: BRIDGE STREET, APPROXIMATELY 0.25 MILES SOUTH OF THE INTERSECTION OF US ROUTE 2 AND BRIDGE STREET (T.H. 1) IN THE TOWN OF RICHMOND.

PROJECT DESCRIPTION: THIS PROJECT INVOLVES CLEANING AND PAINTING THE EXISTING STEEL SUPERSTRUCTURE MEMBERS AND MINOR ASSOCIATED WORK.

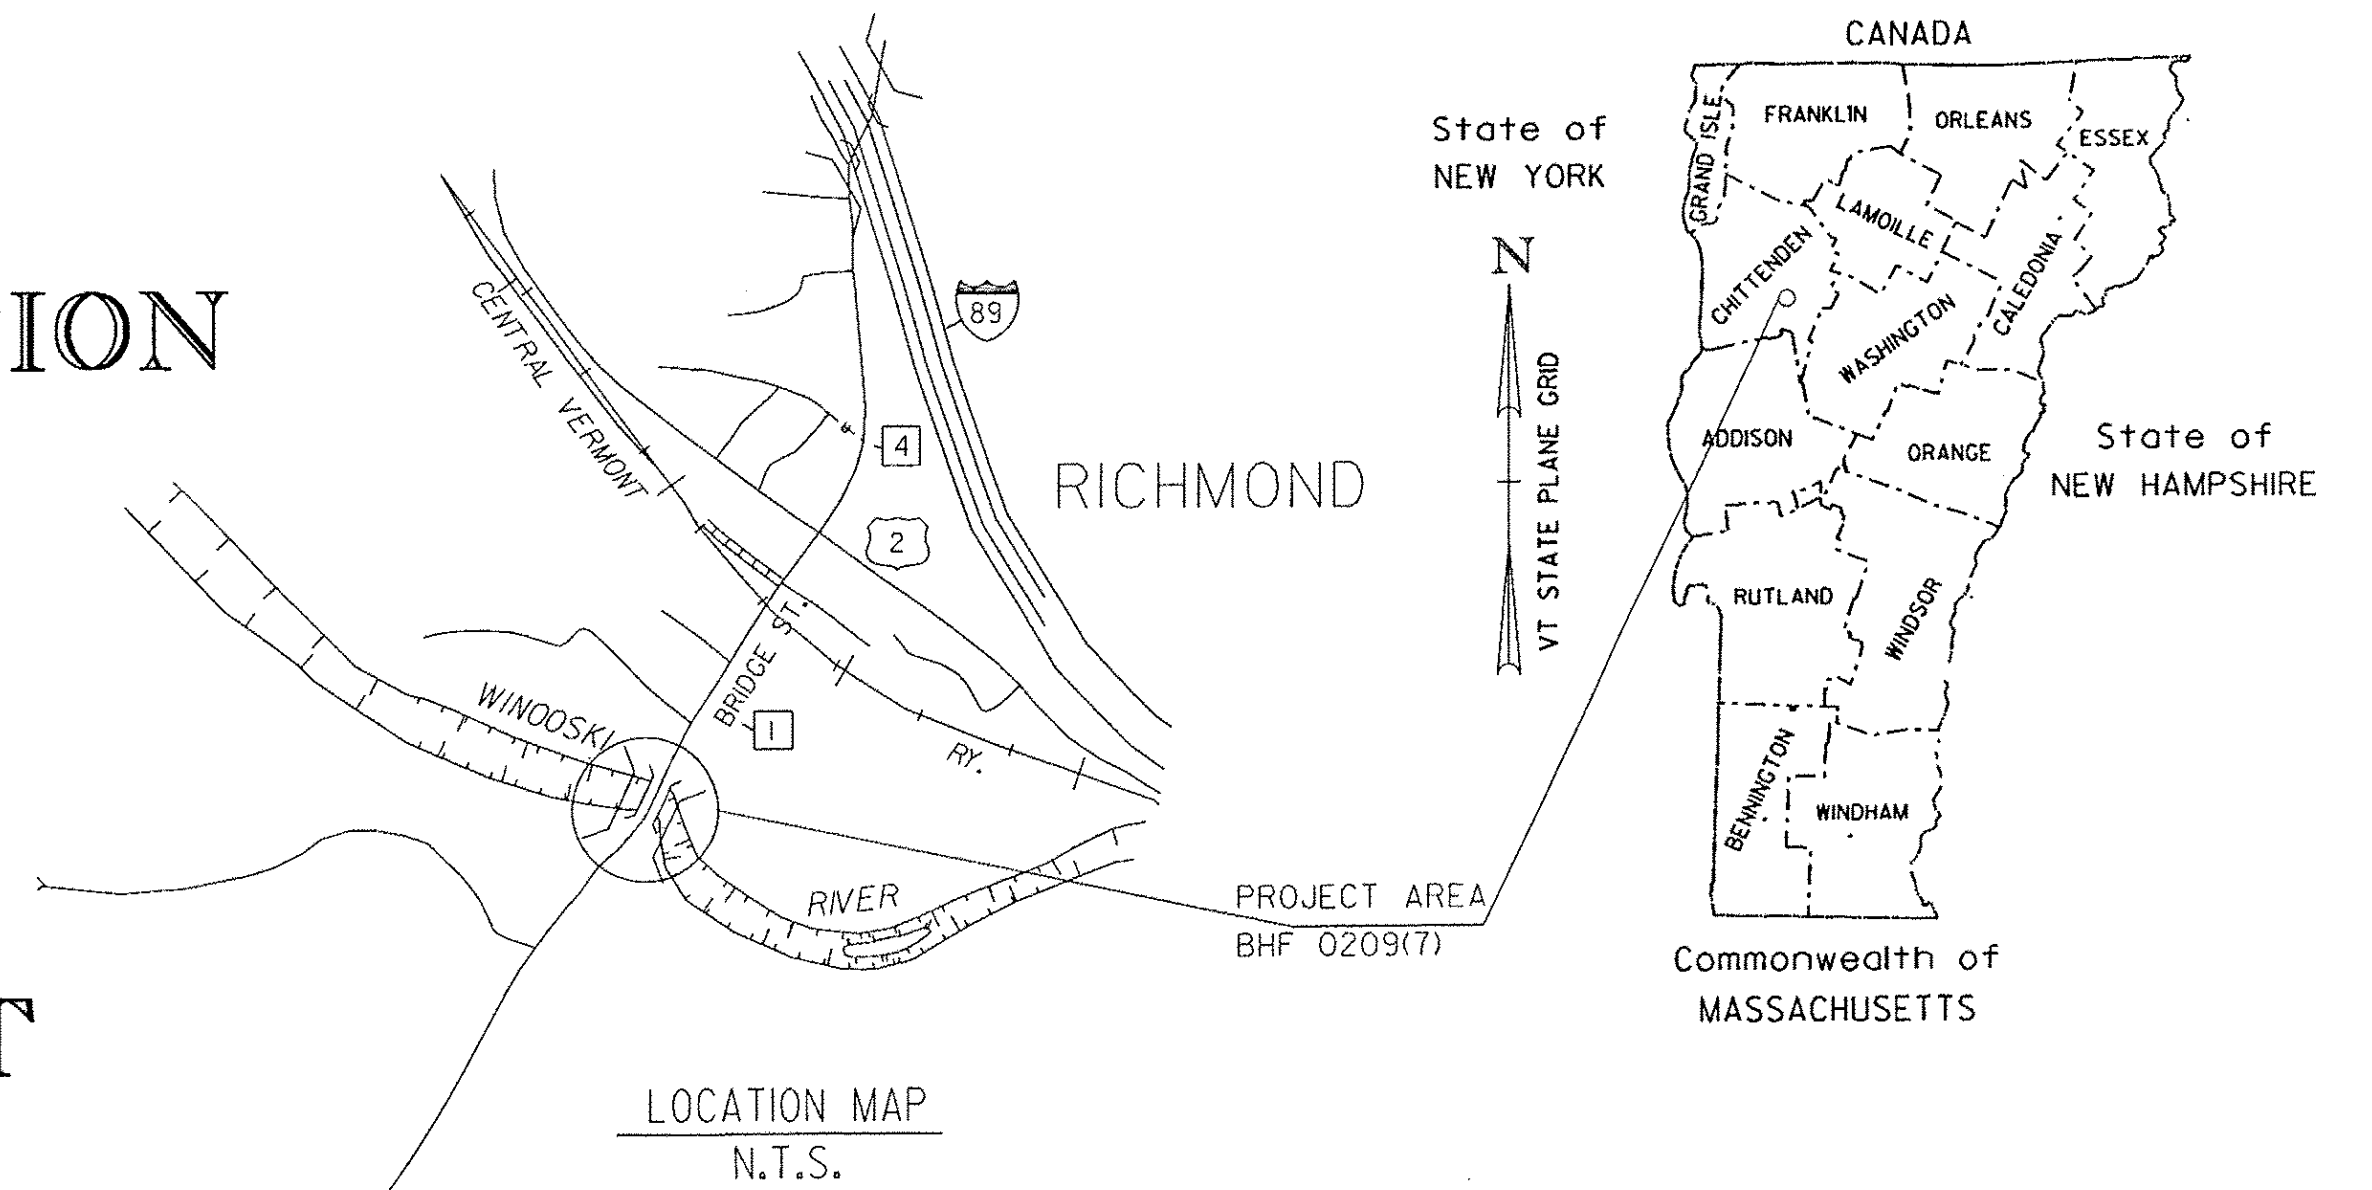

RECORD PLANS	
CONTRACTOR:	PHENIX DEVELOPMENT & CONST., INC. - CORFU, NY
RESIDENT ENGINEER:	S. WHEATLEY
CONSTRUCTION BEGAN:	SEPTEMBER 7, 2011
CONSTRUCTION COMPLETE:	JUNE 1, 2012
RECORD PLANS BY:	S. WHEATLEY
I HEREBY CERTIFY THAT ALL THE CONSTRUCTION REQUIRED BY THIS SET OF DRAWINGS HAS BEEN ACCOMPLISHED AS INDICATED HEREIN.	
BY:	<i>S. Wheatley</i> RESIDENT ENGINEER
DATE:	8-26-13
NOTE: Any further information concerning final quantities, amounts or other details relative to this project may be found at Central Files in the electronic archives.	



BUILT AS DESIGNED

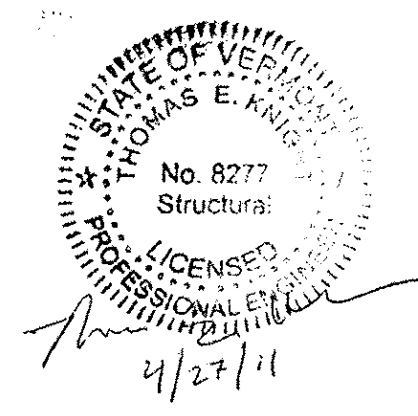

QUALITY ASSURANCE PROGRAM: LEVEL 2

CONVENTIONAL SYMBOLS	
COUNTY LINE	
TOWN LINE	
LIMITS OF ACCESS	
POINT OF ACCESS	
FENCE LINE	
STONE WALL	
TRAVELED WAY	
GUARD RAIL	
RAILROAD	
SURVEY LINE	
CULVERT	
POWER POLE	
TELEPHONE POLE	
TREES	
CONTROL OF ACCESS	
PROPERTY LINE	
R.O.W. TAKING LINE	
SLOPE RIGHTS	
TOP OF CUT	
TOE OF SLOPE	

SURVEYED BY :	VERMONT SURVEY
SURVEYED DATE :	06/26/07
DATUM	
VERTICAL	NAVD88 (GeoId03)
HORIZONTAL	NAD 83 (CORS96) SPC (4400 VT)

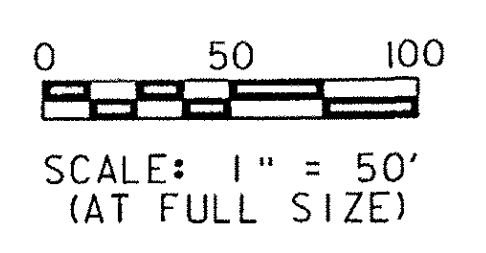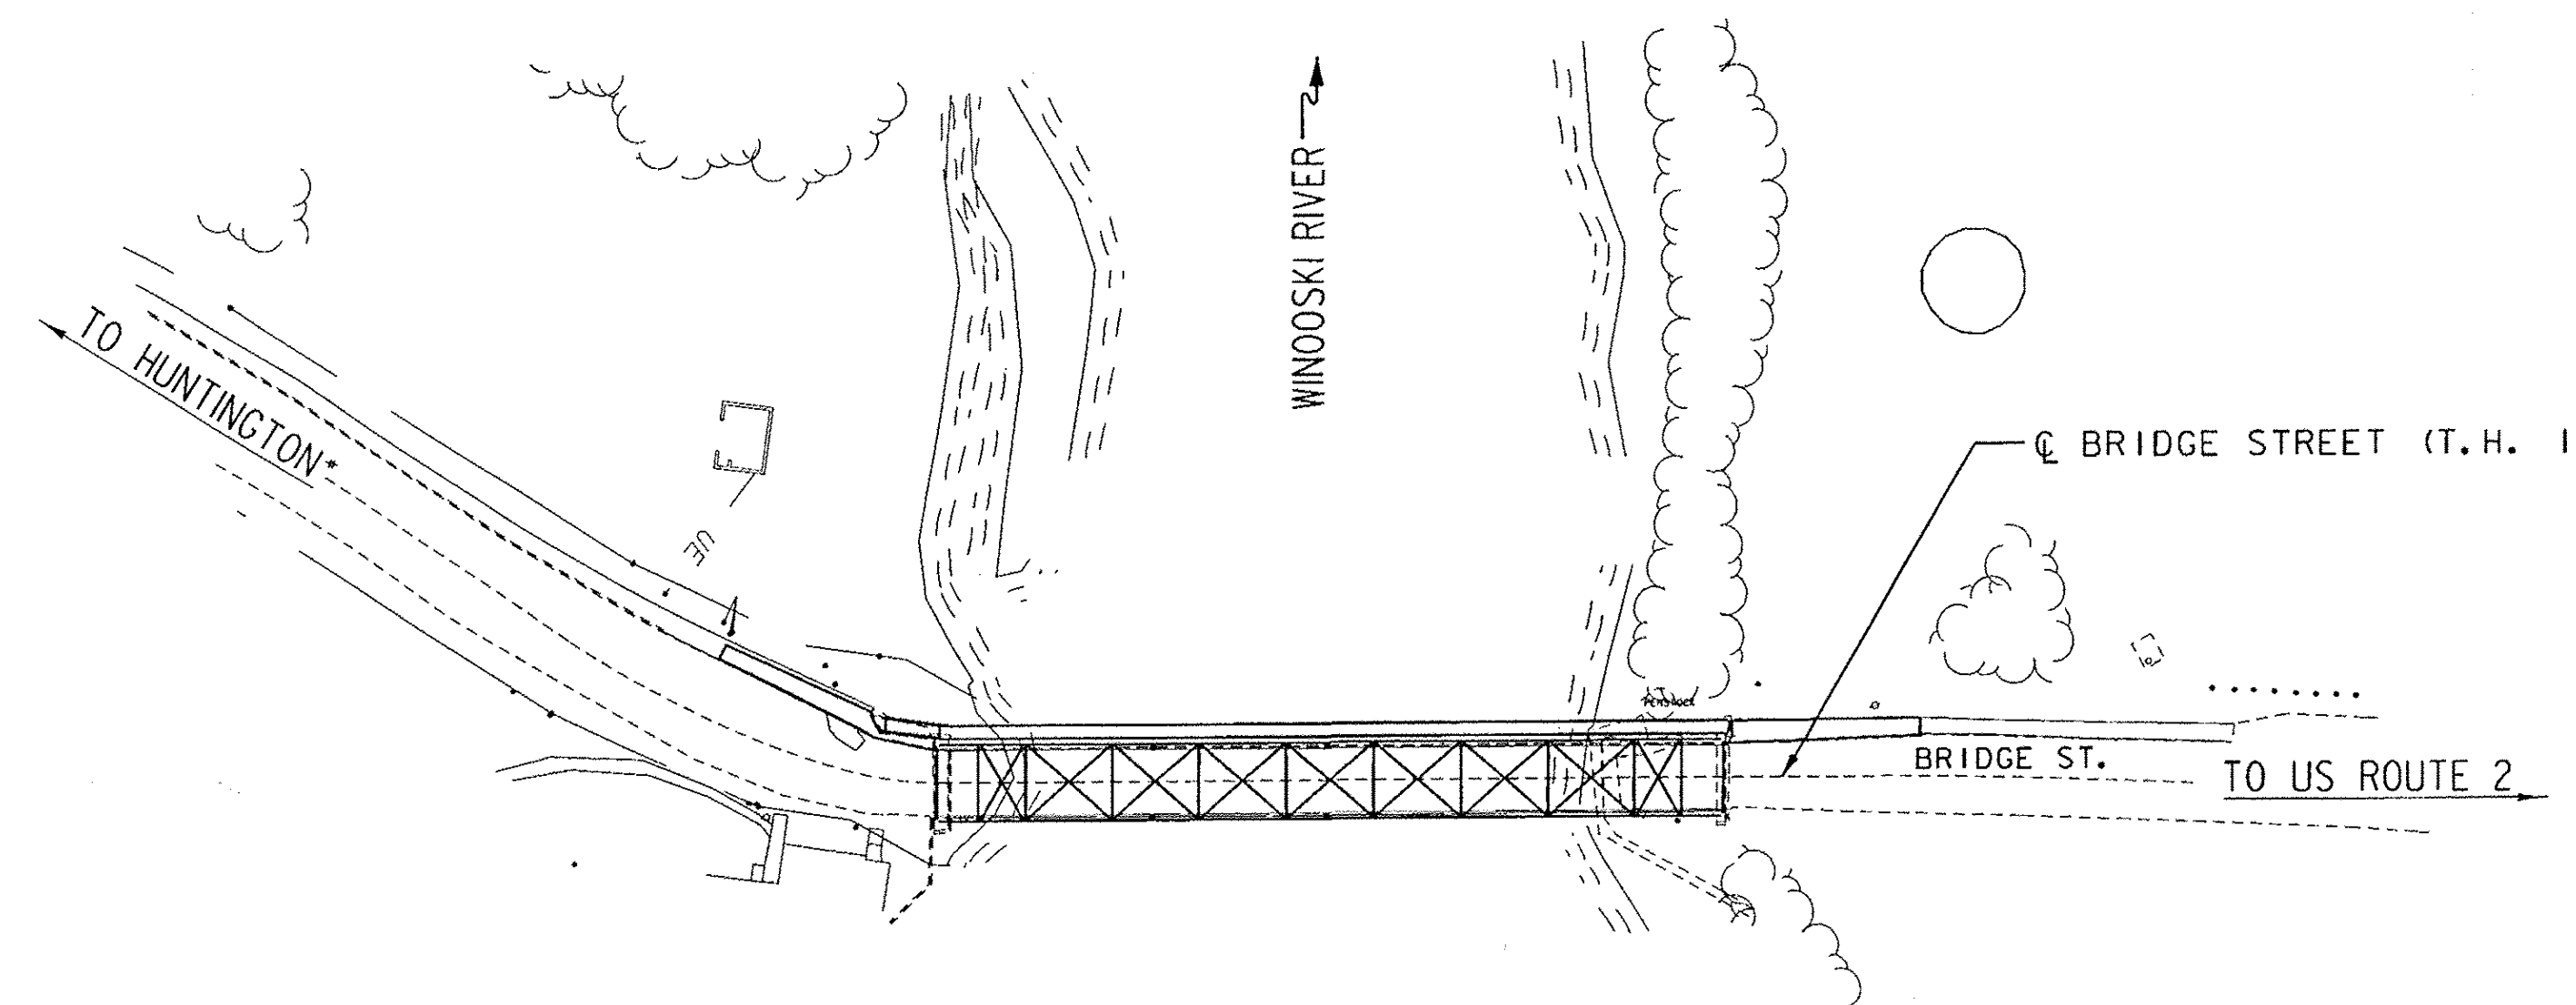

THESE PLANS ARE SUBJECT TO SUCH ENGINEERING CHANGES AS MAY BE REQUIRED BY THE FEDERAL HIGHWAY ADMINISTRATION OR THE DIRECTOR OF PROGRAM DEVELOPMENT.  
CONSTRUCTION IS TO BE CARRIED ON IN ACCORDANCE WITH THESE PLANS AND THE STANDARD SPECIFICATIONS FOR CONSTRUCTION DATED 2006, AS APPROVED BY THE FEDERAL HIGHWAY ADMINISTRATION ON JUNE 15, 2006 FOR USE ON THIS PROJECT, INCLUDING ALL SUBSEQUENT REVISIONS AND SUCH REVISED SPECIFICATIONS AND SPECIAL PROVISIONS AS ARE INCORPORATED IN THESE PLANS.

DIRECTOR OF PROGRAM DEVELOPMENT	
APPROVED:	<i>Mark Sargent</i> DATE 5-2-11
PROJECT MANAGER : MARK SARGENT	
PROJECT NAME : RICHMOND	
PROJECT NUMBER : BHF 0209 (7)	
SHEET 1 OF 23 SHEETS	