


**BRESSOR, GARY T. & JEAN H.**

STATE OF VERMONT

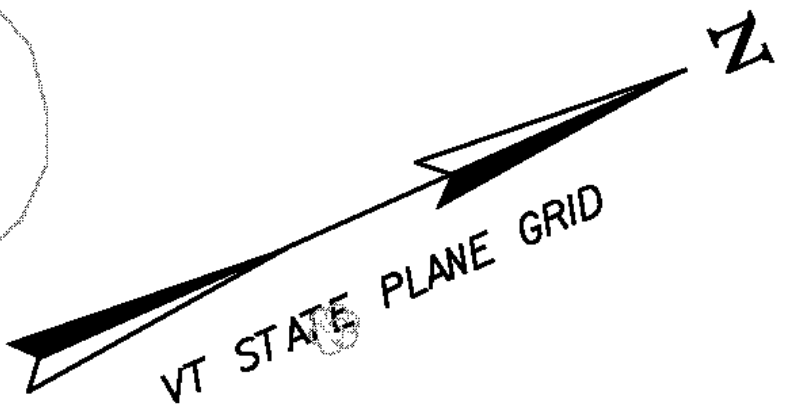

**CURVE 1 (COMPOUND)**  
 PI BK = 6+95.08  
 PI AHD = 6+91.46  
 $\Delta = 34^{\circ}01'25''$   
 $D = 19^{\circ}05'55''$  (1)  $D = 57^{\circ}17'45''$  (2)  
 $R = 300.00'$  (1)  $R = 100.00'$  (2)  
 $T = 76.05'$  (1)  $T = 46.14'$  (2)  
 $L = 88.79'$  (1)  $L = 29.78'$  (2)  
 $E = 9.49'$

**PCC STATION 7+07.82**  
 N = 693205.00  
 E = 1510483.66  
 ELEV = 316.11 FT

**BRESSOR, GARY T. & JEAN H.**

**CAST-IN-PLACE CONCRETE CURB, TYPE B**  
 STA. 6+60, 17.5' LT - STA. 7+11, 12.8' LT  
 STA. 9+70, 10.6' LT - STA. 10+25, 12.6' LT

**SPECIAL PROVISION (BOX BEAM GUARDRAIL, TRUSS)**  
 STA. 7+24, 14.5' RT - STA. 7+36, 11.1' RT  
 STA. 9+68, 10.8' RT - STA. 11+08, 19.1' RT  
 STA. 9+68, 11.1' LT - STA. 10+28, 12.8' LT

**SPECIAL PROVISION (BRIDGE RAILING, TRUSS)**  
 STA. 7+36, 10.6' RT - STA. 9+68, 10.6' RT  
 STA. 7+36, 10.6' LT - STA. 9+68, 10.6' LT

**PORTLAND CEMENT CONCRETE SIDEWALK, 5 INCH**  
 STA. 6+60, 17.5' LT - STA. 7+11, 12.8' LT  
 STA. 9+70, 10.6' LT - STA. 10+25, 12.6' LT

**REMOVE EXISTING SIDEWALK PER PAY ITEM SOLID ROCK EXCAVATION**  
 STA. 6+60, 17.5' LT - STA. 7+11, 12.8' LT  
 STA. 9+70, 10.6' LT - STA. 10+25, 12.6' LT

**REMOVAL OF EXISTING CURB**  
 STA. 9+70, 10.6' LT - STA. 10+26, 12.6' LT

**REMOVAL AND DISPOSAL OF GUARDRAIL**  
 STA. 7+25, 14.5' RT - STA. 7+34, 11.1' RT  
 STA. 9+70, 10.8' RT - STA. 11+06, 19.1' RT  
 STA. 9+74, 18.0' LT - STA. 10+24, 19.0' LT


**REMOVING AND RESETTING PROPERTY MARKERS**  
 STA. 6+23, 29.0' LT  
 STA. 7+09, 35.3' LT

STATE OF VERMONT

LEGEND

- ▲-▲-▲ CONSTRUCTION LIMITS
- TEMPORARY CONSTRUCTION LIMITS
- TEMPORARY CONSTRUCTION LIMITS, IN-STREAM

**1'-0" STONE FILL, TYPE I**  
 STA. 9+69, 23.0' RT

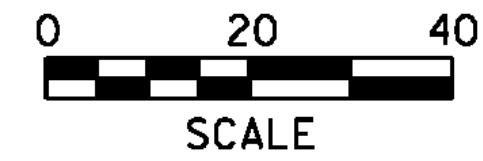

NOTES:

1. SEE TYPICAL ROADWAY SECTIONS SHEETS FOR BRIDGE APPROACH CONSTRUCTION DETAILS.
2. CONTRACTOR SHALL SHIELD EXISTING UTILITY POLES DURING CONSTRUCTION IN ACCORDANCE WITH THE SPECIAL PROVISIONS.
3. LOCATION OF WATER AND SEWER LINES OBTAINED FROM THE TOWN OF RICHMOND WATER RESOURCES DEPARTMENT AND ARE CONSIDERED APPROXIMATE. CONTRACTOR SHALL FIELD VERIFY LOCATION OF WATER AND SEWER LINE LOCATIONS PRIOR TO EARTH DISTURBANCE.
4. PROVIDE GEOTEXTILE UNDER STONE FILL IN ACCORDANCE WITH SECTION 649 OF THE STANDARD SPECIFICATIONS, COST INCIDENTAL TO ITEM 613.10.

PROJECT NAME: RICHMOND  
 PROJECT NUMBER: BHF 0209(5)  
 FILE NAME: ...\\plot files\\Layout Plan.ppt  
 PROJECT LEADER: C. WILLIAMS  
 DESIGNED BY: G. GOYETTE  
**LAYOUT PLAN**

RICHMOND  
 BHF 0209(7)  
 SHEET 7 OF 23  
**FOR REFERENCE ONLY**  
 SHEET 9 OF 50

**GIFFORD, GEORGE D. & VIRGINIA**