




Stantec

# RICHMOND BHF 0209 (7) MISC. STEEL REPAIRS

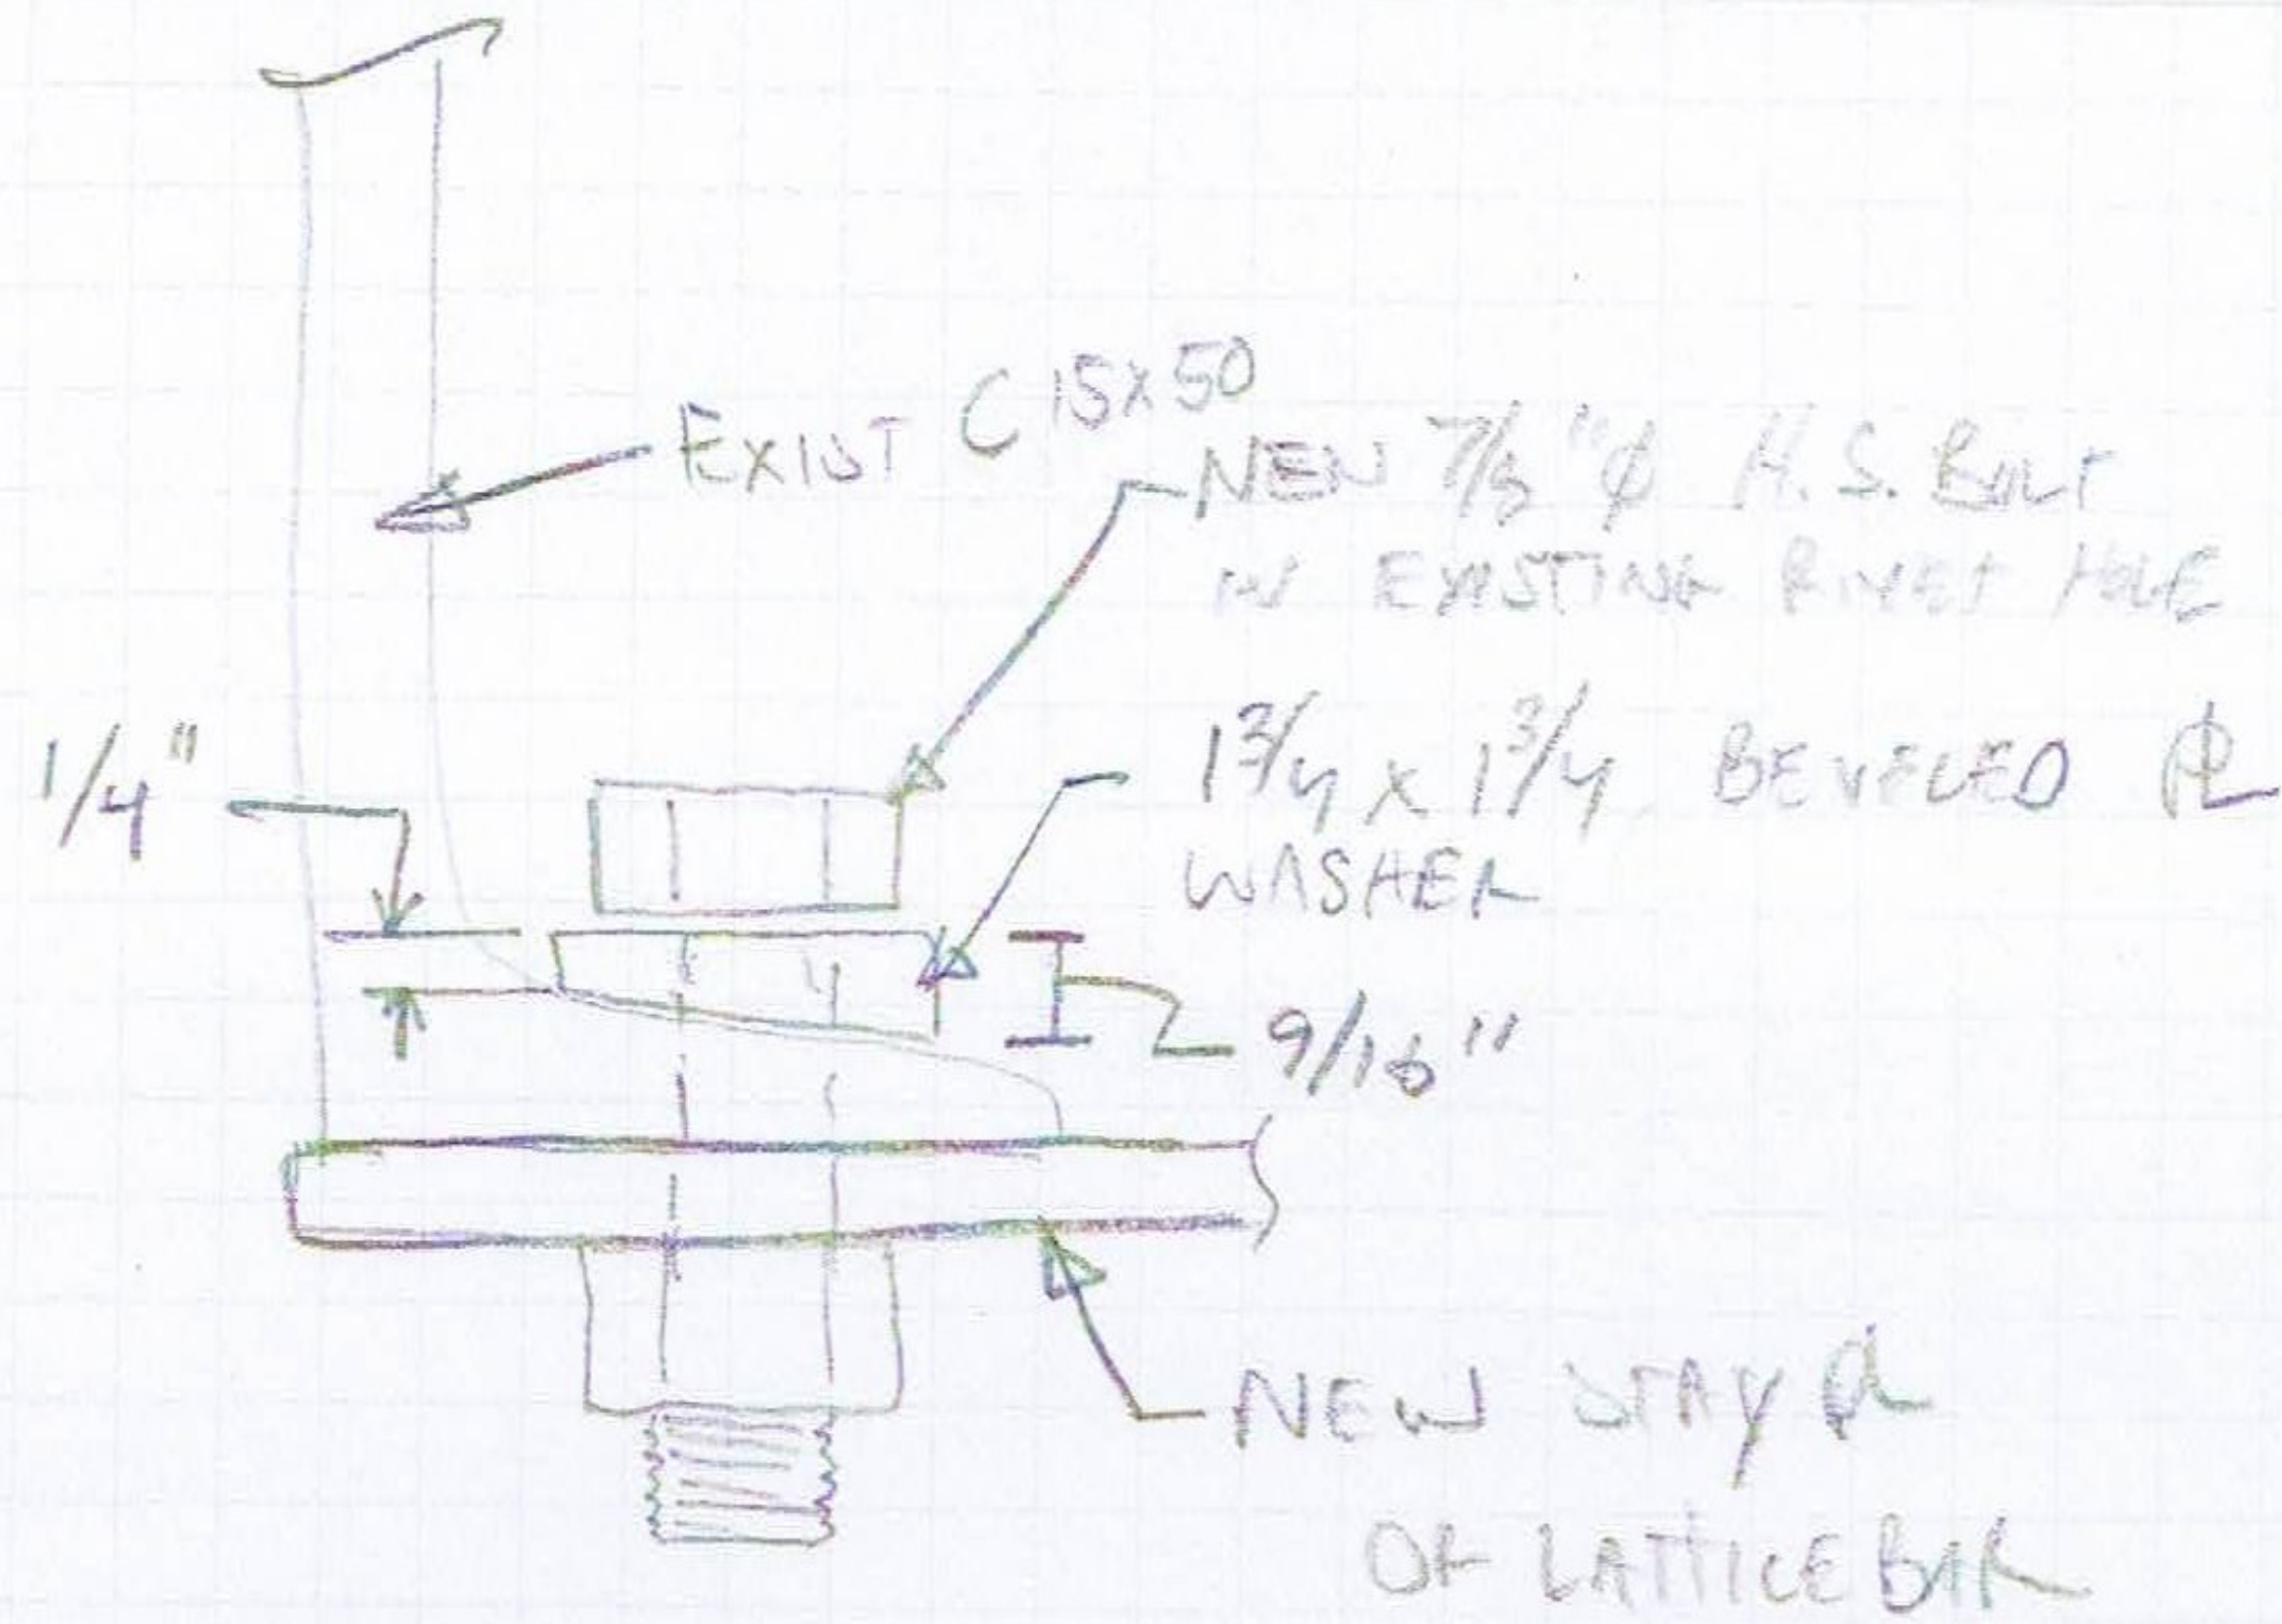

A-A

Designed by: ZEF 6/12/12 Checked by:

