



SEE REVISED UNCLASSIFIED CHANNEL EXCAVATION SECTIONS

STA. 11+28, LT
END GRUBBING MATERIAL

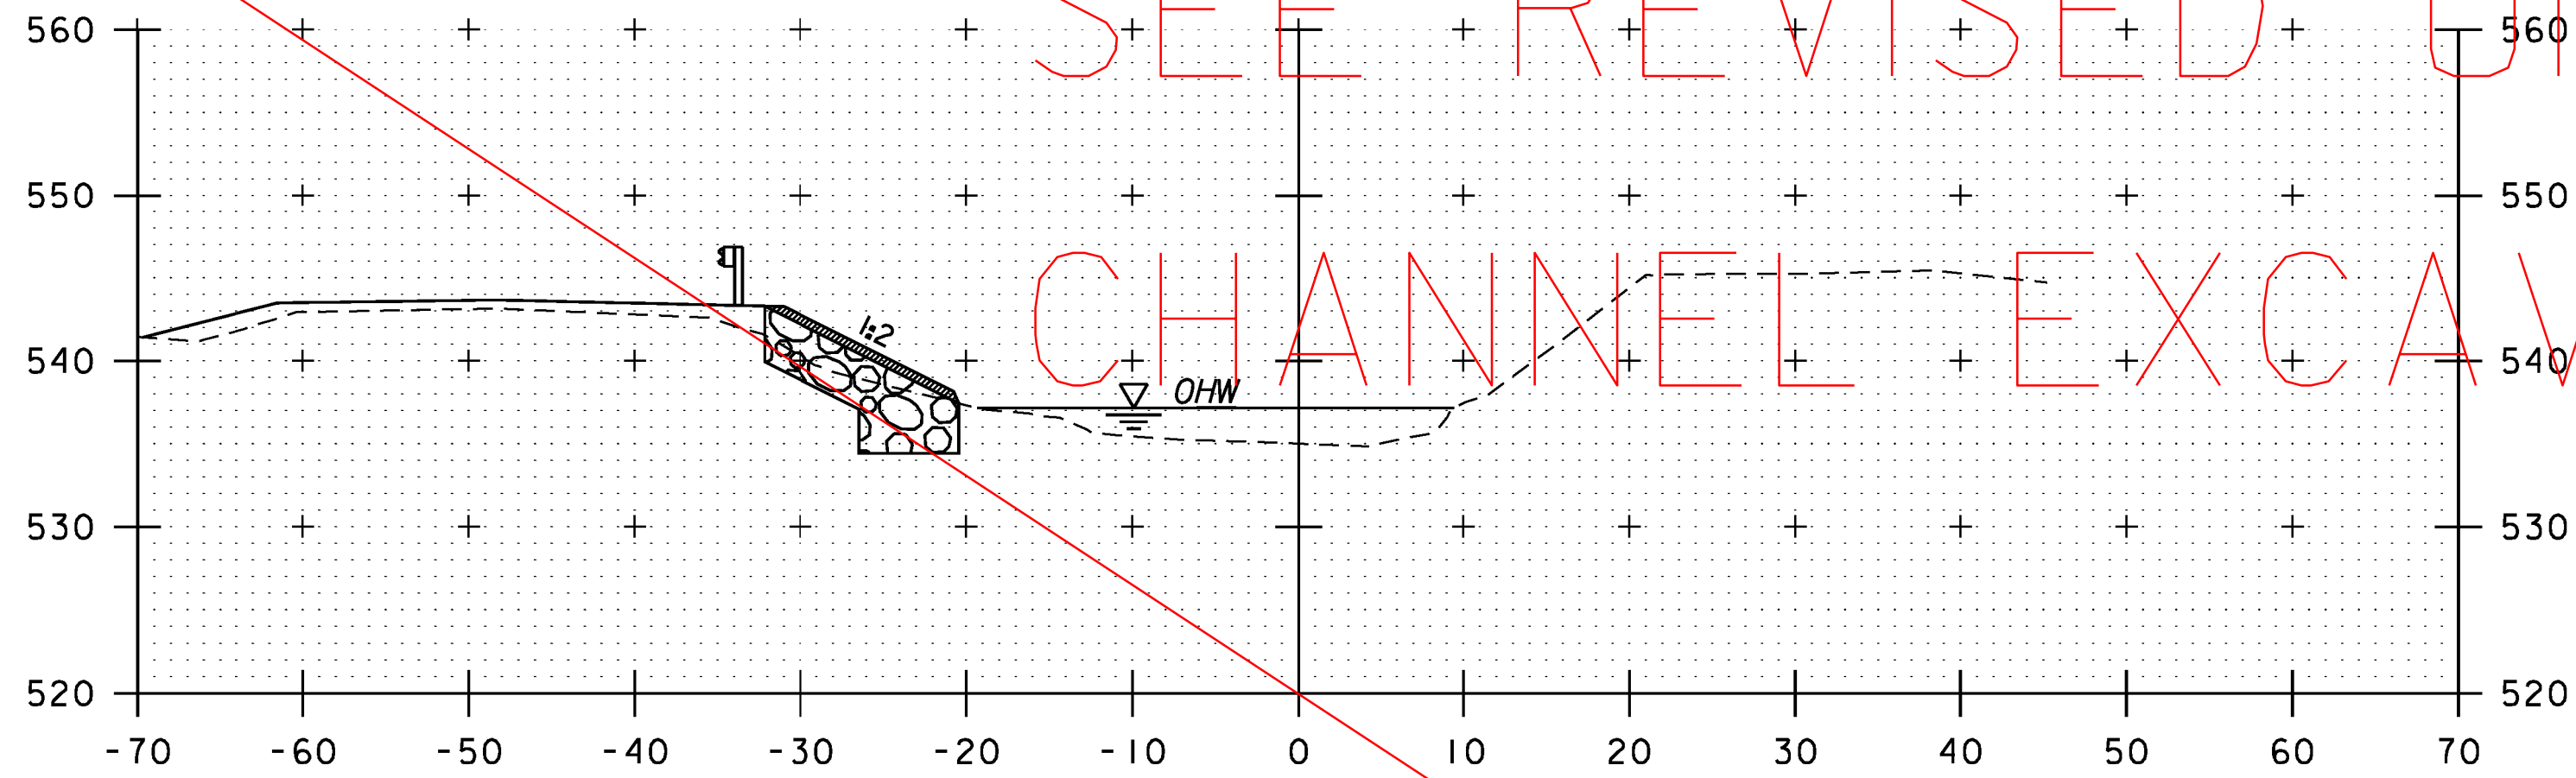


STA. 10+35, LT
BEGIN UNCLASSIFIED CHANNEL EXCAVATION
GEOTEXTILE UNDER STONE FILL
STONE FILL, TYPE III
GRUBBING MATERIAL

10+50

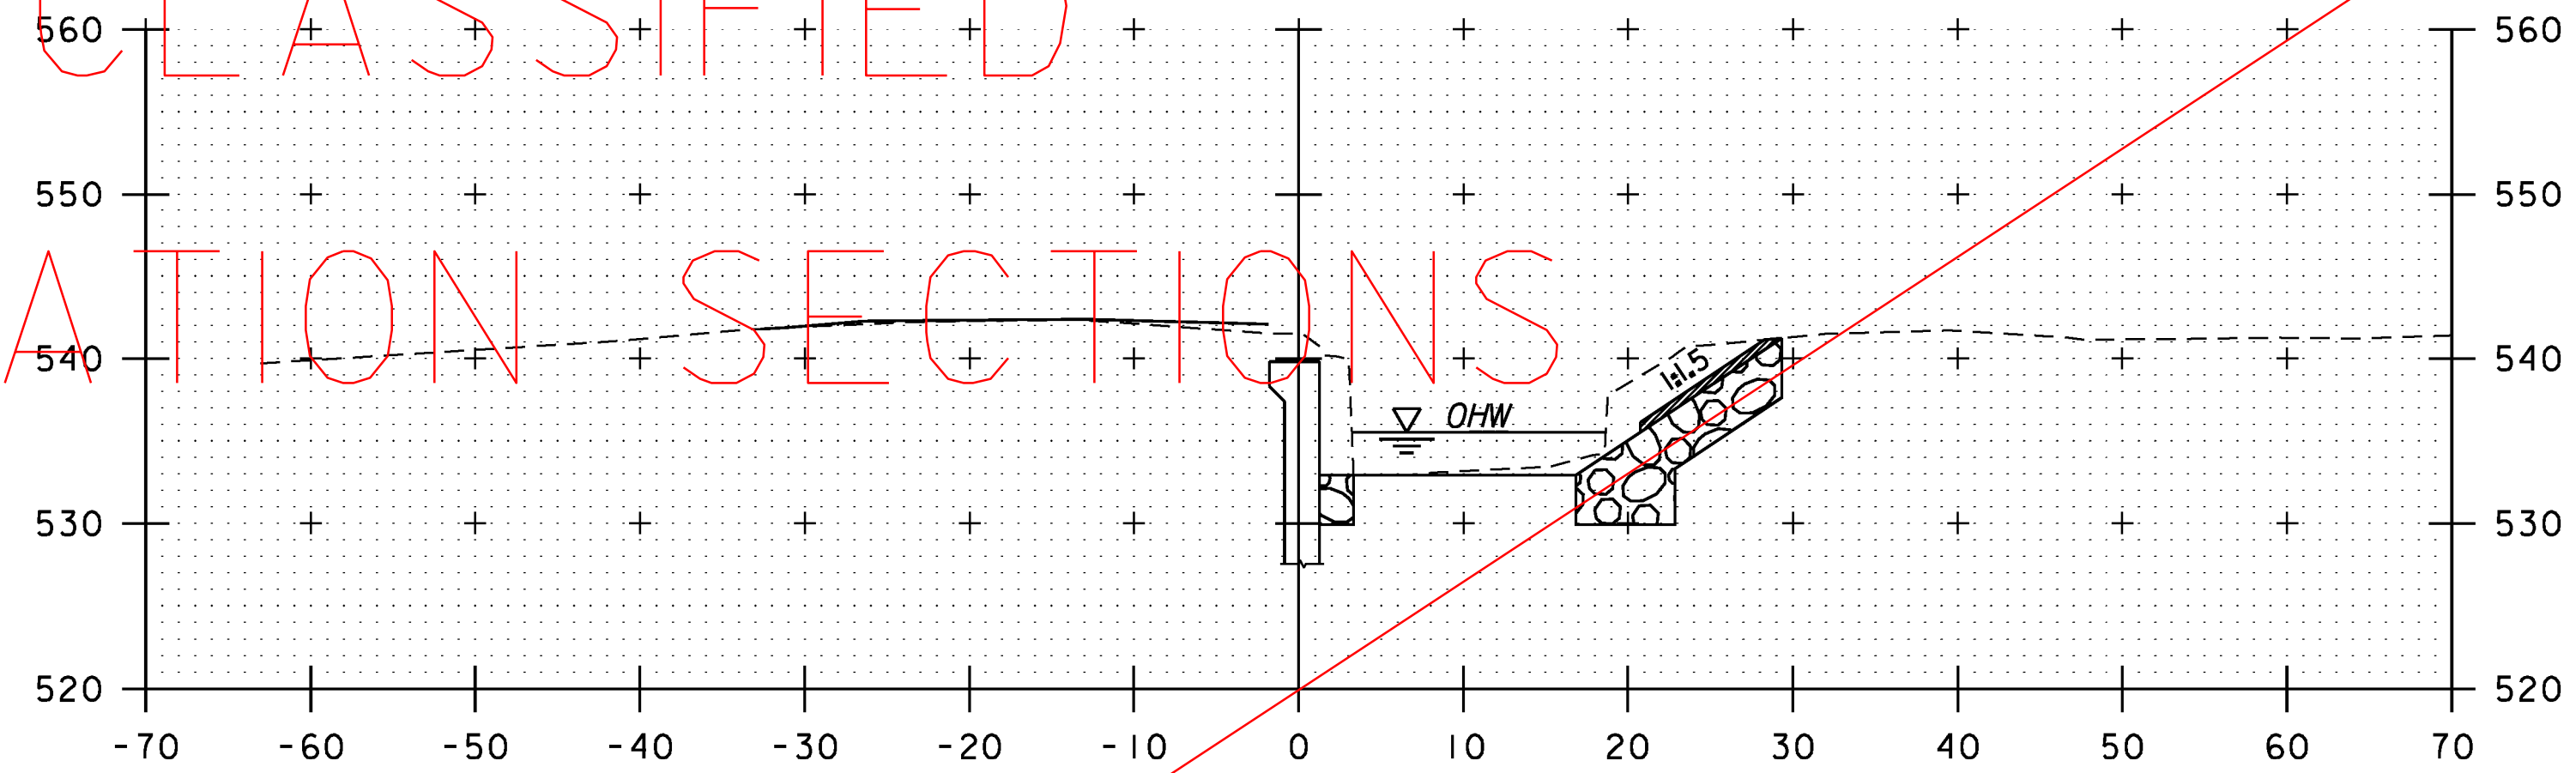


STA. 11+16, RT
BEGIN UNCLASSIFIED CHANNEL EXCAVATION
GEOTEXTILE UNDER STONE FILL
STONE FILL, TYPE III
GRUBBING MATERIAL


11+25

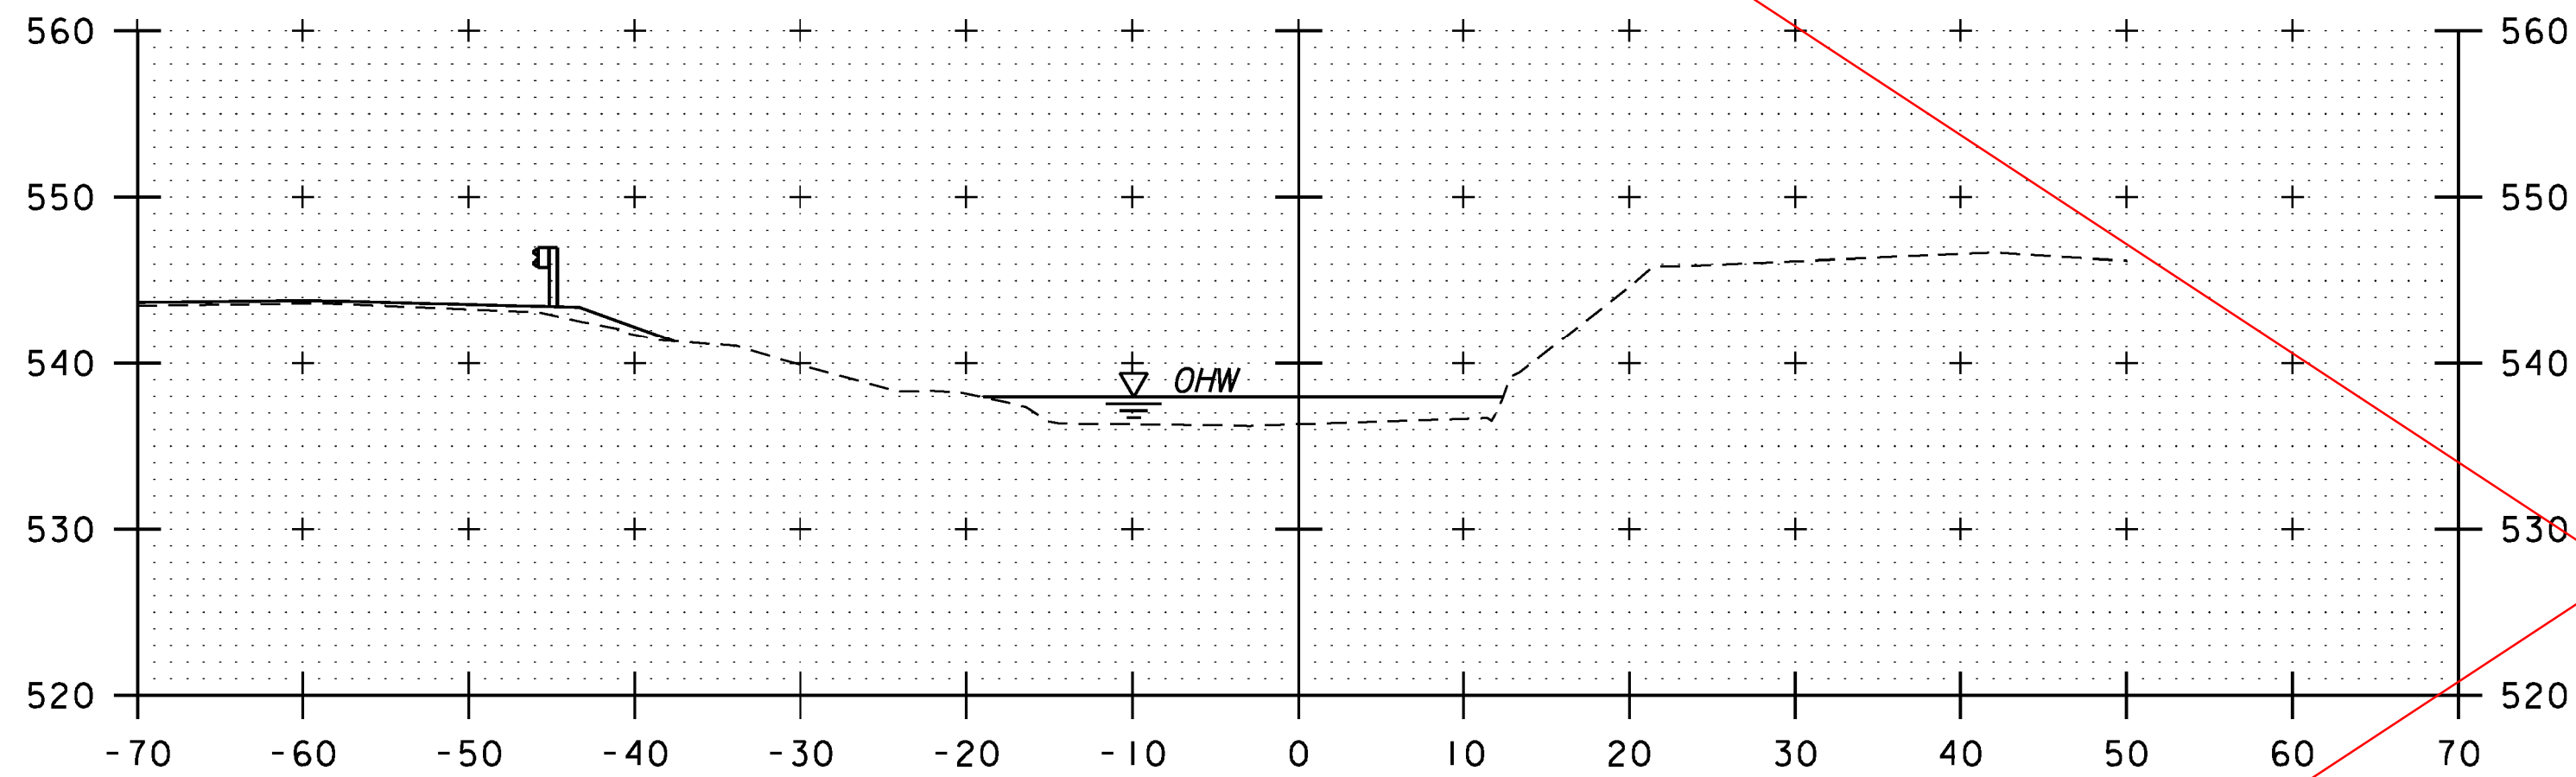


10+25

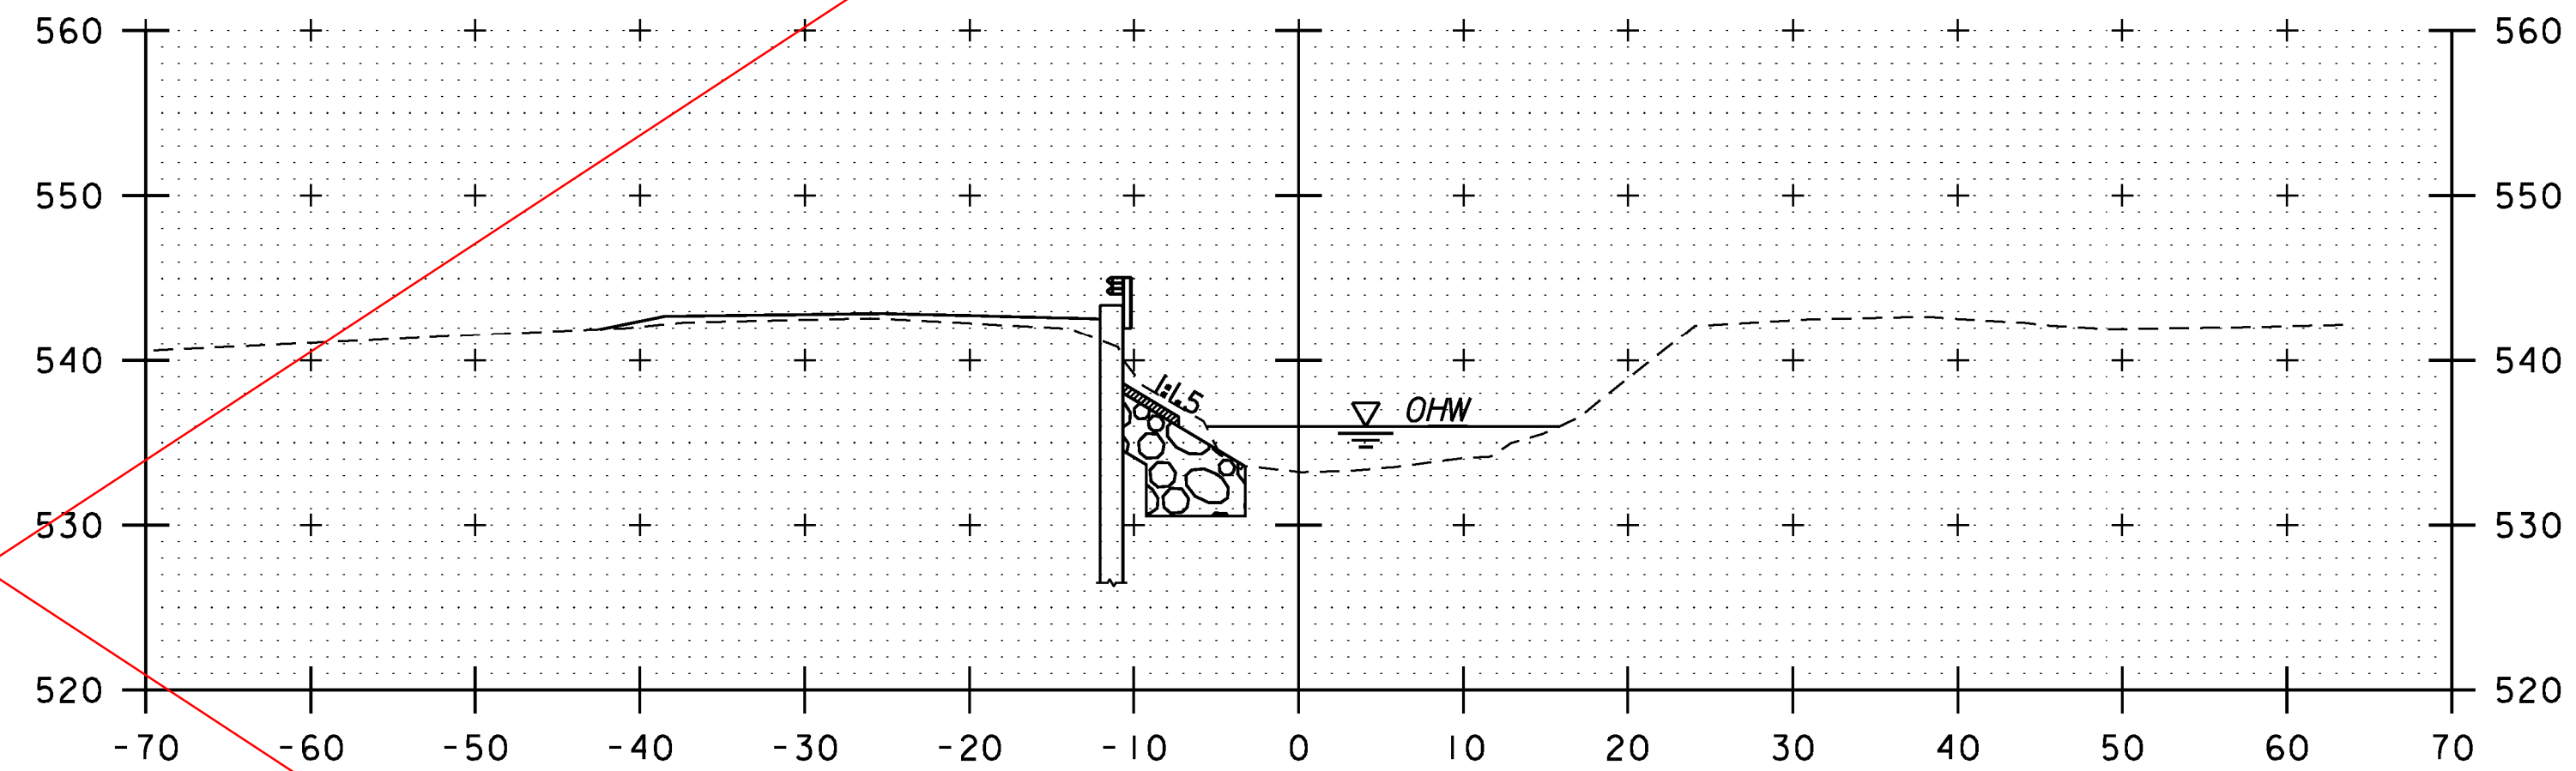

11+00

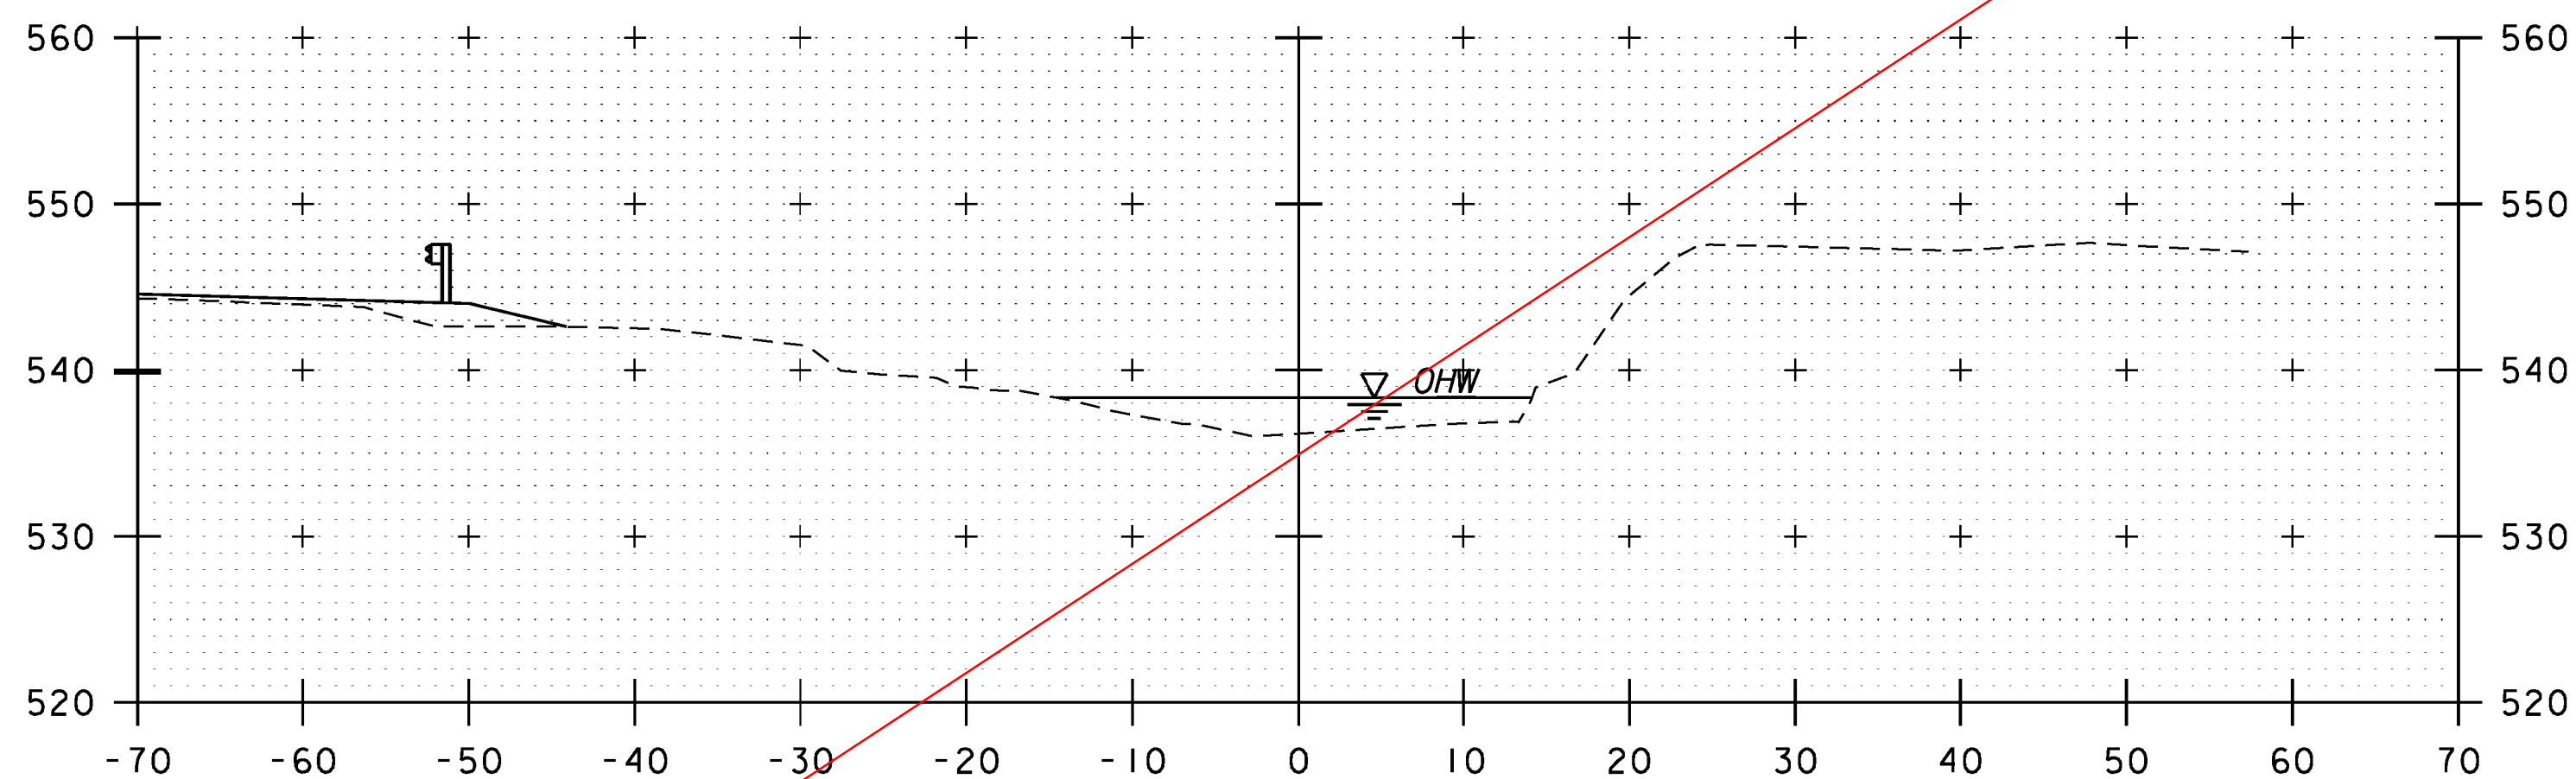

10+00

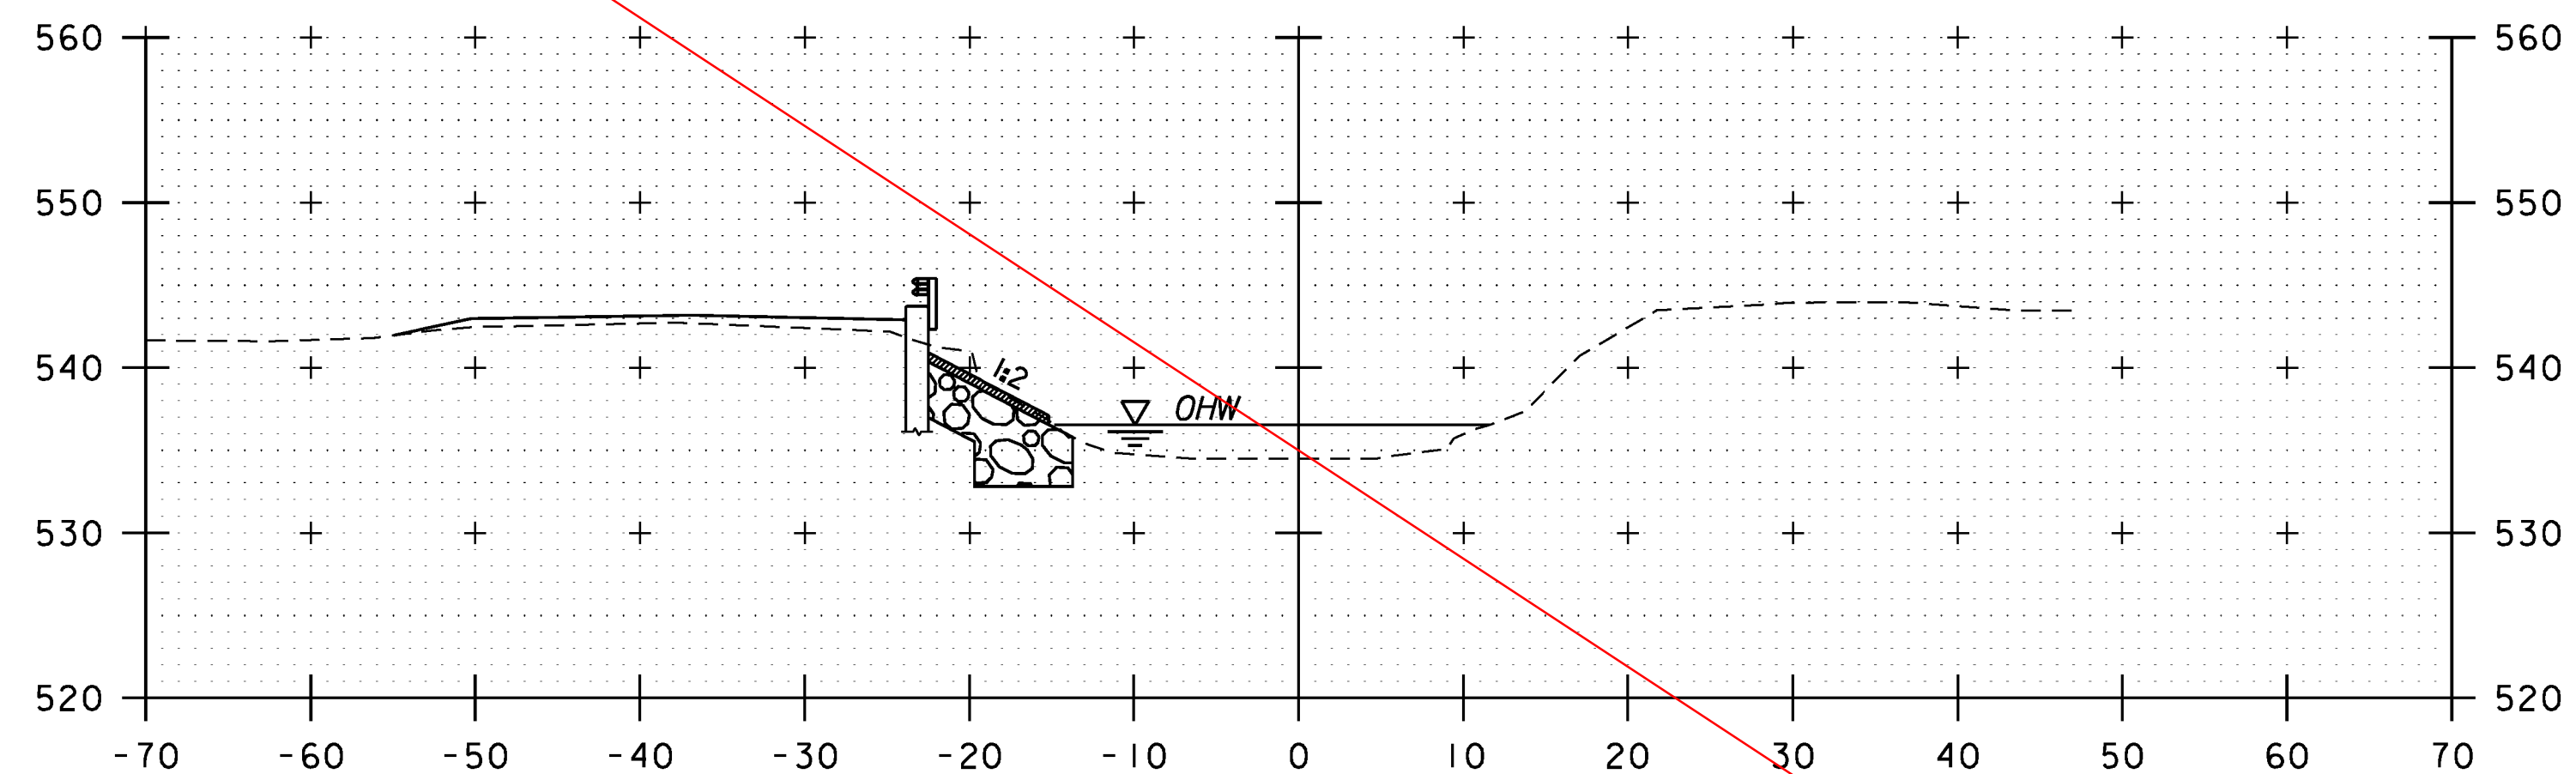

10+75

CHANNEL CROSS SECTIONS

SCALE 1" = 10'-0"

STA. 10+00 TO STA. 11+25



PROJECT NAME: BRATTLEBORO
PROJECT NUMBER: BRO 1442(35)

FILE NAME: z10j062xsl.dgn
PROJECT LEADER: S.E. BURBANK
DESIGNED BY: E.A. FIALA
CHANNEL CROSS SECTIONS (1 OF 3)

PLOT DATE: 10/14/2013
DRAWN BY: E.A. FIALA
CHECKED BY: S.E. BURBANK
SHEET 57 OF 68