


SEE REVISED UNCLASSIFIED CHANNEL EXCAVATION SECTIONS

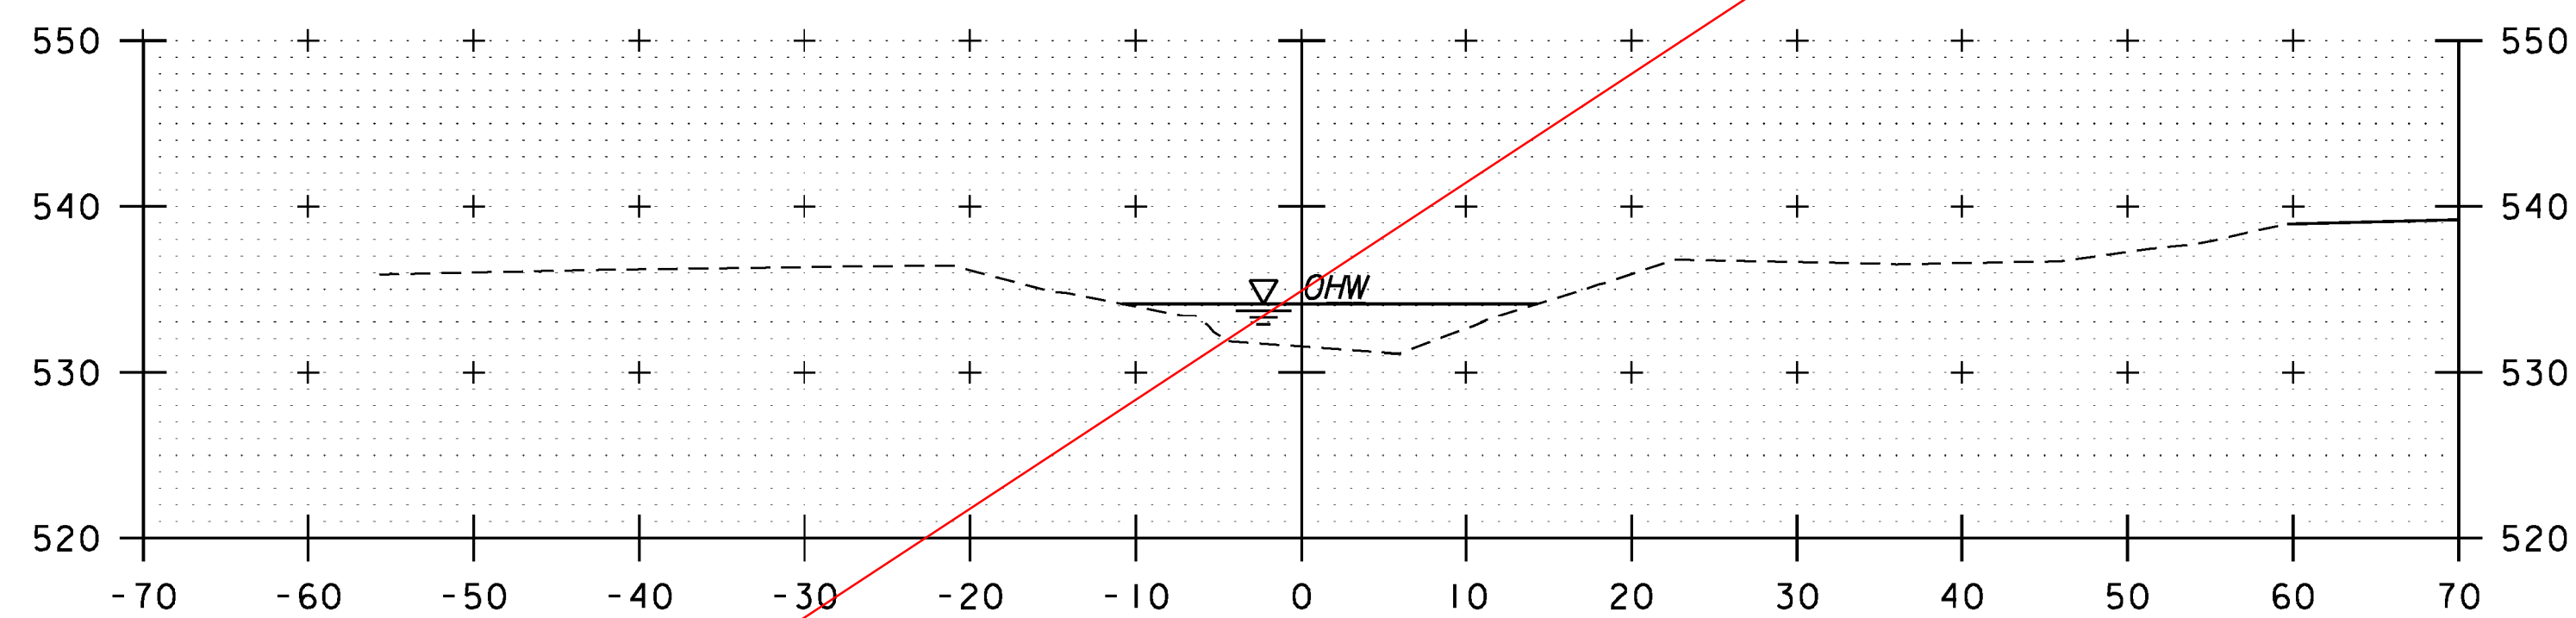

13+00

CHANNEL CROSS SECTIONS

SCALE 1" = 10'-0"

STA. 13+00



PROJECT NAME: BRATTLEBORO
PROJECT NUMBER: BRO 1442(35)

FILE NAME: z10j062xsl.dgn
PROJECT LEADER: S.E. BURBANK
DESIGNED BY: E.A. FIALA
CHANNEL CROSS SECTIONS (3 OF 3)

PLOT DATE: 10/14/2013
DRAWN BY: E.A. FIALA
CHECKED BY: S.E. BURBANK
SHEET 59 OF 68