


STATE OF VERMONT AGENCY OF TRANSPORTATION



PROPOSED IMPROVEMENT BRIDGE PROJECT TOWN OF BRATTLEBORO COUNTY OF WINDHAM

TH 12, CLASS III (LOCAL ROAD), BRIDGE NO. 7

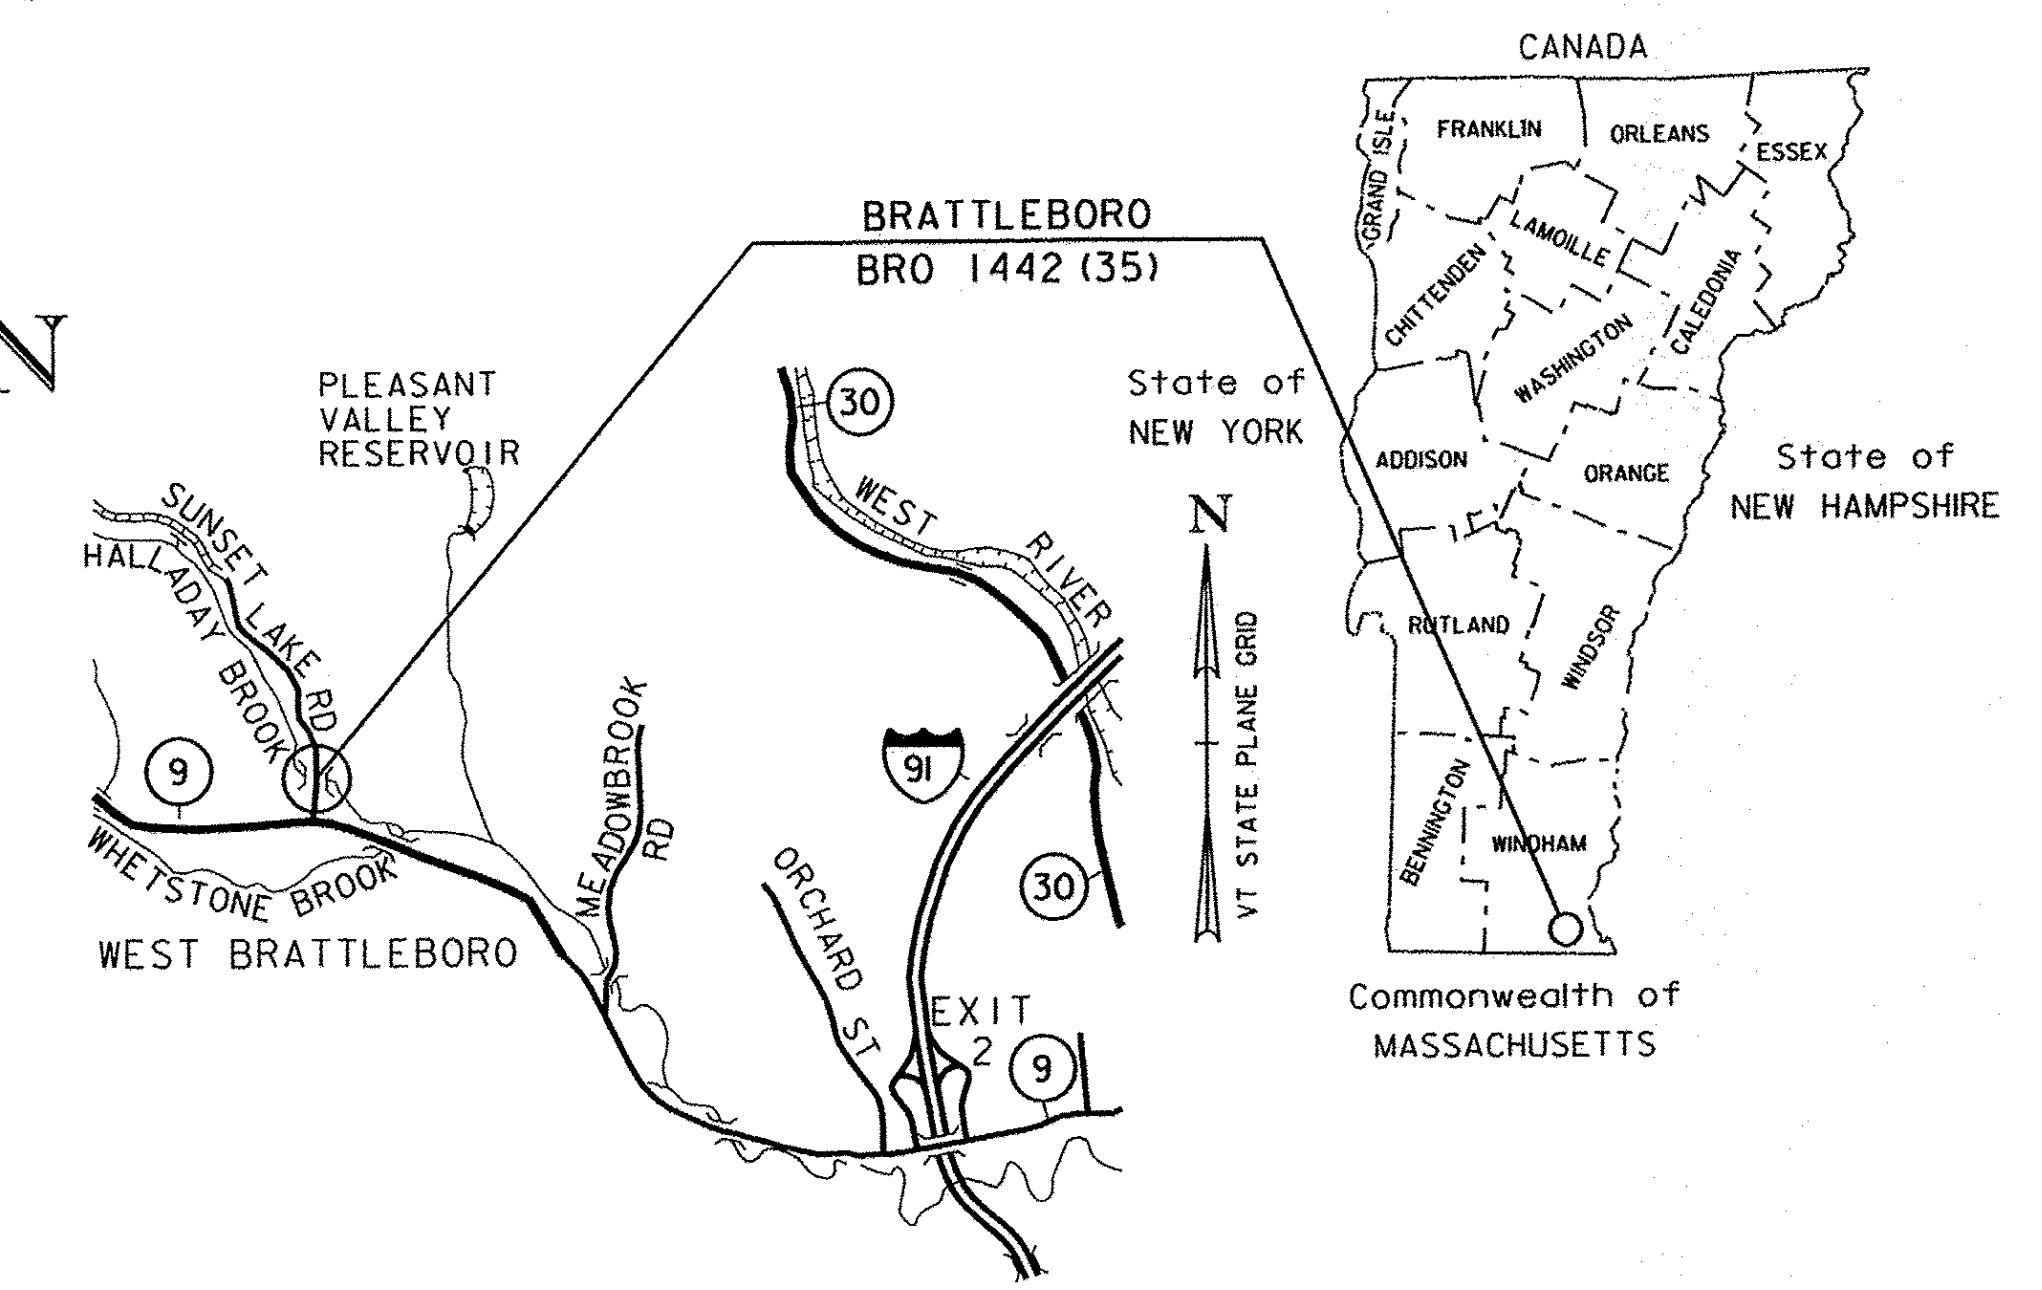


RECORD PLANS	
CONTRACTOR:	RENAUD BROTHERS, INC. - VERNON, VT
RESIDENT ENGINEER:	FRED ROSS III
CONSTRUCTION BEGAN:	APRIL 14, 2010
CONSTRUCTION COMPLETE:	MAY 21, 2013
RECORD PLANS BY:	FRED ROSS III & KEVIN KING
I HEREBY CERTIFY THAT ALL THE CONSTRUCTION REQUIRED BY THIS SET OF DRAWINGS HAS BEEN ACCOMPLISHED AS INDICATED HEREIN.	
BY	<i>Kevin Gammell, RCE</i> for RESIDENT ENGINEER
DATE	<i>04-08-16</i>
NOTE: Any further information concerning final quantities, amounts or other details relative to this project may be found at Central Files in the electronic archives.	

PROJECT LOCATION: LOCATED IN THE COUNTY OF WINDHAM, TOWN OF BRATTLEBORO, ON SUNSET LAKE ROAD (TH 12); BRIDGE NO. 7 OVER HALLADAY BROOK, APPROXIMATELY 0.20 MILES NORTH OF THE INTERSECTION OF VT 9 AND SUNSET LAKE RD (TH 12).

PROJECT DESCRIPTION: WORK TO BE PERFORMED UNDER THIS PROJECT INCLUDES REMOVAL AND REPLACEMENT OF BRIDGE NO. 7, ON THE EXISTING ALIGNMENT, WITH ASSOCIATED ROADWAY AND CHANNEL WORK.



LENGTH OF ROADWAY: 272.17 FEET
LENGTH OF BRIDGE: 47.83 FEET
LENGTH OF PROJECT: 320.00 FEET

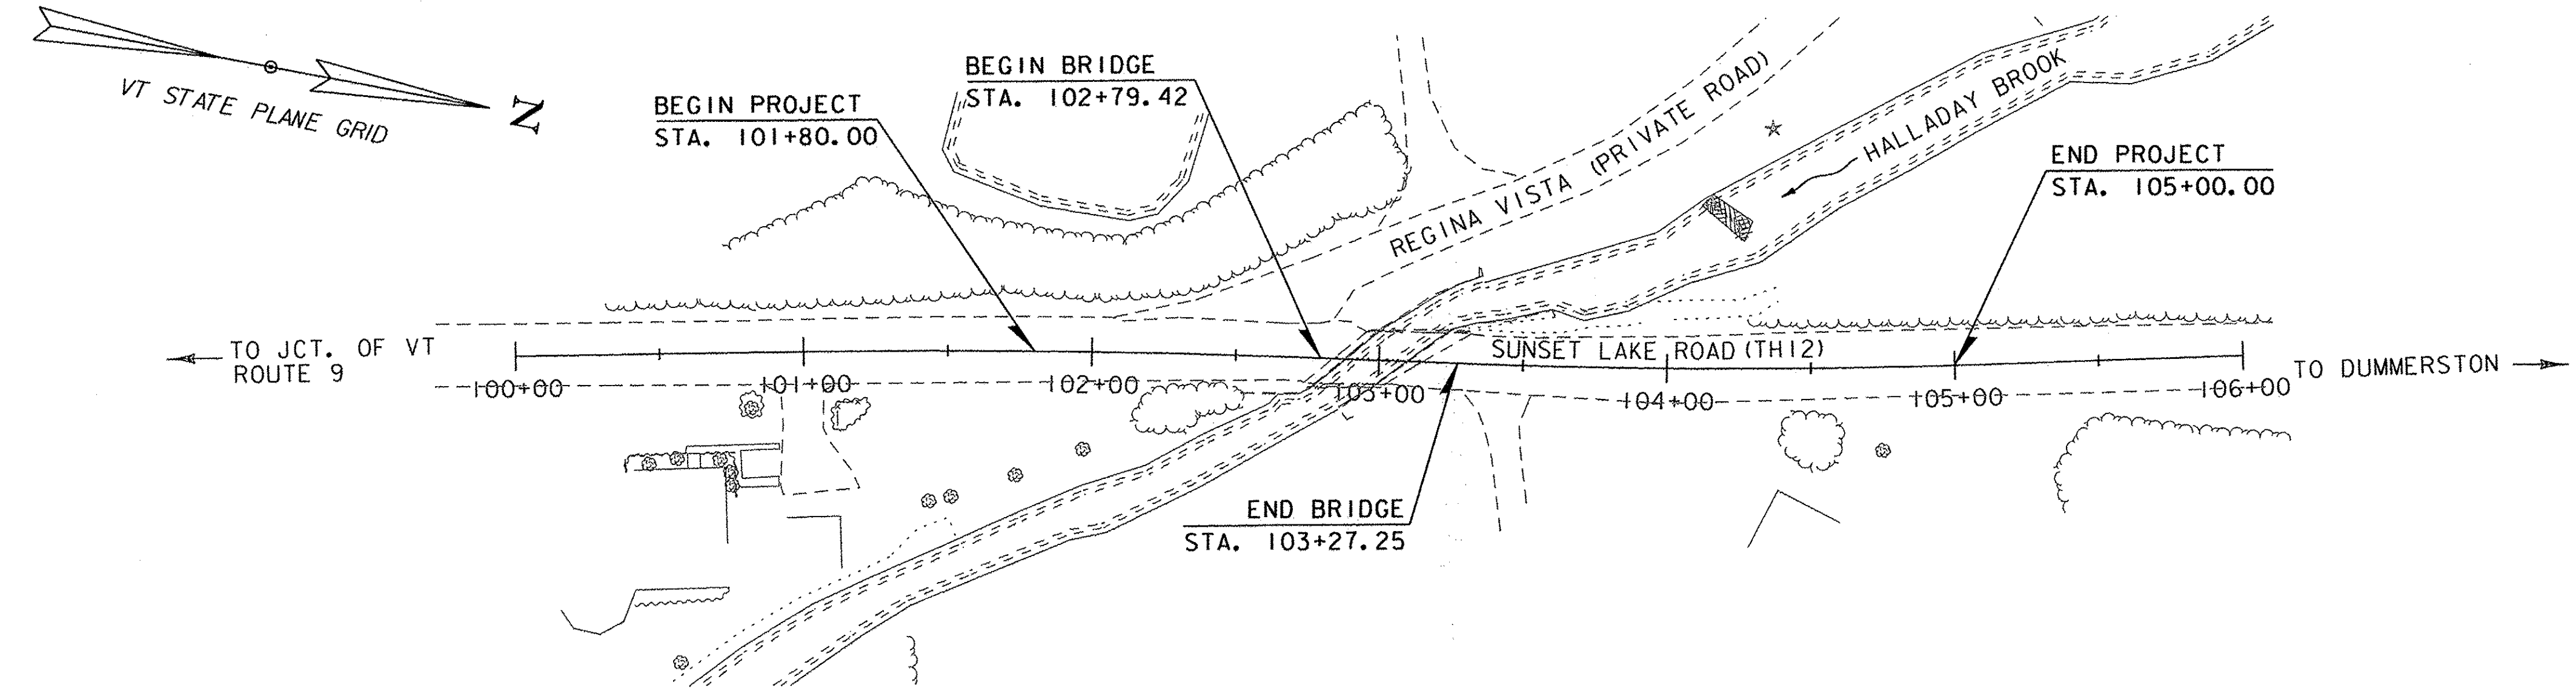

THESE PLANS ARE SUBJECT TO SUCH ENGINEERING CHANGES AS MAY BE REQUIRED BY THE FEDERAL HIGHWAY ADMINISTRATION OR THE DIRECTOR OF PROGRAM DEVELOPMENT.

CONSTRUCTION IS TO BE CARRIED ON IN ACCORDANCE WITH THESE PLANS AND THE STANDARD SPECIFICATIONS FOR CONSTRUCTION DATED 2011, AS APPROVED BY THE FEDERAL HIGHWAY ADMINISTRATION ON JULY 20, 2011 FOR USE ON THIS PROJECT, INCLUDING ALL SUBSEQUENT REVISIONS AND SUCH REVISED SPECIFICATIONS AND SPECIAL PROVISIONS AS ARE INCORPORATED IN THESE PLANS.

QUALITY ASSURANCE PROGRAM : LEVEL 2	
SURVEYED BY :	VHB
SURVEYED DATE :	NOV 2010
DATUM	
VERTICAL	NAVD 88
HORIZONTAL	NAD 83 (07)

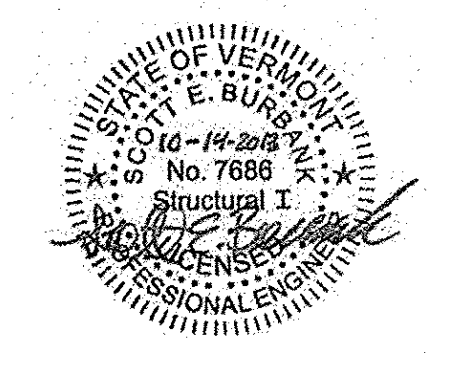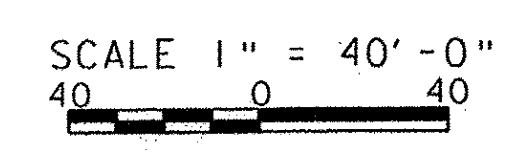

	DIRECTOR OF PROGRAM DEVELOPMENT
	APPROVED <i>Kevin A. Gammell</i> DATE <i>10/15/13</i>
	PROJECT MANAGER : TODD A. SUMNER, P.E.
	PROJECT NAME : BRATTLEBORO PROJECT NUMBER : BRO 1442 (35)
SHEET 1 OF 68 SHEETS	

PRELIMINARY INFORMATION SHEET (BRIDGE)

LRFD

INDEX OF SHEETS

PLAN SHEETS

1	TITLE SHEET
2	PRELIMINARY INFORMATION SHEET
3	TYPICAL BRIDGE SECTION
4	TYPICAL ROADWAY SECTIONS
5	TYPICAL EARTHWORK SECTIONS
6 - 7	PROJECT NOTES
8 - 9	QUANTITY SHEETS
10	BRIDGE QUANTITY SHEET
11	CONVENTIONAL SYMBOLOLOGY LEGEND
12	TIE SHEET
13	ALIGNMENT LAYOUT SHEET
14	LAYOUT SHEET
15	PROFILE SHEET
16 - 18	TRAFFIC CONTROL PLANS
19	PLANTING PLAN
20	PLANTING AREA 1 PLAN AND SCHEDULE
21	PLANTING AREA 2 PLAN AND SCHEDULE
22	PLANTING DETAILS
23	TRAFFIC SIGNS & LINE STRIPING SHEET
24	TRAFFIC SIGN SUMMARY SHEET
25	BORING INFORMATION SHEET
26 - 28	BORING LOGS
29	PLAN AND ELEVATION
30	FRAMING PLAN
31 - 32	NON-VOIDED SLAB DETAILS TYPE I
33 - 34	NON-VOIDED SLAB DETAILS TYPE II
35 - 36	NON-VOIDED SLAB DETAILS TYPE III
37	PRESTRESSED BEAM DETAILS
38	OVERLAY REINFORCING DETAILS
39	BEARING DETAILS
40	APPROACH SLAB DETAILS
41	ABUTMENT NO. 1 PLAN & ELEVATION
42	WINGWALL NO. 1 ELEVATION & DETAILS
43	WINGWALL NO. 2 ELEVATION & DETAILS
44	ABUTMENT NO. 1 FOOTING PLAN
45	ABUTMENT NO. 2 PLAN & ELEVATION
46	WINGWALL NO. 3 ELEVATION & DETAILS
47	WINGWALL NO. 4 ELEVATION & DETAILS
48	ABUTMENT NO. 2 FOOTING PLAN
49 - 50	REINFORCING STEEL SCHEDULES
51	BRIDGE RAIL DETAILS
52	BRIDGE RAIL LAYOUT SHEET
53 - 56	ROADWAY CROSS SECTIONS
57 - 59	CHANNEL CROSS SECTIONS
60	EPSC NARRATIVE
61	EPSC EXISTING CONDITIONS PLAN
62	EPSC CONSTRUCTION CONDITIONS PLAN
63	EPSC FINAL CONDITIONS PLAN
64 - 66	EROSION CONTROL DETAILS
67	R.O.W. DETAIL SHEET #1
68	ROW LAYOUT SHEET 1 OF 1

STANDARDS LIST

E-121	STANDARD SIGN PLACEMENT - CONVENTIONAL ROAD	08-06-1995
G-1	STEEL BEAM GUARDRAIL DETAILS (POST, DELINEATOR, TYPICALS)	01-03-2000
G-1D	STEEL BEAM GUARDRAIL DETAILS (END TERMINAL, ANCHOR, MEDIAN)	01-03-2000
S-367B	GUARDRAIL APPROACH SECTION, GALVANIZED HD STEEL BEAM	05-24-2012
T-1	TRAFFIC CONTROL GENERAL NOTES	08-06-2012
T-10	CONVENTIONAL ROADS CONSTRUCTION APPROACH SIGNING	08-06-2012
T-30	CONSTRUCTION SIGN DETAILS	08-06-2012
T-35	CONSTRUCTION ZONE LONGITUDINAL DROP-OFFS	08-06-2012
T-36	CONSTRUCTION ZONE LONGITUDINAL DROP-OFFS FOR PAVING	08-06-2012

FINAL HYDRAULIC REPORT

HYDROLOGIC DATA

Date: 5/31/2013

DRAINAGE AREA : 5.5 sq. mi.
 CHARACTER OF TERRAIN : Hilly to mountainous, mostly forested
 STREAM CHARACTERISTICS : Sinuous, slightly incised with minimal floodplain
 NATURE OF STREAMBED : Gravel, cobbles, boulders and ledge

PEAK FLOW DATA

Q 2.33 =	300 cfs	Q 50 =	1100 cfs
Q 10 =	650 cfs	Q 100 =	1275 cfs
Q 25 =	900 cfs	Q 500 =	1785 cfs

DATE OF FLOOD OF RECORD 1927
 ESTIMATED DISCHARGE: Unknown
 WATER SURFACE ELEV.: Unknown
 NATURAL STREAM VELOCITY: @ Q25 = 5.8 fps
 ICE CONDITIONS : Moderate
 DEBRIS: Moderate
 DOES THE STREAM REACH MAXIMUM HIGHWATER ELEV. RAPIDLY? Yes
 IS ORDINARY RISE RAPID? Yes
 IS STAGE AFFECTED BY UPSTREAM OR DOWNSTREAM CONDITIONS? No
 IF YES, DESCRIBE:

WATERSHED STORAGE: < 1 % HEADWATERS:
 UNIFORM: X
 IMMEDIATELY ABOVE SITE:

EXISTING STRUCTURE INFORMATION

STRUCTURE TYPE: Single span concrete encased steel beam bridge
 YEAR BUILT: 1920
 CLEAR SPAN(NORMAL TO STREAM): 11'-6"
 VERTICAL CLEARANCE ABOVE STREAMBED: 5'-0"
 WATERWAY OF FULL OPENING: 54.5 sq. ft.
 DISPOSITION OF STRUCTURE: Remove and replace structure
 TYPE OF MATERIAL UNDER SUBSTRUCTURE: See borings

WATER SURFACE ELEVATIONS AT:

Q2.33 =	538.1 ft	VELOCITY =	9.1 fps
Q10 =	542.1 ft	"	9.5 fps
Q25 =	542.6 ft	"	9.7 fps
Q50 =	542.7 ft	"	10.8 fps
Q100 =	543.1 ft	"	8.5 fps

LONG TERM STREAMBED CHANGES: None noted

IS THE ROADWAY OVERTOPPED BELOW Q100: Yes
 FREQUENCY: Q10
 RELIEF ELEVATION: 539.6
 DISCHARGE OVER ROAD @Q100: 182 cfs

UPSTREAM STRUCTURE

TOWN: Brattleboro DISTANCE: 8450 ft
 HIGHWAY #: TH 4 (Halladay Brook Road) STRUCTURE #: 16
 CLEAR SPAN: 20' CLEAR HEIGHT: 9'
 YEAR BUILT: 2005 FULL WATERWAY:
 STRUCTURE TYPE: Single span concrete slab

DOWNSTREAM STRUCTURE

TOWN: Brattleboro DISTANCE: 1340'
 HIGHWAY #: Private Road (Winding Hill Road) STRUCTURE #: Private
 CLEAR SPAN: CLEAR HEIGHT:
 YEAR BUILT: FULL WATERWAY:
 STRUCTURE TYPE:

LRFR LOAD RATING FACTORS

LOADING LEVELS	TRUCK						
	H-20	HL-93	3S2	6 AXLE	3A STR.	4A STR.	5A SEMI
TONNAGE	20	36	36	66	30	34.5	38
INVENTORY	2.59	1.27					
POSTING							
OPERATING	3.84	1.91	3.39	1.41	2.38	2	2.48
COMMENTS:							

PROPOSED STRUCTURE

STRUCTURE TYPE: Single span precast, prestressed concrete non-voided slab bridge

CLEAR SPAN(NORMAL TO STREAM): 25'-0"
 VERTICAL CLEARANCE ABOVE STREAMBED: 6'-0"
 WATERWAY OF FULL OPENING: 129.4 sq. ft.

WATER SURFACE ELEVATIONS AT:

Q2.33 =	536.3 ft	VELOCITY =	8.4 fps
Q10 =	537.9 ft	"	9.8 fps
Q25 =	538.8 ft	"	10.5 fps
Q50 =	539.5 ft	"	11.2 fps
Q100 =	541.2 ft	"	9.3 fps

IS THE ROADWAY OVERTOPPED BELOW Q100: No
 FREQUENCY: Above Q100
 RELIEF ELEVATION: 541.1 ft
 DISCHARGE OVER ROAD @Q100: None

AVERAGE LOW ELEVATION OF SUPERSTRUCTURE: 539.2 ft
 VERTICAL CLEARANCE: @ Q25 = 0.4 ft

SCOUR: Footings are bearing on bedrock

REQUIRED CHANNEL PROTECTION: Stone Fill, Type III

PERMIT INFORMATION

AVERAGE DAILY FLOW: 10 cfs DEPTH OR ELEVATION:
 ORDINARY LOW WATER: 2 cfs 0.5 ft
 ORDINARY HIGH WATER: 80 cfs 2.0 ft

TEMPORARY BRIDGE REQUIREMENTS

STRUCTURE TYPE: Single span bridge*
 CLEAR SPAN (NORMAL TO STREAM): 44'-0"
 VERTICAL CLEARANCE ABOVE STREAMBED: 4'-0"
 WATERWAY AREA OF FULL OPENING: 176 sq. ft.

ADDITIONAL INFORMATION

*The temporary bridge may be in place through the winter.

TRAFFIC MAINTENANCE NOTES

1. MAINTAIN ONE-WAY ALTERNATING TRAFFIC ON A TEMPORARY BRIDGE.
2. TRAFFIC SIGNALS ARE NECESSARY.
3. SIDEWALKS ARE NOT NECESSARY.
4. THE APPROACHES FOR THE TEMPORARY BRIDGE SHALL BE PAVED.

DESIGN VALUES

1. DESIGN LIVE LOAD	HL-93
2. FUTURE PAVEMENT	d _p : 3.0 INCH
3. DESIGN SPAN	L: 45.00 FT
4. MIN. MID-SPAN POS. CAMBER @ RELEASE (PRESTRESSED UNITS)	Δ: SEE NOTES
5. PRESTRESSING STRAND (0.60 INCH DIAMETER - LOWRELAX)	f _y : 270 KSI
6. PRESTRESSED CONCRETE STRENGTH	f' _c : 6.0 KSI
7. PRESTRESSED CONCRETE RELEASE STRENGTH	f' _{cr} : 4.8 KSI
8. CONCRETE, HIGH PERFORMANCE CLASS AA	f' _c : 4.0 KSI
9. CONCRETE, HIGH PERFORMANCE CLASS A	f' _c : 4.0 KSI
10. CONCRETE, HIGH PERFORMANCE CLASS B	f' _c : 3.5 KSI
11. CONCRETE, CLASS C	f' _c : ---
12. REINFORCING STEEL	f _y : 60 KSI
13. STRUCTURAL STEEL AASHTO M270	f _y : ---
14. SOIL UNIT WEIGHT	γ: 0.140 KCF
15. NOMINAL BEARING RESISTANCE OF SOIL	q _n : ---
16. SOIL BEARING RESISTANCE FACTOR (REFER TO AASHTO LRFD)	φ: ---
17. NOMINAL BEARING RESISTANCE OF ROCK	q _n : 70.0 KSF
18. ROCK BEARING RESISTANCE FACTOR (REFER TO AASHTO LRFD)	φ: 0.45
19. NOMINAL AXIAL PILE RESISTANCE	q _p : ---
20. PILE YIELD STRENGTH ASTM A572	f _y : ---
21. PILE SIZE	---
22. EST. PILE LENGTH	L _p : ---
23. PILE RESISTANCE FACTOR	φ: ---
24. LATERAL PILE DEFLECTION	Δ: ---
25. BASIC WIND SPEED	V _{3s} : ---
26. MINIMUM GROUND SNOW LOAD	p _g : ---
27. SEISMIC DATA	PGA: --- S _s : --- S ₁ : ---

STRUCTURES DETAILS

SD-501.00	CONCRETE DETAILS AND NOTES	05-10-2010
SD-502.00	CONCRETE DETAILS AND NOTES	06-04-2010
SD-516.10	BRIDGE JOINT ASPHALTIC PLUG	05-07-2010


AS BUILT "REBAR" DETAIL		
LEVEL I	LEVEL II	LEVEL III
TYPE:	TYPE:	TYPE:
GRADE:	GRADE:	GRADE:

TRAFFIC DATA


YEAR	ADT	DHV	% D	% T	ADTT
2012	460	50	76	2.1	10
2032	490	55	76	3.6	20

20 year ESAL for flexible pavement from 2012 to 2032 : 40000
 40 year ESAL for flexible pavement from 2012 to 2052 : 93000
 Design Speed : 25 mph

TEMPORARY BRIDGE PROFILE ALONG TEMP CL

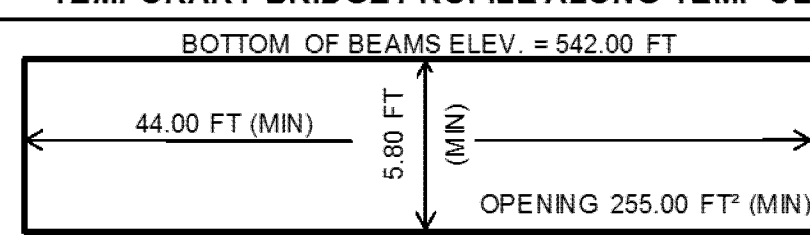


PROJECT NAME: BRATTLEBORO
 PROJECT NUMBER: BRO 1442(35)
 FILE NAME: z10j062pi.dgn PLOT DATE: 10/14/2013
 PROJECT LEADER: S.E. BURBANK DRAWN BY: E.A. FIALA
 DESIGNED BY: VHB CHECKED BY: S.E. BURBANK
 PRELIMINARY INFORMATION SHEET SHEET 2 OF 68

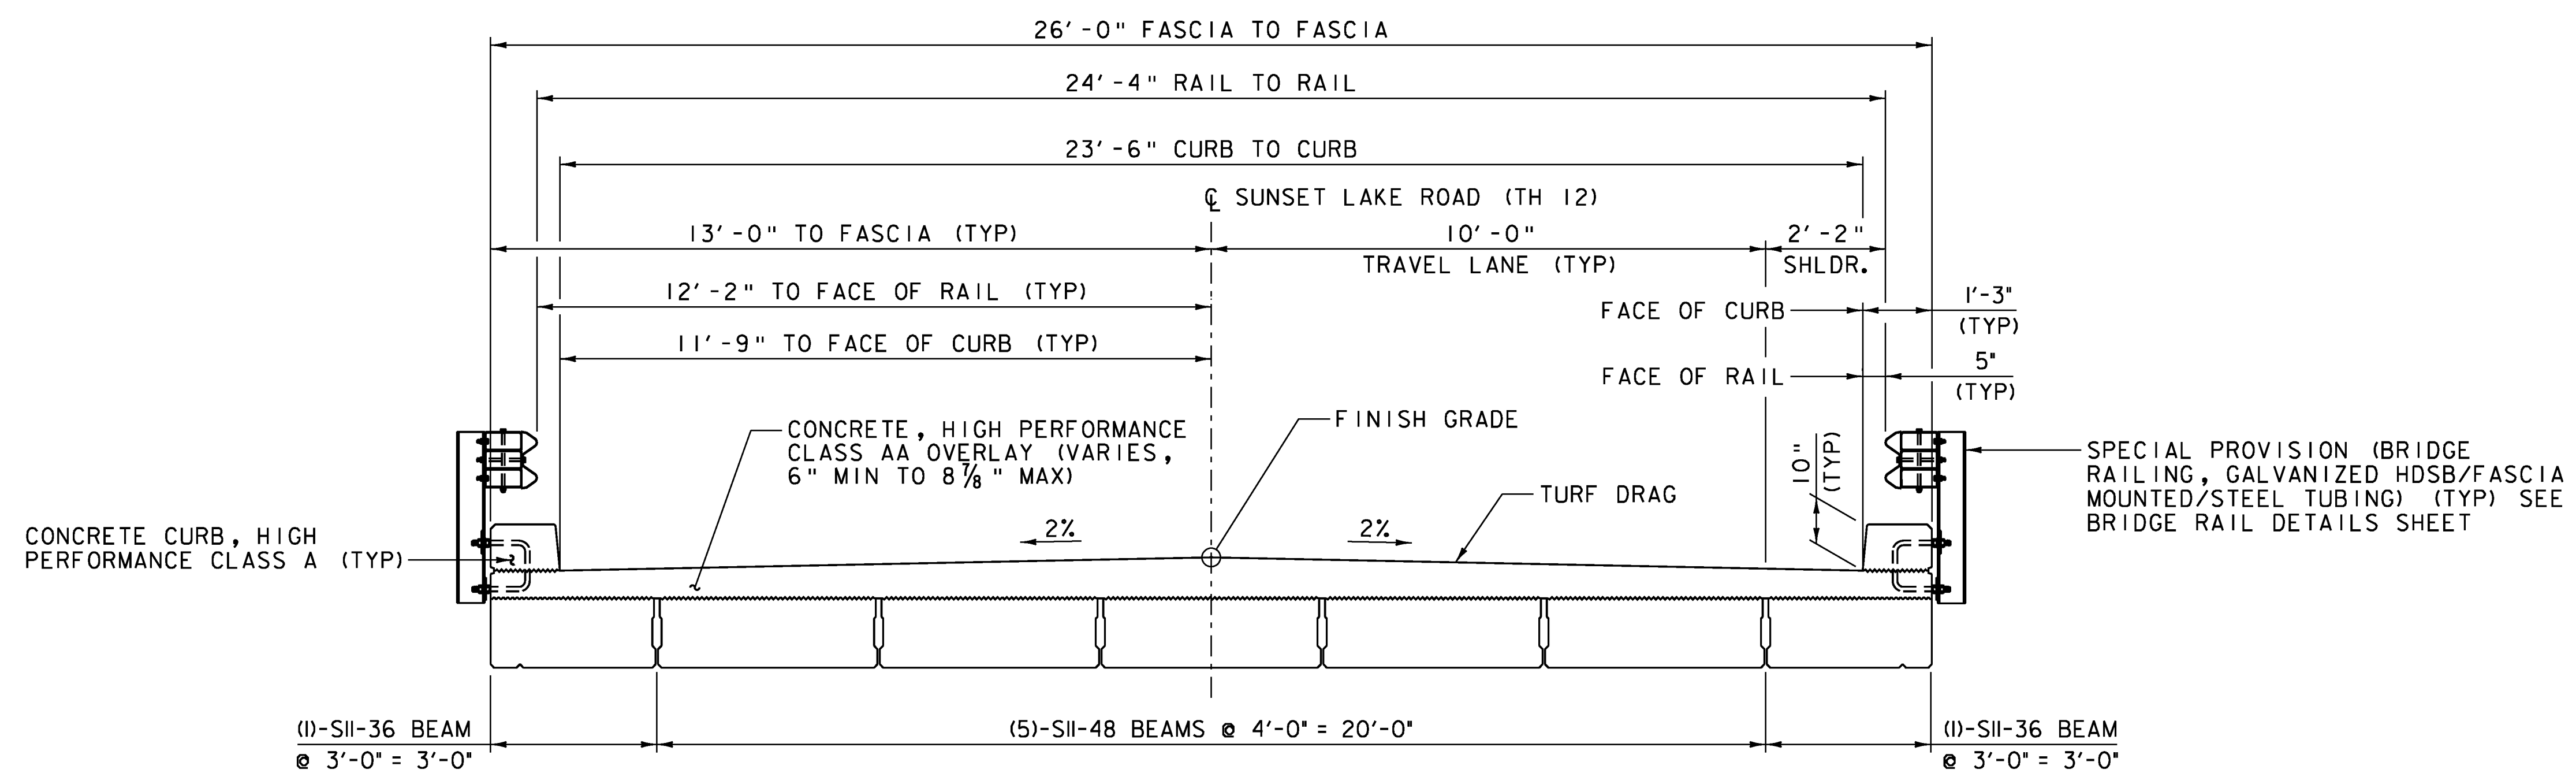

TYPICAL BRIDGE SECTION
SCALE 1/2" = 1'-0"


PROJECT NAME: BRATTLEBORO	PLOT DATE: 10/14/2013
PROJECT NUMBER: BRO 1442(35)	DRAWN BY: B.J. MASSE
FILE NAME: z10j062+yp.dgn	CHECKED BY: S.E. BURBANK
PROJECT LEADER: S.E. BURBANK	SHEET 3 OF 68
DESIGNED BY: S.E. BURBANK	
TYPICAL BRIDGE SECTION	

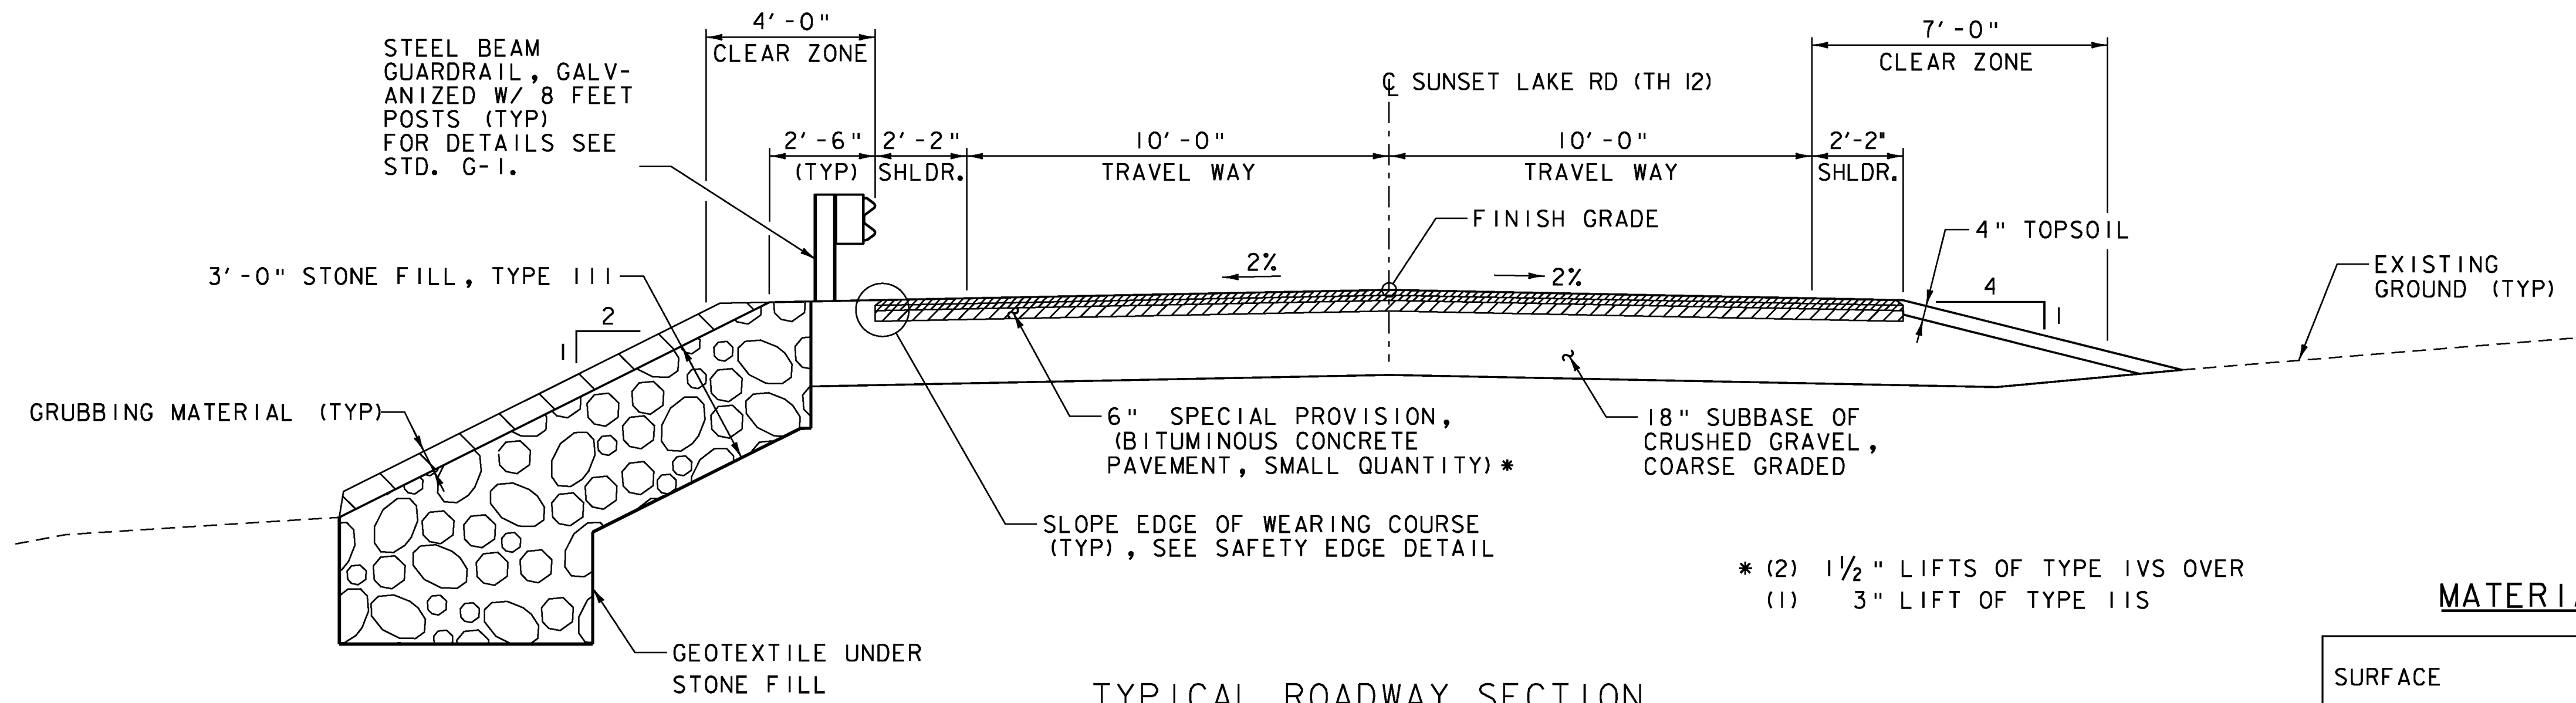

TYPICAL ROADWAY SECTION
SCALE 3/8" = 1'-0"


MATERIAL TOLERANCES

SURFACE	TOLERANCE
- PAVEMENT (TOTAL THICKNESS)	+/- 1/4"
- SUBBASE	+/- 1"

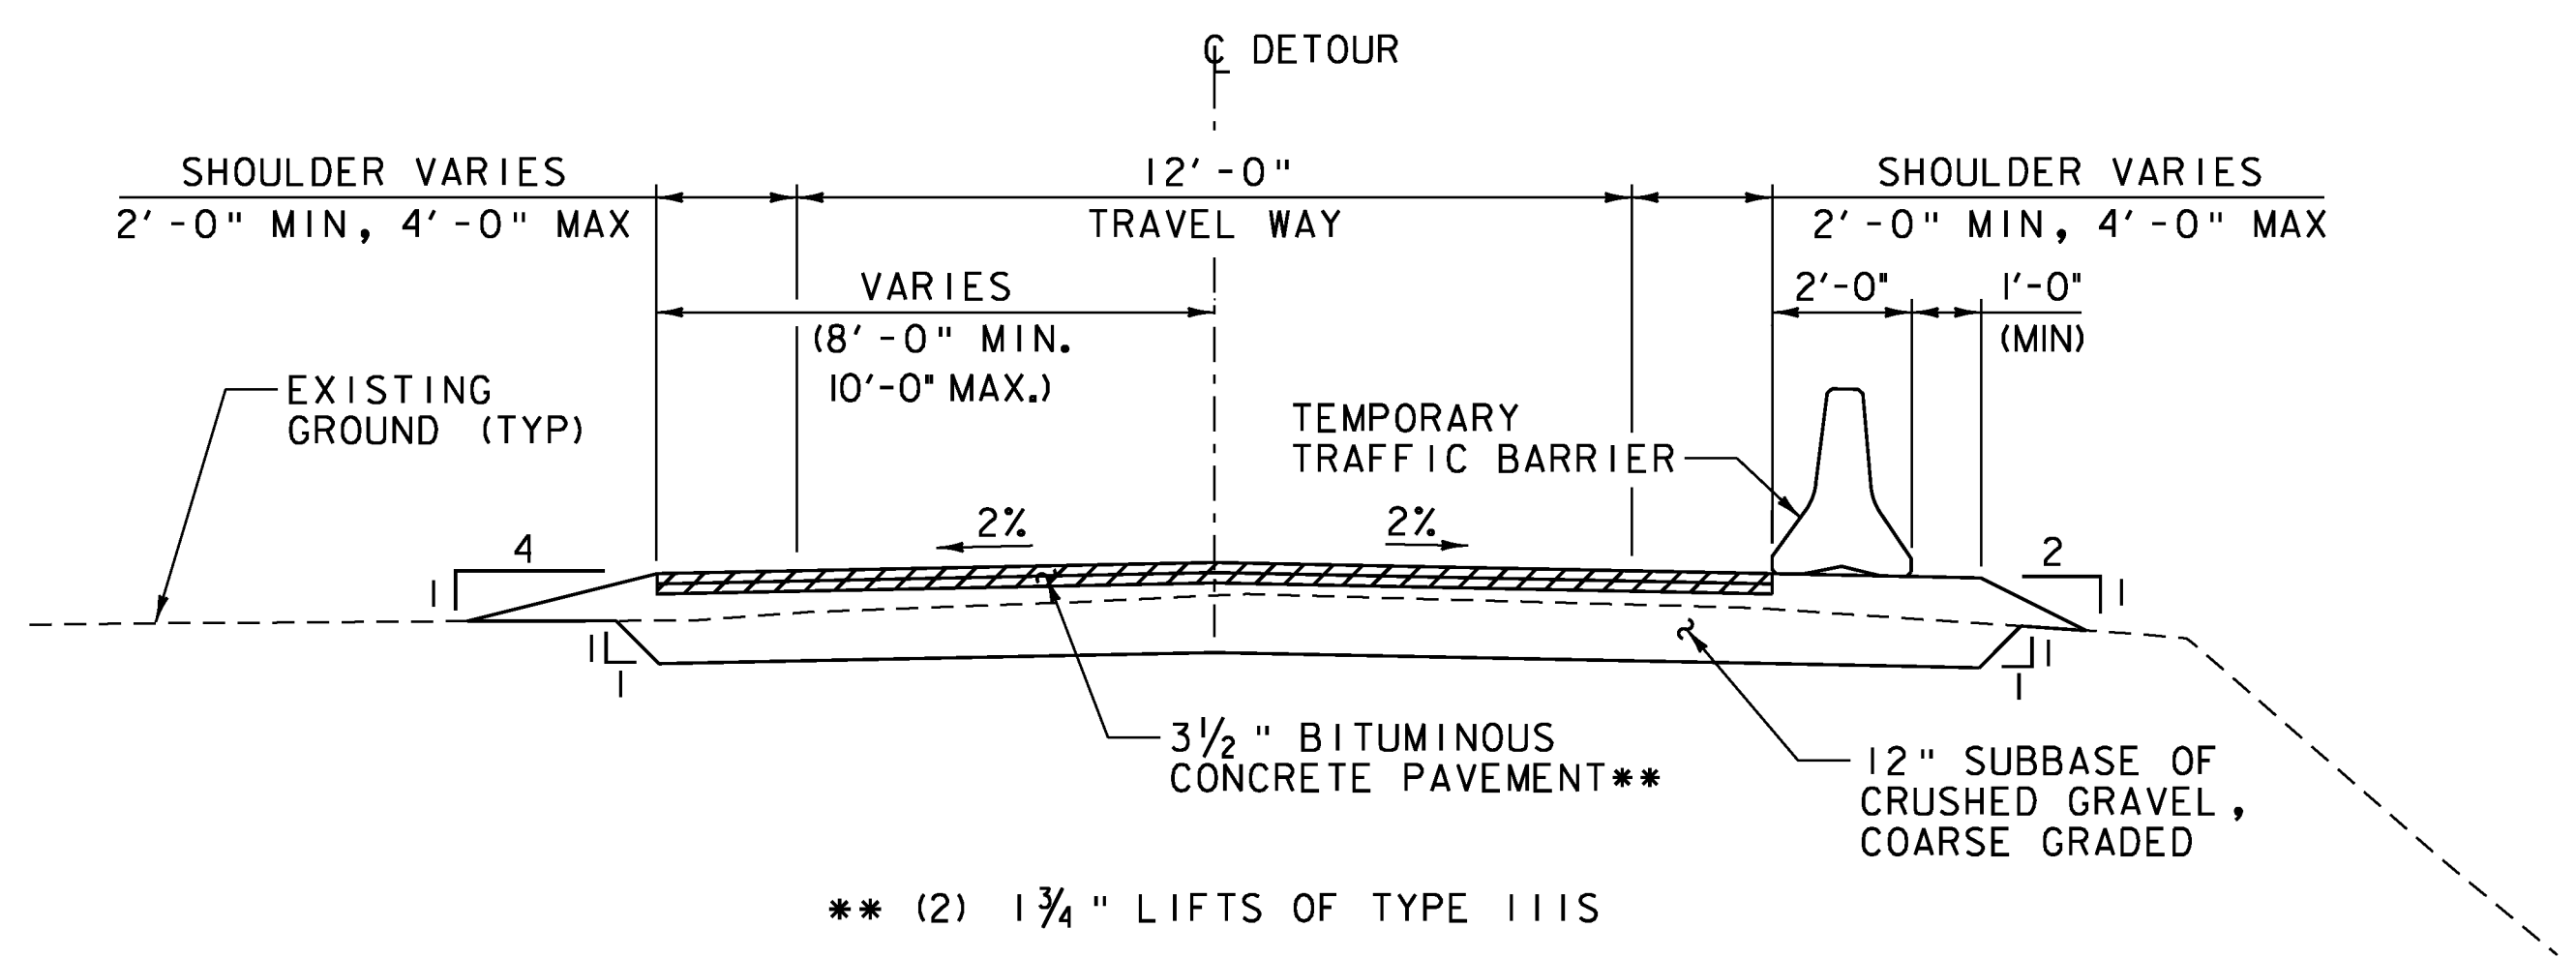


NOTE: ALL WORK ASSOCIATED WITH THE INSTALLATION AND REMOVAL OF THE DETOUR WILL BE INCLUDED IN THE UNIT PRICE BID FOR CONTRACT ITEM 528.10.

TYPICAL ONE-WAY DETOUR ROADWAY SECTION
SCALE 3/8" = 1'-0"

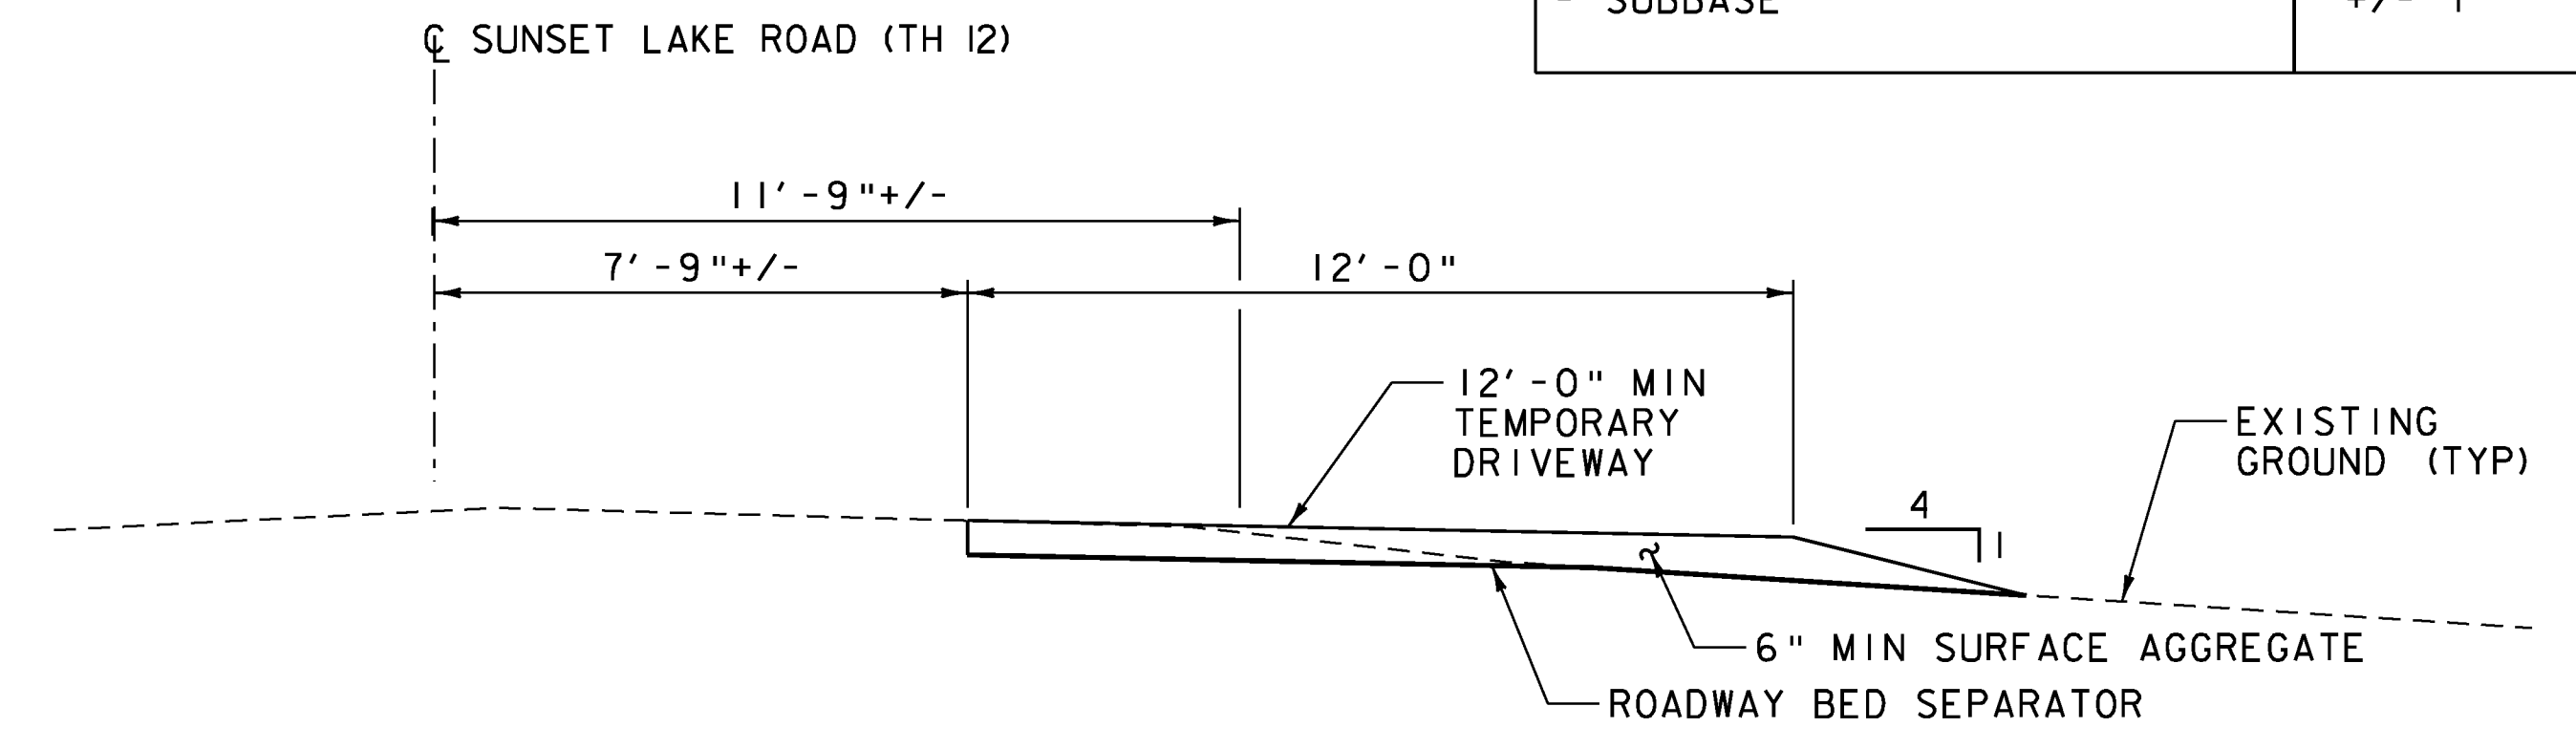


NOTE: ALL WORK ASSOCIATED WITH THE INSTALLATION AND REMOVAL OF THE TEMPORARY DRIVEWAY WILL BE INCLUDED IN THE UNIT PRICE BID FOR CONTRACT ITEM 528.10.

TYPICAL TEMPORARY DRIVEWAY SECTION
SCALE 3/8" = 1'-0"

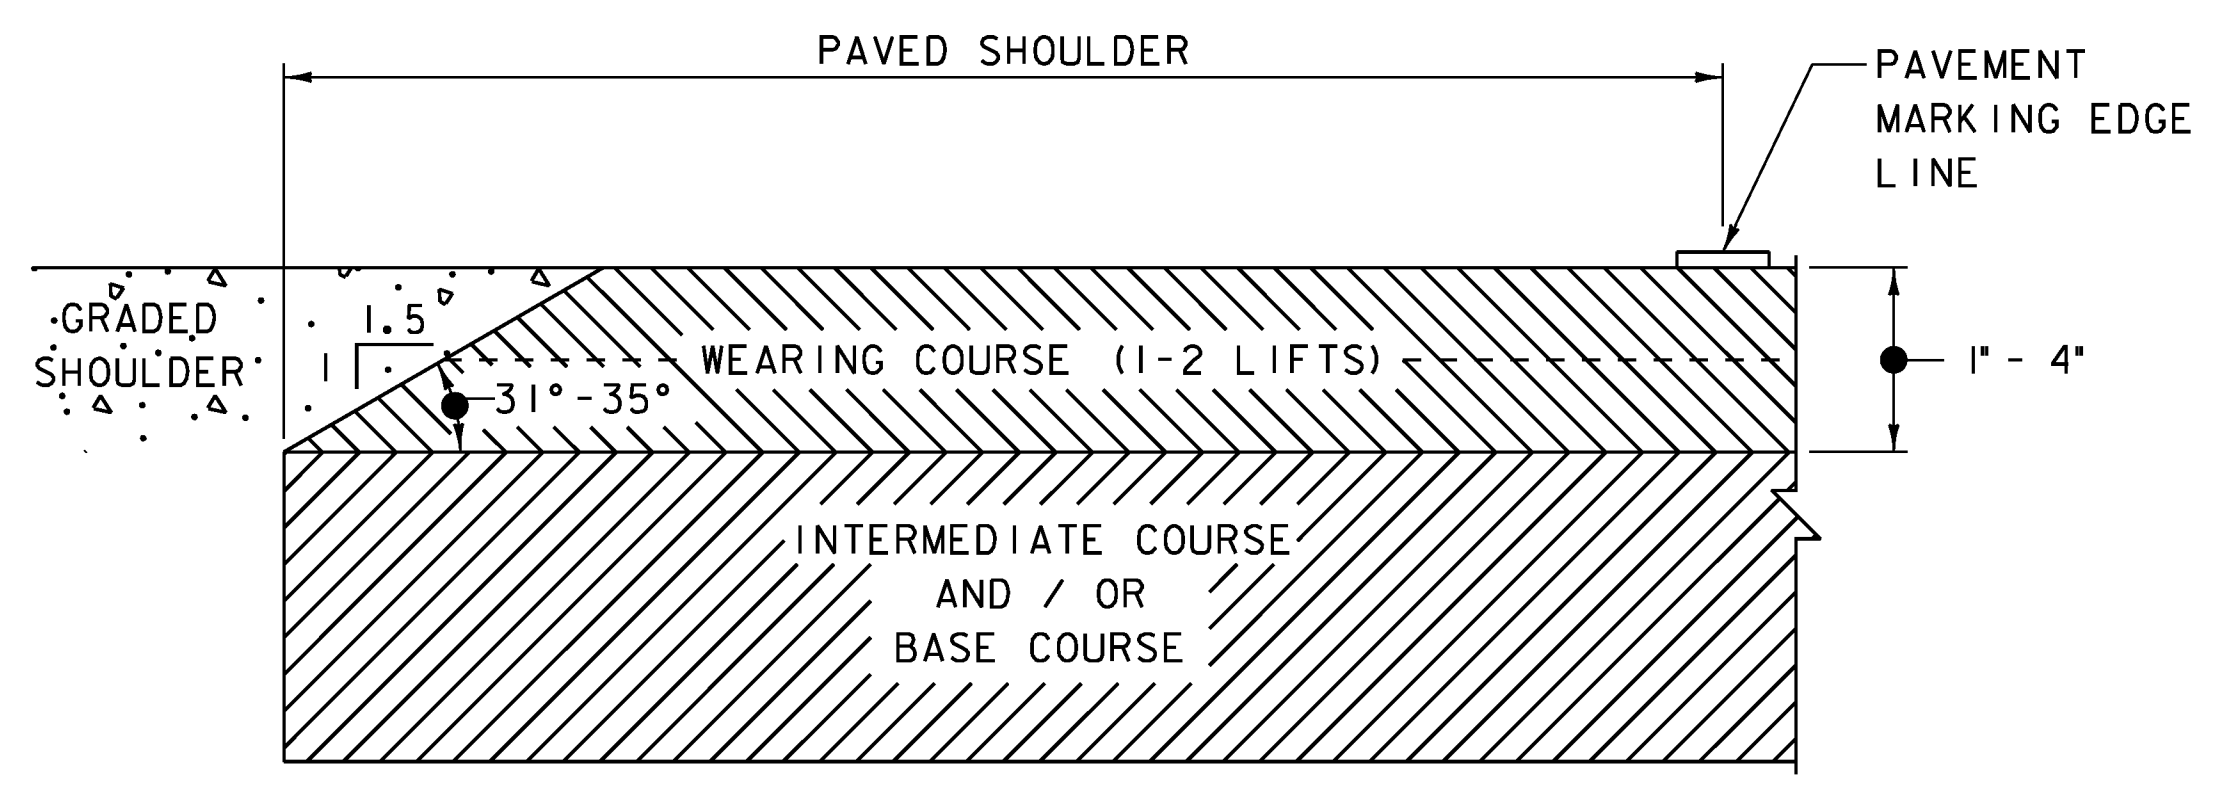

NOTE: COST FOR FORMING AND COMPACTING SAFETY EDGE SHALL BE INCIDENTAL TO ITEM 900.680, "SPECIAL PROVISION (BITUMINOUS CONCRETE PAVEMENT, SMALL QUANTITY)".

SAFETY EDGE DETAIL
NOT TO SCALE

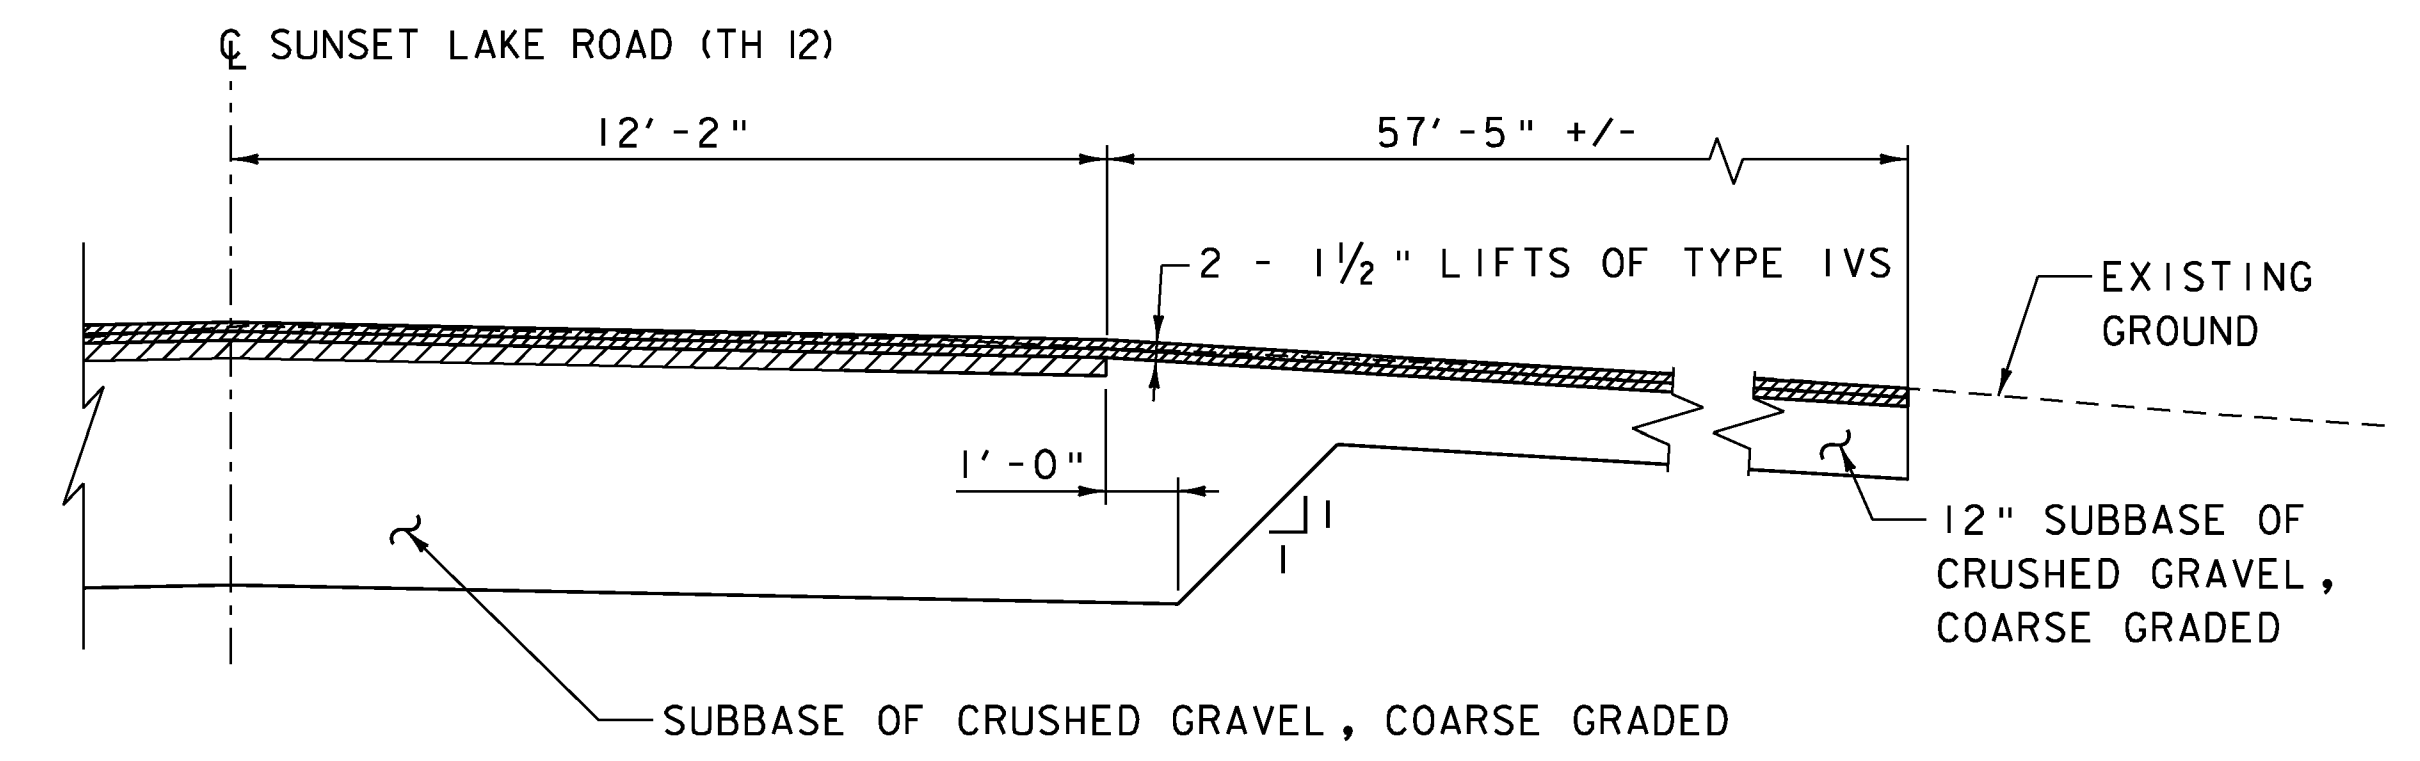


NOTE: SEE TYPICAL ROADWAY SECTION FOR INFORMATION NOT SHOWN.


TYPICAL DRIVEWAY SECTION
SCALE 3/8" = 1'-0"

PROJECT NAME: BRATTLEBORO	PLOT DATE: 10/14/2013
PROJECT NUMBER: BRO 1442(35)	DRAWN BY: B.J. MASSE
FILE NAME: z10j062+yp.dgn	CHECKED BY: S.E. BURBANK
PROJECT LEADER: S.E. BURBANK	SHEET 4 OF 68
DESIGNED BY: S.E. BURBANK	
TYPICAL ROADWAY SECTIONS	



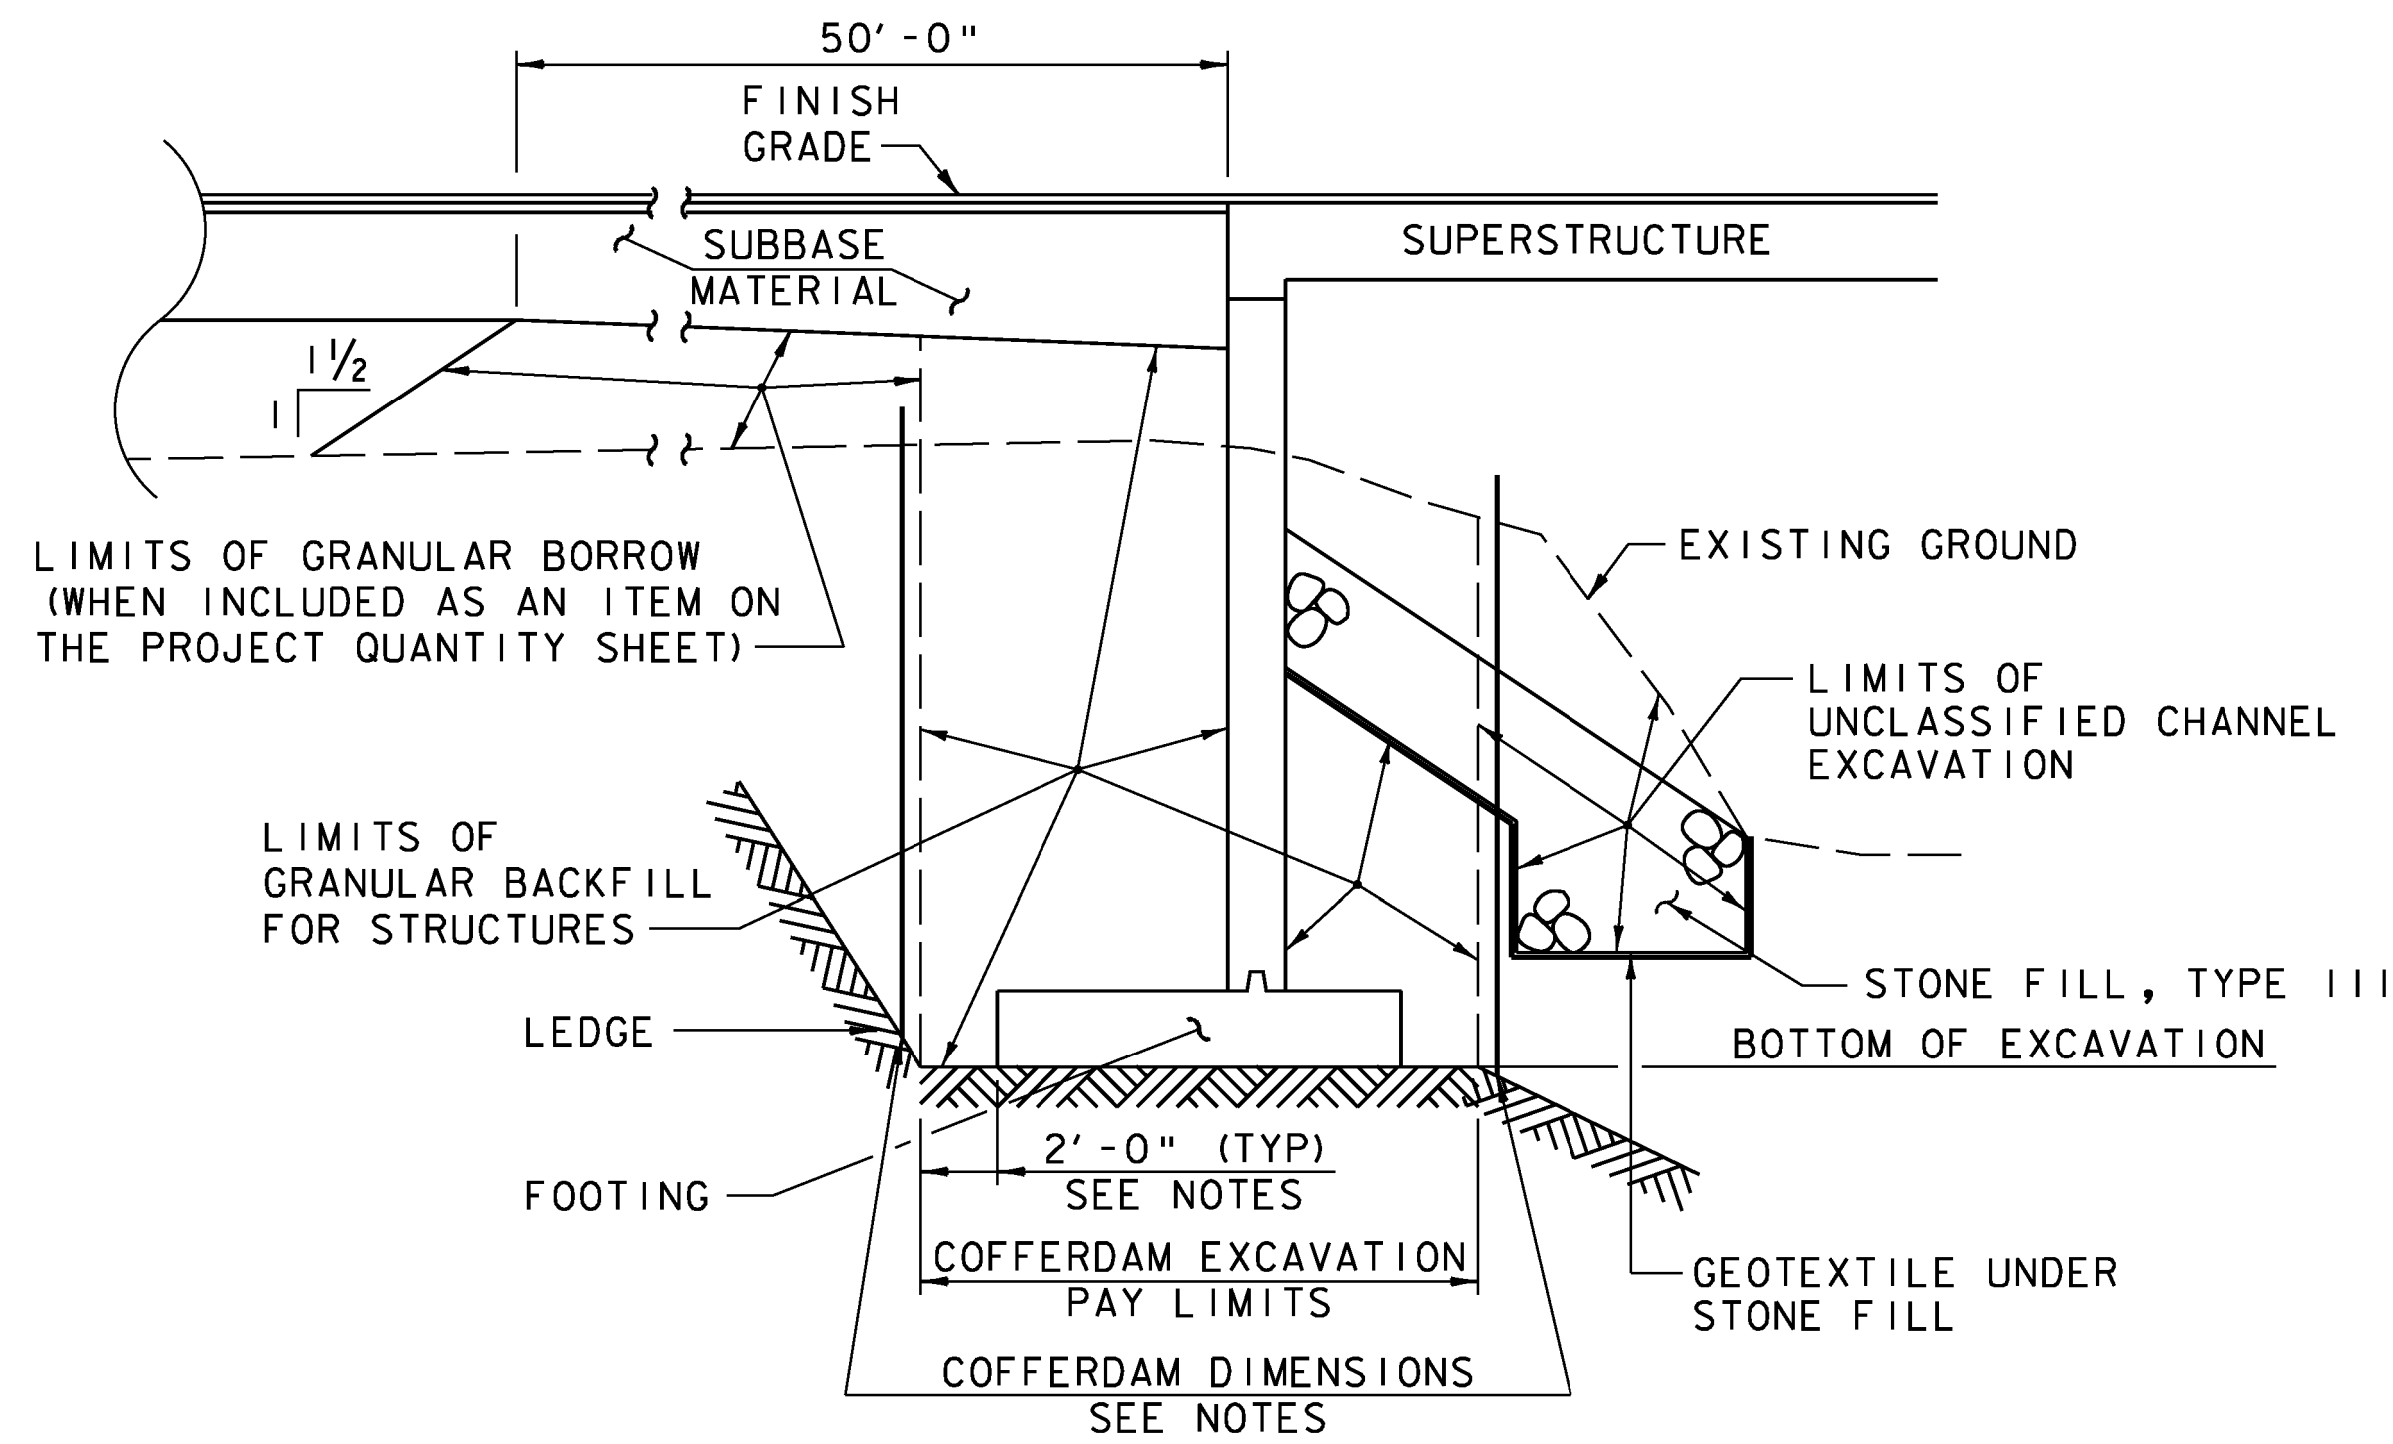


COFFERDAM AND EARTHWORK SECTION
(NOT TO SCALE)

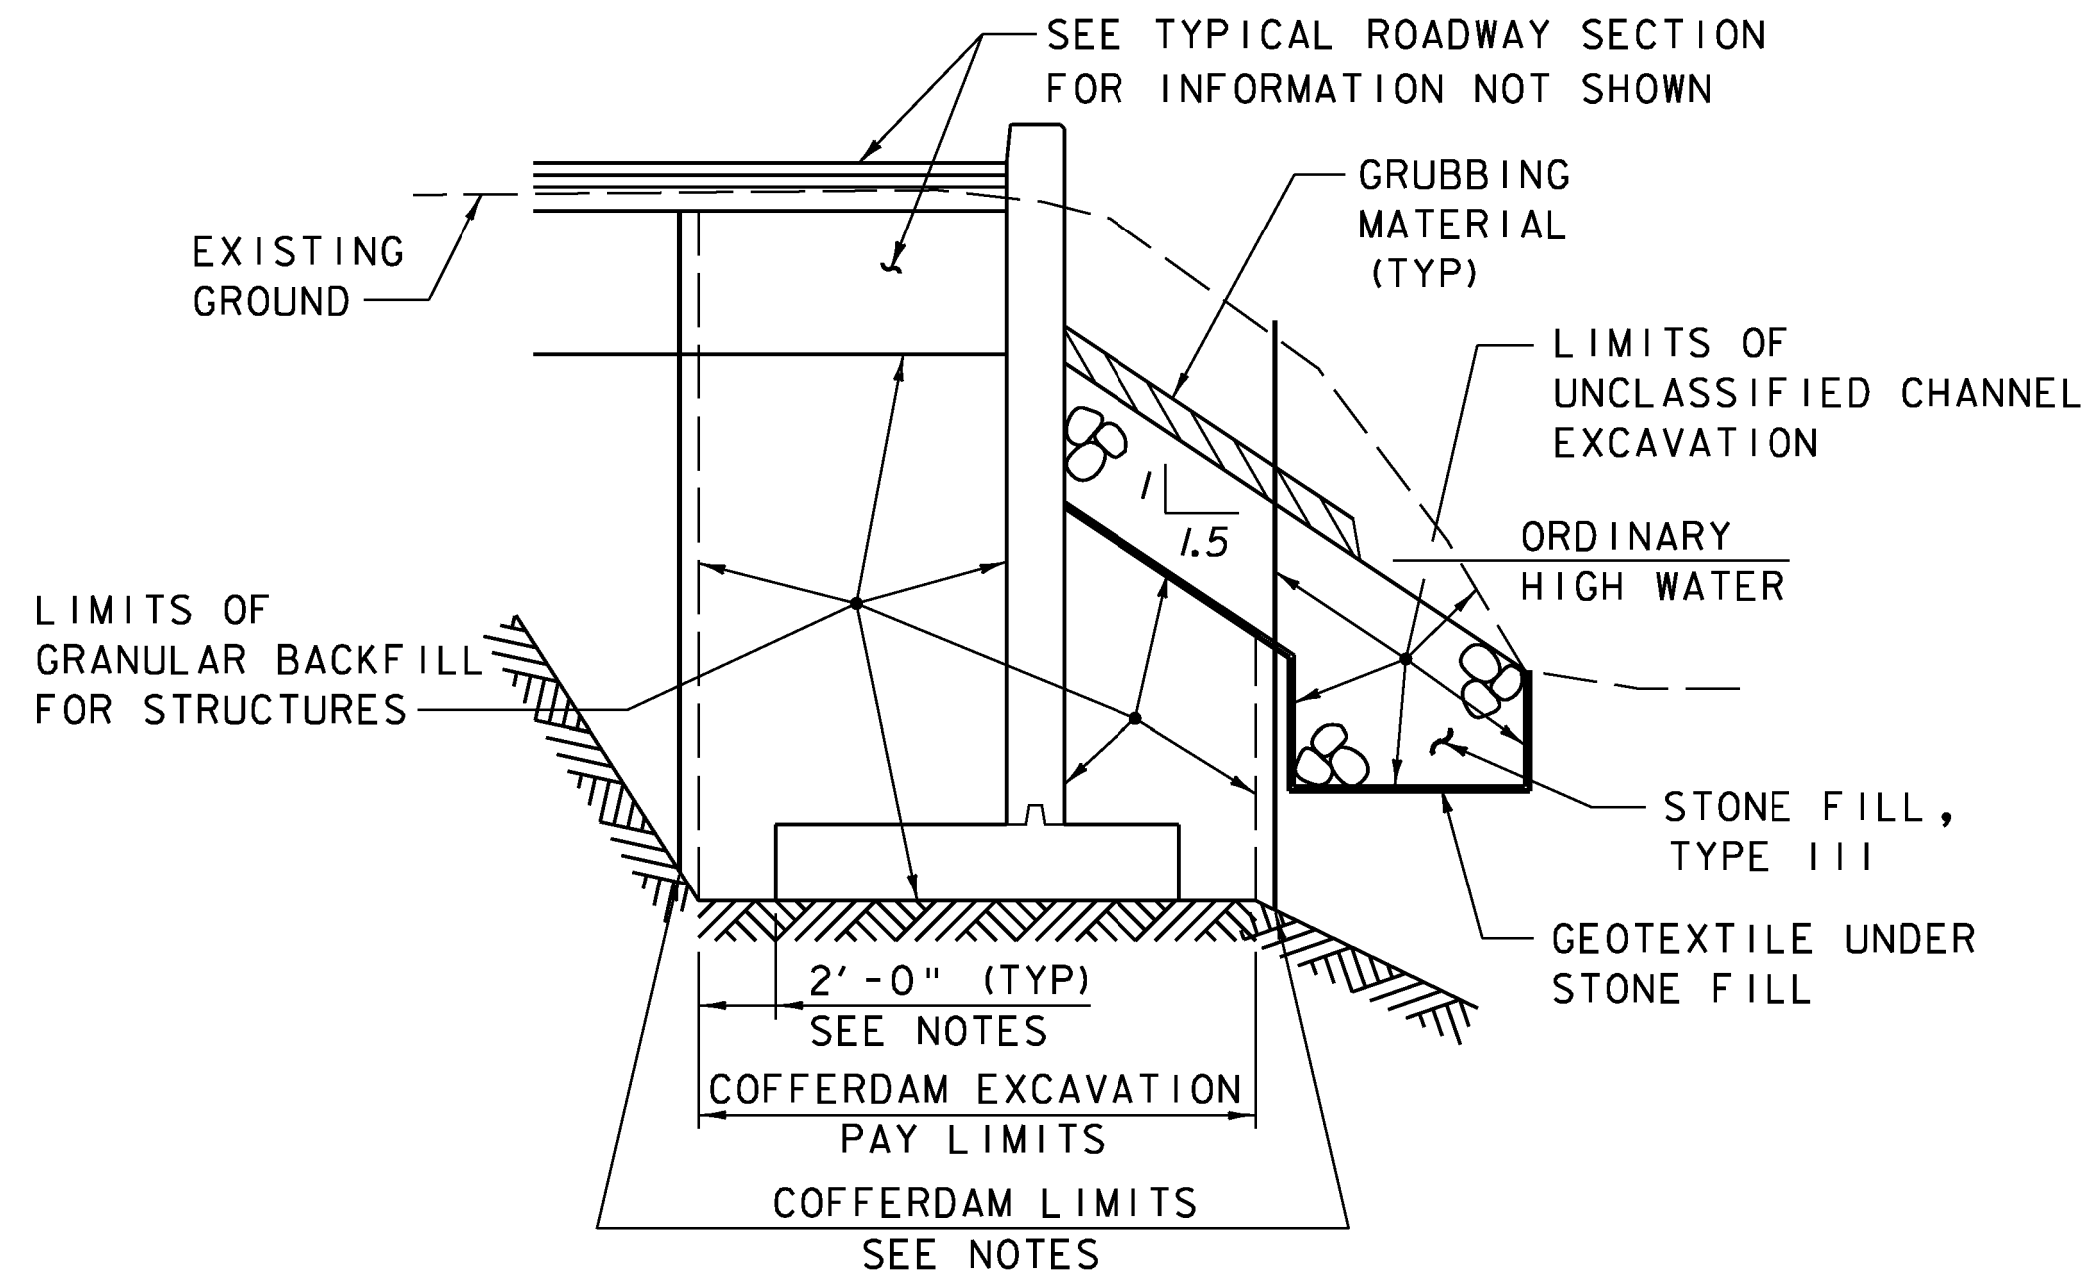


TYPICAL WINGWALL SECTION
(NOT TO SCALE)

- COFFERDAM NOTES**
1. COFFERDAM DIMENSIONS TO BE DETERMINED BY THE CONTRACTOR.
 2. THE PAY LIMITS OF EITHER "COFFERDAM EXCAVATION, EARTH" OR "COFFERDAM EXCAVATION, ROCK" SHALL BE 2'-0" OUTSIDE THE PERIMETER OF THE FOOTING AND FROM BOTTOM OF EXCAVATION UP TO THE EXISTING GROUND OR BOTTOM OF SUBBASE, WHICHEVER IS LOWER.
 3. IF A COFFERDAM IS CONSTRUCTED WHICH IS LARGER THAN THE INDICATED COFFERDAM EXCAVATION PAY LIMITS, PAYMENT FOR ALL UNCLASSIFIED CHANNEL EXCAVATION, INCLUDING THAT PORTION WHICH IS INSIDE THE COFFERDAM BUT OUTSIDE THE COFFERDAM PAY LIMITS, WILL BE MADE AT THE CONTRACT UNIT PRICE FOR UNCLASSIFIED CHANNEL EXCAVATION. NO MEASUREMENT AND PAYMENT WILL BE MADE FOR COFFERDAM EXCAVATION AND GRANULAR BACKFILL FOR STRUCTURES OUTSIDE THE PAY LIMITS DEFINED IN NOTE 2.

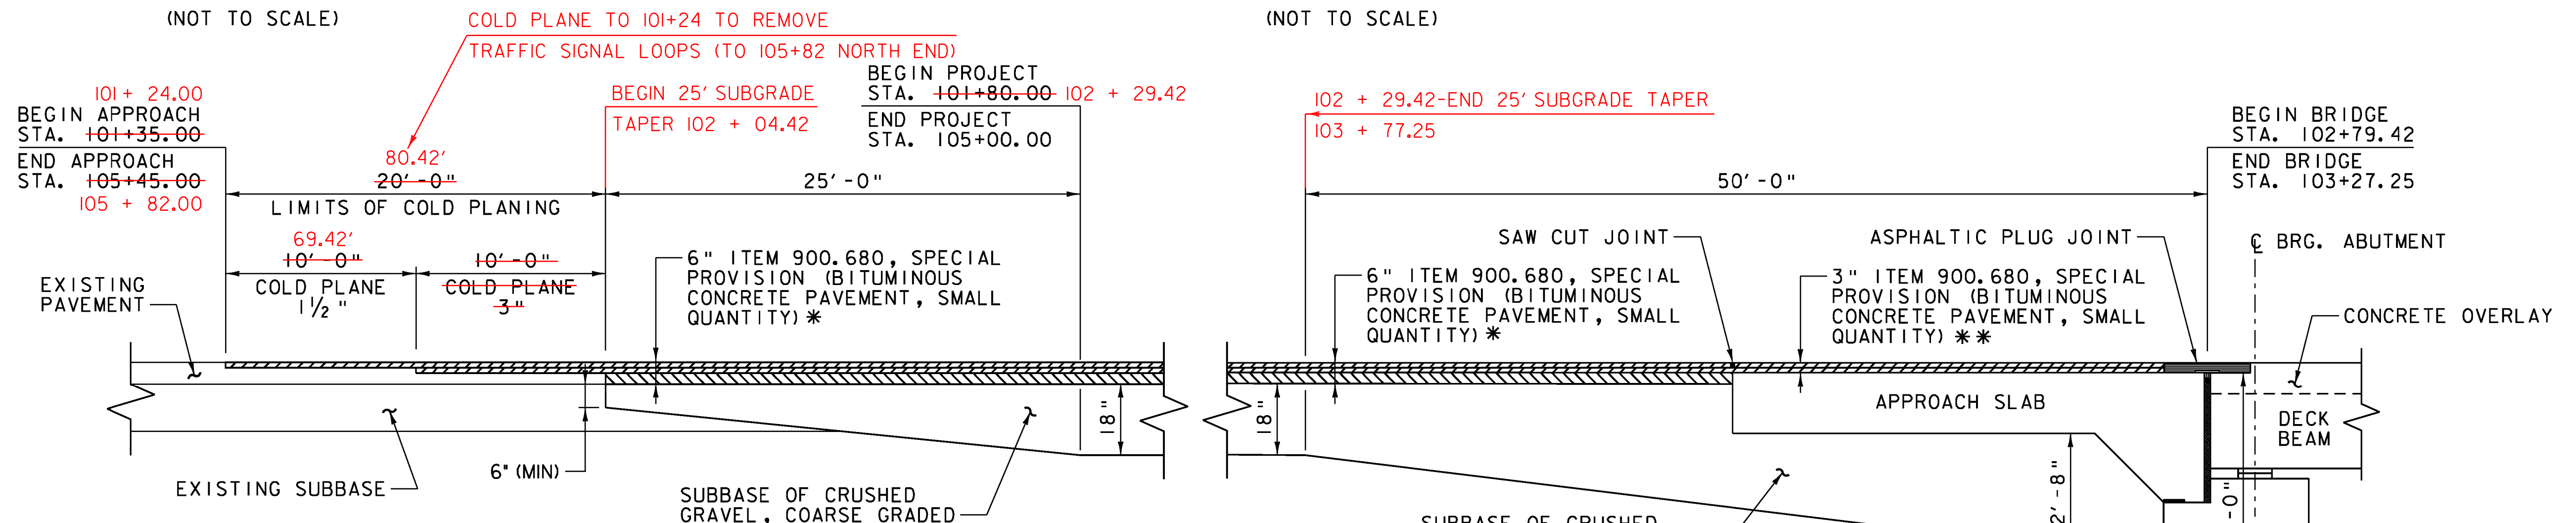

TYPICAL APPROACH SECTION
NOT TO SCALE

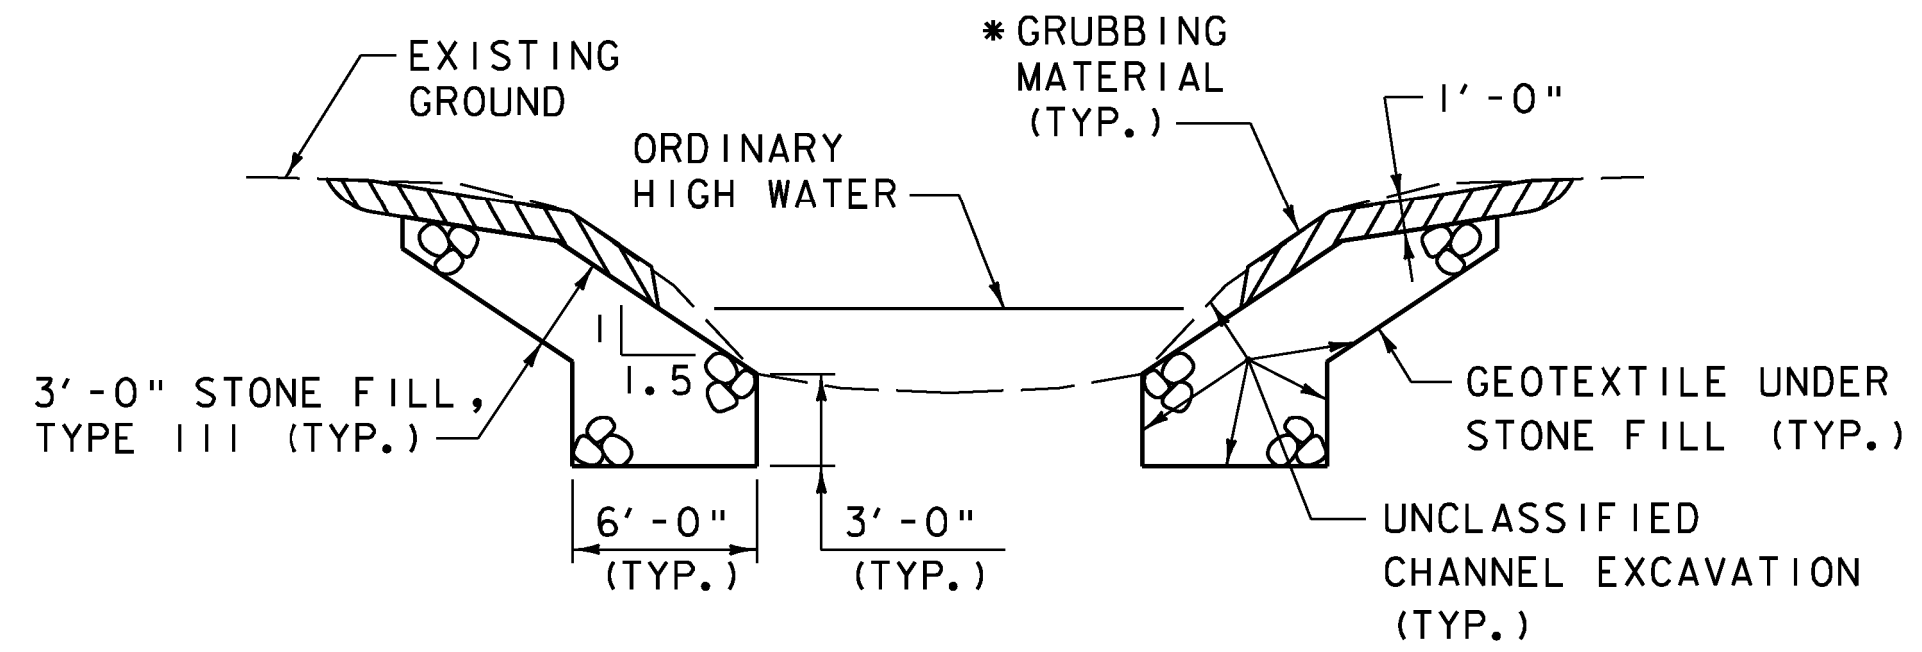

TYPICAL CHANNEL SECTION
(NOT TO SCALE)

*GRUBBING MATERIAL SHALL NOT BE PLACED ON THE STONE FILL IN THE AREA UNDER THE BRIDGE. WHENEVER CHANNEL SLOPE INTERSECTS ROADWAY SUBBASE, GRUBBING MATERIAL SHALL BEGIN AT THE BOTTOM OF SUBBASE.

- * (2) 1 1/2" LIFTS OF TYPE IVS OVER (1) 3" LIFT OF TYPE IIS
- ** (2) 1 1/2" LIFTS OF TYPE IVS

NOTE: EMULSIFIED ASPHALT IS TO BE APPLIED AT A RATE OF 0.040 GAL/SY BETWEEN ALL LIFTS OF BITUMINOUS CONCRETE PAVEMENT, ON ALL COLD PLANED SURFACES, AND ON THE APPROACH SLAB PRIOR TO PLACING THE FIRST LIFT OF PAVEMENT, AS DIRECTED BY THE ENGINEER.



PROJECT NAME:	BRATTLEBORO
PROJECT NUMBER:	BRO 1442(35)
FILE NAME:	z10j062+yp.dgn
PROJECT LEADER:	S.E. BURBANK
DESIGNED BY:	S.E. BURBANK
TYPICAL EARTHWORK SECTIONS	
PLOT DATE:	10/14/2013
DRAWN BY:	B.J. MASSE
CHECKED BY:	S.E. BURBANK
SHEET	5 OF 68

PROJECT NOTES

GENERAL

1. ALL MATERIALS AND CONSTRUCTION SHALL CONFORM TO THE STATE OF VERMONT AGENCY OF TRANSPORTATION STANDARD SPECIFICATIONS FOR CONSTRUCTION, DATED 2011, AND ITS LATEST REVISIONS, AND THE AASHTO LRFD BRIDGE DESIGN SPECIFICATIONS, 5TH EDITION, AND ITS LATEST REVISIONS.
2. THE BRIDGE IS DESIGNED FOR HL-93 LIVE LOAD WITH A 3.0 INCH ALLOWANCE FOR FUTURE PAVEMENT.
3. SALVAGED SIGNS NOT REUSED SHALL REMAIN THE PROPERTY OF THE TOWN OF BRATTLEBORO. THE CONTRACTOR SHALL DELIVER THE SIGNS TO THE TOWN AT THE DEPT. OF PUBLIC WORKS GARAGE LOCATED AT 211 FAIRGROUND ROAD.
4. ALL DIMENSIONS ARE HORIZONTAL OR VERTICAL AND ARE GIVEN AT 68 DEGREES FAHRENHEIT UNLESS NOTED OTHERWISE.
5. THE LIMITS OF THE COFFERDAM ARE TO BE DETERMINED BY THE CONTRACTOR.
6. ITEM 529.15 "REMOVAL OF STRUCTURE" IS FOR THE COMPLETE REMOVAL AND DISPOSAL OF THE EXISTING BRIDGE SUBSTRUCTURE AND SUPERSTRUCTURE, INCLUDING ALL BRIDGE RAIL, BEARINGS AND ANCHOR BOLTS, WHERE THE REMOVAL IS OUTSIDE OF THE AREAS COVERED BY ANY OF THE EXCAVATION ITEMS.
7. THE EXISTING BRIDGE CONTAINS STRUCTURAL STEEL ENCASED IN CONCRETE. THE STRUCTURAL STEEL MAY BE PAINTED WITH A MATERIAL THAT MAY CONTAIN LEAD. THE CONTRACTOR SHALL FOLLOW ALL APPLICABLE REGULATIONS WHEN HANDLING AND WORKING WITH THIS STEEL. THE REMOVED STRUCTURAL STEEL IS THE PROPERTY OF THE CONTRACTOR. THE CONTRACTOR SHALL INDEMNIFY AND HOLD THE STATE, ITS OFFICERS, AND EMPLOYEES HARMLESS CONCERNING THE CONTRACTOR'S USE OR DISPOSITION OF THE REMOVED EXISTING STRUCTURAL STEEL.
8. REMOVAL OF EXISTING BRIDGE PAVEMENT SHALL BE PAID AS ITEM 529.10, "REMOVAL OF BRIDGE PAVEMENT".
9. THE CONTRACTOR SHALL VERIFY THE LOCATION OF ALL BURIED AND AERIAL UTILITIES AND POLES PRIOR TO STARTING WORK. SOME UTILITIES HAVE BEEN RELOCATED DURING THE PREPARATION OF THESE PLANS AND THE CONTRACTOR WILL NEED TO COORDINATE WITH ALL UTILITY OWNERS TO CONFIRM ACTUAL LOCATIONS PRIOR TO CONSTRUCTION. SEE THE UTILITY SPECIAL PROVISIONS FOR ADDITIONAL INFORMATION AND REQUIREMENTS.

EARTHWORK AND RELATED ITEMS

10. TEMPORARY CONSTRUCTION FILLS WITHIN THE WATERCOURSE FOR ANY PURPOSE SHALL CONSIST OF CLEAN STONE FILL ONLY. NO OTHER FILLING IN THE STREAM SHALL OCCUR WITHOUT THE APPROVAL OF THE STREAM ALTERATION ENGINEER.
11. A COFFERDAM IS REQUIRED FOR THE CONSTRUCTION OF THE ABUTMENTS. REFER TO THE "TYPICAL EARTHWORKS SECTIONS" FOR COFFERDAM NOTES.
12. STONE FILL, TYPE III SHALL BE PLACED IN FRONT OF THE ABUTMENTS BEFORE THE NEW BEAMS ARE SET, AS SHOWN ON THE PLANS.
13. ANY TEMPORARY MEANS OF SUPPORTING EXCAVATION NECESSARY TO MAINTAIN TRAFFIC SHALL BE INCIDENTAL TO ITEM 528.10, "ONE-WAY TEMPORARY BRIDGE", AND SHALL MEET THE REQUIREMENTS OF SECTION 204. ASSOCIATED CONSTRUCTION DRAWINGS SHALL BE SUBMITTED IN ACCORDANCE WITH SECTION 105.
14. THE HEIGHT OF THE FILL BEHIND ABUTMENTS SHALL BE LIMITED TO THE BRIDGE SEAT ELEVATION UNTIL THE OVERLAY HAS BEEN POURED AND THE CURING PERIOD IS UP.
15. THE AREA DISTURBED BY THE TEMPORARY DETOUR SHALL BE RESTORED TO ITS ORIGINAL GRADE AND VEGETATED IF NECESSARY. ALL COSTS WILL BE INCIDENTAL TO ITEM 528.10, "ONE-WAY TEMPORARY BRIDGE".
16. NEW TREES WILL BE PLANTED AT THE SITE WHERE TREES WERE REMOVED FOR THE TEMPORARY DETOUR AND WILL FOLLOW THE PLANTING SCHEDULE INCLUDED IN THE PLANS.

TRAFFIC MAINTENANCE DURING CONSTRUCTION

17. THE CONTRACTOR SHALL IMPLEMENT THE ROAD CLOSURE, TRAFFIC CONTROL, AND DETOUR AS SHOWN ON THE PLANS.
18. THE CONTRACTOR SHALL NOTIFY THE TOWN A MINIMUM OF TWO (2) WEEKS PRIOR TO CLOSING THE ROAD AND IMPLEMENTING THE DETOUR.
19. DURING CONSTRUCTION, TRAFFIC SHALL BE MAINTAINED ON A ONE-WAY TEMPORARY BRIDGE LOCATED UPSTREAM OF THE NEW STRUCTURE. THE TEMPORARY BRIDGE AND DETOUR SHALL BE PAVED. CONSTRUCTION AND MAINTENANCE OF THE TEMPORARY BRIDGE AND ITS APPROACHES SHALL BE PAID FOR UNDER ITEM 528.10, "ONE-WAY TEMPORARY BRIDGE".
20. FULL ACCESS TO ALL SIDE ROADS AND DRIVES WITHIN THE PROJECT LIMITS SHALL BE MAINTAINED AT ALL TIMES. THIS WORK SHALL BE CONSIDERED INCIDENTAL TO ITEM 641.10, "TRAFFIC CONTROL".

21. UNLESS COVERED UNDER INDIVIDUAL PAY ITEMS OR NOTED OTHERWISE, ALL COSTS FOR WORK SHOWN ON THE TRAFFIC CONTROL SHEETS AND FOR TEMPORARY TRAFFIC CONTROL DEVICES WILL BE CONSIDERED TO BE INCLUDED IN THE CONTRACT LUMP SUM PRICE FOR TRAFFIC CONTROL, ITEM 641.10, "TRAFFIC CONTROL". THIS INCLUDES, BUT IS NOT LIMITED TO, THE FOLLOWING ITEMS:

RETROREFLECTIVE DRUMS
 PORTABLE TRAFFIC LIGHTS
 PORTABLE LUMINAIRE
 TYPE III BARRICADES
 ENERGY ABSORPTION ATTENUATOR
 SIGNS
 SIGN POSTS

ENERGY ABSORPTION ATTENUATOR(S) SHALL BE FURNISHED IN ACCORDANCE WITH SECTION 621.

22. ALL SIGNS SHALL BE IN ACCORDANCE WITH THE CURRENT EDITIONS OF THE "MANUAL ON UNIFORM TRAFFIC CONTROL DEVICES" (MUTCD) AND THE "STANDARD HIGHWAY SIGNS AND MARKINGS" BOOK (SHSM) PUBLISHED BY THE FEDERAL HIGHWAY ADMINISTRATION (FHWA).
23. ALL TEMPORARY PORTABLE TRAFFIC CONTROL SIGNALS AND PORTABLE LIGHT TOWERS SHALL BE IN ACCORDANCE WITH SECTION 678 AND THE CURRENT EDITION OF THE "MANUAL ON UNIFORM TRAFFIC CONTROL DEVICES" (MUTCD).
24. SIGNAL TIMING/TIMING ADJUSTMENTS REQUESTED BY THE ENGINEER SHALL BE ACCOMPLISHED WITHIN 24 HOURS AFTER BEING REQUESTED. PAYMENT SHALL BE INCIDENTAL TO ITEM 641.10 "TRAFFIC CONTROL". THE CONTRACTOR, AT THE DIRECTION OF THE ENGINEER, SHALL MAKE SEVERAL TRIAL RUNS TO DETERMINE THE PROPER ALL-RED CLEARANCE INTERVAL.

CONCRETE

25. CONCRETE FOR THE OVERLAY SHALL BE ITEM 501.32, "CONCRETE, HIGH PERFORMANCE, CLASS AA". CONCRETE FOR THE CURBS SHALL BE ITEM 501.33, "CONCRETE, HIGH PERFORMANCE, CLASS A". SUBSTRUCTURE CONCRETE SHALL BE ITEM 501.34, "CONCRETE, HIGH PERFORMANCE CLASS B", UNLESS OTHERWISE NOTED.
26. THE KEY IN CONCRETE CONSTRUCTION JOINTS SHALL BE MONOLITHIC AND CONTINUOUS FOR THE FULL LENGTH OF THE JOINT.
27. ALL EXPOSED EDGES OF CONCRETE SHALL BE CHAMFERED 1" BY 1".
28. JOINTS AND SCORE MARKS IN CONCRETE SHALL BE CONSTRUCTED AS INDICATED ON THE PLANS OR AS DIRECTED BY THE ENGINEER.
29. ALL REINFORCING STEEL SHALL BE DETAILED AND FABRICATED USING PROCEDURES AND TOLERANCES IN ACCORDANCE WITH APPLICABLE PUBLICATIONS OF THE CONCRETE REINFORCING STEEL INSTITUTE (CRSI).
30. REINFORCING STEEL PLACEMENT TOLERANCES SHALL BE:

SPACING ± 1"
 CLEARANCE ± ¼"

31. MINIMUM COVER FOR REINFORCING STEEL SHALL BE 2" ALONG THE BACK FACES OF WALLS AGAINST EARTH AND 3" ELSEWHERE, UNLESS OTHERWISE NOTED.
32. NO CONCRETE IN THE ABUTMENTS OR WINGWALLS SHALL BE PLACED ABOVE THE BRIDGE SEAT ELEVATIONS UNTIL THE BEAMS OR SLABS HAVE BEEN PROFILED AND THE FINISHED GRADE OF THE DECK HAS BEEN DETERMINED.
33. RELATIVE TO GRADE, ALL DECK POURS SHALL BEGIN FROM THE LOW ELEVATION END AND PROCEED TOWARDS THE HIGH ELEVATION END.
34. SURFACES OF BRIDGE SEATS UNDER BEARING DEVICES SHALL BE LEVEL IN THE LONGITUDINAL DIRECTION (FROM THE APPROACH SLAB SEAT TO THE FRONT FACE OF THE ABUTMENT). ALL OTHER AREAS SHALL BE SLOPED DOWN 1/2 INCH PER FOOT FROM THE APPROACH SLAB SEAT TOWARD THE NEAREST OUTSIDE FACE OF THE SUBSTRUCTURE UNIT, SUCH AS TO PREVENT PONDING ON THE BRIDGE SEAT AREA. THE ENTIRE BRIDGE SEAT SURFACE SHALL BE SMOOTH STEEL TROWEL FINISHED.
35. WATER REPELLENT, SILANE, SHALL BE APPLIED TO ALL EXPOSED CONCRETE SURFACES EXCEPT THE UNDERSIDE OF THE DECK BETWEEN THE DRIP NOTCHES.
36. ½" SACRIFICIAL WEARING SURFACE HAS BEEN ADDED TO THE TOP OF THE CONCRETE OVERLAY. SEE SECTION 501 FOR DETAILS ON PROVIDING TEXTURING.
37. ALL SUPERSTRUCTURE REINFORCING STEEL SHALL MEET THE REQUIREMENTS OF SECTION 507 FOR LEVEL II REINFORCEMENT. REINFORCEMENT FOR OVERLAY SHALL BE PAID FOR UNDER ITEM 507.12, "REINFORCING STEEL, LEVEL II". REINFORCEMENT FOR PRESTRESSED CONCRETE NON-VOIDED SLABS SHALL BE PAID FOR UNDER ITEM 900.640, "SPECIAL PROVISION (PRESTRESSED CONCRETE NON-VOIDED SLABS)". REINFORCING FOR THE SUBSTRUCTURE SHALL BE PAID FOR UNDER ITEM 507.11, "REINFORCING STEEL, LEVEL I" AND ITEM 507.12, REINFORCING STEEL, LEVEL II". CUTTING AND REPAIRING DAMAGED AREAS OF COATED REINFORCING STEEL SHALL BE PERFORMED IN ACCORDANCE WITH SUBSECTION 507.

SUBSTRUCTURE ON LEDGE

38. FOOTINGS AND SUB-FOOTINGS SHALL BE FOUNDED ON LEDGE WHICH HAS BEEN CLEANED OF ALL LOOSE ROCK AND DEBRIS TO ENSURE THAT SUBSTRUCTURES ARE PLACED ON COMPETENT ROCK.
39. UPON COMPLETION OF THE EXCAVATION FOR SUBSTRUCTURES FOUNDED ON BEDROCK AND PRIOR TO PLACING FORMWORK, THE ENGINEER SHALL NOTIFY THE PROJECT MANAGER AND THE VTRANS STATE GEOLOGIST. THE GEOLOGIST WILL DETERMINE IF THE BEDROCK IS COMPETENT TO OBTAIN THE NOMINAL BEARING RESISTANCE AS SHOWN ON THE PLANS. THE CONTRACTOR SHALL NOTIFY THE GEOLOGIST 72 HOURS PRIOR TO WHEN THE ANALYSIS WILL BE NEEDED.
40. LEDGE THAT IS EXCAVATED FOR PLACEMENT OF FOOTINGS SHALL BE EXCAVATED TO PROVIDE A LEVEL SURFACE OR AS DIRECTED BY THE ENGINEER.
41. A MAXIMUM OF 6" OVER BREAKAGE WILL BE REPLACED WITH "HIGH PERFORMANCE CLASS B CONCRETE". OVER BREAKAGE BEYOND 6" SHALL BE REPLACED WITH HIGH PERFORMANCE CLASS B CONCRETE" AT THE EXPENSE OF THE CONTRACTOR.
42. THE LIMITS OF THE SUBFOOTING SHALL BE 1'-0" OUTSIDE THE LIMITS OF THE FOOTING.
43. THE SUBSTRUCTURE UNITS HAVE BEEN DESIGNED FOR THE TOP OF FOOTING ELEVATIONS SHOWN ON THE PLANS. IF THE LEDGE ELEVATION IS GREATER THAN 1'-0" BELOW THE DESIGN BOTTOM OF FOOTING, A SUBFOOTING SHALL BE POURED SO THAT THE DESIGN TOP OF FOOTING IS AT THE REQUIRED ELEVATION.
44. FOR ALL SUBSTRUCTURES, WHERE LEDGE IS WITHIN ONE FOOT FROM THE BOTTOM OF THE FOOTING AS DESIGNED, THE FOOTING MAY BE POURED TO THE TOP OF THE LEDGE USING "CONCRETE, HIGH PERFORMANCE CLASS B".
45. FOR ALL SUBSTRUCTURE UNITS WHERE LEDGE IS BELOW TOP OF FOOTING BY LESS THAN THE DEPTH OF FOOTING DETAILED IN THE PLANS, THE LEDGE SHALL BE EXCAVATED DOWN TO THE INDICATED BOTTOM OF FOOTING FOR THE FULL WIDTH (TOE TO HEEL) OF THE CONFIGURATION.
46. IF LEDGE IS ABOVE THE DESIGN TOP OF FOOTING, THE FOOTING MAY BE RAISED. BEFORE ANY UPWARD ADJUSTMENT IS MADE IN FOOTING ELEVATION, THE PROJECT MANAGER SHALL BE CONTACTED AND PROVIDED WITH A LEDGE PROFILE. NO FURTHER WORK SHALL BE DONE UNTIL APPROVAL OF THE CONFIGURATION IS RECEIVED.
47. #8 DOWELS SHALL BE DRILLED AND GROUTED INTO THE LEDGE AS SHOWN ON THE PLANS. THE DOWELS SHALL HAVE A MINIMUM 2'-0" EMBEDMENT INTO THE LEDGE AND SHALL EXTEND INTO THE FOOTING A MINIMUM OF 1'-6". IN AREAS WHERE A SUBFOOTING IS REQUIRED #8 DOWELS WILL ALSO BE USED AT THE INTERFACE BETWEEN SUBFOOTING AND FOOTING. THE DRILLING AND GROUTING SHALL BE PAID FOR UNDER THE ITEM 507.16, "DRILLING AND GROUTING DOWELS".
48. PRIOR TO ANY COLD WEATHER CONCRETE PLACEMENT AS DEFINED IN SECTION 501, THE CONTRACTOR SHALL SUBMIT A PLAN TO THE ENGINEER FOR APPROVAL. THE PLAN AT A MINIMUM SHALL PROVIDE METHODS FOR INSULATING, CURING, AND HEATING, TEMPERATURE MONITORING, AND ANY WEATHER RESTRICTIONS FOR CONCRETE PLACEMENT. THE PLAN SHALL BE SPECIFIC TO THE LOCATION OF THE PLACEMENT AND BE SUBMITTED A MINIMUM OF 14 DAYS PRIOR TO THE ANTICIPATED PLACEMENT DATE. COLD WEATHER CONCRETE SHALL NOT BE PLACED PRIOR TO APPROVAL OF THE PLAN.

PRESTRESSED NON-VOIDED SLABS

49. PRESTRESSED CONCRETE NON-VOIDED SLABS SHALL BE PAID FOR UNDER ITEM 900.640, "SPECIAL PROVISION (PRESTRESSED CONCRETE NON-VOIDED SLABS)(18"x36")" OR ITEM 900.640, "SPECIAL PROVISION (PRESTRESSED CONCRETE NON-VOIDED SLABS)(18"x48")".
50. ITEM 900.640, "SPECIAL PROVISION (PRESTRESSED CONCRETE NON-VOIDED SLAB)" SHALL:
 - A. CONFORM TO SECTION 510 "PRESTRESSED CONCRETE".
 - B. HAVE THE ENDS OF THE STRANDS RECESSED AND GROUTED ACCORDING TO STANDARD PRACTICE.
 - C. INCLUDE COLD POURED JOINT FILLER AND TRANSVERSE TENDONS.
 - D. GALVANIZE TRANSVERSE THREADED STEEL ROD PLATES AND ANCHOR NUTS AFTER FABRICATION ACCORDING TO AASHTO M 232M/M 232.
51. ITEM 510.24, "GROUTING SHEAR KEYS": FILL THE JOINTS BETWEEN THE BEAMS WITH MORTAR, TYPE IV, AS DESCRIBED IN SUBSECTION 510.13.

REV.	DESCRIPTION	DATE
△	PRESTRESSED NON-VOIDED SLAB NOTES	11/20/2013
PROJECT NAME: BRATTLEBORO		
PROJECT NUMBER: BRO 1442(35)		
FILE NAME: z10J062pn.dgn		PLOT DATE: 11/20/2013
PROJECT LEADER: S.E. BURBANK		DRAWN BY: E.A. FIALA
DESIGNED BY: S.E. BURBANK		CHECKED BY: S.E. BURBANK
PROJECT NOTES (1 OF 2)		SHEET 6 OF 68



PROJECT NOTES CONT'D...

52. DESIGN VALUES:

- A. CONCRETE: $F'_c = 6 \text{ ksi}$ AND $F_c = 4.8 \text{ ksi}$
- B. LIVE LOAD: AASHTO HL-93
- C. PRESTRESSING STRANDS: 0.6" DIAMETER, 270 KSI, LOW-RELAXATION 7-WIRE STRANDS PULLED TO 75% OF THEIR YIELD STRENGTH
- D. POST-TENSIONING STRANDS: 1" DIAMETER, 150 KSI, THREADED STEEL ROD.
- E. THERE SHALL BE ONE (1) THREADED STEEL ROD PER POST-TENSION DUCT.
- F. THREADED STEEL RODS SHALL BE COVERED WITH CORROSION INHIBITOR GREASE FOR THE LENGTH OF THE STRAND. TIES SHALL BE TENSIONED TO 47 KIPS FOR EACH 1" DIAMETER THREADED STEEL ROD.
- G. SERVICE LOADS (INT & EXT):

MEMBER MOMENT	189.8 & 142.4 K-FT
SUPERIMPOSED DEAD LOAD MOMENT	142.5 & 101.0 K-FT
LIVE LOAD & IMPACT MOMENT	197.8 & 165.7 K-FT
DEAD LOAD REACTION	27.2 & 18.5 K
LIVE LOAD & IMPACT REACTION	41.7 K & 63.6 K
TOTAL REACTION	68.9 & 82.1 K
RELEASE CAMBER	1.033 & 0.925 IN
ERECTION CAMBER	1.095 & 0.990 IN

- 53. THE FABRICATOR MAY, WITH THE APPROVAL OF THE PROJECT MANAGER, ALTER THE DESIGN AS DETAILED TO MEET THE PLANT'S PRESTRESSING OPERATION AND MATERIAL REQUIREMENTS. ALTERNATE STRAND, TRANSVERSE TIE AND CROSS-SLOPE CONFIGURATIONS MAY BE SUBMITTED TO THE ENGINEER FOR APPROVAL. ANY DESIGN CHANGES SHALL MEET ALL OF THE APPLICABLE DESIGN CRITERIA AND SHALL BE STAMPED AND SIGNED BY A PROFESSIONAL ENGINEER LICENSED IN THE STATE OF VERMONT.
- 54. THE PRECASTER SHALL SANDBLAST SHEAR KEY FACES PRIOR TO DELIVERY.
- 55. ALL TIES AND STIRRUPS IN THE NON-VOIDED SLABS SHALL MEET THE REQUIREMENTS OF SECTION 507 FOR LEVEL II REINFORCEMENT. PAYMENT WILL BE INCLUDED IN THE UNIT PRICE BID FOR CONTRACT ITEM 900.640, "SPECIAL PROVISION (PRESTRESSED CONCRETE NON-VOIDED SLABS)".
- 56. THE CONTRACTOR IS RESPONSIBLE FOR DESIGN OF ALL LIFTING POINTS, POST TENSIONING ELEMENTS IN THE ANCHORAGE ZONE AND ADDITIONAL REINFORCEMENT IN THE ANCHORAGE ZONE (REQUIRED FOR SPLITTING, BURSTING SPALLING, ETC.) INCLUDING THE LOCAL ZONE (REGION IMMEDIATELY SURROUNDING THE POST TENSIONING DEVICE). THE CONTRACTOR IS RESPONSIBLE FOR CONSIDERATION OF ADDITIONAL STRESSES DUE TO HANDLING. DESIGN MUST CONFORM TO AASHTO LRFD SPECIFICATIONS.

PROPOSED CONSTRUCTION SEQUENCE FOR PRESTRESSED NON-VOIDED SLABS

- 57. LAY OUT WORKING LINES:
 - A. LAY OUT WORKING LINES FOR THE ENTIRE BRIDGE WIDTH ON THE BEAM SEAT.
 - B. MEASURE ALL WORKING LINES FROM A COMMON WORKING POINT.
 - C. BASE THE WORKING LINES ON THE NOMINAL BEAM WIDTHS.
- 58. VERIFY BEAM SEAT ELEVATIONS:
 - A. MEASURE ELEVATIONS AT BEAM SEATS.
 - B. IF SEATS ARE HIGH OR LOW, TAKE CORRECTIVE ACTION.
 - C. INSTALL BEARINGS.
- 59. ERECT BEAMS STARTING AT THE LOWER EXTERIOR BEAM, PLACING ONE BEAM AT A TIME:
 - A. PLACE BEAMS TO FIT WITHIN THE WORKING LINES.
 - B. PRIOR TO INSTALLING INTERIOR BEAMS IN EACH PHASE OF CONSTRUCTION, INSTALL ANCHORED END OF THREADED STEEL ROD WITH ENOUGH ROD TO PASS THROUGH THE NEXT BEAM TO BE PLACED IN THE FOLLOWING PHASE OF CONSTRUCTION.
 - C. AS WORK PROGRESSES, INSTALL HARDWOOD WEDGES BETWEEN ADJACENT BEAMS TO MAINTAIN PROPER JOINT OPENING (A MINIMUM OF ONE WEDGE AT EACH POST TENSIONING DUCT).
 - D. DRILL ANCHOR BOLT HOLES.
 - E. PLACE ANCHOR BOLTS.
- 60. INSTALL BACKER ROD: PLACE FILLER BELOW THE KEYWAY BOTTOM, AS SHOWN ON THE PLANS.
- 61. INSTALL THREADED STEEL RODS:
 - A. FEED THREADED STEEL RODS THROUGH DUCTS.
 - B. VERIFY THAT HARDWOOD WEDGES ARE IN PLACE AS REQUIRED TO PREVENT SLIPPAGE OF BEAMS.
 - C. USING A CALIBRATED JACK, POST-TENSION THE THREADED STEEL RODS TO APPROXIMATELY 5 KIPS TO SEAT THE ANCHOR NUT.
- 62. GROUT SHEAR KEYS:
 - A. CLEAN JOINTS WITH AN OIL FREE AIR-BLAST IMMEDIATELY BEFORE GROUT PLACEMENT. VERIFY THAT THE BACKER ROD IS STILL IN PLACE.
 - B. FOLLOW MANUFACTURER'S RECOMMENDATIONS FOR ADDITIONAL JOINT PREPARATION AND GROUT PLACEMENT.
 - C. CAREFULLY ROD JOINTS TO ELIMINATE ANY POSSIBILITY OF VOIDS.
- 63. POST-TENSION THREADED STEEL RODS:
 - A. GROUT SHALL ATTAIN A MINIMUM COMPRESSIVE STRENGTH OF 1500 PSI, BASED ON THE MANUFACTURER'S RECOMMENDATIONS, PRIOR TO STRESSING. THE GROUT NEED NOT BE CURED FOR THREE DAYS PRIOR TO THE COMMENCING OF POST-TENSIONING.
 - B. PROVIDE APPROPRIATE CUBE MOLDS AS DESCRIBED IN AASHTO T106 FOR 3 SETS OF 3 DAY CUBES, 3 SETS OF 28 DAY CUBES AND AT A MINIMUM OF 3 MORE CUBES TO TEST FOR THE 1500 PSI MINIMUM COMPRESSIVE STRENGTH.
 - C. POST-TENSION THREADED STEEL RODS TO 47 KIPS USING A CALIBRATED JACK OPERATED BY QUALIFIED PERSONNEL.
- 64. FOR EACH BEAM, REPEAT THE SEQUENCE SPECIFIED IN NOTES 59-63.

- 65. END DETAILS:
 - A. GROUT ANCHOR BOLTS INTO THE SLEEVES IN THE PRESTRESSED UNITS AT THE FIXED ENDS. BEFORE THE GROUT CURES, PLACE THE WASHER PLATE, AND INSTALL THE NUT ON TOP AND TIGHTEN.
 - B. PLACE THE COLD POURED JOINT SEALER IN THE SLEEVES IN THE PRESTRESSED UNITS AT THE EXPANSION ENDS. PLACE THE WASHER PLATE AND INSTALL THE NUT ON TOP. HAND TIGHTEN AND THEN LOOSEN 1/2 TURN.
 - C. GROUT OVER THE NUT AND BOLT IN THE ANCHOR BOLT BLOCK OUT ON THE FIXED ENDS. FILL THE ANCHOR BOLT BLOCK OUTS ON THE EXPANSION ENDS WITH COLD POURED JOINT SEALER.
- 66. FINISH WORK: REMOVE WEDGES, AND PATCH SURFACE AND FASCIA BEAMS AT TRANSVERSE TENDONS.

REV.	DESCRIPTION	DATE
△	POST TENSIONING NOTES	11/20/2013
PROJECT NAME: BRATTLEBORO		
PROJECT NUMBER: BRO 1442(35)		
FILE NAME: z10J062pn.dgn		PLOT DATE: 11/20/2013
PROJECT LEADER: S.E. BURBANK		DRAWN BY: E.A. FIALA
DESIGNED BY: S.E. BURBANK		CHECKED BY: S.E. BURBANK
PROJECT NOTES (2 OF 2)		SHEET 7 OF 68



QUANTITY SHEET 1

SUMMARY OF ESTIMATED QUANTITIES										TOTALS		DESCRIPTIONS				DETAILED SUMMARY OF QUANTITIES		
					ROADWAY	LANDSCAPING	EROSION CONTROL	BRIDGE	FULL C.E. ITEMS	GRAND TOTAL	FINAL	UNIT	ITEMS	ITEM NUMBER	ROUND	QUANTITIES	UNIT	ITEMS
					1					1		LS	CLEARING AND GRUBBING, INCLUDING INDIVIDUAL TREES AND STUMPS	201.10				
					630					630		CY	COMMON EXCAVATION	203.15		86	CY	FILL REQUIRED (75 CY *1.15)
								420		420		CY	UNCLASSIFIED CHANNEL EXCAVATION	203.27				FILL AVAILABLE
					1					1		CY	TRENCH EXCAVATION OF EARTH, EXPLORATORY (N.A.B.I.)	204.22		504	CY	COMMON EXCAVATION (630 CY * 0.80)
								820		820		CY	GRANULAR BACKFILL FOR STRUCTURES	204.30		315	CY	UNCLASSIFIED CHANNEL EXCAVATION (420 CY * 0.75)
								1070		1070		CY	COFFERDAM EXCAVATION, EARTH	208.30		803	CY	COFFERDAM EXCAVATION EARTH (1070 CY * 0.75)
								365		365		CY	COFFERDAM EXCAVATION, ROCK	208.35		181	CY	COFFERDAM EXCAVATION ROCK (365 CY * 0.495)
								1		1		LS	COFFERDAM (ABUTMENT NO. 1)	208.40		1802	CY	SUBTOTAL
								1		1		LS	COFFERDAM (ABUTMENT NO. 2)	208.40		0	CY	ROUNDING
					175					175		SY	COLD PLANING, BITUMINOUS PAVEMENT	210.10		1802	CY	TOTAL
					550					550		CY	SUBBASE OF CRUSHED GRAVEL, COARSE GRADED	301.25		1802	CY	FILL AVAILABLE
					7					7		CWT	EMULSIFIED ASPHALT	404.65		86	CY	FILL REQUIRED
					1					1		LU	PRICE ADJUSTMENT, ASPHALT CEMENT (N.A.B.I.)	406.50		0	CY	BORROW
								25		25		CY	CONCRETE, HIGH PERFORMANCE CLASS AA	501.32		1716	CY	WASTE
								5		5		CY	CONCRETE, HIGH PERFORMANCE CLASS A	501.33				COMMON EXCAVATION
								330		330		CY	CONCRETE, HIGH PERFORMANCE CLASS B	501.34		576	CY	MAINLINE
								30280		30280		LB	REINFORCING STEEL, LEVEL I	507.11		54	CY	DRIVES
								13345		13345		LB	REINFORCING STEEL, LEVEL II	507.12		0	CY	ROUNDING
								100		100		LF	DRILLING AND GROUTING DOWELS	507.16		630	CY	TOTAL
								290		290		LF	GROUTING SHEAR KEYS	510.24				SUBBASE OF CRUSHED GRAVEL, COARSE GRADED
								16		16		GAL	WATER REPELLENT, SILANE	514.10		490	CY	MAINLINE
								68		68		LF	BRIDGE EXPANSION JOINT, ASPHALTIC PLUG	516.10		60	CY	DRIVES
								69		69		LF	JOINT SEALER, HOT POURED	524.11		0	CY	ROUNDING
								1		1		LS	ONE-WAY TEMPORARY BRIDGE (880 SF - EST.)	528.10		550	CY	TOTAL
								55		55		SY	REMOVAL OF BRIDGE PAVEMENT	529.10				
								1		1		EACH	REMOVAL OF STRUCTURE (653 SF - EST.)	529.15				
								28		28		EACH	BEARING DEVICE ASSEMBLY, STEEL REINFORCED ELASTOMERIC PAD	531.17				
					20					20		MGAL	DUST CONTROL WITH WATER	609.10				
								410		410		CY	STONE FILL, TYPE III	613.12				
					1					1		EACH	RELOCATE MAILBOX, SINGLE SUPPORT	617.10				
					1					1		EACH	RELOCATE MAILBOX, MULTIPLE SUPPORT	617.12				
					58					58		LF	STEEL BEAM GUARDRAIL, GALVANIZED	621.20				
					113					113		LF	STEEL BEAM GUARDRAIL, GALVANIZED W/8 FEET POSTS	621.205				
					4					4		EACH	ANCHOR FOR STEEL BEAM RAIL	621.60				
					4					4		EACH	GUARDRAIL APPROACH SECTION, GALV HD STEEL BEAM W/ 8FT POSTS	621.738				
					180					180		LF	REMOVAL AND DISPOSAL OF GUARDRAIL	621.80				
					100					100		HR	FLAGGERS	630.15				
									1	1		LS	FIELD OFFICE, ENGINEERS	631.10				
									1	1		LS	TESTING EQUIPMENT, CONCRETE	631.16				
									1	1		LS	TESTING EQUIPMENT, BITUMINOUS	631.17				

PROJECT NAME:	BRATTLEBORO
PROJECT NUMBER:	BRO 1442(35)
FILE NAME:	z10J062qs.dgn
PROJECT LEADER:	S.E. BURBANK
DESIGNED BY:	E.A. FIALA
QUANTITY SHEET #1	
PLOT DATE:	11/12/2013
DRAWN BY:	A.J. GOUDREAU
CHECKED BY:	S.E. BURBANK
SHEET	8 OF 68



QUANTITY SHEET 2

SUMMARY OF ESTIMATED QUANTITIES										TOTALS		DESCRIPTIONS				DETAILED SUMMARY OF QUANTITIES			
						ROADWAY	LANDSCAPING	EROSION CONTROL	BRIDGE	FULL C.E. ITEMS	GRAND TOTAL	FINAL	UNIT	ITEMS	ITEM NUMBER	ROUND	QUANTITIES	UNIT	ITEMS
										3000	3000		DL	FIELD OFFICE TELEPHONE (N.A.B.I.)	631.26				SPECIAL PROVISION (BITUMINOUS CONCRETE PAVEMENT, SMALL QUANTITY)
						1					1		LS	MOBILIZATION/DEMobilIZATION	635.11		148	TONS	TYPE IVS - WEARING COURSE
						1					1		LS	TRAFFIC CONTROL	641.10		130	TONS	TYPE IIS - BASE COURSE
									1010		1010		SY	GEOTEXTILE UNDER STONE FILL	649.31		278	TONS	TOTAL
								300			300		SY	GEOTEXTILE FOR SILT FENCE	649.51				DRIVES
								300			300		SY	GEOTEXTILE FOR FILTER CURTAIN	649.61		12	TONS	STA. 102+55, LT
								10			10		LB	SEED	651.15		20	TONS	STA. 103+60, RT
								70			70		LB	FERTILIZER	651.18		32	TONS	TOTAL
								0.3			0.3		TON	AGRICULTURAL LIMESTONE	651.20				
								0.3			0.3		TON	HAY MULCH	651.25				
								40			40		CY	TOPSOIL	651.35				
								300			300		SY	GRUBBING MATERIAL	651.40				
								1			1		LS	EPSC PLAN	652.10				
								80			80		HR	MONITORING EPSC PLAN	652.20				
								1			1		LU	MAINTENANCE OF EPSC PLAN (N.A.B.I.)	652.30				
								110			110		SY	TEMPORARY EROSION MATTING	653.20				
								15			15		CY	TEMPORARY STONE CHECK DAM, TYPE I	653.25				
								30			30		CY	VEHICLE TRACKING PAD	653.35				
								70			70		LF	BARRIER FENCE	653.50				
								650			650		LF	PROJECT DEMARCATION FENCE	653.55				
							7				7		EACH	DECIDUOUS TREES (ACER RUBRUM) (B&B) (2.5" - 3" DIA.)	656.30				
							6				6		EACH	DECIDUOUS TREES (ACER SACCHARINUM) (B&B) (2" - 2.5" DIA.)	656.30				
							58				58		EACH	DECIDUOUS SHRUBS (CORNUS SERICEA) (B&B) (36" - 48" HT.)	656.35				
							7.2				7.2		MGAL	LANDSCAPE WATERING	656.65				
							65				65		CY	LANDSCAPE BACKFILL, TRUCK MEASUREMENT	656.80				
							1				1		LS	TREE PROTECTION	656.85				
						12					12		SF	TRAFFIC SIGNS, TYPE A	675.20				
						30					30		LF	SQUARE TUBE SIGN POST AND ANCHOR	675.341				
						11					11		EACH	REMOVING SIGNS	675.50				
						1					1		EACH	ERECTING SALVAGED SIGNS	675.60				
									200		200		LF	SPECIAL PROVISION (BRIDGE RAILING, GALVANIZED HDSB/FASCIA MOUNTED/STEEL TUBING)	900.640				
						175					175		LF	SPECIAL PROVISION (FABRIC SCREENING FENCE)	900.640				
									96		96		LF	SPECIAL PROVISION (PRESTRESSED CONCRETE NON-VOIDED SLABS)(18"x36")	900.640				
									240		240		LF	SPECIAL PROVISION (PRESTRESSED CONCRETE NON-VOIDED SLABS)(18"x48")	900.640				
						1					1		LU	SPECIAL PROVISION (MAT DENSITY PAY ADJUSTMENT, SMALL QUANTITY) (N.A.B.I.)	900.650				
						1					1		LU	SPECIAL PROVISION (MIXTURE PAY ADJUSTMENT) (N.A.B.I.)	900.650				
						310					310		TON	SPECIAL PROVISION (BITUMINOUS CONCRETE PAVEMENT, SMALL QUANTITY)	900.680				

PROJECT NAME: BRATTLEBORO

PROJECT NUMBER: BRO 1442(35)

FILE NAME: z10J062qs.dgn

PROJECT LEADER: S.E. BURBANK

DESIGNED BY: E.A. FIALA

QUANTITY SHEET #2

PLOT DATE: 11/12/2013

DRAWN BY: A.J. GOUDREAU

CHECKED BY: S.E. BURBANK

SHEET 9 OF 68



BRIDGE QUANTITY SHEET 1

SUMMARY OF BRIDGE QUANTITIES										TOTALS		DESCRIPTIONS			DETAILED SUMMARY OF QUANTITIES			
				TEMPORARY BRIDGE	APP SLAB 1	ABUTMENT 1	SUPER-STRUCTURE	ABUTMENT 2	APP SLAB 2	BRIDGE TOTAL		UNIT	ITEMS	ITEM NUMBER		QUANTITIES	UNIT	ITEMS
						180		240		420		CY	UNCLASSIFIED CHANNEL EXCAVATION	203.27				
						450		370		820		CY	GRANULAR BACKFILL FOR STRUCTURES	204.30				
						545		525		1070		CY	COFFERDAM EXCAVATION, EARTH	208.30				
						185		180		365		CY	COFFERDAM EXCAVATION, ROCK	208.35				
						1				1		LS	COFFERDAM (ABUTMENT NO. 1)	208.40				
								1		1		LS	COFFERDAM (ABUTMENT NO. 2)	208.40				
							25			25		CY	CONCRETE, HIGH PERFORMANCE CLASS AA	501.32				
							5			5		CY	CONCRETE, HIGH PERFORMANCE CLASS A	501.33				
					35	130		130	35	330		CY	CONCRETE, HIGH PERFORMANCE CLASS B	501.34				
						16660		13620		30280		LB	REINFORCING STEEL, LEVEL I	507.11				
					3570	945	2835	2485	3510	13345		LB	REINFORCING STEEL, LEVEL II	507.12				
						42		58		100		LF	DRILLING AND GROUTING DOWELS	507.16				
							290			290		LF	GROUTING SHEAR KEYS	510.24				
						2.5	9.5	4		16		GAL	WATER REPELLENT, SILANE	514.10				
							68			68		LF	BRIDGE EXPANSION JOINT, ASPHALTIC PLUG	516.10				
					34.5				34.5	69		LF	JOINT SEALER, HOT POURED	524.11				
								1		1		LS	ONE-WAY TEMPORARY BRIDGE (880 SF - EST.)	528.10				
							55			55		SY	REMOVAL OF BRIDGE PAVEMENT	529.10				
							1			1		EACH	REMOVAL OF STRUCTURE (653 SF - EST.)	529.15				
						14		14		28		EACH	BEARING DEVICE ASSEMBLY, STEEL REINFORCED ELASTOMERIC PAD	531.17				
						175		235		410		CY	STONE FILL, TYPE III	613.12				
						418		592		1010		SY	GEOTEXTILE UNDER STONE FILL	649.31				
							200			200		LF	SPECIAL PROVISION (BRIDGE RAILING, GALVANIZED HDSB/FASCIA MOUNTED/STEEL TUBING)	900.640				
							96			96		LF	SPECIAL PROVISION (PRESTRESSED CONCRETE NON-VOIDED SLABS)(18"x36")	900.640				
							240			240		LF	SPECIAL PROVISION (PRESTRESSED CONCRETE NON-VOIDED SLABS)(18"x48")	900.640				

PROJECT NAME: BRATTLEBORO

PROJECT NUMBER: BRO 1442(35)

FILE NAME: z10J062qs.dgn

PROJECT LEADER: S.E. BURBANK

DESIGNED BY: E.A. FIALA

BRIDGE QUANTITY SHEET #1

PLOT DATE: 11/12/2013

DRAWN BY: A.J. GOUDREAU

CHECKED BY: S.E. BURBANK

SHEET 10 OF 68



GENERAL INFORMATION

SYMBOLY LEGEND NOTE

THE SYMBOLY ON THIS SHEET IS INTENDED TO COVER STANDARD CONVENTIONAL SYMBOLY. THE SYMBOLY IS USED FOR EXISTING & PROPOSED FEATURES WITH HEAVIER LINEWEIGHT, IN COMBINATION WITH PROJECT ANNOTATION, AS NOTED ON PROJECT PLAN SHEETS. THIS LEGEND SHEET COVERS THE BASICS. SYMBOLY ON PLANS MAY VARY, PLAN ANNOTATIONS AND NOTES SHOULD BE USED TO CLARIFY AS NEEDED.

COMMON TOPOGRAPHIC POINT SYMBOLS

POINT	CODE	DESCRIPTION
⊛	APL	BOUND APPARENT LOCATION
◻	BM	BENCH MARK
◻	BND	BOUND
◻	CB	CATCH BASIN
⊕	COMB	COMBINATION POLE
◻	DITHR	DROP INLET THROATED DNC
⊕	EL	ELECTRIC POWER POLE
⊙	FPOLE	FLAGPOLE
⊙	GASFIL	GAS FILLER
⊙	GP	GUIDE POST
⊗	GSO	GAS SHUT OFF
⊙	GUY	GUY POLE
⊙	GUYW	GUY WIRE
⊗	GV	GATE VALUE
⊙	H	TREE HARDWOOD
△	HCTRL	CONTROL HORIZONTAL
△	HVCTRL	CONTROL HORIZ. & VERTICAL
◇	HYD	HYDRANT
⊙	IP	IRON PIN
⊙	IPIPE	IRON PIPE
⊕	LI	LIGHT - STREET OR YARD
⊕	MB	MAILBOX
⊙	MH	MANHOLE (MH)
⊙	MM	MILE MARKER
⊙	PM	PARKING METER
⊙	PMK	PROJECT MARKER
⊙	POST	POST STONE/WOOD
⊕	RRSIG	RAILROAD SIGNAL
⊕	RRSL	RAILROAD SWITCH LEVER
⊕	S	TREE SOFTWOOD
⊕	SAT	SATELLITE DISH
⊕	SHRUB	SHRUB
⊕	SIGN	SIGN
⊕	STUMP	STUMP
⊕	TEL	TELEPHONE POLE
⊕	TIE	TIE
⊕	TSIGN	SIGN W/DOUBLE POST
⊕	VCTRL	CONTROL VERTICAL
⊕	WELL	WELL
⊕	WSO	WATER SHUT OFF

THESE ARE COMMON VAOT SURVEY POINT SYMBOLS FOR EXISTING FEATURES, ALSO USED FOR PROPOSED FEATURES WITH HEAVIER LINEWEIGHT, IN COMBINATION WITH PROPOSED ANNOTATION.

PROPOSED GEOMETRY CODES

CODE	DESCRIPTION
PC	POINT OF CURVATURE
PI	POINT OF INTERSECTION
CC	CENTER OF CURVE
PT	POINT OF TANGENCY
PCC	POINT OF COMPOUND CURVE
PRC	POINT OF REVERSE CURVE
POB	POINT OF BEGINNING
POE	POINT OF ENDING
STA	STATION PREFIX
AH	AHEAD STATION SUFFIX
BK	BACK STATION SUFFIX
D	CURVE DEGREE OF (100FT)
R	CURVE RADUIS OF
T	CURVE TANGENT LENGTH
L	CURVE LENGTH OF
E	CURVE EXTERNAL DISTANCE

UTILITY SYMBOLY

UNDERGROUND UTILITIES	
— UT —	TELEPHONE
— UE —	ELECTRIC
— UC —	CABLE (TV)
— UEC —	ELECTRIC+CABLE
— UET —	ELECTRIC+TELEPHONE
— UCT —	CABLE+TELEPHONE
— UECT —	ELECTRIC+CABLE+TELEP.
— G —	GAS LINE
— W —	WATER LINE
— S —	SANITARY SEWER (SEPTIC)

ABOVE GROUND UTILITIES (AERIAL)

— T —	TELEPHONE
— E —	ELECTRIC
— C —	CABLE (TV)
— EC —	ELECTRIC+CABLE
— ET —	ELECTRIC+TELEPHONE
— AER E&T —	ELECTRIC+TELEPHONE
— CT —	CABLE+TELEPHONE
— ECT —	ELECTRIC+CABLE+TELEP.
— — —	UTILITY POLE GUY WIRE

PROJECT CONSTRUCTION SYMBOLY

PROJECT DESIGN & LAYOUT SYMBOLY	
— — — CZ — — —	CLEAR ZONE
— — — — —	PLAN LAYOUT MATCHLINE

PROJECT CONSTRUCTION FEATURES

△ — △ — △ — △ — △ — △ —	TOP OF CUT SLOPE
○ — ○ — ○ — ○ — ○ — ○ —	TOE OF FILL SLOPE
⊗ ⊗ ⊗ ⊗ ⊗ ⊗	STONE FILL
— — — — —	BOTTOM OF DITCH
— — — — —	CULVERT PROPOSED
— — — — —	STRUCTURE SUBSURFACE
PDF — PDF —	PROJECT DEMARCATION FENCE
BF — — — — — BF — — — — —	BARRIER FENCE
XXXXXXXXXXXXXXXXXXXX	TREE PROTECTION ZONE (TPZ)
//// //// //// //// ////	STRIPING LINE REMOVAL
~~~~ ~~~~ ~~~~ ~~~~ ~~~~	SHEET PILES

**CONVENTIONAL BOUNDARY SYMBOLY**

BOUNDARY LINES	
— TOWN LINE —	TOWN BOUNDARY LINE
— COUNTY LINE —	COUNTY BOUNDARY LINE
— STATE LINE —	STATE BOUNDARY LINE
— — — — —	PROPOSED STATE R.O.W. (LIMITED ACCESS)
— — — — —	PROPOSED STATE R.O.W.
— — — — —	STATE ROW (LIMITED ACCESS)
— — — — —	STATE ROW
— — — — —	TOWN ROW
— — — — —	PERMANENT EASEMENT LINE (P)
— — — — —	TEMPORARY EASEMENT LINE (T)
— — — — —	SURVEY LINE
+ — + — + — + — + — + —	PROPERTY LINE (P/L)
— P — — — — — P — — — — —	PROPERTY LINE (P/L)
— L — — — — — L — — — — —	PROPERTY LINE (P/L)
— SR — — — — — SR — — — — — SR — — — — —	SLOPE RIGHTS
6f — — — — — 6f — — — — —	6F PROPERTY BOUNDARY
4f — — — — — 4f — — — — —	4F PROPERTY BOUNDARY
HAZ — — — — — HAZ — — — — —	HAZARDOUS WASTE

**EPSC LAYOUT PLAN SYMBOLY**

EPSC MEASURES	
ONNOONNOONNO	FILTER CURTAIN
— — — — —	SILT FENCE
— X — X — X — X — X — X —	SILT FENCE WOVEN WIRE
— — — — —	CHECK DAM
— — — — —	DISTURBED AREAS REQUIRING RE-VEGETATION
— — — — —	EROSION MATTING

**ENVIRONMENTAL RESOURCES**

— — — — —	WETLAND BOUNDARY
— — — — —	RIPARIAN BUFFER ZONE
— — — — —	WETLAND BUFFER ZONE
— — — — —	SOIL TYPE BOUNDARY
— T&E — — — — —	THREATENED & ENDANGERED SPECIES
— HAZ — — — — — HAZ — — — — —	HAZARDOUS WASTE AREA
— AG — — — — —	AGRICULTURAL LAND
— HABITAT — — — — —	FISH & WILDLIFE HABITAT
— FLOOD PLAIN — — — — —	FLOOD PLAIN
— OHW — — — — —	ORDINARY HIGH WATER (OHW)
— — — — —	STORM WATER
— — — — —	USDA FOREST SERVICE LANDS
— — — — —	WILDLIFE HABITAT SUIT/CONN

**ARCHEOLOGICAL & HISTORIC**

— ARCH — — — — —	ARCHEOLOGICAL BOUNDARY
— HISTORIC DIST — — — — —	HISTORIC DISTRICT BOUNDARY
— HISTORIC — — — — —	HISTORIC AREA
(H)	HISTORIC STRUCTURE

**CONVENTIONAL TOPOGRAPHIC SYMBOLY**

EXISTING FEATURES	
— — — — —	ROAD EDGE PAVEMENT
— — — — —	ROAD EDGE GRAVEL
— — — — —	DRIVEWAY EDGE
— — — — —	DITCH
— — — — —	FOUNDATION
— — — — —	FENCE (EXISTING)
— — — — —	FENCE WOOD POST
— — — — —	FENCE STEEL POST
— — — — —	GARDEN
— — — — —	ROAD GUARDRAIL
— — — — —	RAILROAD TRACKS
— — — — —	CULVERT (EXISTING)
— — — — —	STONE WALL
— — — — —	WALL
— — — — —	WOOD LINE
— — — — —	BRUSH LINE
— — — — —	HEDGE
— — — — —	BODY OF WATER EDGE
— — — — —	LEDGE EXPOSED

**R.O.W. ABBREVIATIONS (CODES) & SYMBOLS**

POINT	CODE	DESCRIPTION
CH		CHANNEL EASEMENT
CONST		CONSTRUCTION EASEMENT
CUL		CULVERT EASEMENT
D&C		DISCONNECT & CONNECT
DIT		DITCH EASEMENT
DR		DRAINAGE EASEMENT
DRIVE		DRIVEWAY EASEMENT
EC		EROSION CONTROL
I&M		INSTALL & MAINTAIN EASEMENT
LAND		LANDSCAPE EASEMENT
SR		SLOPE RIGHT
UE		UTILITY EASEMENT
(P)		PERMANENT EASEMENT
(T)		TEMPORARY EASEMENT
■	BNDNS	BOUND SET
◻	BNDNS	BOUND TO BE SET
●	IPNS	IRON PIN SET
⊙	IPNS	IRON PIN TO BE SET
⊗	CALC	CALCULATED ROW POINT [DISTANCE]
		DISTANCE CARRIED ON NEXT SHEET

PROJECT NAME: BRATTLEBORO  
PROJECT NUMBER: BRO 1442(35)

FILE NAME: z10J062LegendSheet.dgn  
PROJECT LEADER: S.E. BURBANK  
DESIGNED BY: VTRANS  
CONVENTIONAL SYMBOLY LEGEND

PLOT DATE: 10/14/2013  
DRAWN BY: E.A. FIALA  
CHECKED BY: S.E. BURBANK  
SHEET II OF 68



GPS CONTROL POINTS

**HVCTRL #2**

MAG NAIL SET  
 NORTH = 135124.4650  
 EAST = 1607422.7270  
 ELEV. = 541.0500





GENERAL LOCATION, WEST BRATTLEBORO, VT. FROM THE INTERSECTION OF VT ROUTE 9 AND SUNSET LAKE ROAD (T.H.12), PROCEED NORTH ON SUNSET LAKE ROAD (T.H.12) FOR 0.2 MI (0.3 KM) TO THE SOUTHWEST CORNER OF BRIDGE 7 OVER HALLADAY BROOK AND THE MARK ON THE LEFT. THE MARK IS SET IN THE PAVEMENT. SEE TRAVERSE TIES BELOW FOR TIE DISTANCES.

**VCTRL #106**

B 14 RESET 1988  
 NORTH = 134276.6160  
 EAST = 1608361.3210  
 ELEV. = 522.7390

GENERAL LOCATION, BRATTLEBORO, VT., ABOUT 3.5 MI (5.6 KM) WEST OF BRATTLEBORO, ABOUT 13 MI (20.9 KM) EAST OF WILMINGTON, AND ABOUT 9.5 MI (15.3 KM) NORTH OF THE MASSACHUSETTS/VERMONT STATE LINE. TO REACH FROM THE EAST END OF THE VT ROUTE 9 BRIDGE OVER I-91 IN BRATTLEBORO GO WEST ALONG VT ROUTE 9 FOR 2.6 MI (4.2 KM) TO THE INTERSECTION OF WESTGATE DRIVE LEFT AND WINDING HILL ROAD RIGHT. TURN RIGHT AND GO NORTH ALONG WINDING HILL ROAD FOR 0.1 MI (0.2 KM) TO THE SOUTH END OF THE BRIDGE OVER HALLADAY BROOK AND THE MARK ON THE LEFT, SET IN THE TOP OF THE WINGWALL AT THE SOUTHWEST CORNER OF THE BRIDGE. THE MARK IS A STATE OF VERMONT SURVEY MARK AND IS 18.4 FT (5.6 M) WEST OF AND ABOUT 1.6 FT (0.5 M) LOWER THAN THE CENTERLINE OF WINDING HILL ROAD, 78.1 FT (23.8 M) EAST OF POLE NO.7-0-27/7-0/3/3, 99.1 FT (30.2 M) NORTH OF POLE NO.2A (WITH LUMEN), AND 18.0 FT (5.5 M) NORTHEAST OF A WATER METER MANHOLE.

TRAVERSE TIES

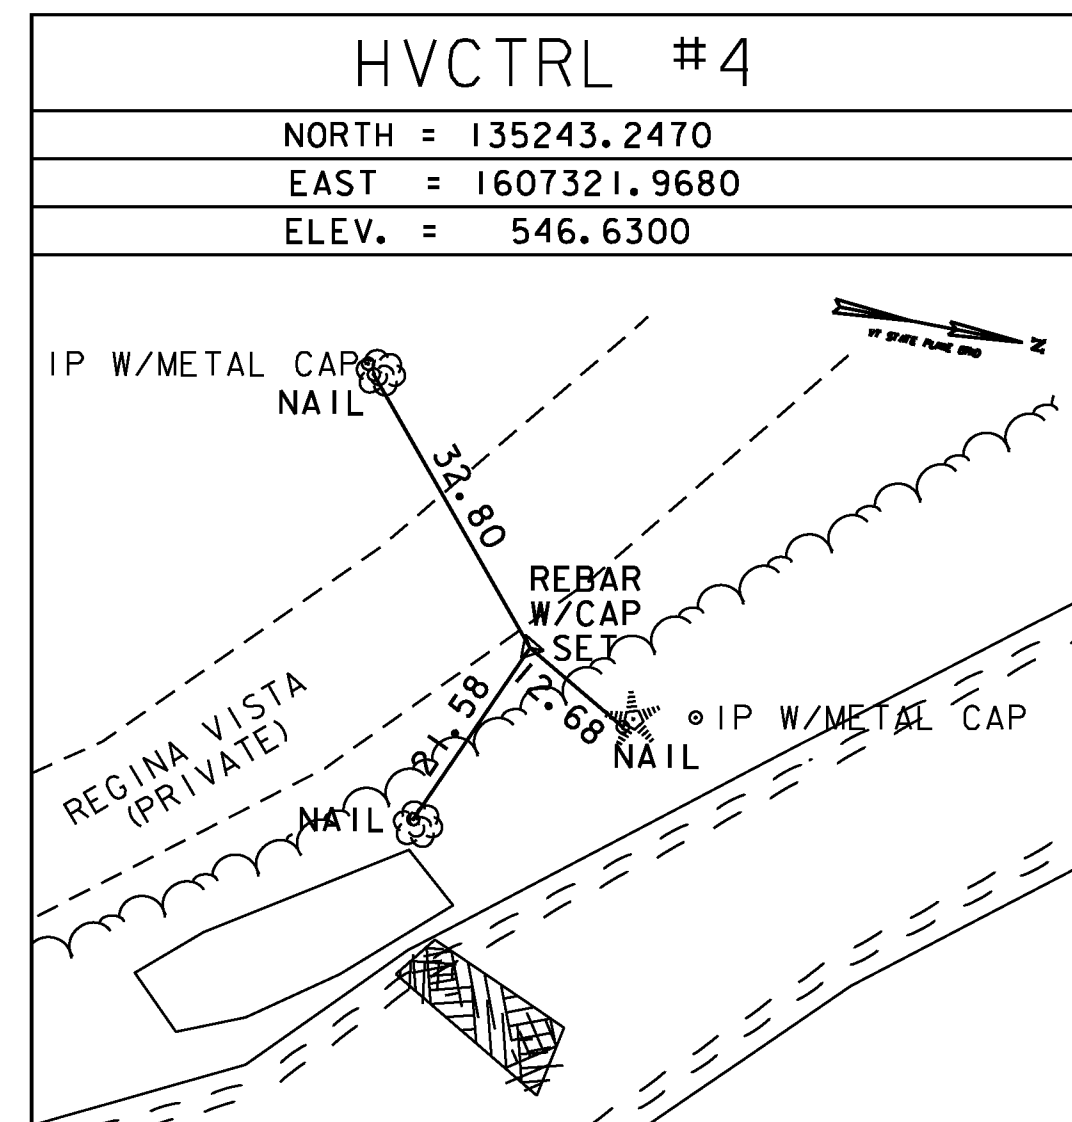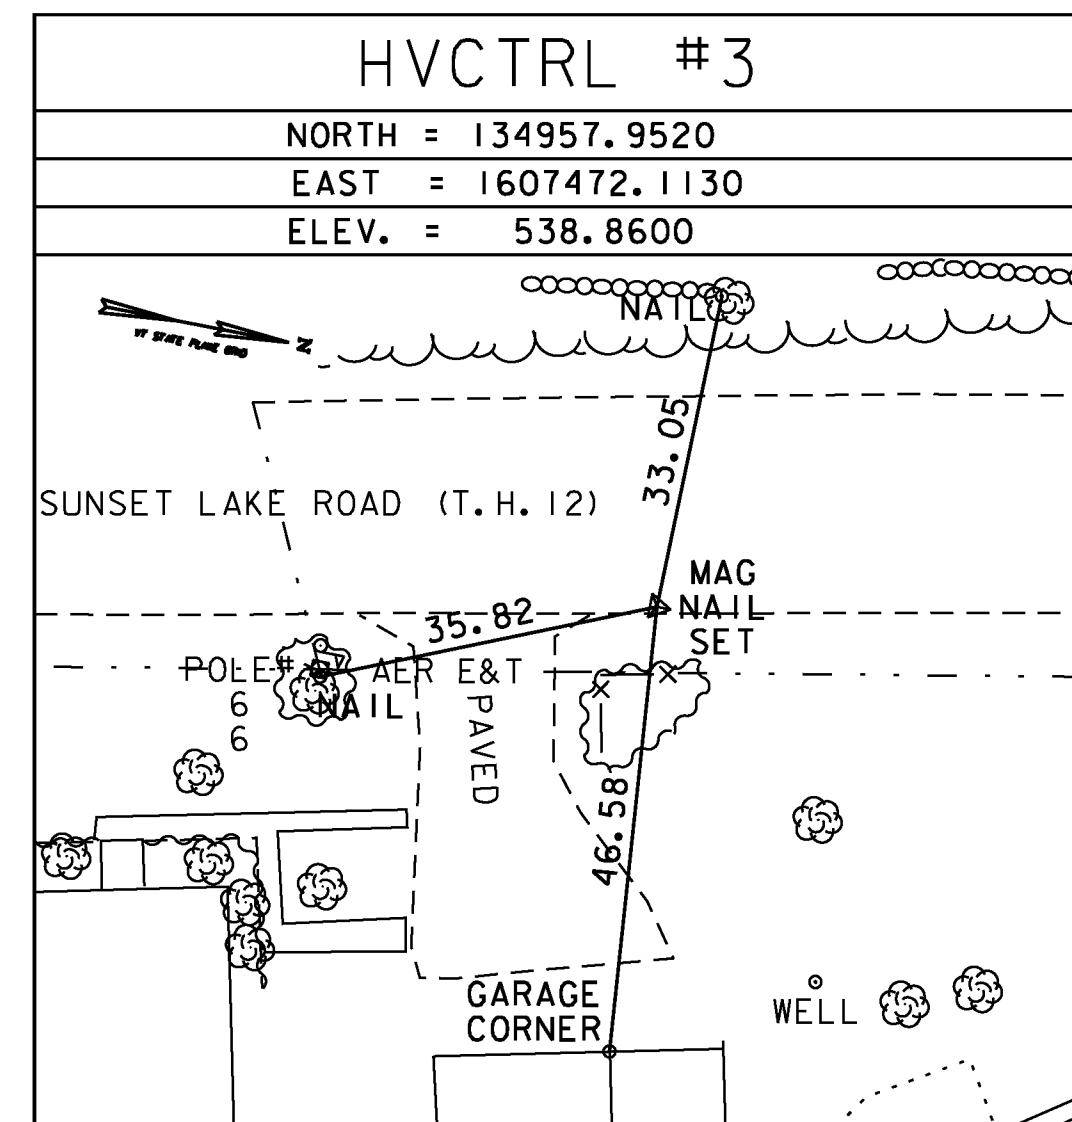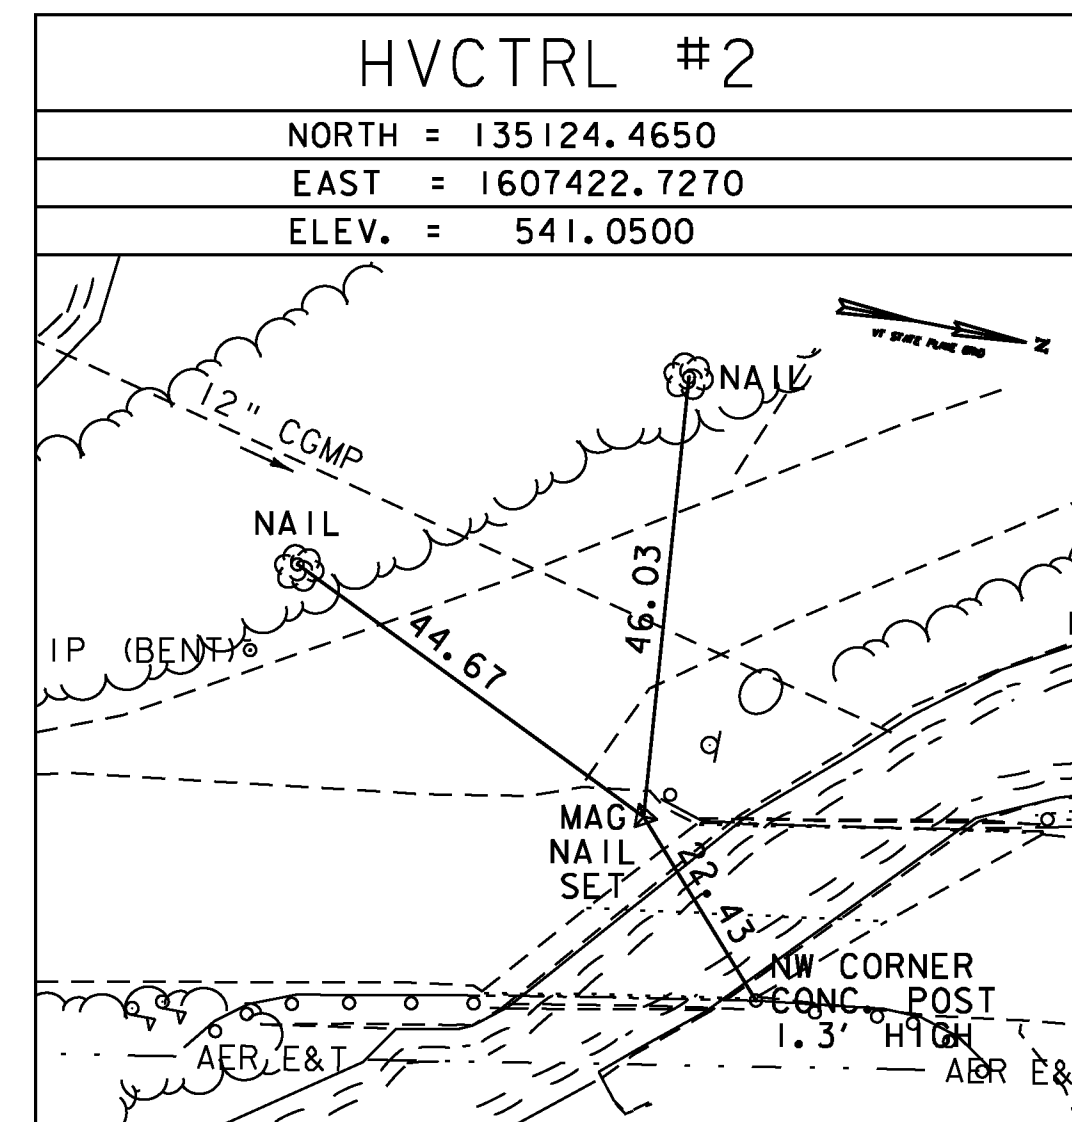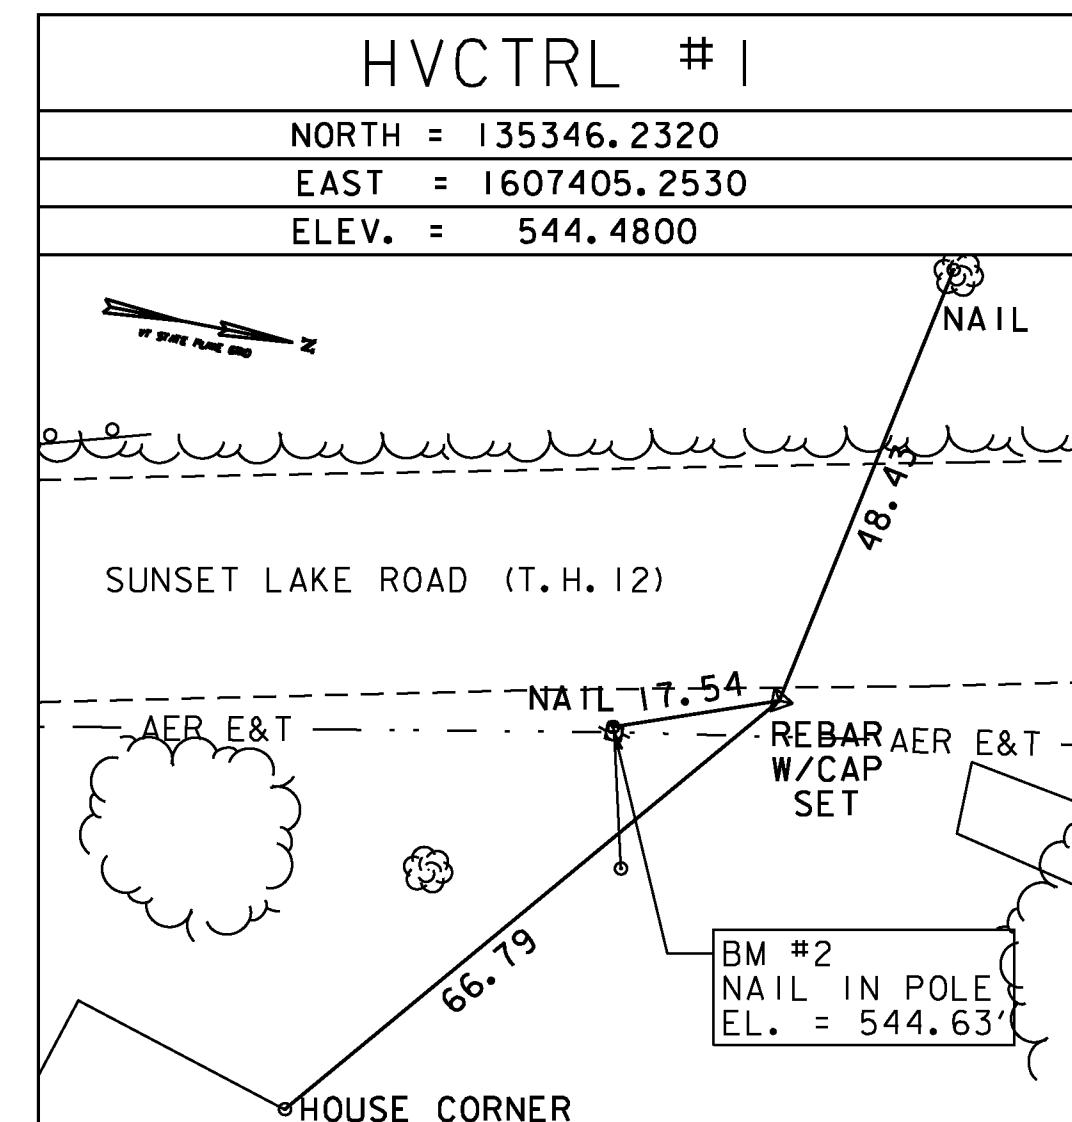


* Main Traverse Completed 11/15/10 by T.J.Gaudet and B.M.Klinefelter

DATUM	
VERTICAL	NAVD 88
HORIZONTAL	NAD 83 (07)

PROJECT NAME:	BRATTLEBORO
PROJECT NUMBER:	BRO 1442(35)
FILE NAME:	z10J062+1.dgn
PROJECT LEADER:	S.E. BURBANK
DESIGNED BY:	B.M. KLINEFELTER
TIE SHEET	
PLOT DATE:	10/14/2013
DRAWN BY:	B.M. KLINEFELTER
CHECKED BY:	J.W. GOLEK
SHEET	12 OF 68



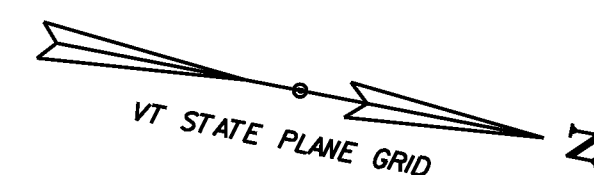

**DETOUR (T.H. 12)  
CURVE NO. 1 DATA**  
 $\Delta = 19^{\circ}05'20.51''$   
 $D = 43^{\circ}04'46.32''$   
 $R = 133.00'$   
 $T = 22.36'$   
 $L = 44.31'$   
 $E = 1.87'$   
 BANK = NONE

**DETOUR (T.H. 12)  
CURVE NO. 2 DATA**  
 $\Delta = 60^{\circ}21'44.73''$   
 $D = 127^{\circ}19'26.24''$   
 $R = 45.00'$   
 $T = 26.17'$   
 $L = 47.41'$   
 $E = 7.06'$   
 BANK = NONE

**DETOUR (T.H. 12)  
CURVE NO. 3 DATA**  
 $\Delta = 38^{\circ}31'27.38''$   
 $D = 57^{\circ}17'44.81''$   
 $R = 100.00'$   
 $T = 34.95'$   
 $L = 67.24'$   
 $E = 5.93'$   
 BANK = NONE

**MAINLINE ALIGNMENT**

Horizontal Alignment Name: TH 12 Proposed

Element:	STATION	NORTHING	EASTING
Element: Linear			
POB (24)	100+00.00	134840.8468	1607485.0762
PC (25)	100+95.56	134934.4914	1607466.0249
Tangent Direction:	N 11°29'58.03" W		
Tangent Length:	95.56		

Element: Circular			
PC (25)	100+95.56	134934.4914	1607466.0249
PI	101+78.38	135015.6414	1607449.5155
CC (26)	102+61.15	135580.4132	1610640.9871
PT (27)	102+61.15	135097.5289	1607437.1733


Radius: 3240.00  
 Delta: 2°55'41.70" Right  
 Degree of Curvature: 1°46'06.20"  
 Length: 165.59  
 Tangent: 82.81  
 Chord: 165.57  
 Middle Ordinate: 1.06  
 External: 1.06  
 Tangent Direction: N 11°29'58.03" W  
 Radial Direction: N 78°30'01.97" E  
 Chord Direction: N 10°02'07.18" W  
 Radial Direction: N 81°25'43.67" E  
 Tangent Direction: N 8°34'16.33" W

Element: Linear			
PT (27)	102+61.15	135097.5289	1607437.1733
PC (28)	103+35.54	135171.0912	1607426.0859
Tangent Direction:	N 8°34'16.33" W		
Tangent Length:	74.39		

Element: Circular			
PC (28)	103+35.54	135171.0912	1607426.0859
PI	104+20.88	135255.4781	1607413.3669
CC (30)	105+06.15	134817.8702	1605082.5554
PT (31)	105+06.15	135338.7317	1607394.6115

Radius: 2370.00  
 Delta: 4°07'28.14" Left  
 Degree of Curvature: 2°25'03.16"  
 Length: 170.61  
 Tangent: 85.34  
 Chord: 170.57  
 Middle Ordinate: 1.53  
 External: 1.54  
 Tangent Direction: N 8°34'16.33" W  
 Radial Direction: N 81°25'43.67" E  
 Chord Direction: N 10°38'00.40" W  
 Radial Direction: N 77°18'15.52" E  
 Tangent Direction: N 12°41'44.48" W

Element: Linear			
PT (31)	105+06.15	135338.7317	1607394.6115
POE (29)	106+00.00	135430.2829	1607373.9868
Tangent Direction:	N 12°41'44.48" W		
Tangent Length:	93.85		

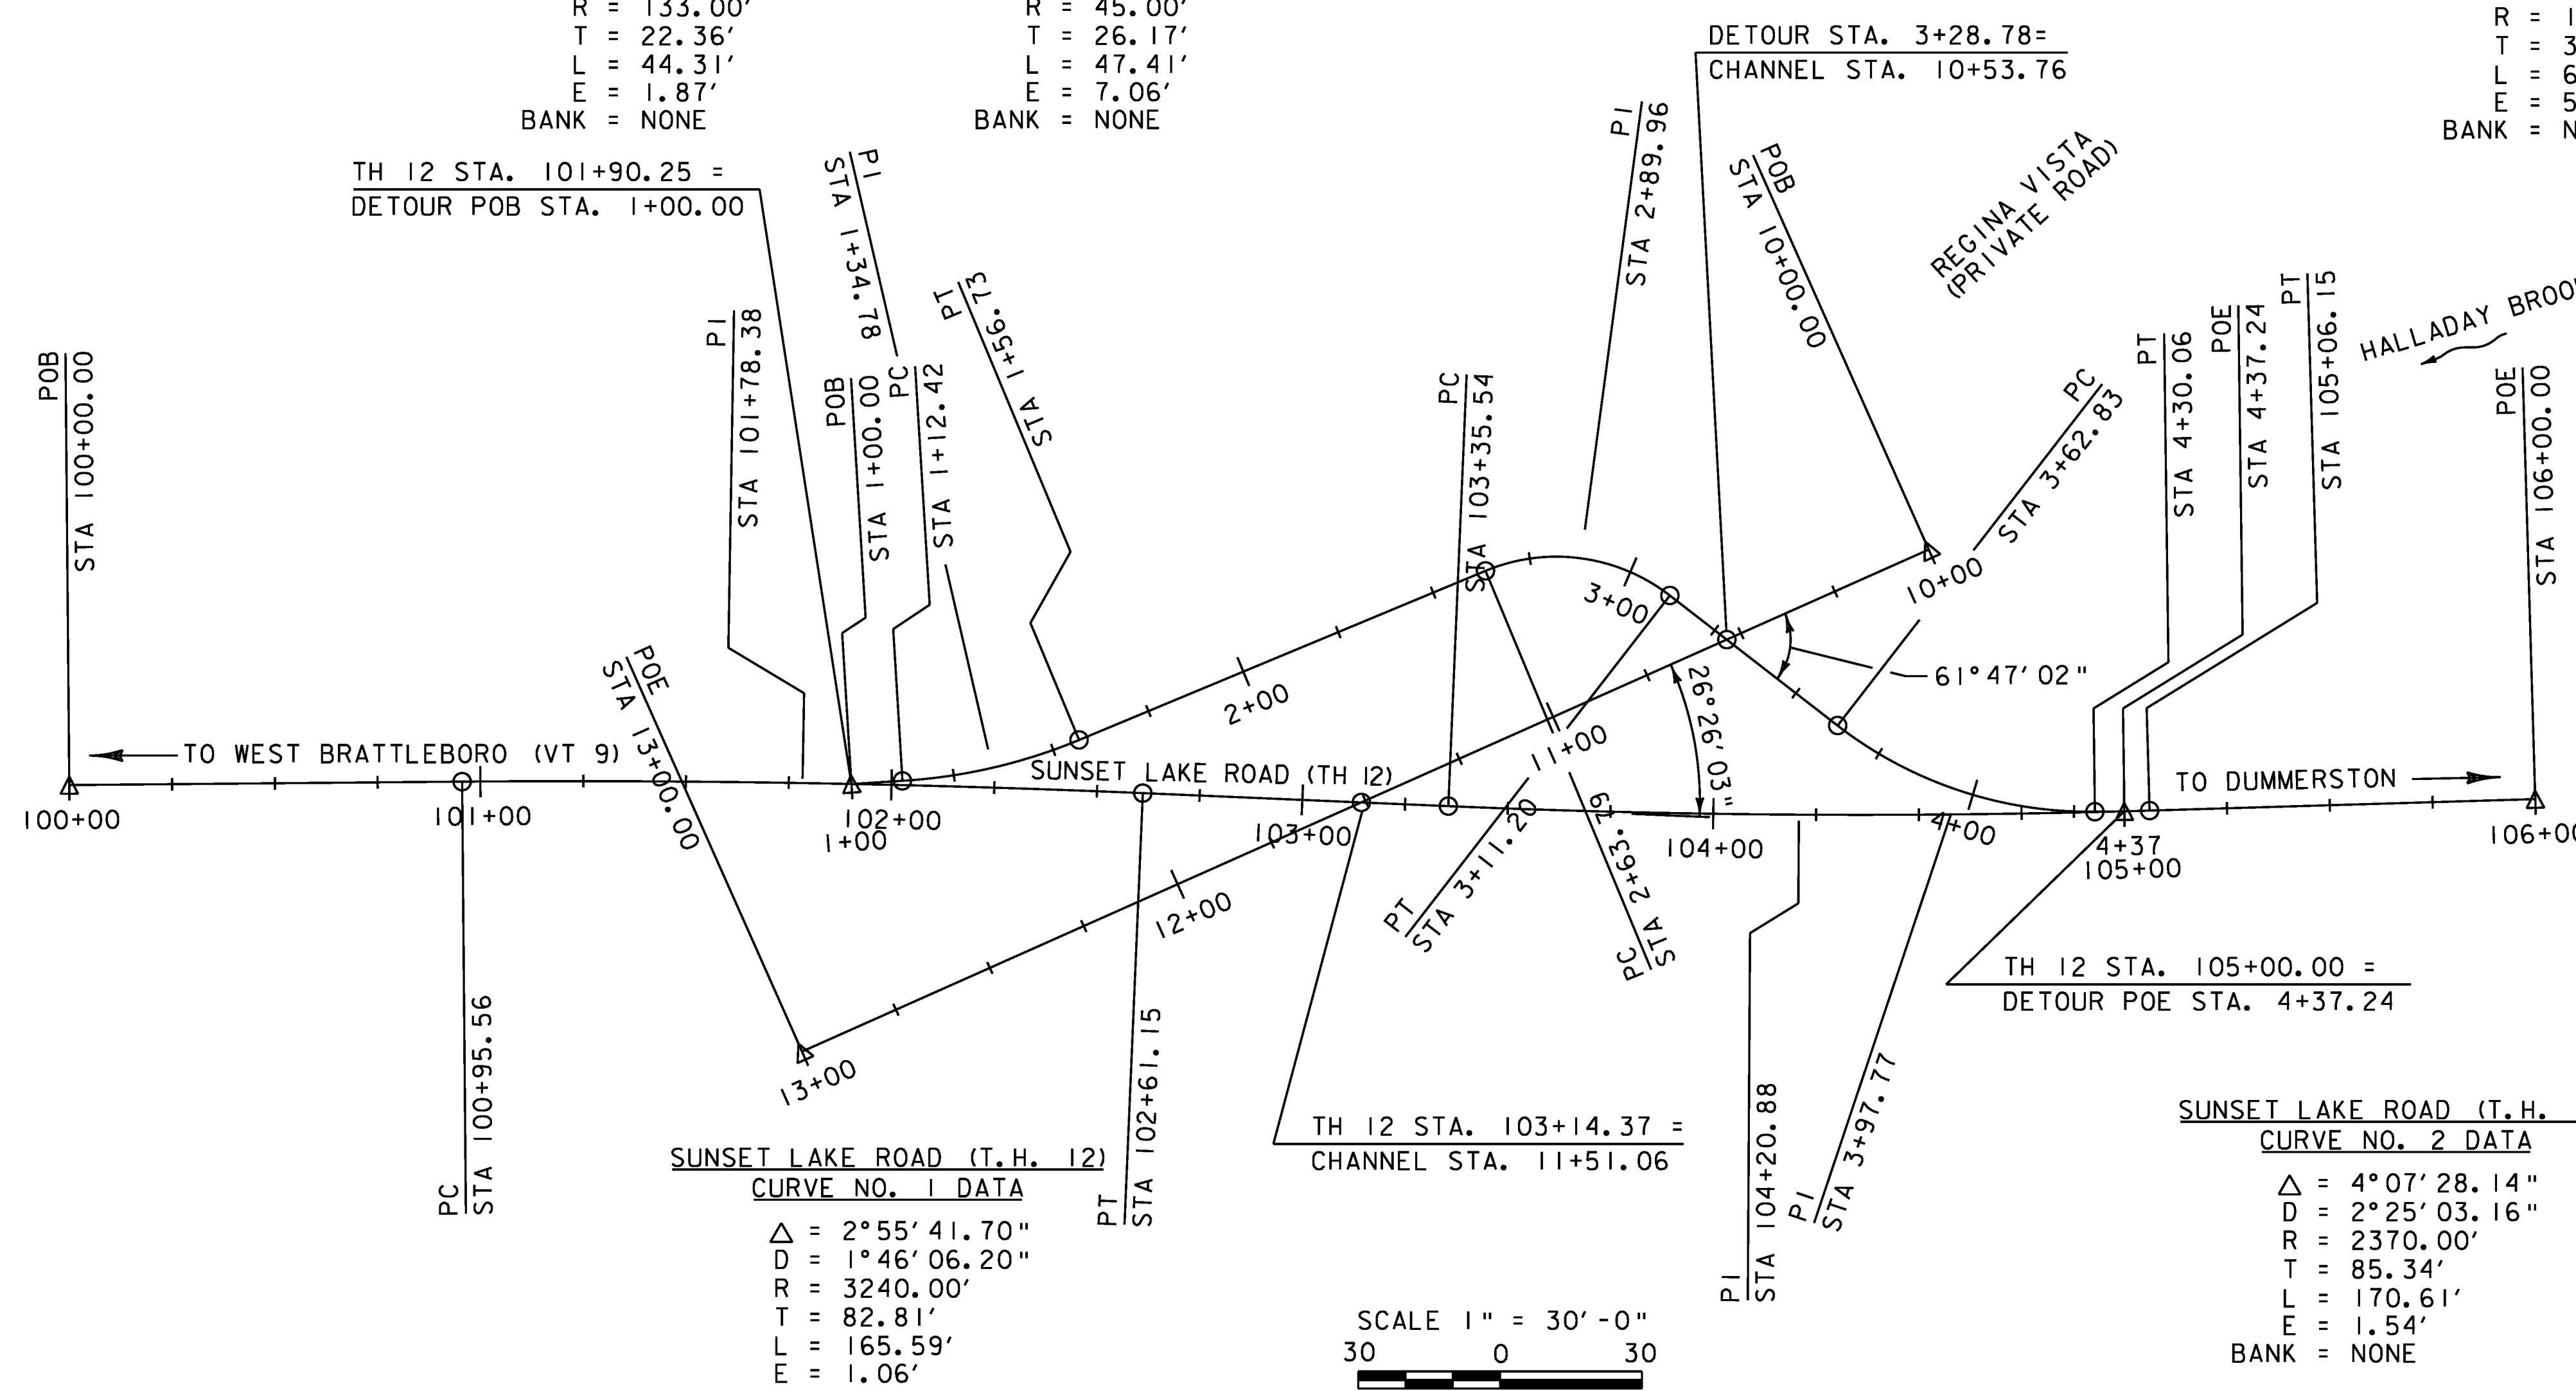

**SUNSET LAKE ROAD (T.H. 12)  
CURVE NO. 1 DATA**  
 $\Delta = 2^{\circ}55'41.70''$   
 $D = 1^{\circ}46'06.20''$   
 $R = 3240.00'$   
 $T = 82.81'$   
 $L = 165.59'$   
 $E = 1.06'$   
 BANK = NONE

**SUNSET LAKE ROAD (T.H. 12)  
CURVE NO. 2 DATA**  
 $\Delta = 4^{\circ}07'28.14''$   
 $D = 2^{\circ}25'03.16''$   
 $R = 2370.00'$   
 $T = 85.34'$   
 $L = 170.61'$   
 $E = 1.54'$   
 BANK = NONE

**DETOUR ALIGNMENT**

Horizontal Alignment Name:	STATION	NORTHING	EASTING
Element: Linear			
POB (13)	1+00.00	135027.5412	1607448.5065
PC (14)	1+12.42	135039.5643	1607445.3982
Tangent Direction:	N 14°29'41.61" W		
Tangent Length:	12.42		
Element: Circular			
PC (14)	1+12.42	135039.5643	1607445.3982
PI	1+34.78	135061.2153	1607439.8010
CC (15)	1+56.73	135006.2752	1607316.6316
PT (39)	1+56.73	135079.8452	1607427.4308
Radius:	133.00		
Delta:	19°05'20.51" Left		
Degree of Curvature (Arc):	43°04'46.32"		
Length:	44.31		
Tangent:	22.36		
Chord:	44.11		
Middle Ordinate:	1.84		
External:	1.87		
Tangent Direction:	N 14°29'41.61" W		
Radial Direction:	N 75°30'18.39" E		
Chord Direction:	N 24°02'21.87" W		
Radial Direction:	N 56°24'57.88" E		
Tangent Direction:	N 33°35'02.12" W		

Horizontal Alignment Name:	STATION	NORTHING	EASTING
Element: Linear			
PT (39)	1+56.73	135079.8452	1607427.4308
PC (36)	2+63.79	135169.0338	1607368.2101
Tangent Direction:	N 33°35'02.12" W		
Tangent Length:	107.06		
Element: Circular			
PC (36)	2+63.79	135169.0338	1607368.2101
PI	2+89.96	135190.8362	1607353.7335
CC (37)	3+11.20	135193.9259	1607405.6985
PT (38)	3+11.20	135214.2004	1607365.5246
Radius:	45.00		
Delta:	60°21'44.73" Right		
Degree of Curvature (Arc):	127°19'26.24"		
Length:	47.41		
Tangent:	26.17		
Chord:	45.25		
Middle Ordinate:	6.10		
External:	7.06		
Tangent Direction:	N 33°35'02.12" W		
Radial Direction:	N 56°24'57.88" E		
Chord Direction:	N 3°24'09.76" W		
Radial Direction:	S 63°13'17.40" E		
Tangent Direction:	N 26°46'42.60" E		
Element: Linear			
PT (38)	3+11.20	135214.2004	1607365.5246
PC (21)	3+62.83	135260.2927	1607388.7858
Tangent Direction:	N 26°46'42.60" E		
Tangent Length:	51.63		

Horizontal Alignment Name:	STATION	NORTHING	EASTING
Element: Circular			
PC (21)	3+62.83	135260.2927	1607388.7858
PI	3+97.77	135291.4903	1607404.5301
CC (22)	4+30.06	135305.3469	1607299.5103
PT (23)	4+30.06	135325.7039	1607397.4163
Radius:	100.00		
Delta:	38°31'27.38" Left		
Degree of Curvature (Arc):	57°17'44.81"		
Length:	67.24		
Tangent:	34.95		
Chord:	65.98		
Middle Ordinate:	5.60		
External:	5.93		
Tangent Direction:	N 26°46'42.60" E		
Radial Direction:	S 63°13'17.40" E		
Chord Direction:	N 7°30'58.91" E		
Radial Direction:	N 78°15'15.22" E		
Tangent Direction:	N 11°44'44.78" W		
Element: Linear			
PT (23)	4+30.06	135325.7039	1607397.4163
POE (35)	4+37.24	135332.7293	1607395.9556
Tangent Direction:	N 11°44'44.78" W		
Tangent Length:	7.18		


DATUM  
 VERTICAL NAVD 88  
 HORIZONTAL NAD 83 (07)



PROJECT NAME: BRATTLEBORO  
 PROJECT NUMBER: BRO 1442(35)

FILE NAME: z10j062alg layout.dgn  
 PROJECT LEADER: S.E. BURBANK  
 DESIGNED BY: J.W. GOLEK  
 ALIGNMENT LAYOUT SHEET

PLOT DATE: 10/14/2013  
 DRAWN BY: J.W. GOLEK  
 CHECKED BY: S.E. BURBANK  
 SHEET 13 OF 68

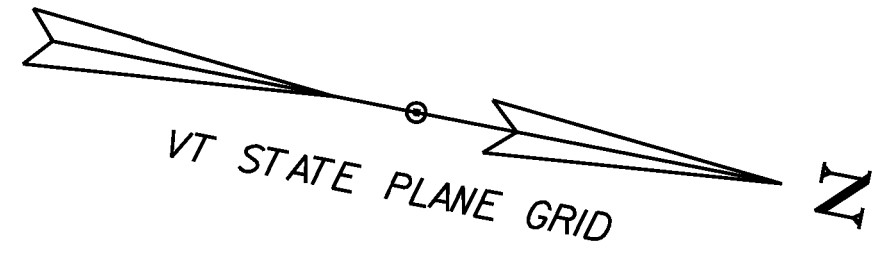

CONSTRUCT 11.5' PAVED APRON  
STA. 102+69, LT - 41.5' WIDE

CONSTRUCT 12' PAVED DRIVE  
STA. 103+59, RT - 12' WIDE

REMOVAL AND DISPOSAL OF GUARDRAIL  
STA. 102+43 - 102+73, RT  
STA. 102+92 - 102+96, LT  
STA. 103+03 - 103+27, RT  
STA. 103+31 - 104+46, LT

COLD PLANING, BITUMINOUS PAVEMENT  
STA. 101+35 - 101+55, LT & RT  
STA. 105+25 - 105+45, LT & RT

SPECIAL PROVISION (BRIDGE  
RAILING, GALVANIZED HDSB/FASCIA  
MOUNTED/STEEL TUBING)  
STA. 102+43 - 103+25, RT  
STA. 102+88 - 104+08, LT

GUARDRAIL APPROACH SECTION, GALVANIZED  
HD STEEL BEAM W/8 FEET POSTS


STA. 102+18 - 102+43, RT  
STA. 102+92, 24.58' LT - 102+88, LT  
STA. 104+08 - 104+33, LT  
STA. 103+25 - 103+36, RT  
RELOCATE MAILBOX, MULTIPLE SUPPORT  
STA. 102+39, RT

RELOCATE MAILBOX, SINGLE SUPPORT  
STA. 103+83, RT

STEEL BEAM GUARDRAIL,  
GALVANIZED W/8 FEET POSTS


STA. 102+12 - 102+18, RT 103+24  
STA. 102+92, 24.58' LT - 103+20, 38.4' LT  
STA. 104+33 - 104+63, LT  
ANCHOR FOR STEEL BEAM RAIL  
STA. 102+06, RT 102+18, RT  
STA. 103+25, 40.75' LT  
STA. 103+30, RT  
STA. 104+69, LT

STEEL BEAM GUARDRAIL, GALV.  
~~STA. 102+00 - 102+12, RT~~  
~~STA. 103+20, 38.4' LT - 103+34, 44.5' LT~~  
~~STA. 103+25 - 103+36, RT~~  
~~STA. 104+63 - 104+76, LT~~  
STA. 102+07 - 102+18, RT  
STA. 103+36 - (2' ON END OF GRASS), RT  
STA. 103+24 - 103+34, LT  
STA. 104+70 - 104+80, LT

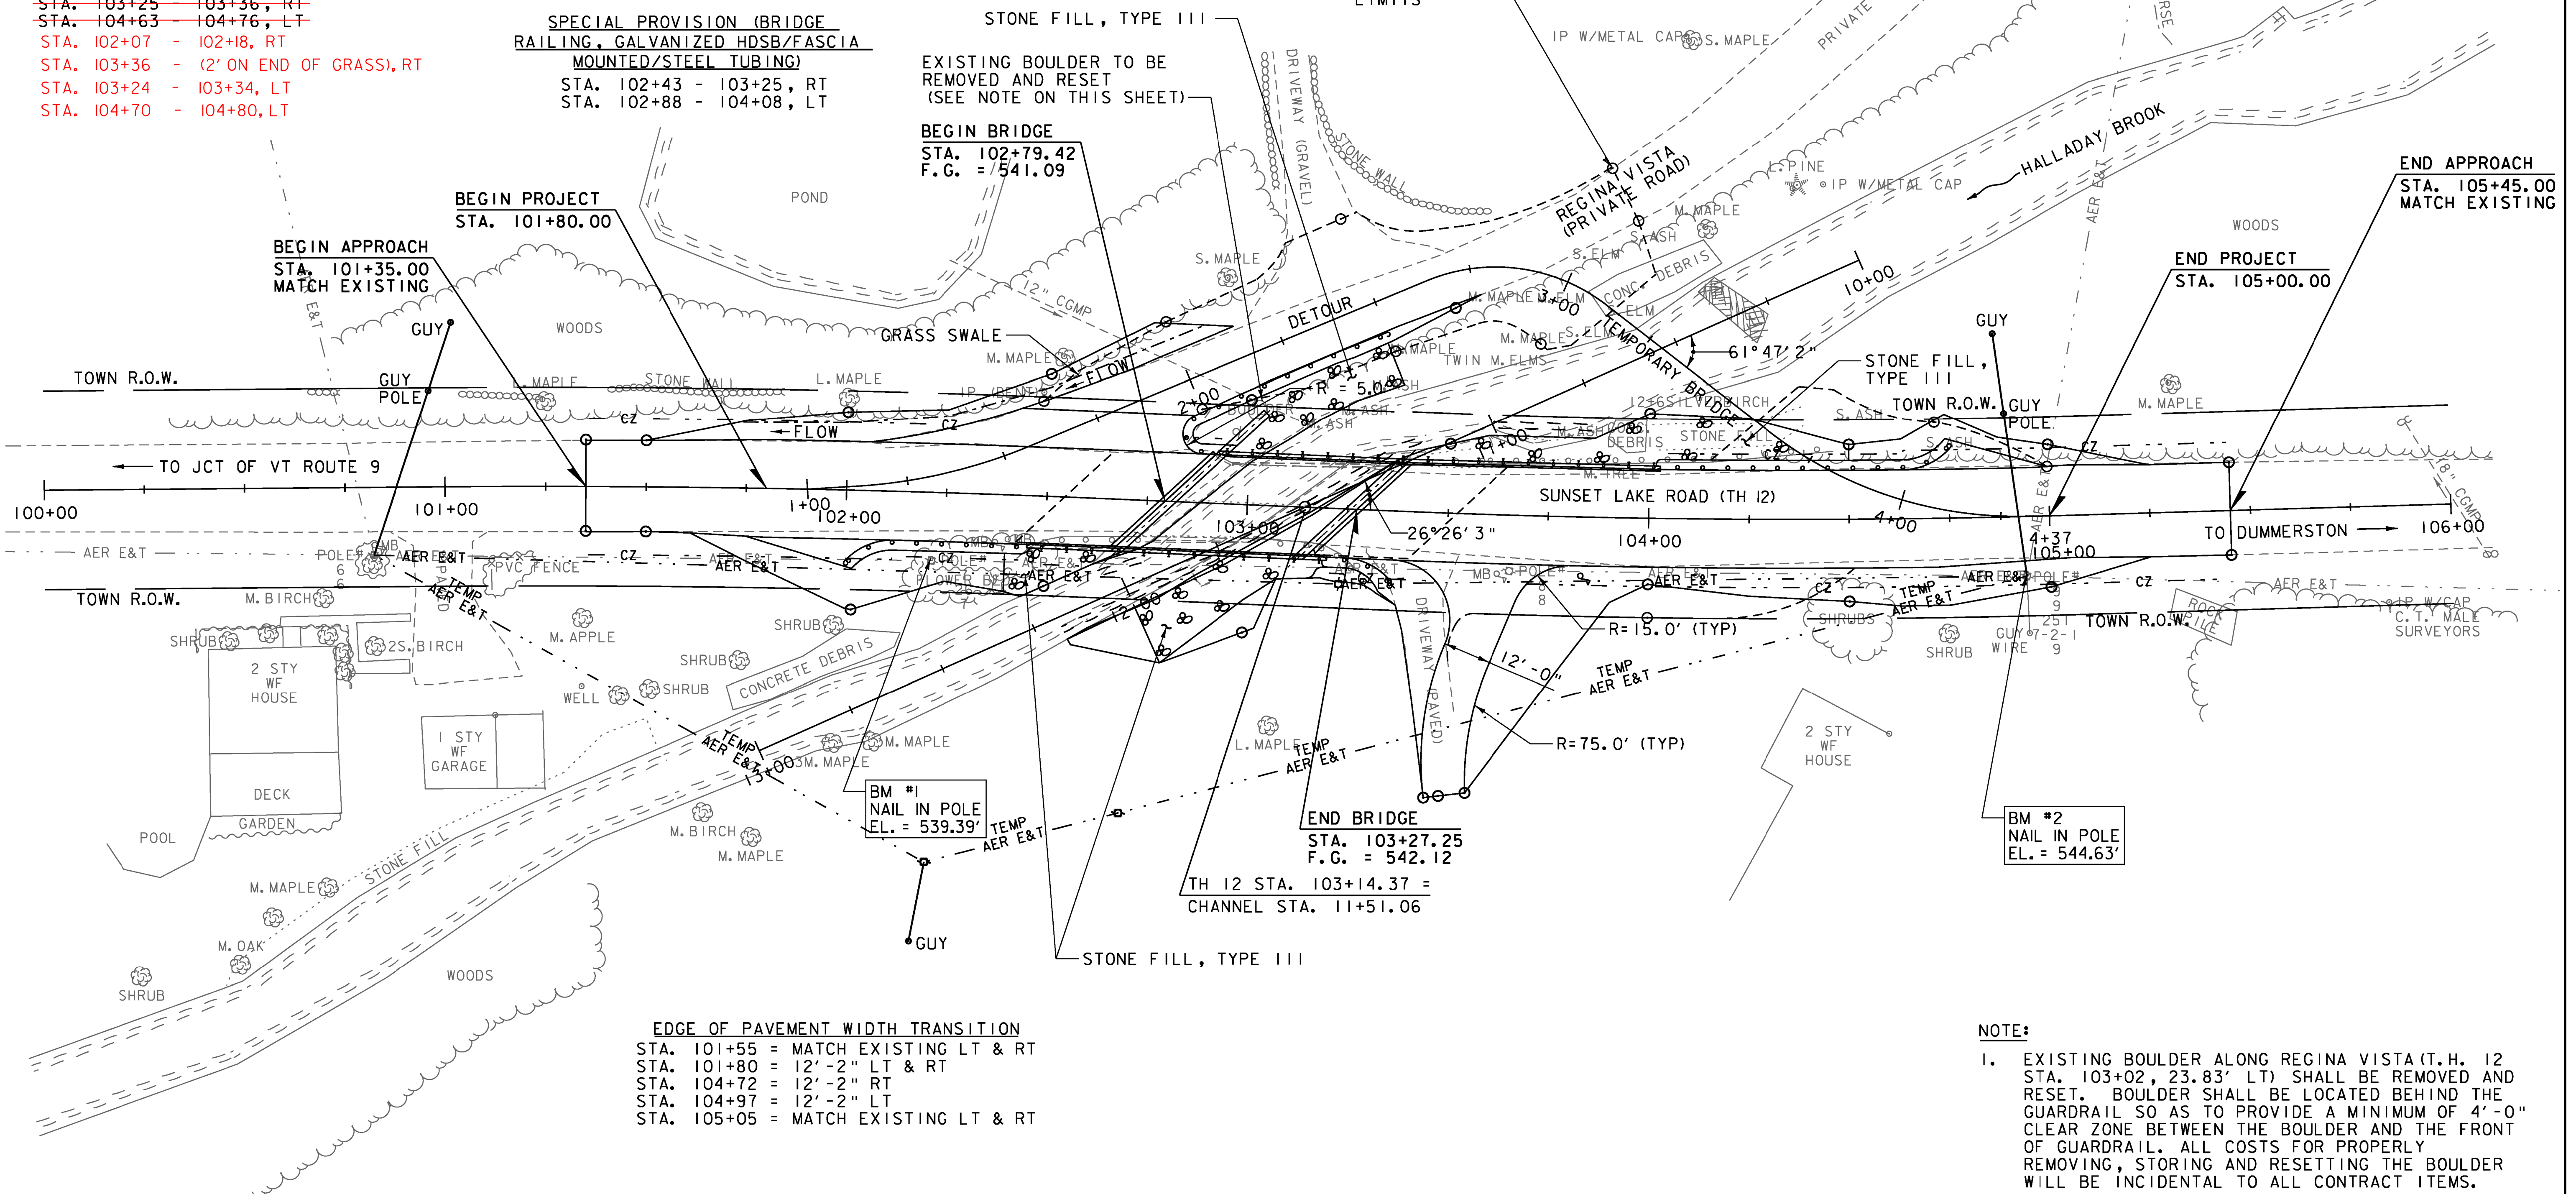


EDGE OF PAVEMENT WIDTH TRANSITION  
STA. 101+55 = MATCH EXISTING LT & RT  
STA. 101+80 = 12'-2" LT & RT  
STA. 104+72 = 12'-2" RT  
STA. 104+97 = 12'-2" LT  
STA. 105+05 = MATCH EXISTING LT & RT

NOTE:  
1. EXISTING BOULDER ALONG REGINA VISTA (T.H. 12 STA. 103+02, 23.83' LT) SHALL BE REMOVED AND RESET. BOULDER SHALL BE LOCATED BEHIND THE GUARDRAIL SO AS TO PROVIDE A MINIMUM OF 4'-0" CLEAR ZONE BETWEEN THE BOULDER AND THE FRONT OF GUARDRAIL. ALL COSTS FOR PROPERLY REMOVING, STORING AND RESETTING THE BOULDER WILL BE INCIDENTAL TO ALL CONTRACT ITEMS.

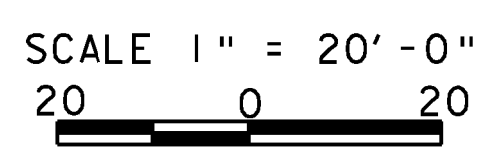

PROJECT NAME:	BATTLEBORO
PROJECT NUMBER:	BRO 1442(35)
FILE NAME:	z10j062bdr_nul.dgn
PROJECT LEADER:	S.E. BURBANK
DESIGNED BY:	S.E. BURBANK
LAYOUT SHEET	
PLOT DATE:	10/14/2013
DRAWN BY:	E.A. FIALA
CHECKED BY:	S.E. BURBANK
SHEET	14 OF 68



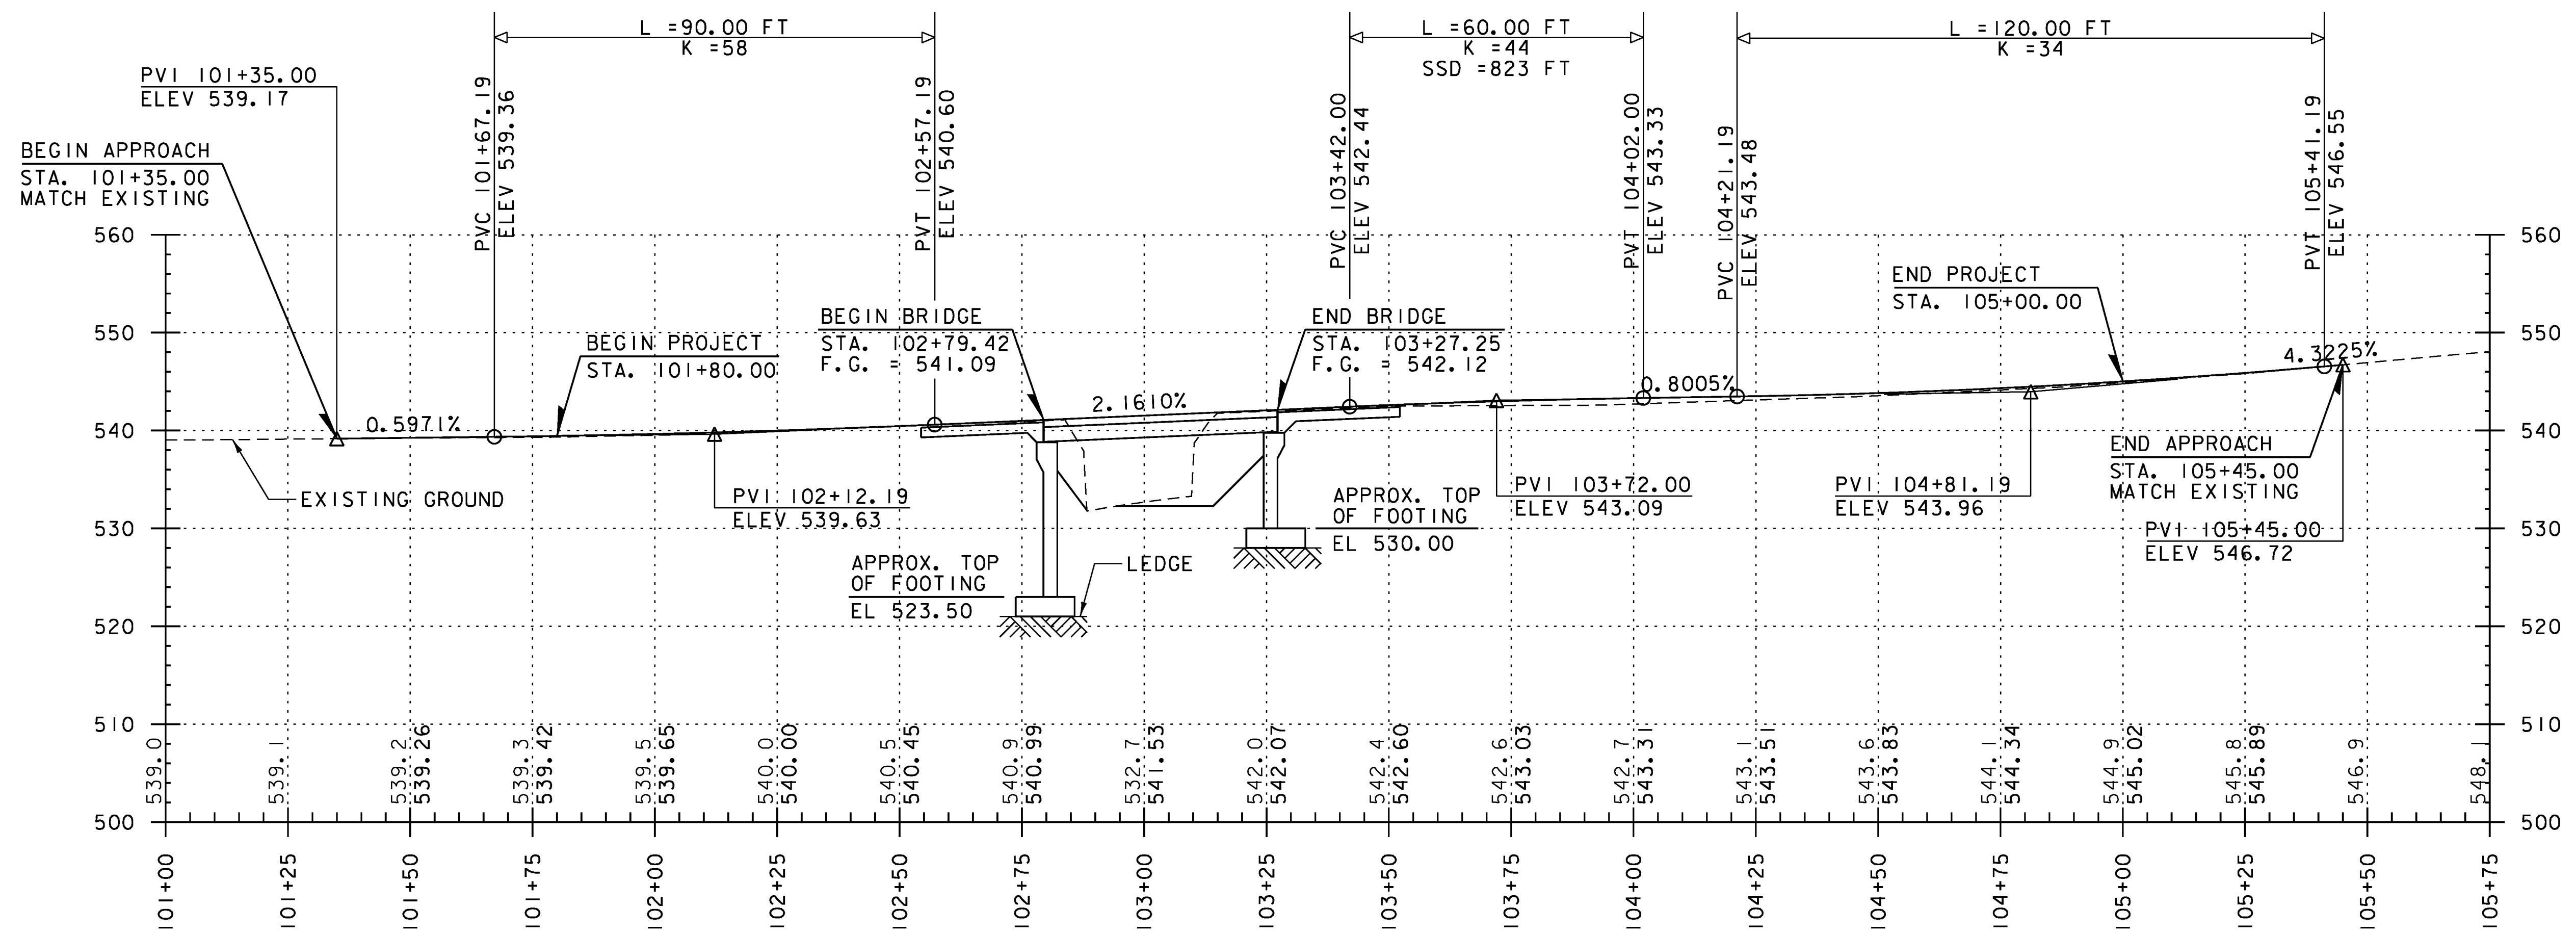


TH 12 PROFILE  
 SCALE 1" = 20' HORIZONTAL  
 1" = 10' VERTICAL

THE GRADES SHOWN TO THE NEAREST TENTH ARE THE ORIGINAL GROUND ELEVATIONS ALONG THE PROPOSED ALIGNMENT. THE GRADES SHOWN TO THE NEAREST HUNDREDTH ARE THE PROPOSED GRADES FOR THE NEW ALIGNMENT.

PROJECT NAME: BRATTLEBORO	PLOT DATE: 10/14/2013
PROJECT NUMBER: BRO 1442(35)	DRAWN BY: E.A. FIALA
FILE NAME: z10j062pro.dgn	CHECKED BY: S.E. BURBANK
PROJECT LEADER: S.E. BURBANK	SHEET 15 OF 68
DESIGNED BY: E.A. FIALA	
PROFILE SHEET	




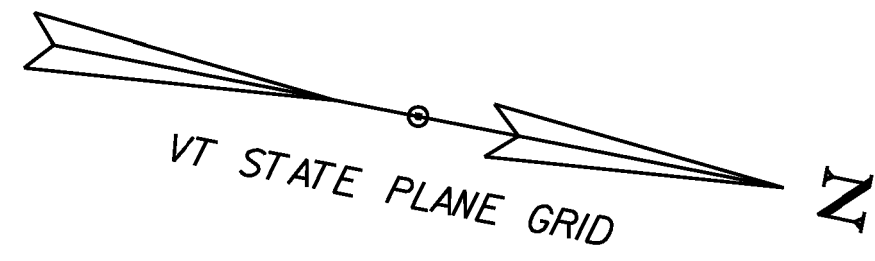

DETOUR (T.H. 12)  
CURVE NO. 1 DATA  
 $\Delta = 19^\circ 05' 20.51''$   
 $D = 43^\circ 04' 46.32''$   
 $R = 133.00'$   
 $T = 22.36'$   
 $L = 44.31'$   
 $E = 1.87'$   
 BANK = NONE


DETOUR (T.H. 12)  
CURVE NO. 2 DATA  
 $\Delta = 60^\circ 21' 44.73''$   
 $D = 127^\circ 19' 26.24''$   
 $R = 45.00'$   
 $T = 26.17'$   
 $L = 47.41'$   
 $E = 7.06'$   
 BANK = NONE

DETOUR (T.H. 12)  
CURVE NO. 3 DATA  
 $\Delta = 38^\circ 31' 27.38''$   
 $D = 57^\circ 17' 44.81''$   
 $R = 100.00'$   
 $T = 34.95'$   
 $L = 67.24'$   
 $E = 5.93'$   
 BANK = NONE

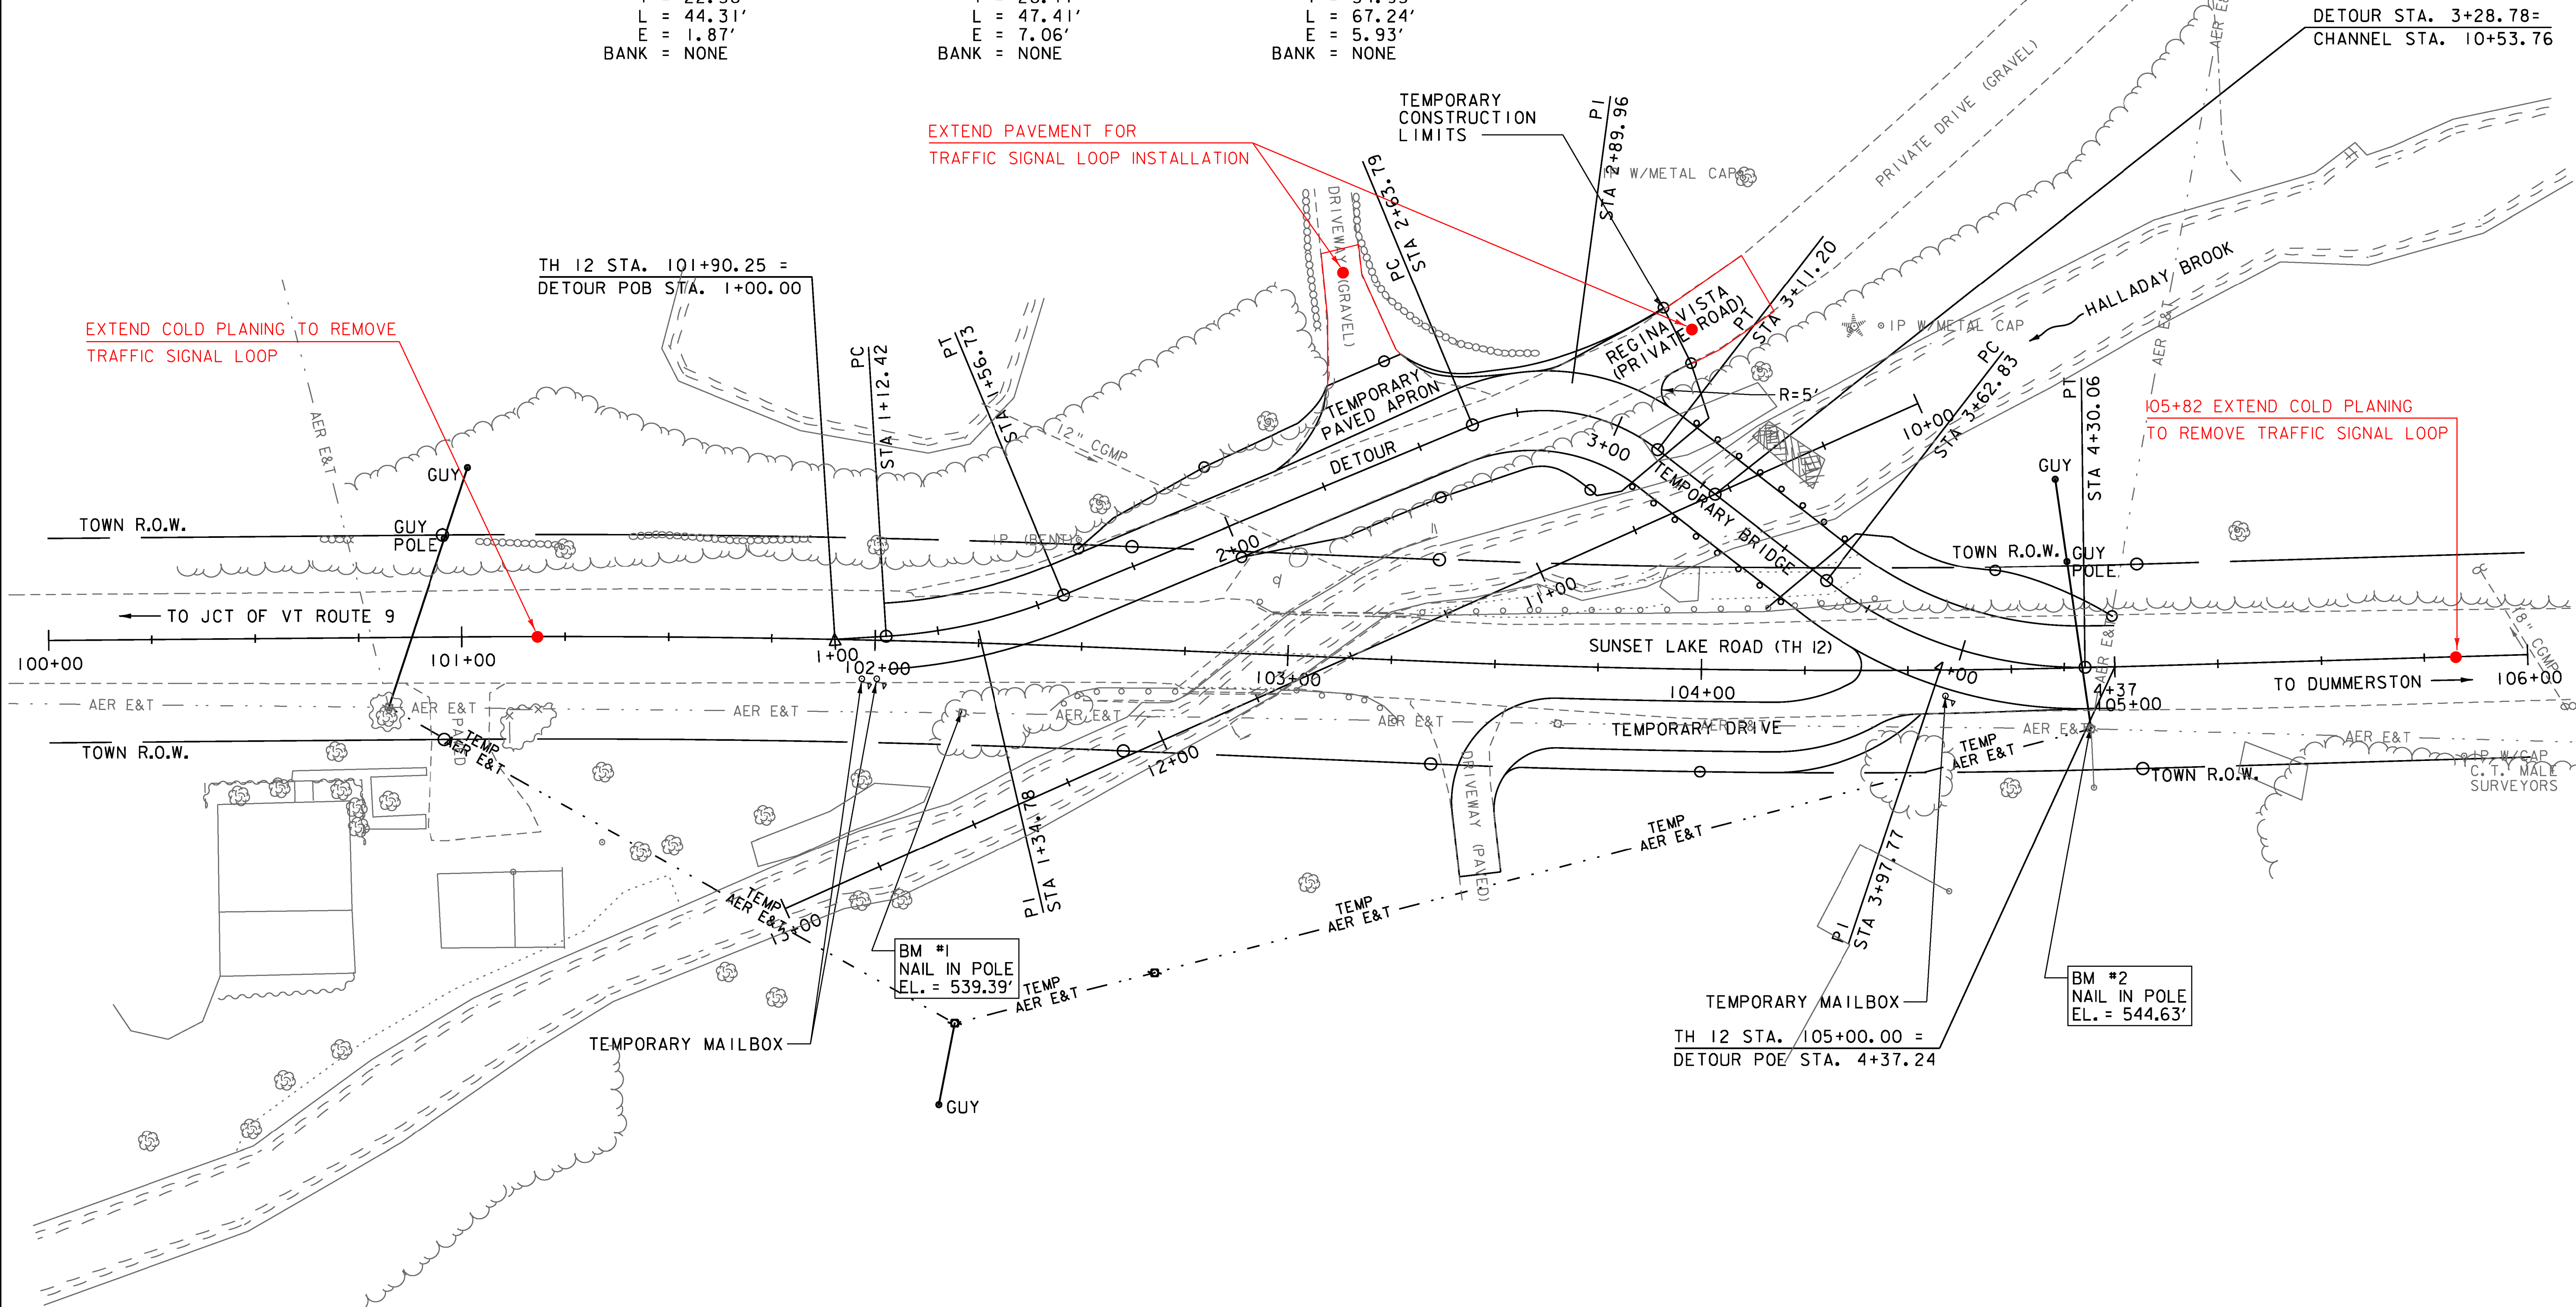


EDGE OF DETOUR PAVEMENT WIDTH TRANSITION

STA. 1+12.42	= 8'-0"	LT & RT
STA. 2+15.42	= 8'-0"	LT
STA. 2+59.66	= 8'-0"	RT
STA. 2+63.79	= 9'-5"	LT
STA. 3+11.20	= 10'-0"	LT
STA. 3+12.95	= 10'-0"	RT
STA. 4+37.22	= 10'-0"	LT & RT

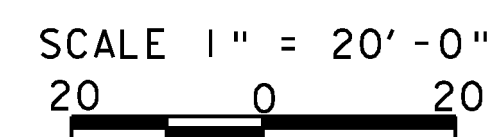


PROJECT NAME:	BRATTLEBORO	PLOT DATE:	10/14/2013
PROJECT NUMBER:	BRO 1442(35)	DRAWN BY:	E.A. FIALA
FILE NAME:	z10j062+cpl.dgn	CHECKED BY:	S.E. BURBANK
PROJECT LEADER:	S.E. BURBANK	TRAFFIC CONTROL PLAN (1 OF 3)	SHEET 16 OF 68



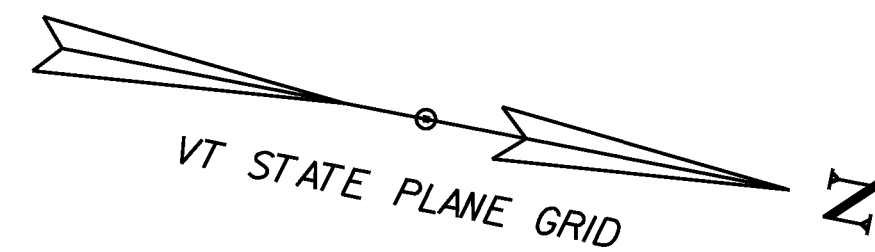

HAD TO SHORTEN DISTANCES, ACTUAL MEASUREMENT WAS 960' TO JCT. WITH RTE. 9 (DESIGN DISTANCE=1790')

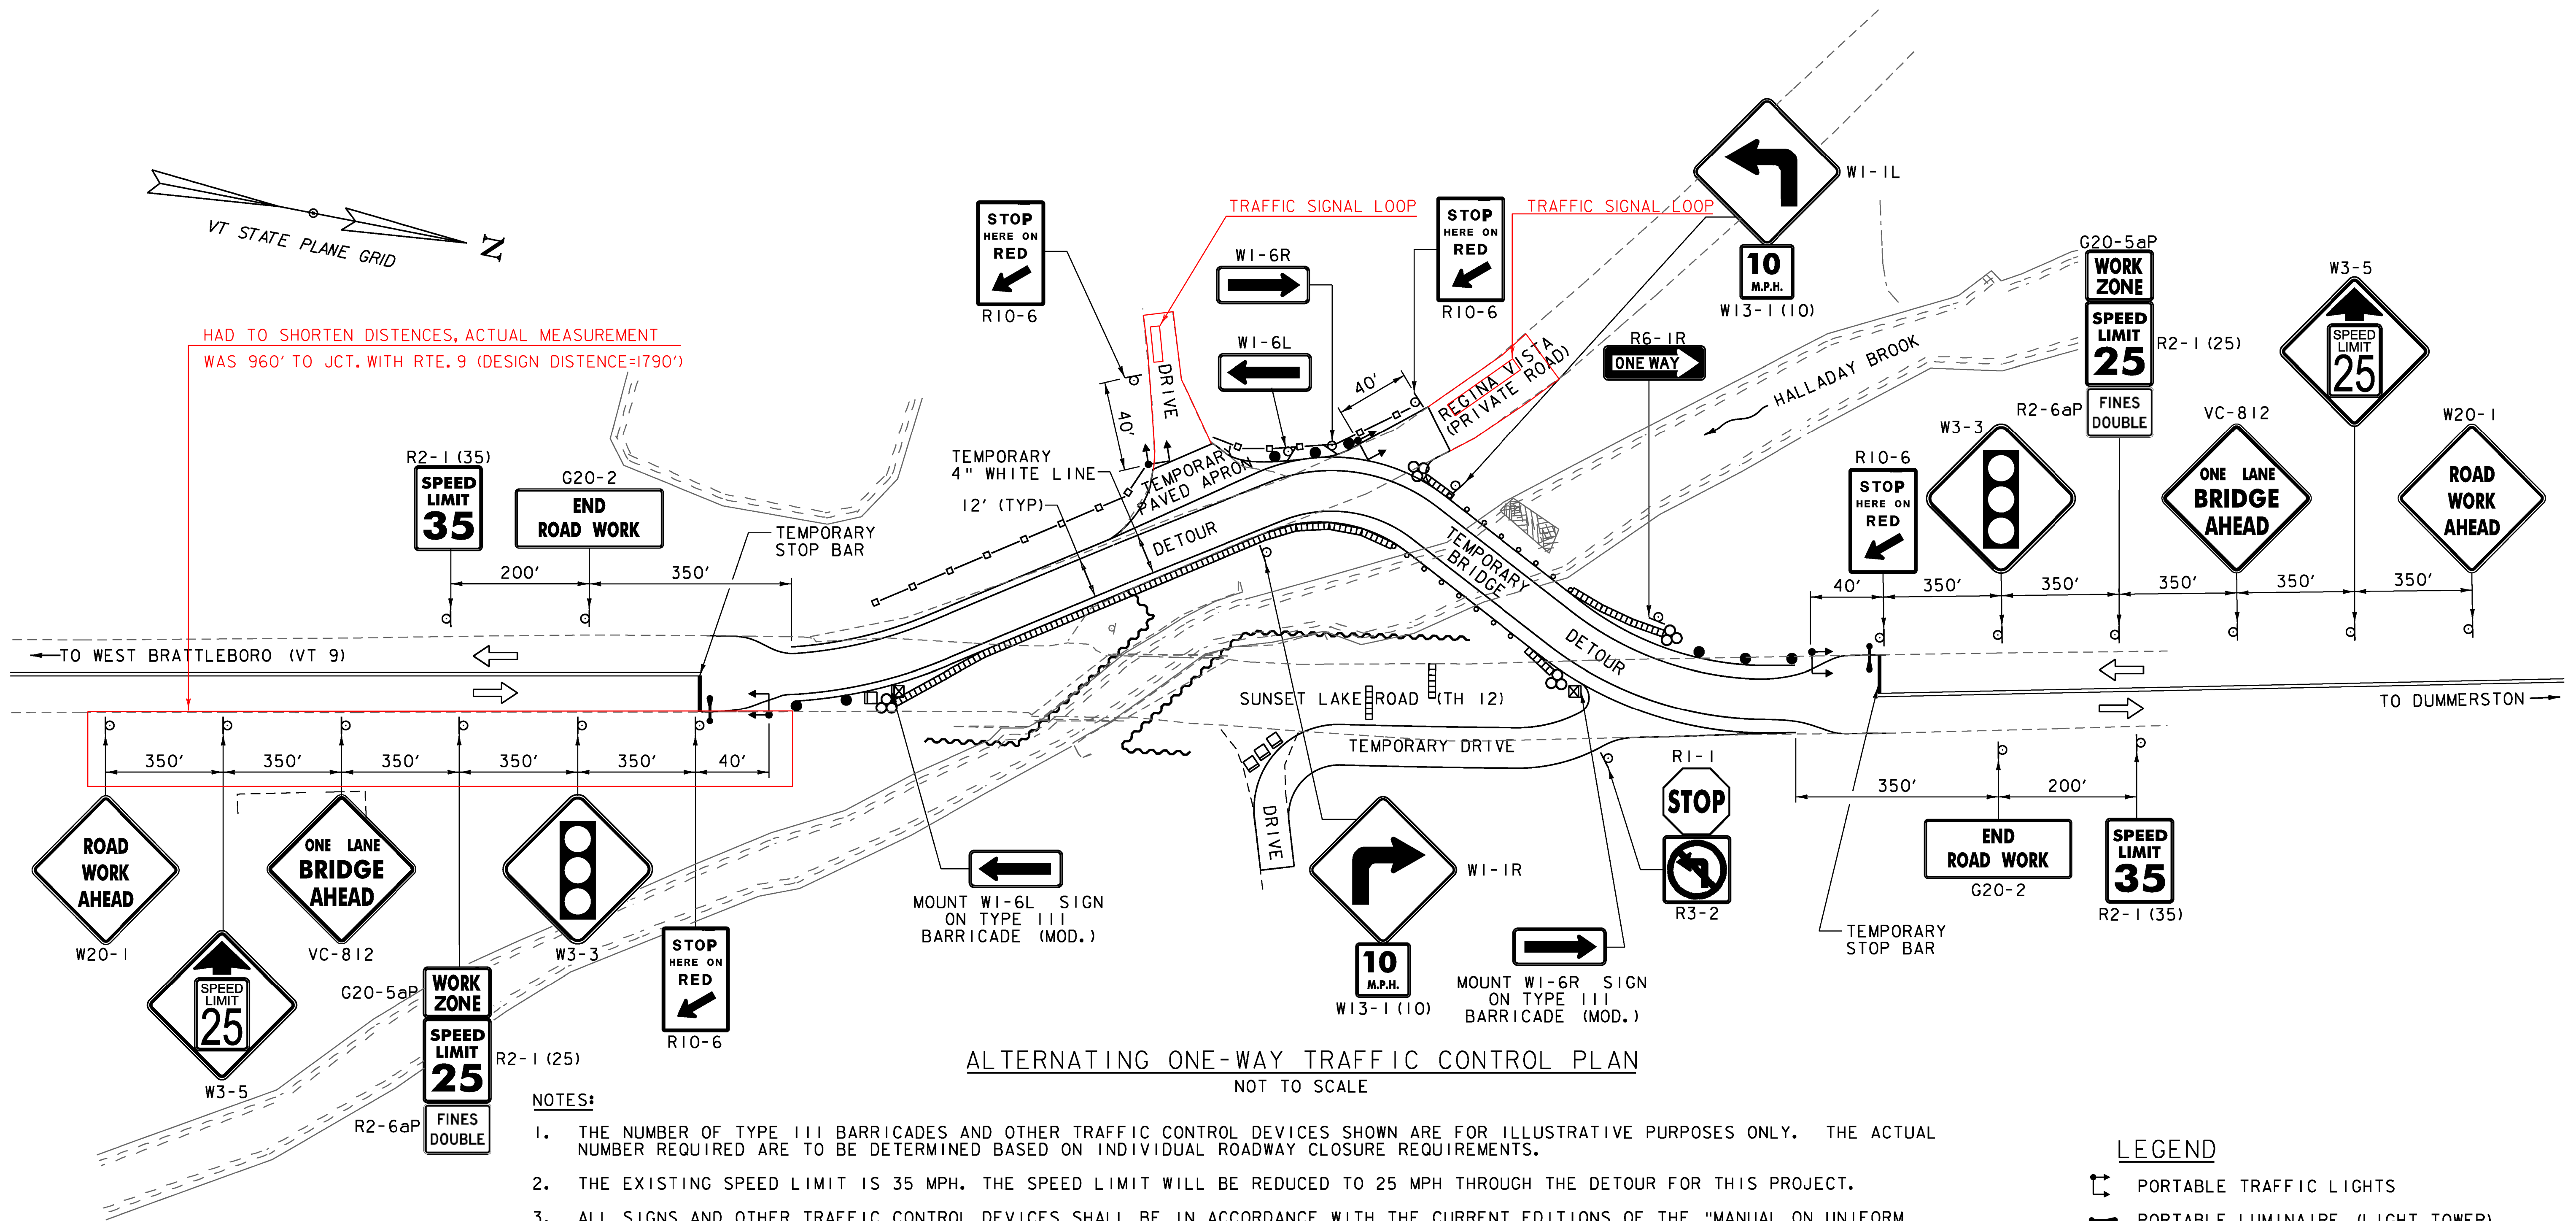

ALTERNATING ONE-WAY TRAFFIC CONTROL PLAN  
NOT TO SCALE

NOTES:

1. THE NUMBER OF TYPE III BARRICADES AND OTHER TRAFFIC CONTROL DEVICES SHOWN ARE FOR ILLUSTRATIVE PURPOSES ONLY. THE ACTUAL NUMBER REQUIRED ARE TO BE DETERMINED BASED ON INDIVIDUAL ROADWAY CLOSURE REQUIREMENTS.
2. THE EXISTING SPEED LIMIT IS 35 MPH. THE SPEED LIMIT WILL BE REDUCED TO 25 MPH THROUGH THE DETOUR FOR THIS PROJECT.
3. ALL SIGNS AND OTHER TRAFFIC CONTROL DEVICES SHALL BE IN ACCORDANCE WITH THE CURRENT EDITIONS OF THE "MANUAL ON UNIFORM TRAFFIC CONTROL DEVICES" (MUTCD) AND THE "STANDARD HIGHWAY SIGNS AND MARKINGS" BOOK (SHSM) PUBLISHED BY THE FEDERAL HIGHWAY ADMINISTRATION (FHWA).
4. SOLID SUBSTRATE CONSTRUCTION SIGNS SHALL HAVE RETRO-REFLECTIVE SHEETING EQUAL TO OR EXCEEDING "AMERICAN SOCIETY FOR TESTING AND MATERIALS" (ASTM D 4956) TYPE VII, VIII, OR IX REQUIREMENTS, UNLESS OTHERWISE NOTED. SOLID SUBSTRATE REGULATORY SIGNS (WHITE BACKGROUND) SHALL HAVE RETRO-REFLECTIVE SHEETING EQUAL TO OR EXCEEDING ASTM D 4956 TYPE III.
5. SIGNS SHALL BE ERECTED BEFORE THE START OF ANY WORK AND SHALL BE COVERED UNTIL WORK COMMENCES. DURING PERIODS OF INACTIVITY OR UPON COMPLETION OF THE WORK, EACH SIGN SHALL BE ERECTED IN A NEAT AND WORKMANLIKE MANNER. SIGNS SHALL BE REMOVED UPON COMPLETION OF THE WORK AT THE DISCRETION OF THE ENGINEER.
6. FIXED SIGNS SHALL BE SET SECURELY IN THE GROUND. THE BOTTOM OF A SIGN SHALL BE AT LEAST SEVEN FEET ABOVE THE EDGE OF PAVEMENT.
7. DURING NON-WORK PERIODS, ALL EQUIPMENT SHALL BE MOVED TO A LOCATION OFF PAVED SHOULDERS AND OUTSIDE THE CLEAR ZONE, OR PROTECTED BY TEMPORARY TRAFFIC BARRIER OR GUARDRAIL.
8. AN ENERGY ABSORPTION ATTENUATOR RATED FOR 35 MPH SHALL BE LOCATED AT THE END OF THE BARRIER.
9. PAYMENT FOR ALL ON AND OFF-PROJECT SIGNING AND TRAFFIC CONTROL DEVICES, WITH THE EXCEPTION OF TEMPORARY TRAFFIC BARRIER, WILL BE INCLUDED IN THE UNIT PRICE BID FOR CONTRACT ITEM 641.10. PAYMENT FOR TEMPORARY TRAFFIC BARRIER WILL BE INCLUDED IN THE UNIT PRICE BID FOR CONTRACT ITEM 528.10.

LEGEND

- ☐ PORTABLE TRAFFIC LIGHTS
- PORTABLE LUMINAIRE (LIGHT TOWER)
- REFLECTIVE PLASTIC DRUM
- ⇐ FLOW OF TRAFFIC
- ☐ TYPE III BARRICADE
- ☒ TYPE III BARRICADE (MOD.)
- ⊗ ENERGY ABSORPTION ATTENUATOR
- ▬ CONCRETE MEDIAN BARRIER
- SPECIAL PROVISION (FABRIC SCREENING FENCE) (SEE TCP 3 OF 3)

PROJECT NAME: BRATTLEBORO  
PROJECT NUMBER: BRO 1442(35)


FILE NAME: z10j062+cp2.dgn  
PROJECT LEADER: M.A. COLGAN  
DESIGNED BY: E.A. FIALA  
TRAFFIC CONTROL PLAN (2 OF 3)

PLOT DATE: 10/14/2013  
DRAWN BY: E.A. FIALA  
CHECKED BY: S.E. BURBANK  
SHEET 17 OF 68



IDENTIFICATION NUMBER	SIZE OF SIGN		TEXT	NUMBER OF SIGNS REQ'D	AREA (SQ FT)	TOTAL AREA (SQ FT)	REMARKS
	WIDTH (IN)	HEIGHT (IN)					
G20-2	48	24		2	8.00	16.00	
G20-5aP	24	18		2	3.00	12.00	MOUNT ABOVE R2-125
R1-1	24	24		1	4.00	4.00	---
R2-1 (25)	18	24		2	3.00	12.00	---
R2-1 (35)	18	24		2	3.00	6.00	---
R2-6aP	18	24		2	3.00	6.00	MOUNT BELOW R2-1 (25)
R3-2	24	24		1	4.00	4.00	---
R6-1R	36	18		1	4.00	4.00	---
R10-6	24	36		4	6.00	24.00	---
VC-812	36	36		2	9.00	18.00	MOUNT ON TWO POSTS
W1-1L	36	36		1	9.00	9.00	MOUNT ON TWO POSTS
W1-1R	36	36		1	9.00	9.00	MOUNT ON TWO POSTS
W1-6L	36	18		2	3.00	6.00	MOUNT ON TWO POSTS
W1-6R	36	18		2	3.00	6.00	MOUNT ON TWO POSTS

IDENTIFICATION NUMBER	SIZE OF SIGN		TEXT	NUMBER OF SIGNS REQ'D	AREA (SQ FT)	TOTAL AREA (SQ FT)	REMARKS
	WIDTH (IN)	HEIGHT (IN)					
W3-3	36	36		2	9.00	18.00	MOUNT ON TWO POSTS
W3-5	36	36		2	9.00	18.00	MOUNT ON TWO POSTS
W13-1 (10)	18	18		2	2.25	4.5	MOUNT BELOW W1-1L OR W1-1R
W20-1	36	36		2	9.00	18.00	MOUNT ON TWO POSTS

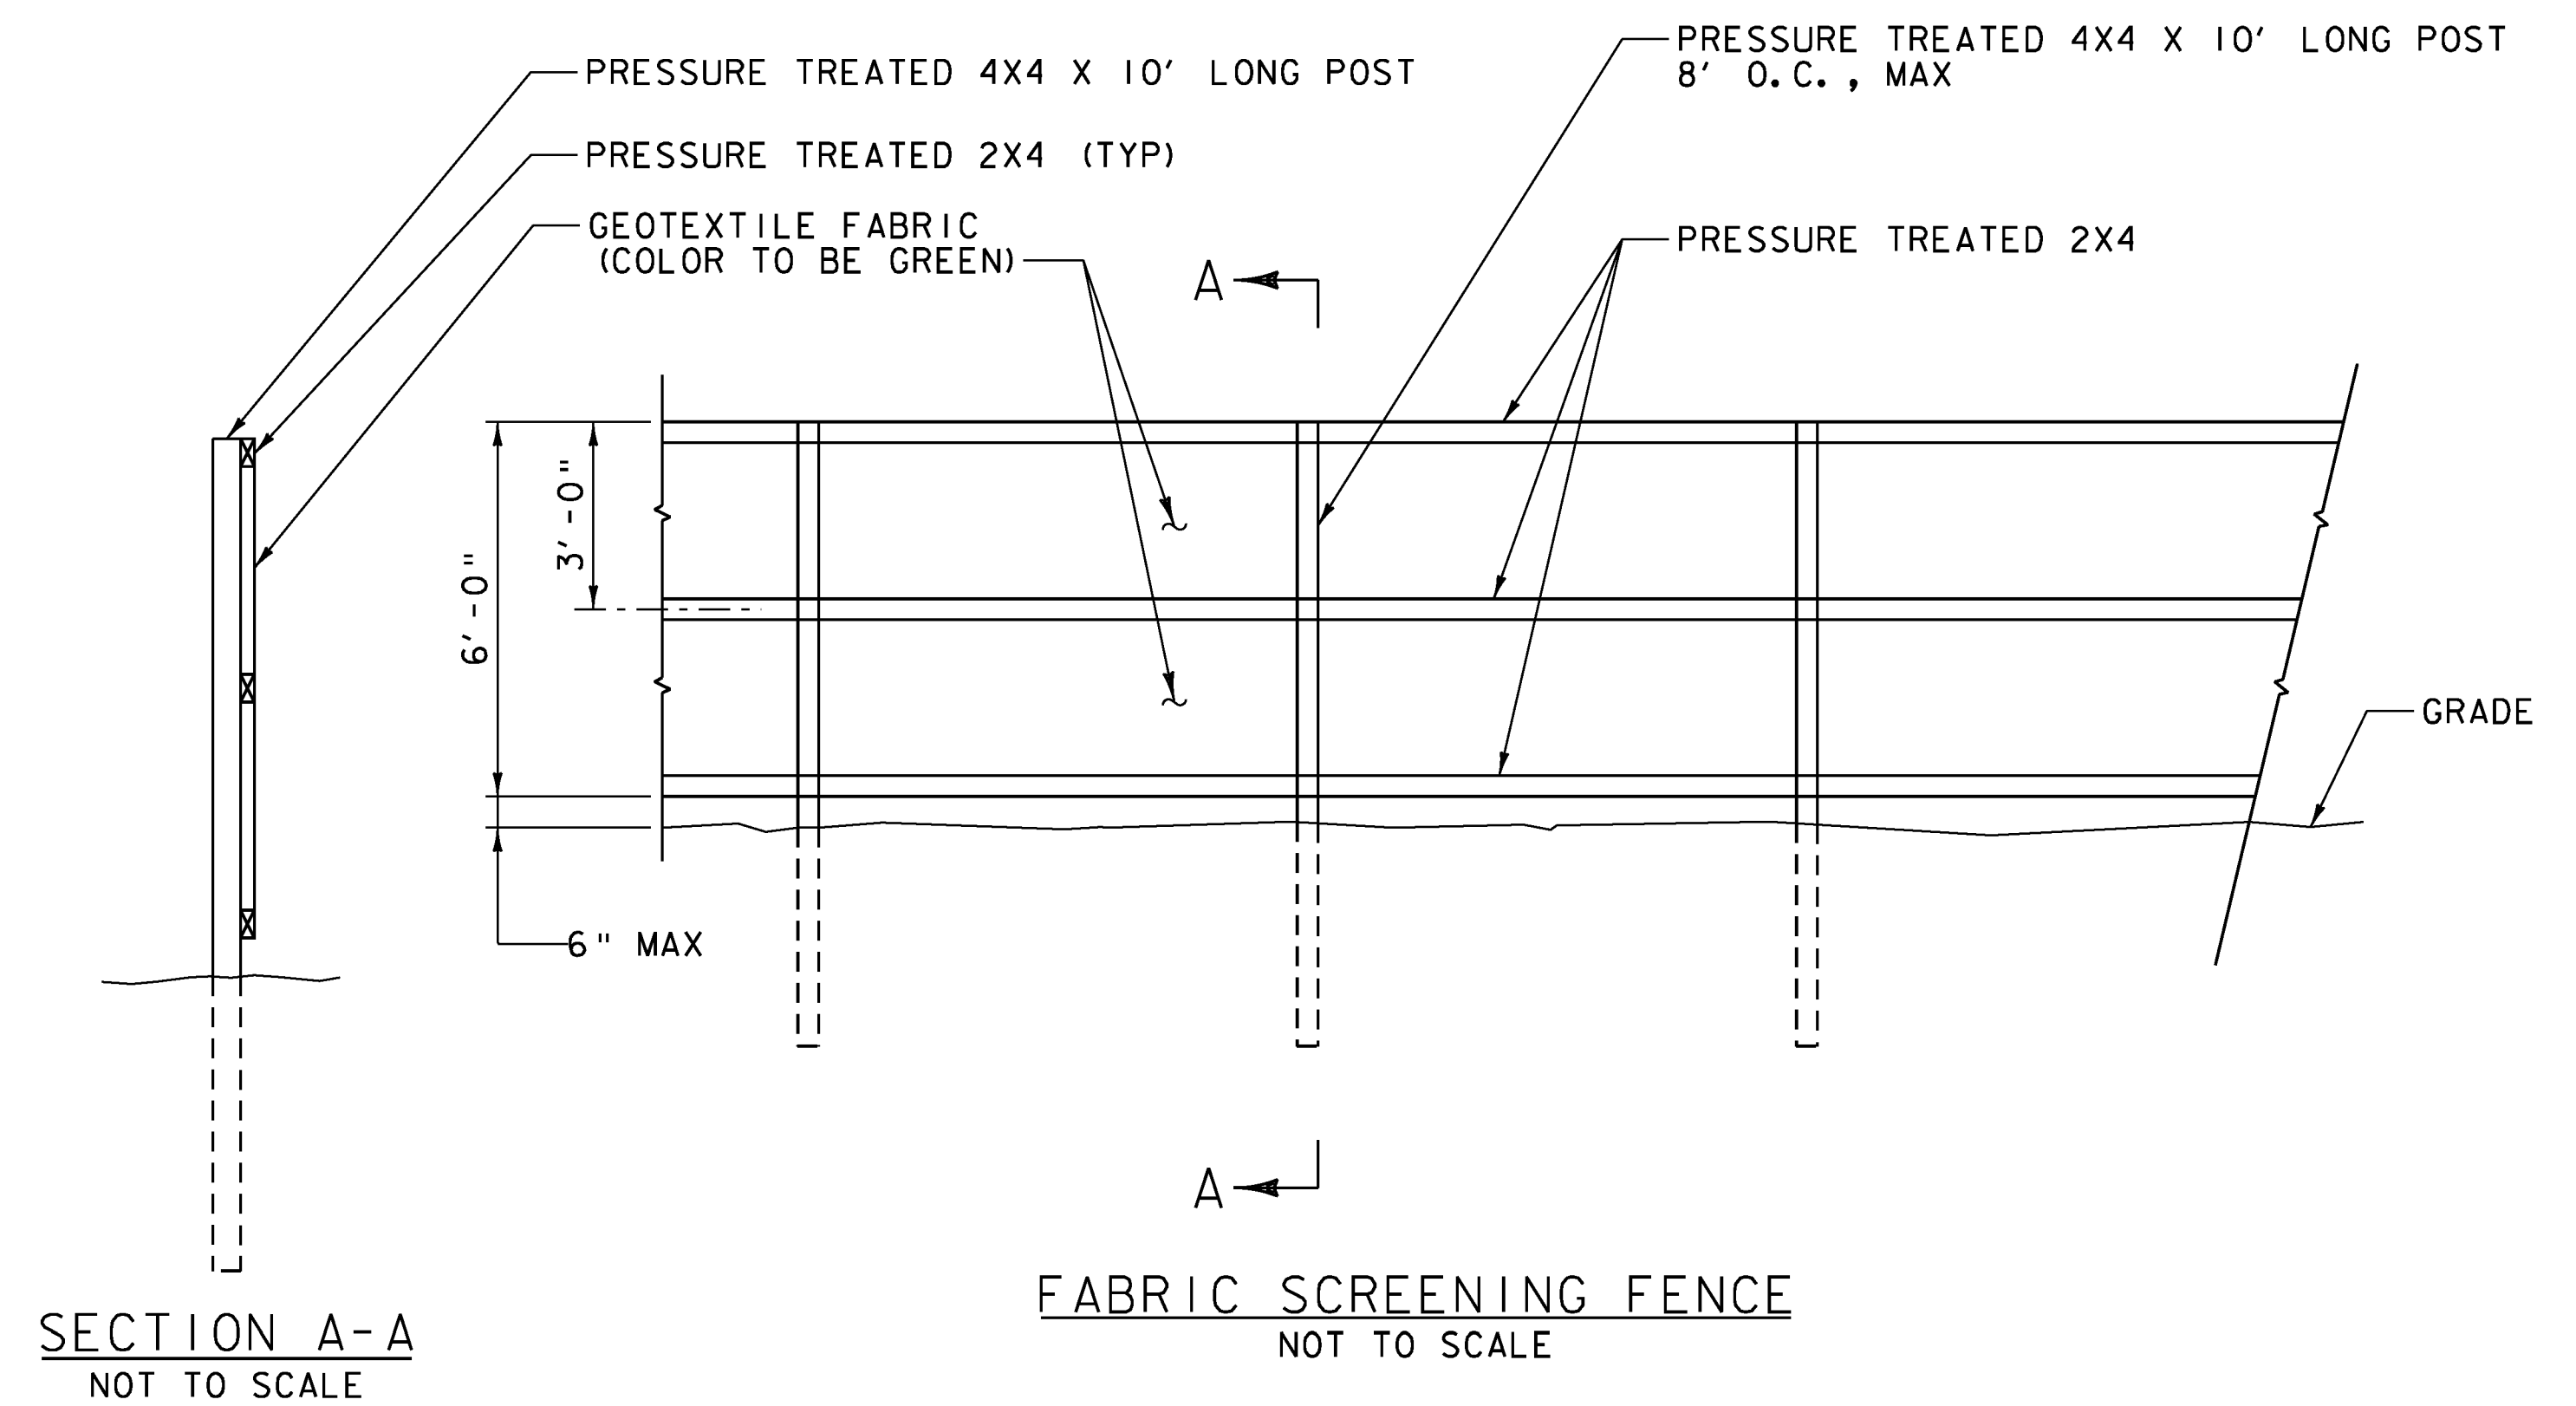



**NOTES:**

1. SEE EPSC CONSTRUCTION CONDITIONS PLAN AND TRAFFIC CONTROL PLAN (2 OF 3) FOR LOCATION OF FABRIC SCREENING FENCE.
2. ALL COSTS ASSOCIATED WITH CONSTRUCTING, INSTALLING, MAINTAINING, AND REMOVING THE FABRIC SCREENING FENCE SHALL BE INCLUDED IN THE UNIT PRICE BID FOR ITEM 900.640, "SPECIAL PROVISION (FABRIC SCREENING FENCE)".

PROJECT NAME: BRATTLEBORO  
PROJECT NUMBER: BRO 1442(35)

FILE NAME: z10j062+cp3.dgn  
PROJECT LEADER: M.A. COLGAN  
DESIGNED BY: E.A. FIALA  
TRAFFIC CONTROL PLAN (3 OF 3)

PLOT DATE: 10/14/2013  
DRAWN BY: E.A. FIALA  
CHECKED BY: S.E. BURBANK  
SHEET 18 OF 68

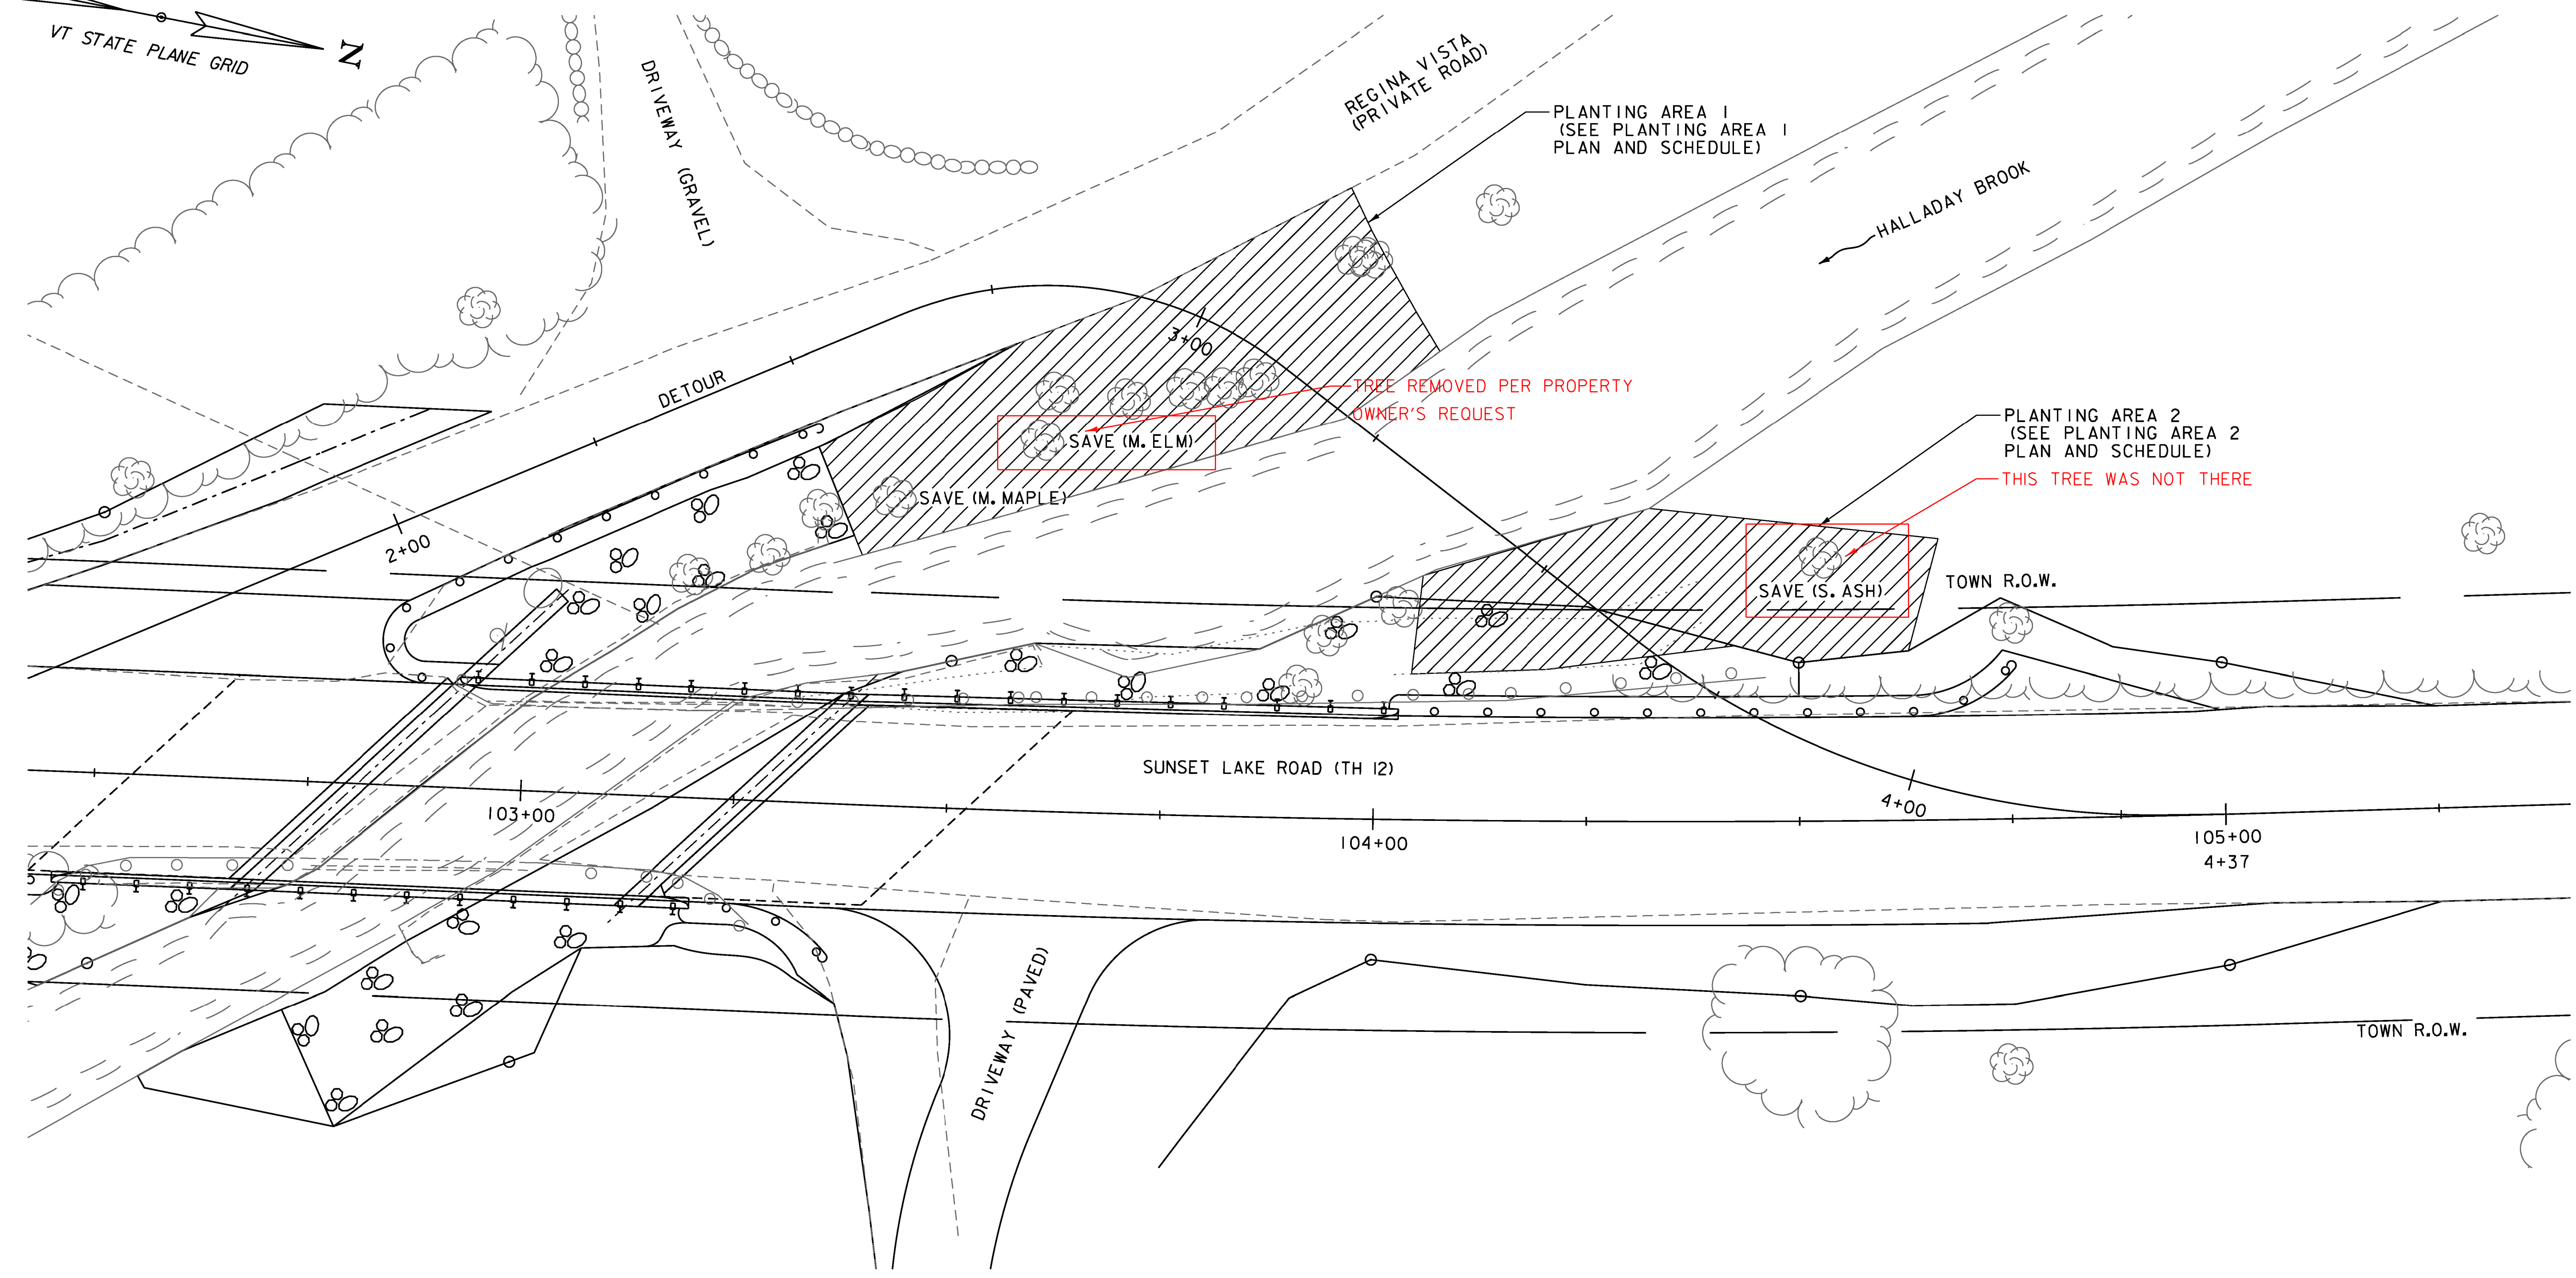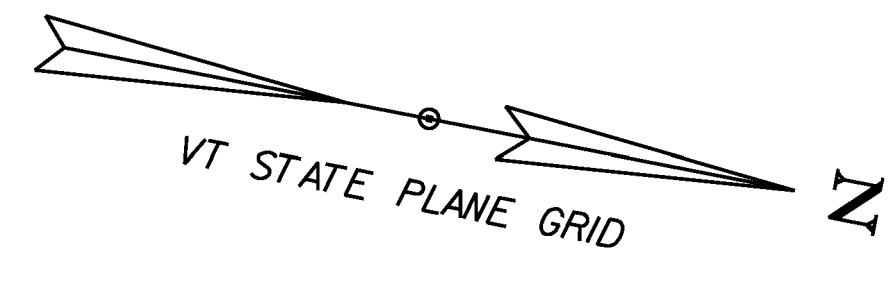



**LEGEND**  
 M. = MEDIUM TREE  
 S. = SMALL TREE

SCALE 1" = 10' - 0"  
 10 0 10


PROJECT NAME:	BRATTLEBORO	PLOT DATE:	10/14/2013
PROJECT NUMBER:	BRO 1442(35)	DRAWN BY:	D.A. GINGRAS
FILE NAME:	z10j062pln1.dgn	CHECKED BY:	S.E. BURBANK
PROJECT LEADER:	S.E. BURBANK	DESIGNED BY:	P.B. WERTS
PLANTING PLAN		SHEET	19 OF 68



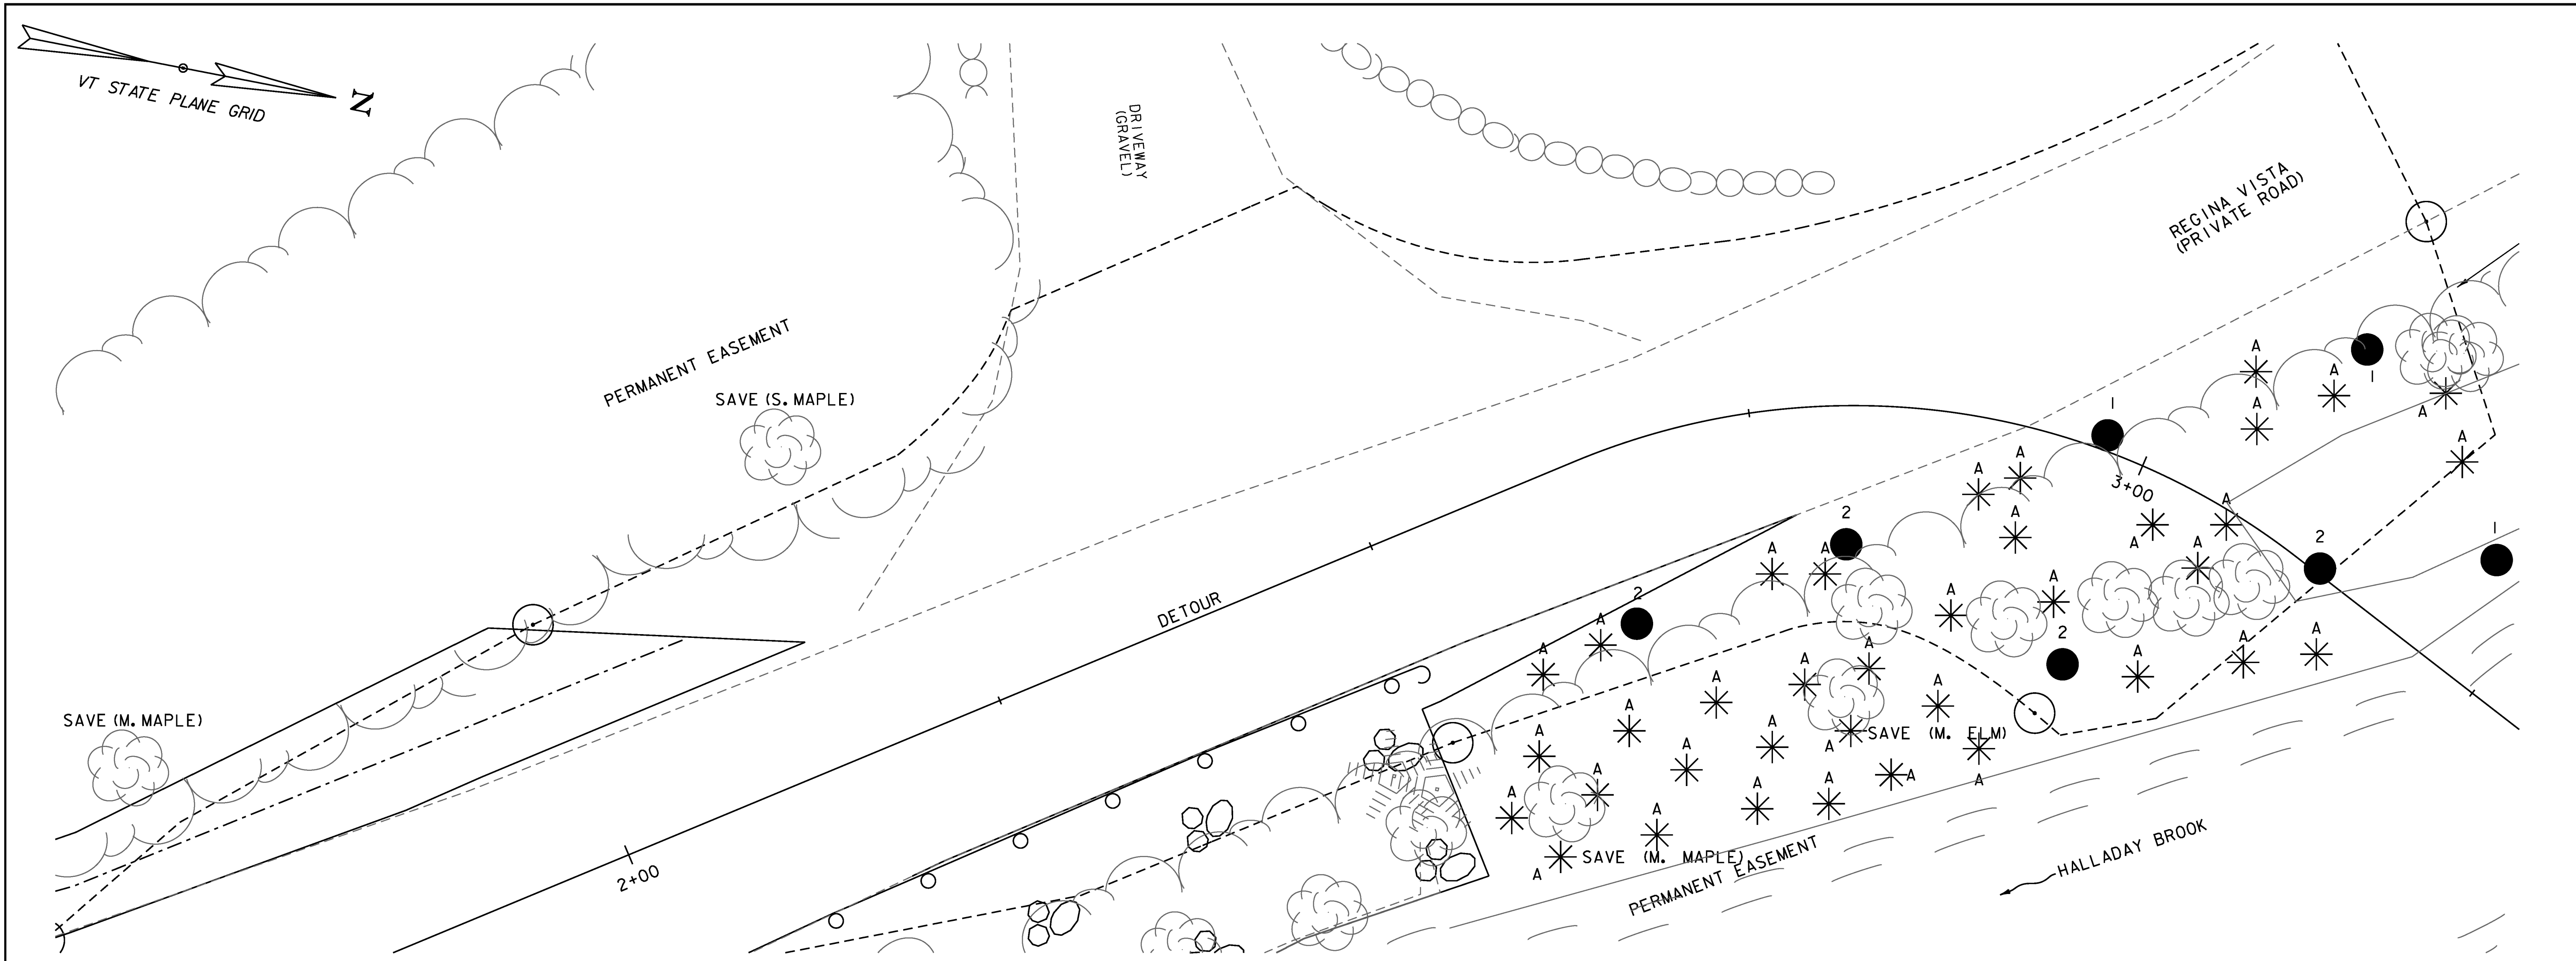



Trees				
Planting Plan Code	Common Name	Scientific Name	Total Number of Trees 	Planting Stock Size
1	Red Maple	<i>Acer rubrum</i>	3	2.5"-3" (dia)
2	Silver Maple	<i>Acer saccharinum</i>	4	2"-2.5" (dia)


 - TOTAL NUMBER OF TREES IN PLANTING AREA I

Shrubs				
Planting Plan Code	Common Name	Scientific Name	Total Number of Shrubs 	Size of Stock (Height)
A	Red-Osier Dogwood	<i>Cornus Sericea</i>	37	36"-48"

 - TOTAL NUMBER OF SHRUBS IN PLANTING AREA I


**LEGEND**

-  - TREE
-  - SHRUB

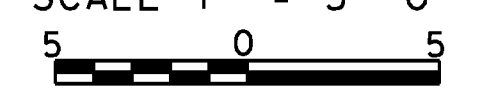
SCALE 1" = 5'-0"  


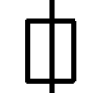


PROJECT NAME: BRATTLEBORO	PLOT DATE: 10/14/2013
PROJECT NUMBER: BRO 1442(35)	DRAWN BY: D.A. GINGRAS
FILE NAME: z10j062plnt_schl.dgn	CHECKED BY: S.E. BURBANK
PROJECT LEADER: S.E. BURBANK	SHEET 20 OF 68
DESIGNED BY: P.B. WERTS	
PLANTING AREA I PLAN AND SCHEDULE	

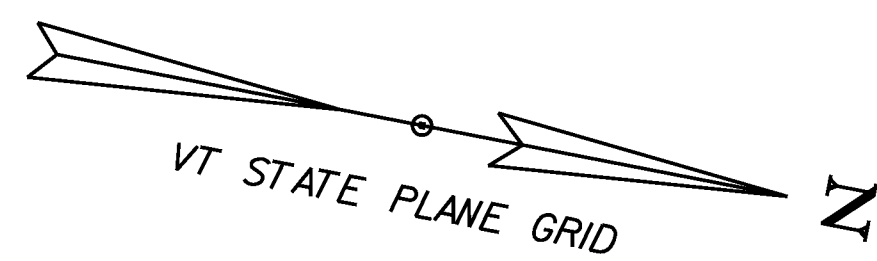



HALLADAY BROOK

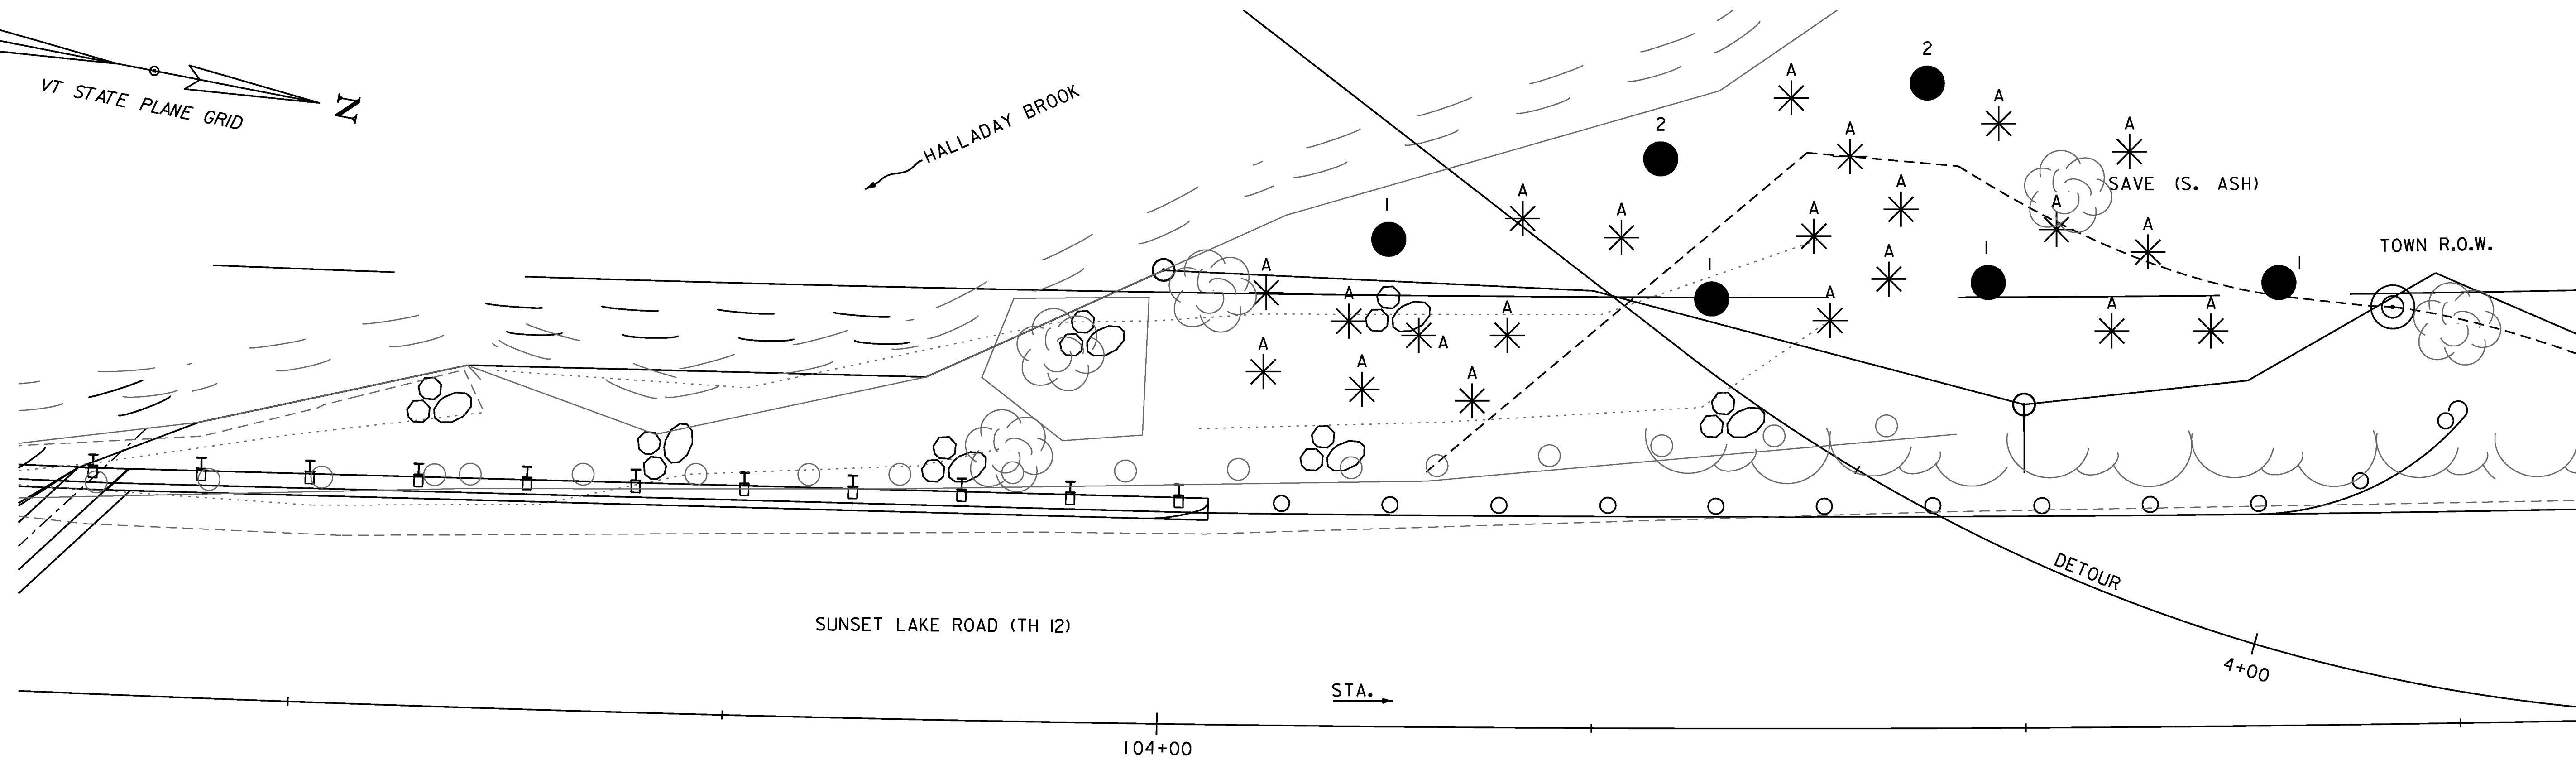



Trees				
Planting Plan Code	Common Name	Scientific Name	Total Number of Trees 	Planting Stock Size
1	Red Maple	<i>Acer rubrum</i>	4	2.5"-3" (dia)
2	Silver Maple	<i>Acer saccharinum</i>	2	2"-2.5" (dia)

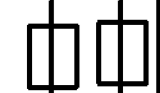
 - TOTAL NUMBER OF TREES IN PLANTING AREA 2

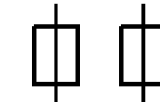Shrubs				
Planting Plan Code	Common Name	Scientific Name	Total Number of Shrubs 	Size of Stock (Height)
A	Red-Osier Dogwood	<i>Cornus Sericea</i>	21	36"-48"

 - TOTAL NUMBER OF SHRUBS IN PLANTING AREA 2


LEGEND

-  - TREE
-  - SHRUB


SCALE 1" = 5'-0"  




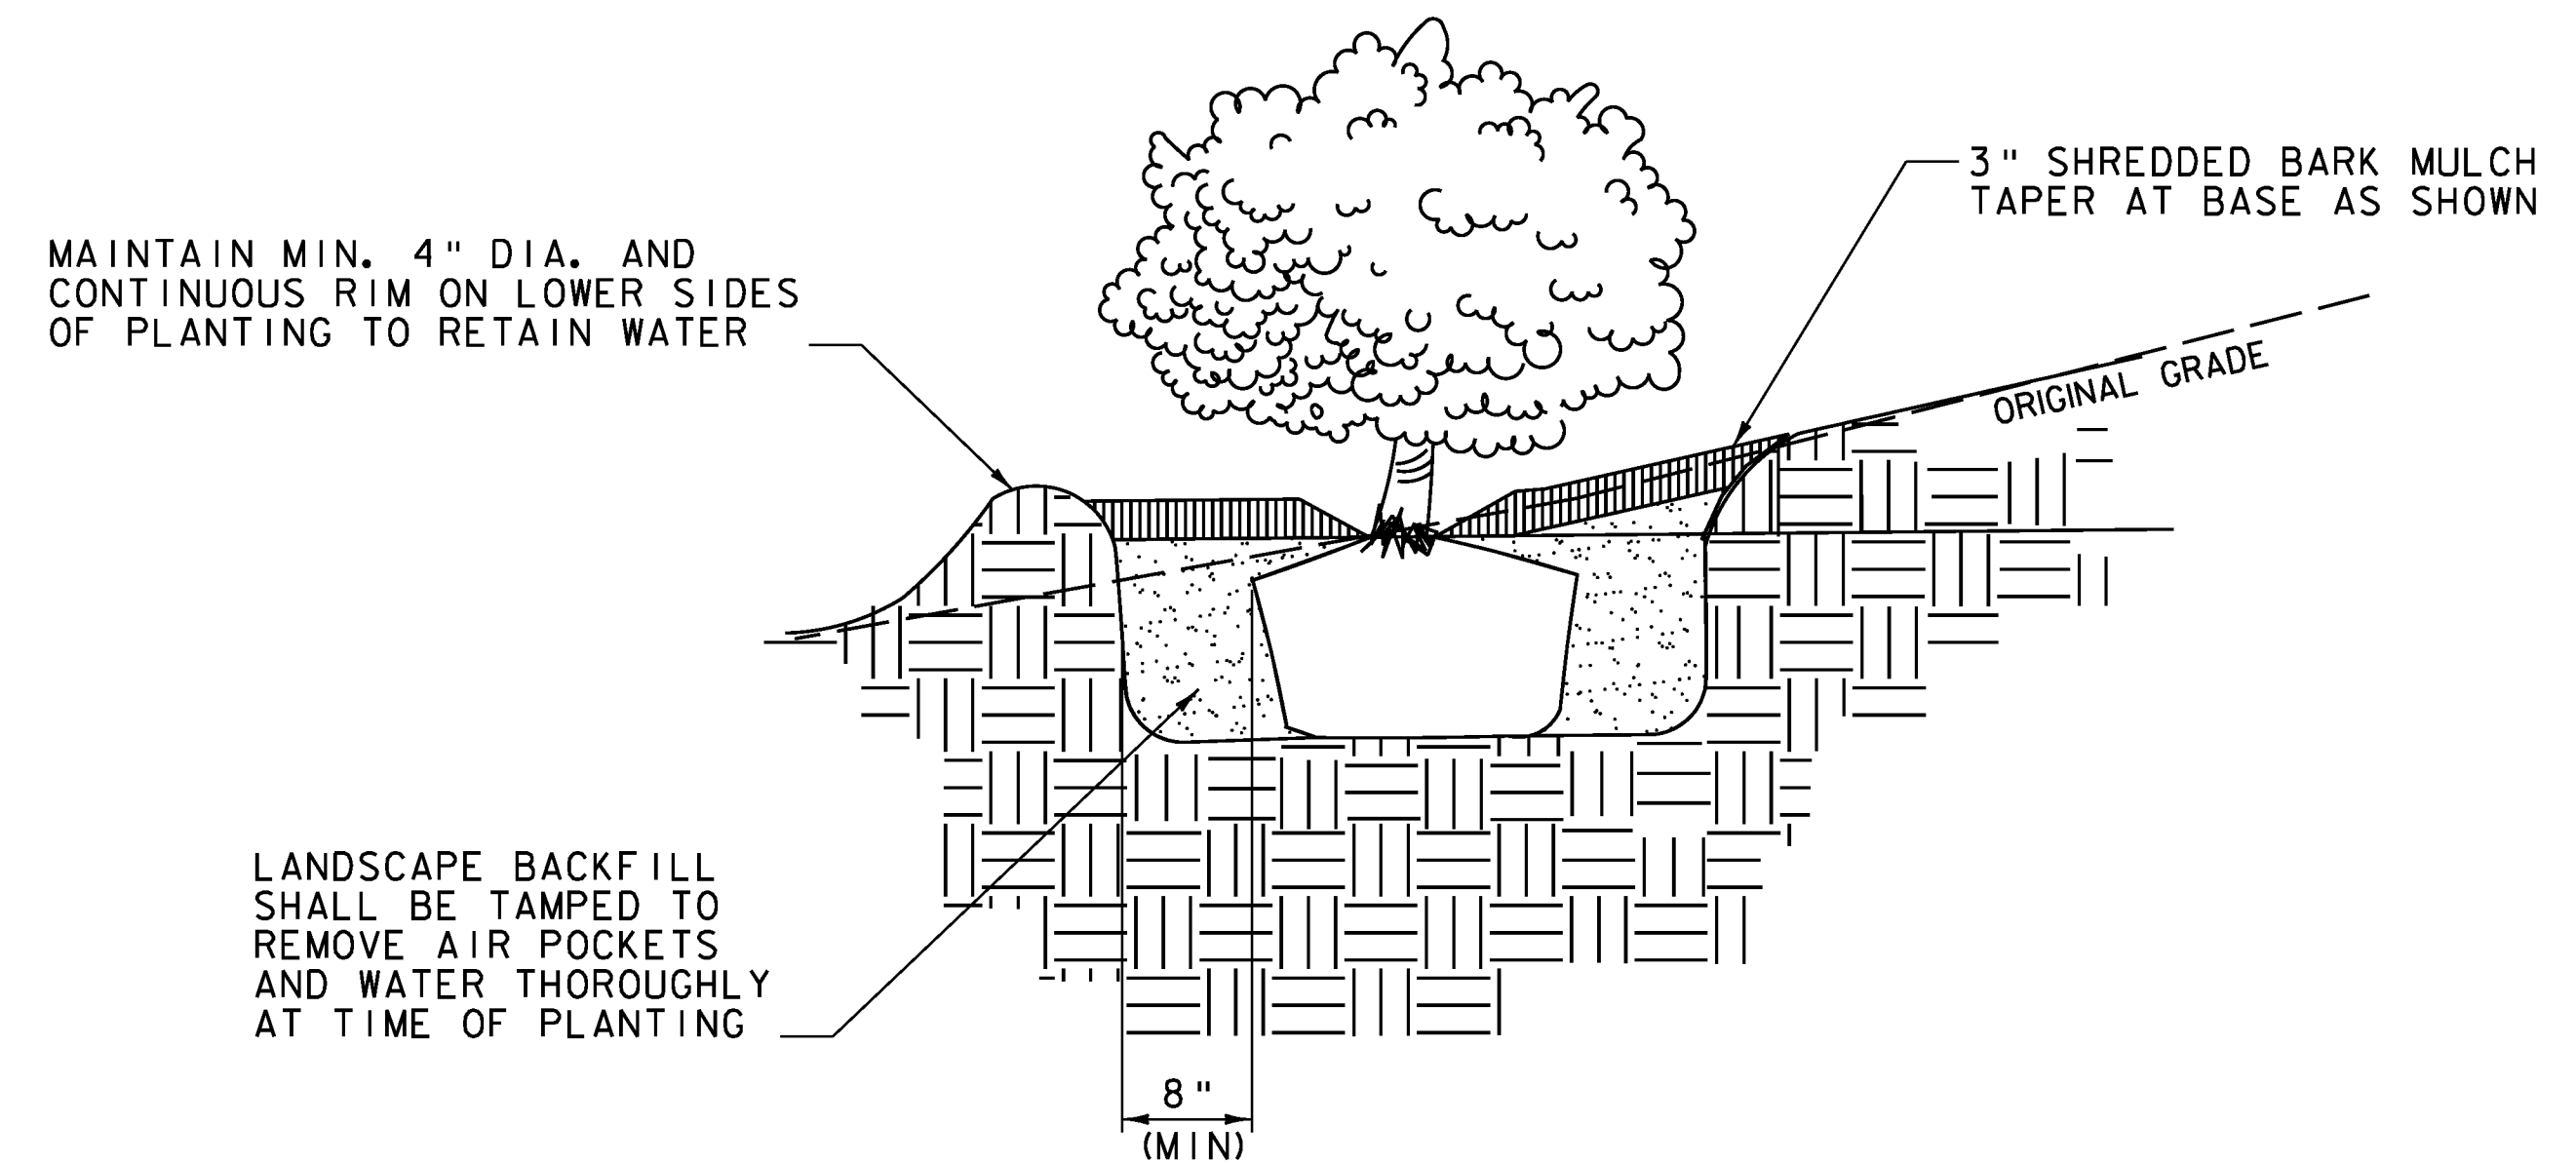
PROJECT NAME: BRATTLEBORO	PLOT DATE: 10/14/2013
PROJECT NUMBER: BRO 1442(35)	DRAWN BY: D.A. GINGRAS
FILE NAME: z10j062plnt_sch2.dgn	DESIGNED BY: P.B. WERTS
PROJECT LEADER: S.E. BURBANK	CHECKED BY: S.E. BURBANK
PLANTING AREA 2 PLAN AND SCHEDULE	SHEET 21 OF 68

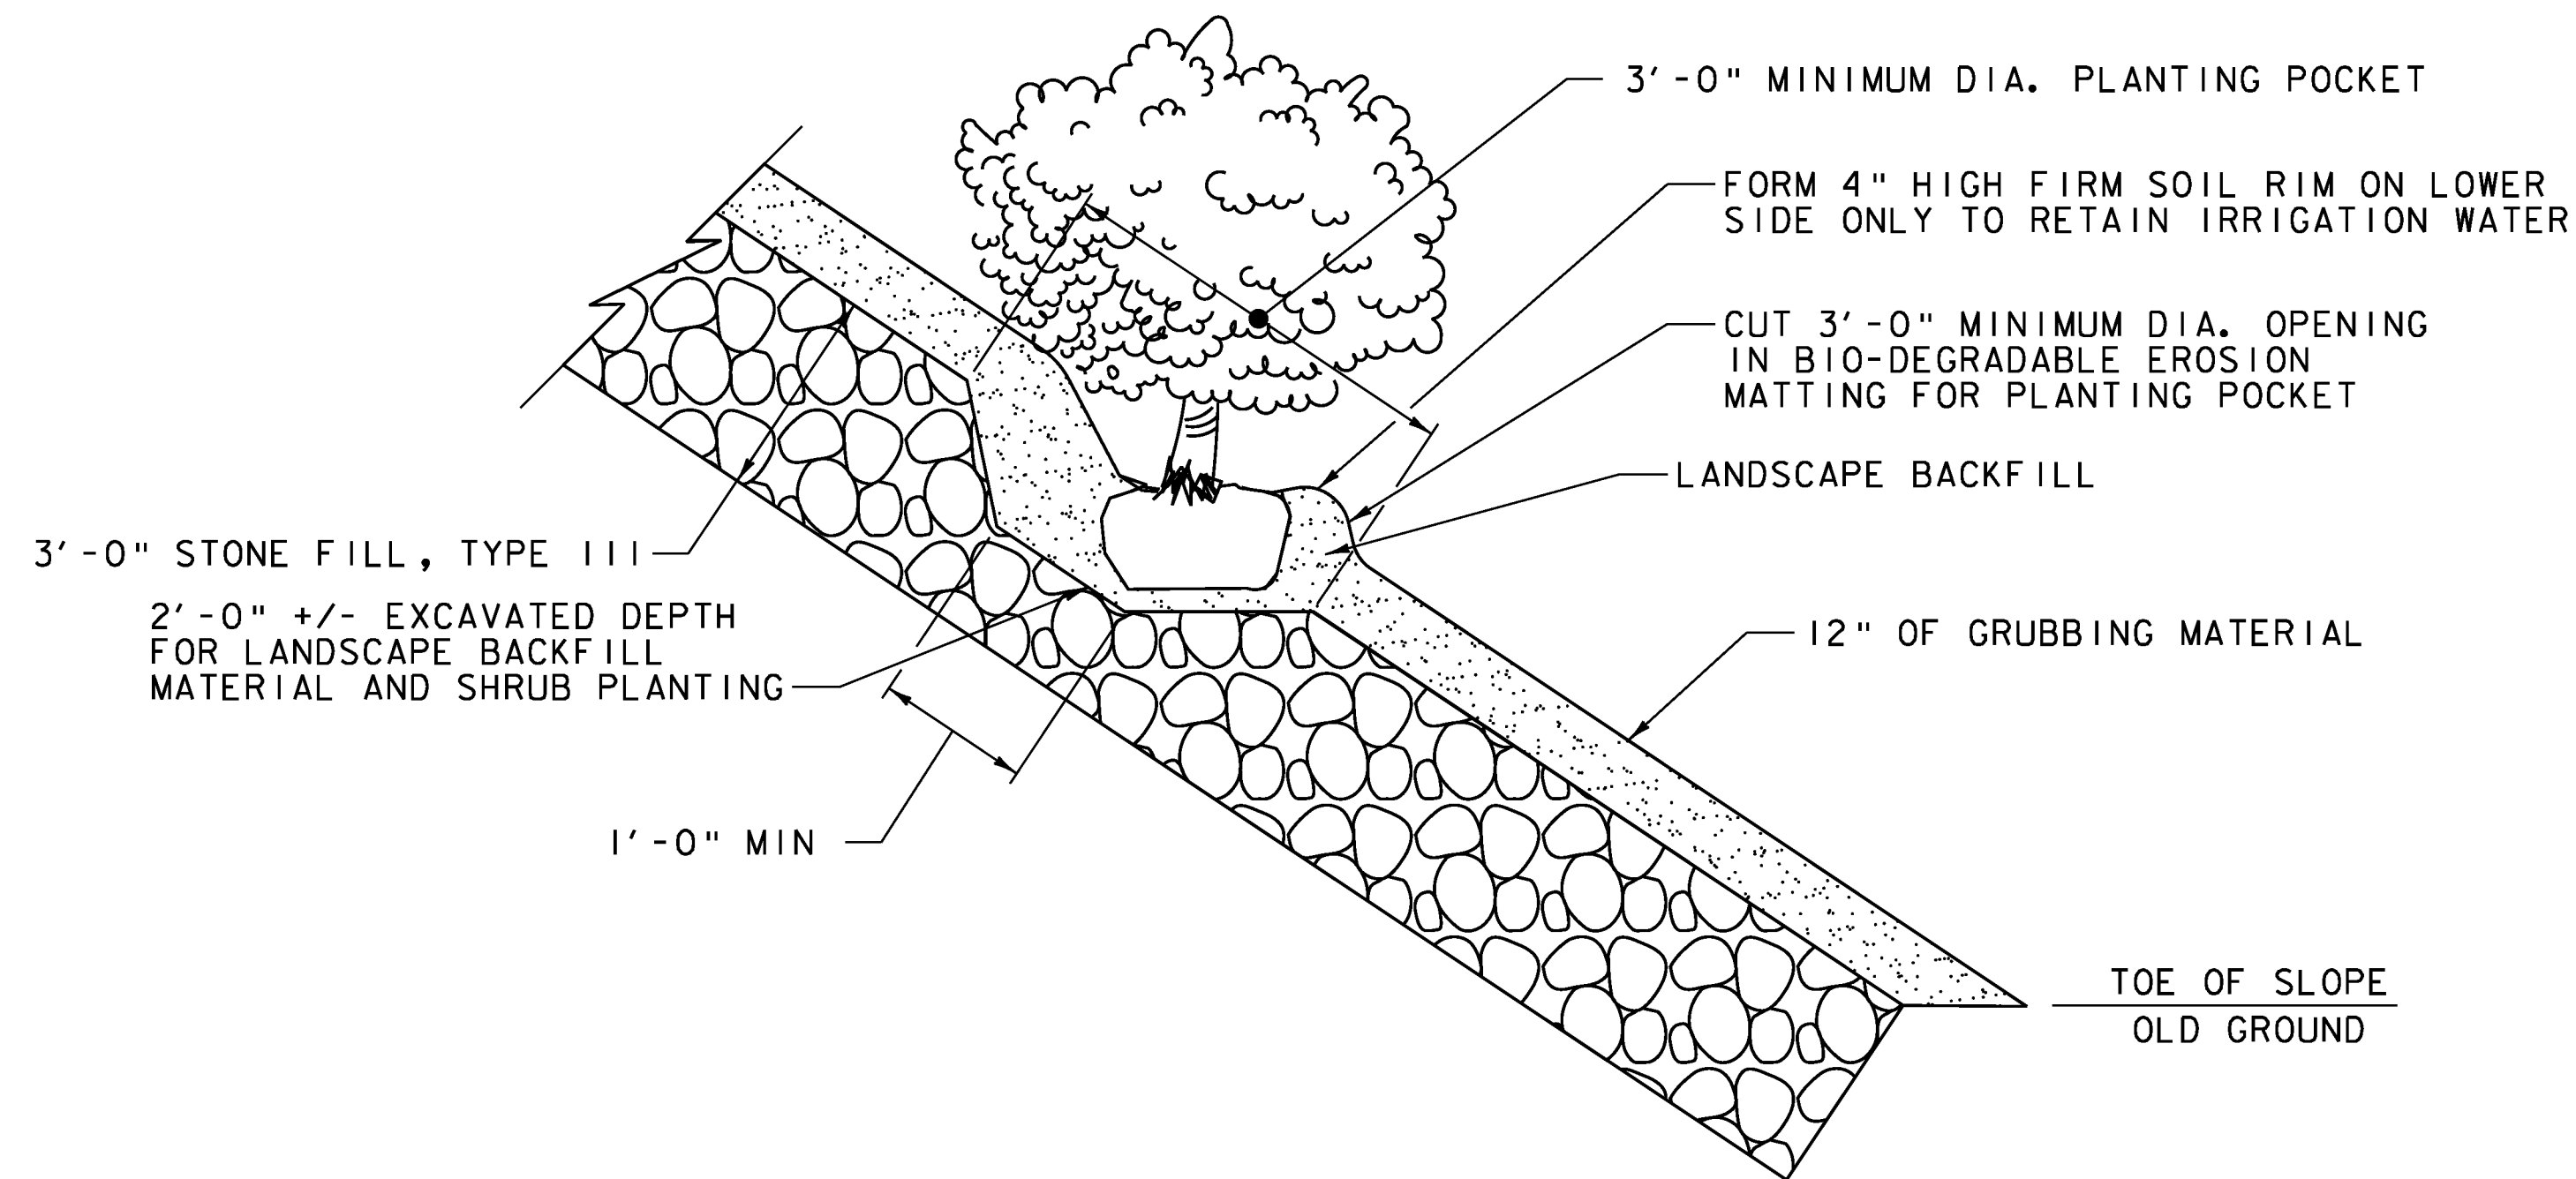

SHRUB PLANTING POCKET CROSS-SECTION IN  
"GRUBBING" MATERIAL OVER STONE FILL  
NOT TO SCALE

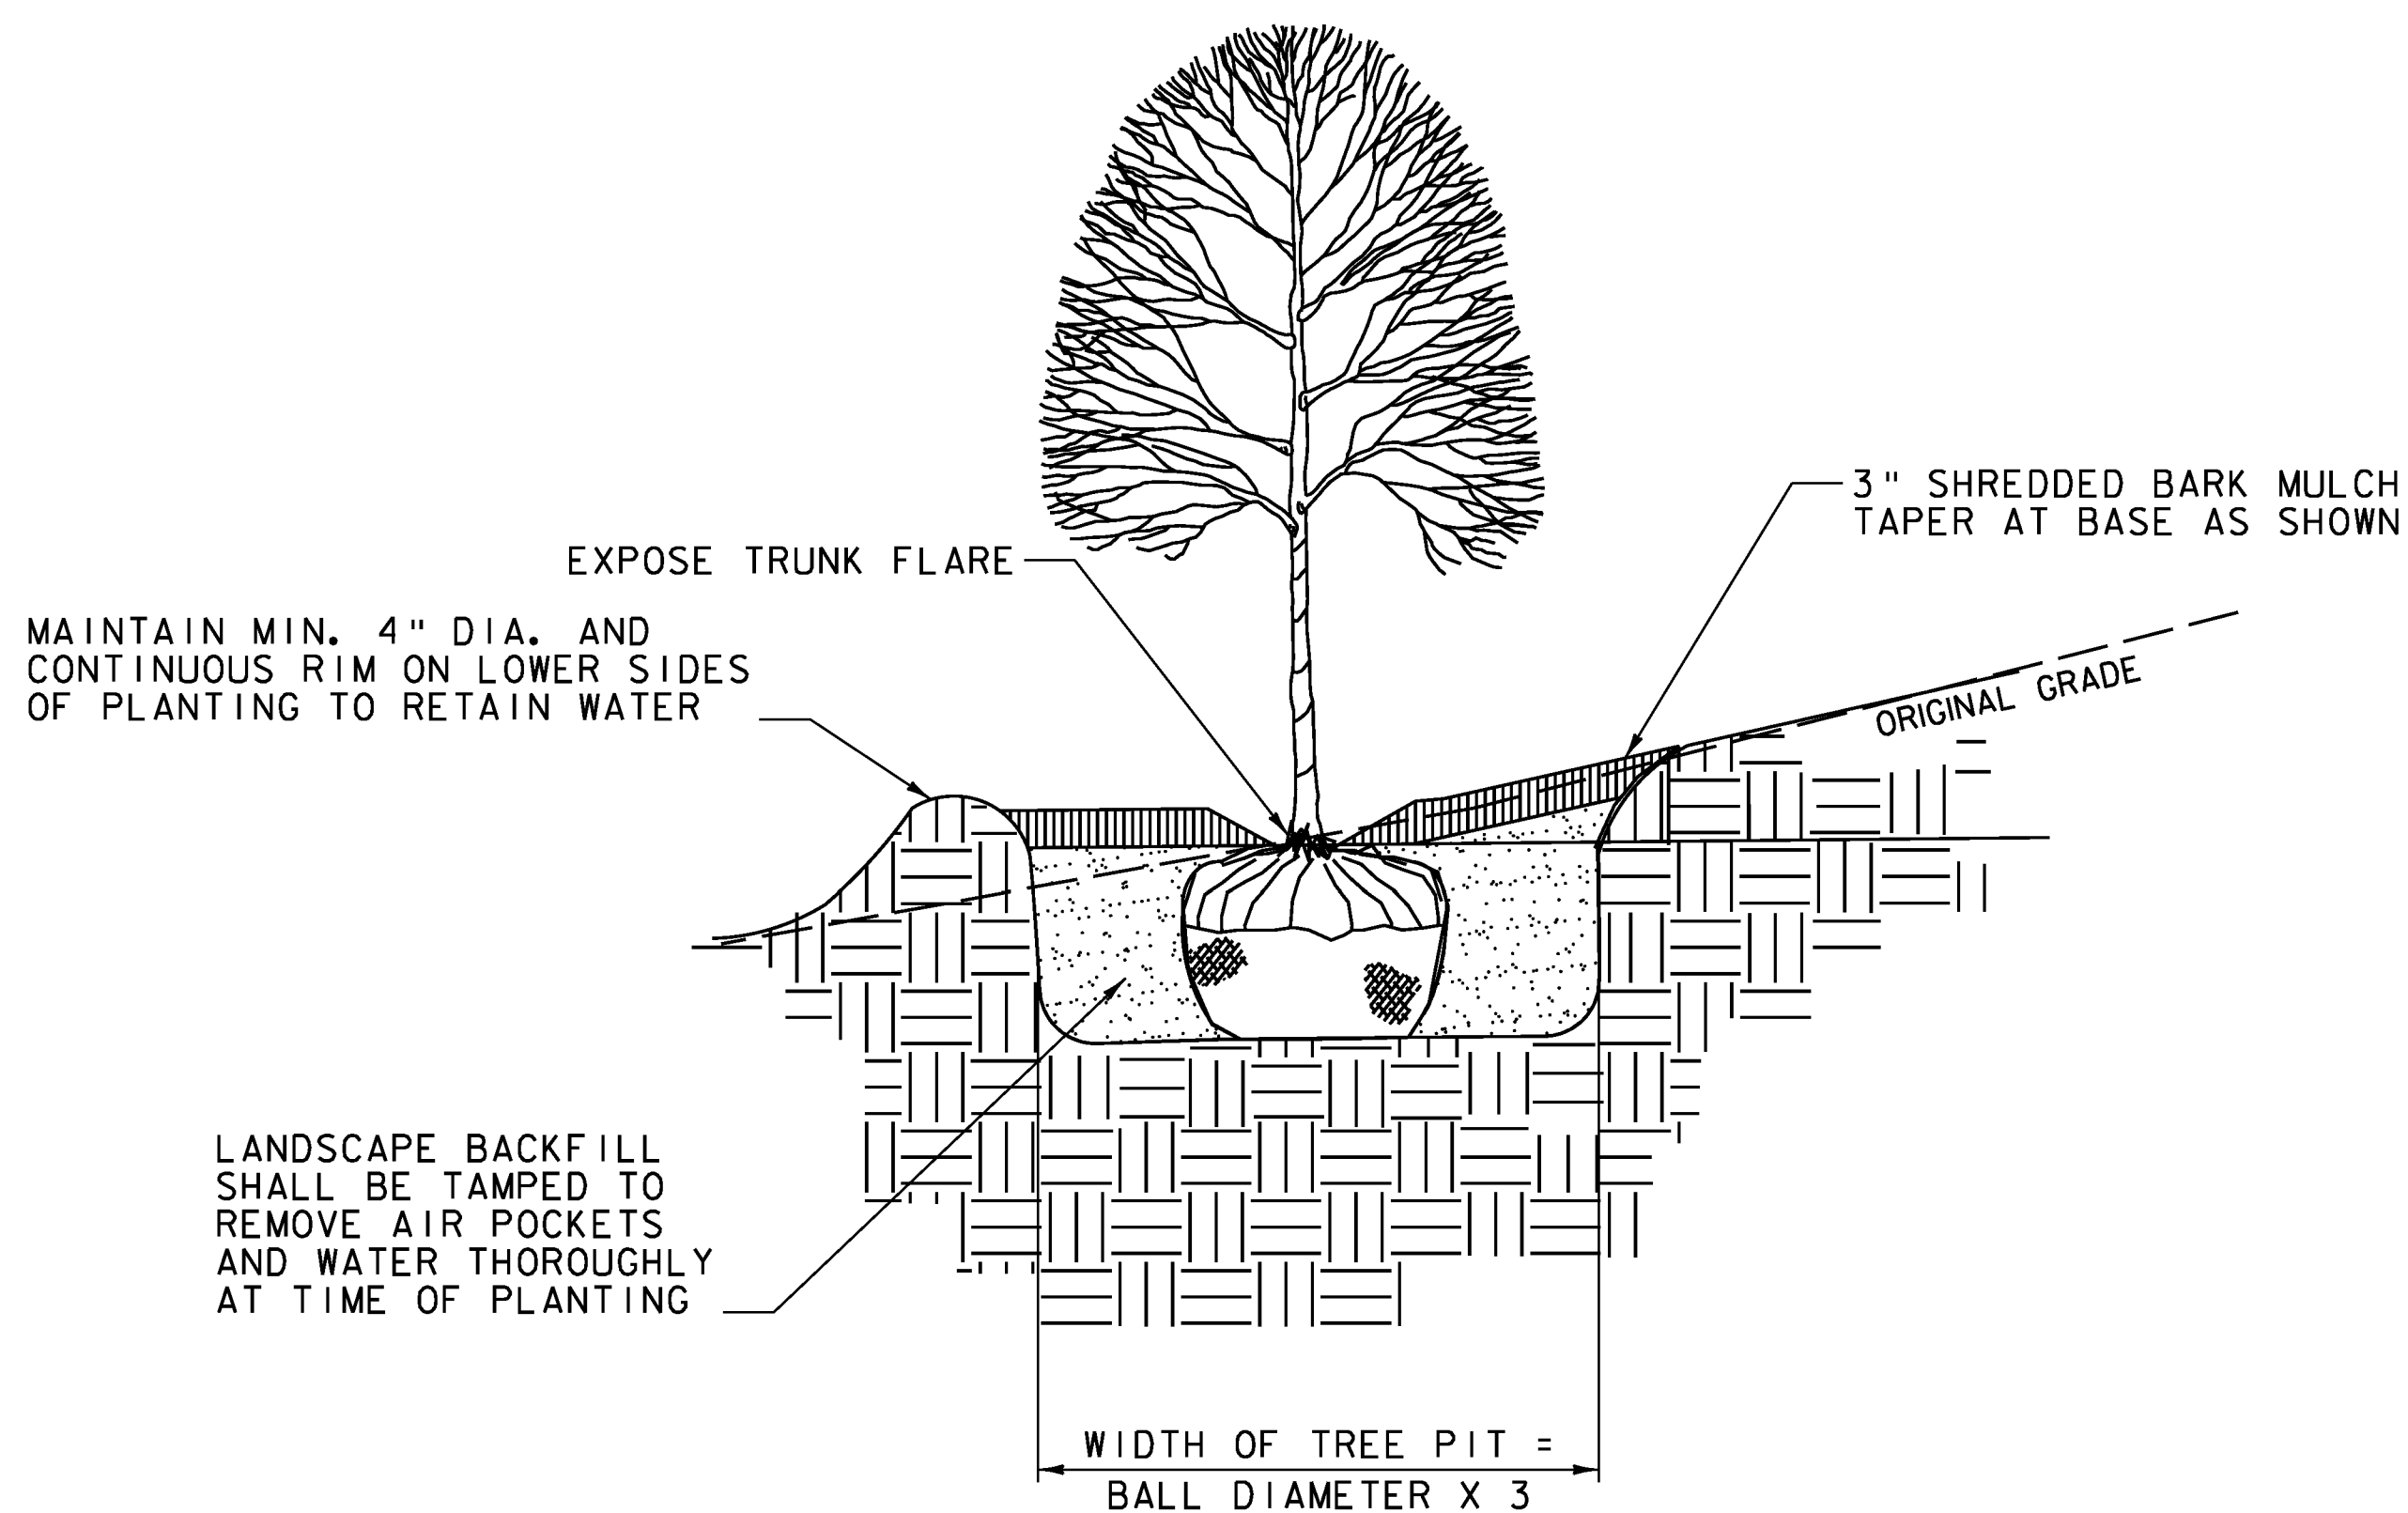

TREE PLANTING ON SLOPES DETAIL  
NOT TO SCALE



SHRUB PLANTING ON SLOPES DETAIL  
NOT TO SCALE



**LANDSCAPE NOTES:**

1. ALL PLANTING LOCATIONS SHALL BE STAKED OUT PRIOR TO PLANTING. THE ENGINEER IN CONSULTATION WITH THE AGENCY'S CONSULTANT FIELD NATURALIST MAY ADJUST THE STAKES AS NEEDED PRIOR TO INSTALLATION. ADJUSTMENTS TO THE PLANTING DESIGN AND LAYOUT MAY BE REQUIRED BASED UPON ACTUAL FIELD CONDITIONS.
2. ALL LANDSCAPE CONSTRUCTION ACTIVITIES SHALL BE CONFINED TO WITHIN THE LIMITS OF DISTURBANCE AS IDENTIFIED ON THE PLANS OR AS OTHERWISE DIRECTED BY THE ENGINEER.
3. LANDSCAPE BACKFILL SHALL CONSIST OF ONE HALF SCREENED TOPSOIL, ONE QUARTER COMPOST, AND ONE QUARTER NATIVE MATERIAL AS APPROVED BY THE ENGINEER. TAMP TO REMOVE AIR POCKETS AND WATER THOROUGHLY IMMEDIATELY AFTER PLANTING. TREES TO RECEIVE A MINIMUM OF 10 GALLONS AT EACH WATERING, TWICE WEEKLY DURING THE ESTABLISHMENT PERIOD. SHRUBS TO RECEIVE A MINIMUM OF 5 GALLONS AT EACH WATERING, TWICE WEEKLY DURING THE ESTABLISHMENT PERIOD. UNSUITABLE NATIVE MATERIAL SHALL BE REPLACED WITH IMPORTED APPROVED TOPSOIL AS DIRECTED BY ENGINEER.
4. MYCORRHIZA SHALL BE APPLIED TO ALL TREE AND SHRUB PLANTINGS PER MANUFACTURER'S INSTRUCTION AND FURNISHED IN ACCORDANCE WITH SUBSECTION 755.07.
5. A 3-4" LAYER OF BARK MULCH AROUND PLANTINGS SHALL BE AGED, DOUBLE SHREDDED AND IN ITS NATURAL UNDYED STATE. EXTEND MULCH LAYER 6" BEYOND PLANT PIT TO PREVENT DRYING AIR FROM REACHING ROOT BALL. TAPER MULCH TO BASE OF TRUNK FLARE AS WELL. AVOID STOCKPILING MULCH FOR LONG PERIODS TO PREVENT ANAEROBIC CONDITION AND BUILD UP OF TOXINS.
6. ALL TREES SHALL BE GROWN AS TREE FORMS AND TRAINED IN THE NURSERY TO A SINGLE STRAIGHT TRUNK.
7. SIDE SLOPE PLANTING IN STONE FILL: DIG INDIVIDUAL 3' DIA. PLANTING POCKETS, ONE FOR EACH SHRUB AS LOCATED ON THE PLANTING PLANS.
8. LANDSCAPE BACKFILL SHALL BE PLACED FOR TREES AT TIME OF FINAL GRADING SO TREES CAN BE PLANTED AT A LATER DATE AND MATERIAL WILL BE IN PLACE.
9. PLACE TREE IN HOLE SO THAT MAIN ORDER ROOTS ARE AT OR SLIGHTLY ABOVE FINISHED GRADE. REMOVE ALL EXCESS SOIL ON TOP OF THE ROOT FLARE AND ABOVE MAIN ORDER ROOTS. AVOID PLANTING TOO DEEP. ONCE IN THE PLANTING HOLE, REMOVE TWINE AND BURLAP FROM TOP 1/2 OF BALL; IF SYNTHETIC, REMOVE COMPLETELY. CUT WIRE BASKETS AND REMOVE ENTIRE SIDES.

PROJECT NAME: BRATTLEBORO  
PROJECT NUMBER: BRO 1442(35)

FILE NAME: z10j062details_plants.dgn  
PROJECT LEADER: S.E. BURBANK  
DESIGNED BY: E.A. FIALA  
PLANTING DETAILS

PLOT DATE: 10/14/2013  
DRAWN BY: E.A. FIALA  
CHECKED BY: S.E. BURBANK  
SHEET 22 OF 68

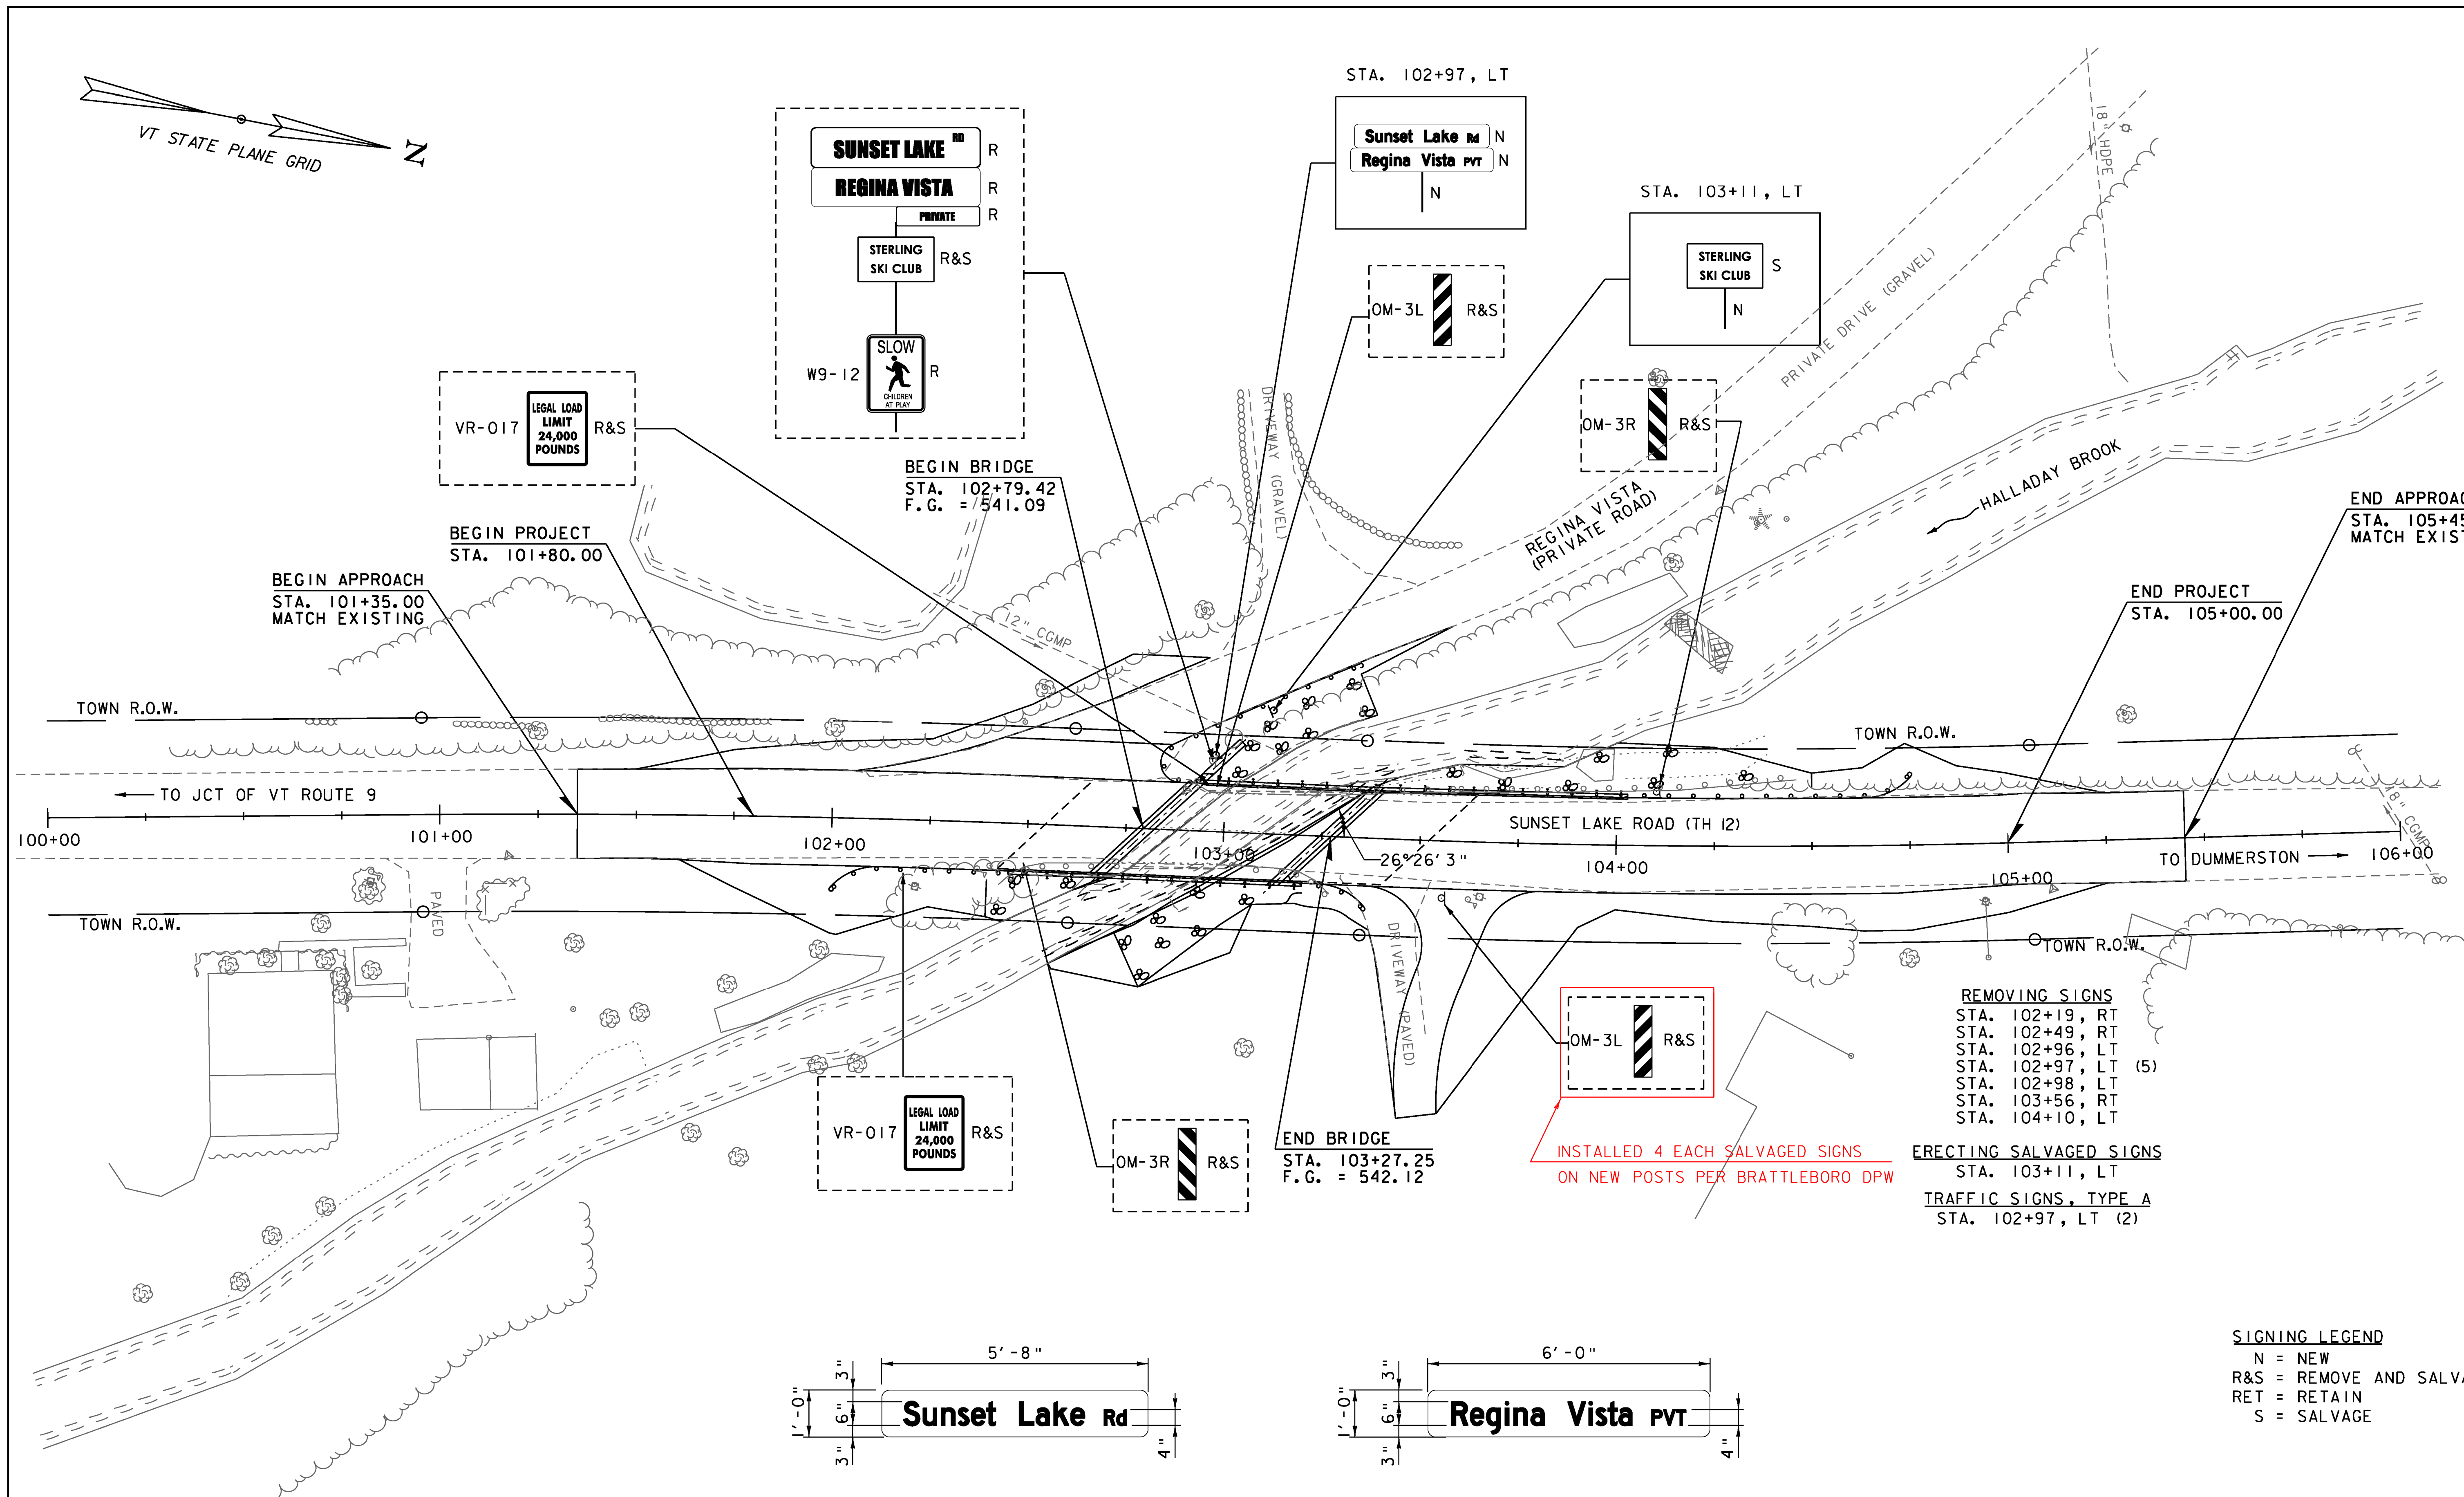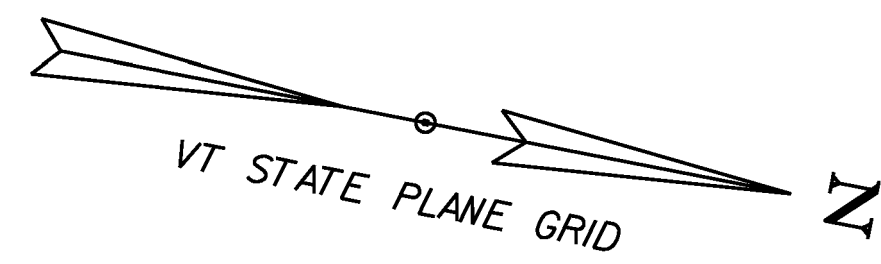

BEGIN APPROACH  
STA. 101+35.00  
MATCH EXISTING

BEGIN PROJECT  
STA. 101+80.00

BEGIN BRIDGE  
STA. 102+79.42  
F.G. = 541.09



END BRIDGE  
STA. 103+27.25  
F.G. = 542.12

END PROJECT  
STA. 105+00.00

END APPROACH  
STA. 105+45.00  
MATCH EXISTING

- REMOVING SIGNS**  
 STA. 102+19, RT  
 STA. 102+49, RT  
 STA. 102+96, LT  
 STA. 102+97, LT (5)  
 STA. 102+98, LT  
 STA. 103+56, RT  
 STA. 104+10, LT
- ERECTING SALVAGED SIGNS**  
 STA. 103+11, LT
- TRAFFIC SIGNS, TYPE A**  
 STA. 102+97, LT (2)

- SIGNING LEGEND**  
 N = NEW  
 R&S = REMOVE AND SALVAGE  
 RET = RETAIN  
 S = SALVAGE

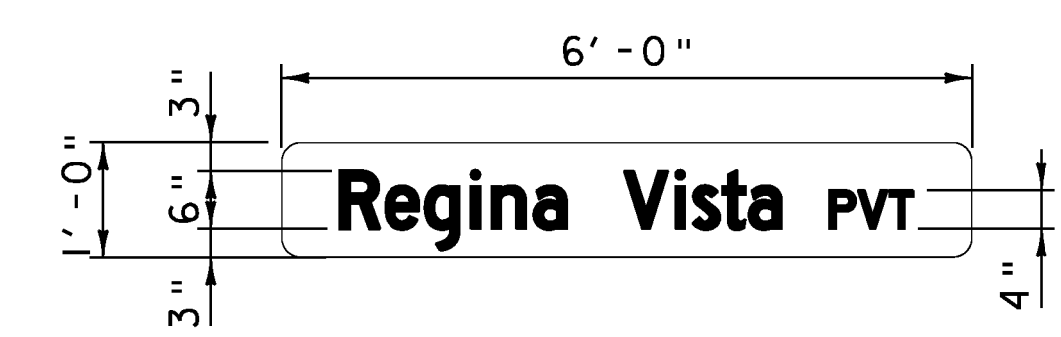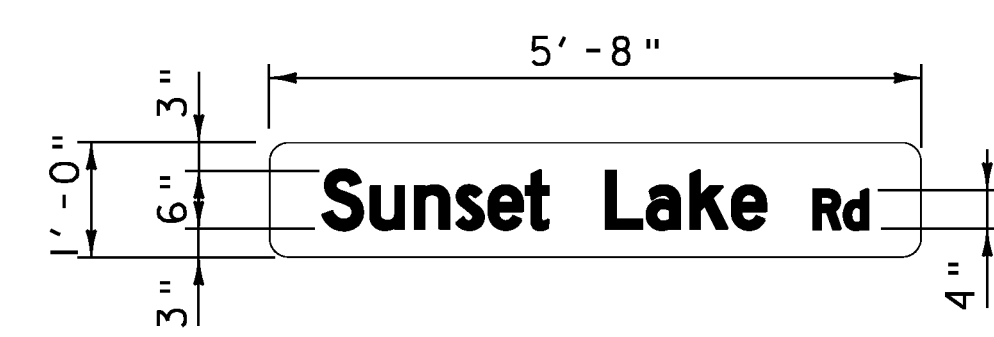

SCALE 1" = 20'-0"  
 20 0 20



PROJECT NAME:	BATTLEBORO
PROJECT NUMBER:	BRO 1442(35)
FILE NAME:	z10j062+sl.dgn
PROJECT LEADER:	S.E. BURBANK
DESIGNED BY:	S.E. BURBANK
TRAFFIC SIGNS & LINE STRIPING SHEET	
PLOT DATE:	10/14/2013
DRAWN BY:	J.L. LEMIEUX
CHECKED BY:	S.E. BURBANK
SHEET	23 OF 68



**SOIL CLASSIFICATION**

AASHTO

A1	Gravel and Sand
A3	Fine Sand
A2	Silty or Clayey Gravel and Sand
A4	Silty Soil - Low Compressibility
A5	Silty Soil - Highly Compressible
A6	Clayey Soil - Low Compressibility
A7	Clayey Soil - Highly Compressible

**ROCK QUALITY DESIGNATION**

R.Q.D. (%)	ROCK DESCRIPTION
<25	Very Poor
25 to 50	Poor
51 to 75	Fair
76 to 90	Good
>90	Excellent

**SHEAR STRENGTH**

UNDRAINED SHEAR STRENGTH IN P.S.F.	CONSISTENCY
<250	Very Soft
250-500	Soft
500-1000	Med. Stiff
1000-2000	Stiff
2000-4000	Very Stiff
>4000	Hard

**CORRELATION GUIDE OF "N" TO DENSITY/CONSISTENCY**



DENSITY (GRANULAR SOILS)		CONSISTENCY (COHESIVE SOILS)	
N	DESCRIPTIVE TERM	N	DESCRIPTIVE TERM
<5	Very Loose	<2	Very Soft
5-10	Loose	2-4	Soft
11-24	Med. Dense	5-8	Med. Stiff
25-50	Dense	9-15	Stiff
>50	Very Dense	16-30	Very Stiff
		31-60	Hard
		>60	Very Hard

**COMMONLY USED SYMBOLS**

- ▼ Water Elevation
- ⊕ Standard Penetration Boring
- ⊕ Auger Boring
- ⊕ Rod Sounding
- ⊕ Sample
- N Standard Penetration Test
- Blow Count Per Foot For:
- 2" O.D. Sampler
- 1 1/2" I.D. Sampler
- Hammer Weight Of 140 Lbs.
- Hammer Fall Of 30"
- YS Field Vane Shear Test
- US Undisturbed Soil Sample
- B Blast
- DC Diamond Core
- MD Mud Drill
- WA Wash Ahead
- HSA Hollow Stem Auger
- AX Core Size 1 1/8"
- BX Core Size 1 3/8"
- NX Core Size 2 1/8"
- M Double Tube Core Barrel Used
- LL Liquid Limit
- PL Plastic Limit
- PI Plasticity Index
- NP Non Plastic
- w Moisture Content (Dry Wgt. Basis)
- D Dry
- M Moist
- MTW Moist To Wet
- W Wet
- Sat Saturated
- Bo Boulder
- Gr Gravel
- Sa Sand
- SI Silt
- Cl Clay
- HP Hardpan
- Le Ledge
- NLTD No Ledge To Depth
- CNPF Can Not Penetrate Further
- TLOB Top of Ledge Or Boulder
- NR No Recovery
- Rec. Recovery
- %Rec. Percent Recovery
- ROD Rock Quality Designation
- CBR California Bearing Ratio
- < Less Than
- > Greater Than
- R Refusal (N > 100)
- VTSPG NAD83 - See Note 7

**COLOR**

- |     |        |      |              |
|-----|--------|------|--------------|
| blk | Black  | pnk  | Pink         |
| bl  | Blue   | pu   | Purple       |
| brn | Brown  | rd   | Red          |
| dk  | Dark   | tn   | Tan          |
| gr  | Gray   | wh   | White        |
| gn  | Green  | yel  | Yellow       |
| lt  | Light  | mltc | Multicolored |
| or  | Orange |      |              |

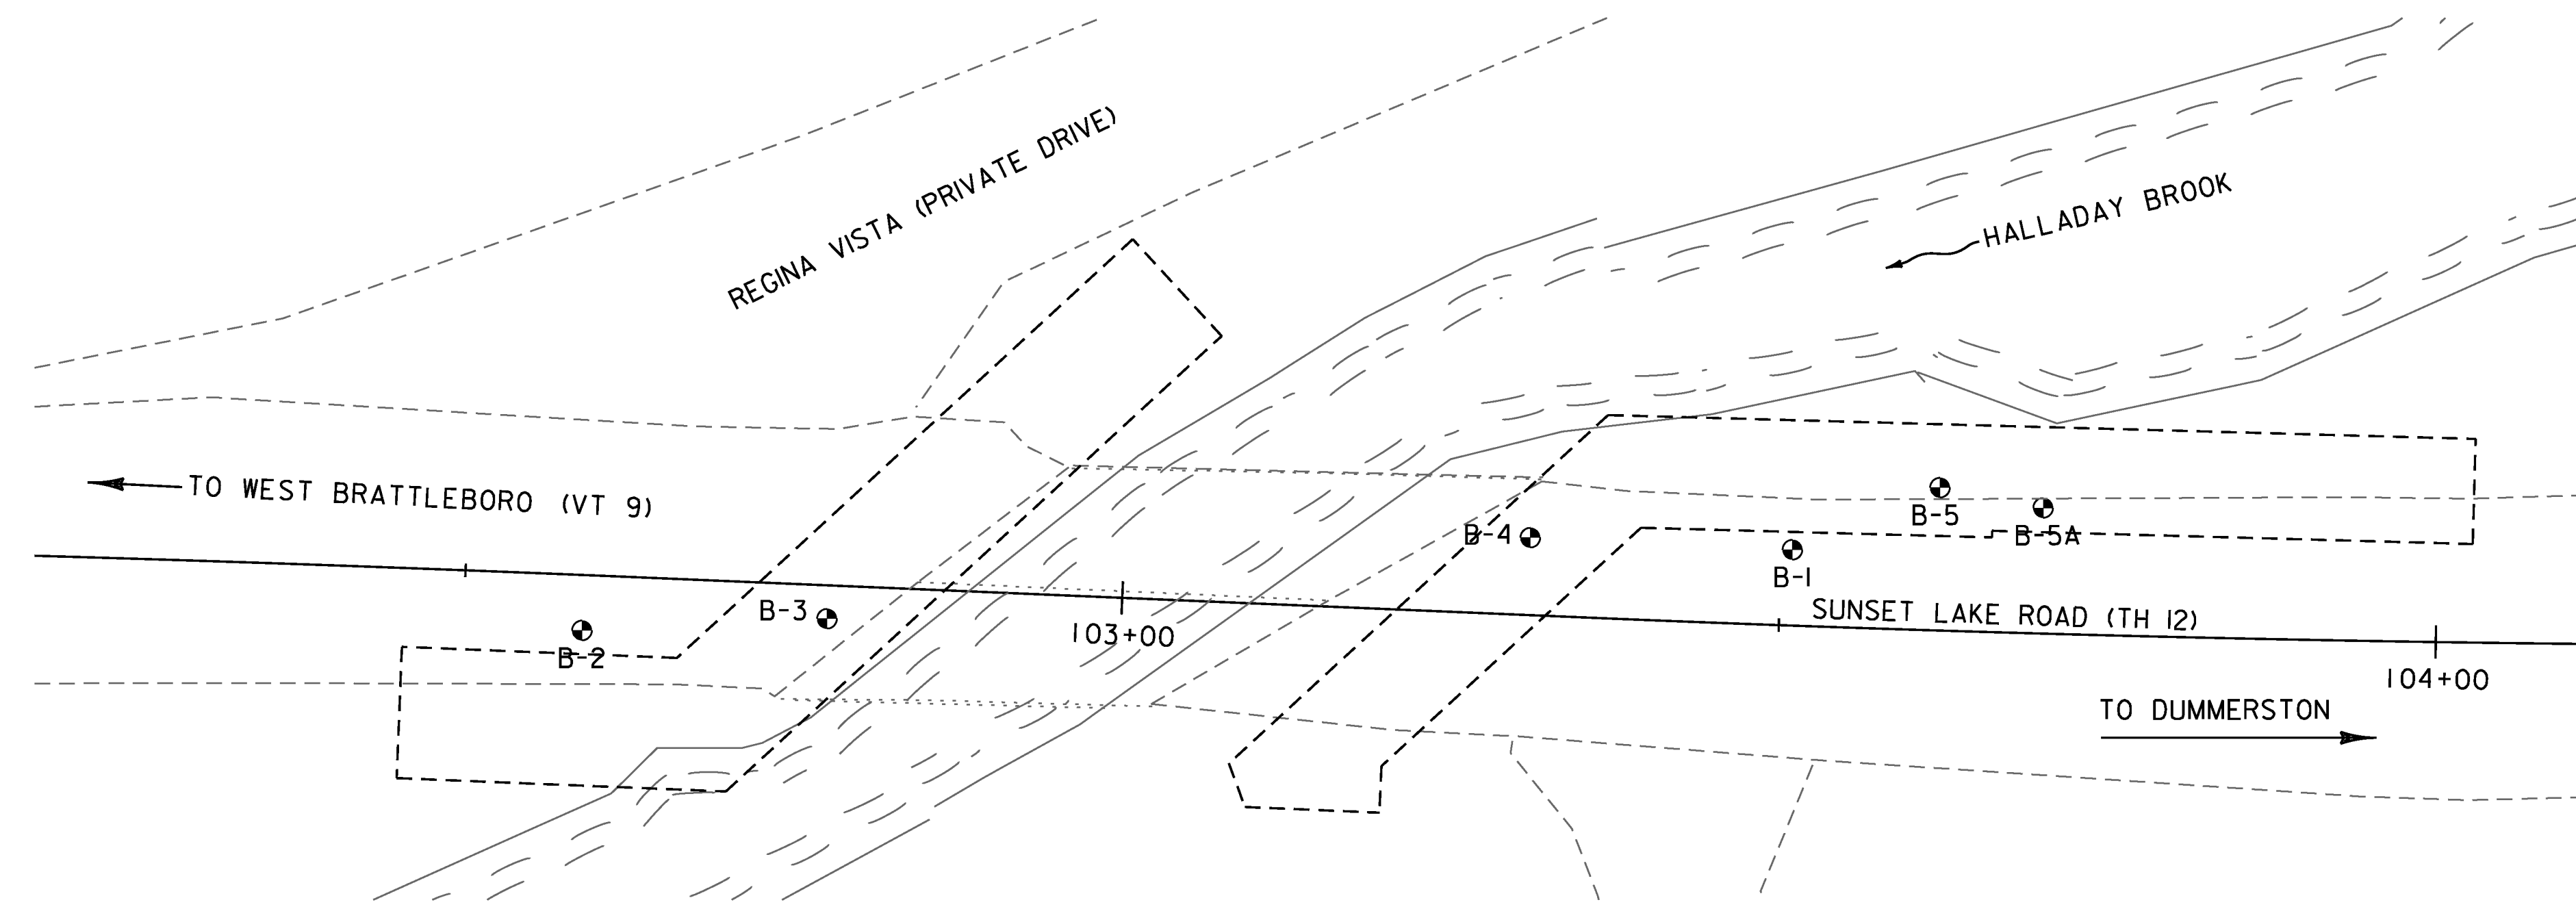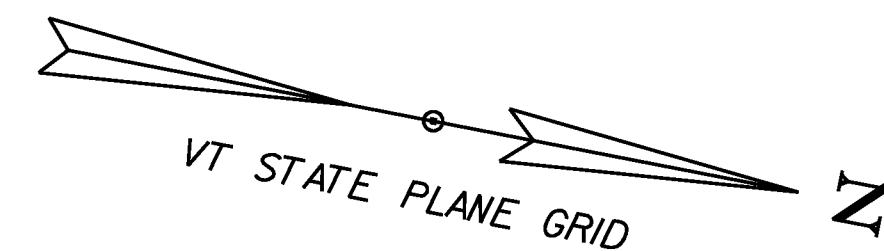

**BORING CHART**

HOLE NO.	SURV. STATION	OFFSET	GROUND ELEV.	ELEV. TLOB
B-1	103+50.31	5.78 LT	N/A	N/A
B-2	102+59.04	4.22 RT	N/A	N/A
B-3	102+77.63	2.54 RT	540.0	521.0
B-4	103+30.82	5.89 LT	541.0	528.0
B-5	103+61.93	10.87 LT	541.0	532.8
B-5A	103+69.87	9.57 LT	N/A	N/A

**BORING LAYOUT**

SCALE 1" = 10' - 0"

**GENERAL NOTES**

- The subsurface explorations shown herein were made between in February, 2004 by Mikes Boring and Coring and November, 2011 by the Agency.
- Soil and rock classifications, properties and descriptions are based on engineering interpretation from available subsurface information by Mikes Coring and Boring and the Agency, and may not necessarily reflect actual variations in subsurface conditions that may be encountered between individual boring or sample locations.
- Observed water levels and/or conditions indicated are as recorded at the time of exploration and may vary according to the prevailing rainfall, methods of exploration and other factors.
- Engineering judgment was exercised in preparing the subsurface information presented herein. Analysis and interpretation of subsurface data was performed and interpreted for Agency design and estimating purposes. Presentation of the information in the Contract is intended to provide the Contractor access to the same data available to the Agency. The subsurface information is presented in good faith and is not intended as a substitute for personal investigation, independent interpretation, independent analysis or judgment by the Contractor.
- Pictorial structure details shown on the boring plan layout or soils profile are for illustrative purposes only and may not accurately portray final contract details.
- Terminology used on boring logs to describe the hardness, degree of weathering, and spacing of fractures, joints and other discontinuities in the bedrock is defined in the AASHTO Manual on Subsurface Investigations, 1988.
- Northing and Easting coordinates are shown in Vermont State Plane Grid North American Datum 1983 in survey feet.

**DEFINITIONS (AASHTO)**

- BEDROCK (LEDGE)** - Rock in its native location of indefinite thickness.
- BOULDER** - A rock fragment with an average dimension > 12 inches.
- COBBLE** - Rock fragments with an average dimension between 3 and 12 inches.
- GRAVEL** - Rounded particles of rock < 3" and > 0.0787" (#10 sieve).
- SAND** - Particles of rock < 0.0787" (#10 sieve) and > 0.0029" (#200 sieve).
- SILT** - Soil < 0.0029" (#200 sieve), non or slightly plastic and exhibits no strength when air-dried.
- CLAY** - Fine grained soil, exhibits plasticity when moist and considerable strength when air-dried.
- VARVED** - Alternate layers of silt and clay.
- HARDPAN** - Extremely dense soil, cemented layer, not softened when wet.
- MUCK** - Soft organic soil (containing > 10% organic material).
- MOISTURE CONTENT** - Weight of water divided by dry weight of soil.
- FLOWING SAND** - Granular soil so saturated (loose) that it flows into drill casing during extraction of wash rod.
- STRIKE** - Angle from magnetic north to line of intersection of bed with a horizontal plane.
- DIP** - Inclination of bed with a horizontal plane.

PROJECT NAME: BRATTLEBORO  
PROJECT NUMBER: BRO 1442(35)

FILE NAME: z10j062bor.dgn  
PROJECT LEADER: M.A. COLGAN  
DESIGNED BY: S.E. BURBANK  
BORING INFORMATION SHEET

PLOT DATE: 10/14/2013  
DRAWN BY: E.A. FIALA  
CHECKED BY: S.E. BURBANK  
SHEET 25 OF 68



MIKE'S BORING & CORING  
 PO Box 75 * East Barre, Vermont 05649 * 802 476-5073

TO: Brian Austin  
 DuBois and King, Inc.  
 P.O. Box 339  
 Randolph, VT 05060-0339

PROJECT NAME: Brattleboro Bridge  
 LOCATION: Brattleboro, VT  
 MBC JOB #: 05001

SHEET: 1  
 DATE: 2-7-04  
 HOLE #: B-1  
 LINE & STA. OFFSET:

Ground Water Observations  
 Not measurable at 0 hrs

Augers-Size I.D. 3.25"  
 Split Spoon 2"  
 Hammer Wt. 140#  
 Hammer Fall 30"

Surface Elevation:  
 Date Started: 2-7-04  
 Date Completed: 2-7-04  
 Boring Foreman: Michael McGinley  
 Inspector:  
 Soils Engineer:

LOCATION OF BORING: As marked

Sample Depths From/To (Feet)	Type of Sample	Blows per 6" on Sampler	Moisture Density or Consist.	Strata Change Elev.	Soil Identification	Sample		
						No.	Pen. Inches	Rec. Inches
5'-7'	D	13/9/13/20	Damp		Sand and gravel	1	24	5
9'-11'	D	44/45/28/100 for 3"	Wet		Sand, gravel and rock	2	21	8
					Set up to core			
11'9"-12'9"	C	11:15-11:23						
12'9"-13'9"	C	11:23-11:27						
13'9"-14'9"	C	11:27-11:30						
14'9"-15'9"	C	11:31-11:36						
15'9"-16'9"	C	11:36-11:40						

Ground Surface to 9' Used 3.25" augers; Then S.S. to 11' set up to core

Earth Borings 11'  
 Rock Coring 5'  
 Samples: 2  
 HOLE NUMBER B-1

MIKE'S BORING & CORING  
 PO Box 75 * East Barre, Vermont 05649 * 802 476-5073

TO: Brian Austin  
 DuBois and King, Inc.  
 P.O. Box 339  
 Randolph, VT 05060-0339

PROJECT NAME: Brattleboro Bridge  
 LOCATION: Brattleboro, VT  
 MBC JOB #: 05001

SHEET: 2  
 DATE: 2-4-04  
 HOLE #: B-2  
 LINE & STA. OFFSET:

Ground Water Observations  
 Not measurable at 0 hrs

Augers-Size I.D. 3.25"  
 Split Spoon 2"  
 Hammer Wt. 140#  
 Hammer Fall 30"

Surface Elevation:  
 Date Started: 2-4-04  
 Date Completed: 2-7-04  
 Boring Foreman: Michael McGinley  
 Inspector:  
 Soils Engineer:

LOCATION OF BORING: As marked

Sample Depths From/To (Feet)	Type of Sample	Blows per 6" on Sampler	Moisture Density or Consist.	Strata Change Elev.	Soil Identification	Sample		
						No.	Pen. Inches	Rec. Inches
5'-7'	D	51/25/31/7	Damp		Sand and stones	1	24	6
10'-12'	D	100 for 4"	Wet	8'	Auger refusal at 8' end of split spoon wet sand rock	2	20	18
15'-17'	D	77/100 for 4"	Wet		Sand and rock	3	10	10
					Set up to core			
13'-14'	C	12:05=12:15						
14'-15'	C	12:15-12:20						
15'-16'	C	12:00-12:24						
16'-17'	C	12:32-12:40						
17'-18'	C	12:40-12:46						
18'-19'	C	12:46-12:55						
19'-20'	C	12:55-1:00						
20'-21'	C	1:00-1:06						
21'-22'	C	1:06-1:13						
22'-23'	C	1:13-1:19						

Ground Surface to 15' Used 3.25" augers; Then S.S. to 17' set up to core

Earth Borings 17'  
 Rock Coring 10'  
 Samples: 3  
 HOLE NUMBER B-2

MIKE'S BORING & CORING  
 P.O. Box 75  
 East Barre, VT 05649

To: Brian Austin  
 DuBois and King, Inc.  
 P.O. Box 339  
 Randolph, VT 05060-0339

Date 1-5-05  
 Job Name/Site Brattleboro Bridge  
 Job Number 05001  
 Crew Mike and Roland  
 Inspector Aaron




HOLE #	OFFSET	STATIC LEVEL	SOILS	AUGER REFUSAL (Feet)	DEPTH (Feet)
P-1	N/A	10'	4" asphalt into medium sand, gravel and cobbles	13'	13'
P-2	N/A	N/A	4" asphalt into medium sand, gravel and cobbles	12'	12'

TOTAL FOOTAGE: 25'  
 AUGERS USED: Solid

PROJECT NAME: BRATTLEBORO  
 PROJECT NUMBER: BRO 1442(35)

FILE NAME: z10j062borlogs.dgn  
 PROJECT LEADER: S.E. BURBANK  
 DESIGNED BY: MIKE'S BORING & CORING  
 BORING LOGS (1 OF 3)

PLOT DATE: 10/14/2013  
 DRAWN BY: E.A. FIALA  
 CHECKED BY: S.E. BURBANK  
 SHEET 26 OF 68

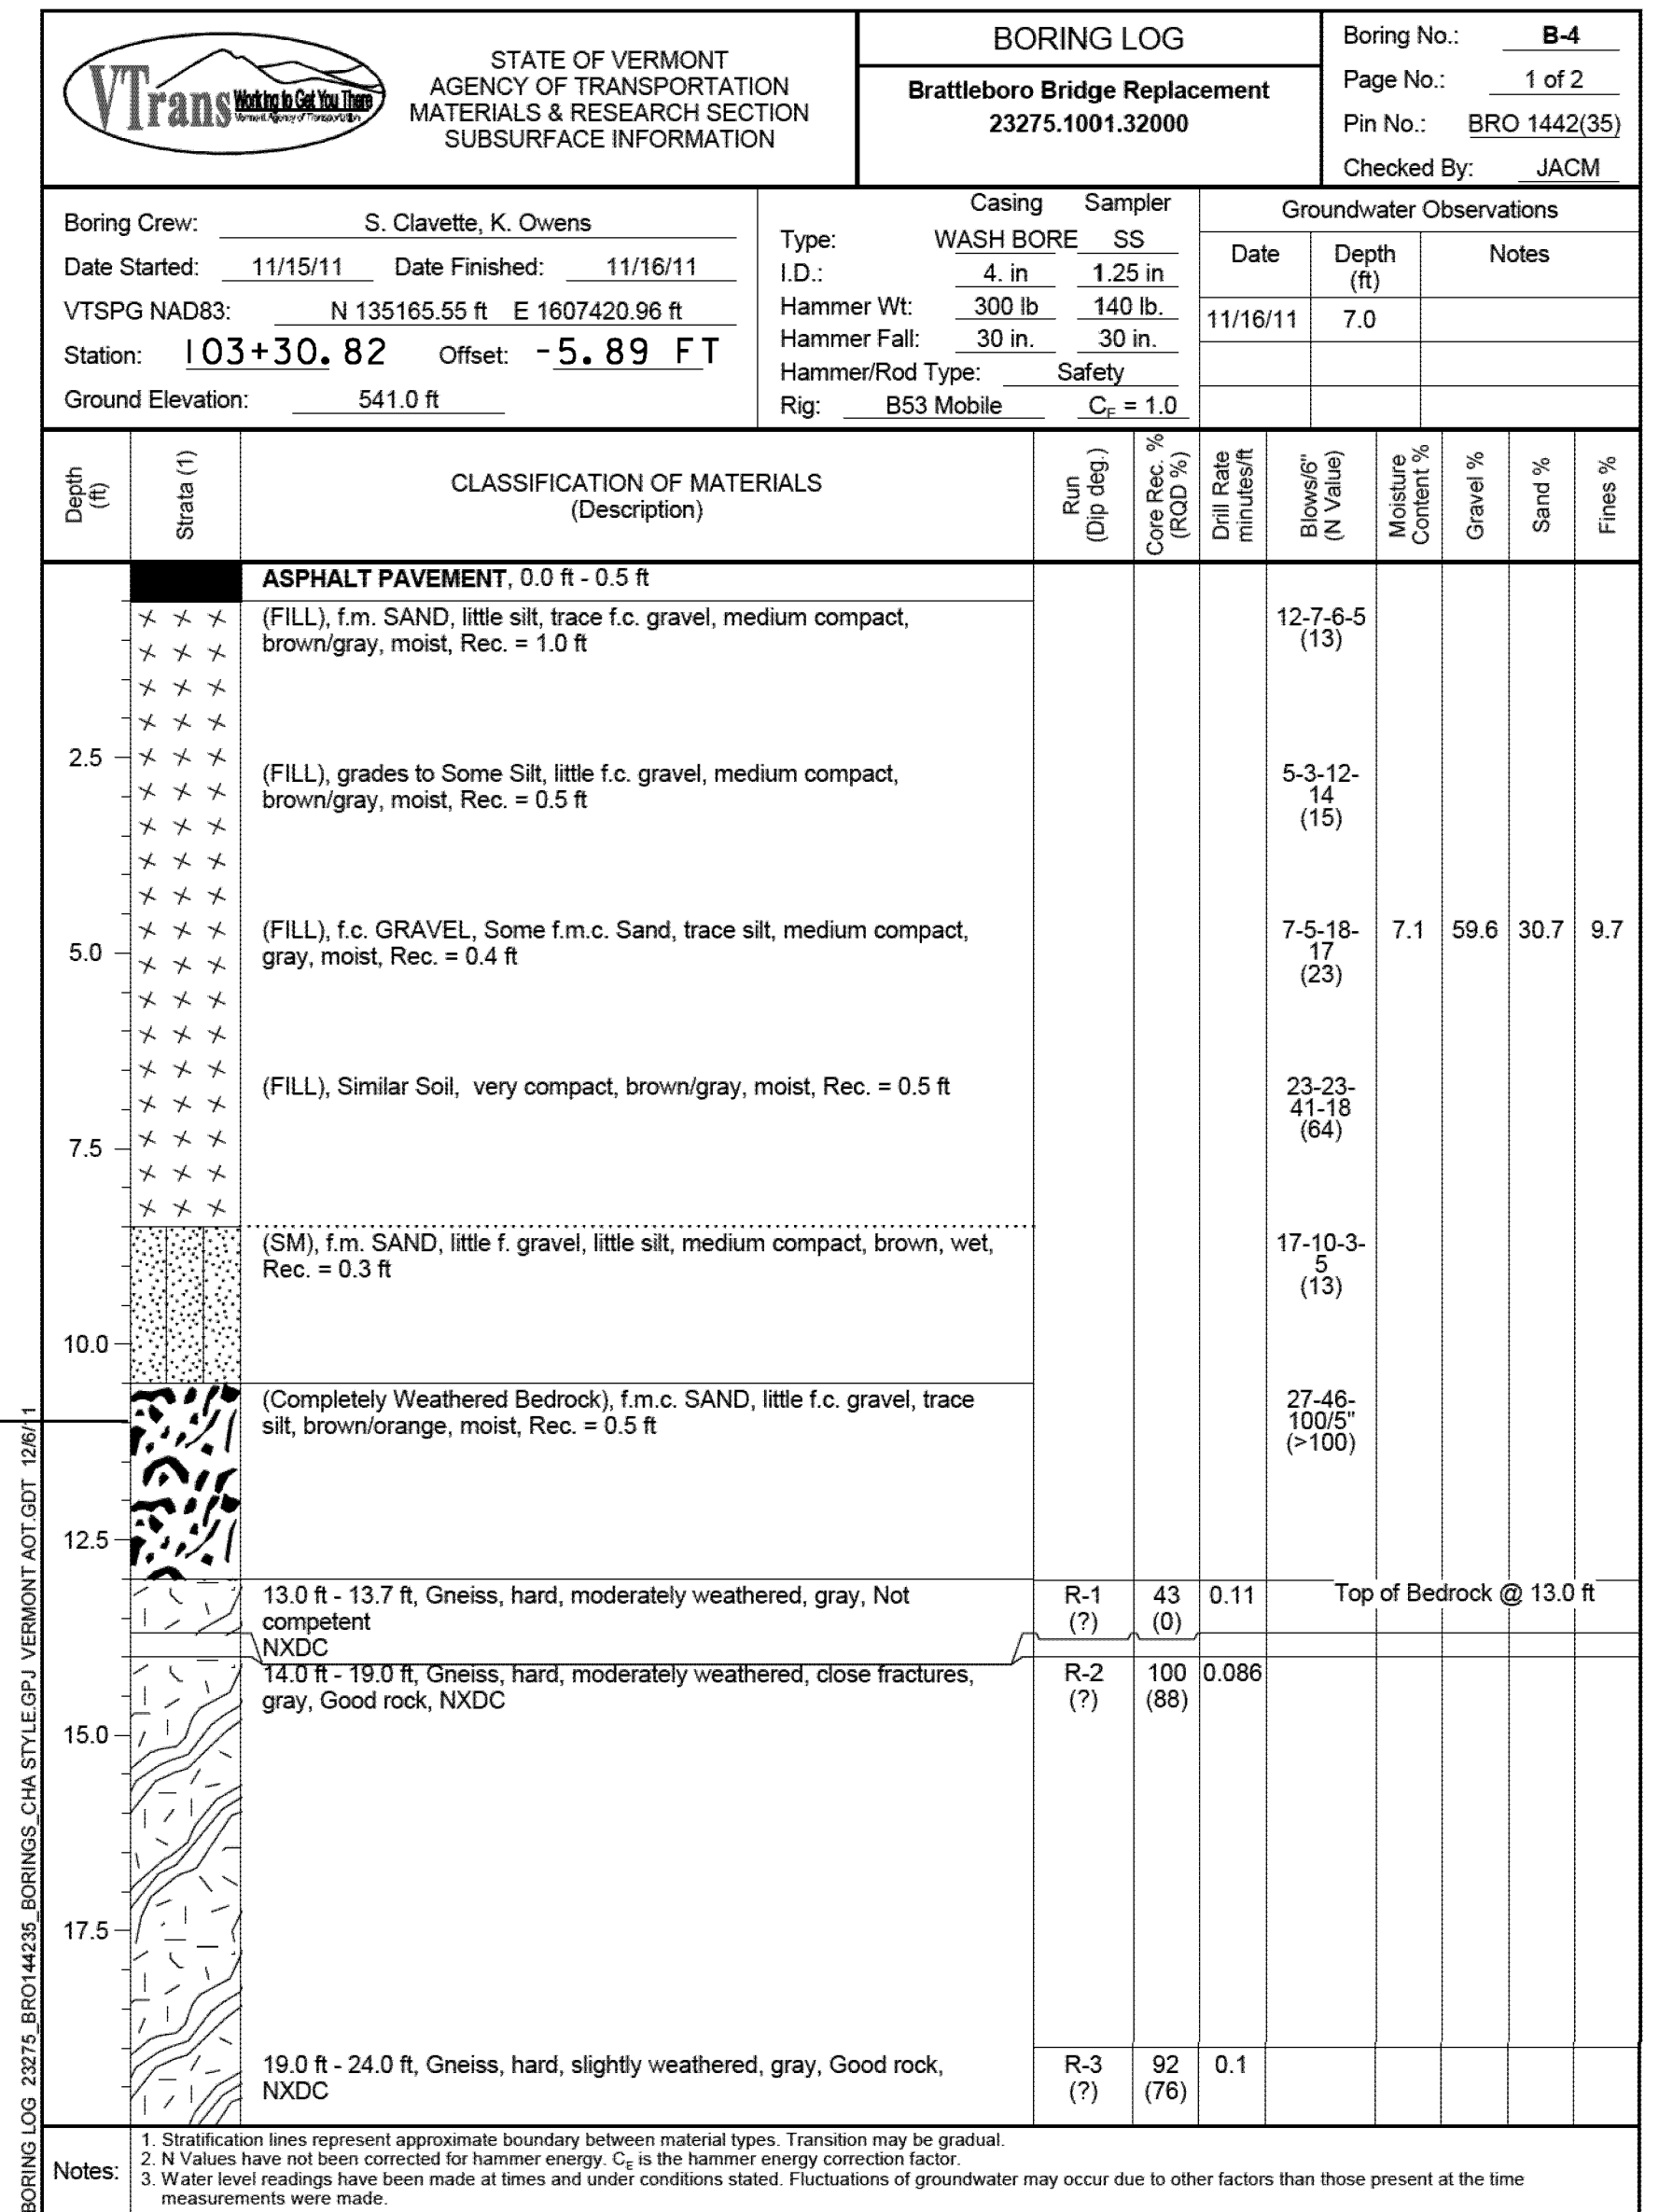
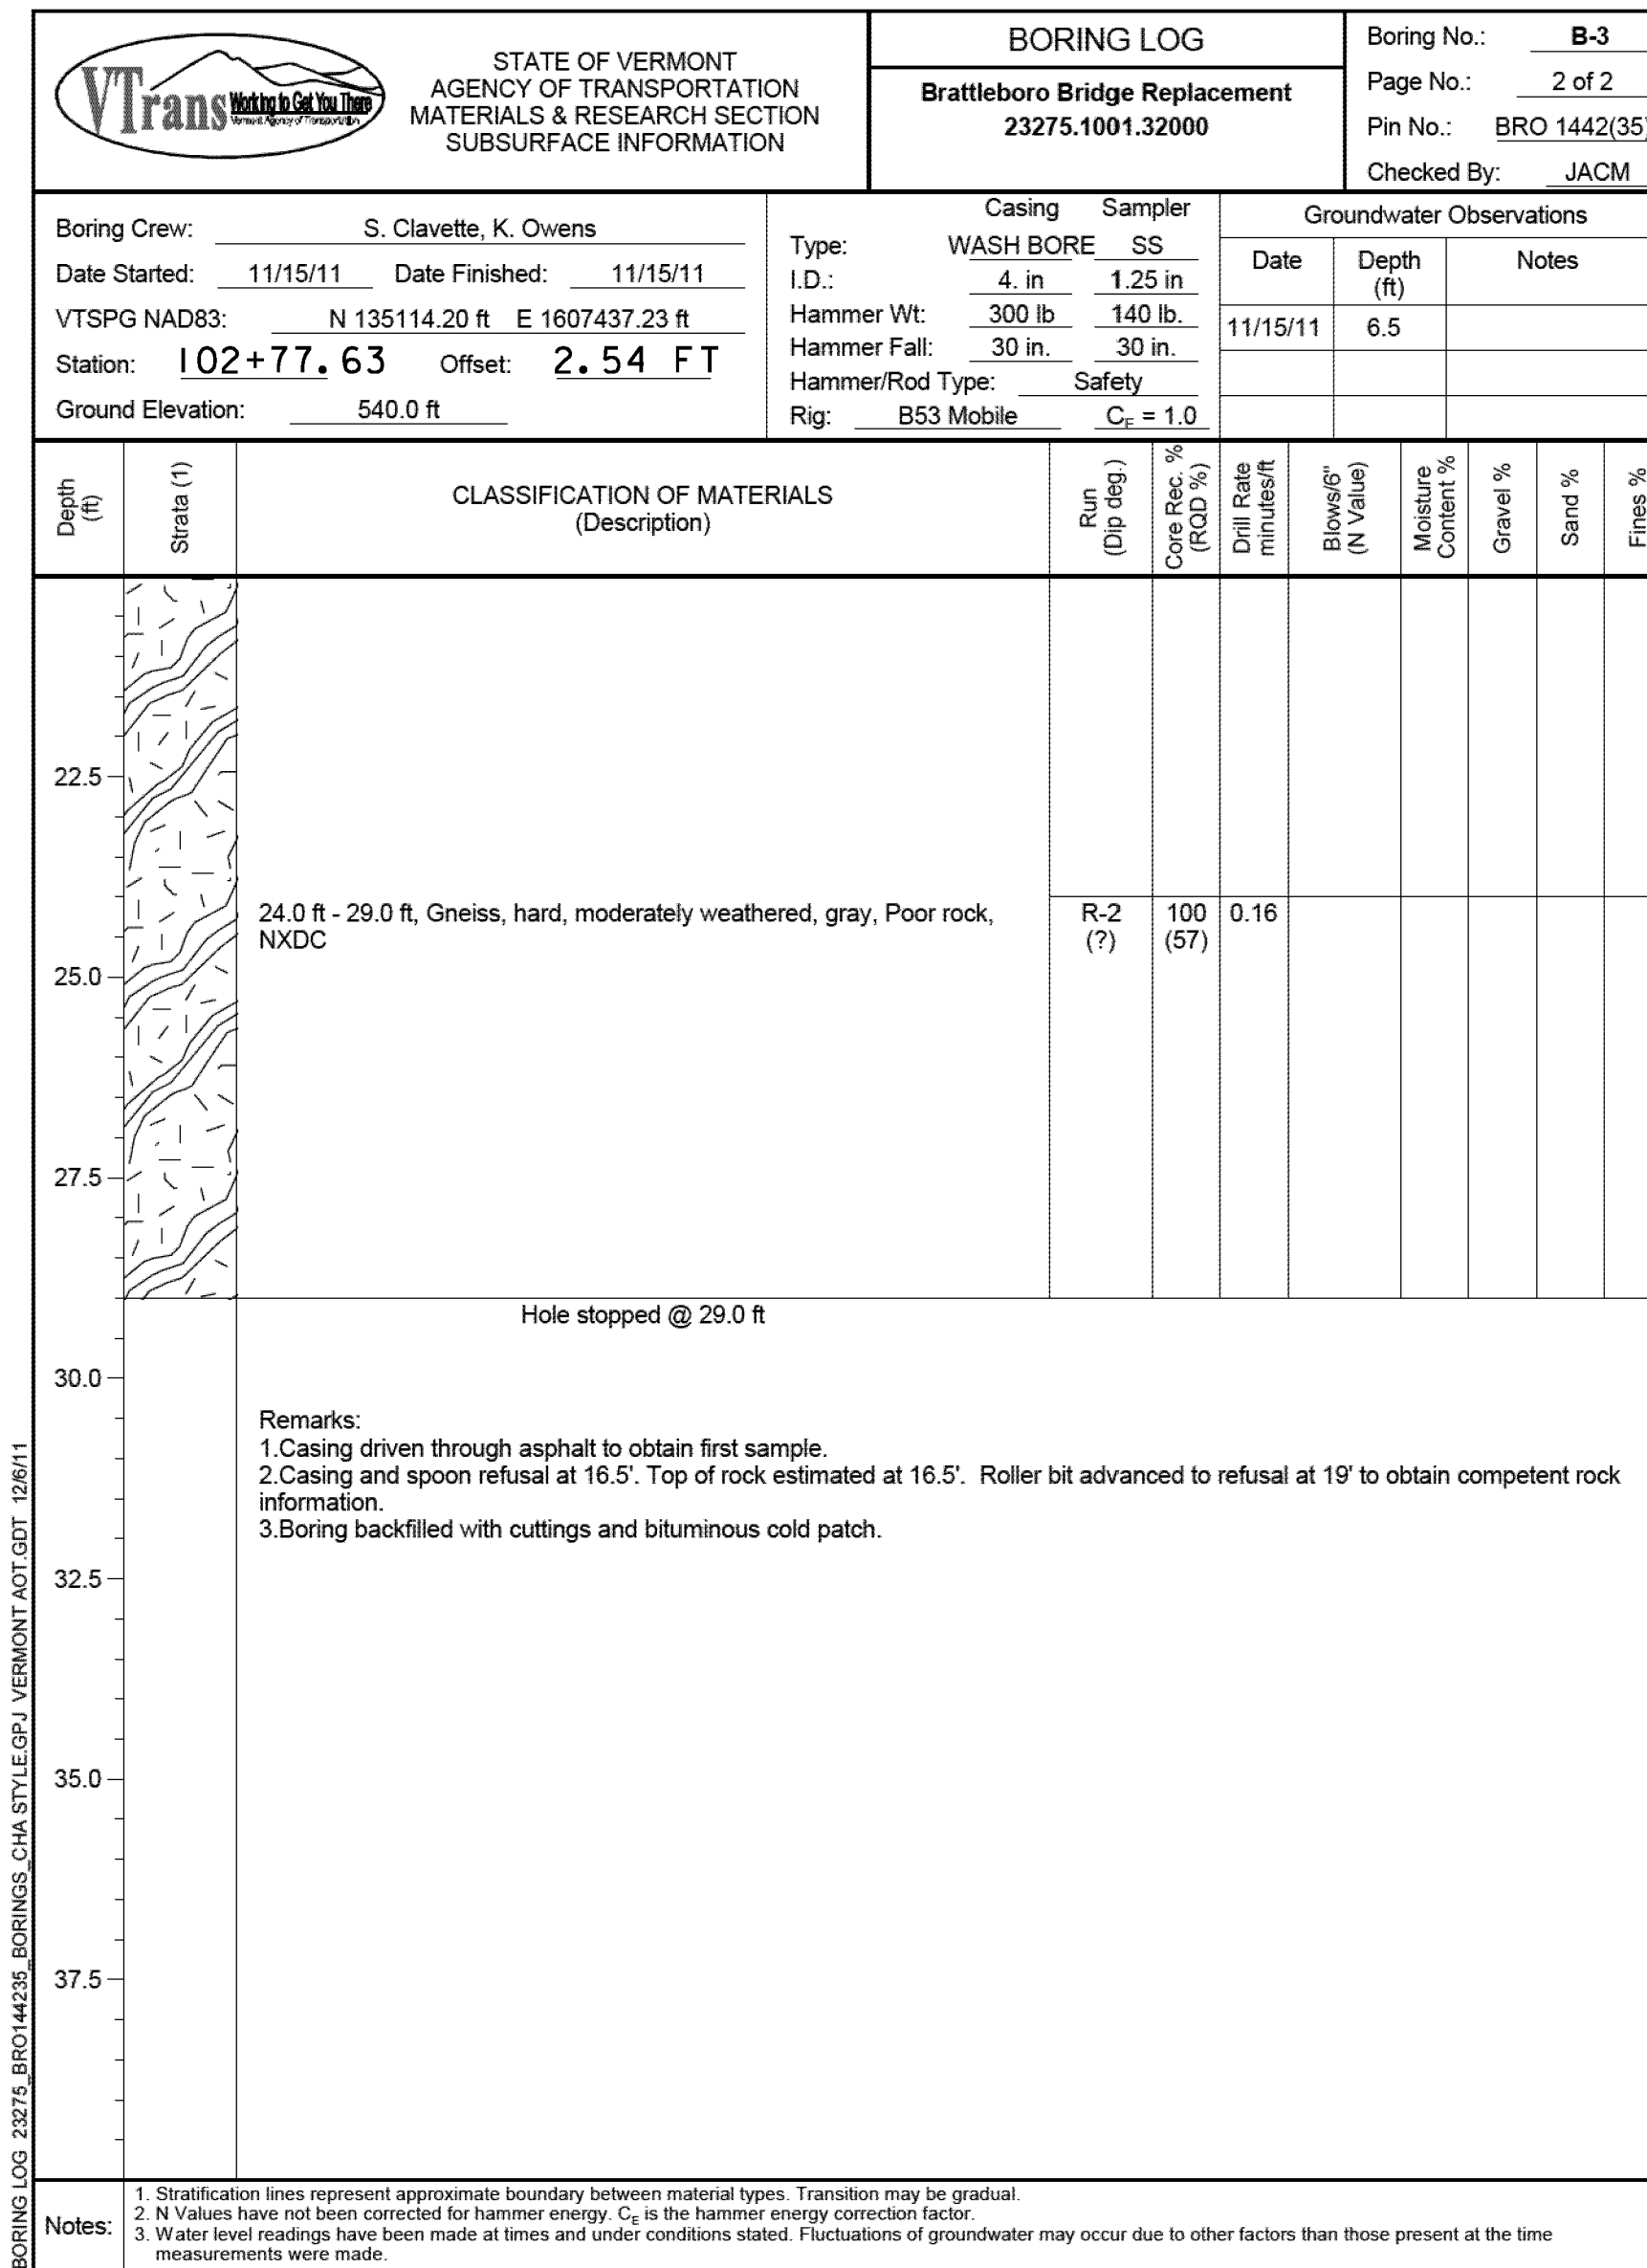
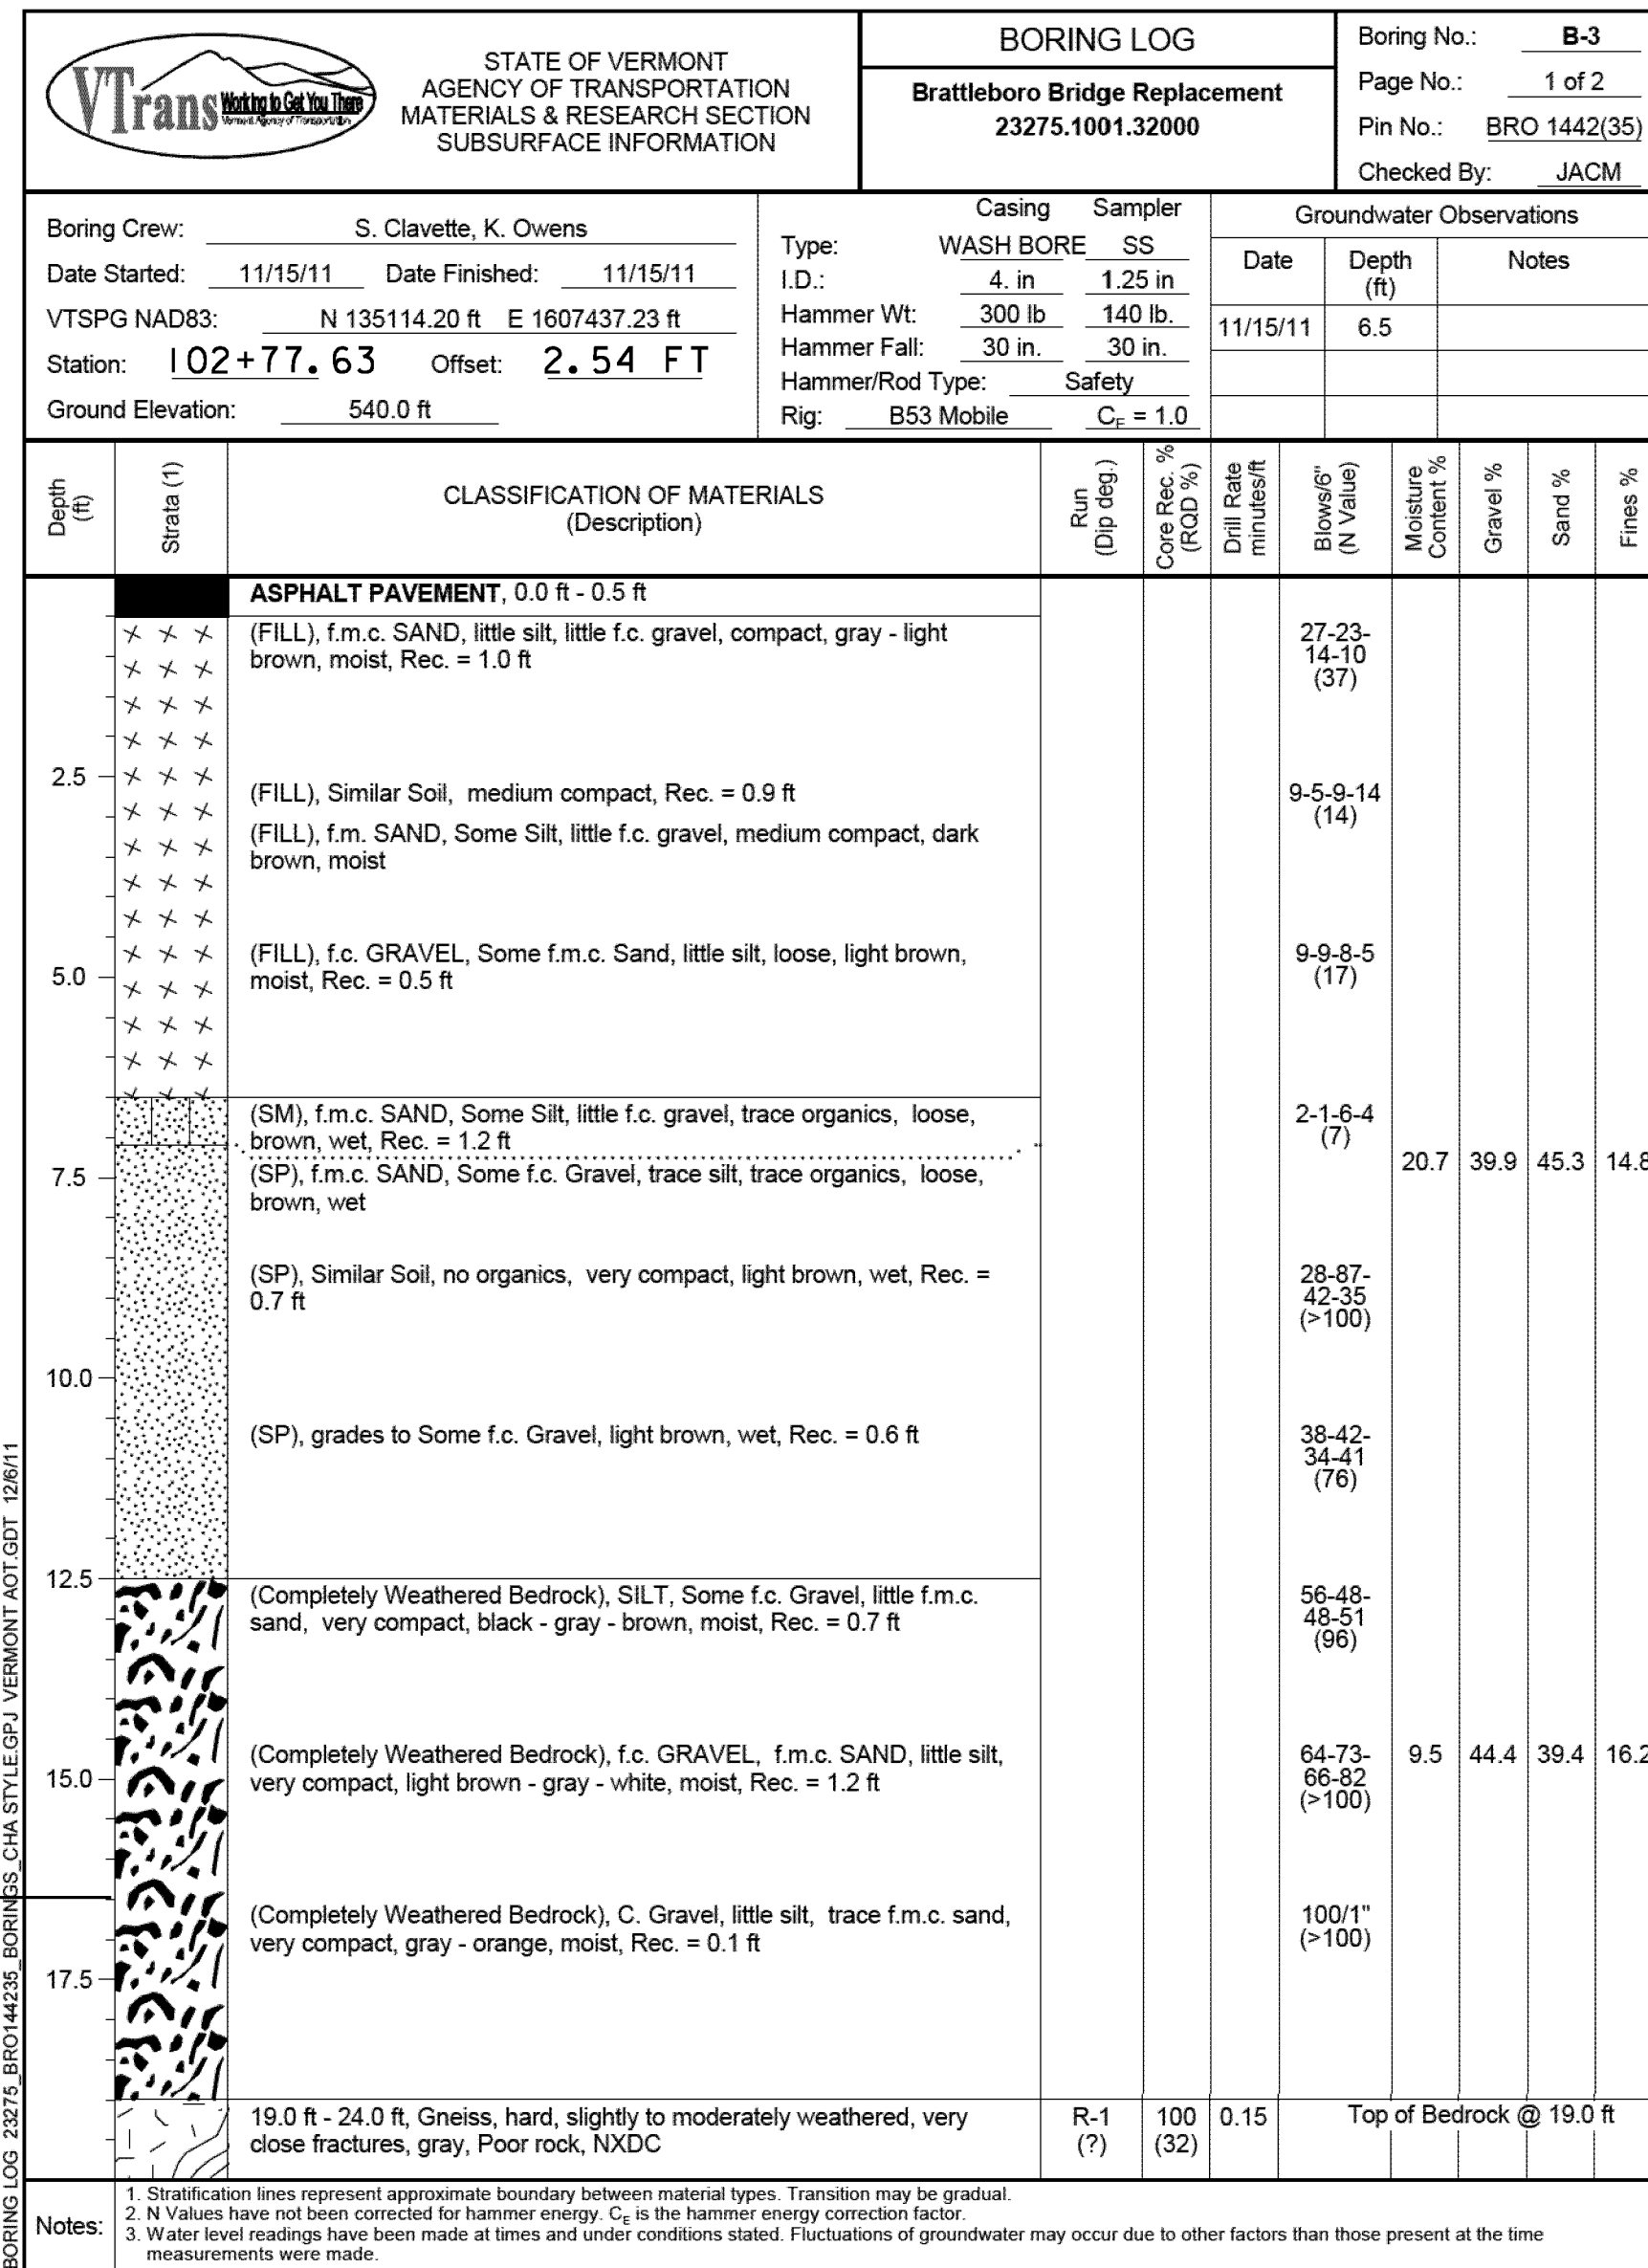


ABUTMENT NO. 1  
TOP OF FOOTING  
EL = 523.5

ABUTMENT NO. 2  
TOP OF FOOTING  
EL = 530.0

PROJECT NAME: BRATTLEBORO  
PROJECT NUMBER: BRO 1442(35)  
FILE NAME: z10J062borlogs.dgn  
PROJECT LEADER: S.E. BURBANK  
DESIGNED BY: VTRANS  
BORING LOGS (2 OF 3)  
PLOT DATE: 10/14/2013  
DRAWN BY: E.A. FIALA  
CHECKED BY: S.E. BURBANK  
SHEET 27 OF 68




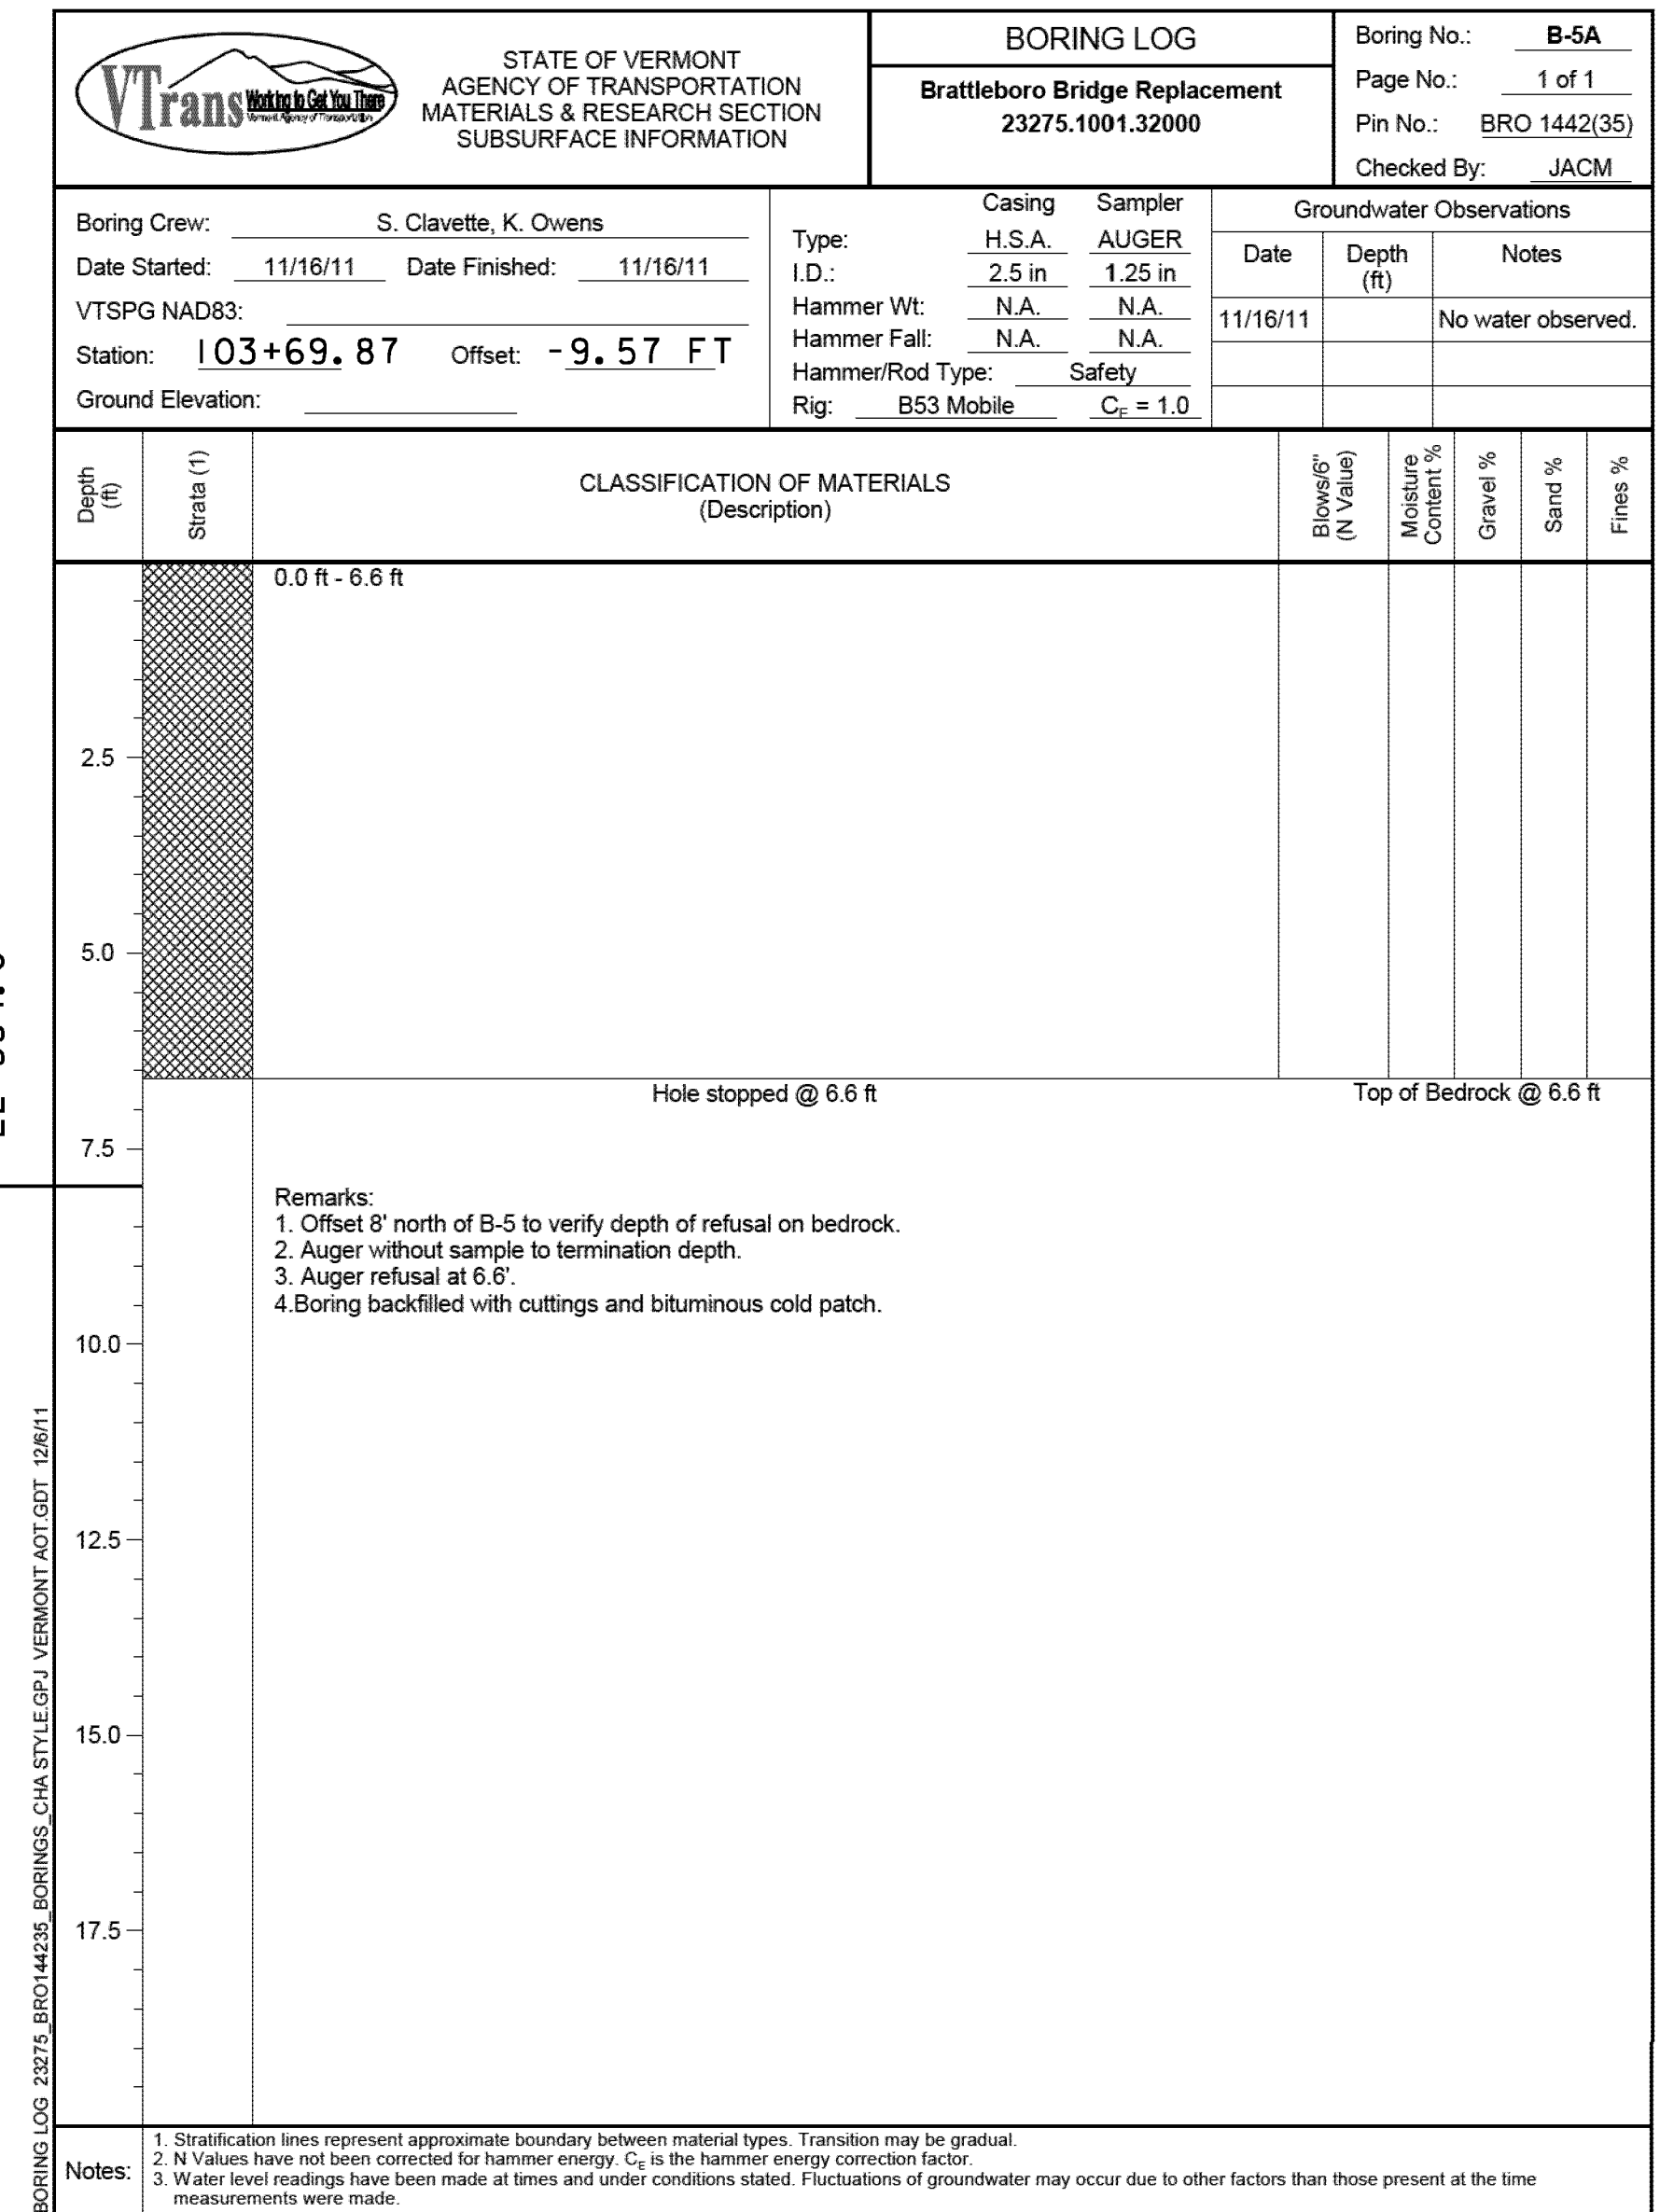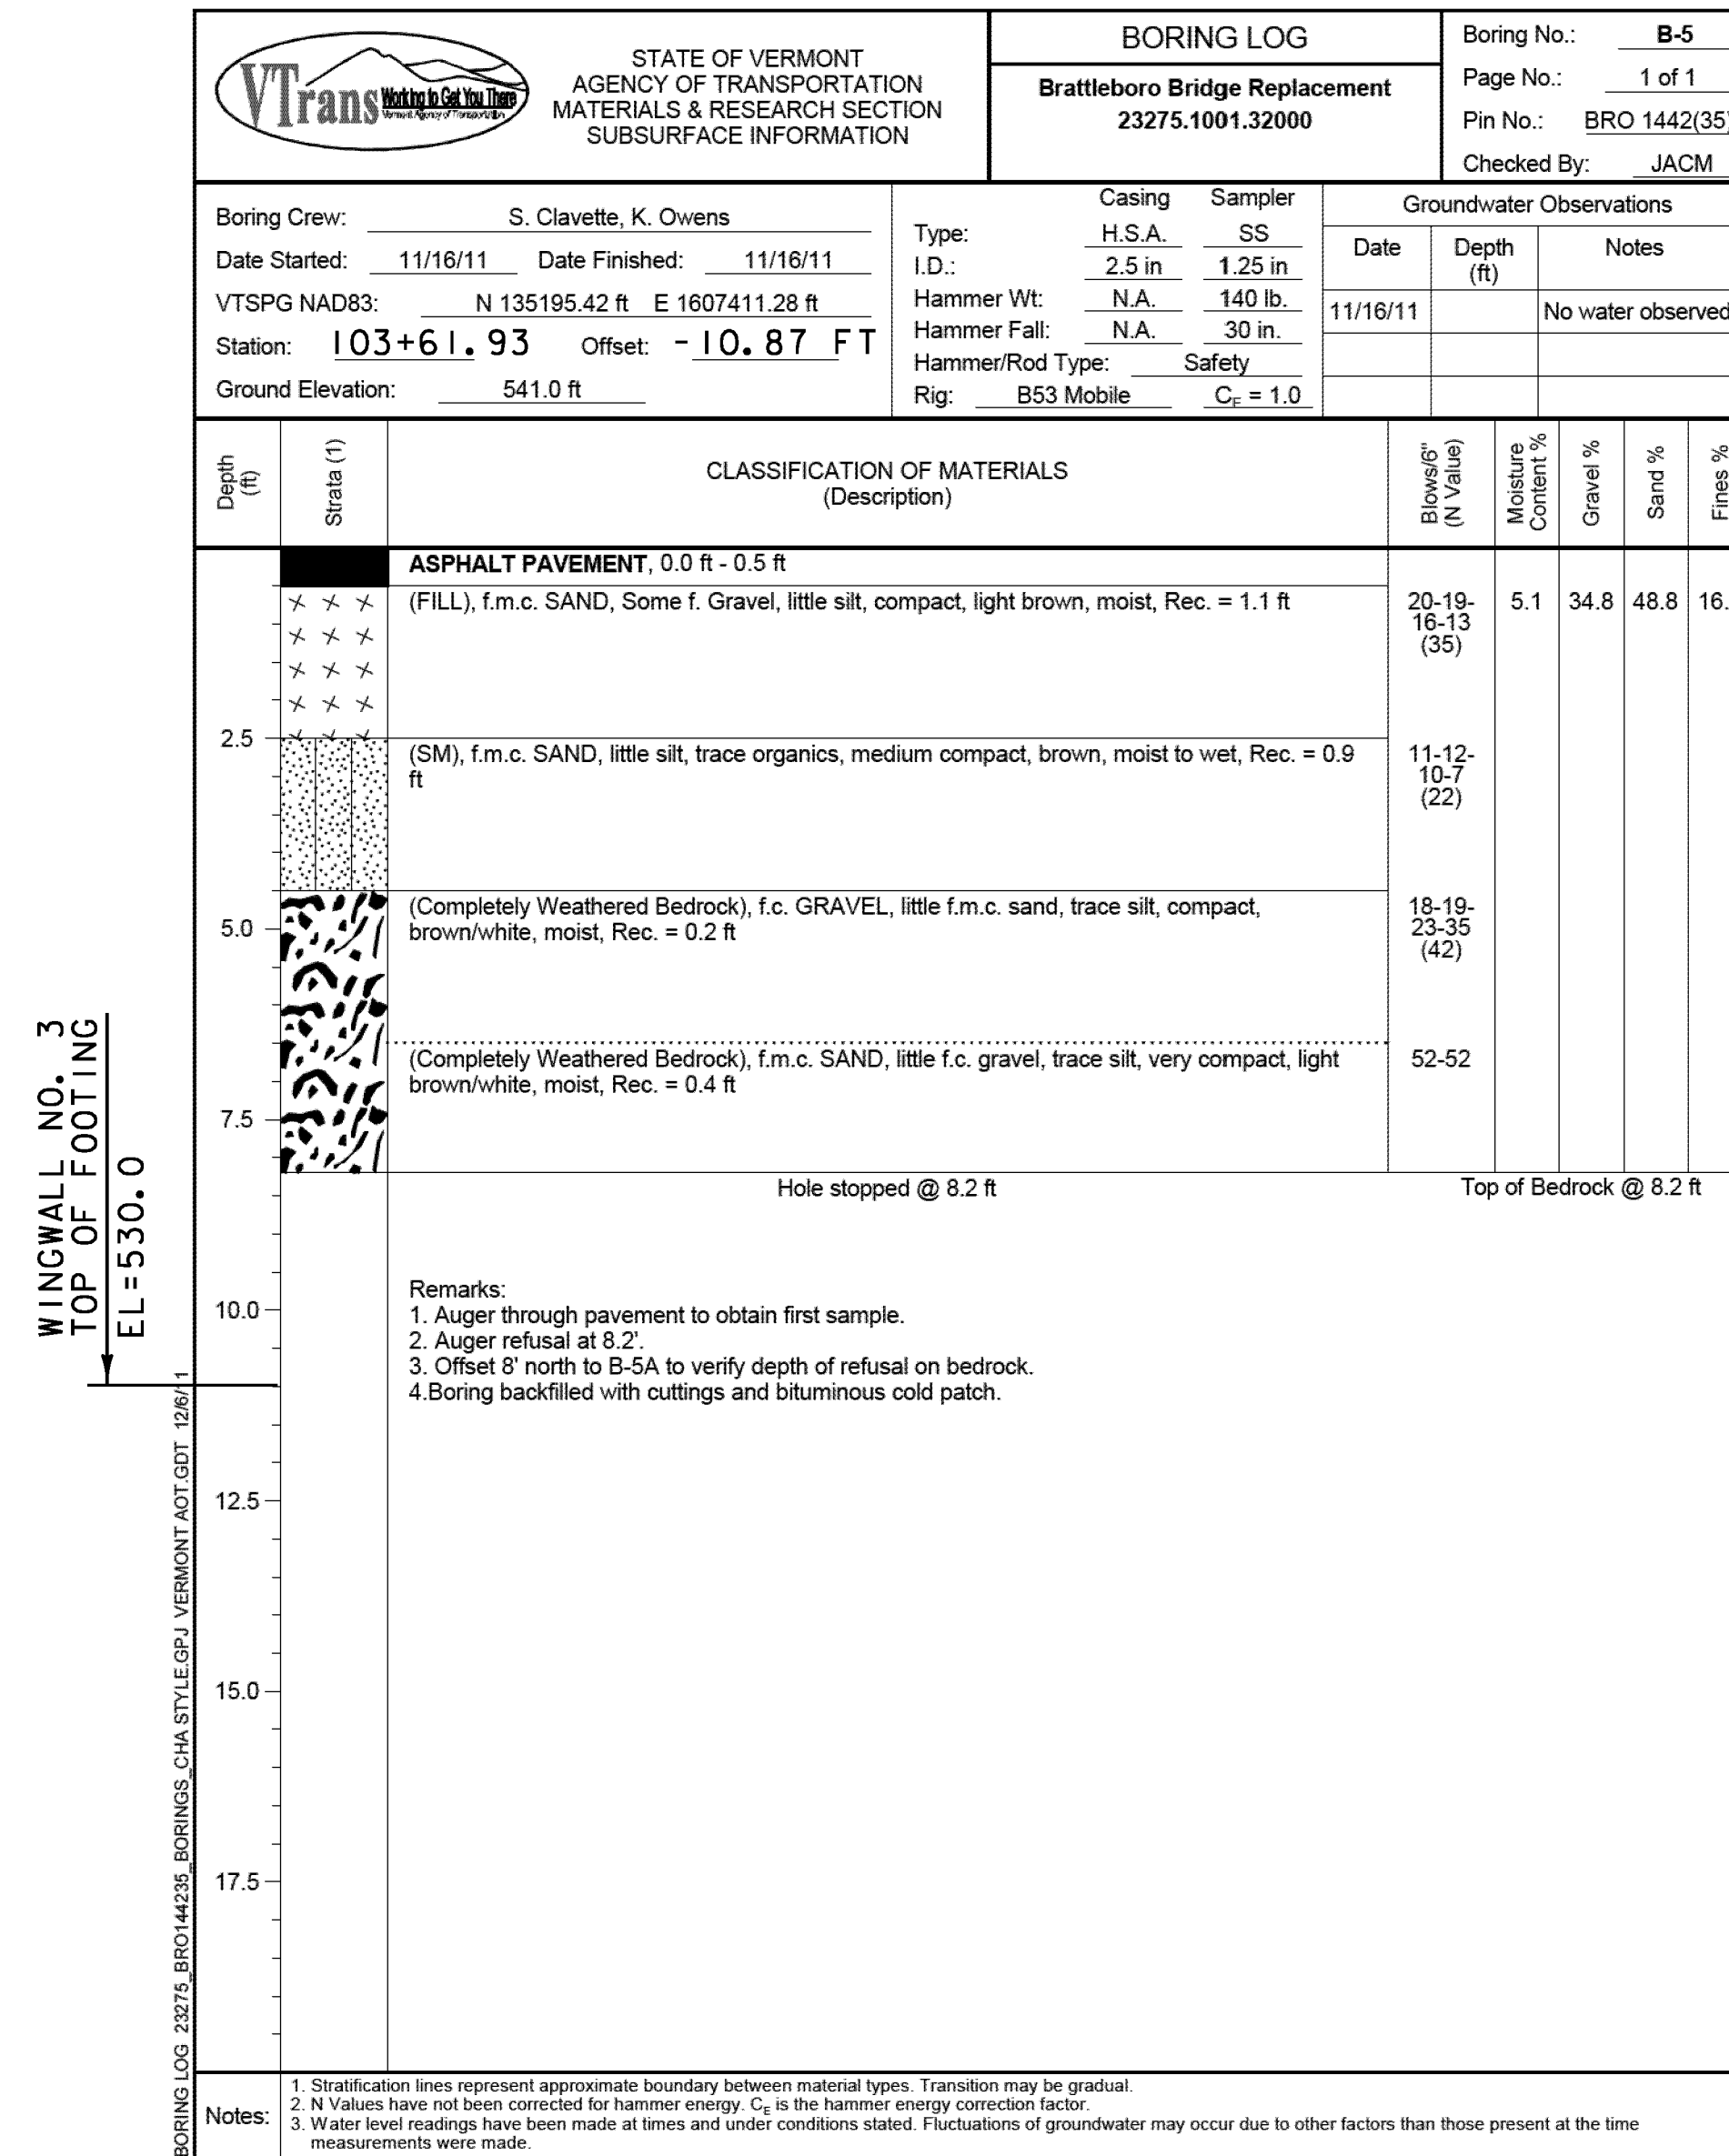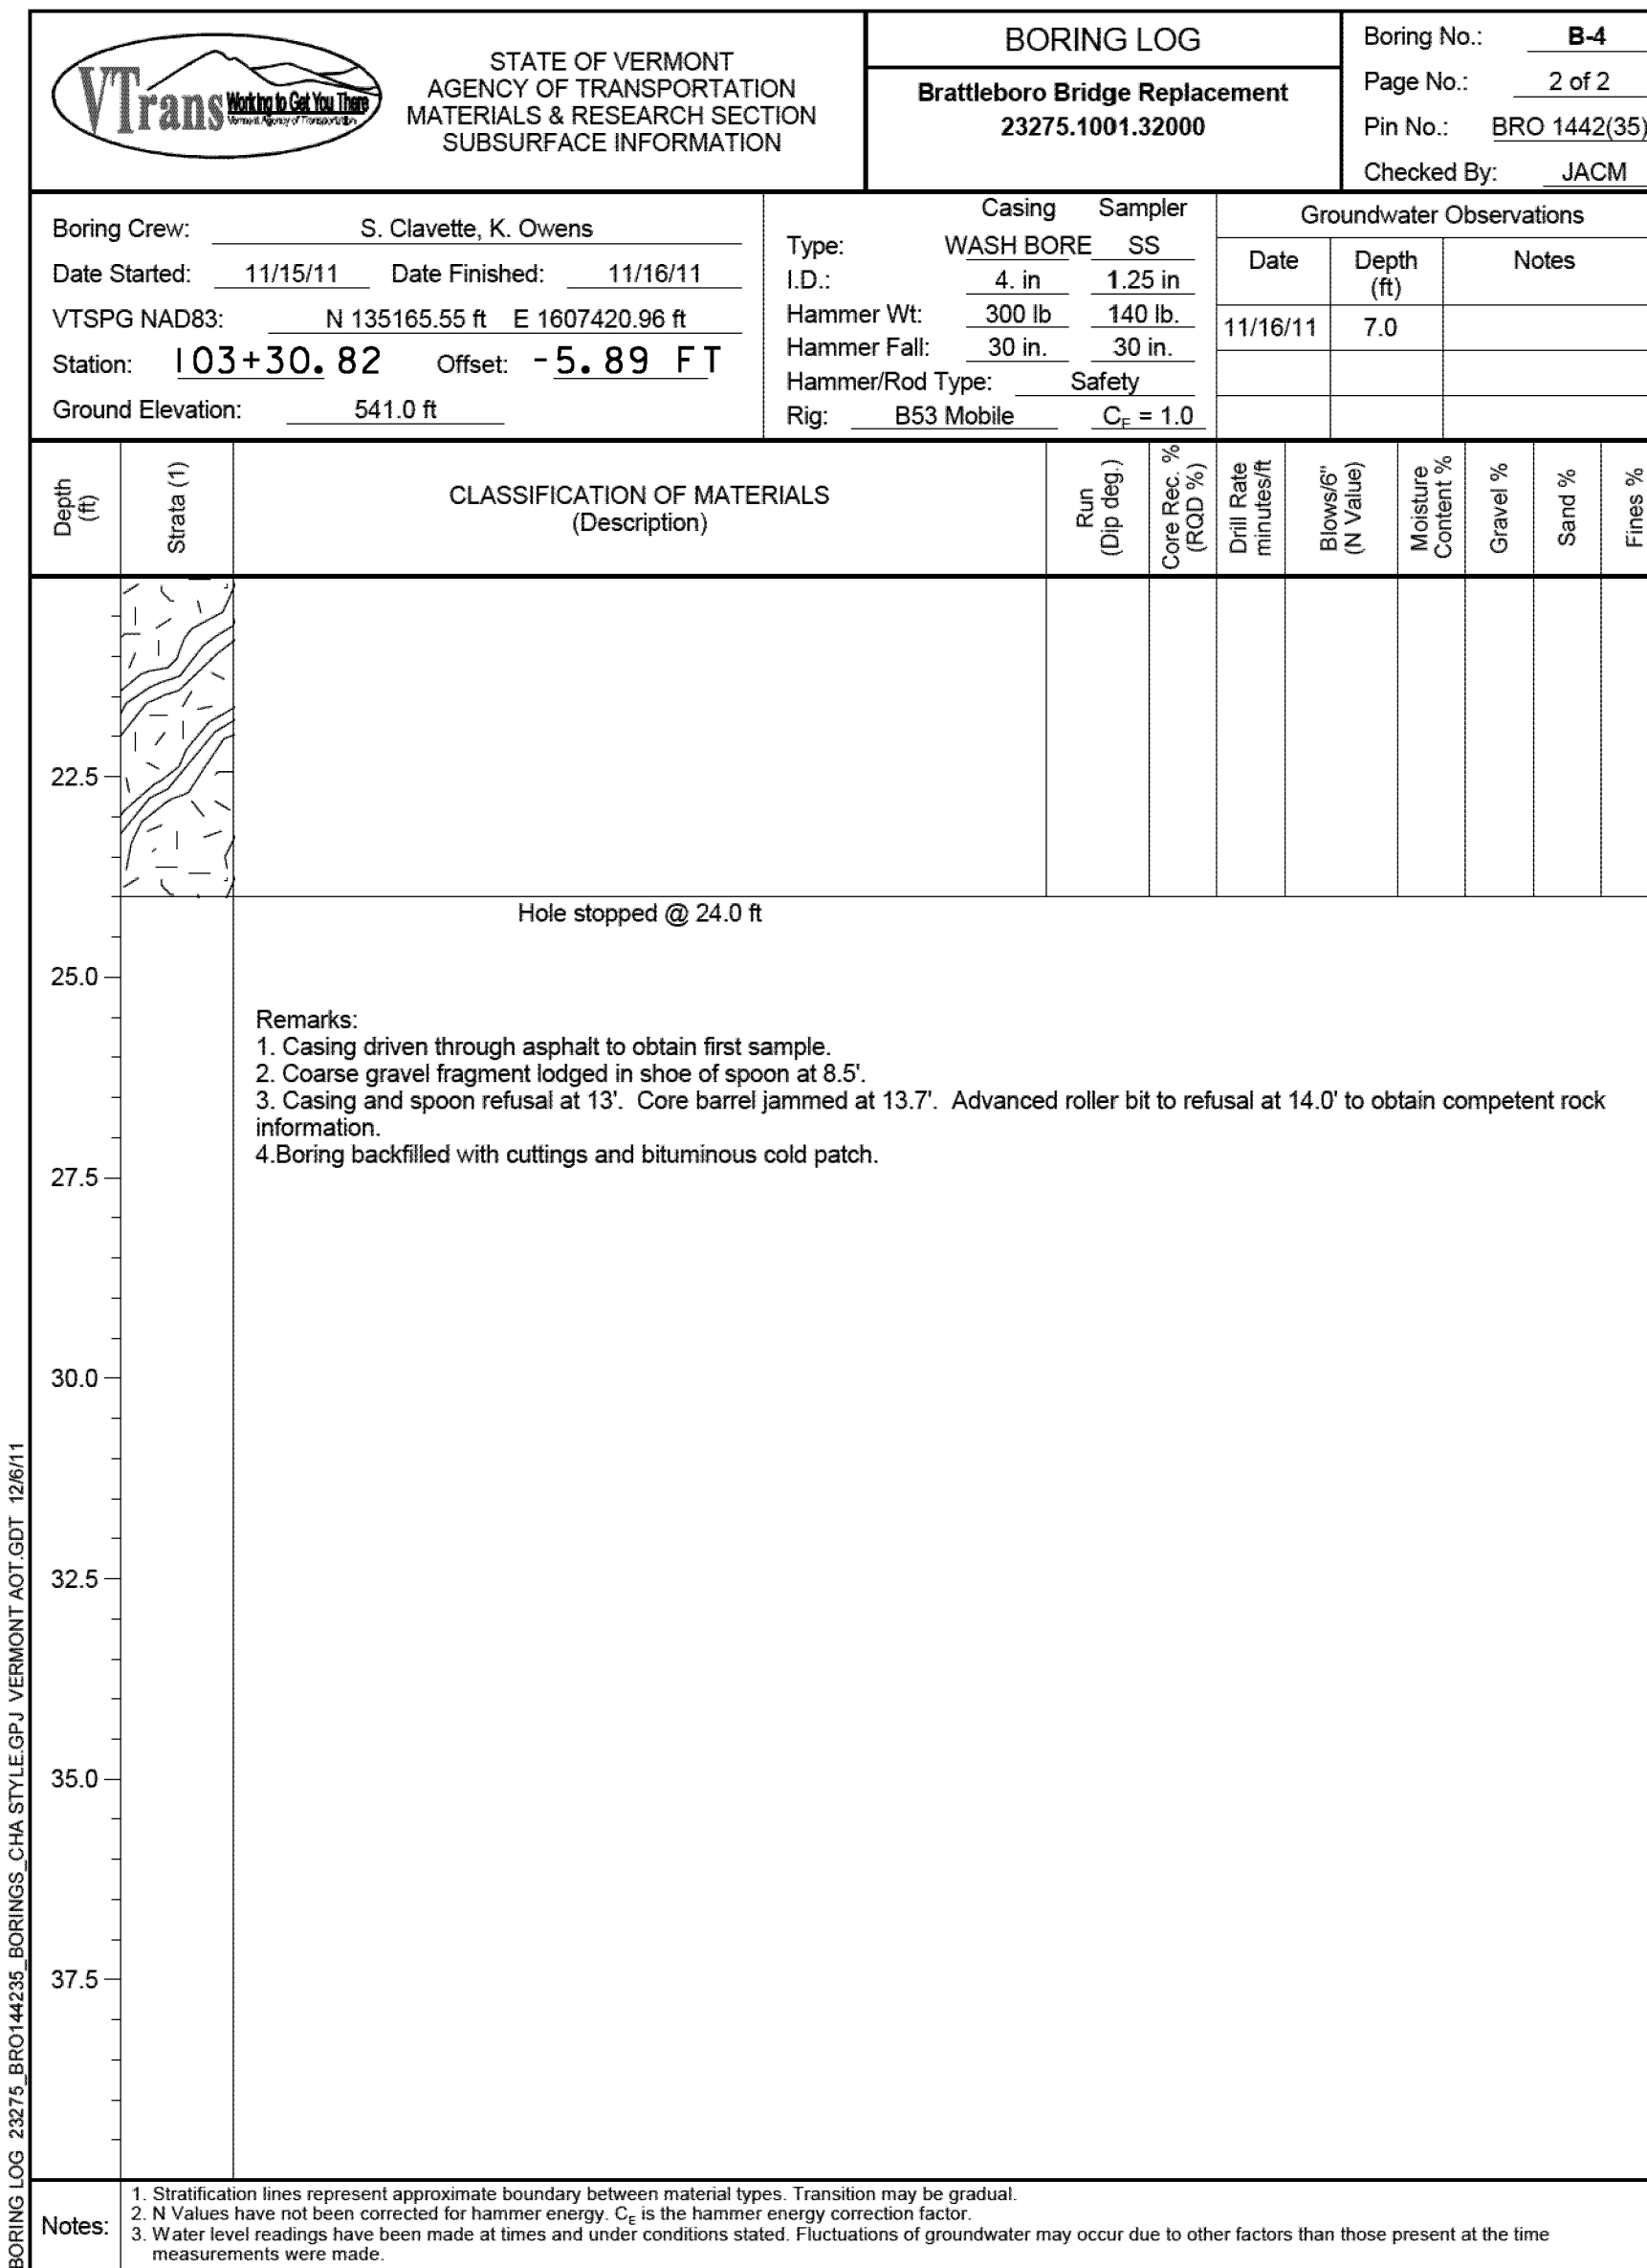


PROJECT NAME: BRATTLEBORO  
 PROJECT NUMBER: BRO 1442(35)  
 FILE NAME: z10J062borlogs.dgn  
 PROJECT LEADER: S.E. BURBANK  
 DESIGNED BY: VTRANS  
 BORING LOGS (3 OF 3)

PLOT DATE: 10/14/2013  
 DRAWN BY: E.A. FIALA  
 CHECKED BY: S.E. BURBANK  
 SHEET 28 OF 68





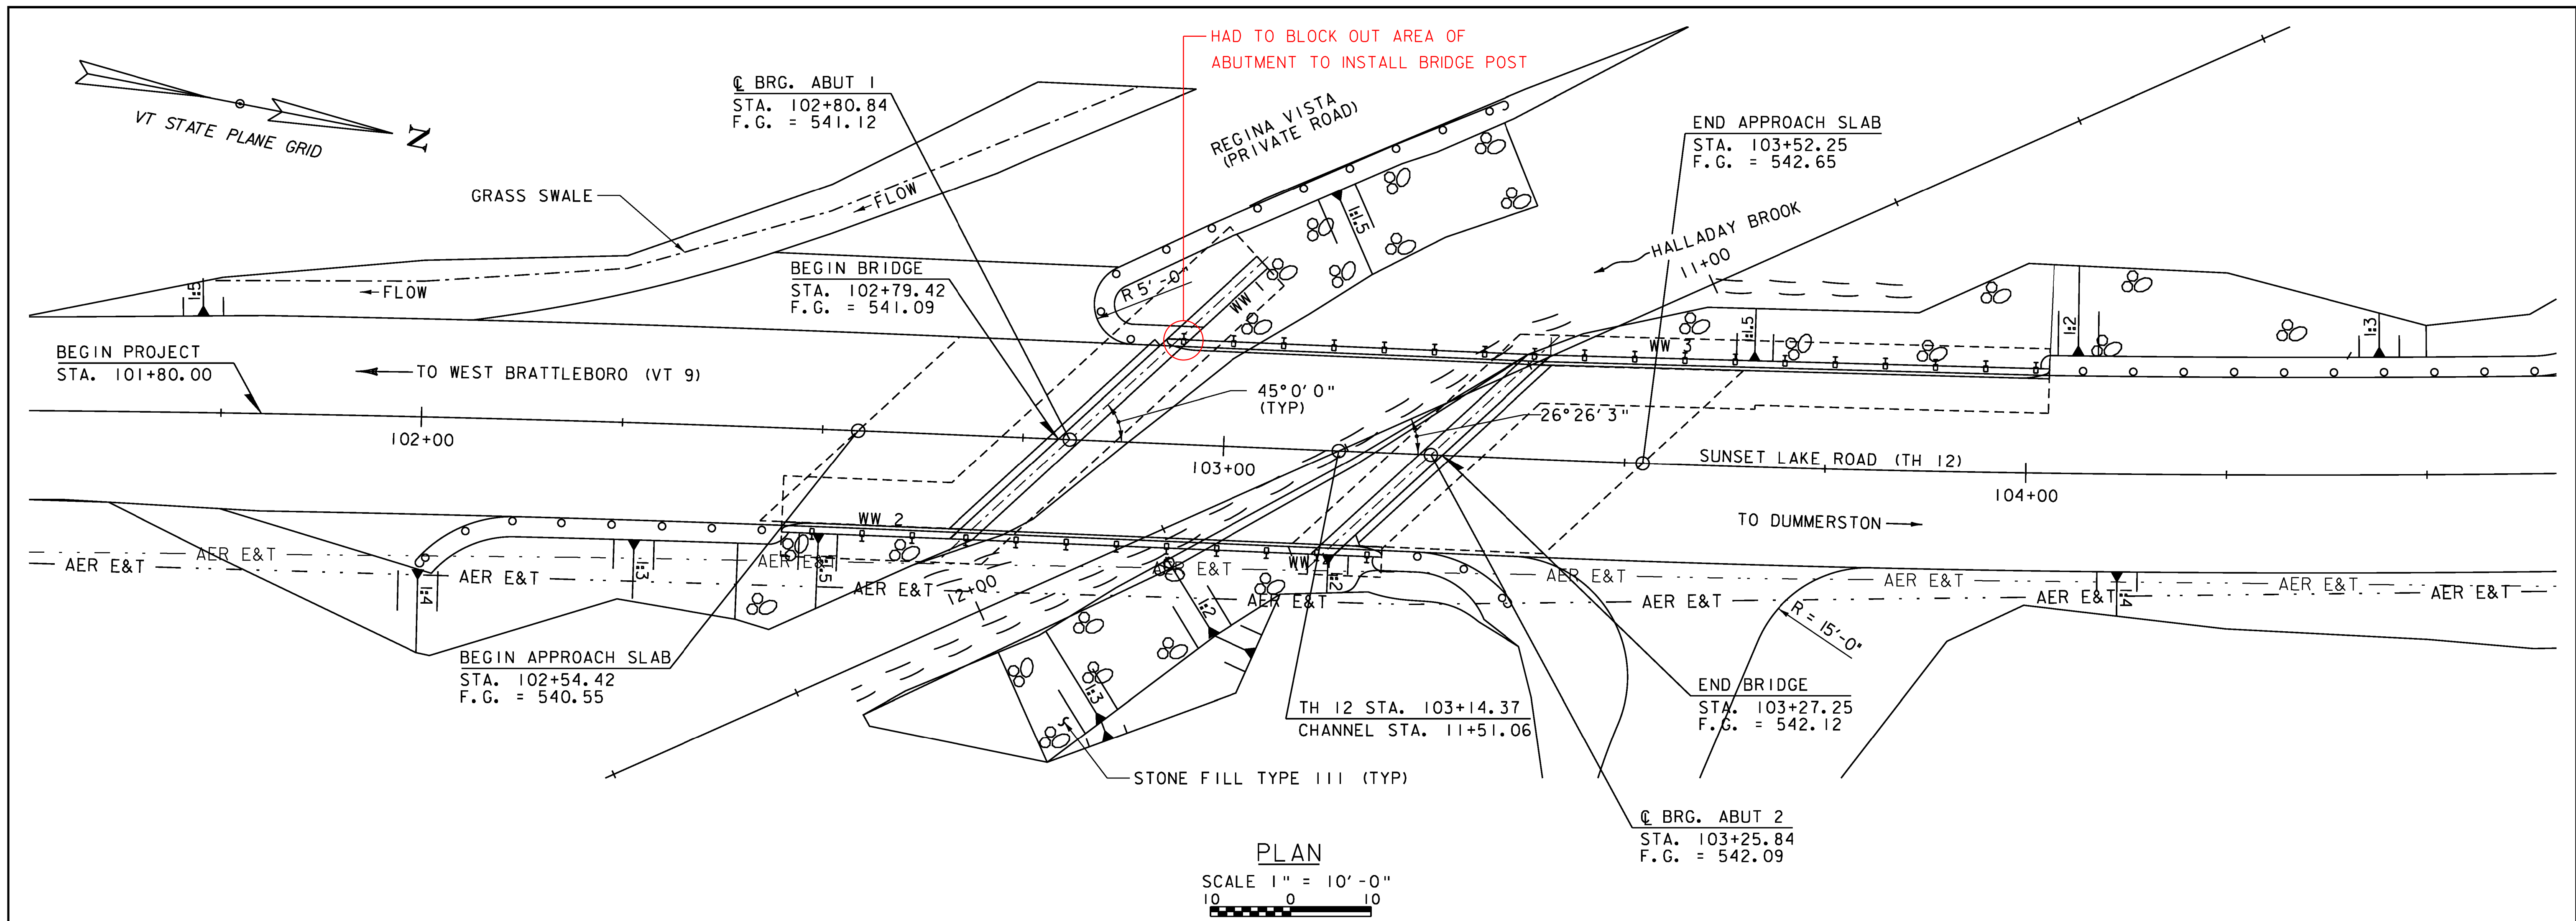

HAD TO BLOCK OUT AREA OF ABUTMENT TO INSTALL BRIDGE POST

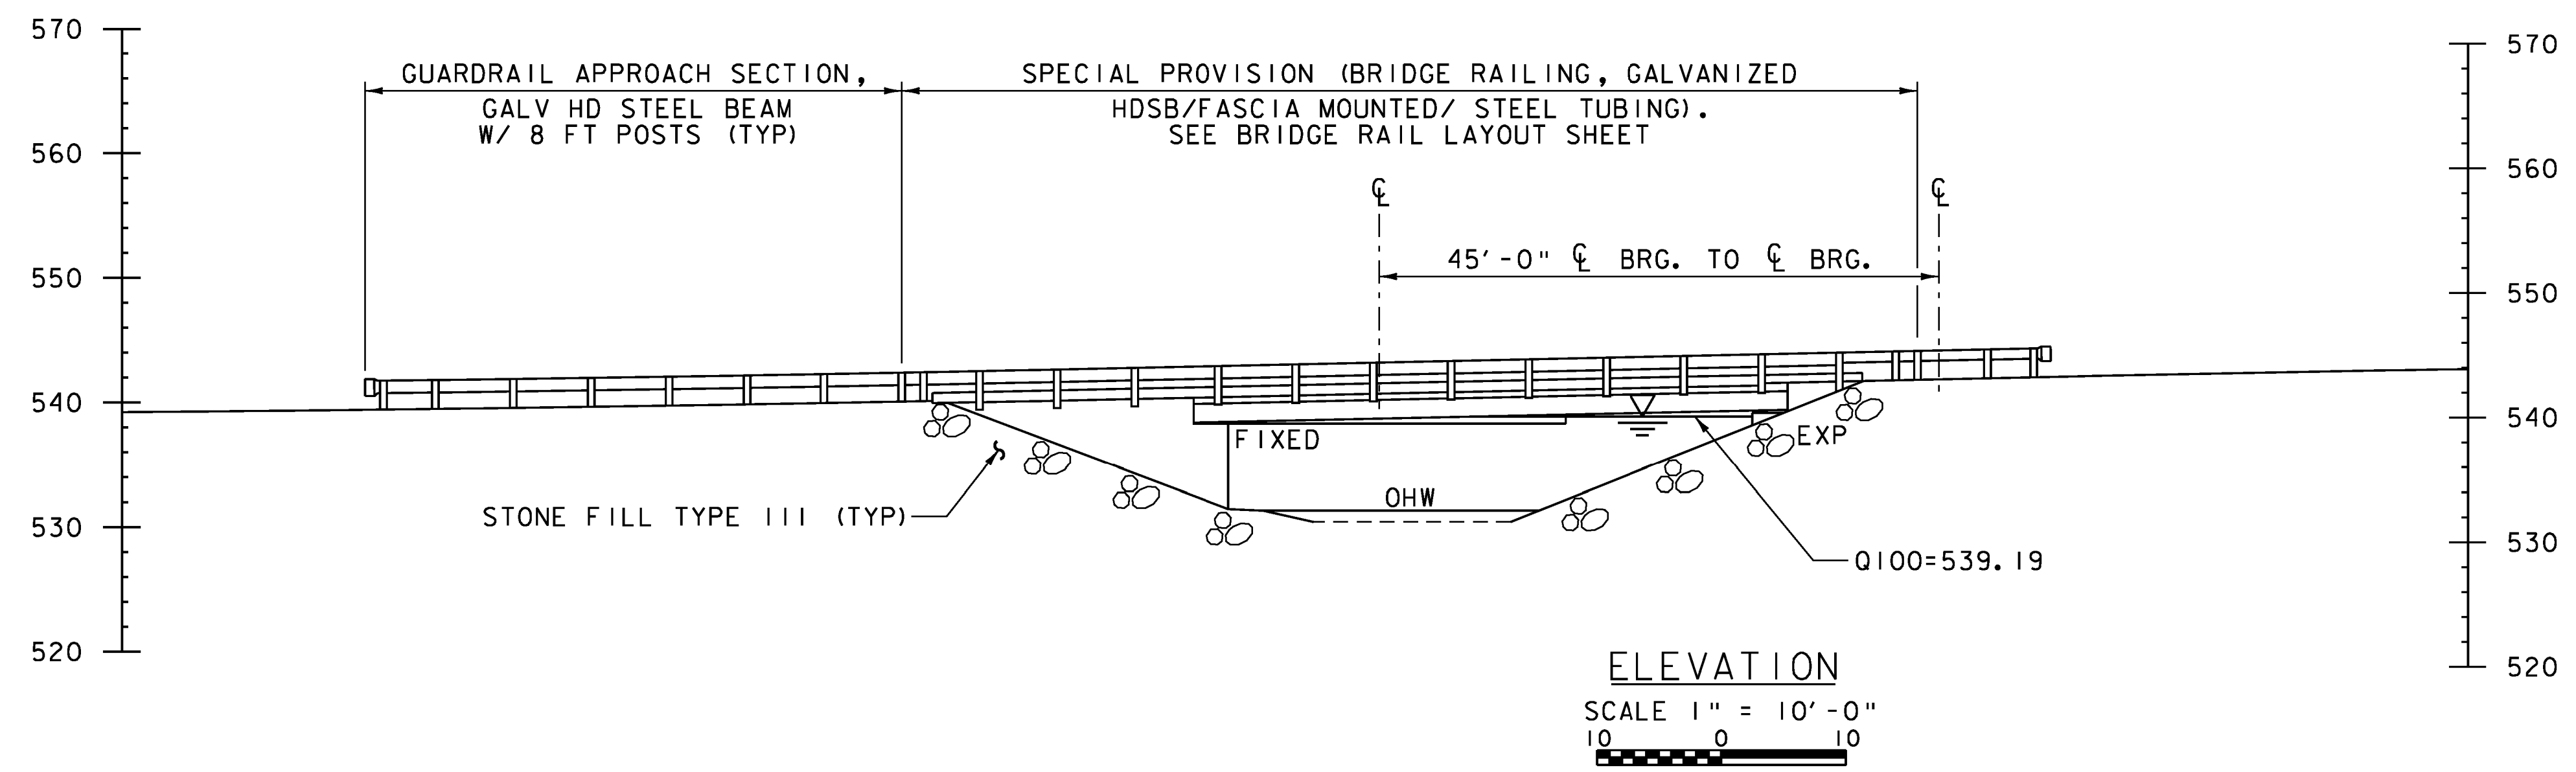

PROJECT NAME:	BRATTLEBORO	PLOT DATE:	10/14/2013
PROJECT NUMBER:	BRO 1442(35)	DRAWN BY:	E.A. FIALA
FILE NAME:	z10j062pe.dgn	CHECKED BY:	S.E. BURBANK
PROJECT LEADER:	S.E. BURBANK	DESIGNED BY:	E.A. FIALA
DESIGNED BY:	E.A. FIALA	PLAN AND ELEVATION	SHEET 29 OF 68

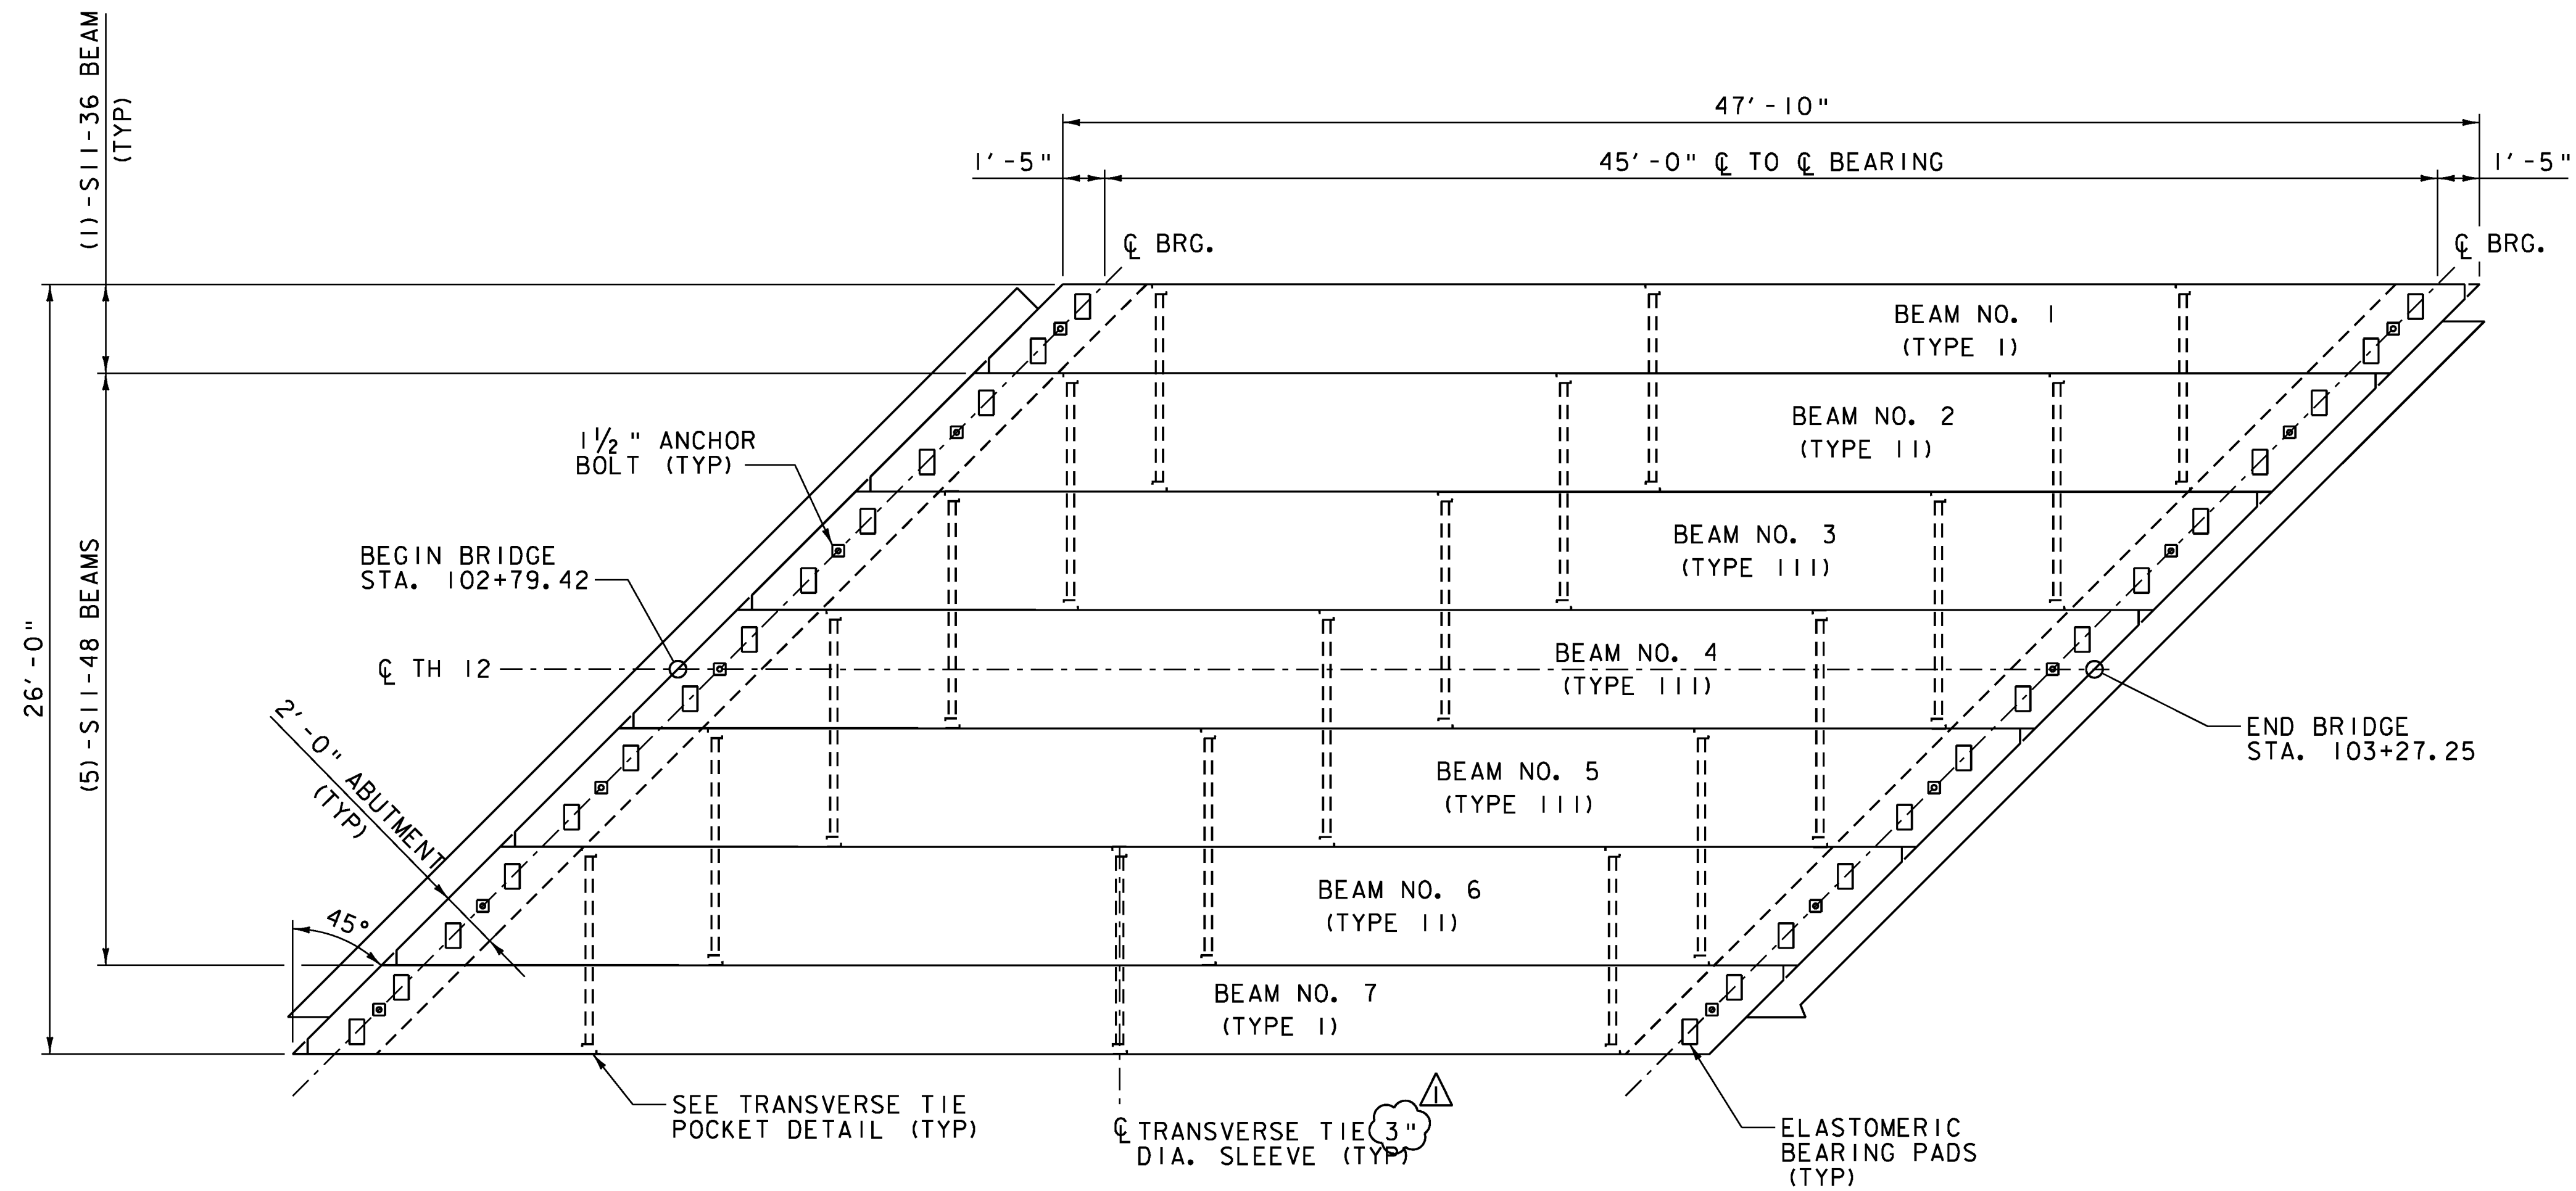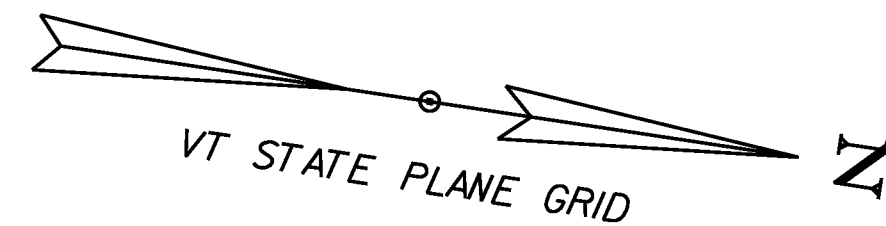


FRAMING PLAN FOR NON-VOIDED SLABS

SCALE 1/4" = 1'-0"


REV.	DESCRIPTION	DATE
△	DIA. POST TENSIONING SLEEVE	11/20/2013
PROJECT NAME: BRATTLEBORO		
PROJECT NUMBER: BRO 1442(35)		
FILE NAME: z10j062sup.dgn		PLOT DATE: 11/20/2013
PROJECT LEADER: S.E. BURBANK		DRAWN BY: J.L. LEMIEUX
DESIGNED BY: E.A. FIALA		CHECKED BY: S.E. BURBANK
FRAMING PLAN		SHEET 30 OF 68



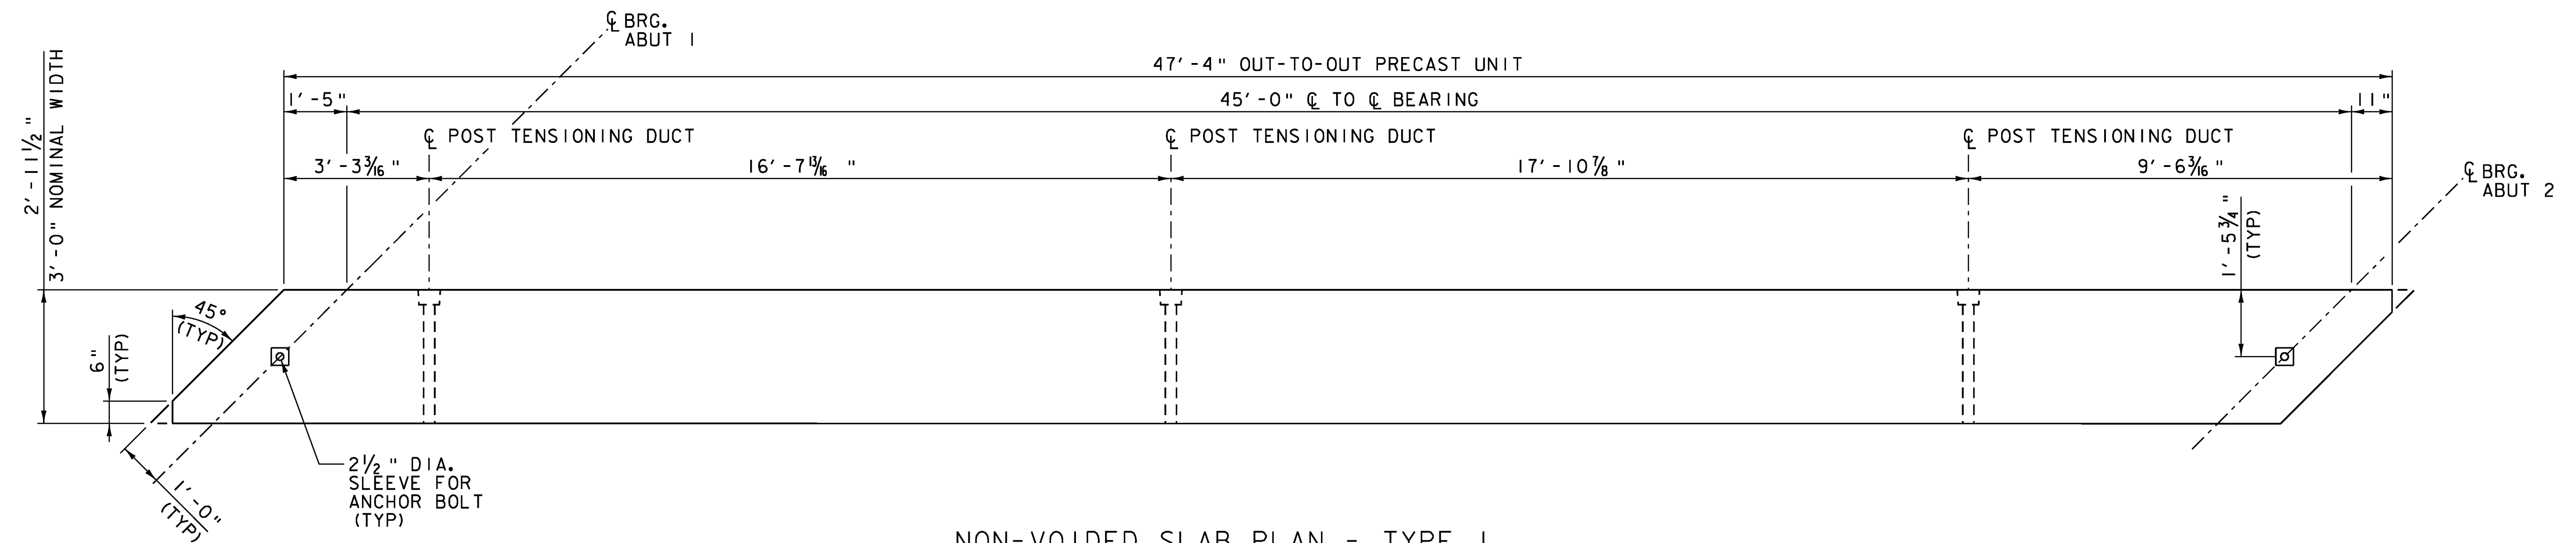


NON-VOIDED SLAB PLAN - TYPE I  
 BEAM NO. 1 (BEAM NO. 7 SAME BY 180° ROTATION)  
 SCALE 1/2" = 1'-0"

DRIP NOTCH  
 SEE SD-502.00 FOR  
 DETAILS AND LOCATIONS

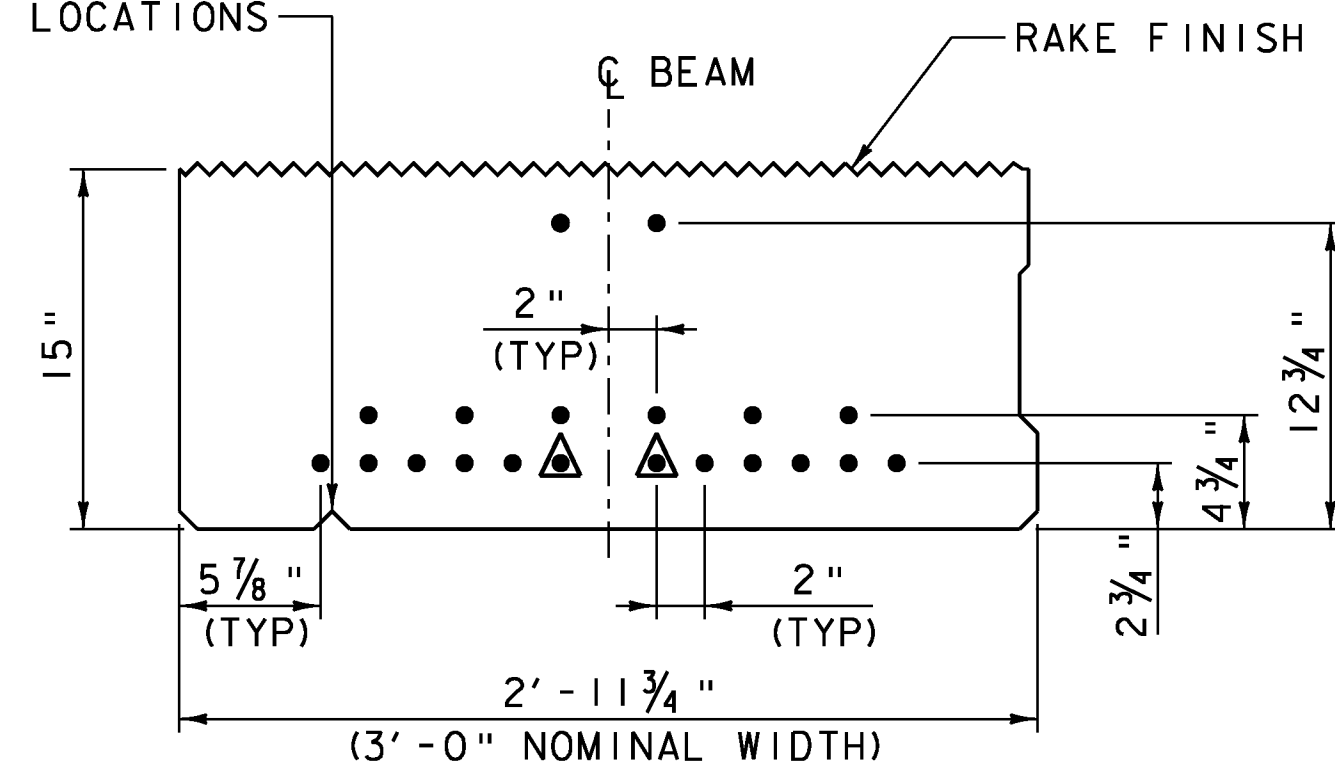


PRESTRESSED S11-36 BEAM  
 TYPICAL SECTION - STRAND LAYOUT  
 SCALE 1/2" = 1'-0"

▲ - (2) SHIELDED AT ENDS FOR 4'-0"

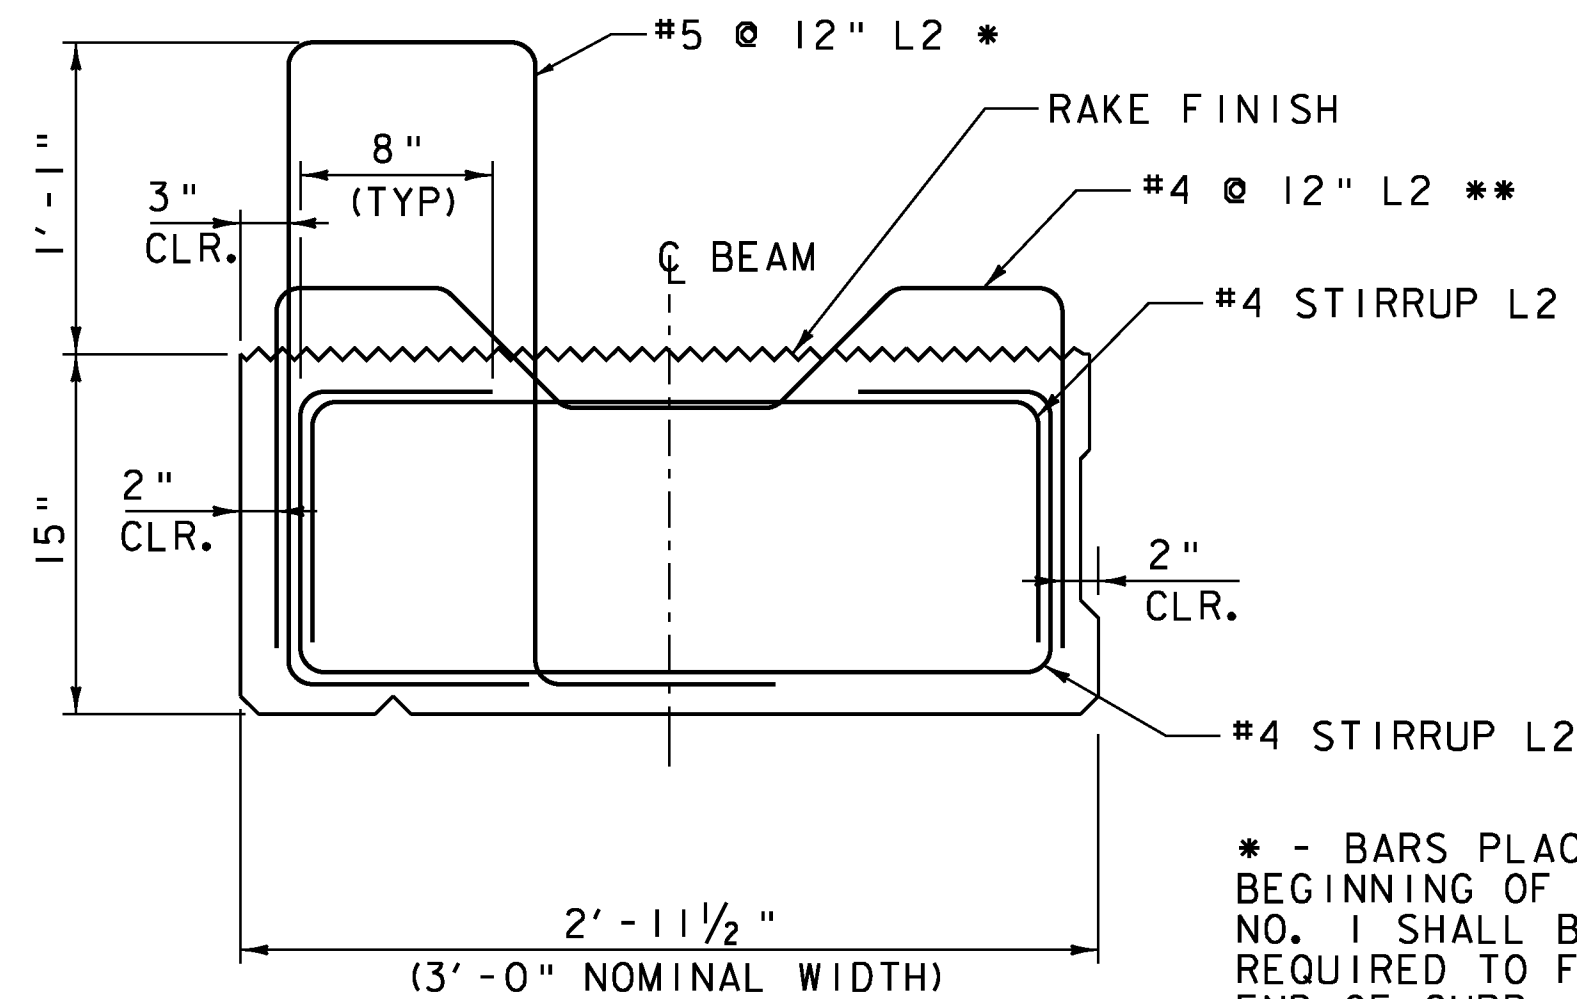


PRESTRESSED S11-36 BEAM  
 TYPICAL SECTION - REINFORCING  
 SCALE 1/2" = 1'-0"


* - BARS PLACED AT  
 BEGINNING OF CURB ON BEAM  
 NO. 1 SHALL BE TURNED AS  
 REQUIRED TO FIT FLARED  
 END OF CURB

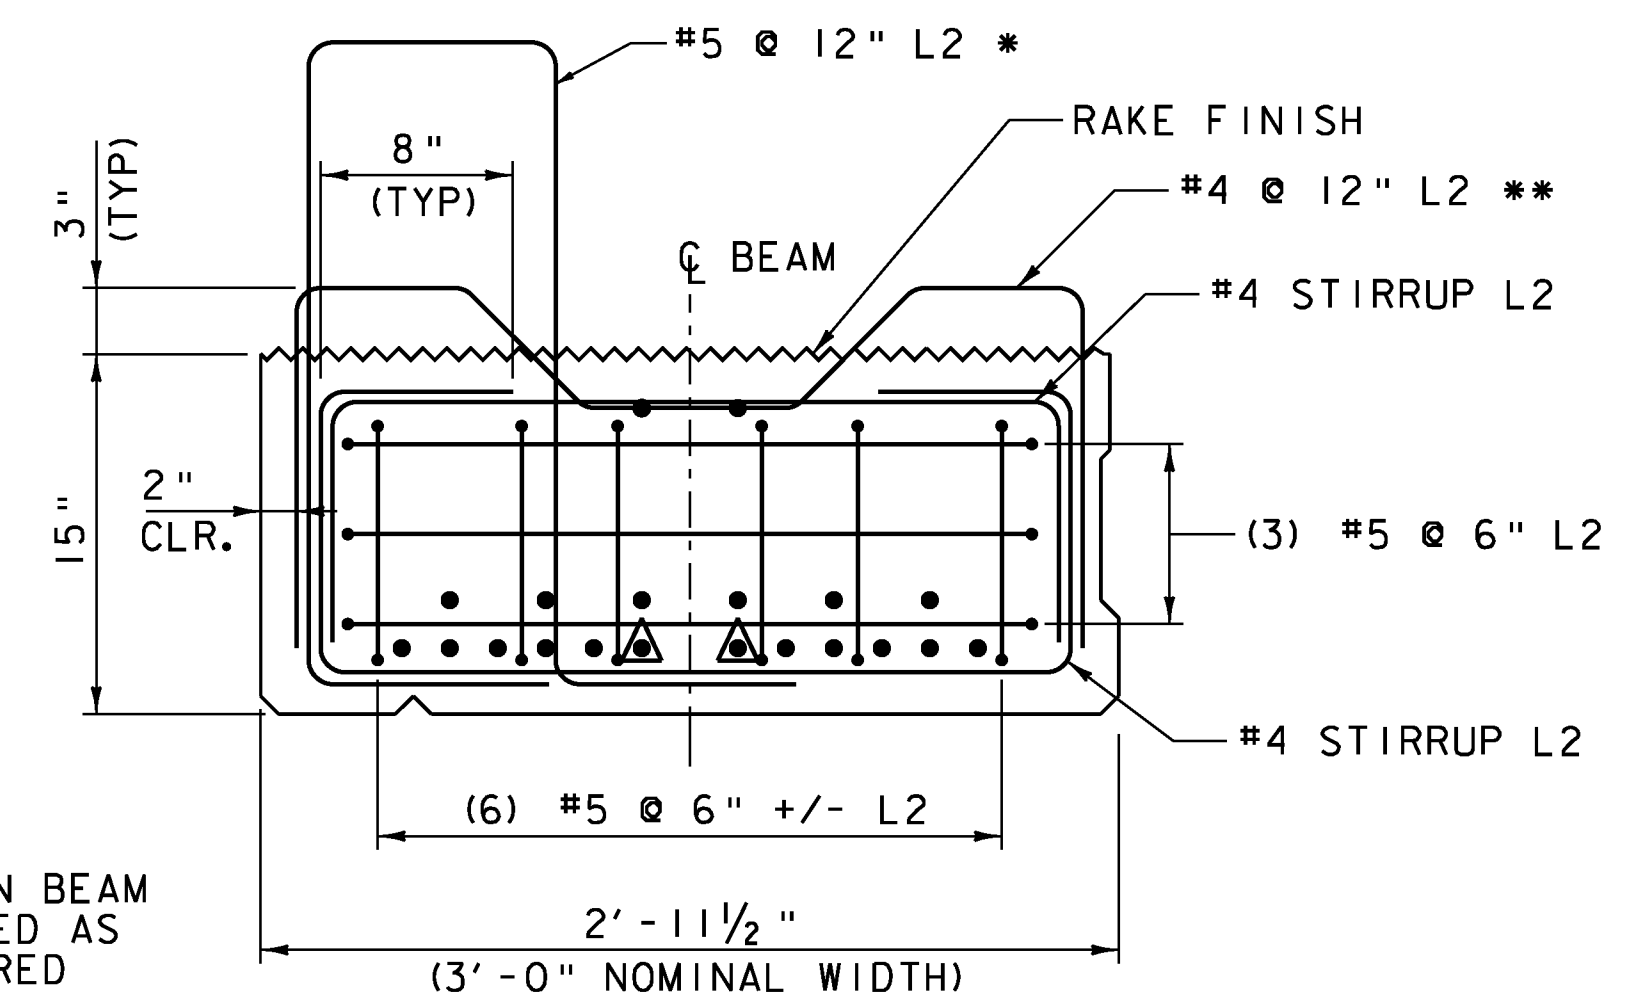

PRESTRESSED S11-36 BEAM  
 TYPICAL SECTION - END REINFORCEMENT  
 SCALE 1/2" = 1'-0"

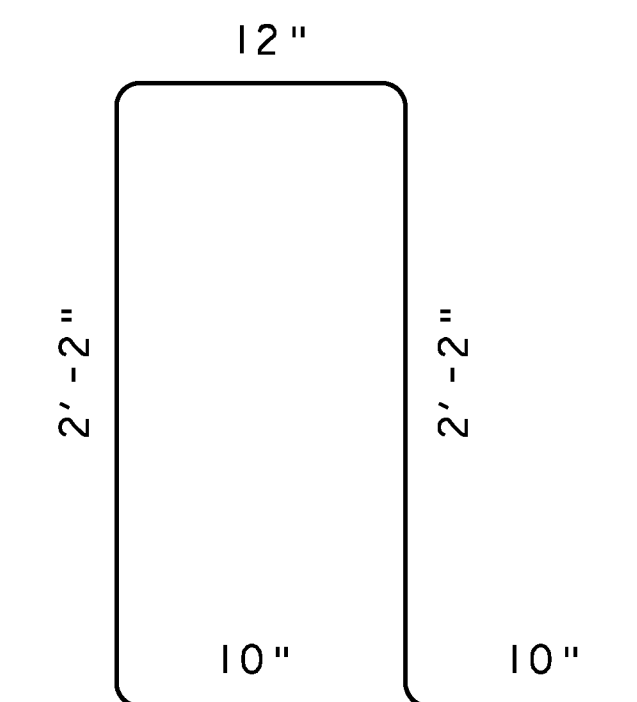

CURB BAR  
 SCALE 1/2" = 1'-0"

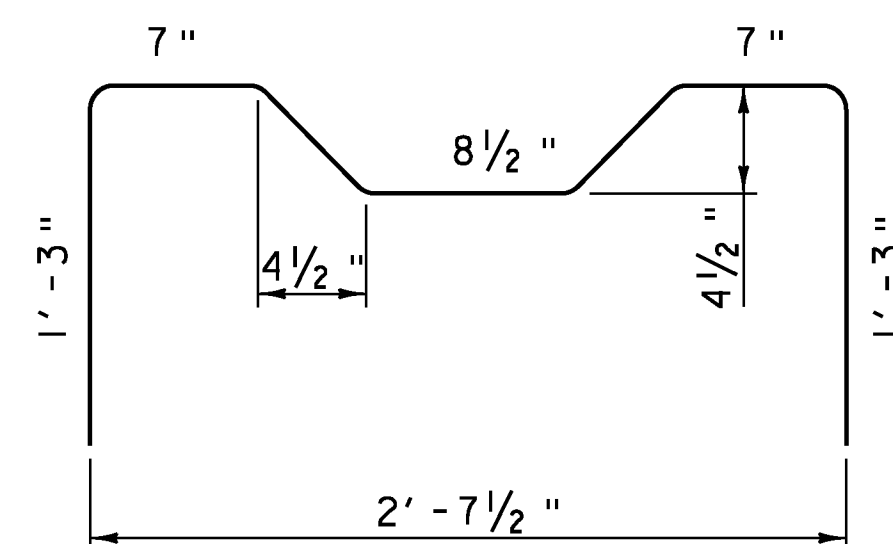

"M" BAR **  
 SCALE 1/2" = 1'-0"


** - FIRST "M" - BAR SHALL BE PARALLEL WITH END OF S11-36 BEAM,  
 2ND SHALL BE FLARED AND THIRD SHALL BE PERPENDICULAR WITH  
 THE SIDES OF THE S11-36 BEAM. FIRST "M" - BAR SHALL BE LOCATED  
 SO AS TO BE 3" CLEAR FROM THE ASPHALTIC PLUG JOINT. CONTRACTOR  
 SHALL COORDINATE BETWEEN ASPHALTIC PLUG MANUFACTURER, INSTALLER  
 AND NON-VOIDED SLAB FABRICATOR TO LOCATE "M" - BAR PROPERLY.

NOTES:


1. REINFORCING STEEL SHALL MEET THE REQUIREMENTS OF SECTION 507, LEVEL 11.
2. SEE NEXT SHEET FOR END OF BEAM REINFORCING AND STIRRUP SPACING.

PROJECT NAME: BRATTLEBORO  
 PROJECT NUMBER: BRO 1442(35)

FILE NAME: z10j062sup01.dgn PLOT DATE: 10/14/2013  
 PROJECT LEADER: S.E. BURBANK DRAWN BY: E.A. FIALA  
 DESIGNED BY: B.M. KLINEFELTER CHECKED BY: S.E. BURBANK  
 NON-VOIDED SLAB DETAILS TYPE I (1 OF 2) SHEET 31 OF 68

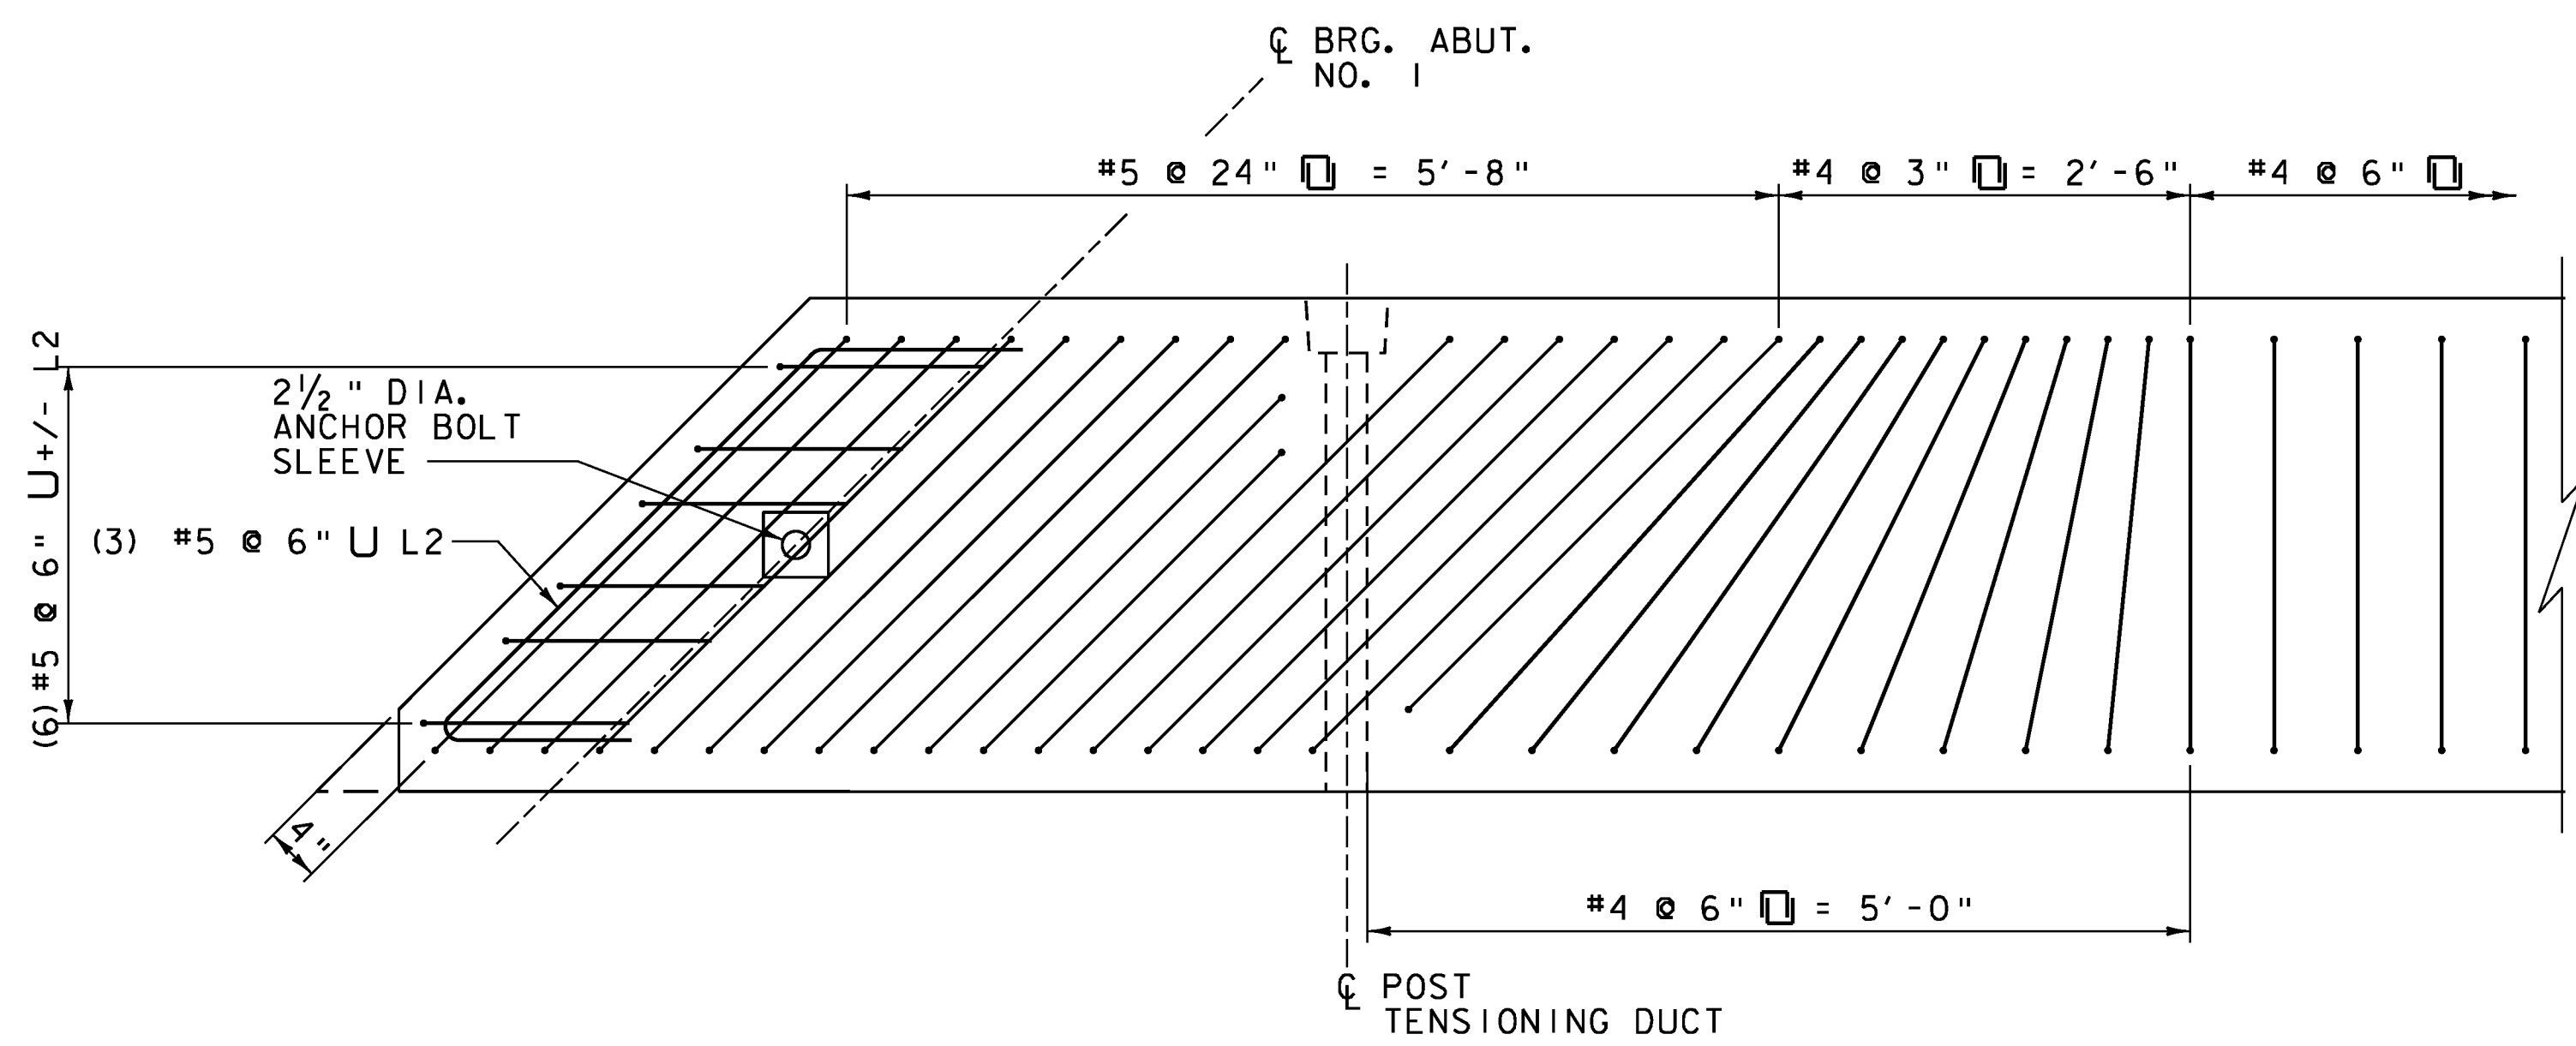

SOUTH END OF BEAM NO. 1 - REINFORCING  
 PLAN TYPE I NON-VOIDED SLAB  
 (NORTH END OF BEAM NO. 7 SAME BY 180° ROTATION)  
 SCALE 1" = 1'-0"

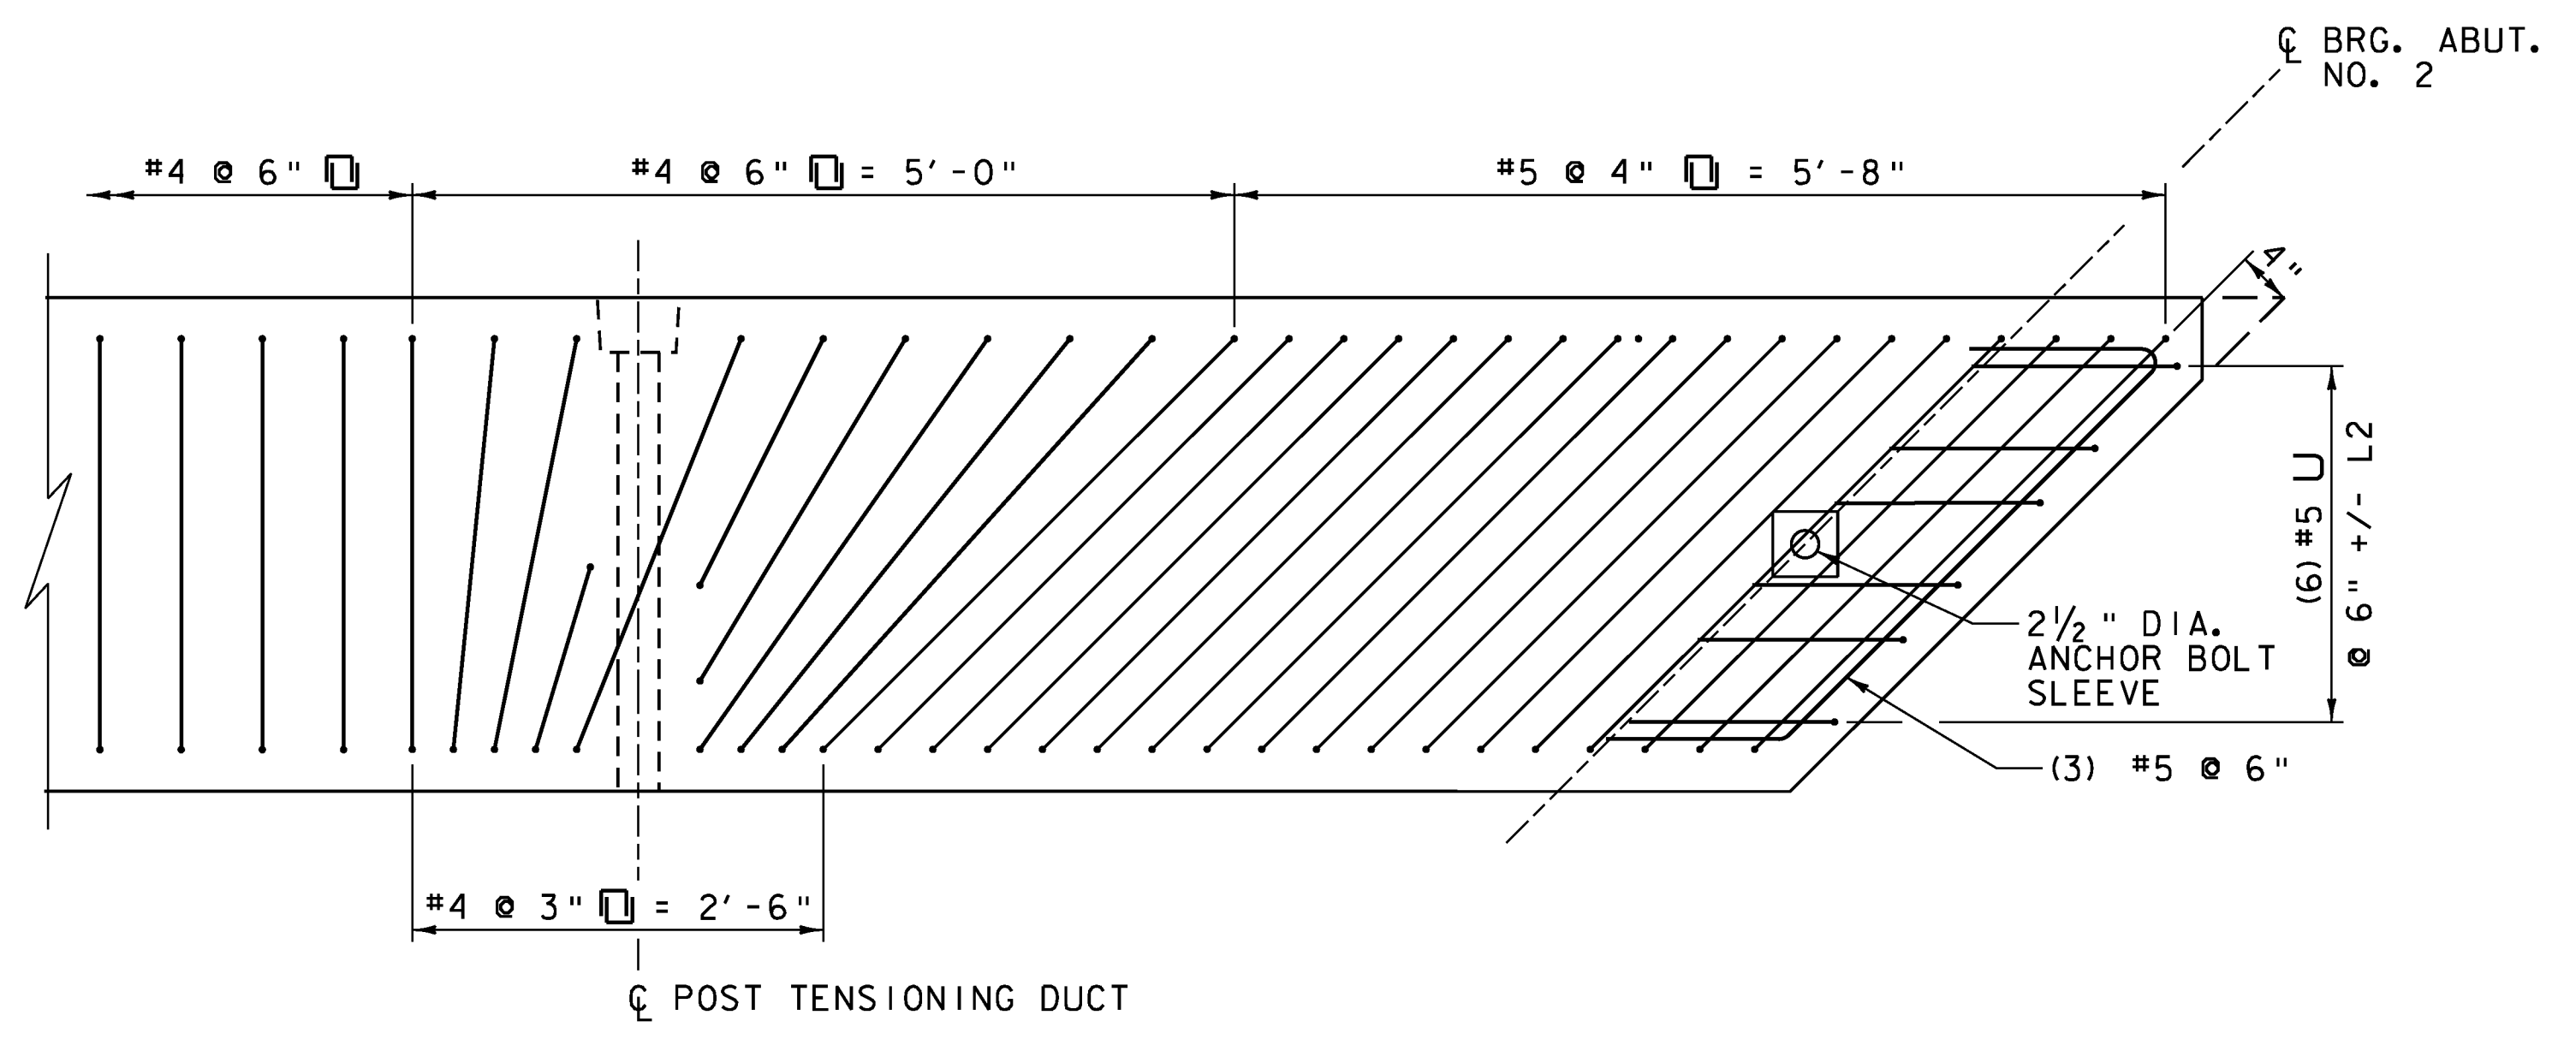


NORTH END OF BEAM NO. 1 - REINFORCING  
 PLAN TYPE I NON-VOIDED SLAB  
 (SOUTH END OF BEAM NO. 7 SAME BY 180° ROTATION)  
 SCALE 1" = 1'-0"


- NOTES:
- REINFORCING STEEL SHALL MEET WITH THE REQUIREMENTS OF SECTION 507, LEVEL 11.

PROJECT NAME: BRATTLEBORO	PROJECT NUMBER: BRO 1442(35)
FILE NAME: z10j062sup01.dgn	PLOT DATE: 10/14/2013
PROJECT LEADER: S.E. BURBANK	DRAWN BY: E.A. FIALA
DESIGNED BY: B.M. KLINEFELTER	CHECKED BY: S.E. BURBANK
NON-VOIDED SLAB DETAILS TYPE 1 (2 OF 2) SHEET 32 OF 68	



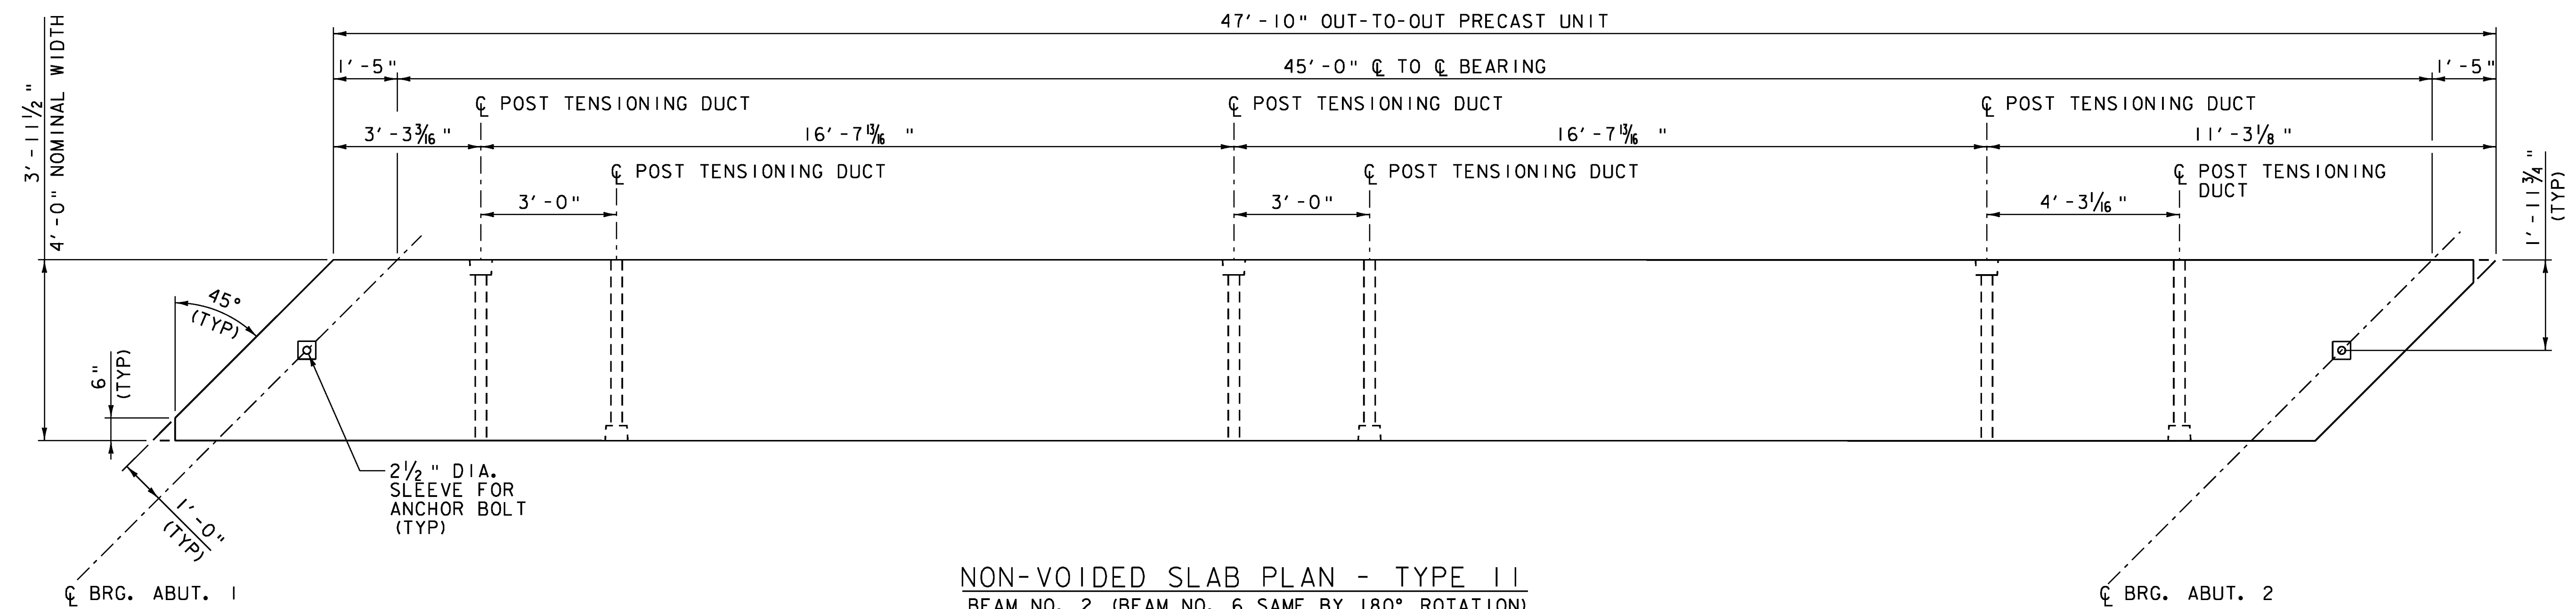


NON-VOIDED SLAB PLAN - TYPE II  
 BEAM NO. 2 (BEAM NO. 6 SAME BY 180° ROTATION)  
 SCALE 1/2" = 1'-0"

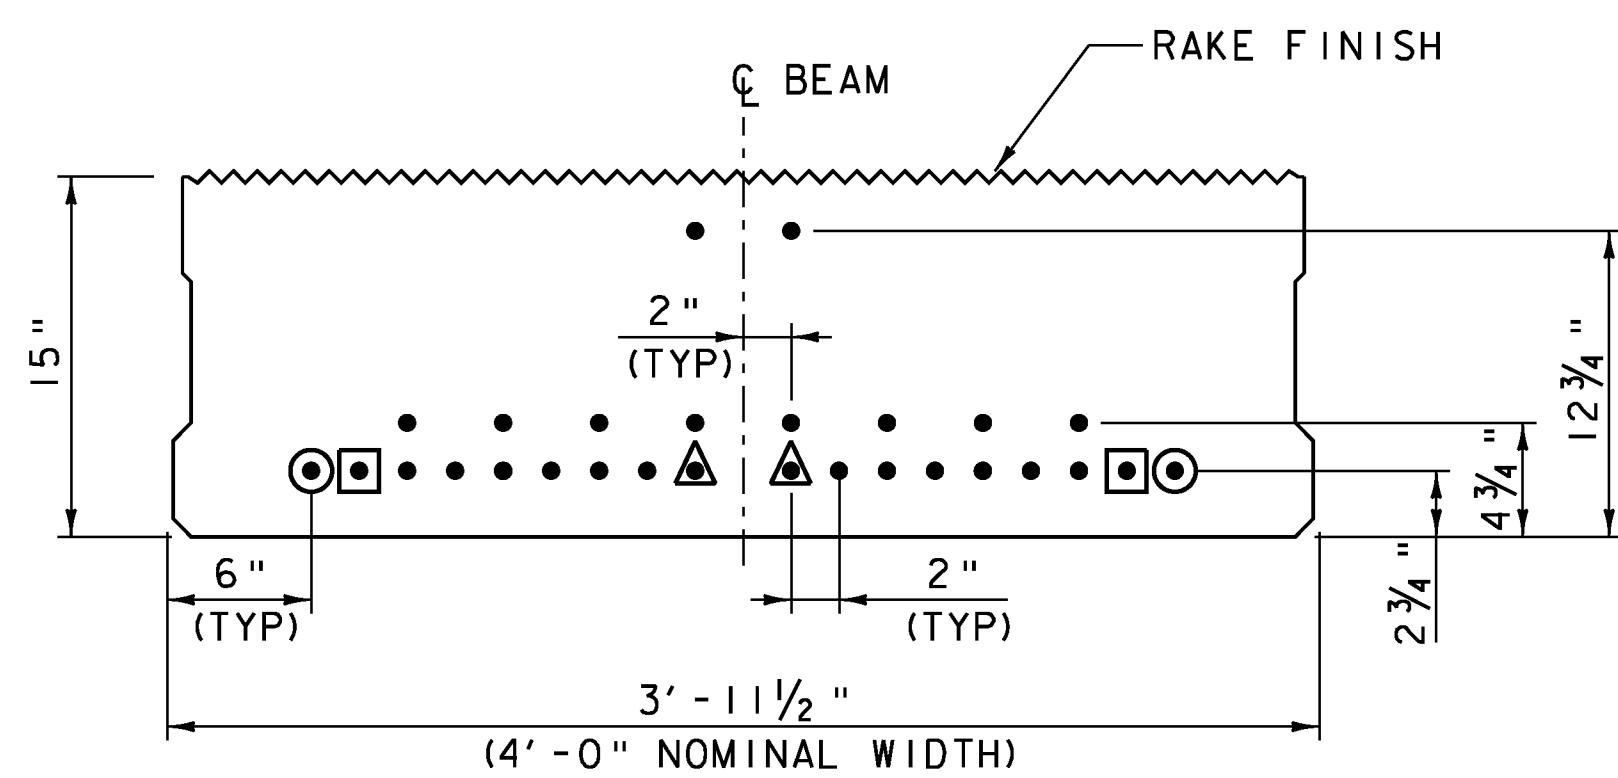


- ▲ - (2) SHIELDED AT ENDS FOR 10'-0"
- - (2) SHIELDED AT ENDS FOR 12'-0"
- - (2) SHIELDED AT ENDS FOR 14'-0"


PRESTRESSED S11-48 BEAM  
 TYPICAL SECTION - STRAND LAYOUT  
 SCALE 1/2" = 1'-0"

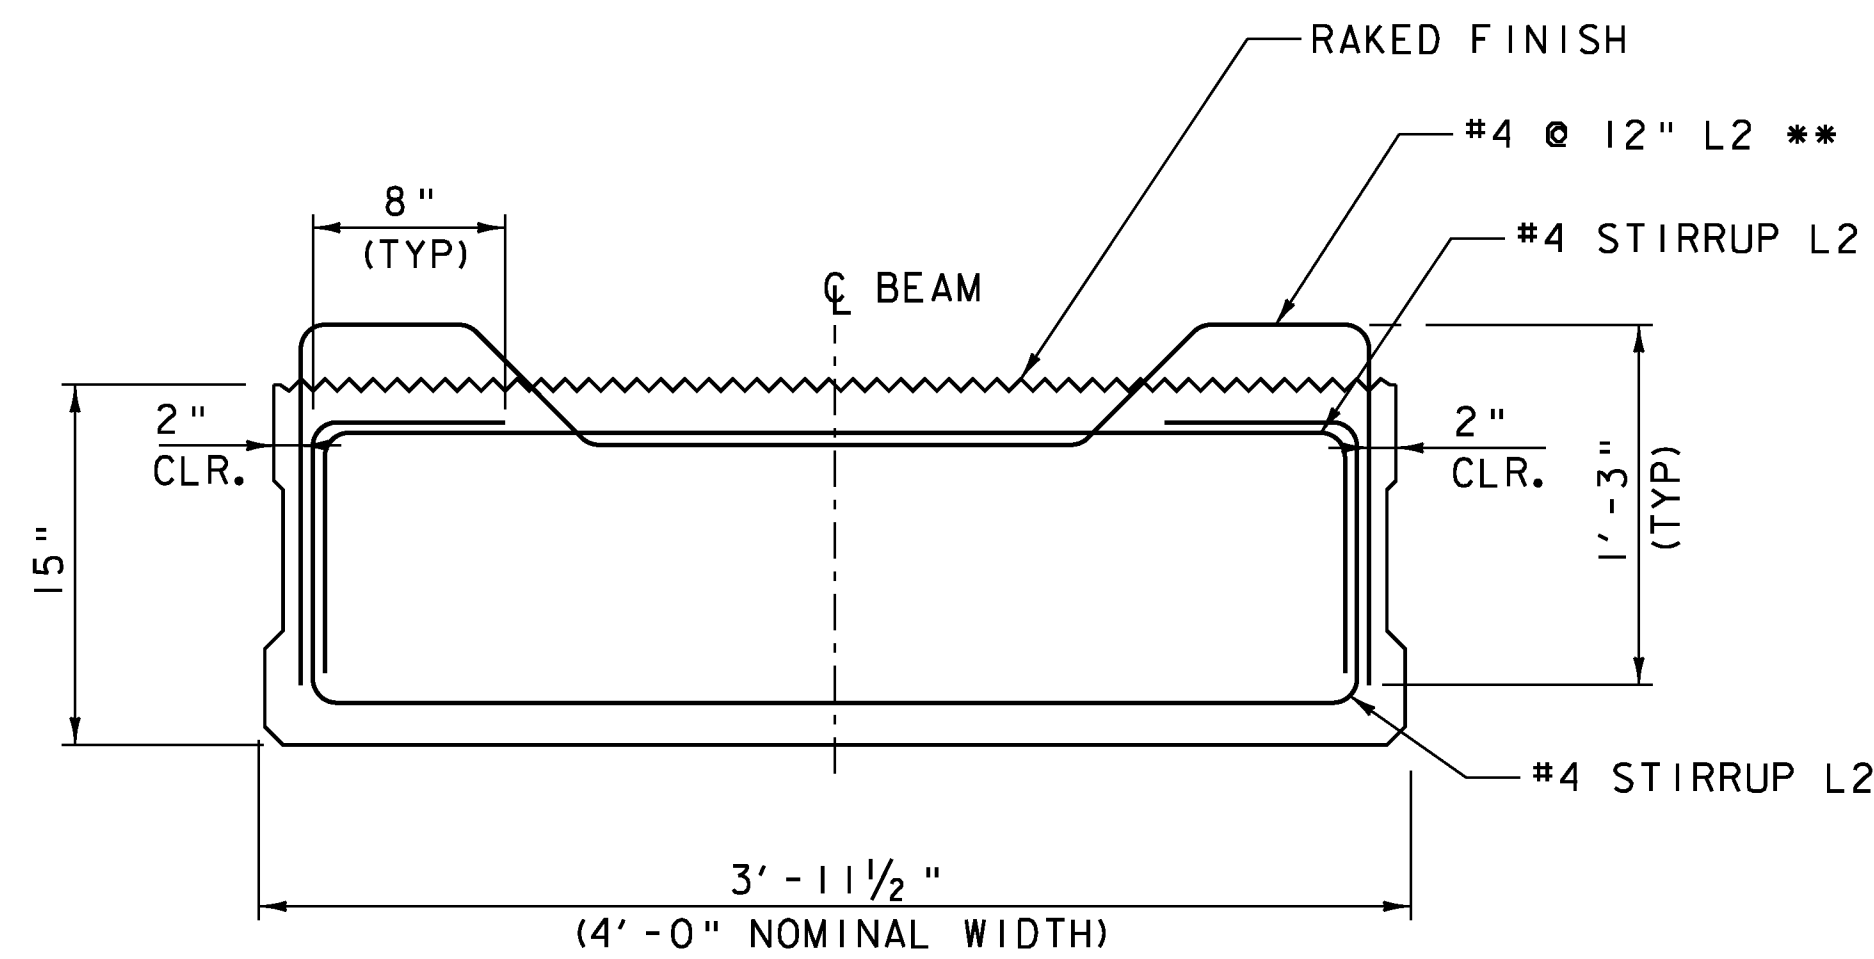

PRESTRESSED S11-48 BEAM  
 TYPICAL SECTION - REINFORCING  
 SCALE 1/2" = 1'-0"

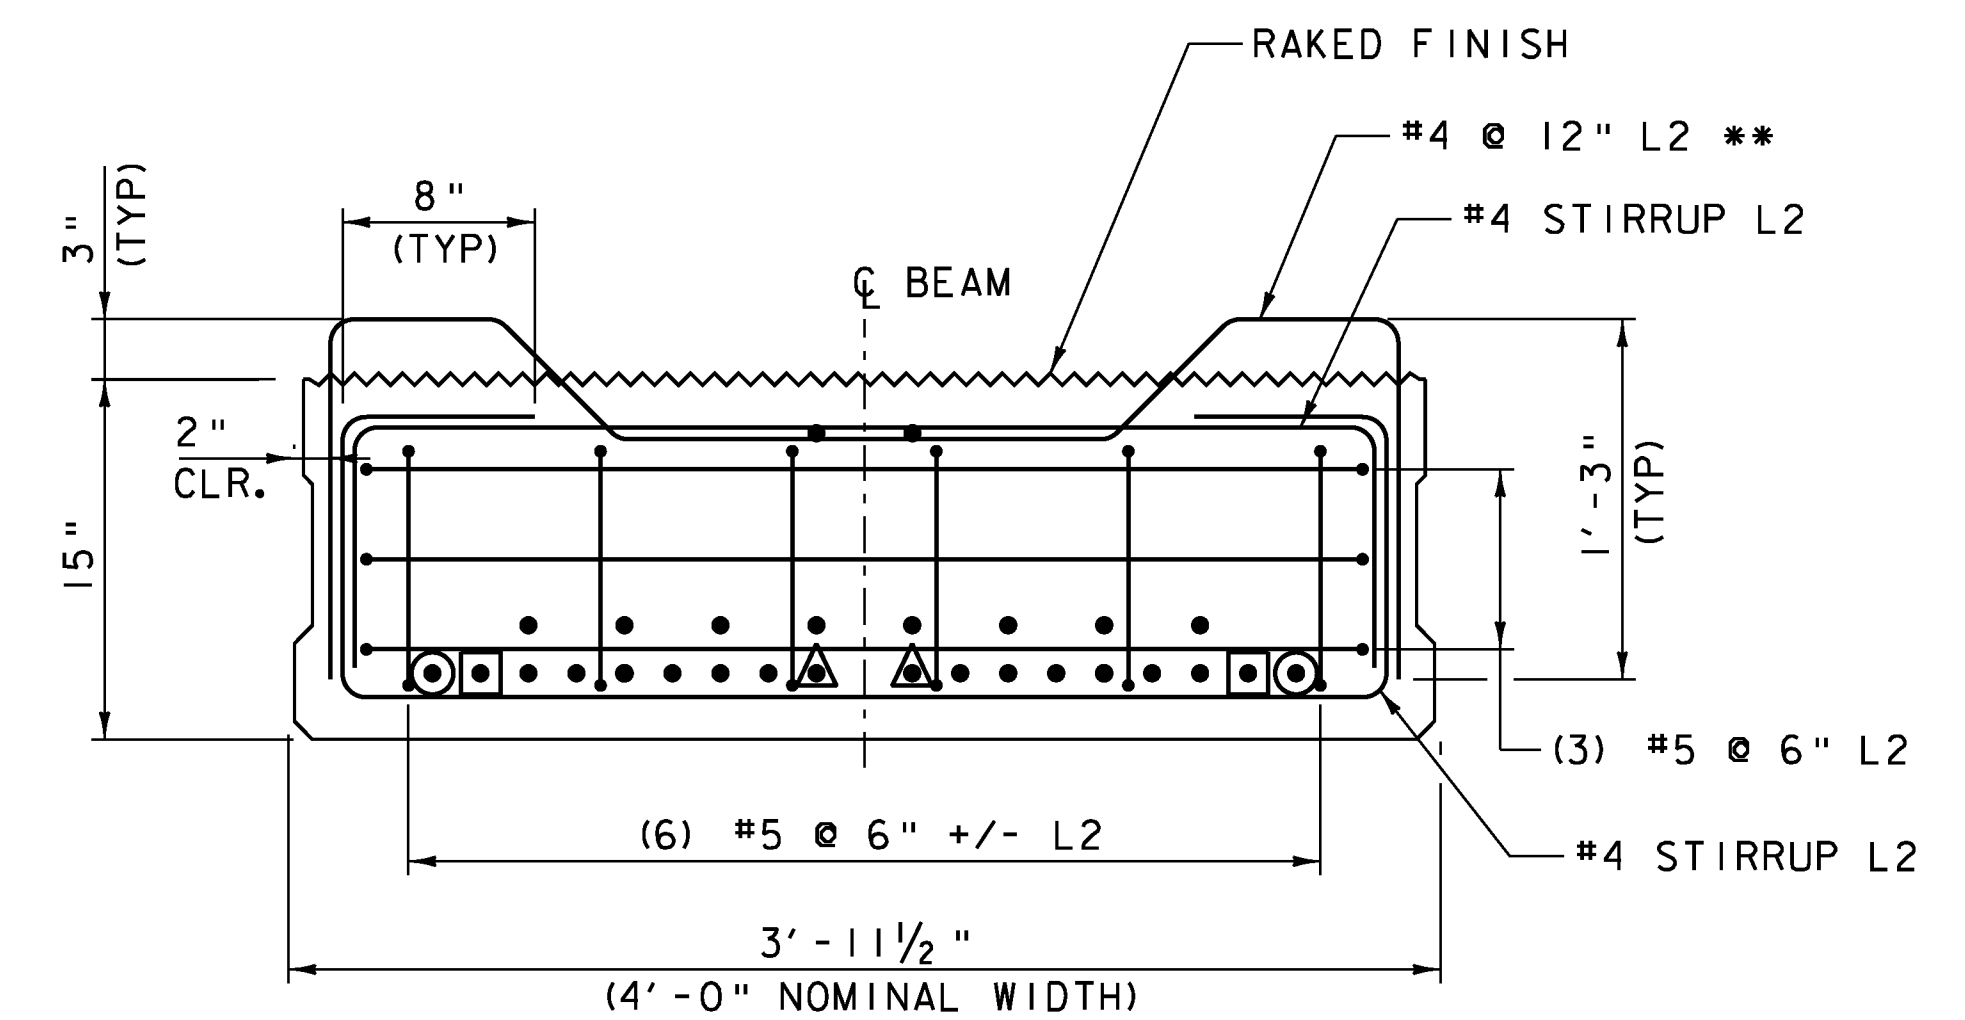

PRESTRESSED S11-48 BEAM  
 TYPICAL SECTION - END REINFORCING  
 SCALE 1/2" = 1'-0"

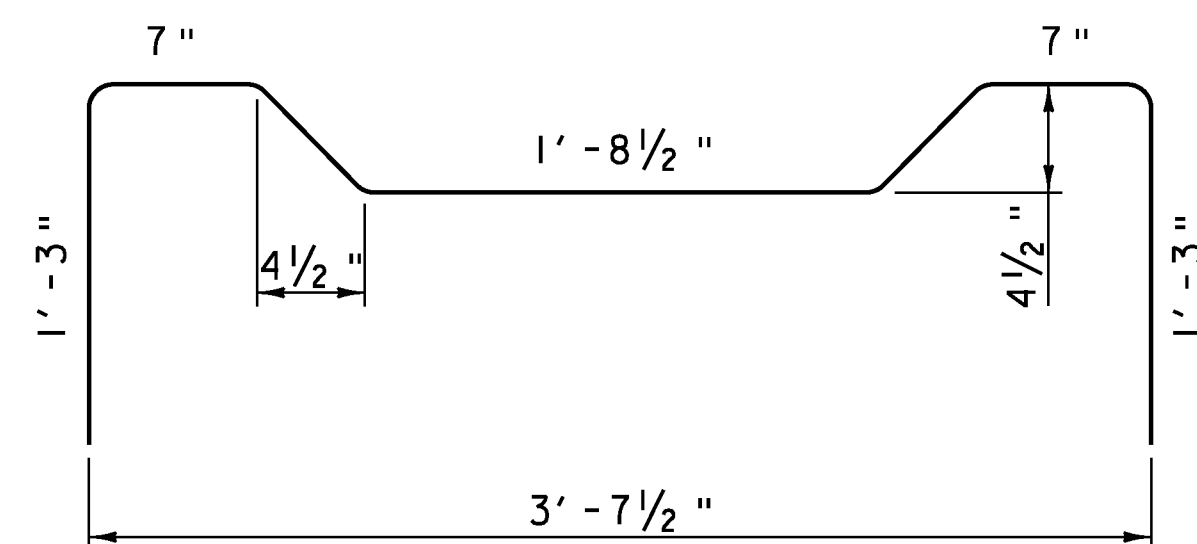

"M" BAR **  
 SCALE 1/2" = 1'-0"

** - FIRST "M" - BAR SHALL BE PARALLEL WITH END OF S11-48 BEAM, 2ND SHALL BE FLARED AND THIRD SHALL BE PERPENDICULAR WITH THE SIDES OF THE S11-48 BEAM. FIRST "M" - BAR SHALL BE LOCATED SO AS TO BE 3" CLEAR FROM THE ASPHALTIC PLUG JOINT. CONTRACTOR SHALL COORDINATE BETWEEN ASPHALTIC PLUG MANUFACTURER, INSTALLER AND NON-VOIDED SLAB FABRICATOR TO LOCATE "M" - BAR PROPERLY.


NOTES:

1. REINFORCING STEEL SHALL MEET THE REQUIREMENTS OF SECTION 507, LEVEL II.
2. SEE NEXT SHEET FOR END OF BEAM REINFORCING AND STIRRUP SPACING.


PROJECT NAME: BRATTLEBORO  
 PROJECT NUMBER: BRO 1442(35)

FILE NAME: z10j062sup02.dgn  
 PROJECT LEADER: S.E. BURBANK  
 DESIGNED BY: B.M. KLINEFELTER  
 NON-VOIDED SLAB DETAILS TYPE II (1 OF 2)

PLOT DATE: 10/14/2013  
 DRAWN BY: E.A. FIALA  
 CHECKED BY: S.E. BURBANK  
 SHEET 33 OF 68

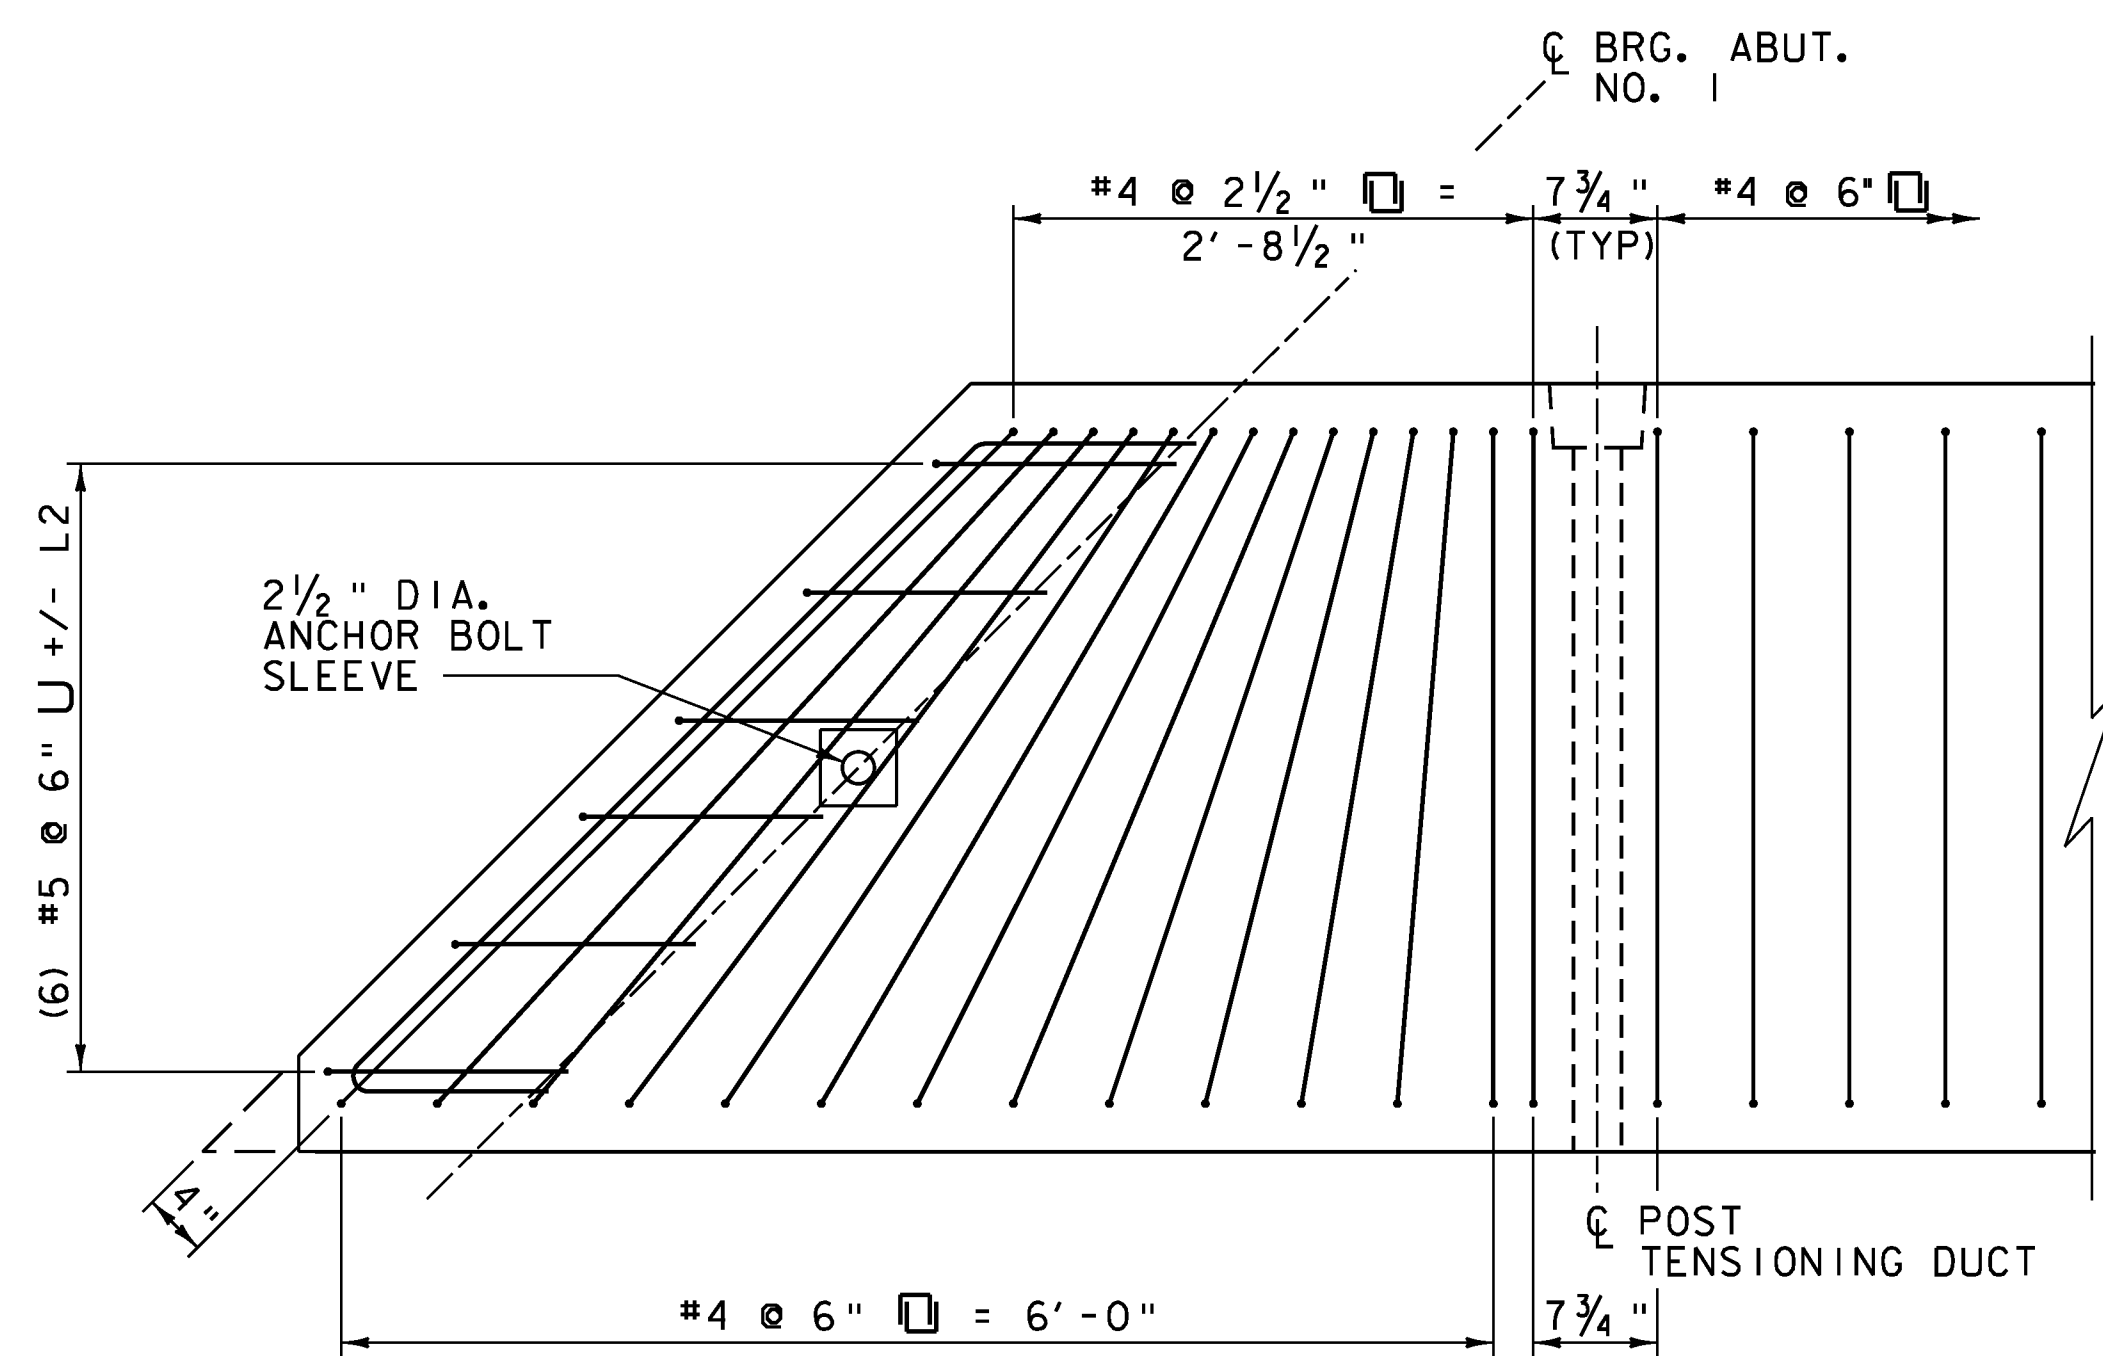

SOUTH END OF BEAM NO. 2 - REINFORCING  
 PLAN TYPE II NON-VOIDED SLAB  
 (NORTH END OF BEAM NO. 6 SAME BY 180° ROTATION)  
 SCALE 1" = 1'-0"

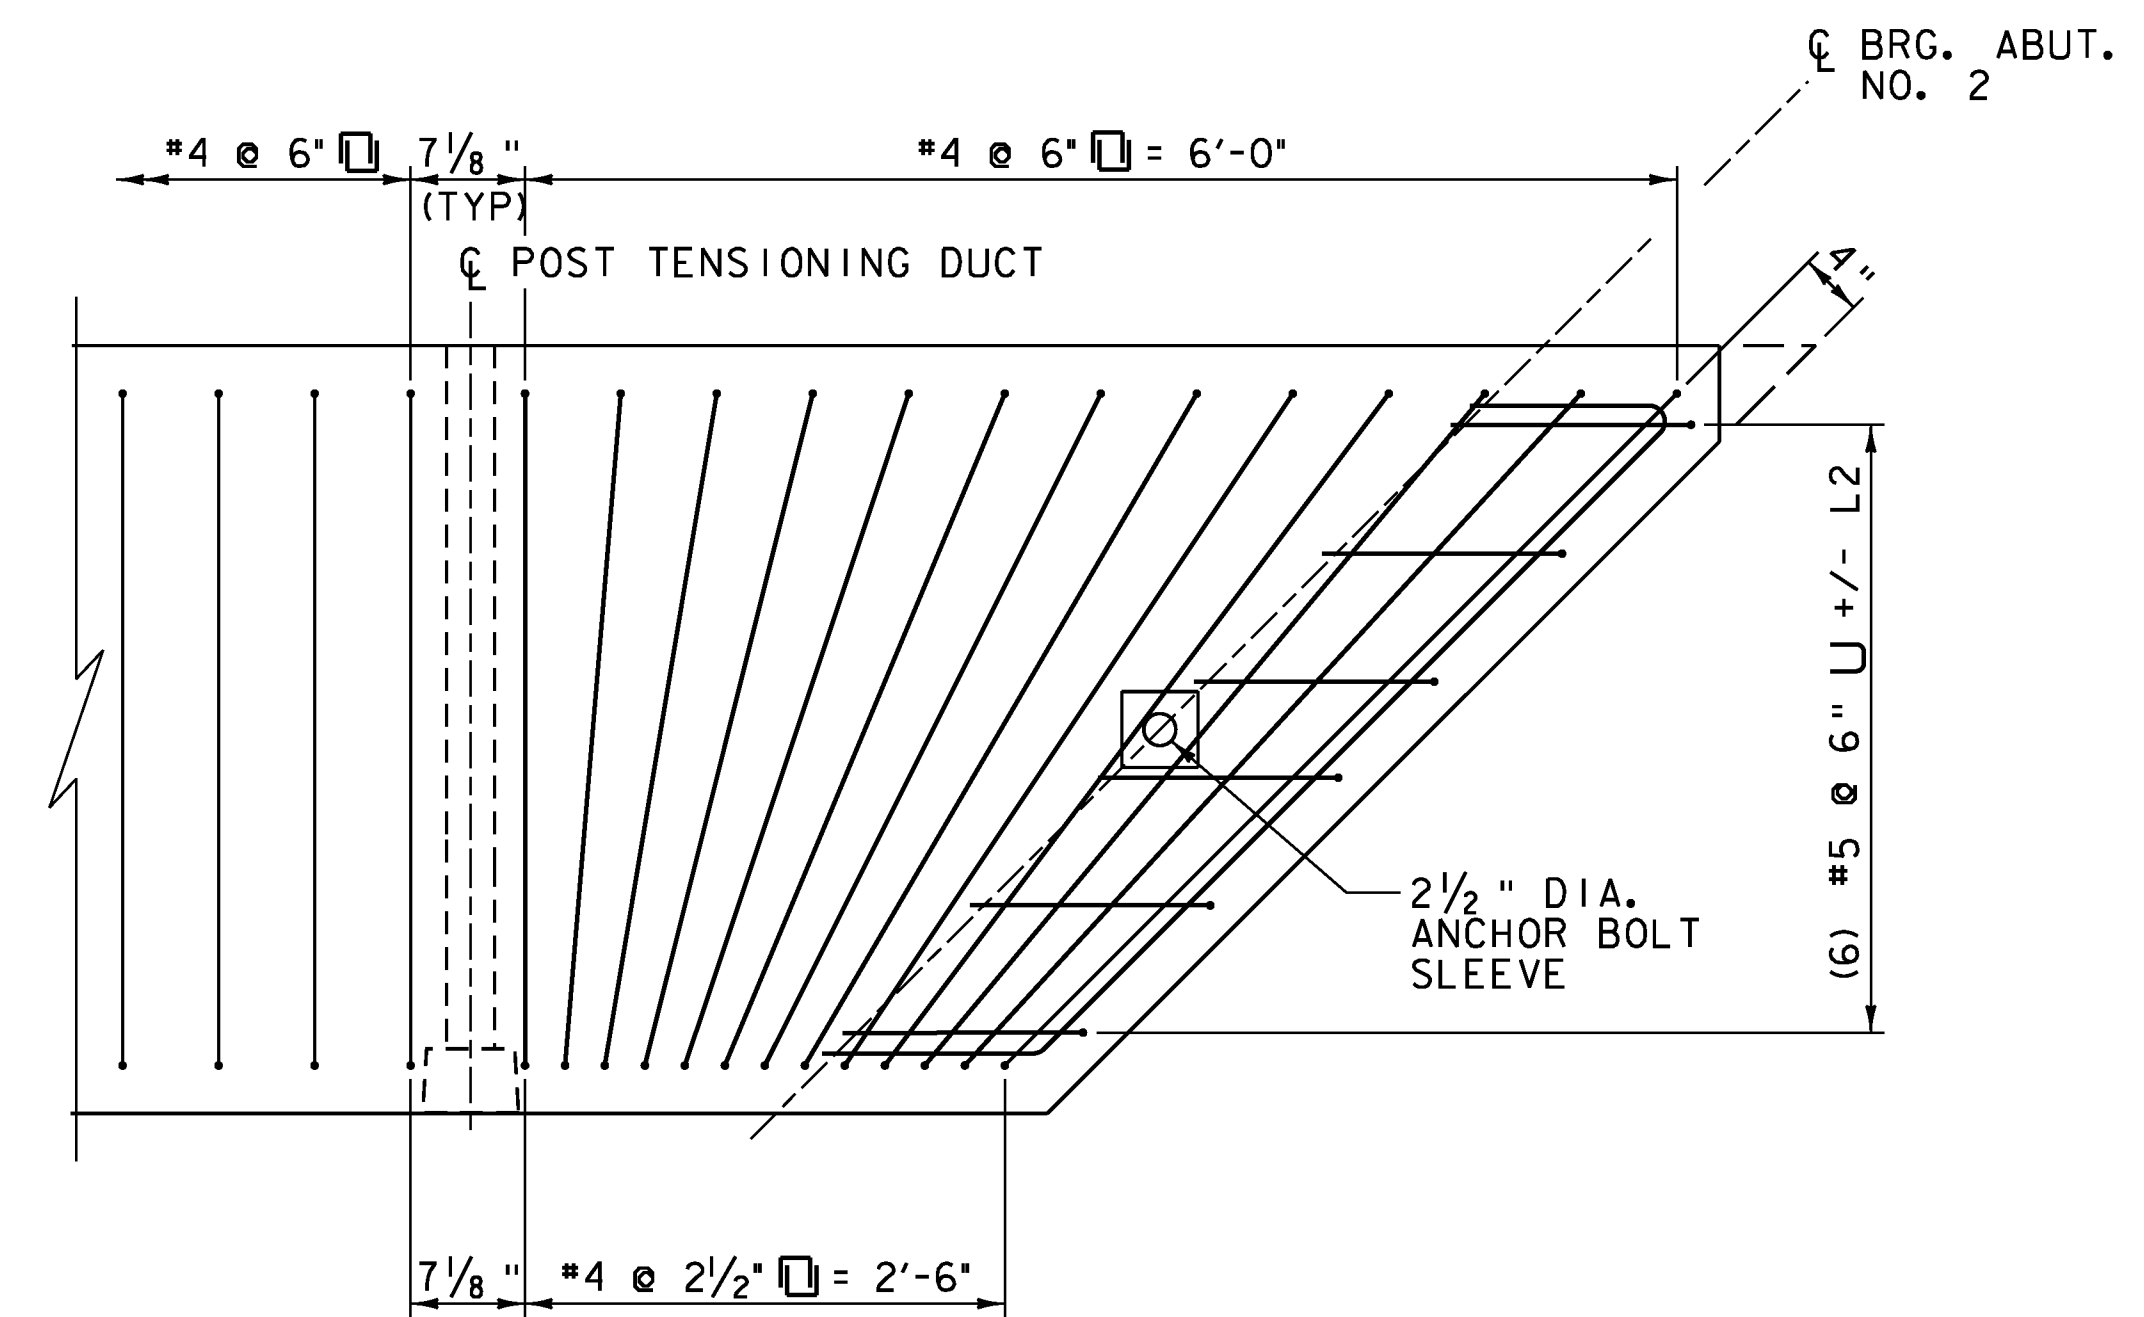


NORTH END OF BEAM NO. 2 - REINFORCING  
 PLAN TYPE II NON-VOIDED SLAB  
 (NORTH END OF BEAM NO. 6 SAME BY 180° ROTATION)  
 SCALE 1" = 1'-0"

NOTES:


- REINFORCING STEEL SHALL MEET THE REQUIREMENTS OF SECTION 507, LEVEL II.

PROJECT NAME: BRATTLEBORO	PLOT DATE: 10/14/2013
PROJECT NUMBER: BRO 1442(35)	DRAWN BY: E.A. FIALA
FILE NAME: z10J062sup02.dgn	CHECKED BY: S.E. BURBANK
PROJECT LEADER: S.E. BURBANK	DESIGNED BY: B.M. KLINEFELTER
NON-VOIDED SLAB DETAILS TYPE II (2 OF 2)	SHEET 34 OF 68

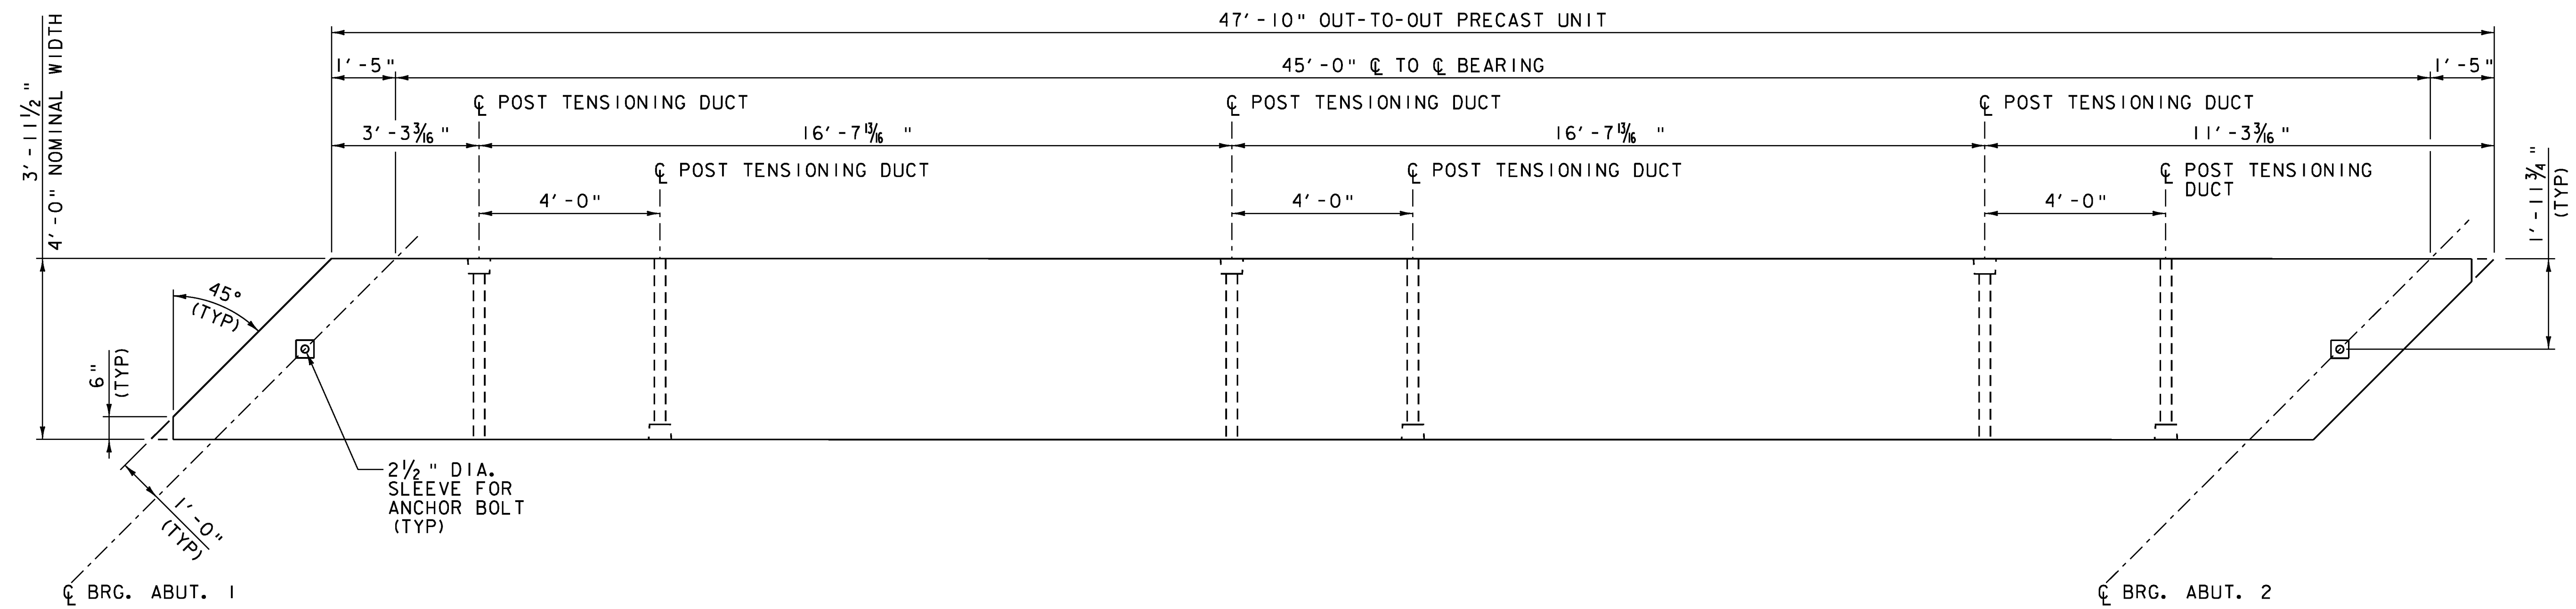


**VOIDED SLAB PLAN - TYPE III**

BEAM NO. 3, 4 AND 5  
SCALE 1/2" = 1'-0"

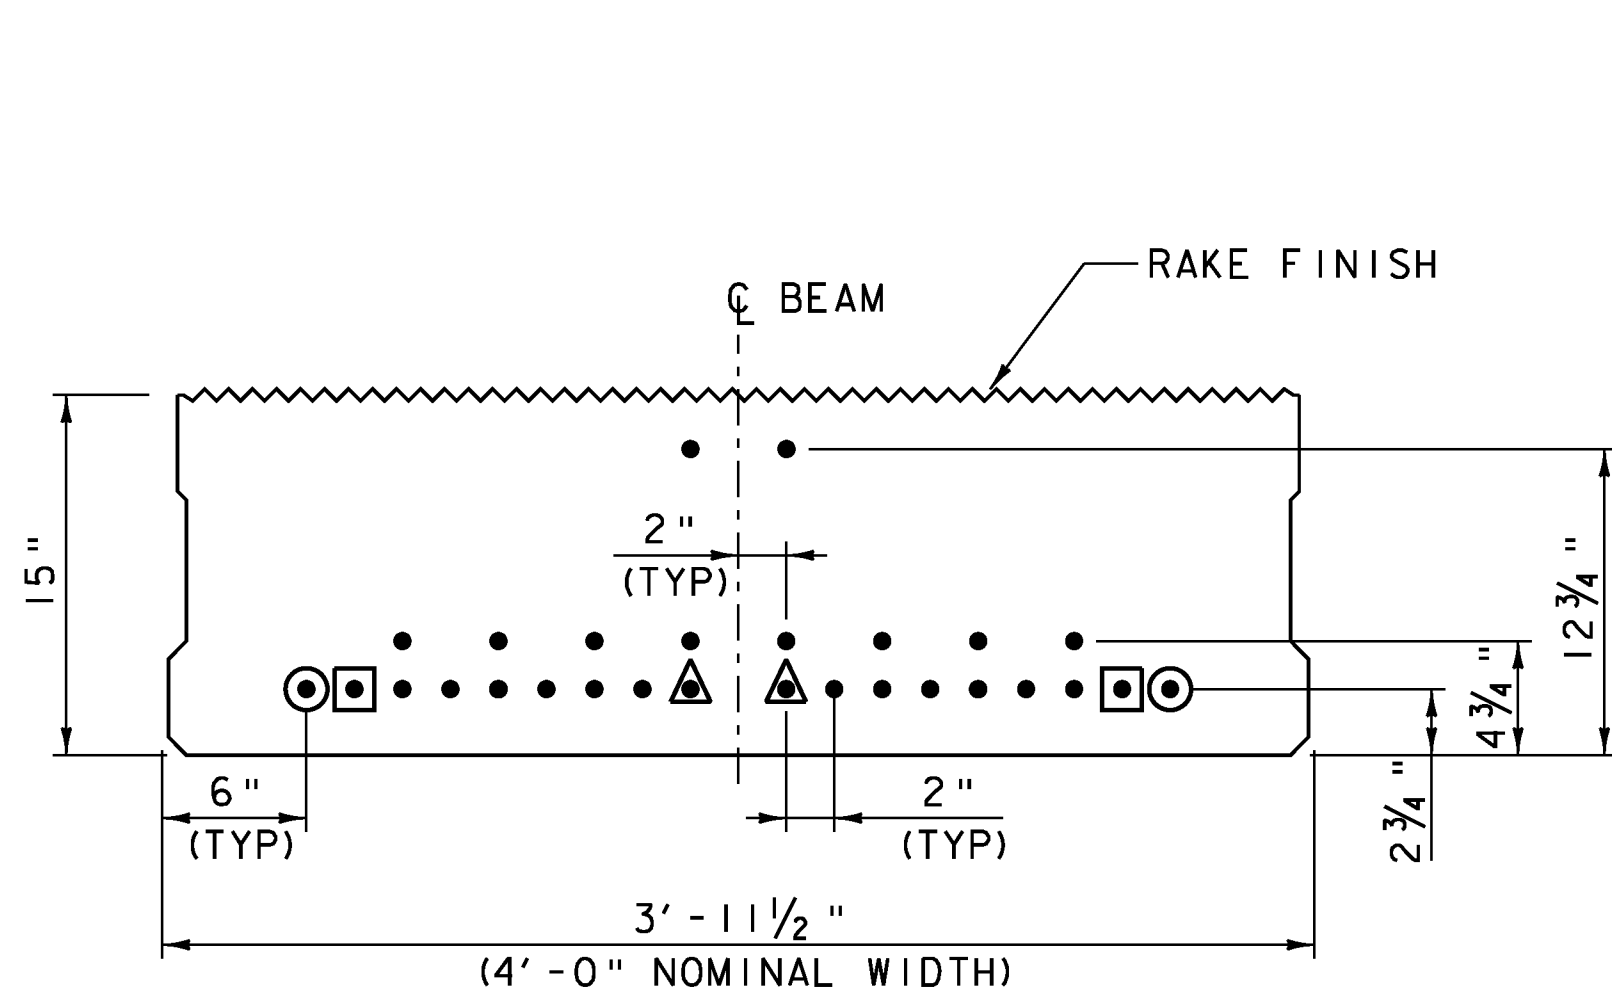


- ▲ - (2) SHIELDED AT ENDS FOR 10'-0"
- - (2) SHIELDED AT ENDS FOR 12'-0"
- - (2) SHIELDED AT ENDS FOR 14'-0"


**PRESTRESSED S11-48 BEAM  
TYPICAL SECTION - STRAND LAYOUT**  
SCALE 1/2" = 1'-0"

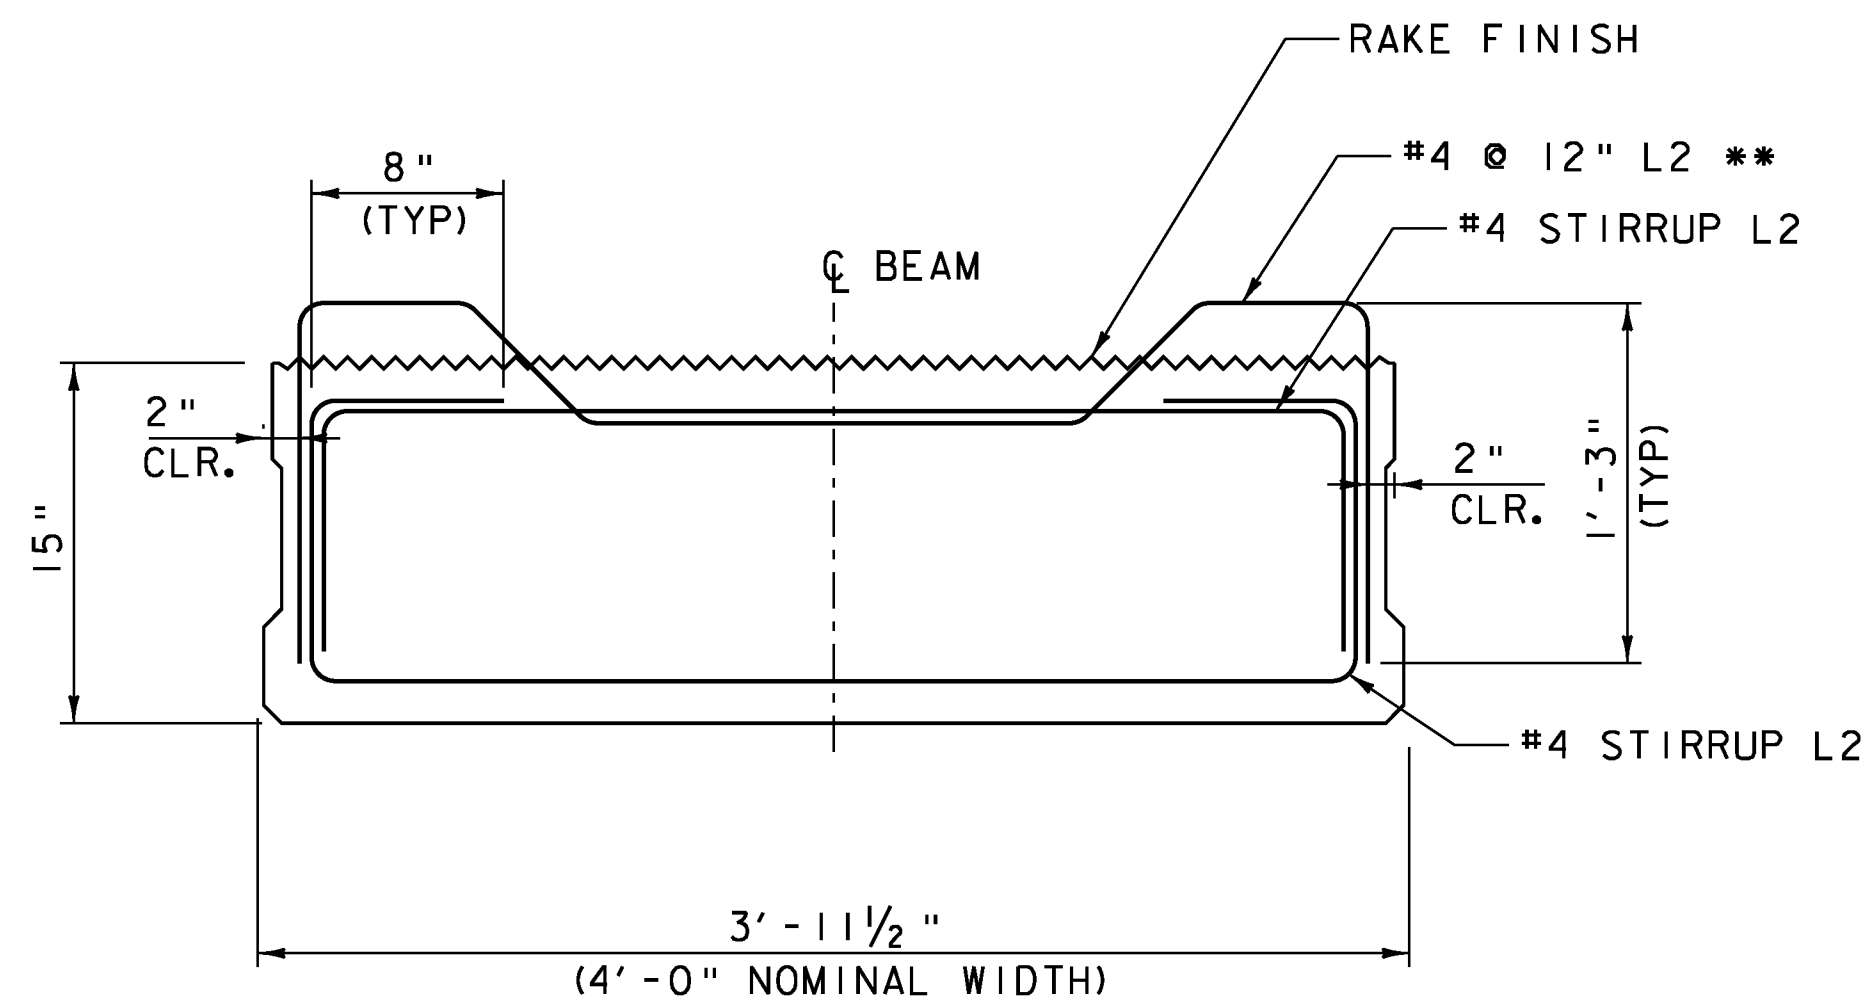

**PRESTRESSED S11-48 BEAM  
TYPICAL SECTION - REINFORCING**  
SCALE 1/2" = 1'-0"

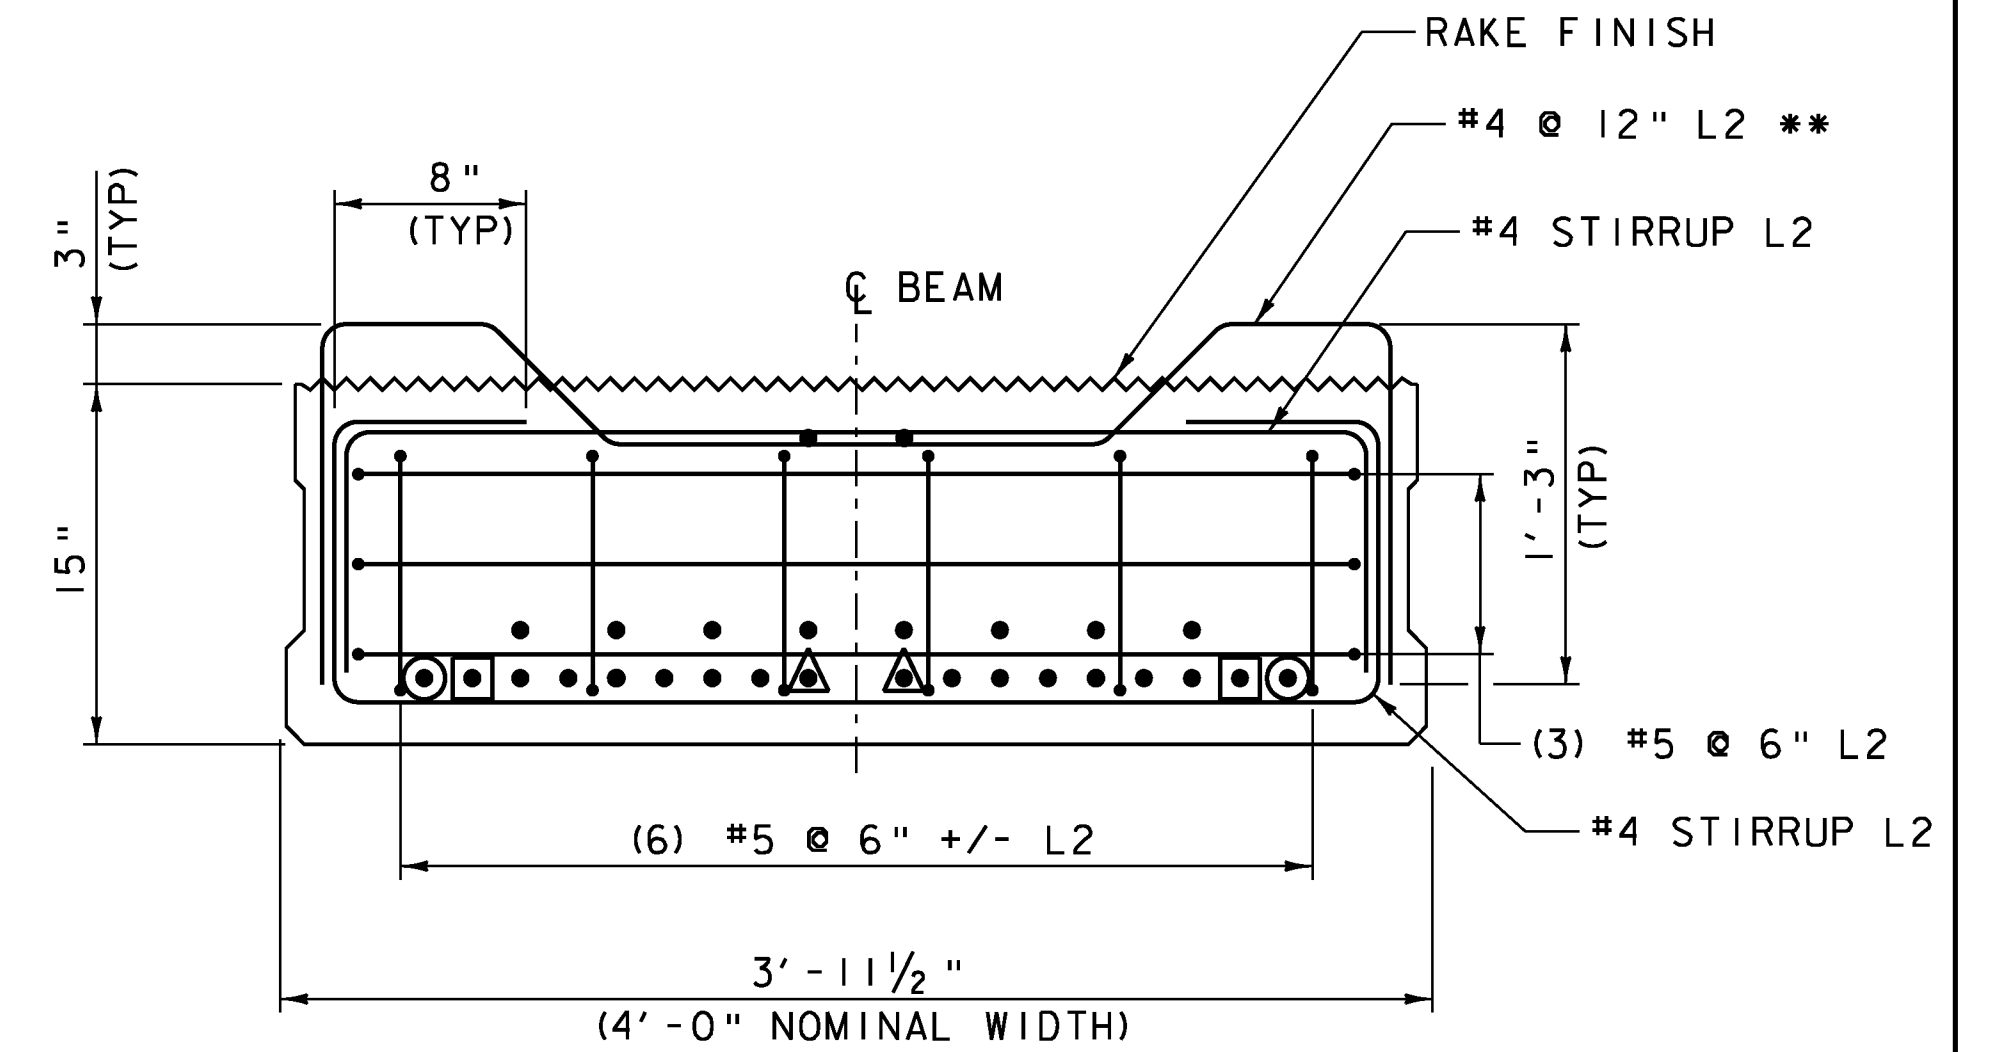

**PRESTRESSED S11-48 BEAM  
TYPICAL SECTION - END REINFORCING**  
SCALE 1/2" = 1'-0"

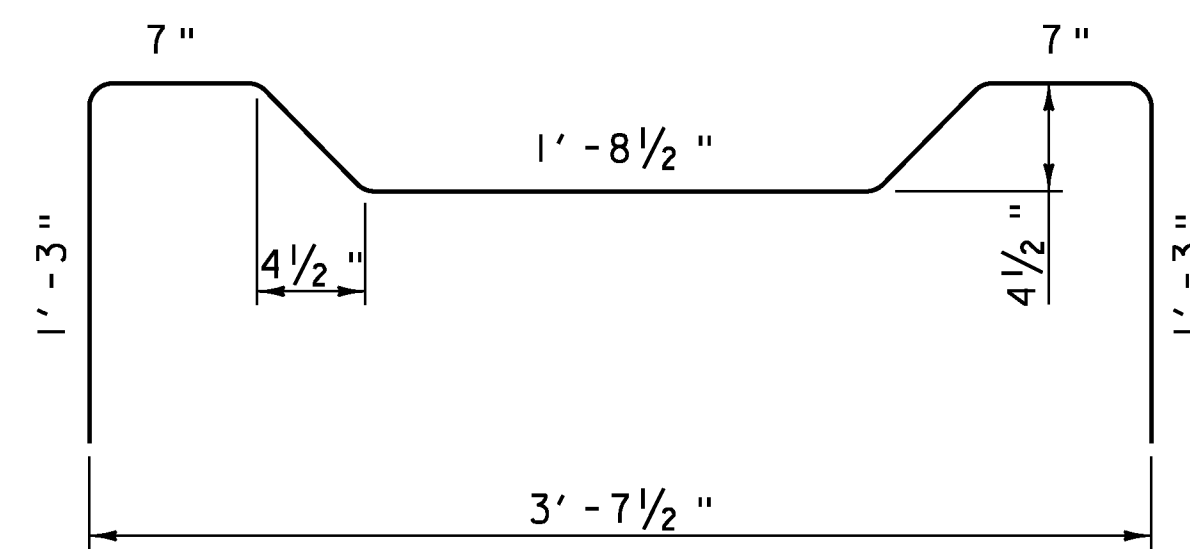

**"M" BAR ****  
SCALE 1/2" = 1'-0"

** - FIRST "M" - BAR SHALL BE PARALLEL WITH END OF S11-48 BEAM, 2ND SHALL BE FLARED AND THIRD SHALL BE PERPENDICULAR WITH THE SIDES OF THE S11-48 BEAM. FIRST "M" - BAR SHALL BE LOCATED SO AS TO BE 3" CLEAR FROM THE ASPHALTIC PLUG JOINT. CONTRACTOR SHALL COORDINATE BETWEEN ASPHALTIC PLUG MANUFACTURER, INSTALLER AND NON-VOIDED SLAB FABRICATOR TO LOCATE "M" - BAR PROPERLY.


**NOTES:**

1. REINFORCING STEEL SHALL MEET THE REQUIREMENTS OF SECTION 507, LEVEL 11.
2. SEE NEXT SHEET FOR END OF BEAM REINFORCING AND STIRRUP SPACING.


PROJECT NAME: BRATTLEBORO  
PROJECT NUMBER: BRO 1442(35)

FILE NAME: z10j062sup03.dgn  
PROJECT LEADER: S.E. BURBANK  
DESIGNED BY: B.M. KLINEFELTER  
NON-VOIDED SLAB DETAILS TYPE III (1 OF 2)

PLOT DATE: 10/14/2013  
DRAWN BY: E.A. FIALA  
CHECKED BY: S.E. BURBANK  
SHEET 35 OF 68

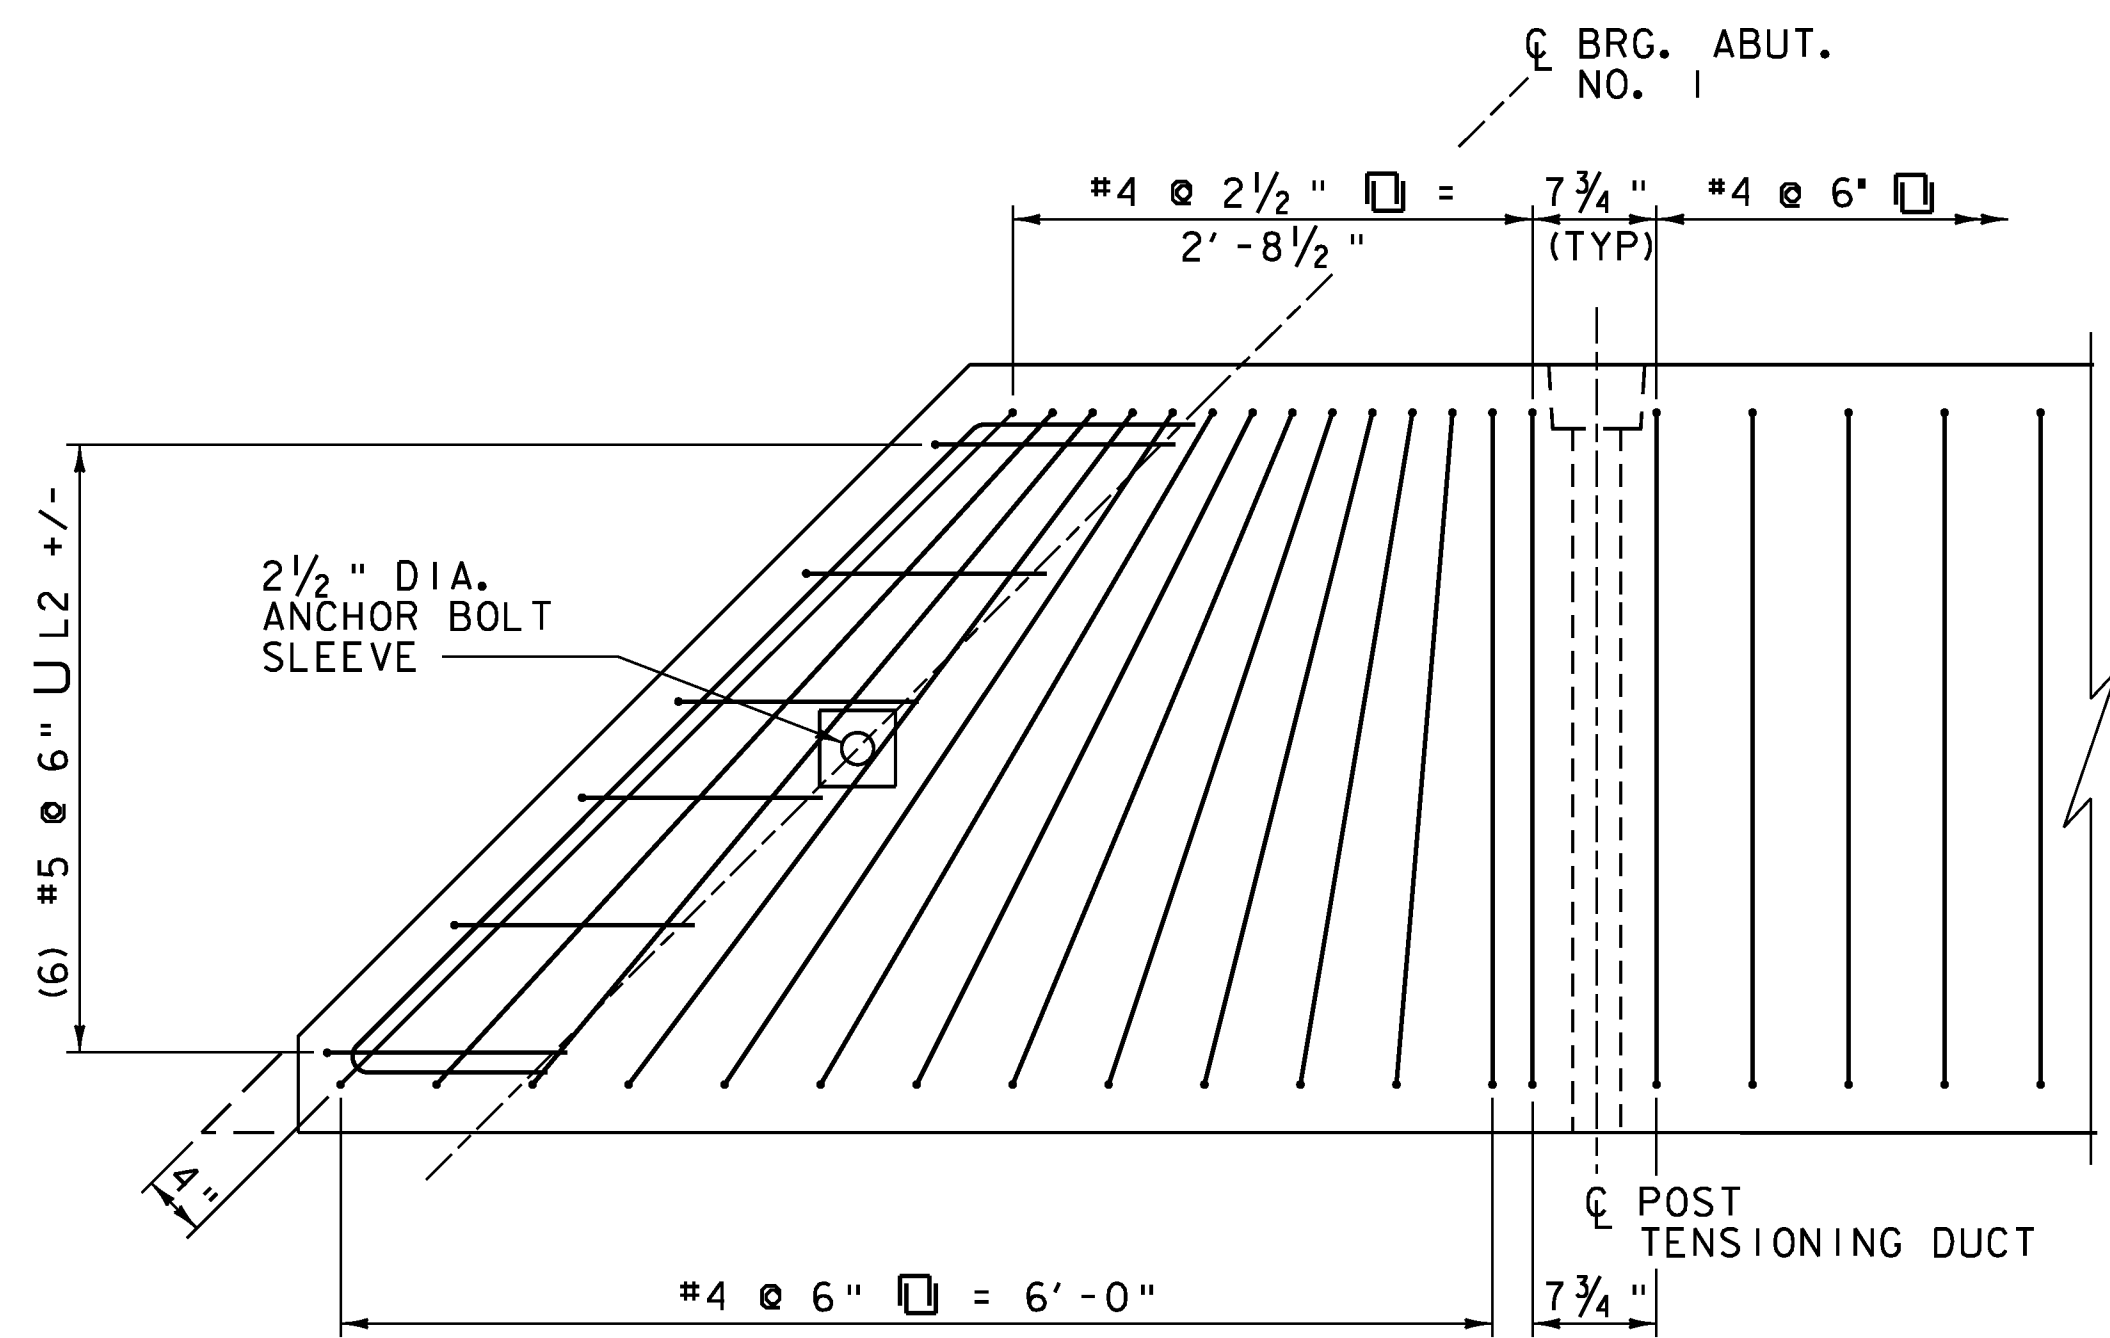

SOUTH END OF BEAM NO. 3, 4, & 5 -  
 REINFORCING PLAN TYPE III NON-VOIDED SLAB  
 SCALE 1" = 1'-0"

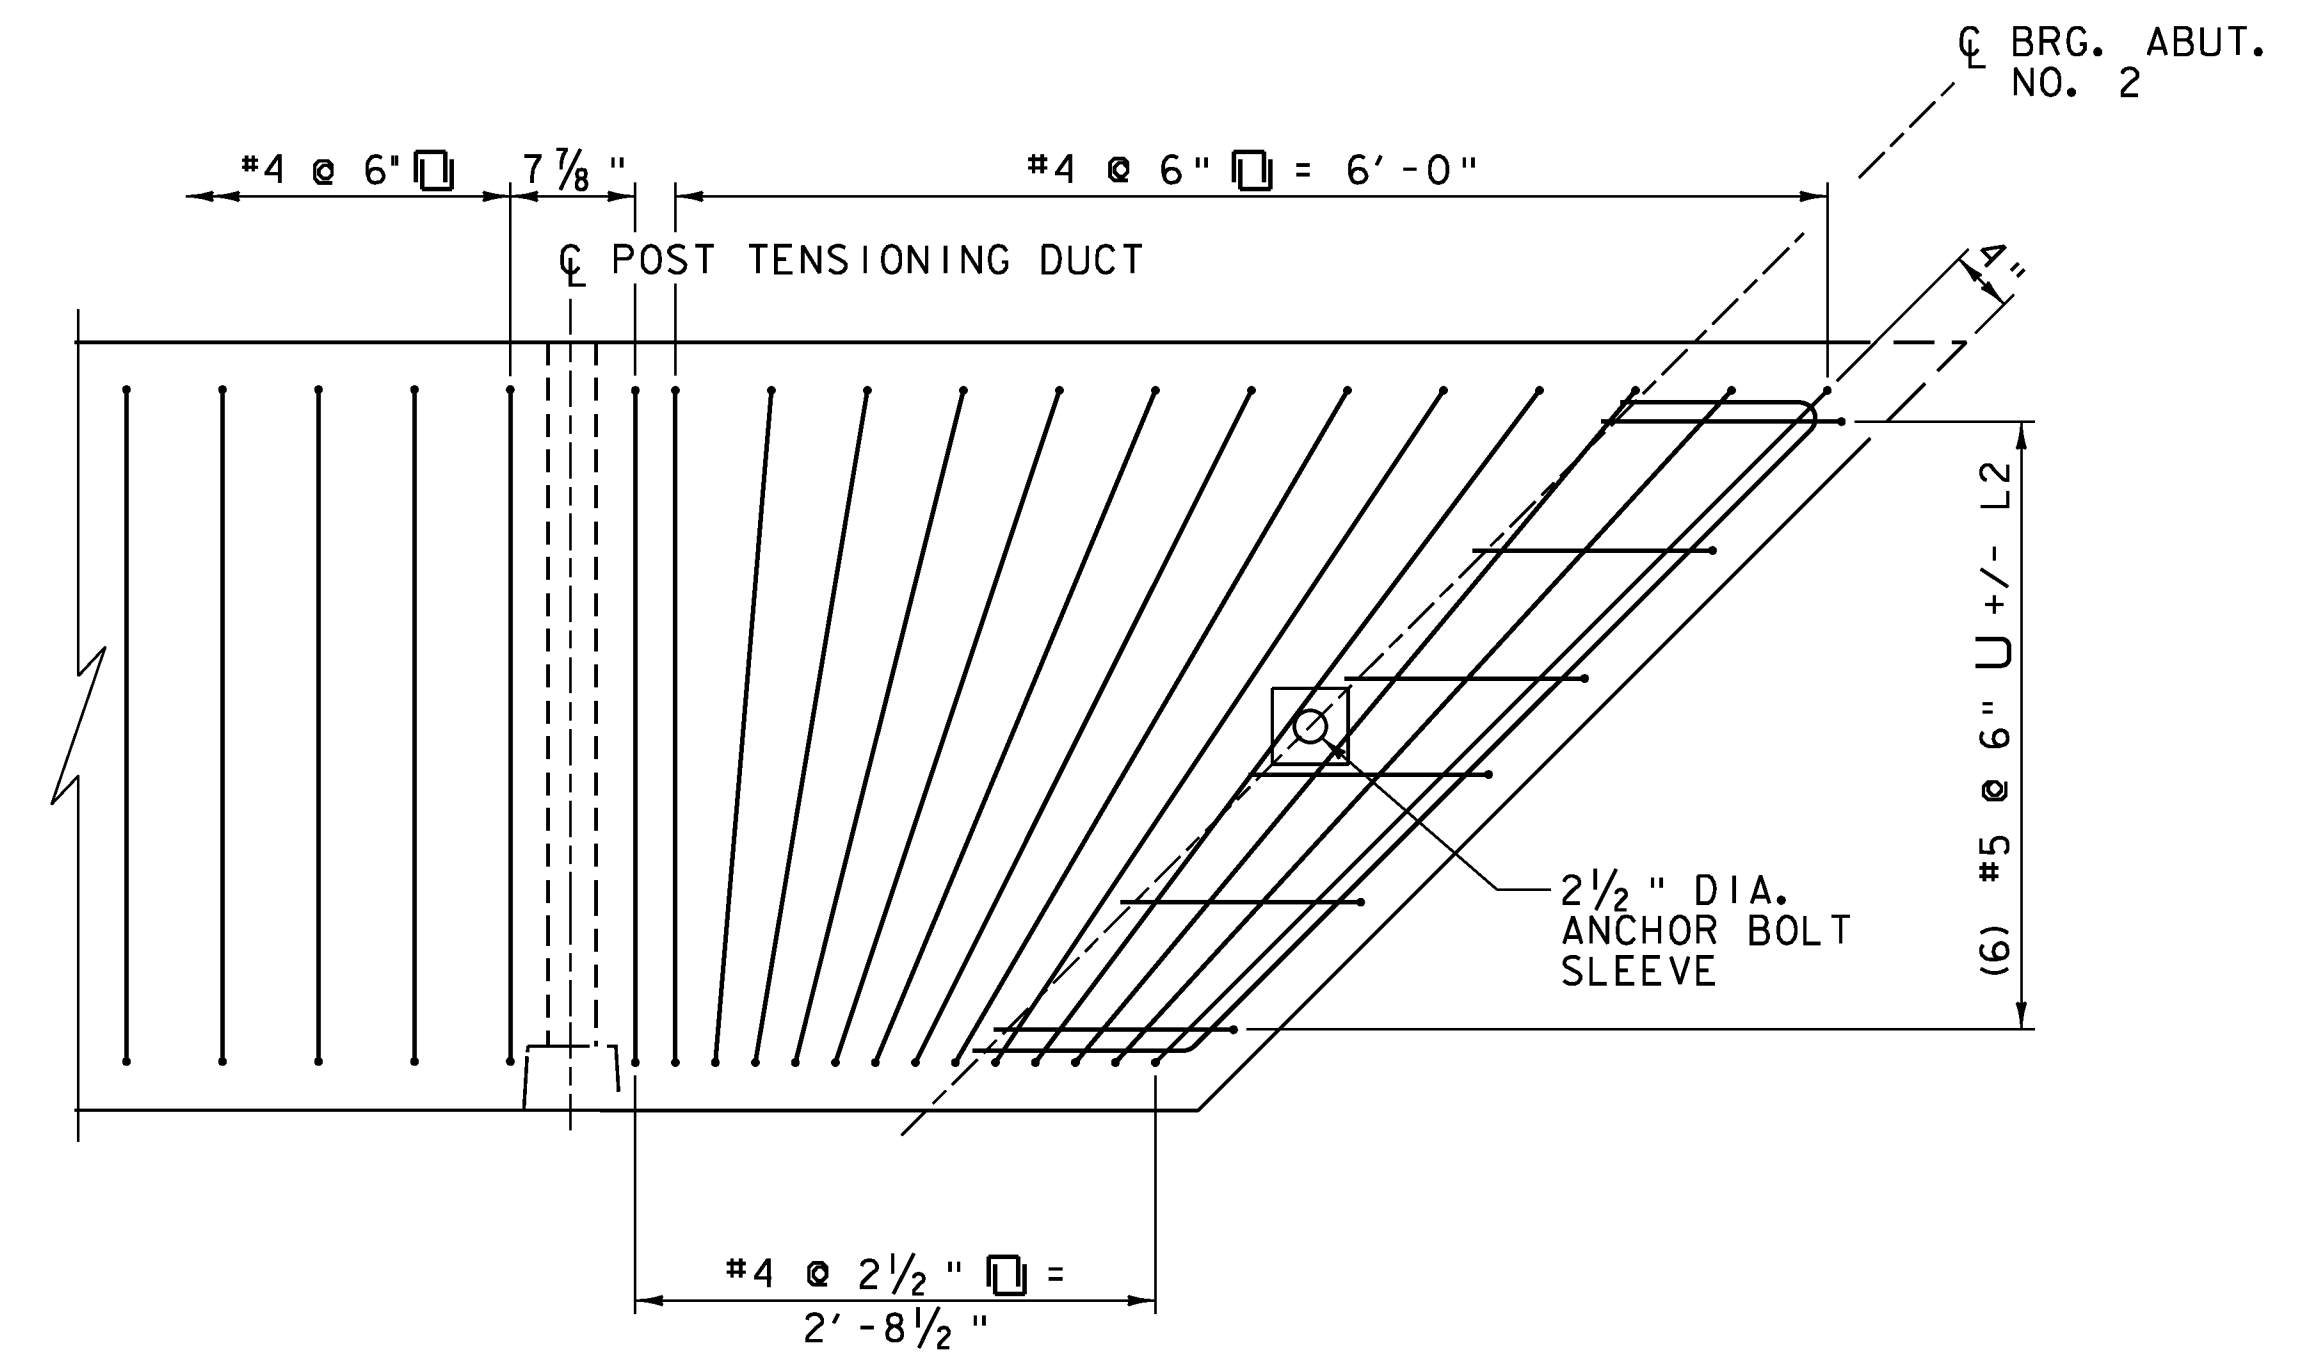

SOUTH END OF BEAM NO. 3, 4, & 5 -  
 REINFORCING PLAN TYPE III NON-VOIDED SLAB  
 SCALE 1" = 1'-0"


NOTES:

- REINFORCING STEEL SHALL MEET THE REQUIREMENTS OF SECTION 507, LEVEL II.

PROJECT NAME: BRATTLEBORO  
 PROJECT NUMBER: BRO 1442(35)

FILE NAME: z10j062sup03.dgn  
 PROJECT LEADER: S.E. BURBANK  
 DESIGNED BY: B.M. KLINEFELTER  
 NON-VOIDED SLAB DETAILS TYPE III (2 OF 2)


PLOT DATE: 10/14/2013  
 DRAWN BY: E.A. FIALA  
 CHECKED BY: S.E. BURBANK  
 SHEET 36 OF 68

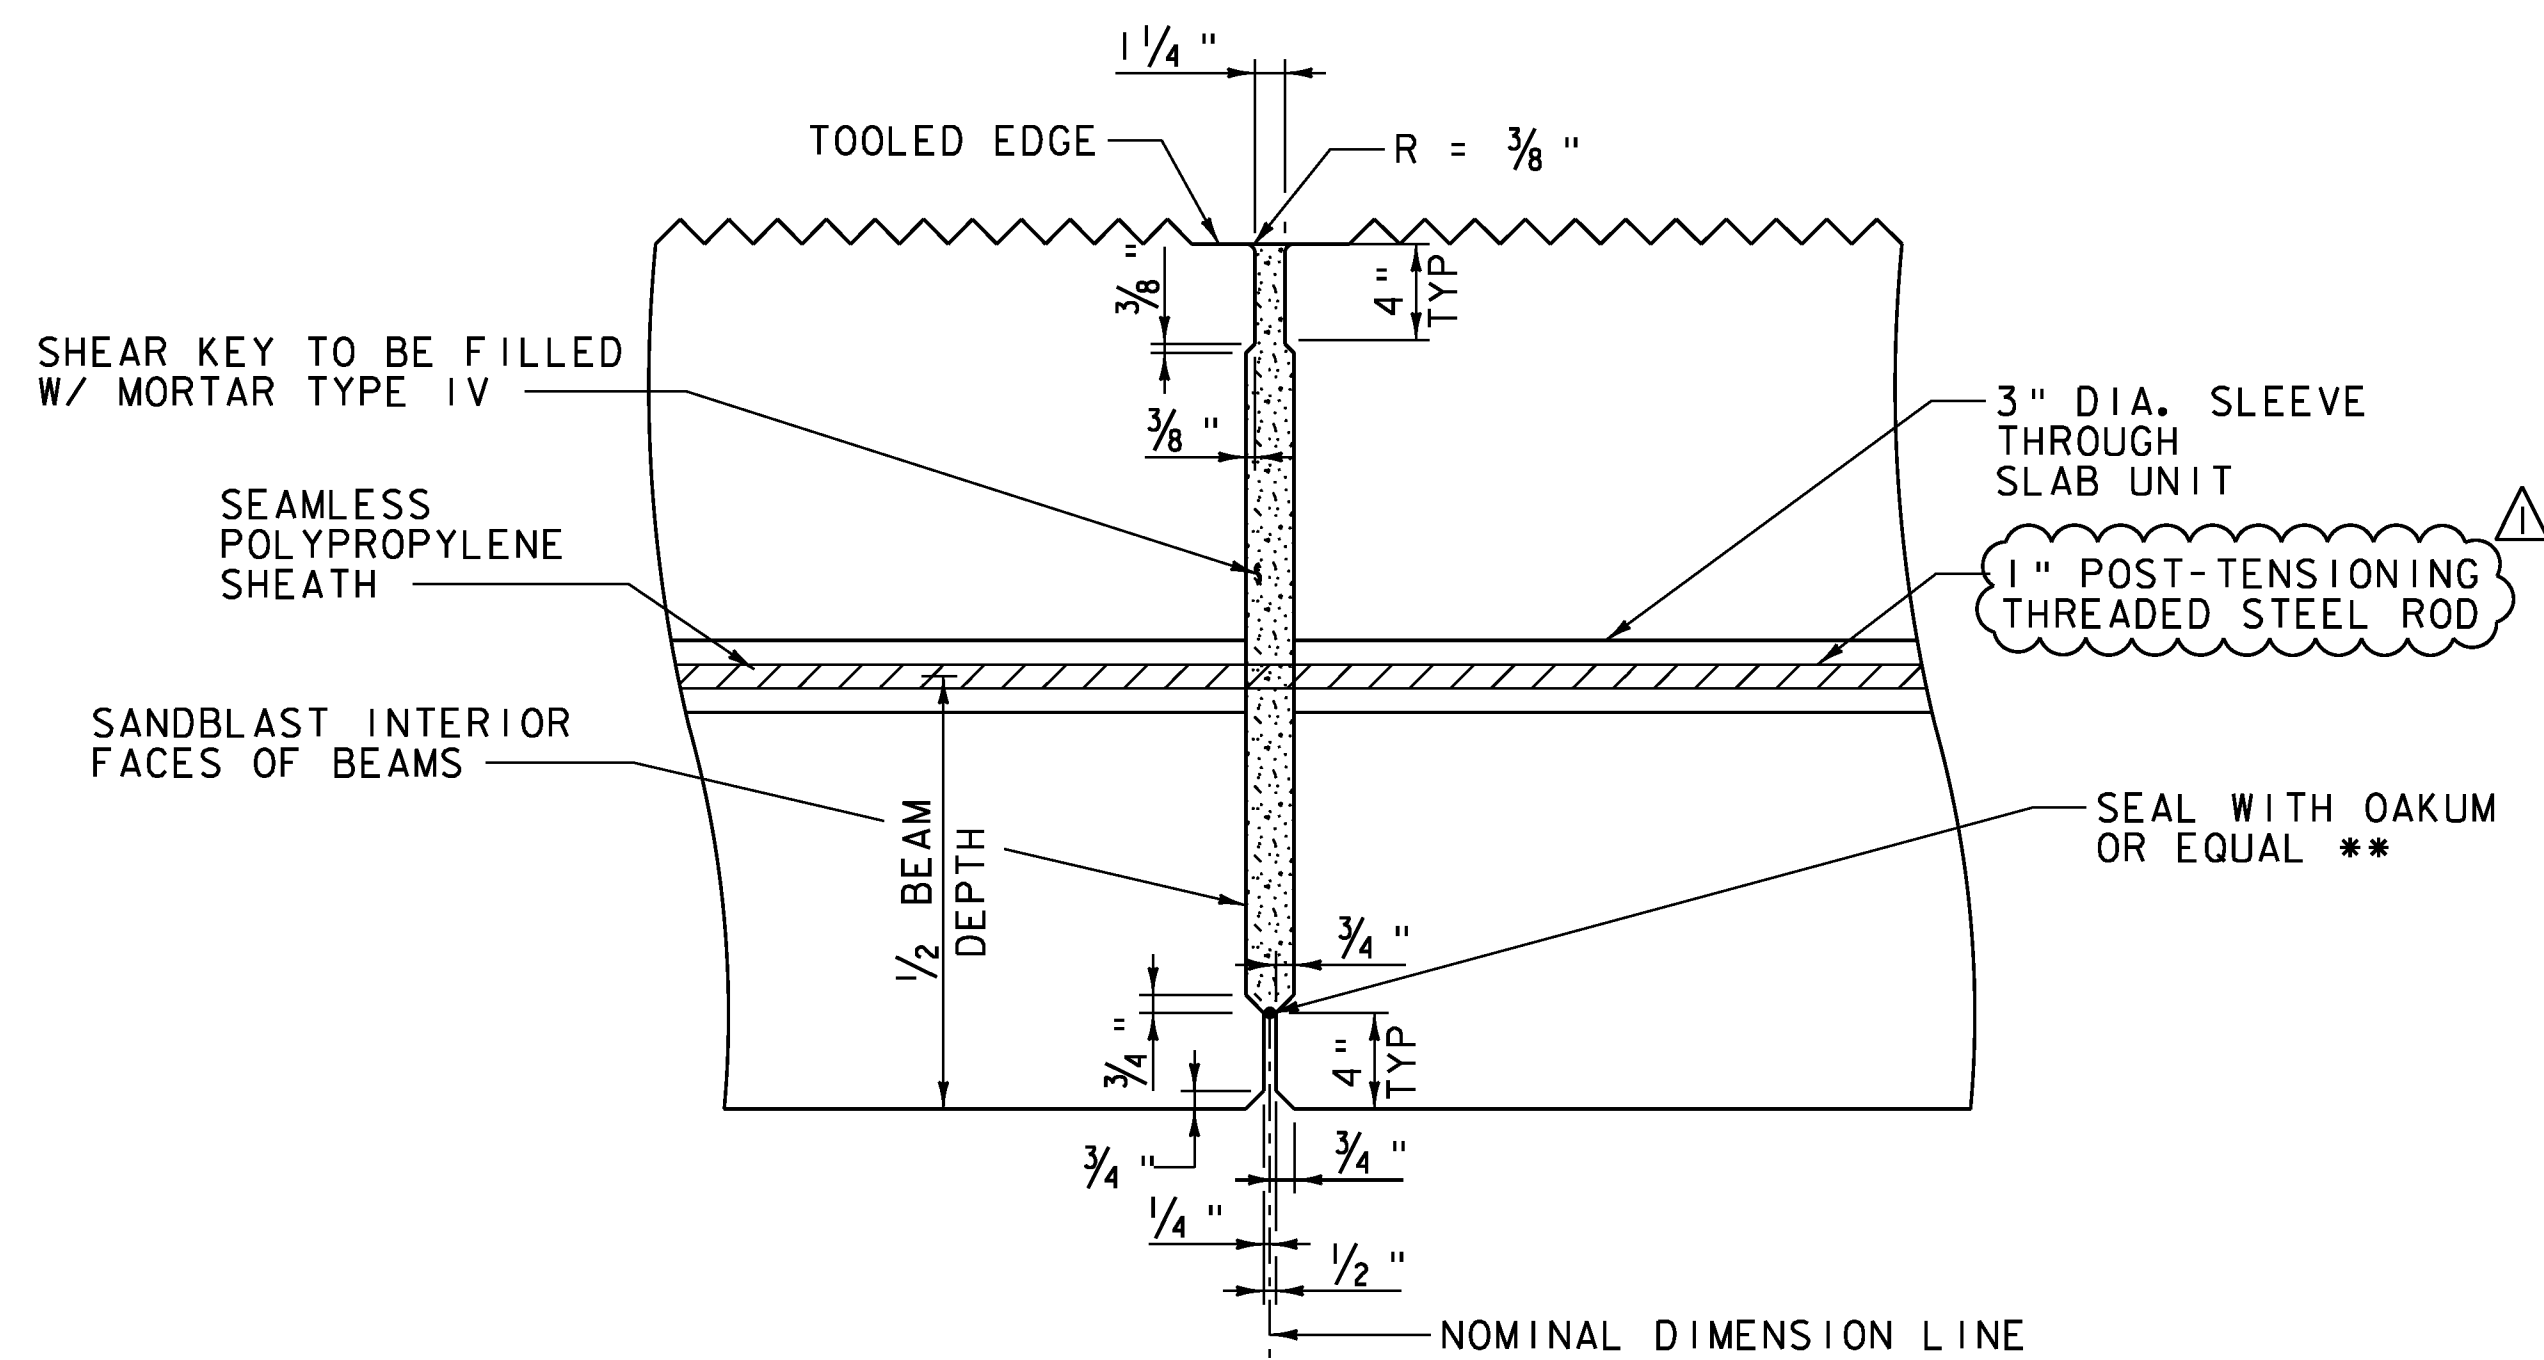

**SHEAR KEY DETAIL  
@ POST-TENSIONING SLEEVE**


SCALE 1/2" = 1'-0"

** NOTE: INSTALL OAKUM AFTER UNITS HAVE BEEN PLACED

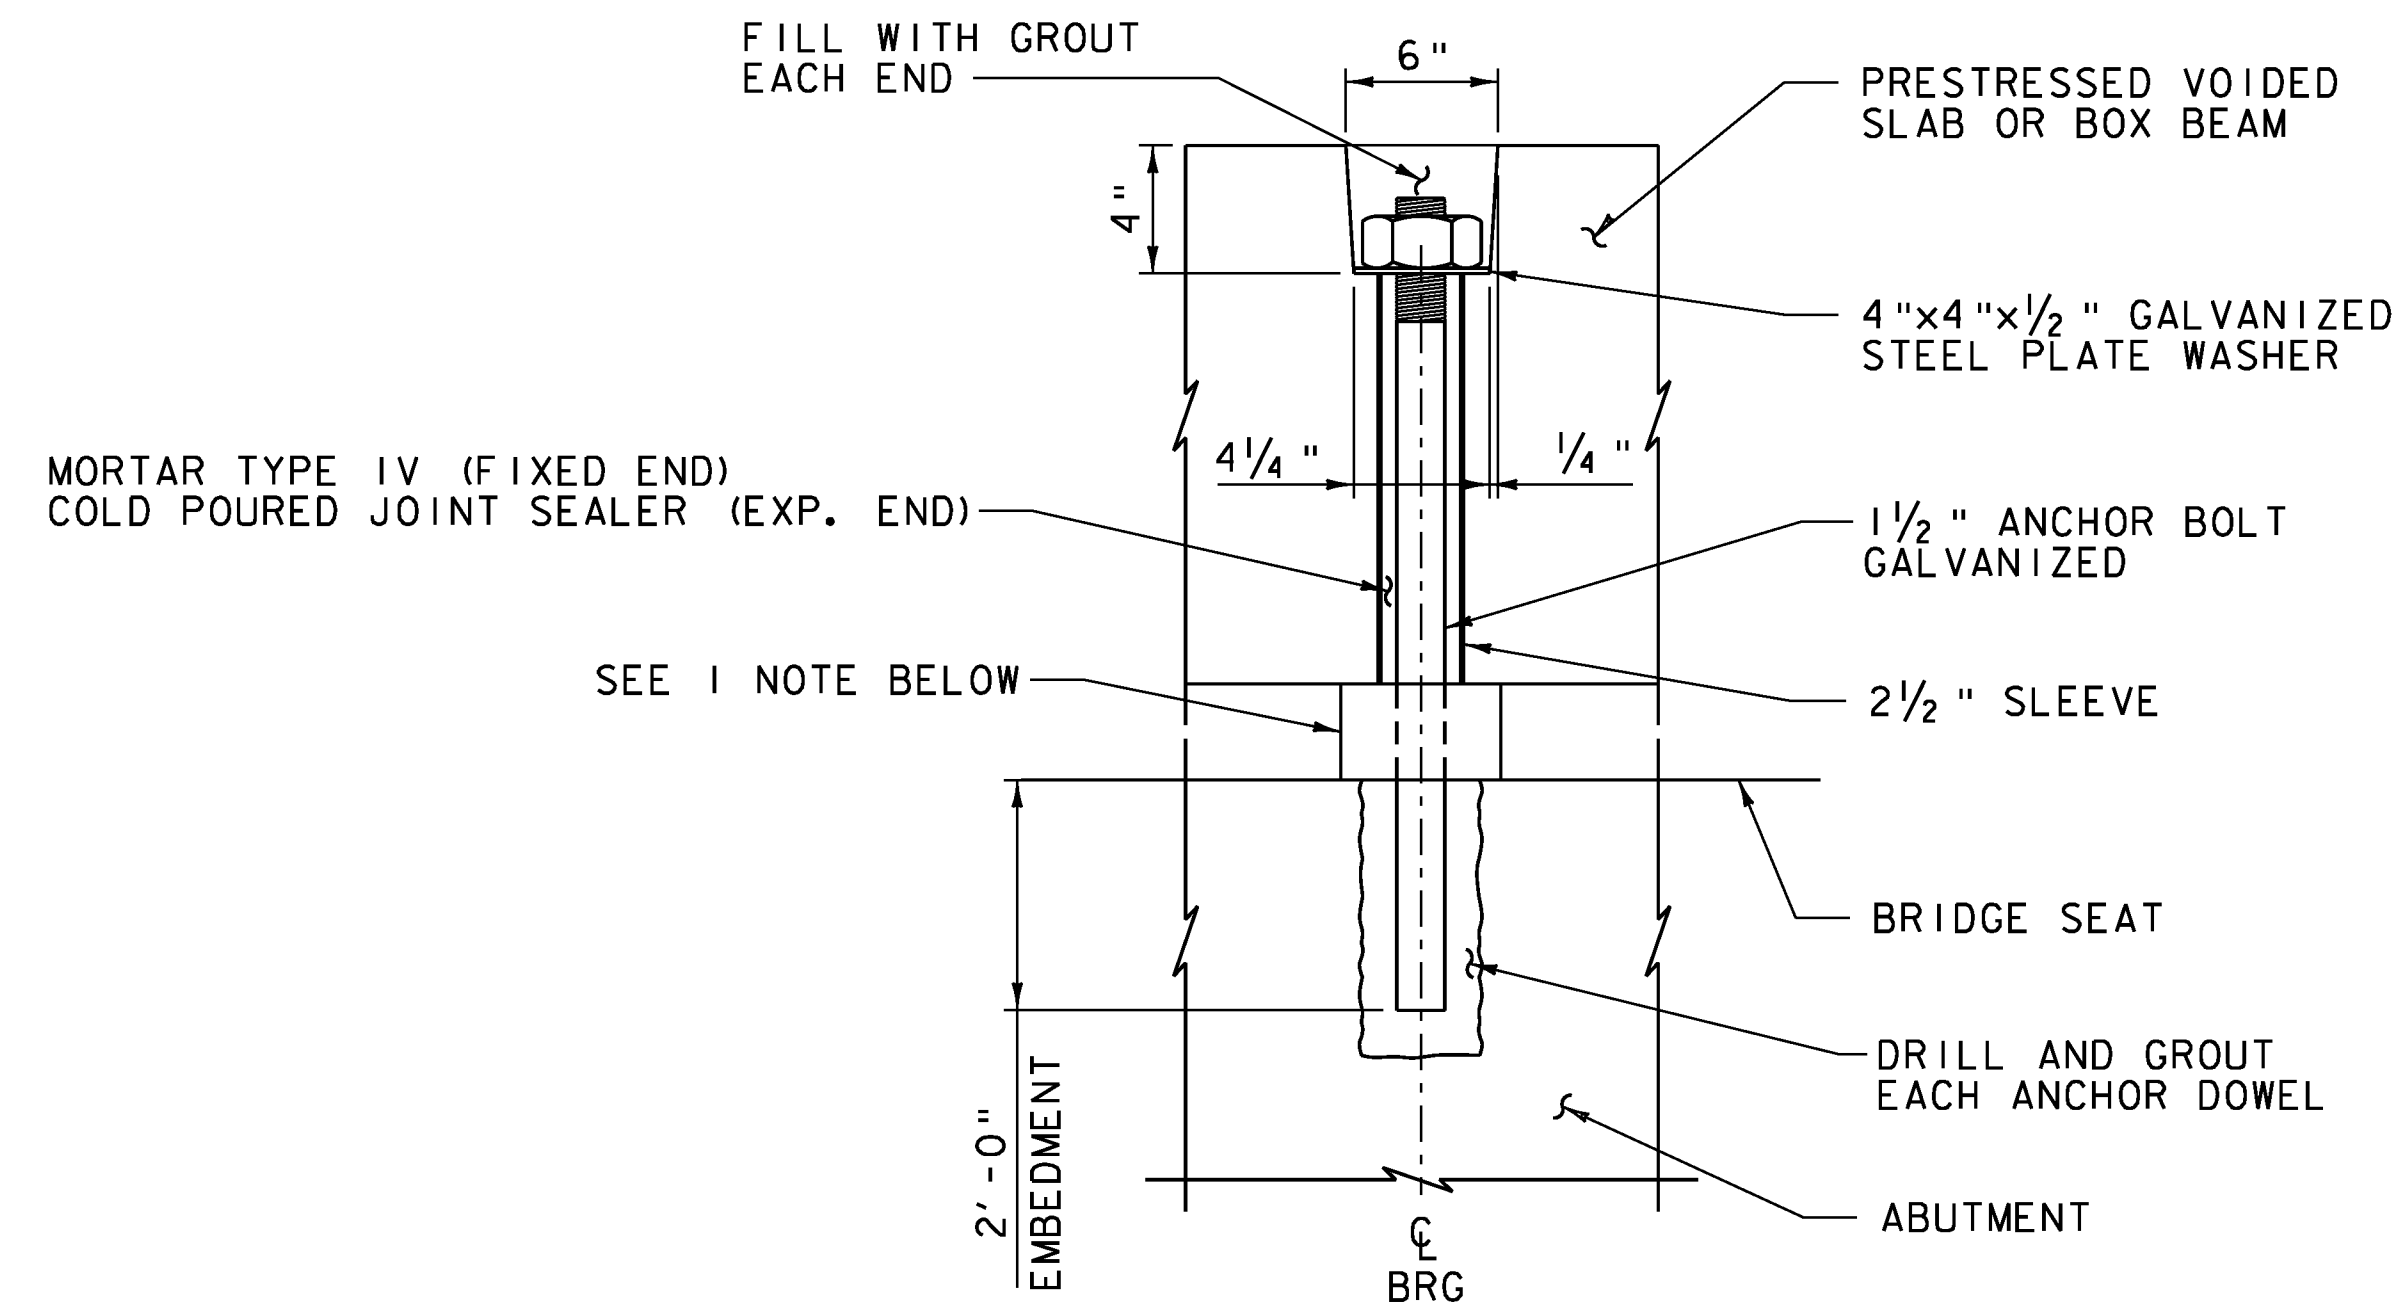


**PRESTRESSED BEAM  
ANCHOR DETAIL**  
NOT TO SCALE

1. CONTRACTOR SHALL SUPPLY A SELF-ADHESIVE COMPRESSIBLE SEALER BETWEEN THE BOTTOM OF THE UNITS AND THE BRIDGE SEAT. THIS COMPRESSIBLE SEALER SHALL SURROUND THE 2 1/2" DIA SLEEVE IN THE UNIT. THE PURPOSE OF THE SEALER IS TO FACILITATE PLACEMENT OF THE GROUT AROUND THE ANCHOR BOLTS.
2. GROUT ANCHOR BOLTS INTO THE SLEEVES. BEFORE THE GROUT CURES, PLACE THE WASHER PLATE AND INSTALL THE NUT ON TOP AND TIGHTEN.
3. PAYMENT FOR BEAM ANCHORAGE, INCLUDING ALL MATERIALS, LABOR, AND INCIDENTALS WILL BE INCLUDED IN THE UNIT PRICE BID FOR PRESTRESSED CONCRETE NON-VOIDED SLABS.

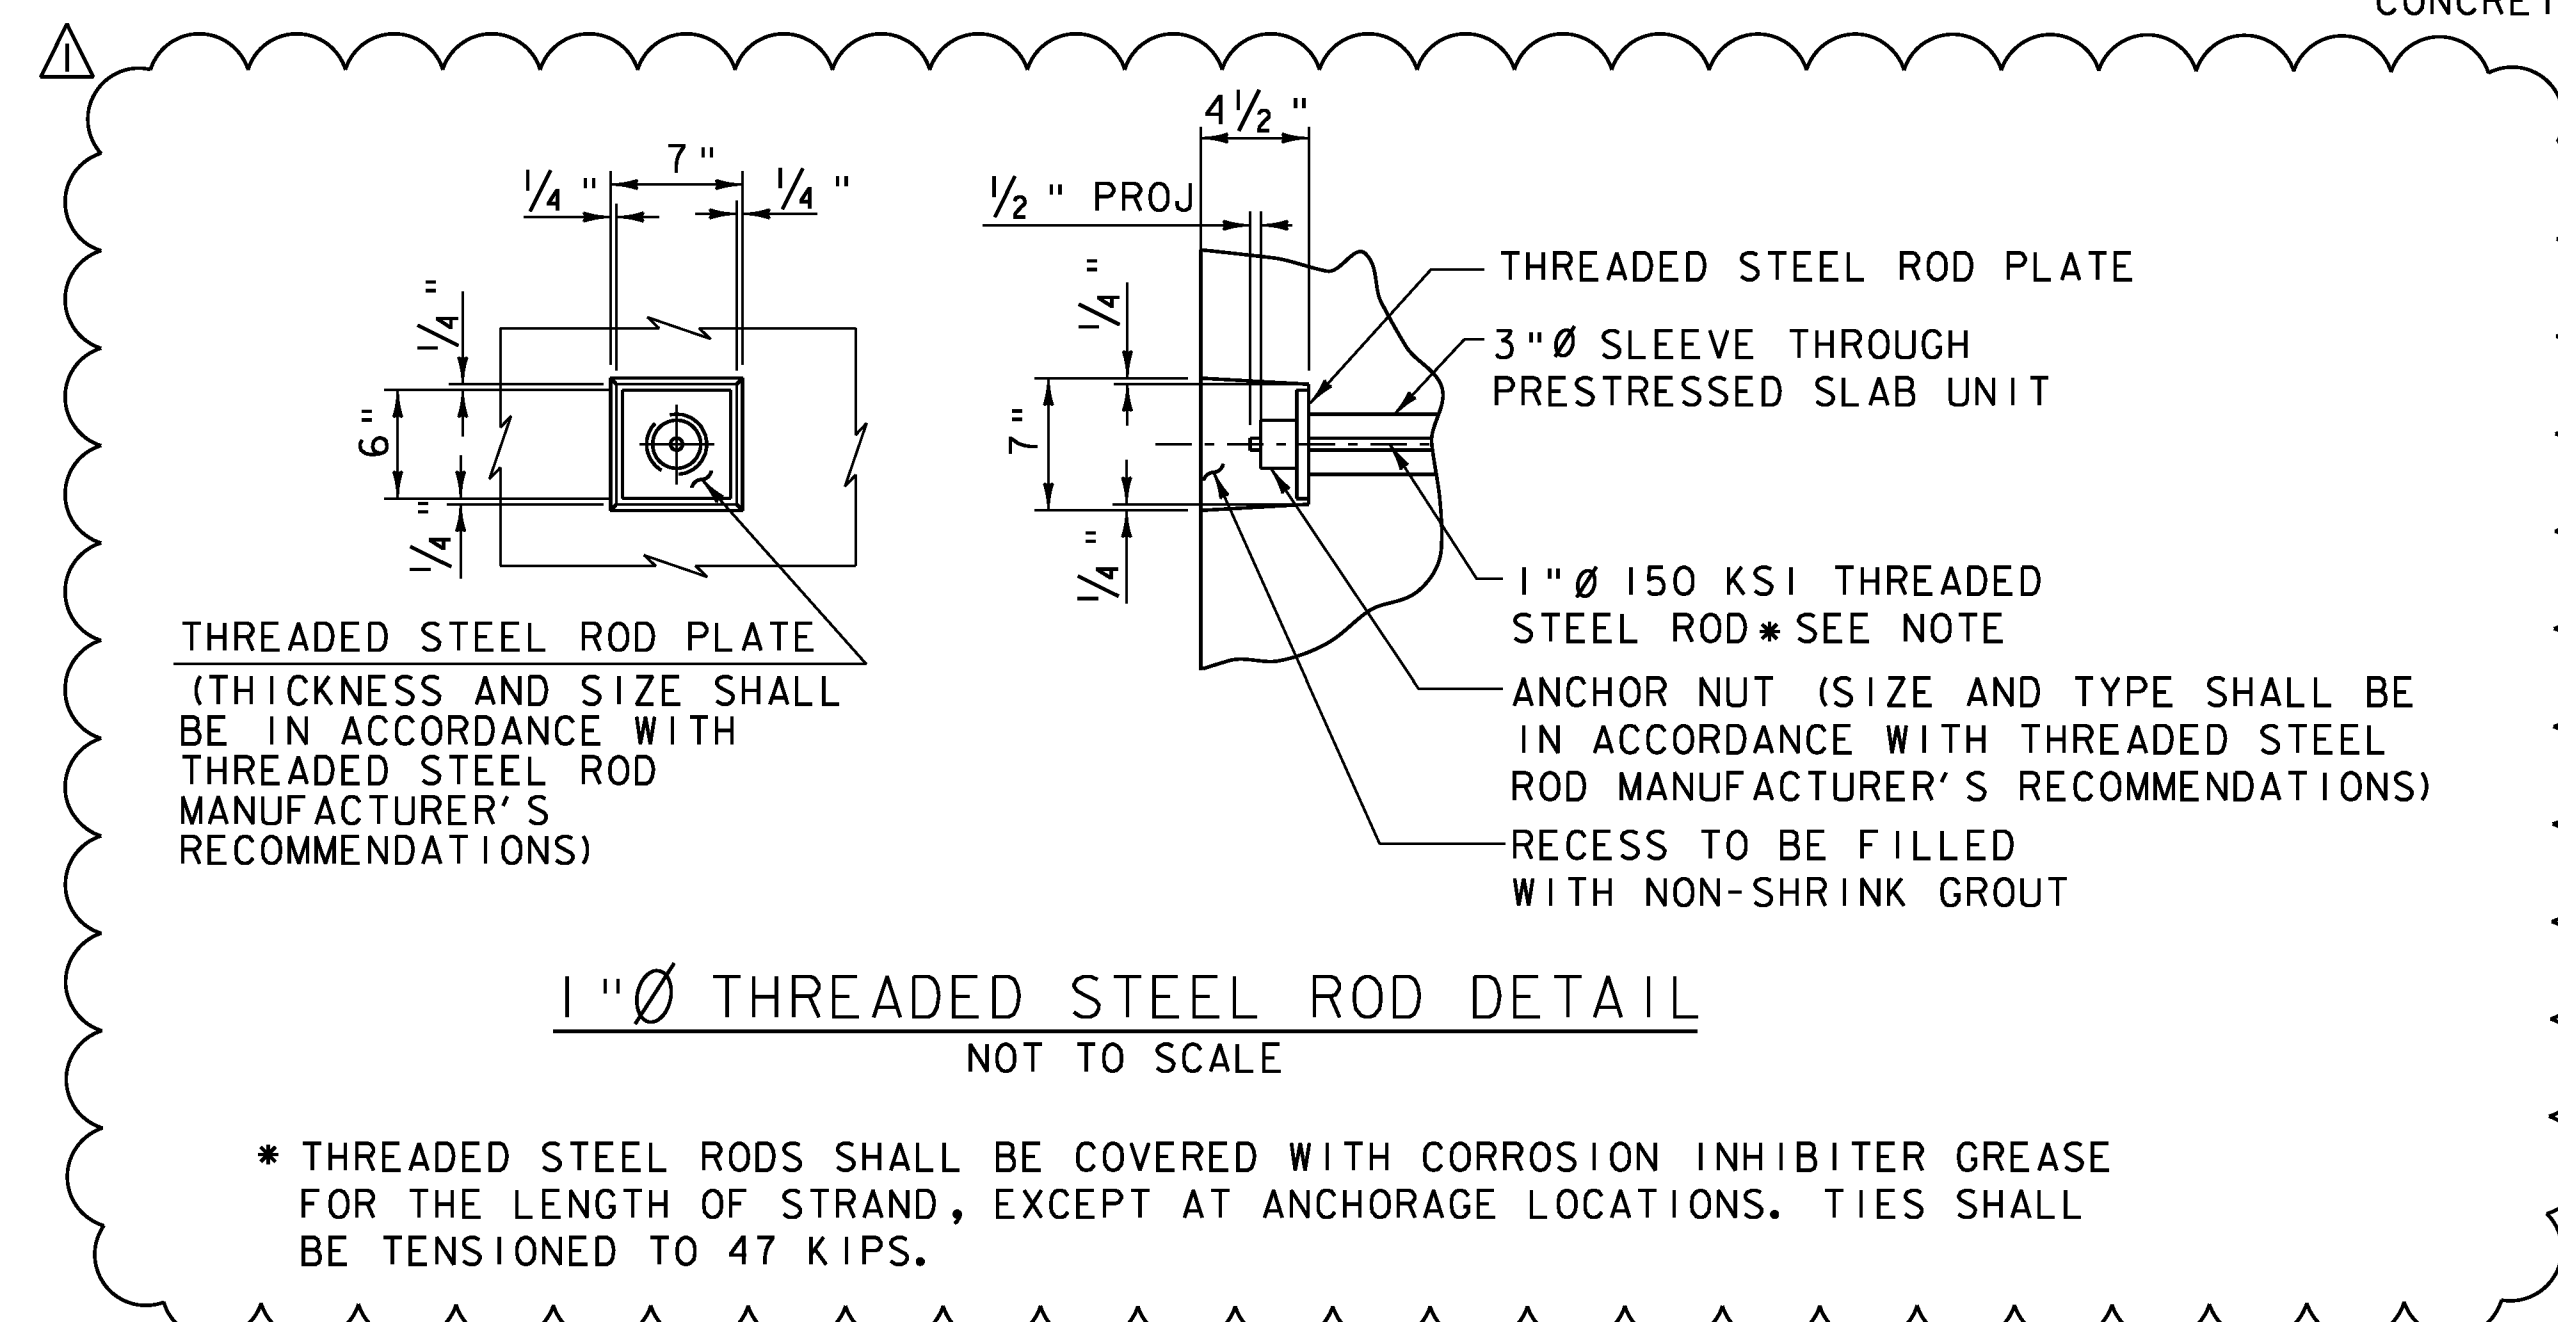


* THREADED STEEL RODS SHALL BE COVERED WITH CORROSION INHIBITOR GREASE FOR THE LENGTH OF STRAND, EXCEPT AT ANCHORAGE LOCATIONS. TIES SHALL BE TENSIONED TO 47 KIPS.

REV.	DESCRIPTION	DATE
△	THREADED STEEL ROD DETAILS	11/20/2013
PROJECT NAME: BRATTLEBORO		
PROJECT NUMBER: BRO 1442(35)		
FILE NAME: z10J062reinfn.dgn		PLOT DATE: 11/20/2013
PROJECT LEADER: S.E. BURBANK		DRAWN BY: J.L. LEMIEUX
DESIGNED BY: B.M. KLINEFELTER		CHECKED BY: S.E. BURBANK
PRESTRESSED BEAM DETAILS		SHEET 37 OF 68

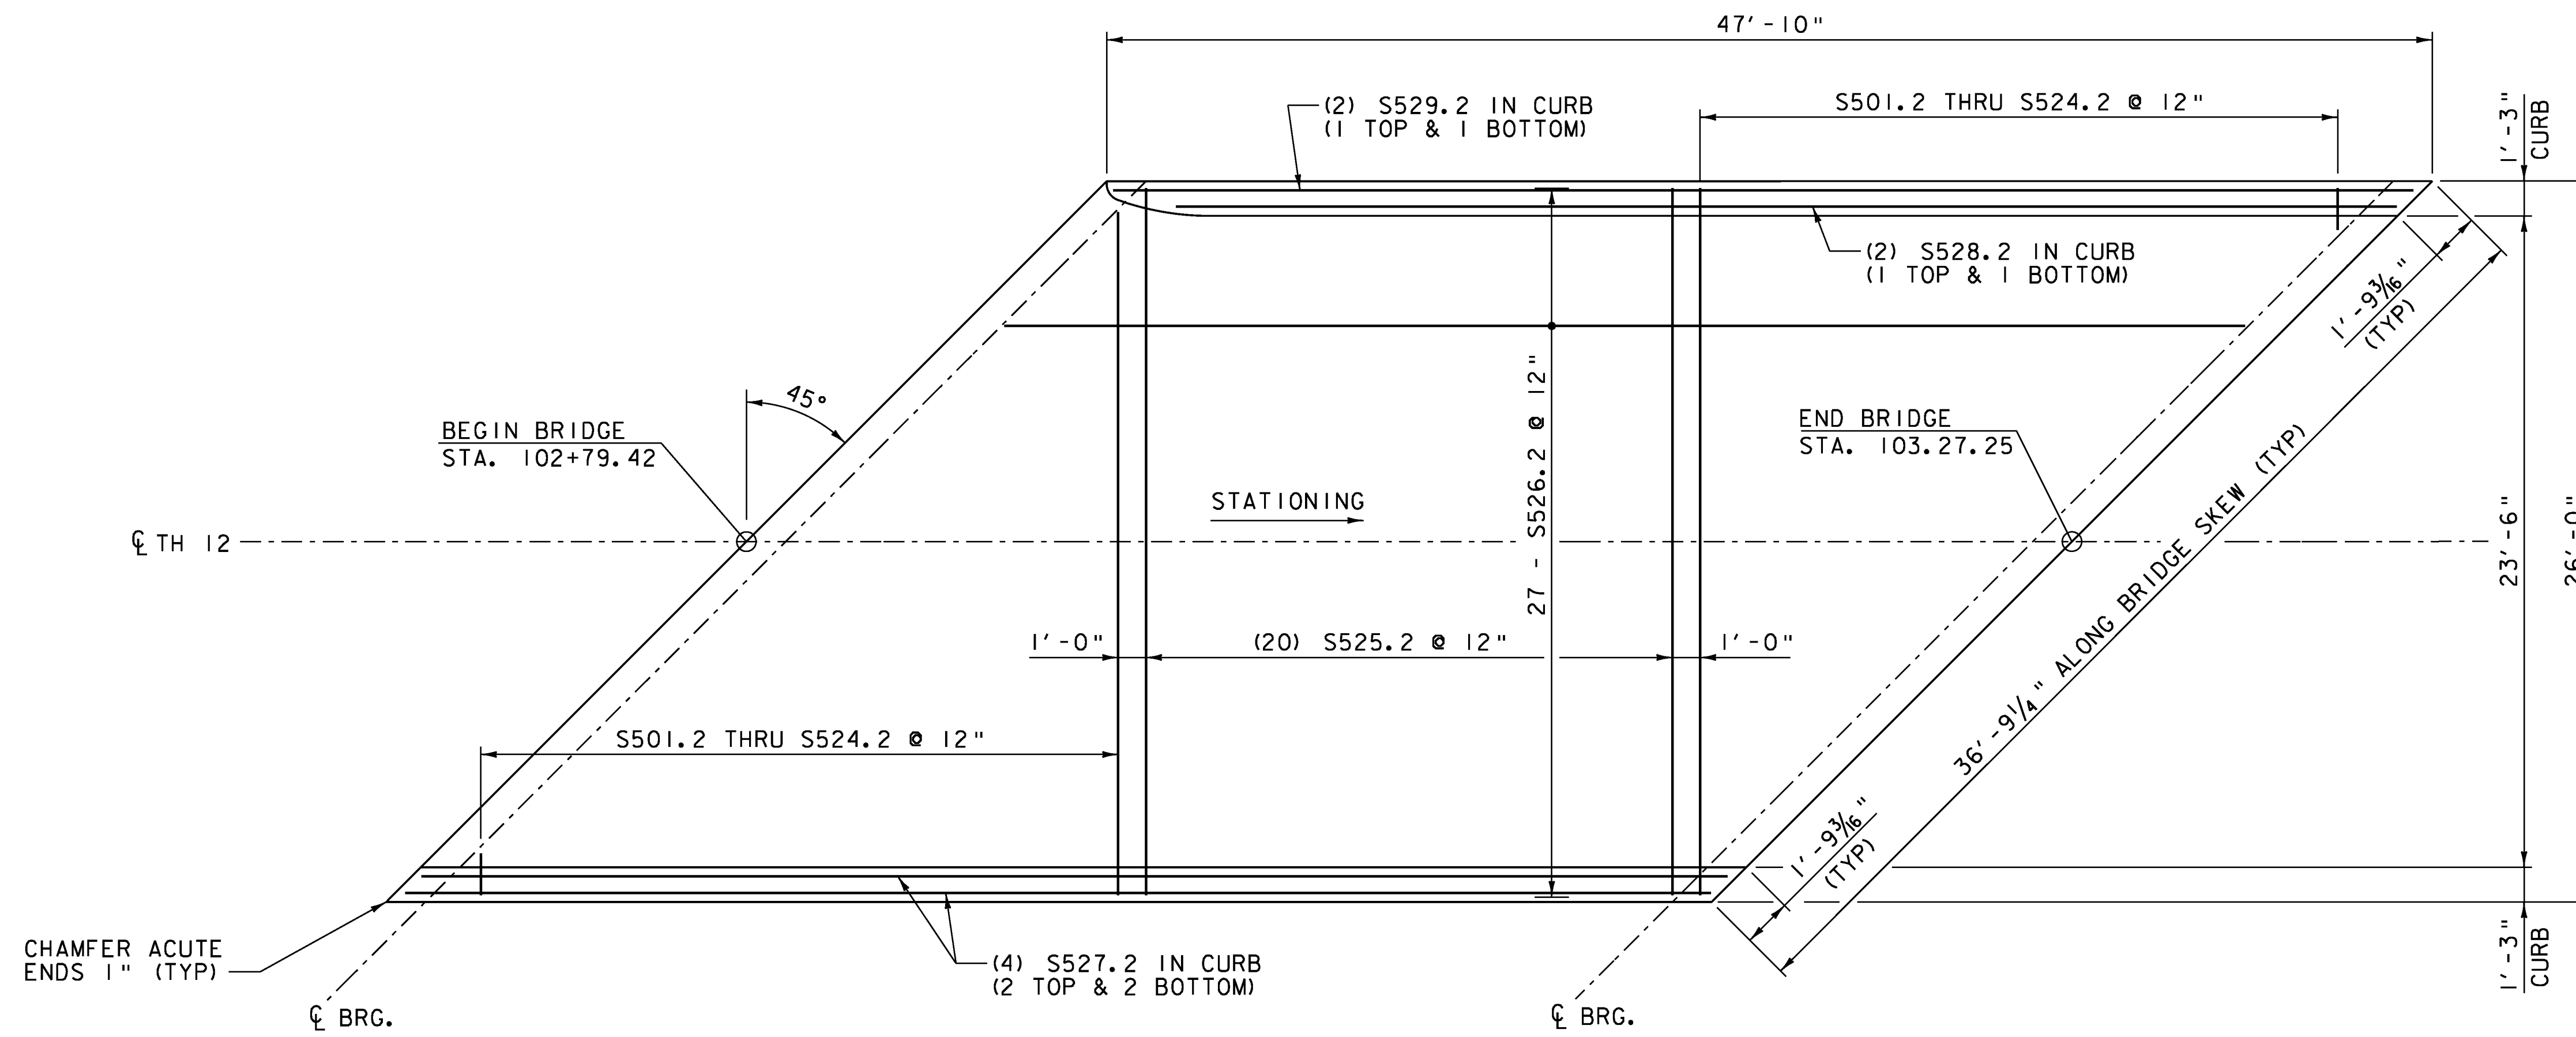


OVERLAY REINFORCING PLAN  
SCALE 1/4" = 1'-0"

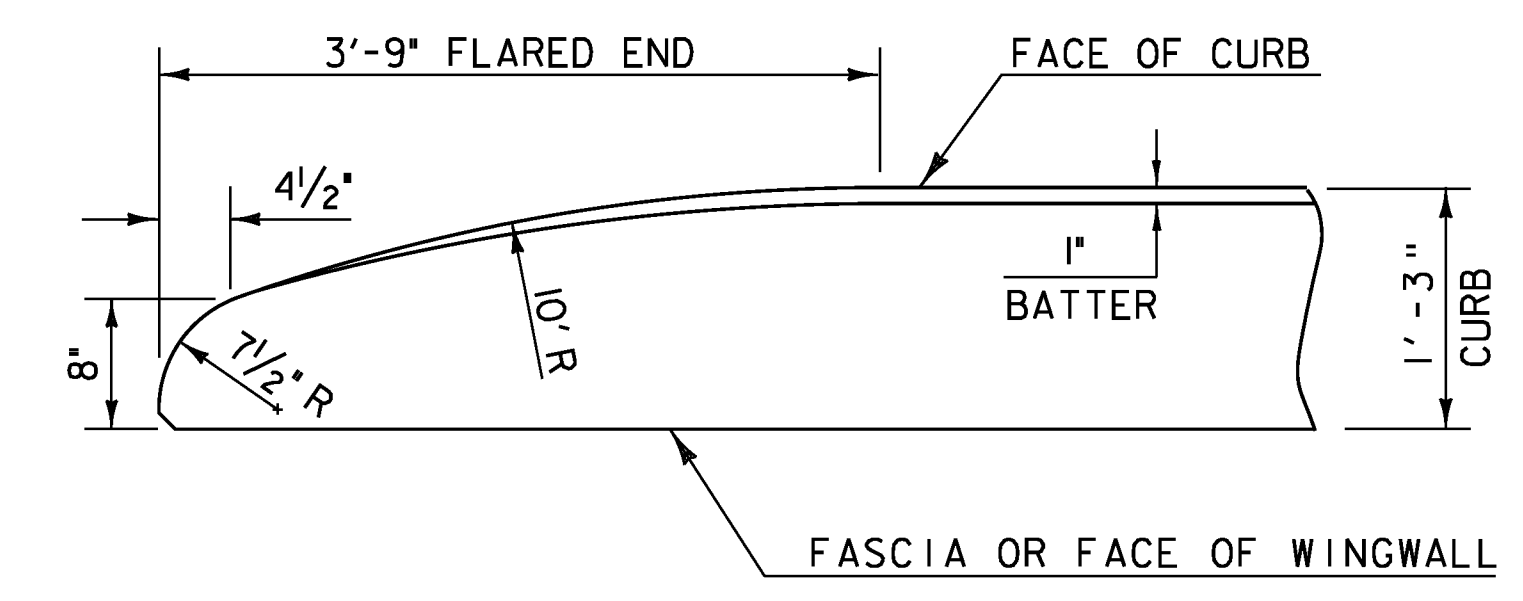

FLARED END DETAIL FOR 1'-3" CURB

CURB REINFORCING STIRRUP BARS SHALL BE TURNED AS REQUIRED TO FIT FLARED ENDS.

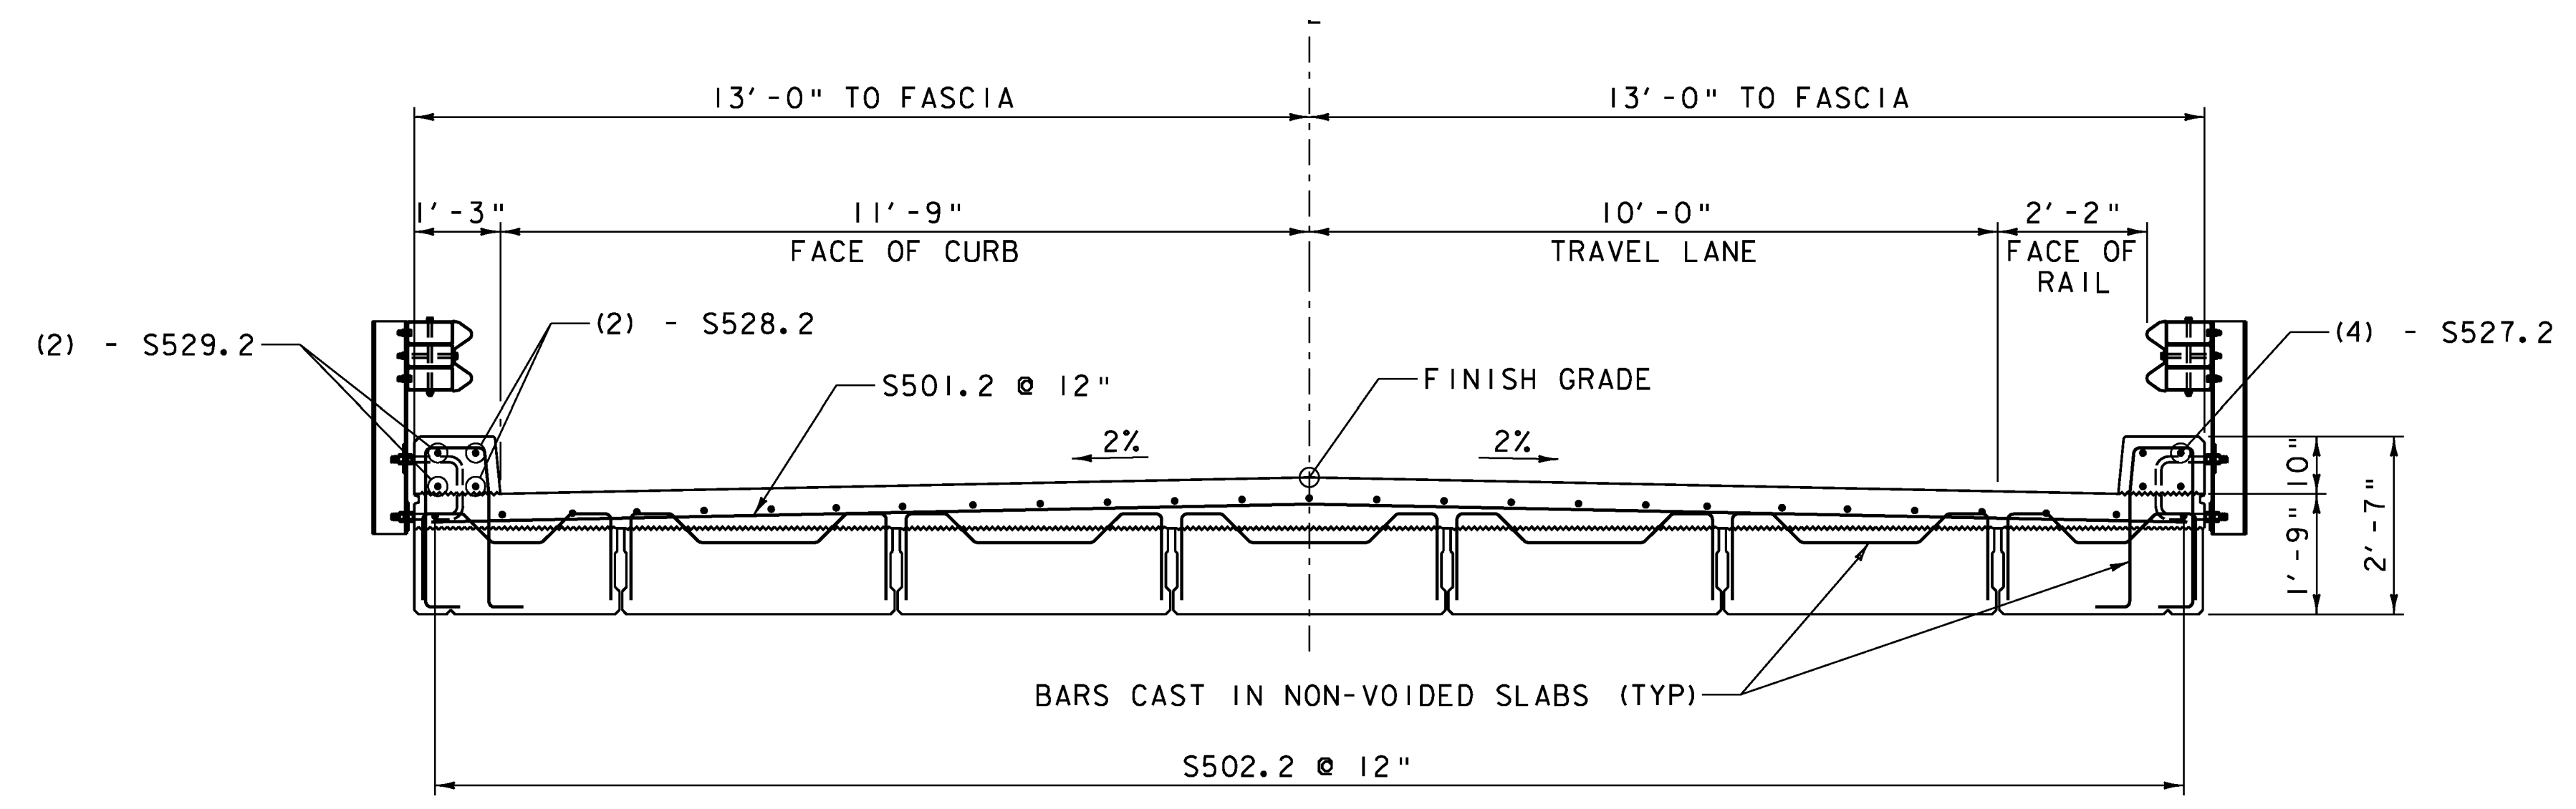


TYPICAL OVERLAY REINFORCEMENT  
SCALE 1/2" = 1'-0"


NOTE:  
 NF = NEAR FACE  
 FF = FAR FACE  
 EF = EACH FACE  
 ▲ = CUT TO FIT IN FIELD  
 3" CLEAR, UNLESS OTHERWISE SPECIFIED ON THE PLANS.  
 2'-2" BAR LAP UNLESS SPECIFIED ON THE PLANS.

PROJECT NAME: BRATTLEBORO	PLOT DATE: 10/14/2013
PROJECT NUMBER: BRO 1442(35)	DRAWN BY: J.L. LEMIEUX
FILE NAME: z10J062deck.dgn	CHECKED BY: S.E. BURBANK
PROJECT LEADER: S.E. BURBANK	SHEET 38 OF 68
DESIGNED BY: B.M. KLINEFELTER	
OVERLAY REINFORCING DETAILS	



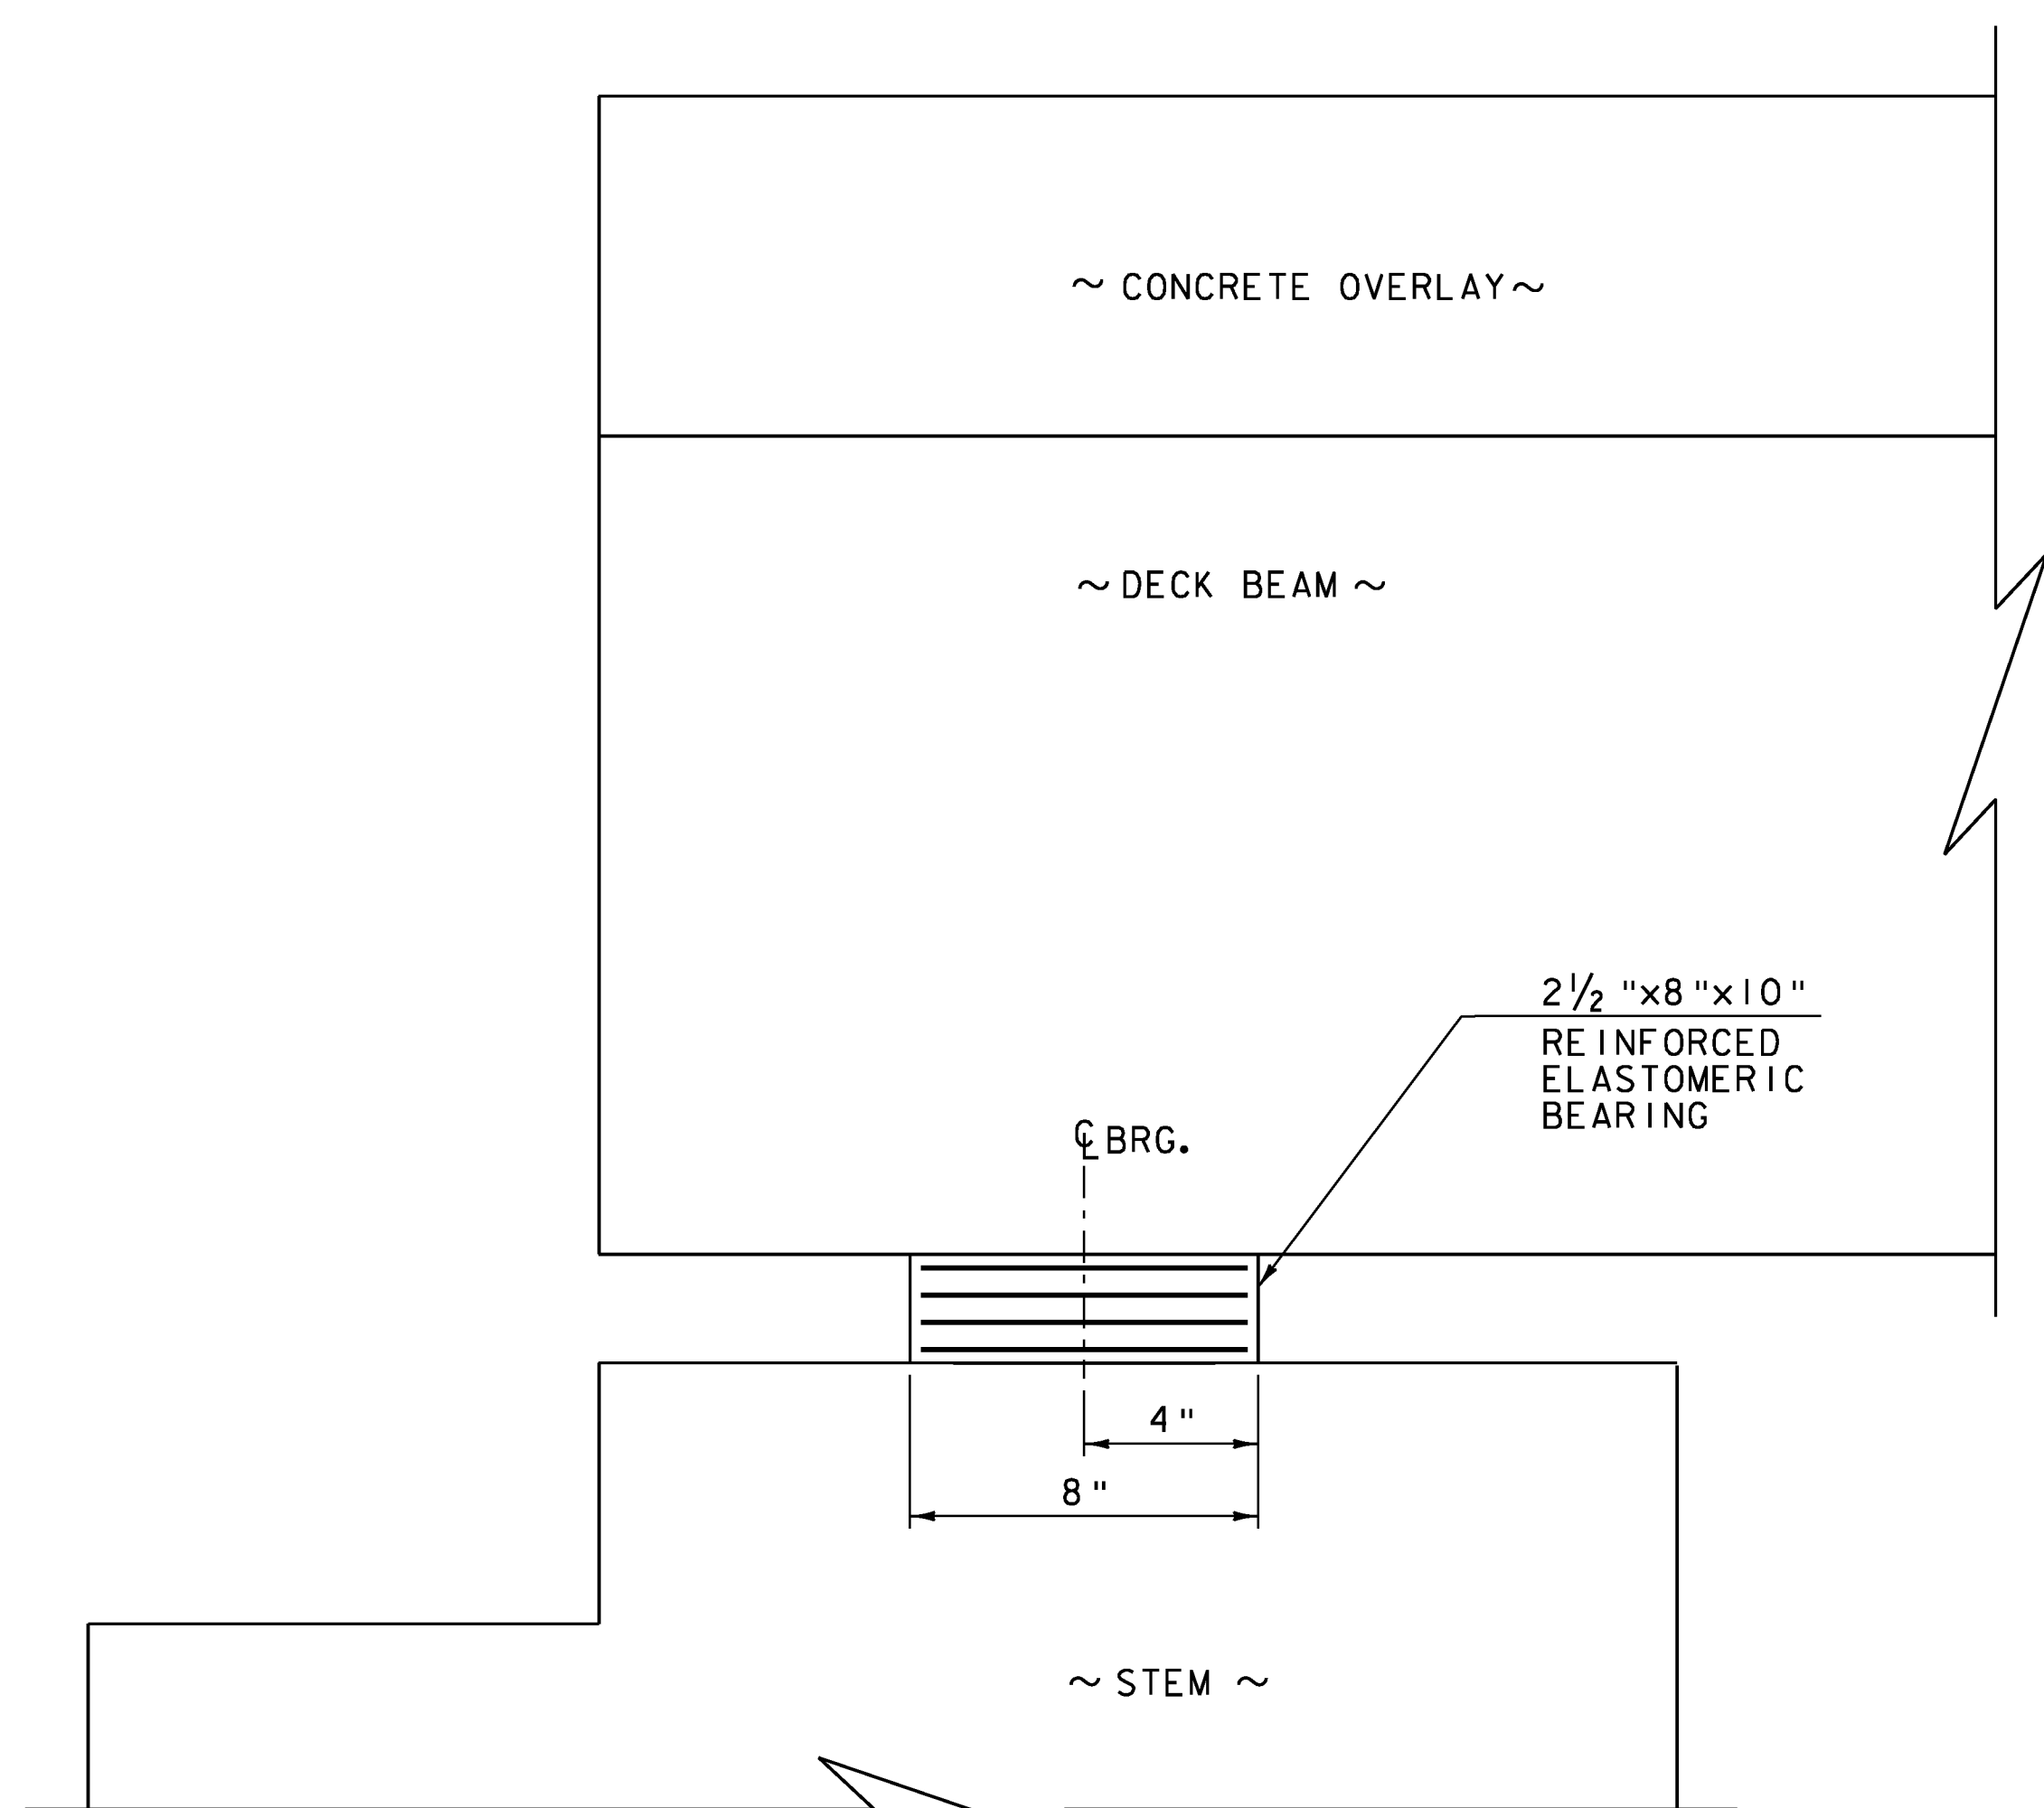


ELASTOMERIC BEARING  
SIDE ELEVATION  
SCALE 3" = 1'-0"

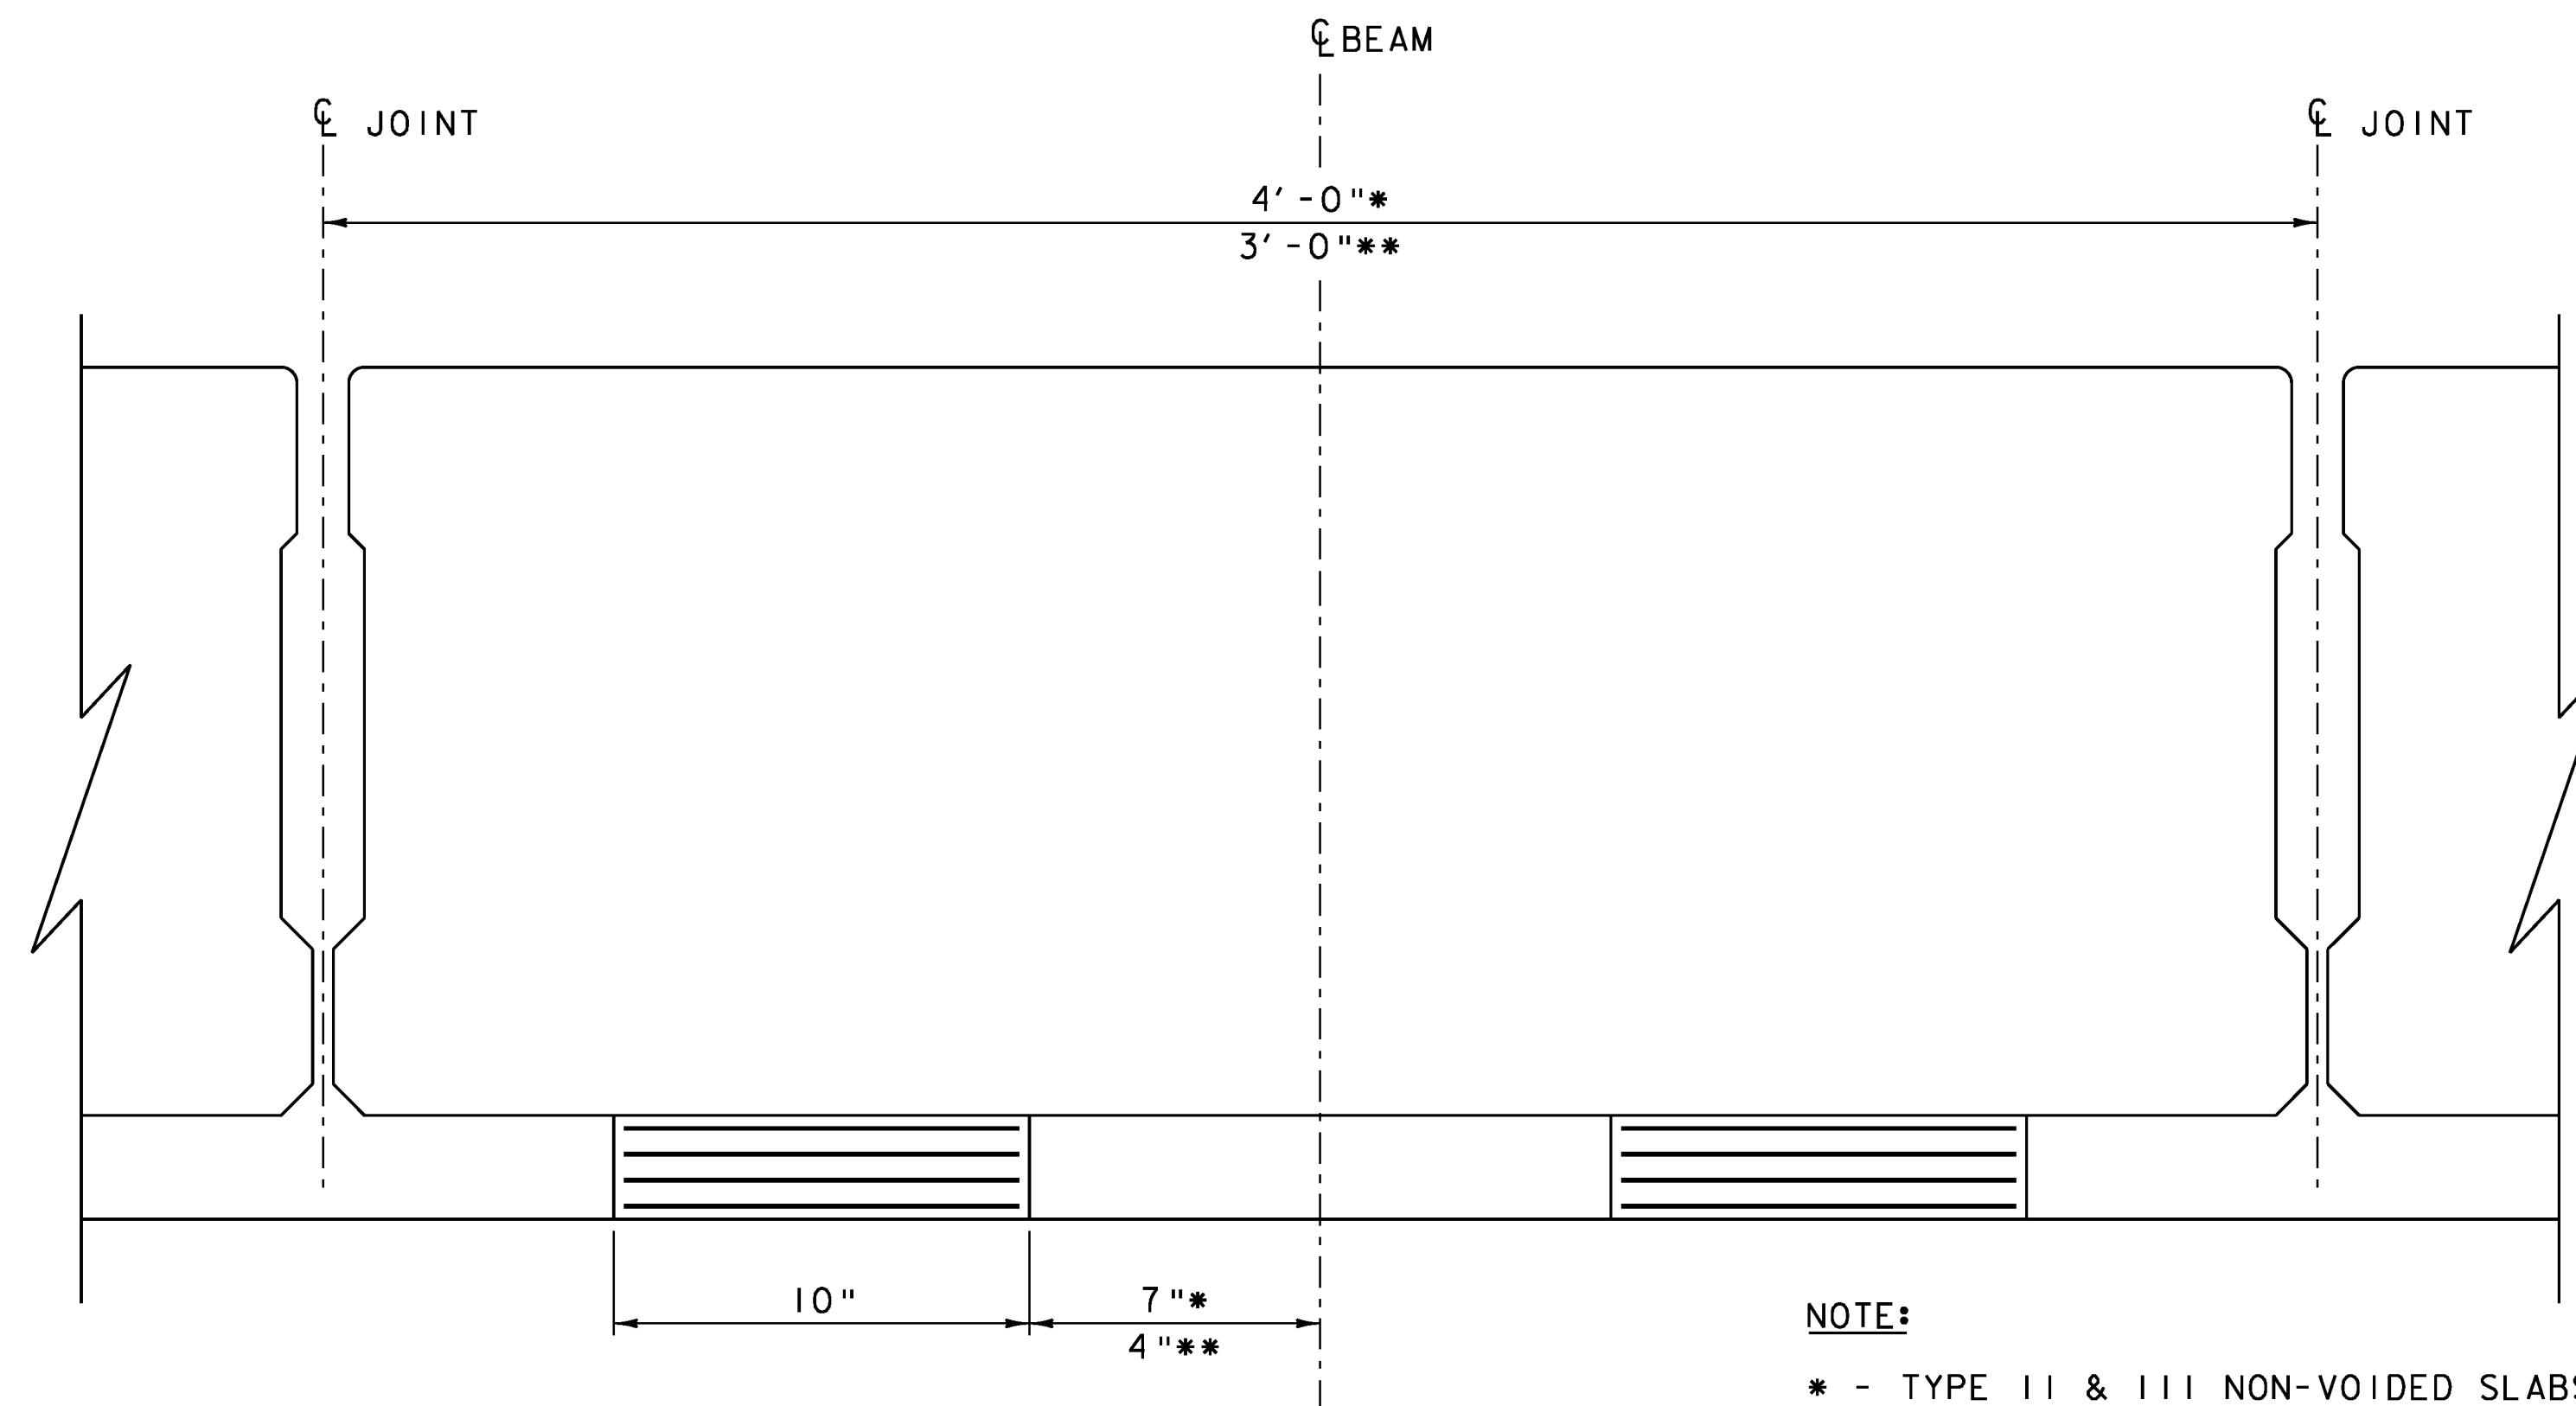


ELASTOMERIC BEARING  
FRONT ELEVATION  
SCALE 3" = 1'-0"

NOTE:


* - TYPE II & III NON-VOIDED SLABS  
** - TYPE I NON-VOIDED SLABS

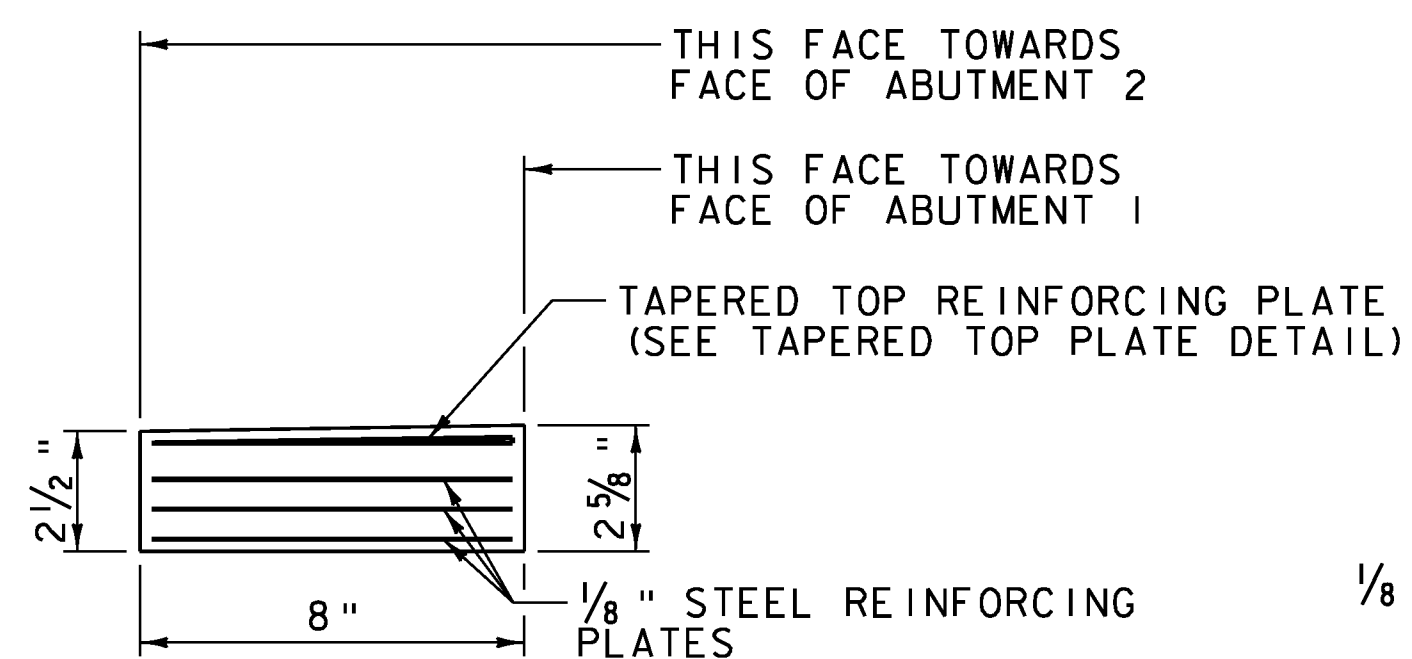

ELASTOMERIC BEARING SIDE VIEW  
SCALE 3" = 1'-0"

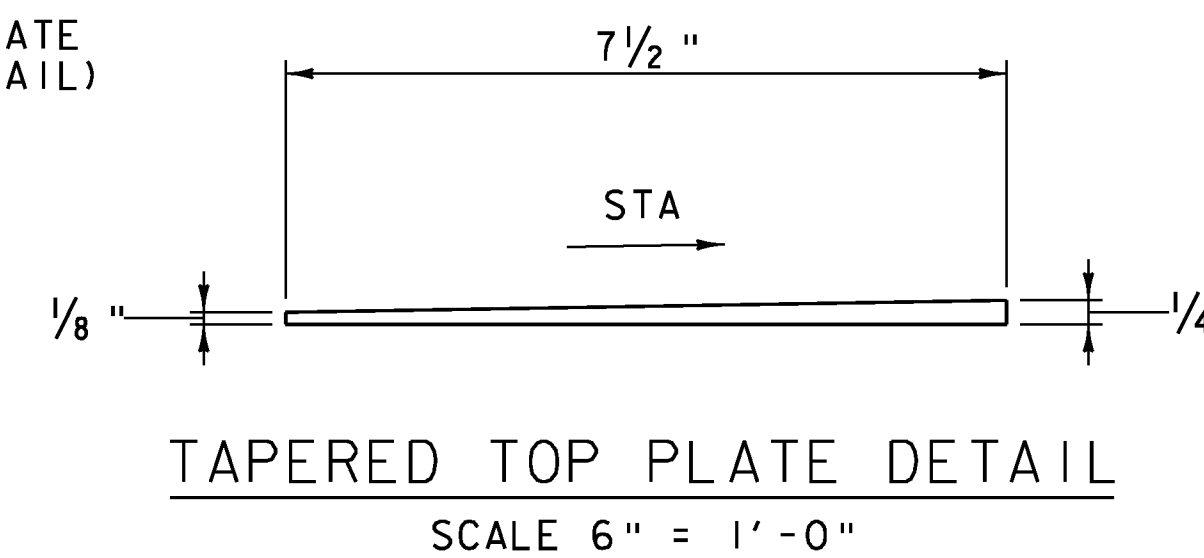

TAPERED TOP PLATE DETAIL  
SCALE 6" = 1'-0"

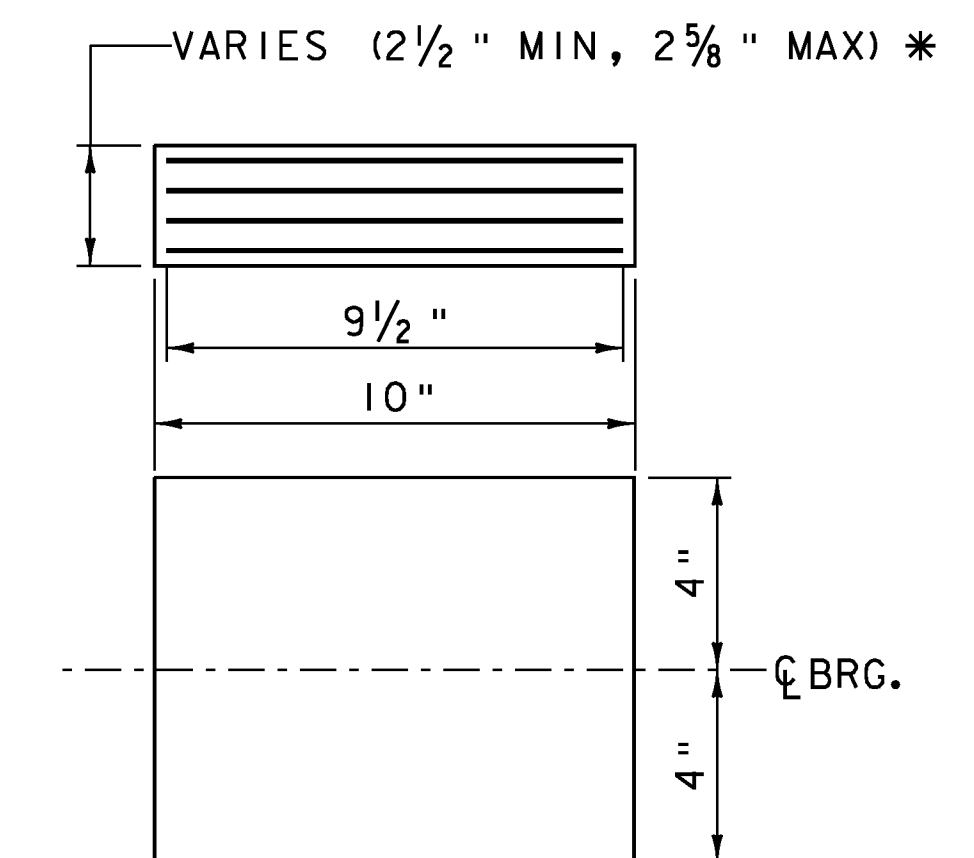

ELASTOMERIC BEARING  
PLAN VIEW  
SCALE 3" = 1'-0"

**BEARING NOTES**

1. BEARINGS SHALL CONFORM TO THE APPLICABLE SUBSECTIONS OF SECTIONS 531 AND 731.
2. THE BEARINGS, INCLUDING ANCHOR BOLTS, DRILLING AND GROUTING, AND WASHERS AND NUTS SHALL BE PAID FOR UNDER ITEM 531.17 "BEARING DEVICE ASSEMBLY, STEEL REINFORCED ELASTOMER PAD."
3. ALL PLATES, NUTS, WASHERS AND ANCHOR BOLTS SHALL BE GALVANIZED OR METALIZED AS PER SUBSECTIONS 726.08 AND 726.09. AREAS OF GALVANIZING OR METALIZING DAMAGED BY FIELD WELDING OR HANDLING SHALL BE REPAIRED IN CONFORMANCE WITH SUBSECTIONS 726.08 AND 726.09.
4. ALL REINFORCEMENT BETWEEN LAYERS OF ELASTOMER SHALL BE STEEL, MEETING THE REQUIREMENTS OF SUBSECTION 714.02. ALL INTERNAL STEEL PLATES SHALL BE SAND BLASTED AND FREE OF COATINGS, RUST AND MILL SCALE. THE PLATES SHALL BE FREE OF SHARP EDGES AND BURRS.
5. ANCHOR BOLTS SHALL BE ASTM F1554, GRADE 55 AND MEET THE REQUIREMENTS OF SUBSECTION 714.08.
6. STEEL REINFORCED ELASTOMERIC BEARINGS SHALL HAVE A MINIMUM 1/4" EDGE SEAL OF ELASTOMER INTEGRAL WITH BEARING OVER ALL INTERNAL PLATES.





7. THE ELASTOMER WAS DESIGNED USING METHOD A WITH A SHEAR MODULUS OF 100 PSI.
8. THE ELASTOMER SHALL MEET THE REQUIREMENTS OF LOW TEMPERATURE ZONE D, GRADE 4.
9. THE CONCRETE UNDER THE BEARING DEVICE SHALL BE LEVEL IN THE LONGITUDINAL DIRECTION
10. ALL DESIGNS DONE FOR THE BEARINGS SHALL BE PER THE AASHTO LRFD BRIDGE DESIGN SPECIFICATIONS 6TH EDITION AND ITS LATEST REVISIONS.
11. ALTERNATIVE CONFIGURATIONS FOR BEARINGS MAY BE SUBMITTED FOR APPROVAL. ANY ALTERNATE SUBMITTED SHALL BE DESIGNED AND CERTIFIED TO MEET THE DESIGN LOADS AND CRITERIA SHOWN ON THE PLANS.
12. BRIDGE SEAT ELEVATIONS MAY BE REVISED TO ACCOMMODATE AN ALTERNATIVE CONFIGURATION.
13. DESIGN CRITERIA:
  - A.) HORIZONTAL CAPACITY SHALL BE A MINIMUM OF 15% VERTICAL LOAD IN ANY UNRESTRAINED DIRECTION.
  - B.) DESIGN LOAD PER BEARING
    - DL = 15 KIPS
    - LL = 25 KIPS W/O IMPACT

- * (2) 1/4" EXTERIOR LAYERS OF ELASTOMER
- (3) 1/2" INTERIOR LAYERS OF ELASTOMER
- (3) 1/8" STEEL REINFORCING PLATES
- (1) TAPERED STEEL REINFORCING TOP PLATE (SEE DETAIL)

PROJECT NAME: BRATTLEBORO  
PROJECT NUMBER: BRO 1442(35)

FILE NAME: z10J062sup.dgn  
PROJECT LEADER: S.E. BURBANK  
DESIGNED BY: E.A. FIALA  
BEARING DETAILS

PLOT DATE: 10/14/2013  
DRAWN BY: J.L. LEMIEUX  
CHECKED BY: S.E. BURBANK  
SHEET 39 OF 68

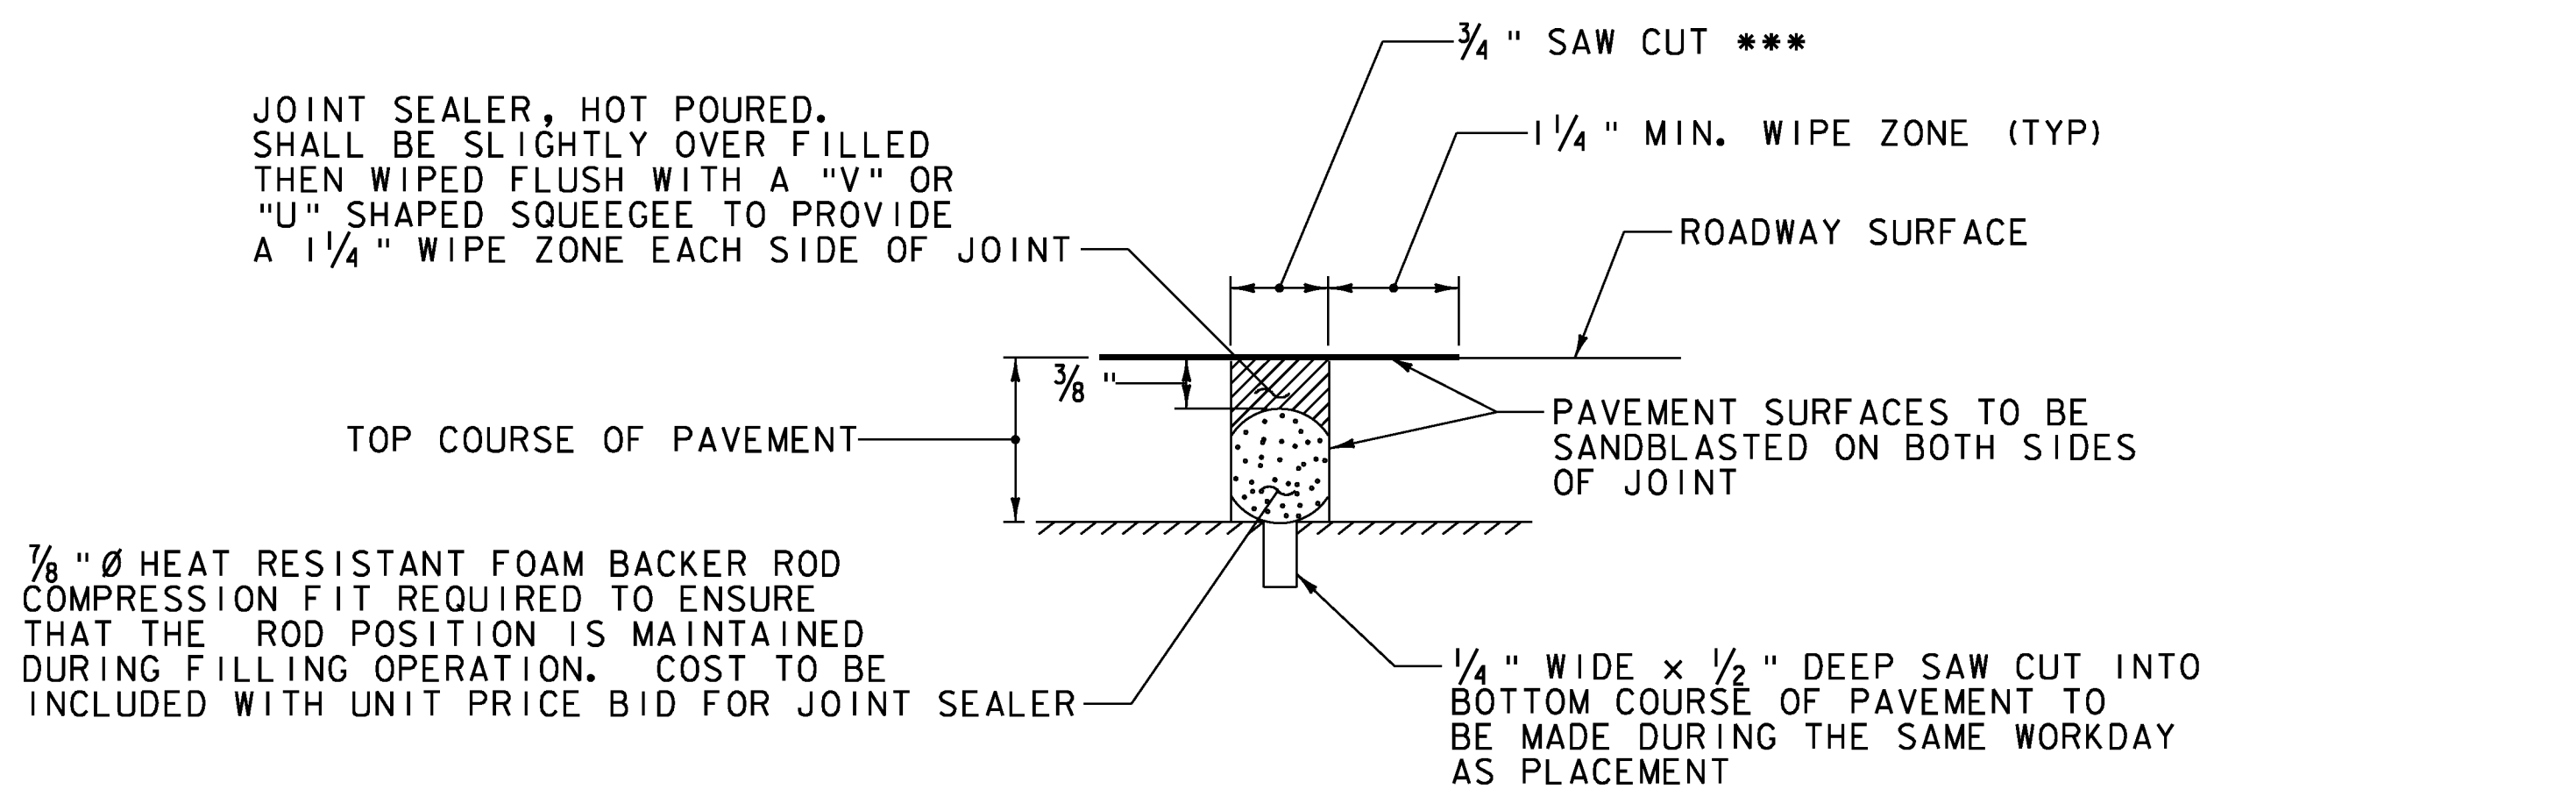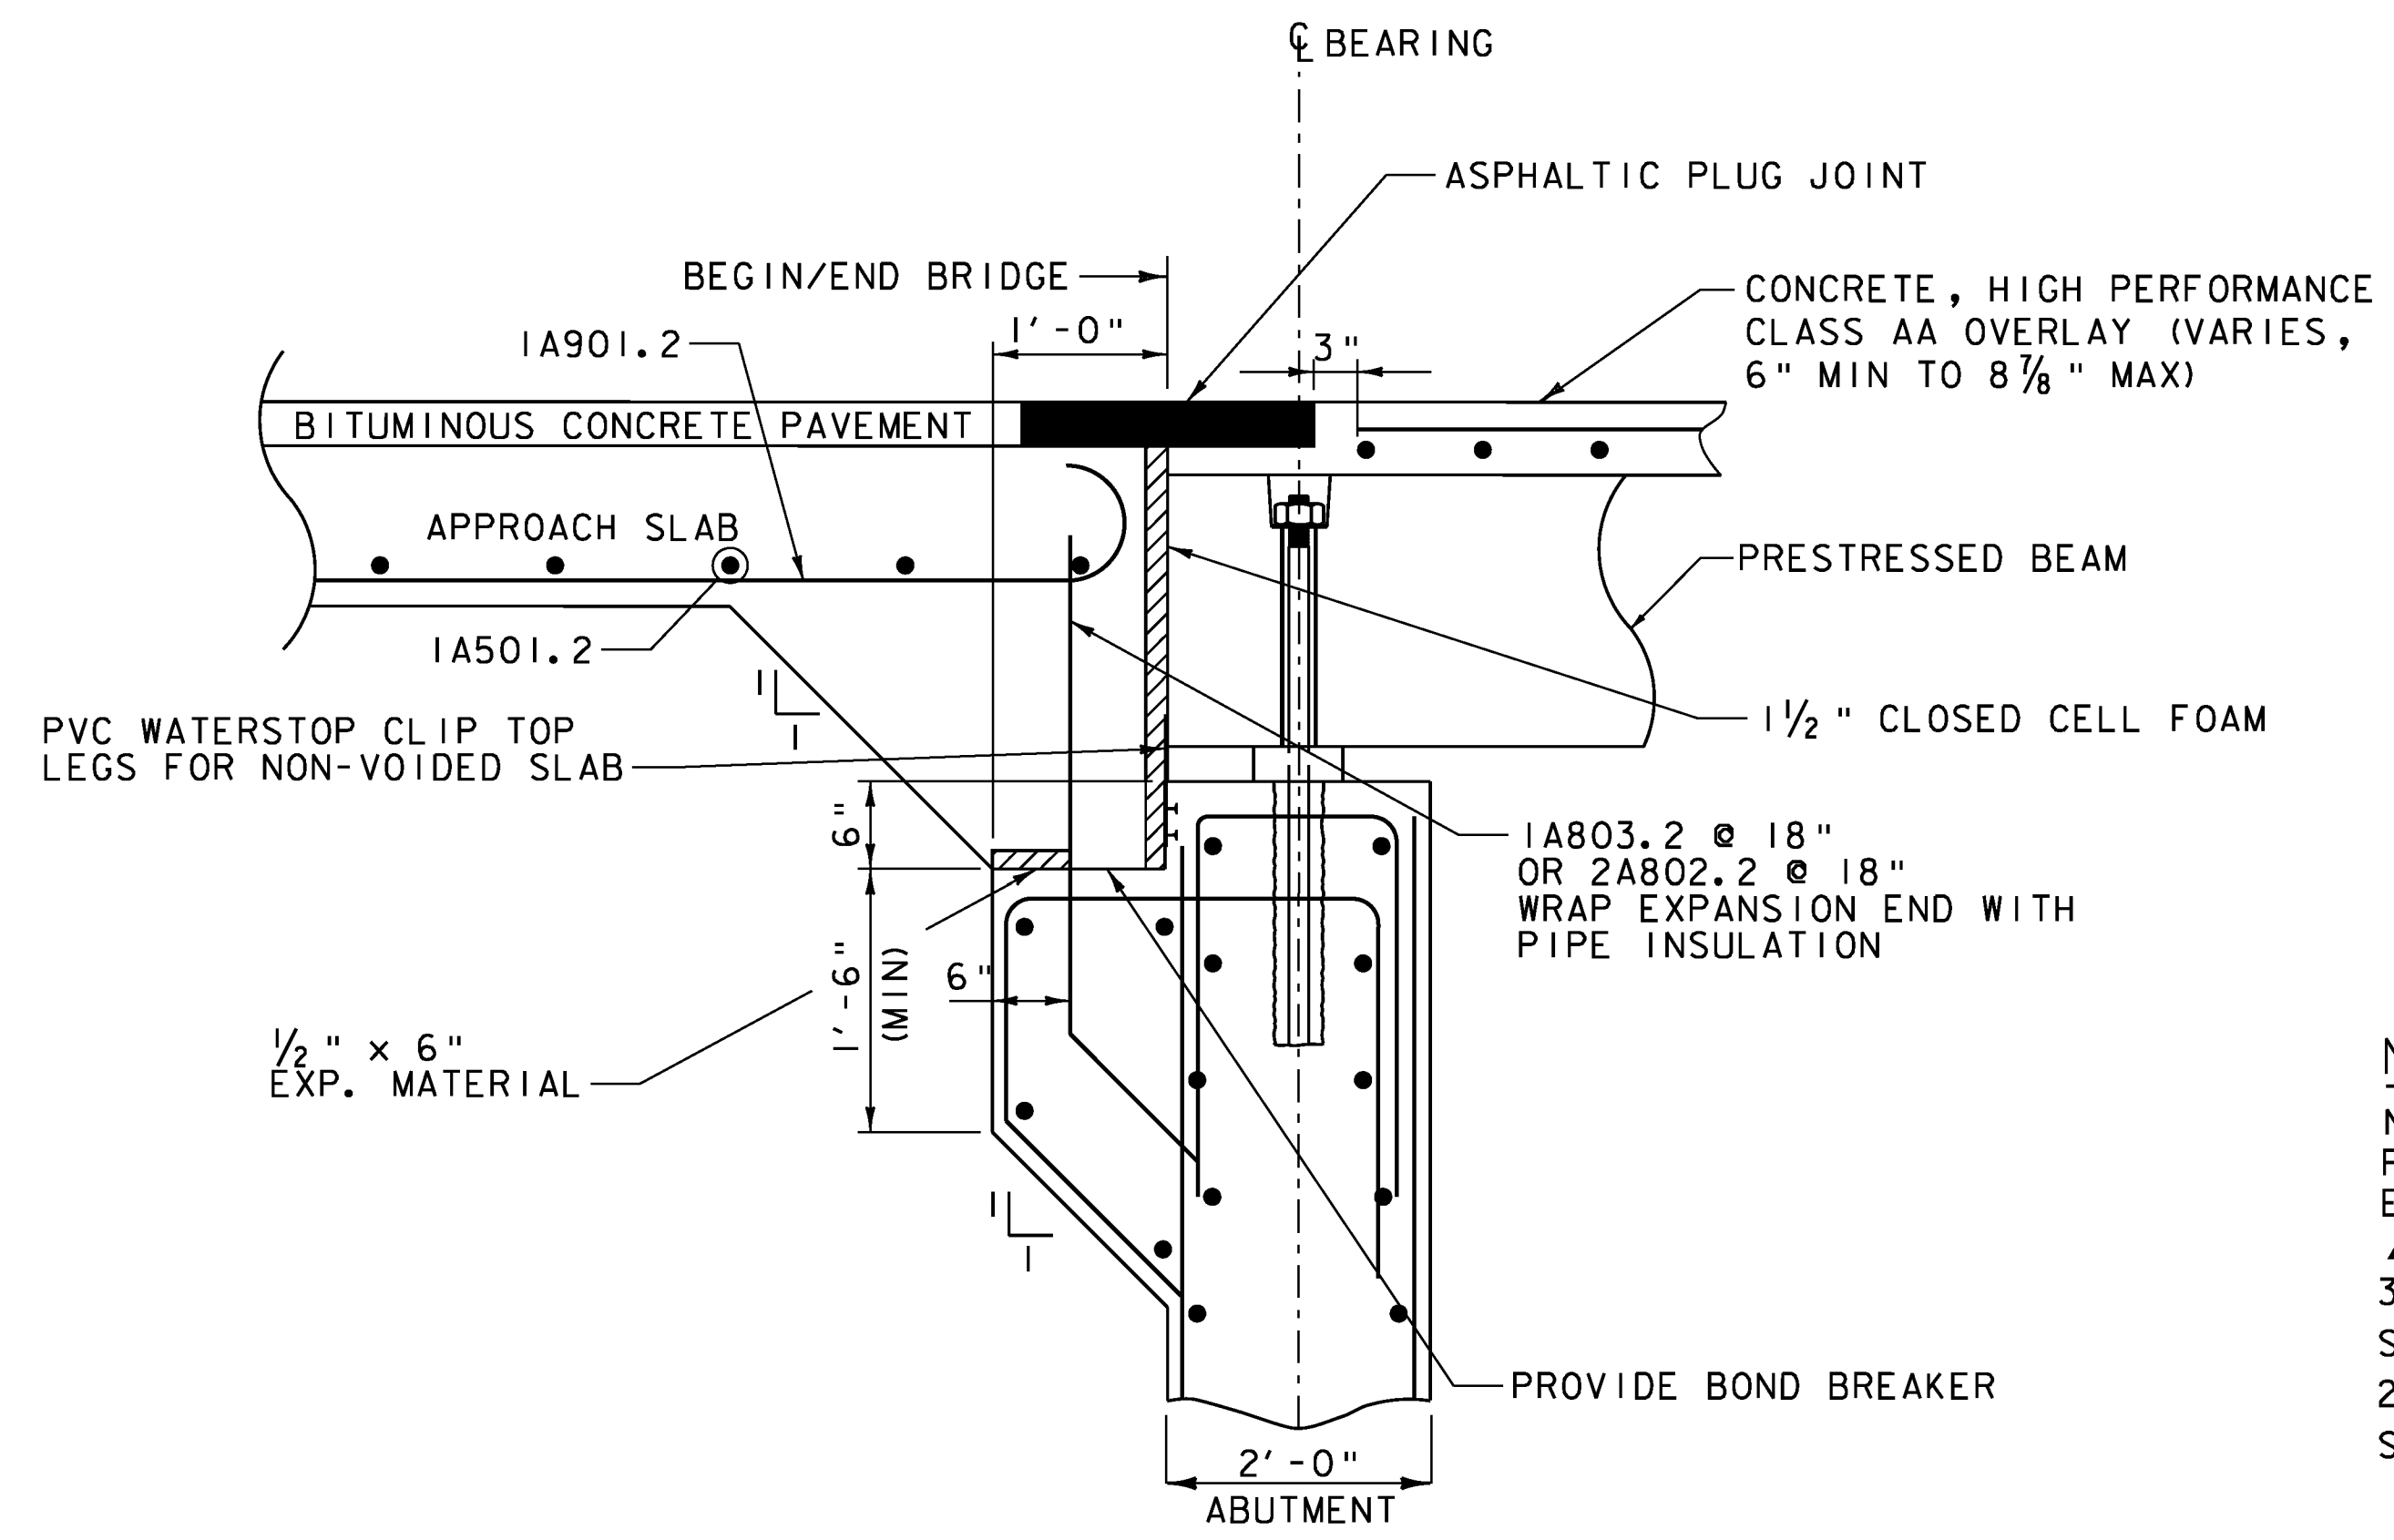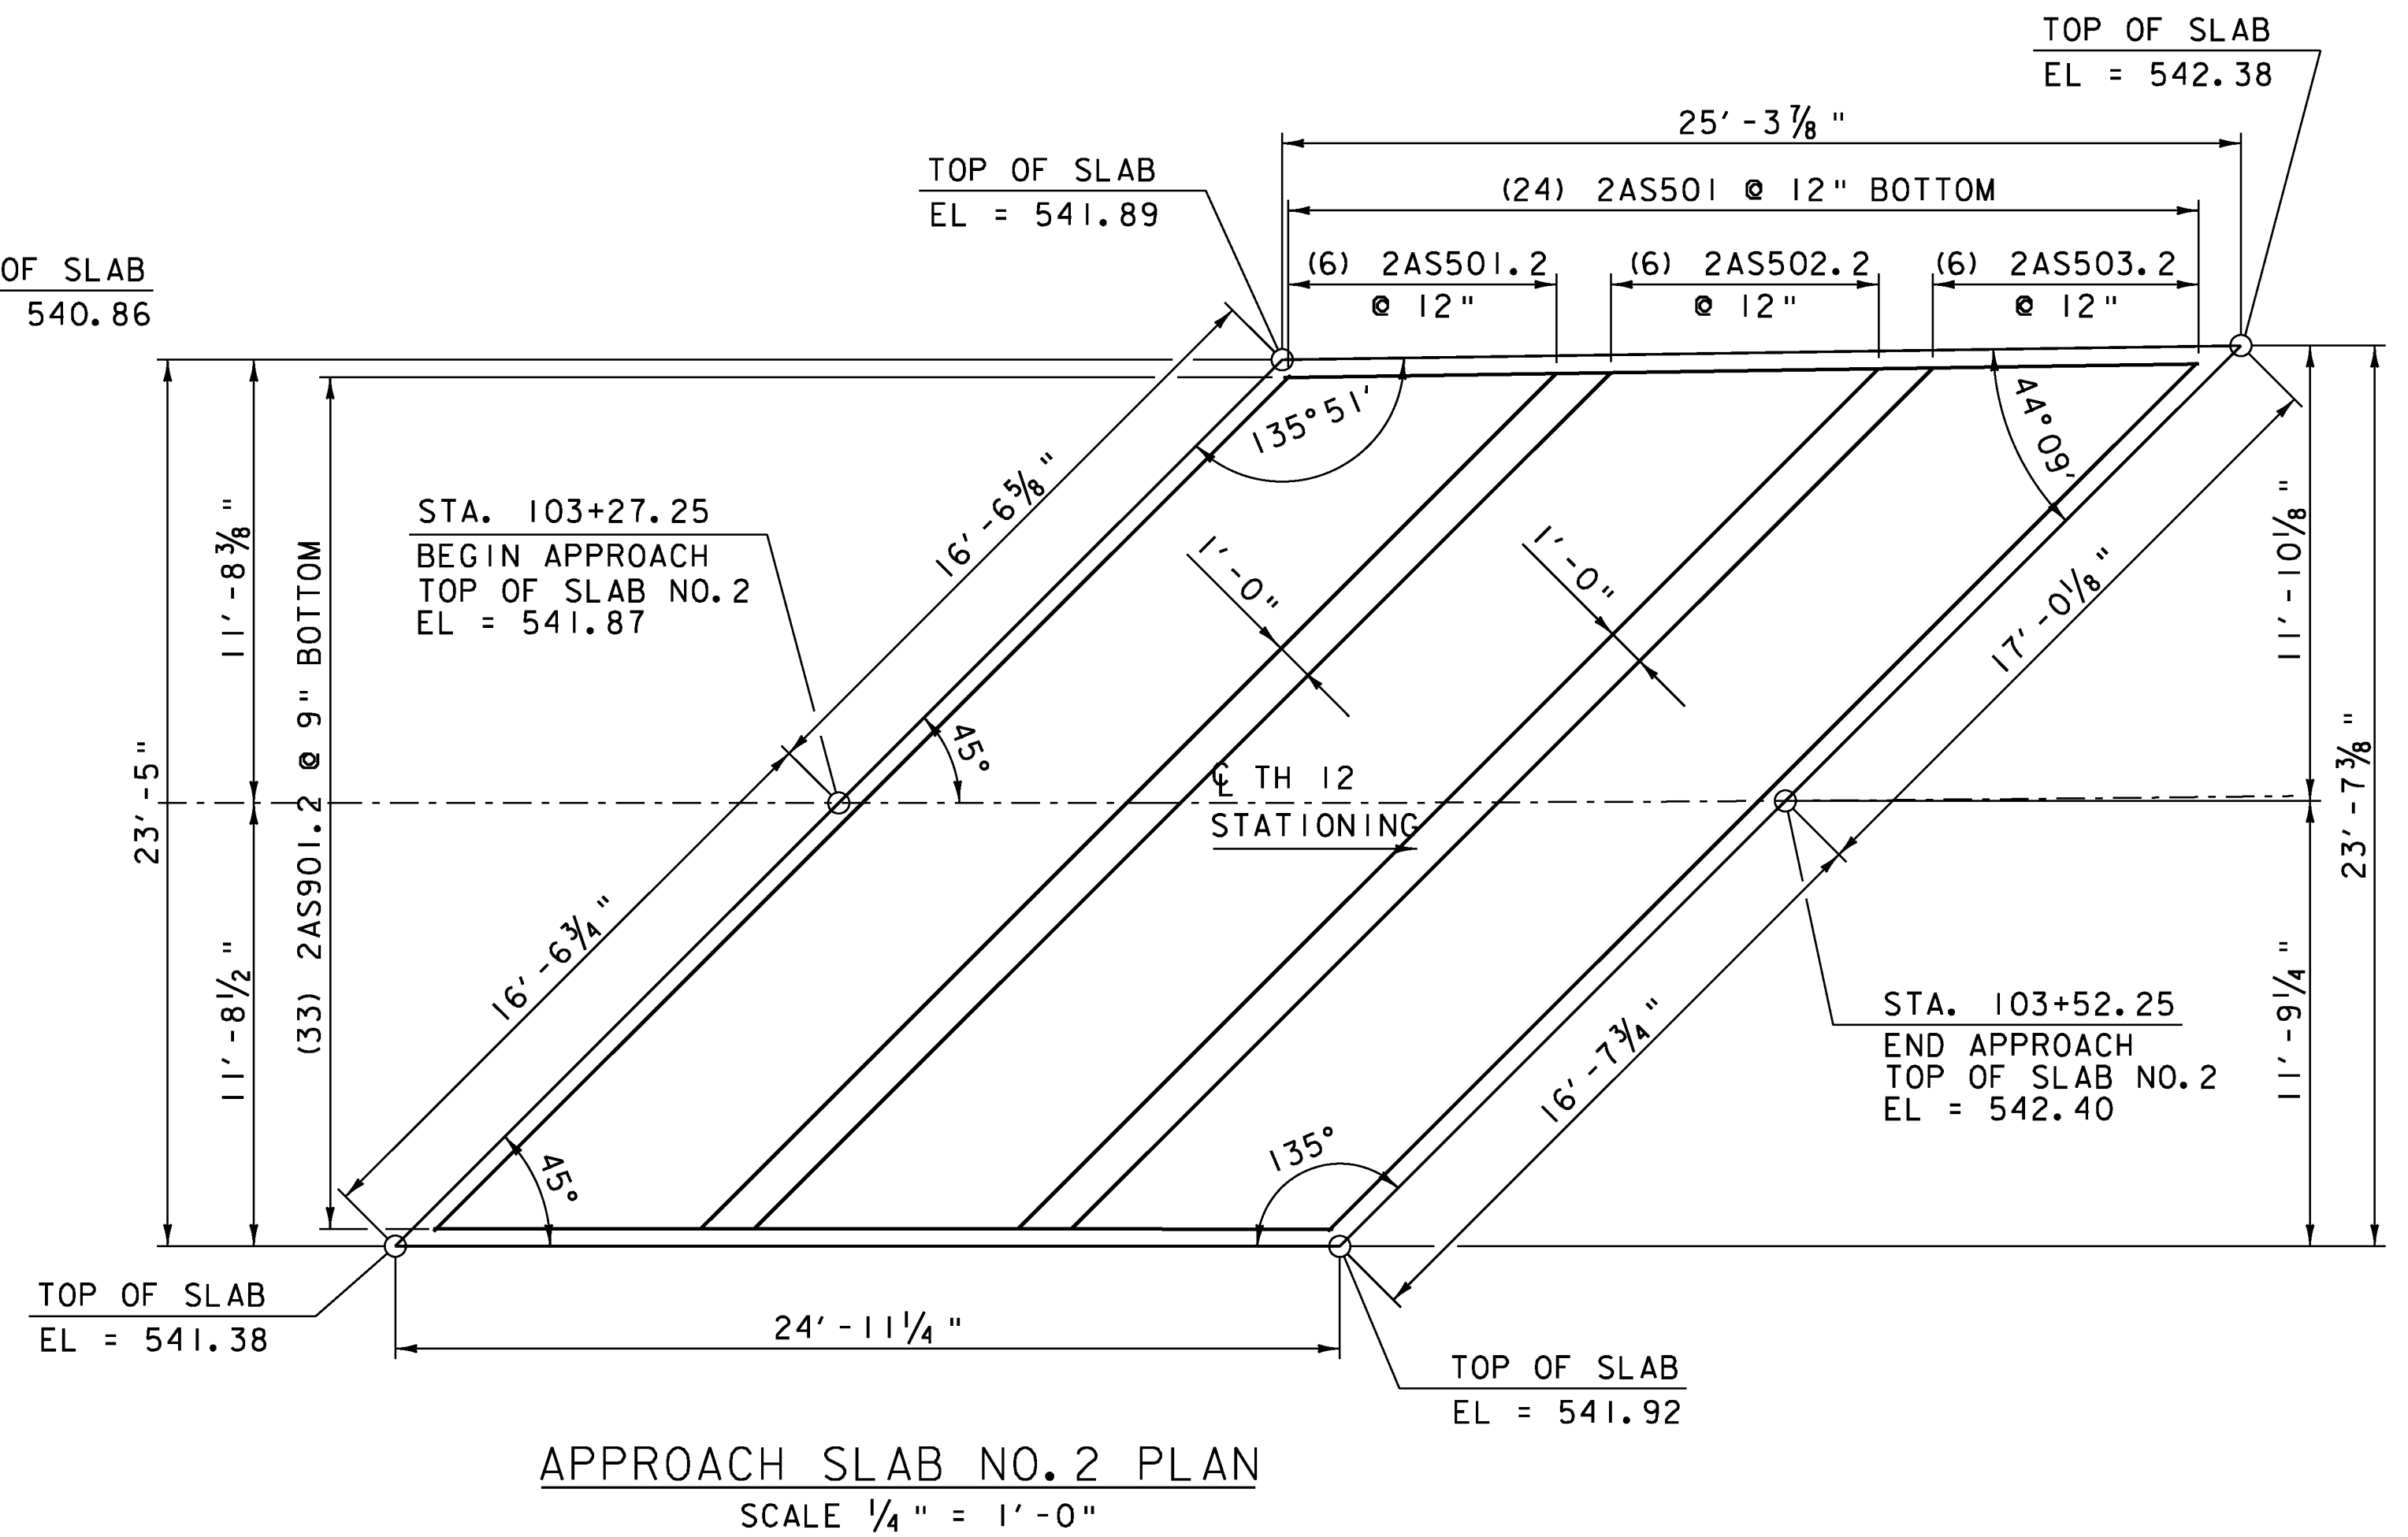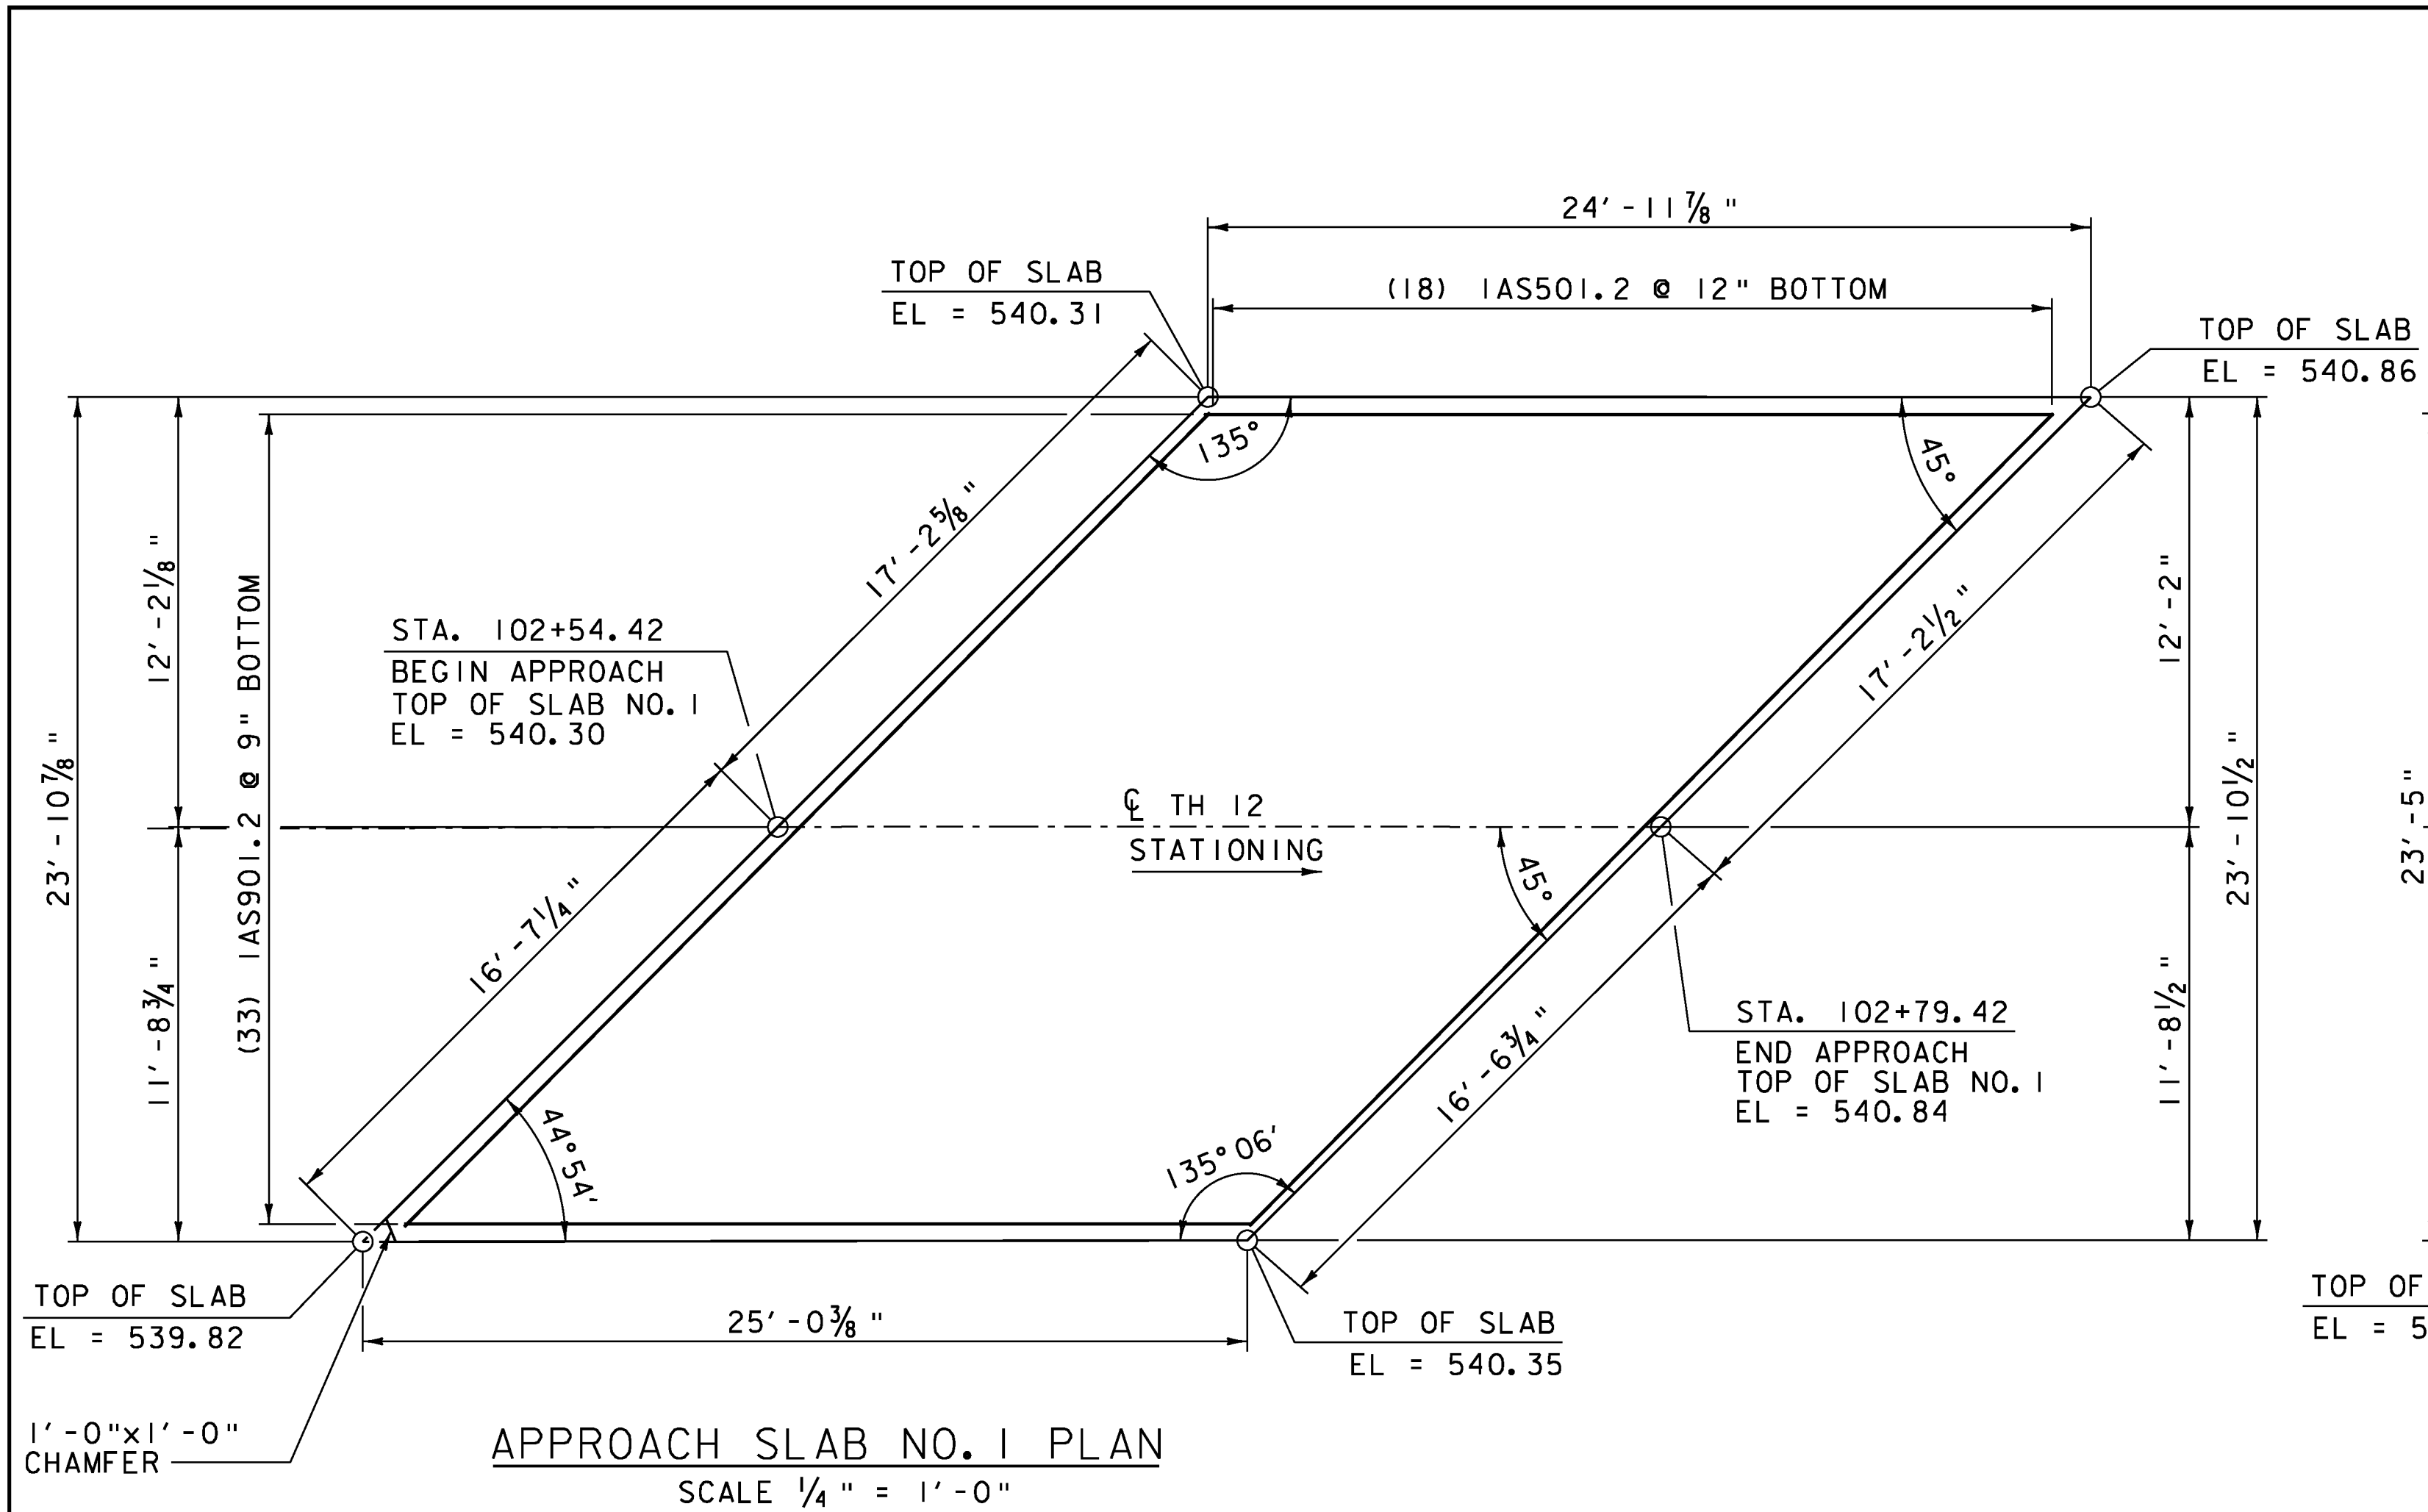


**NOTE:**

- NF = NEAR FACE
- FF = FAR FACE
- EF = EACH FACE
- ▲ = CUT TO FIT IN FIELD
- 3" CLEAR, UNLESS OTHERWISE SPECIFIED ON THE PLANS.
- 2'-2" BAR LAP UNLESS OTHERWISE SPECIFIED ON THE PLANS.


*** JOINT IS TO BE LOCATED ACCURATELY BY STRING LINING, OR OTHER MEANS, PRIOR TO PAVING, SO THAT THE SAW CUTS WILL BE MADE DIRECTLY OVER THE END OF THE APPROACH SLAB. JOINT SHALL BE CUT DRY IN A SINGLE PASS AND BE SEALED WITHIN 24 HOURS OR PRIOR TO EXPOSURE TO TRAFFIC. JOINT SHALL BE CLEANED PRIOR TO APPLYING THE JOINT SEALER.

PROJECT NAME:	BRATTLEBORO	PLOT DATE:	10/14/2013
PROJECT NUMBER:	BRO 1442(35)	DRAWN BY:	J.L. LEMIEUX
FILE NAME:	z10j062sup04.dgn	CHECKED BY:	S.E. BURBANK
PROJECT LEADER:	S.E. BURBANK	SHEET	40 OF 68
DESIGNED BY:	S.E. BURBANK		
APPROACH SLAB DETAILS			




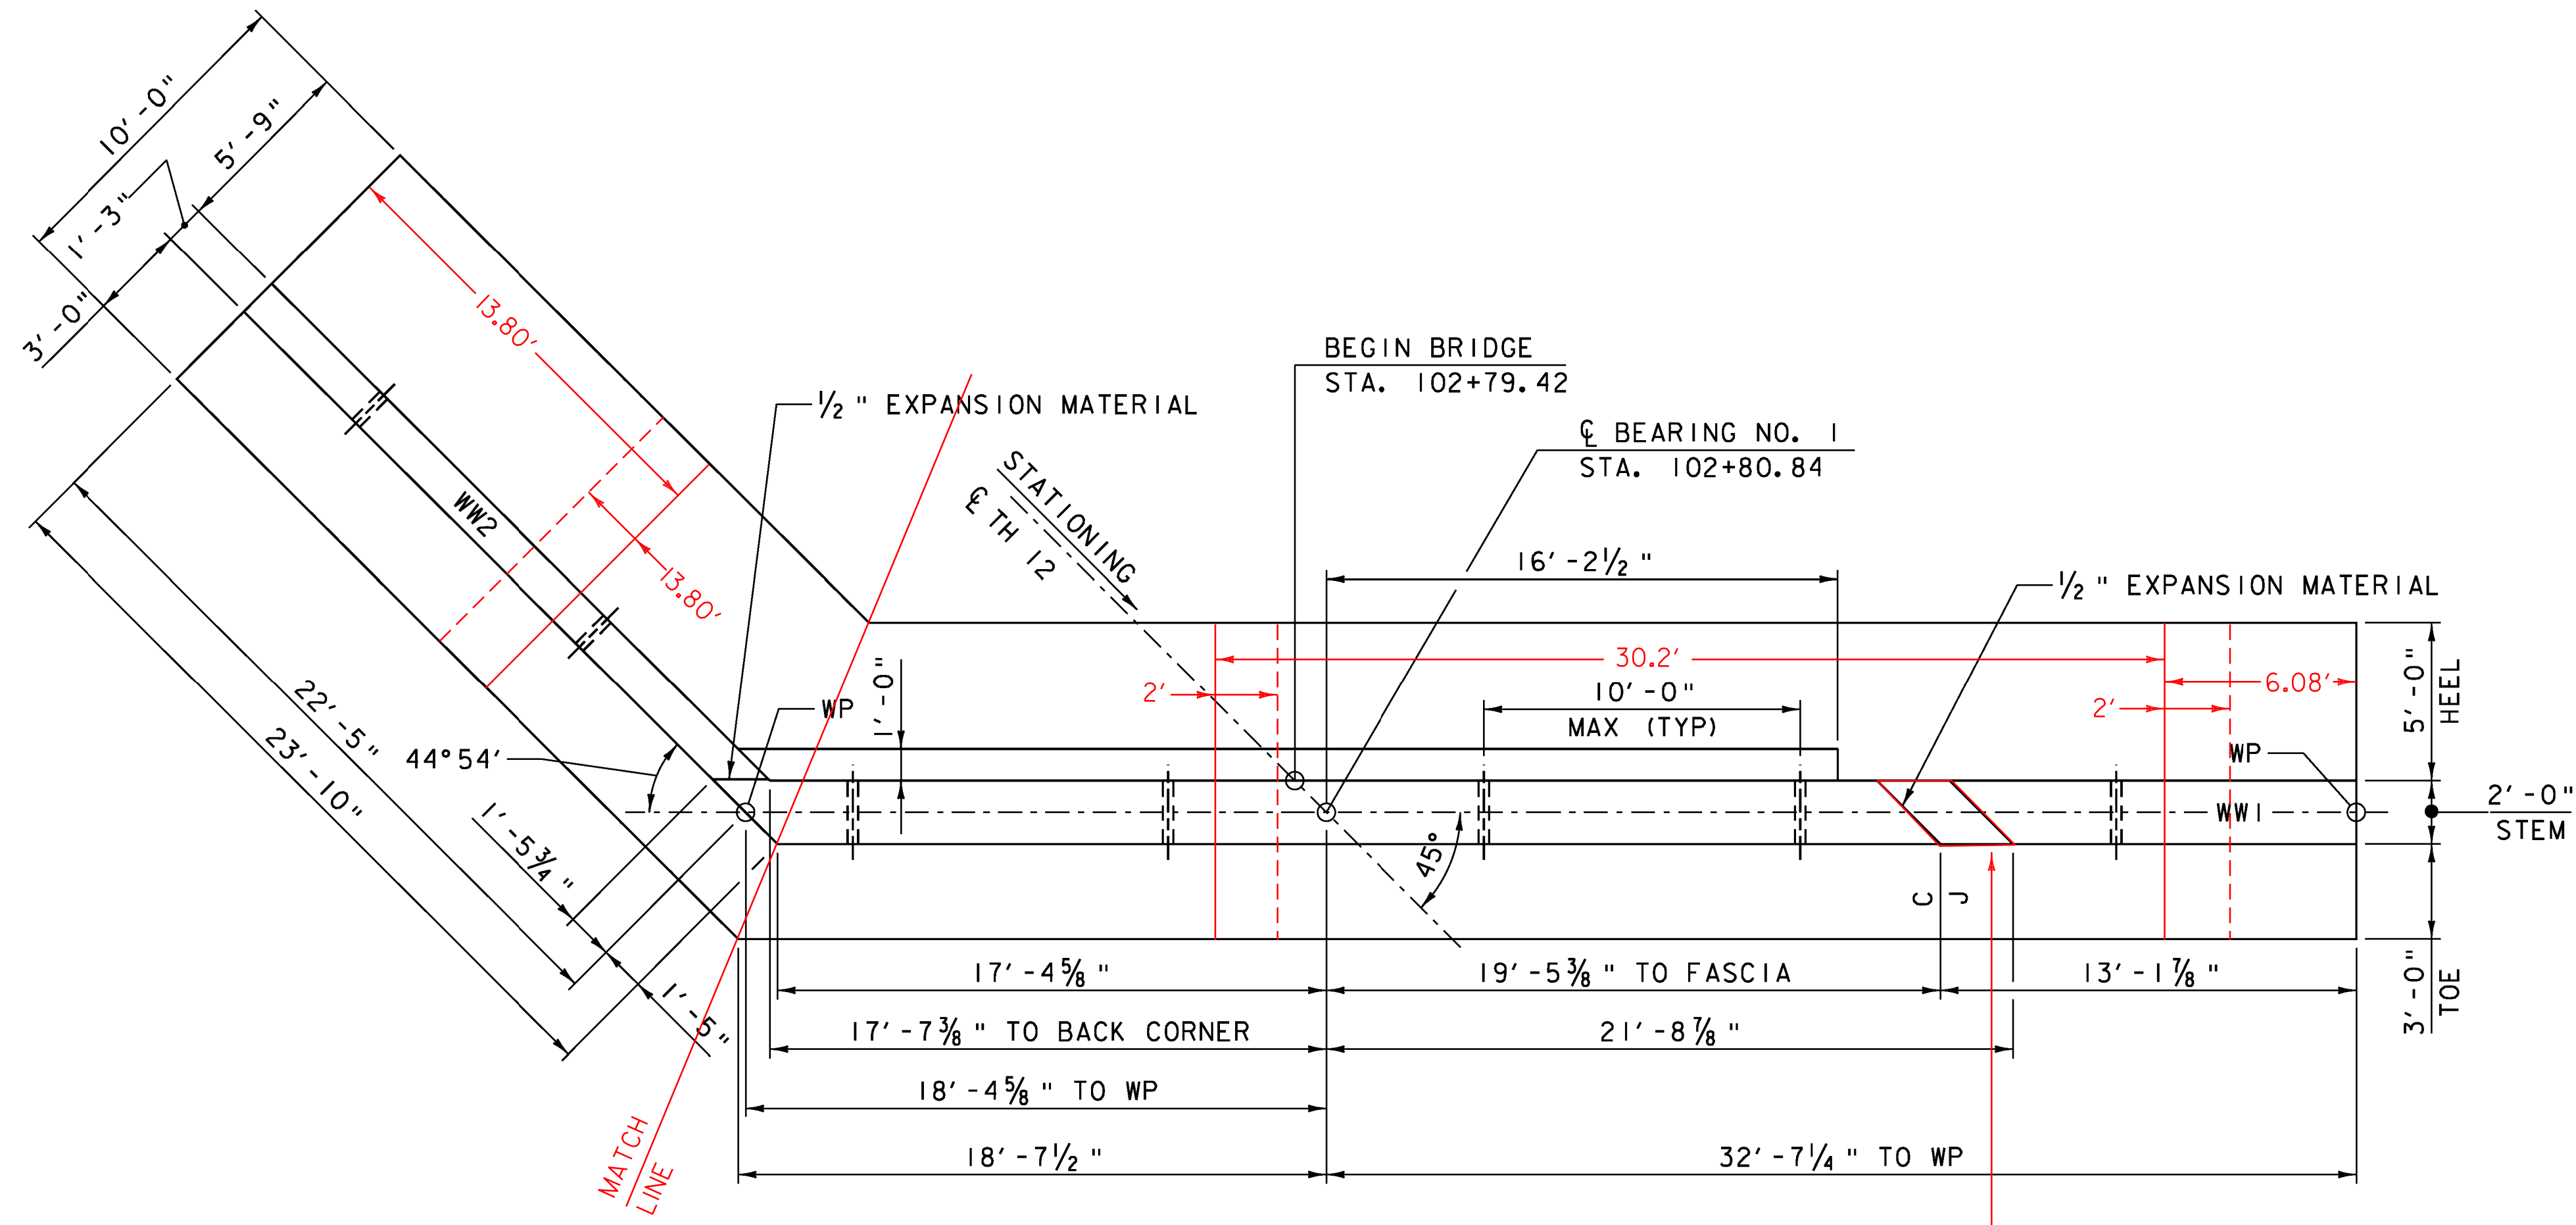

ABUTMENT NO. 1 PLAN VIEW  
 SCALE 1/4" = 1'-0"

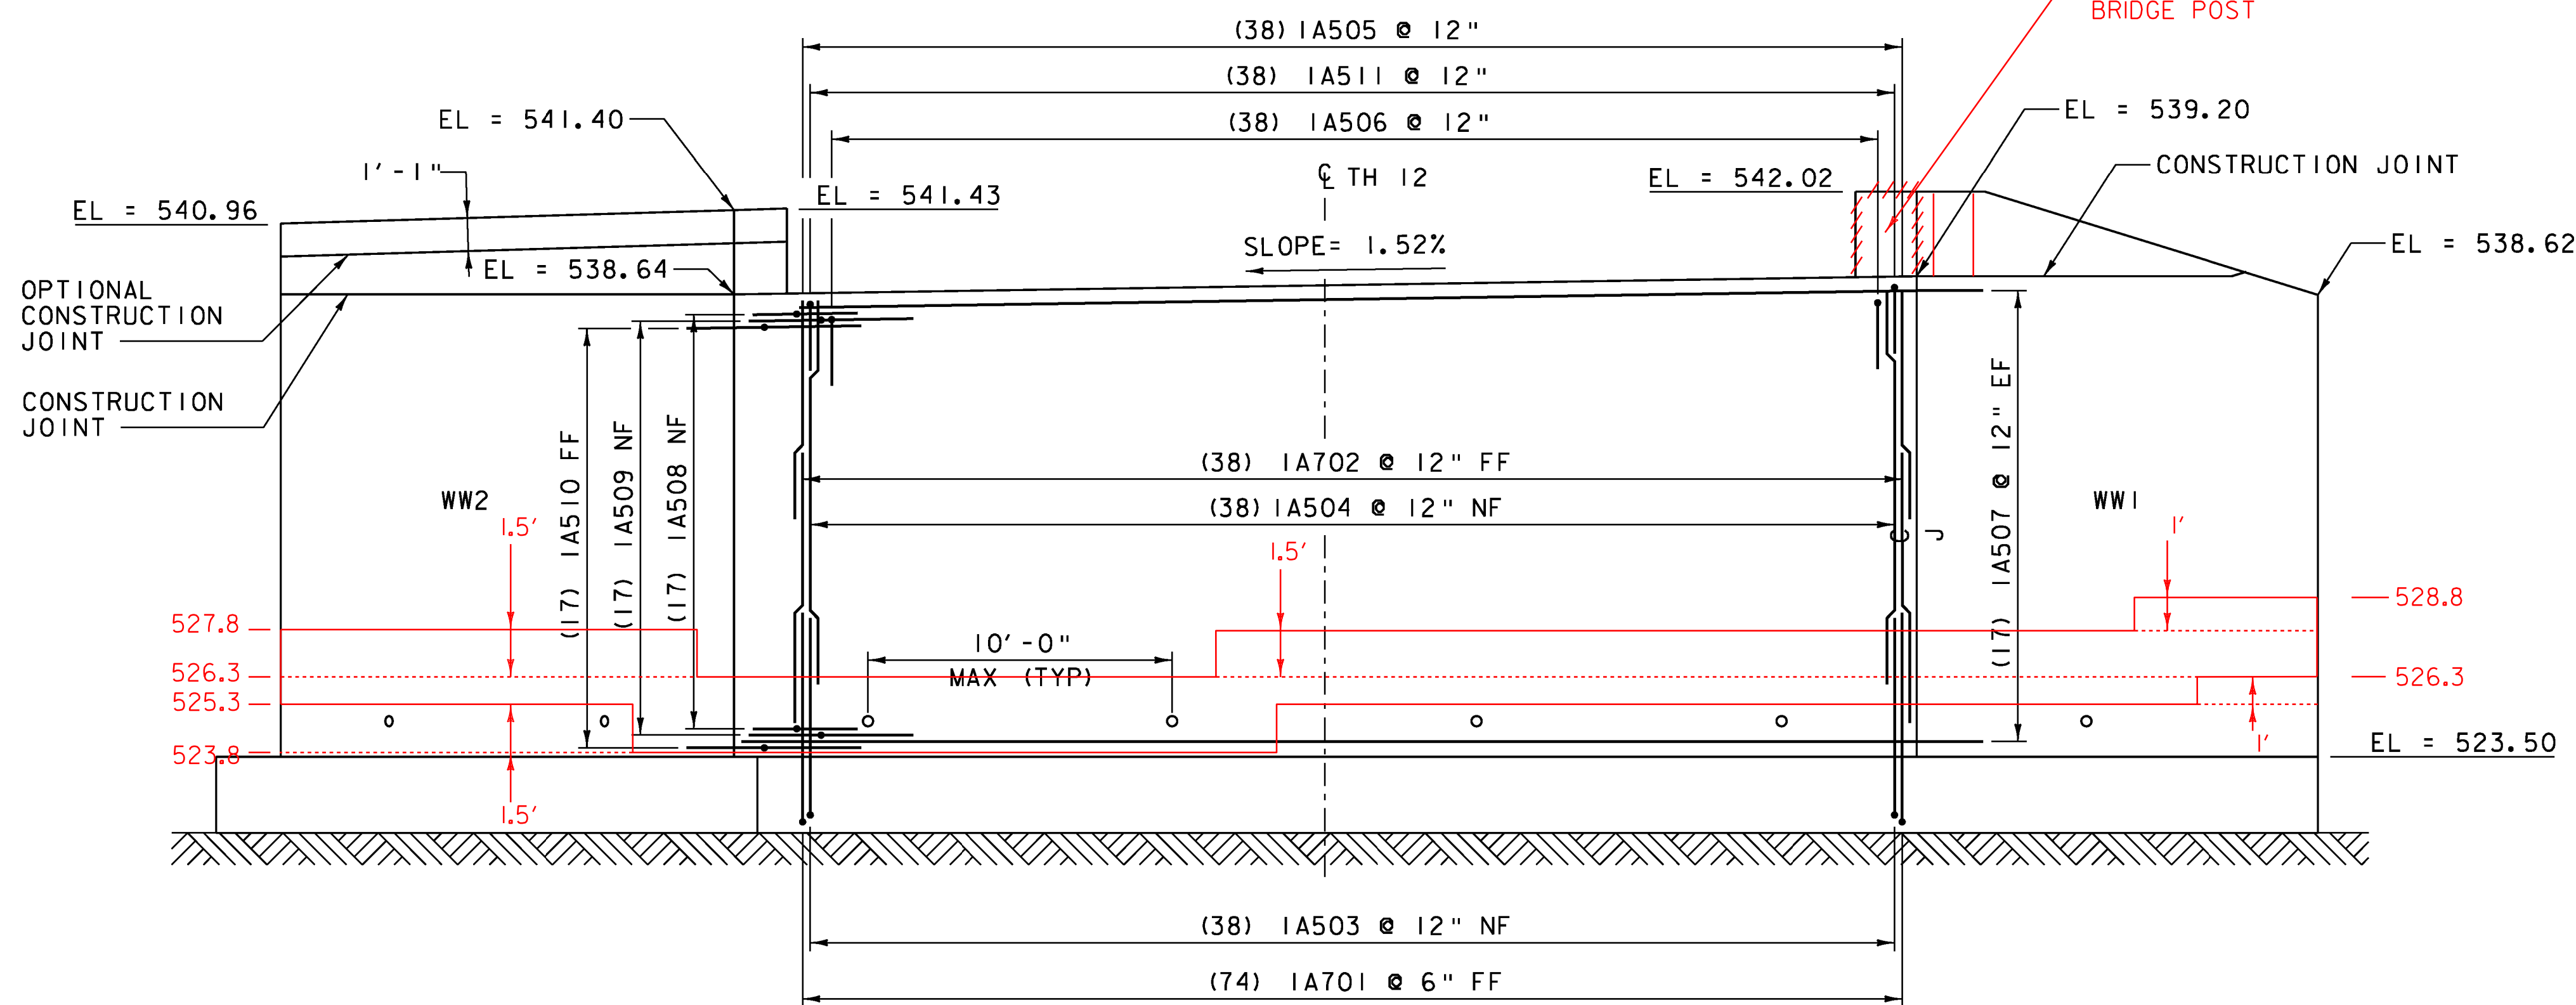

ABUTMENT NO. 1 ELEVATION  
 SCALE 1/4" = 1'-0"

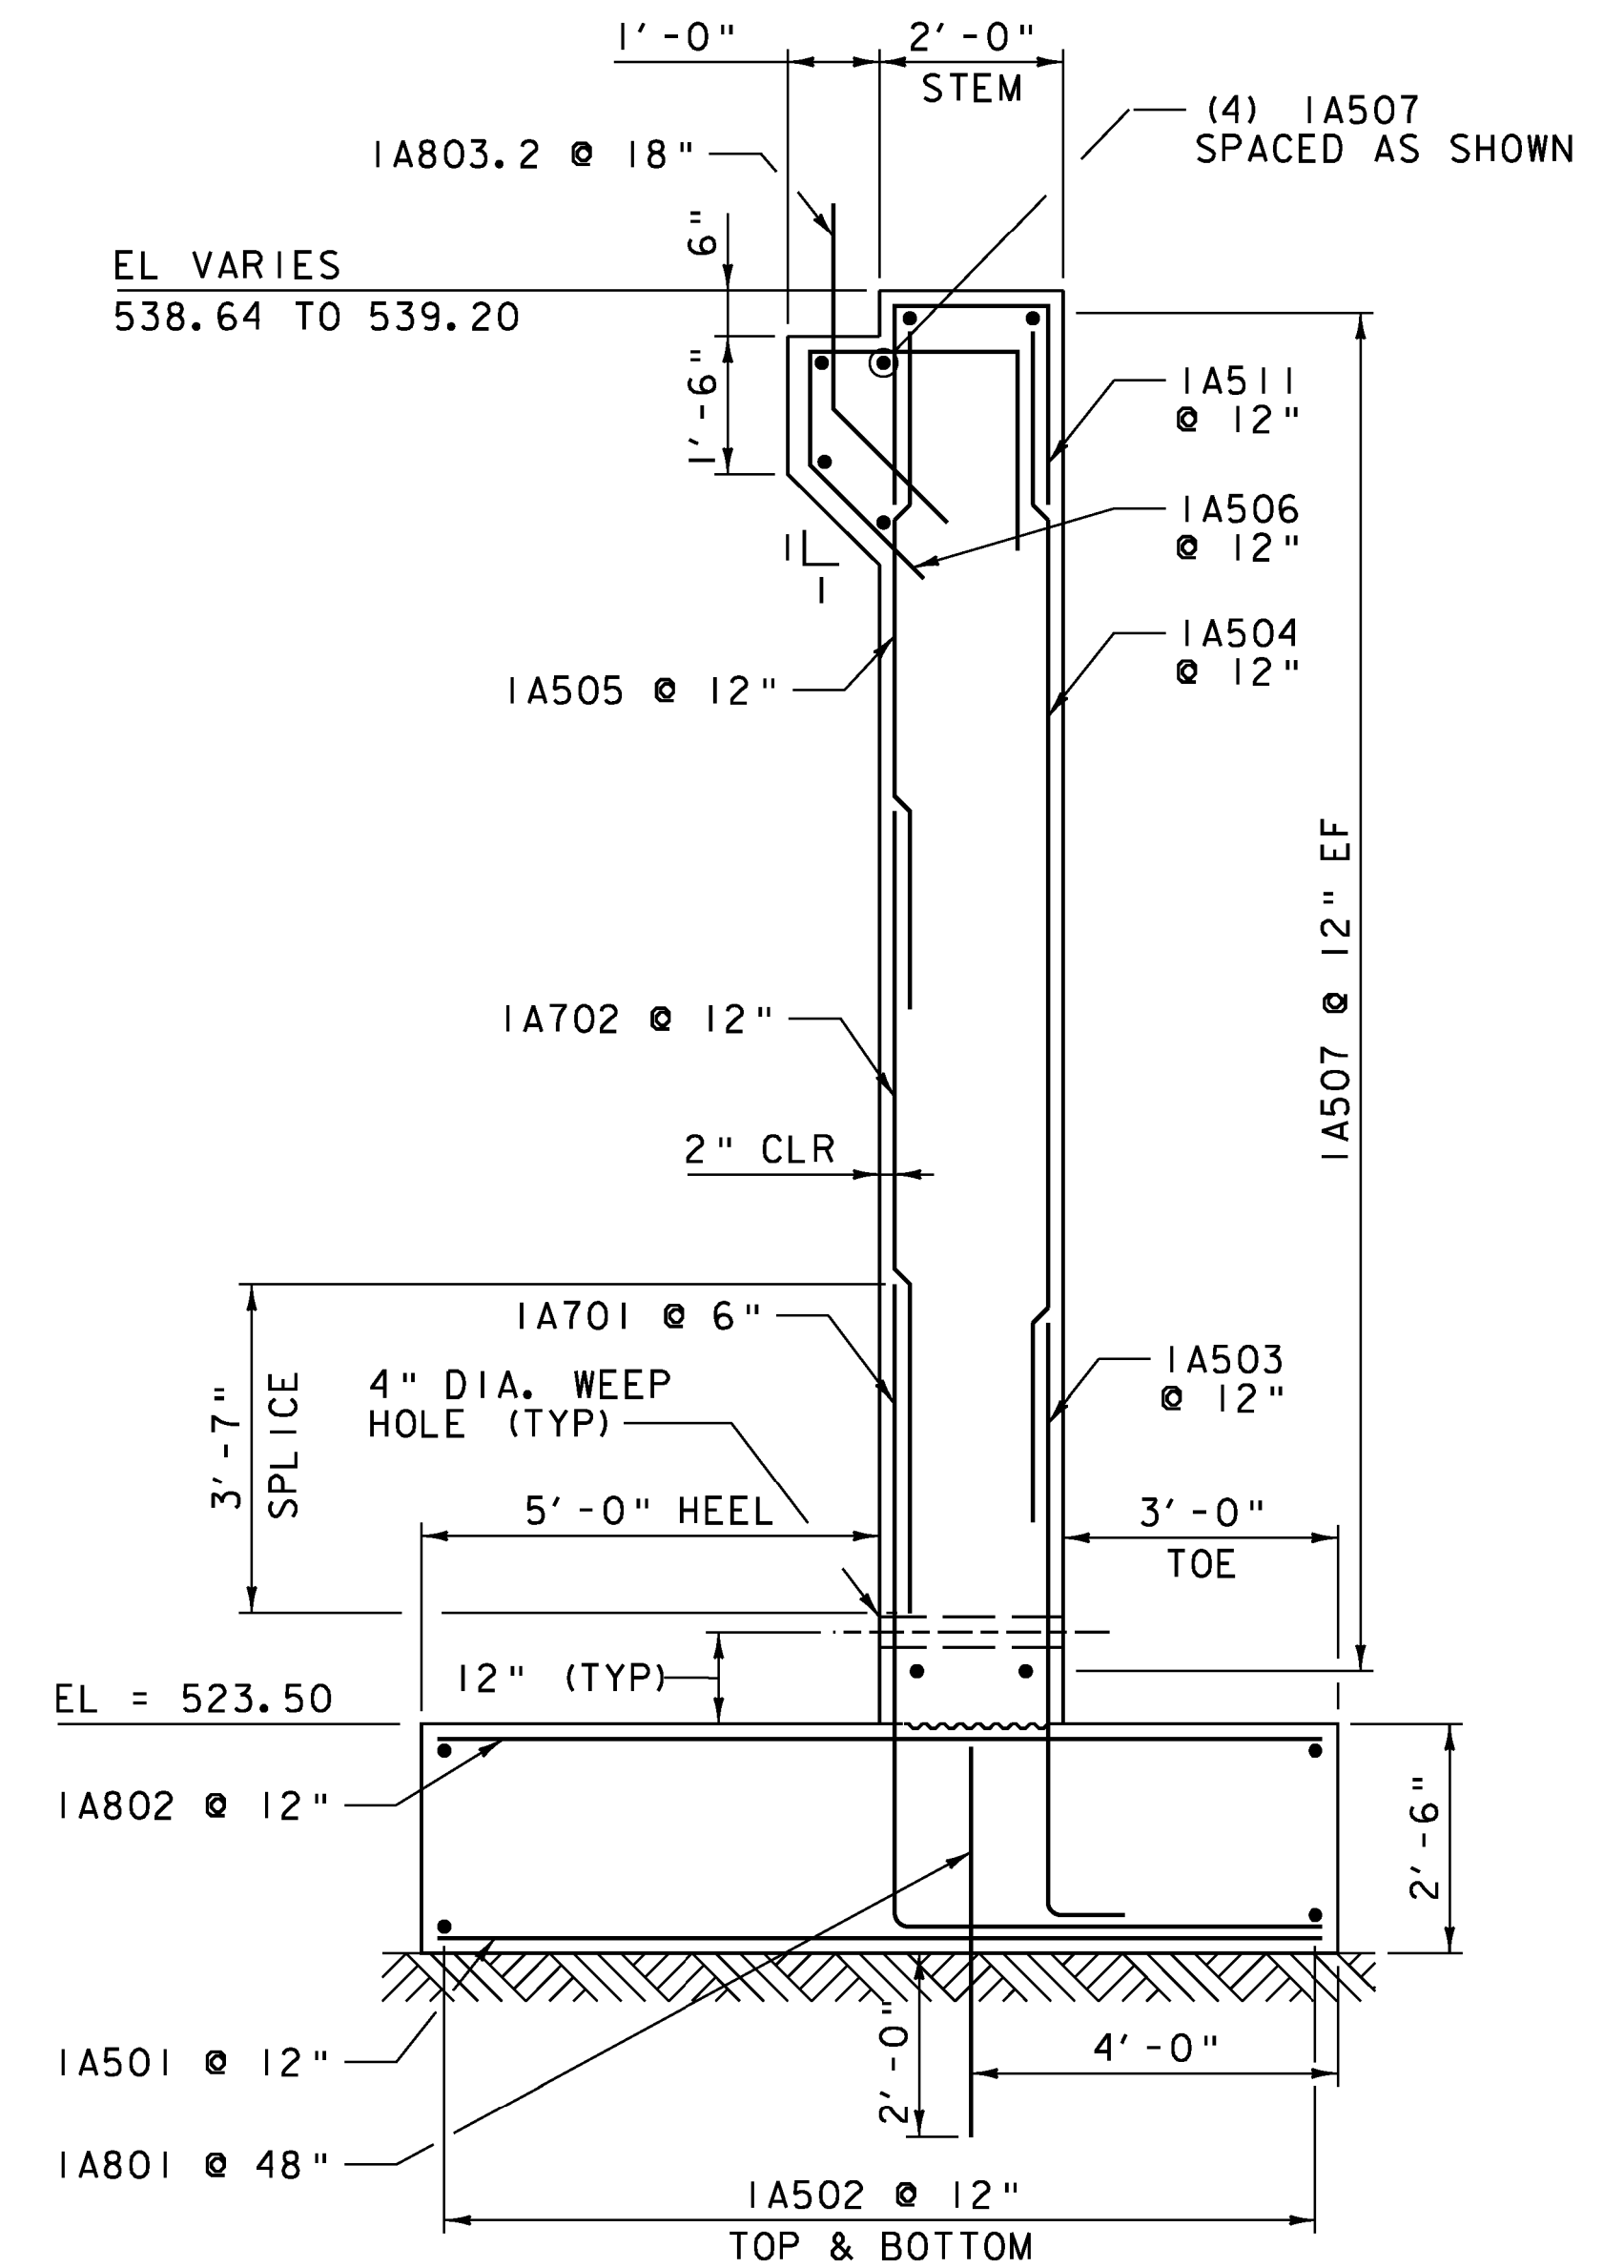


ABUTMENT NO. 1 TYPICAL  
 SCALE 1/2" = 1'-0"

NOTE:  
 NF = NEAR FACE  
 FF = FAR FACE  
 EF = EACH FACE  
 ▲ = CUT TO FIT IN FIELD  
 3" CLEAR, UNLESS OTHERWISE SPECIFIED ON THE PLANS.  
 2'-2" BAR LAP UNLESS SPECIFIED ON THE PLANS.


PROJECT NAME: BRATTLEBORO  
 PROJECT NUMBER: BRO 1442(35)

FILE NAME: z10j062sub1.dgn  
 PROJECT LEADER: S.E. BURBANK  
 DESIGNED BY: C.J. HAKEY  
 ABUTMENT NO. 1 PLAN & ELEVATION  
 PLOT DATE: 10/14/2013  
 DRAWN BY: D.A. GINGRAS  
 CHECKED BY: S.E. BURBANK  
 SHEET 41 OF 68




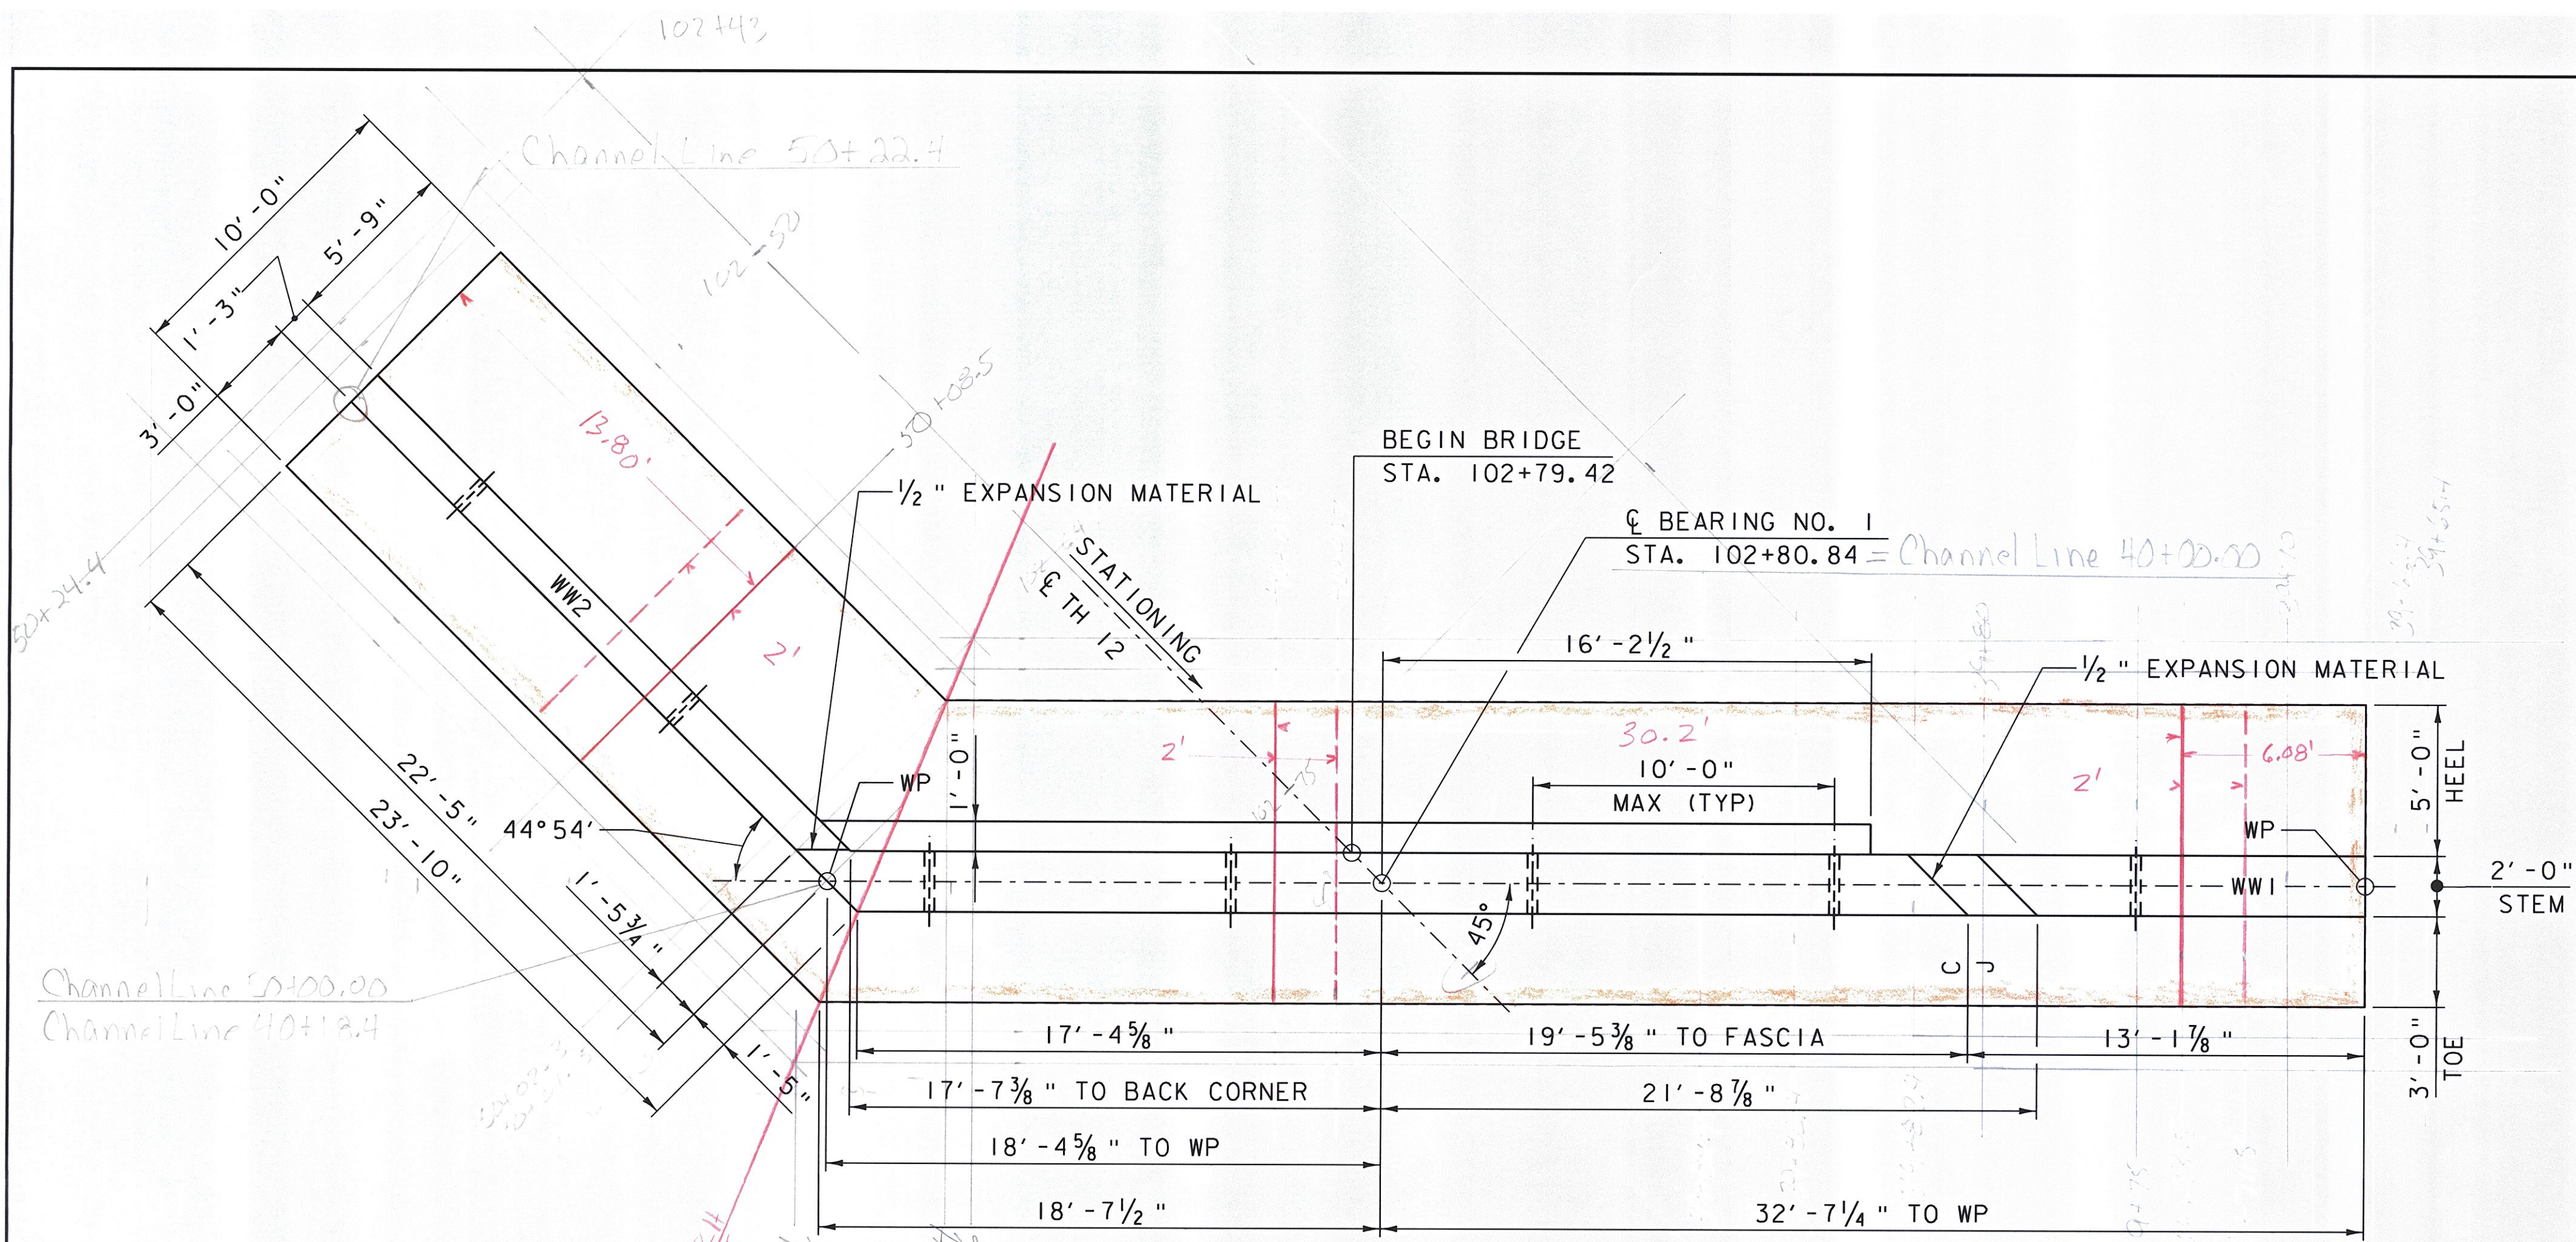

ABUTMENT NO. 1 PLAN VIEW  
SCALE 1/4" = 1'-0"

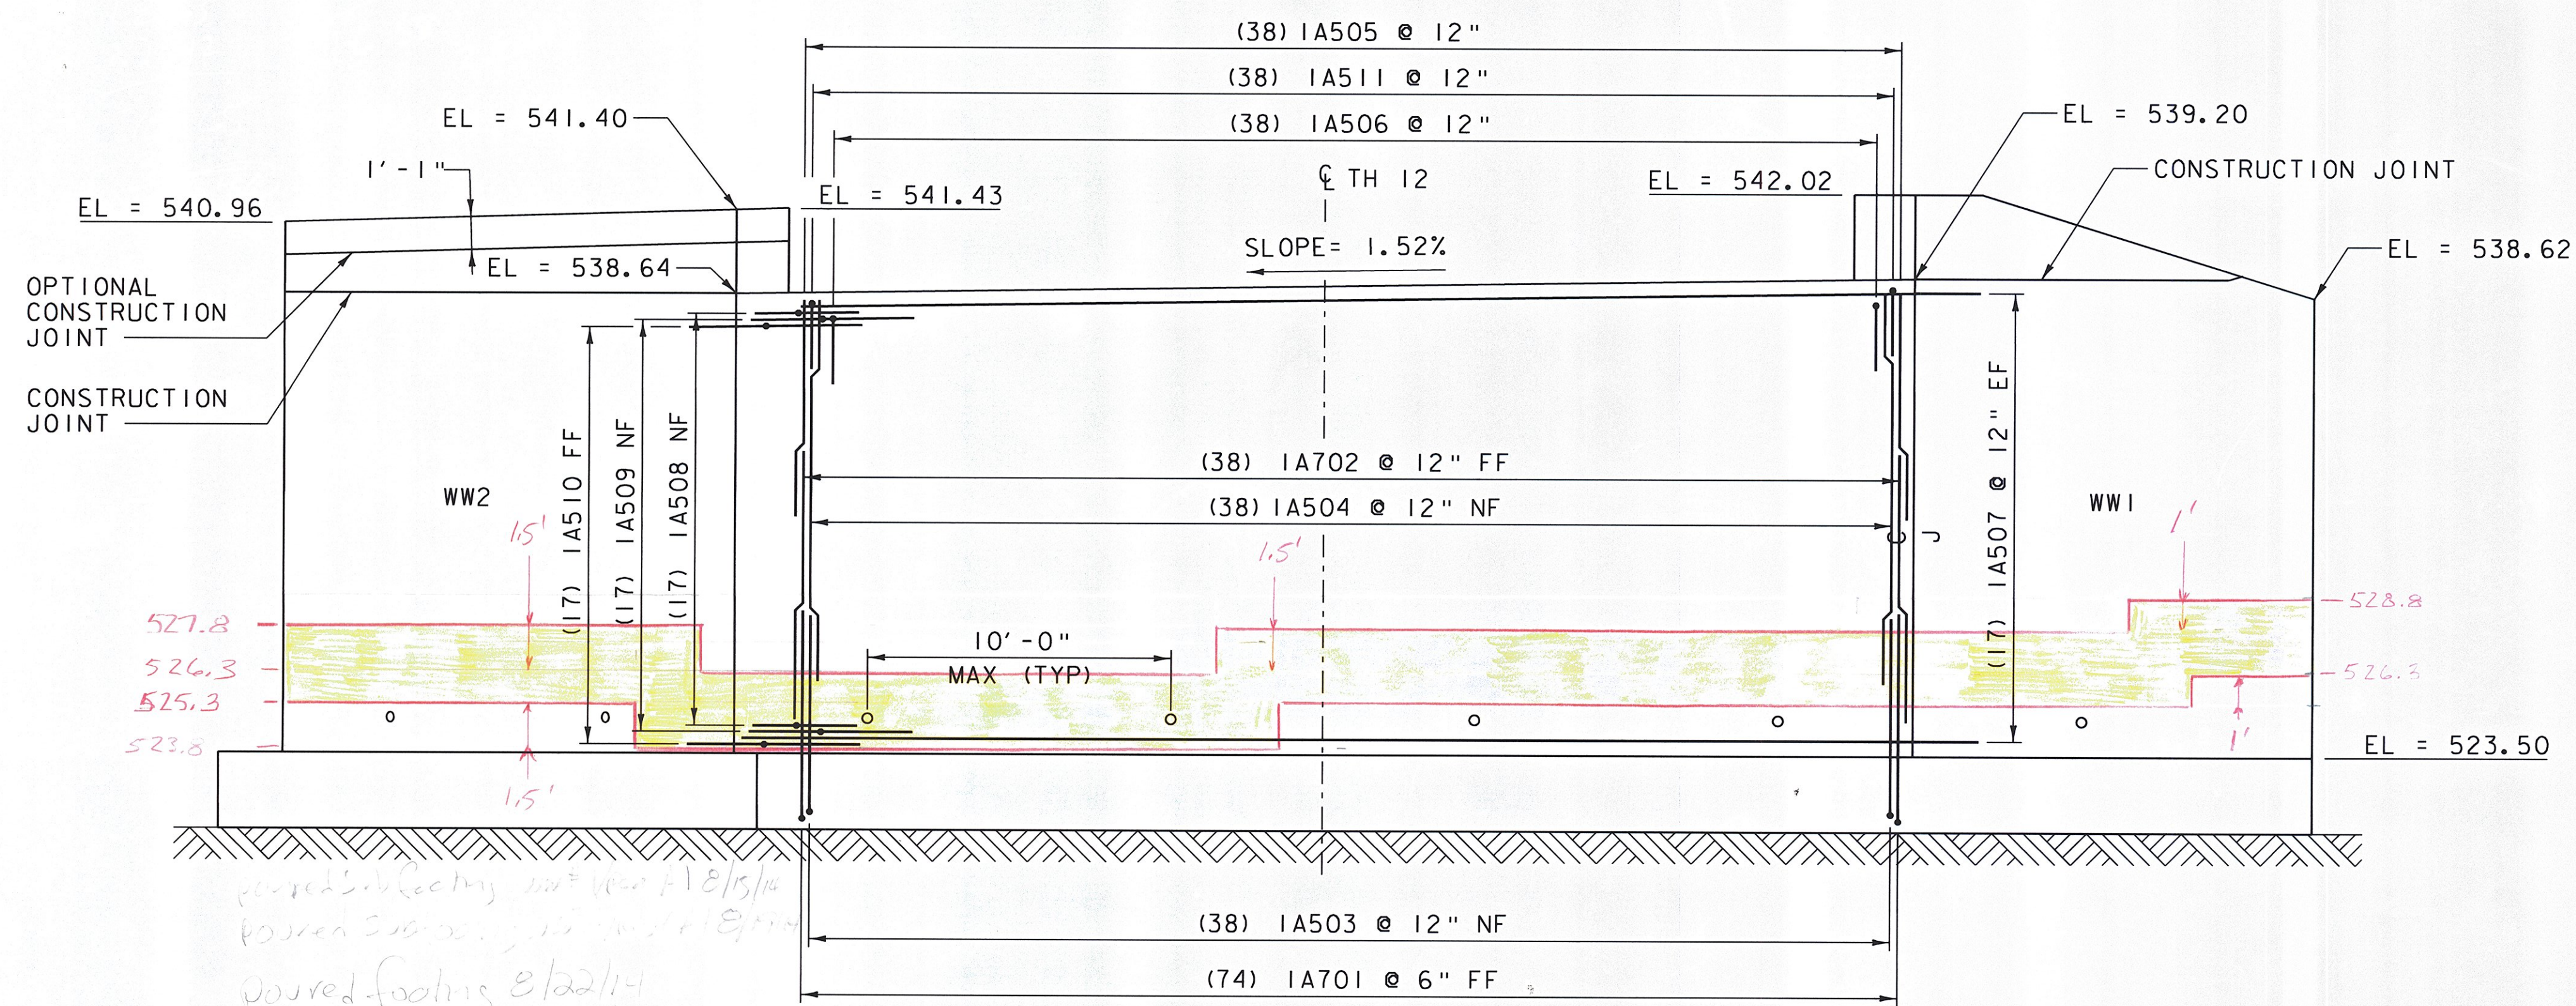

ABUTMENT NO. 1 ELEVATION  
SCALE 1/4" = 1'-0"

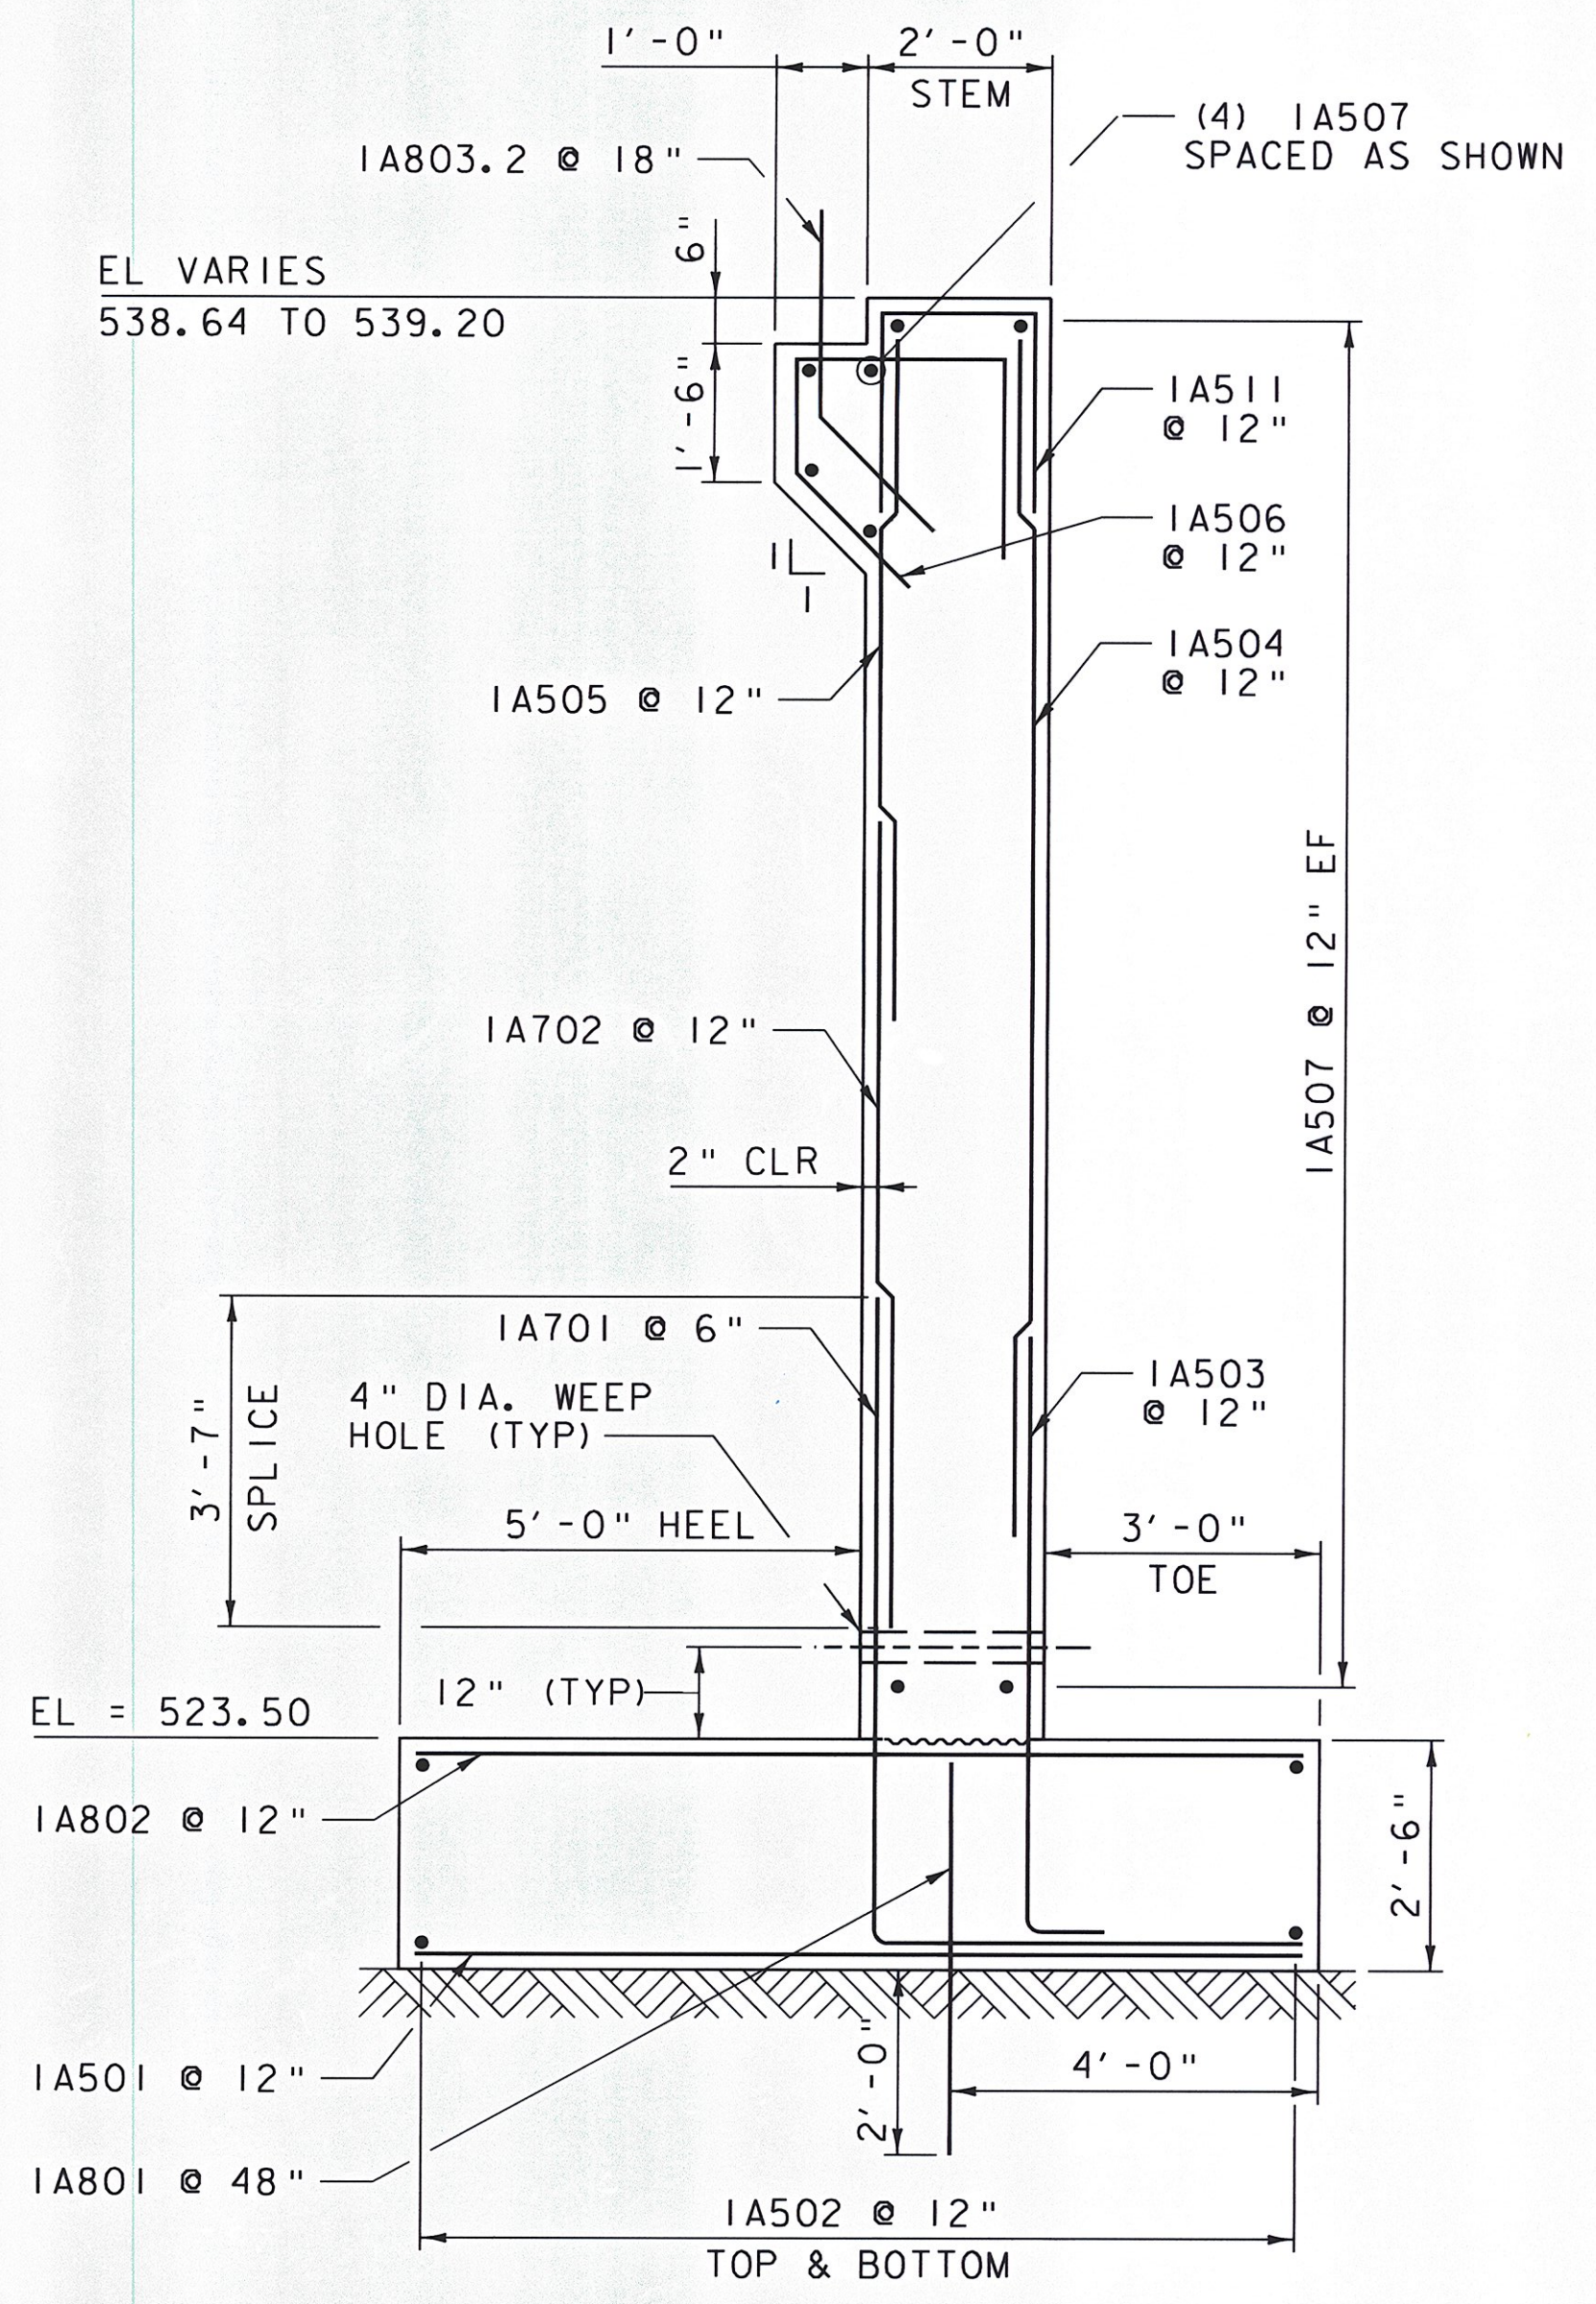


ABUTMENT NO. 1 TYPICAL  
SCALE 1/2" = 1'-0"

NOTE:  
 NF = NEAR FACE  
 FF = FAR FACE  
 EF = EACH FACE  
 ▲ = CUT TO FIT IN FIELD  
 3" CLEAR, UNLESS OTHERWISE SPECIFIED ON THE PLANS.  
 2'-2" BAR LAP UNLESS SPECIFIED ON THE PLANS.

PROJECT NAME:	BRATTLEBORO	<i>Footings - As Built</i>
PROJECT NUMBER:	BRO 1442(35)	
FILE NAME:	z10j062sub1.dgn	PLOT DATE: 10/14/2013
PROJECT LEADER:	S.E. BURBANK	DRAWN BY: D.A. GINGRAS
DESIGNED BY:	C.J. HAKEY	CHECKED BY: S.E. BURBANK
ABUTMENT NO. 1 PLAN & ELEVATION		SHEET 41 OF 68



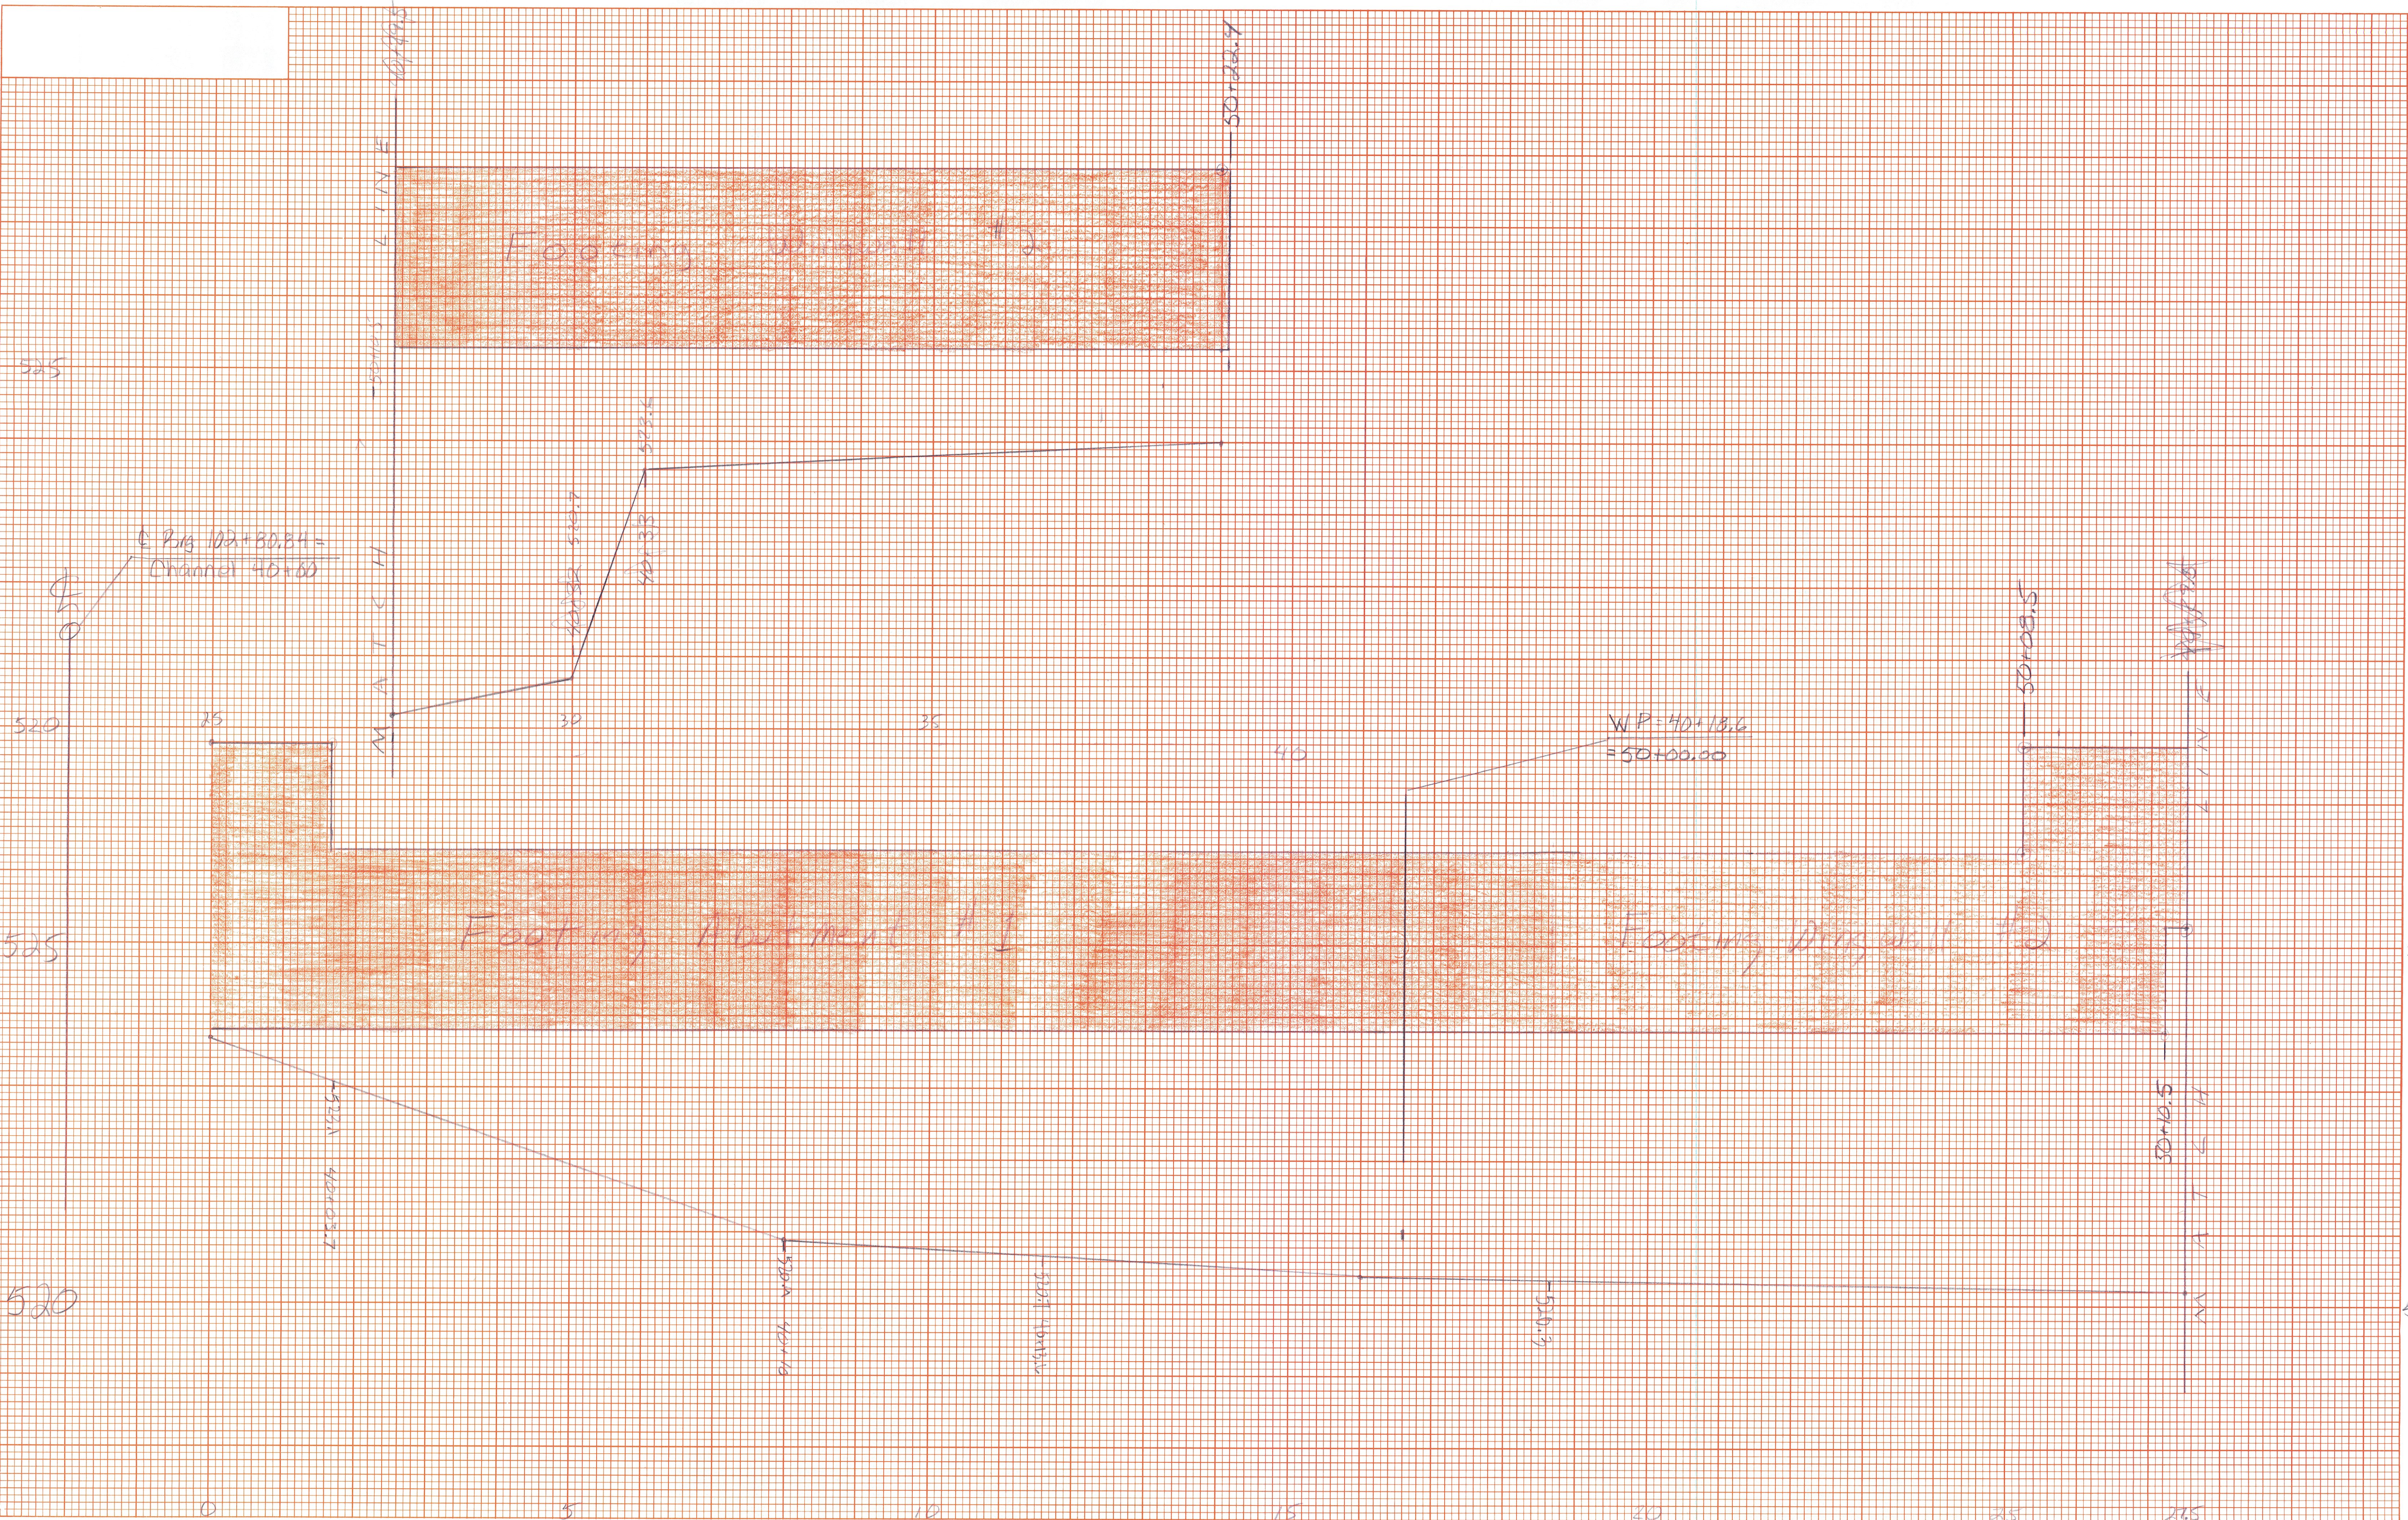



NO.	DATE CHECKED	BY
	DATE CHECKED	BY
	DATE CHECKED	BY
	DATE CHECKED	BY
	DATE CHECKED	BY

528


NO.	DATE CHECKED	BY
	DATE CHECKED	BY
	DATE CHECKED	BY
	DATE CHECKED	BY
	DATE CHECKED	BY

520

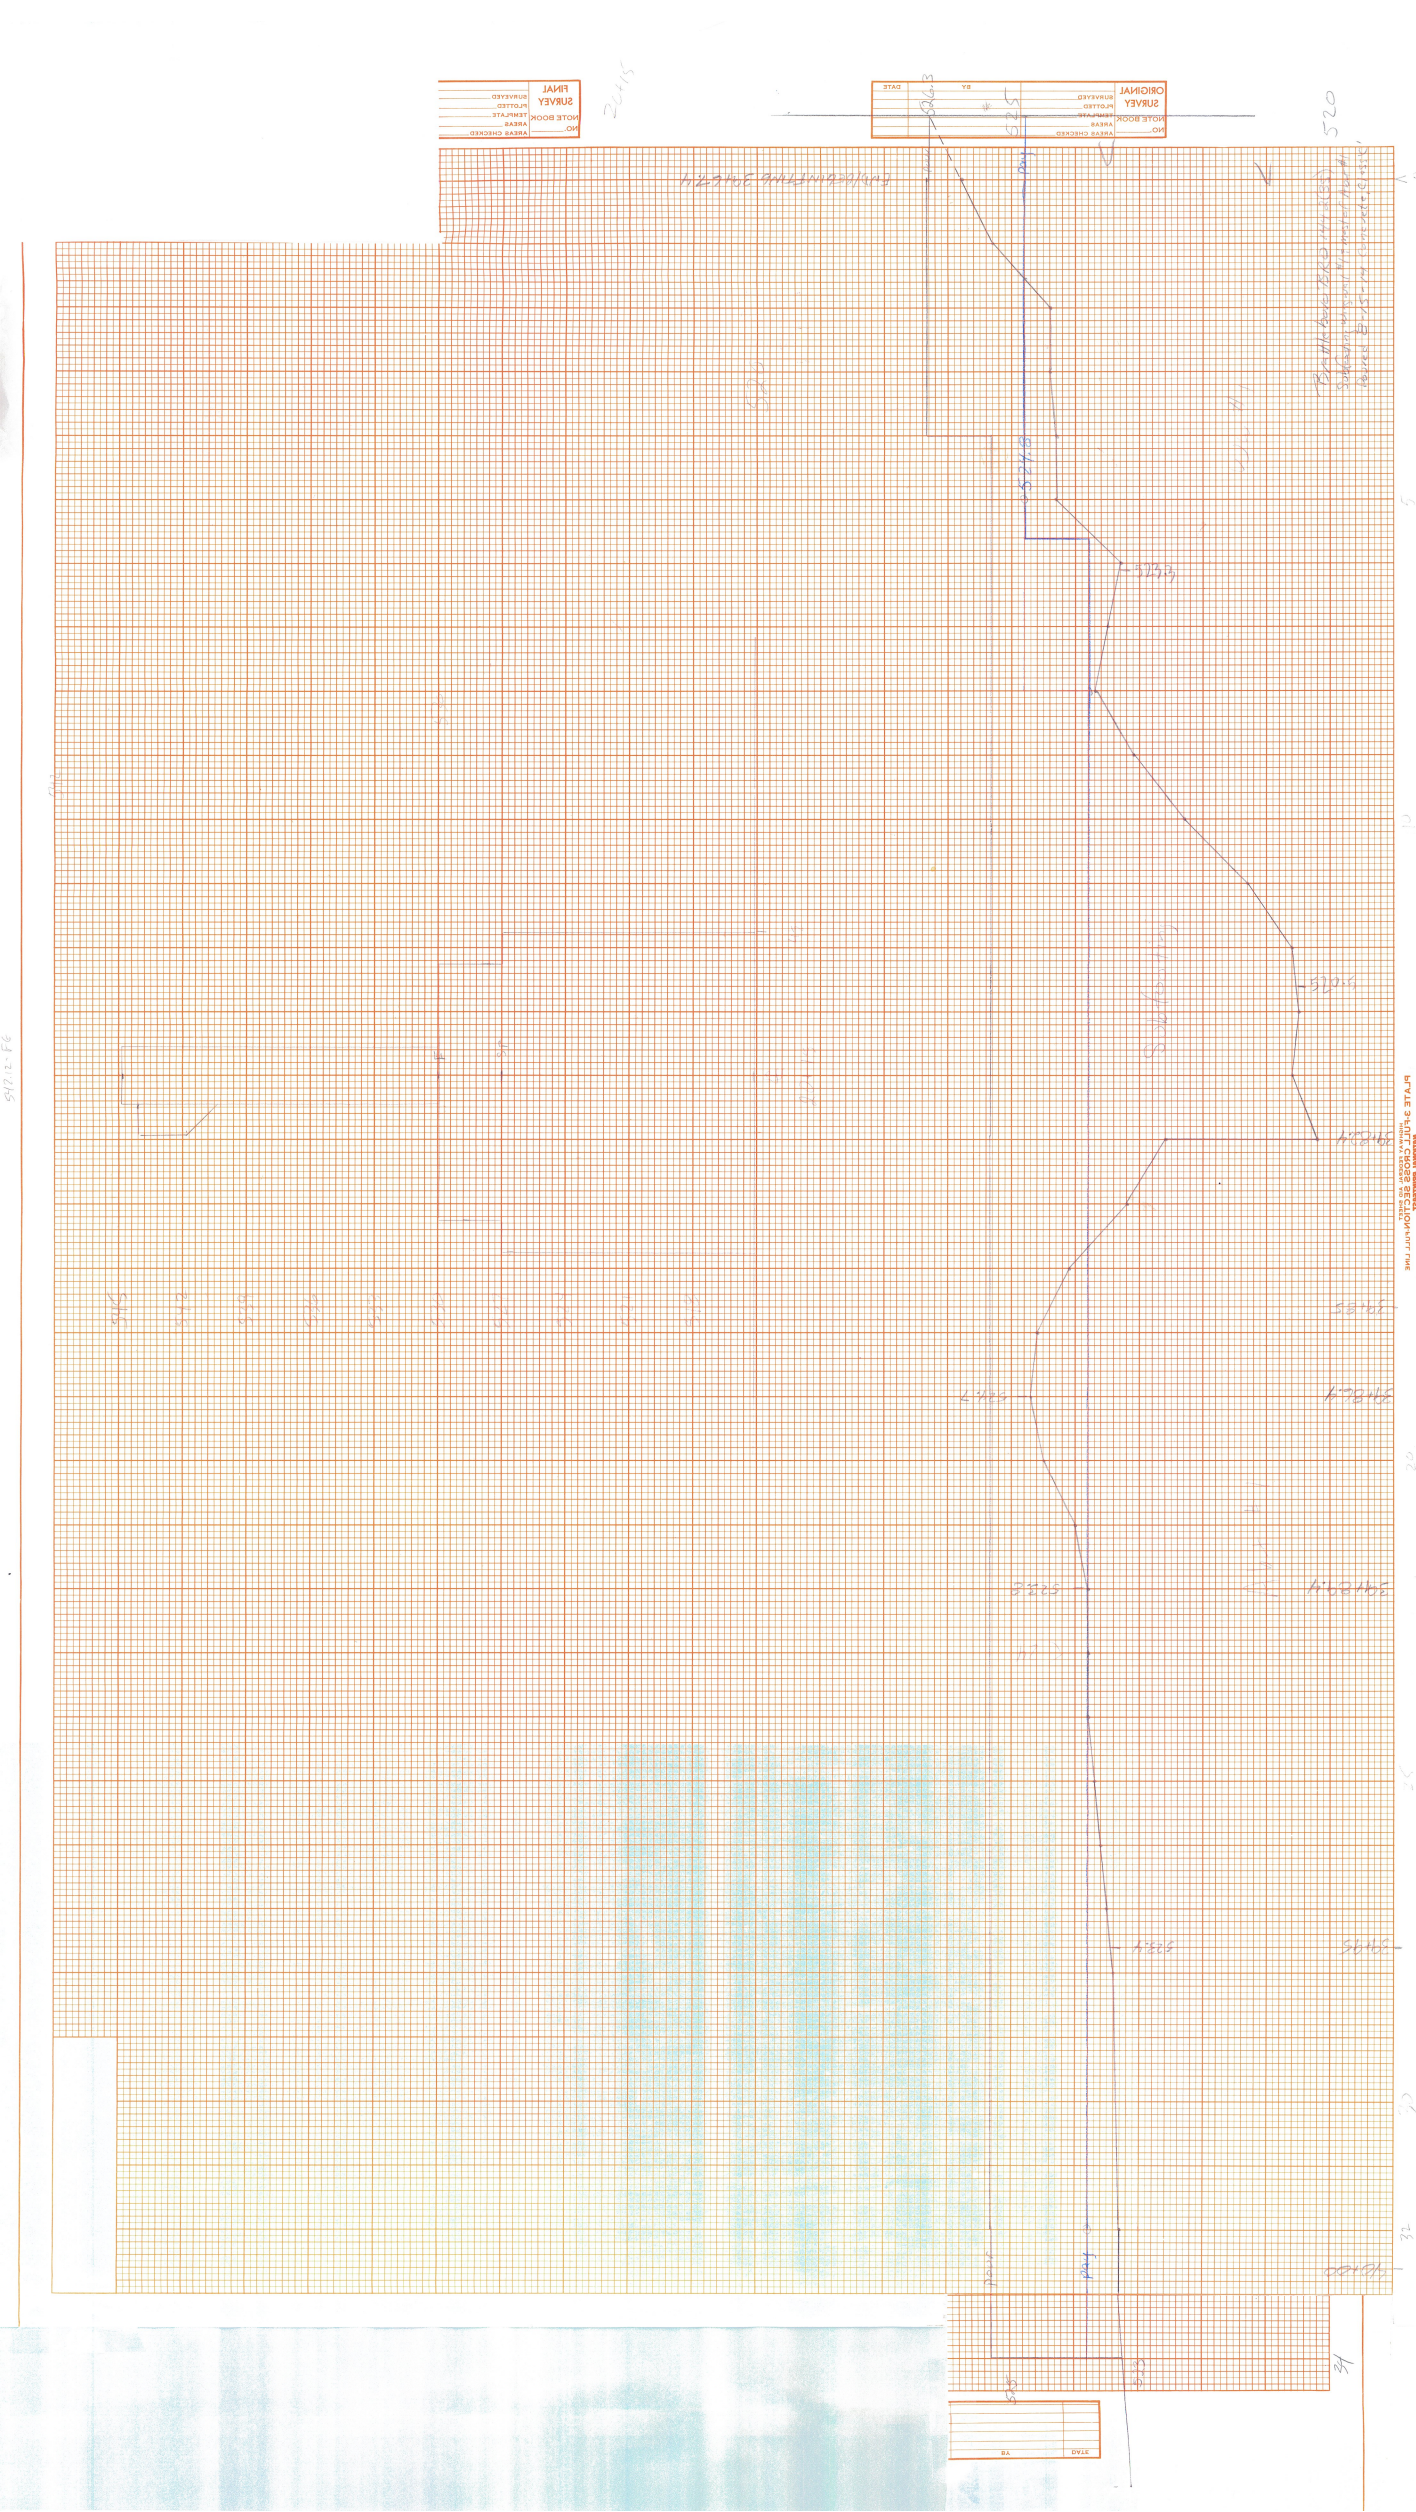

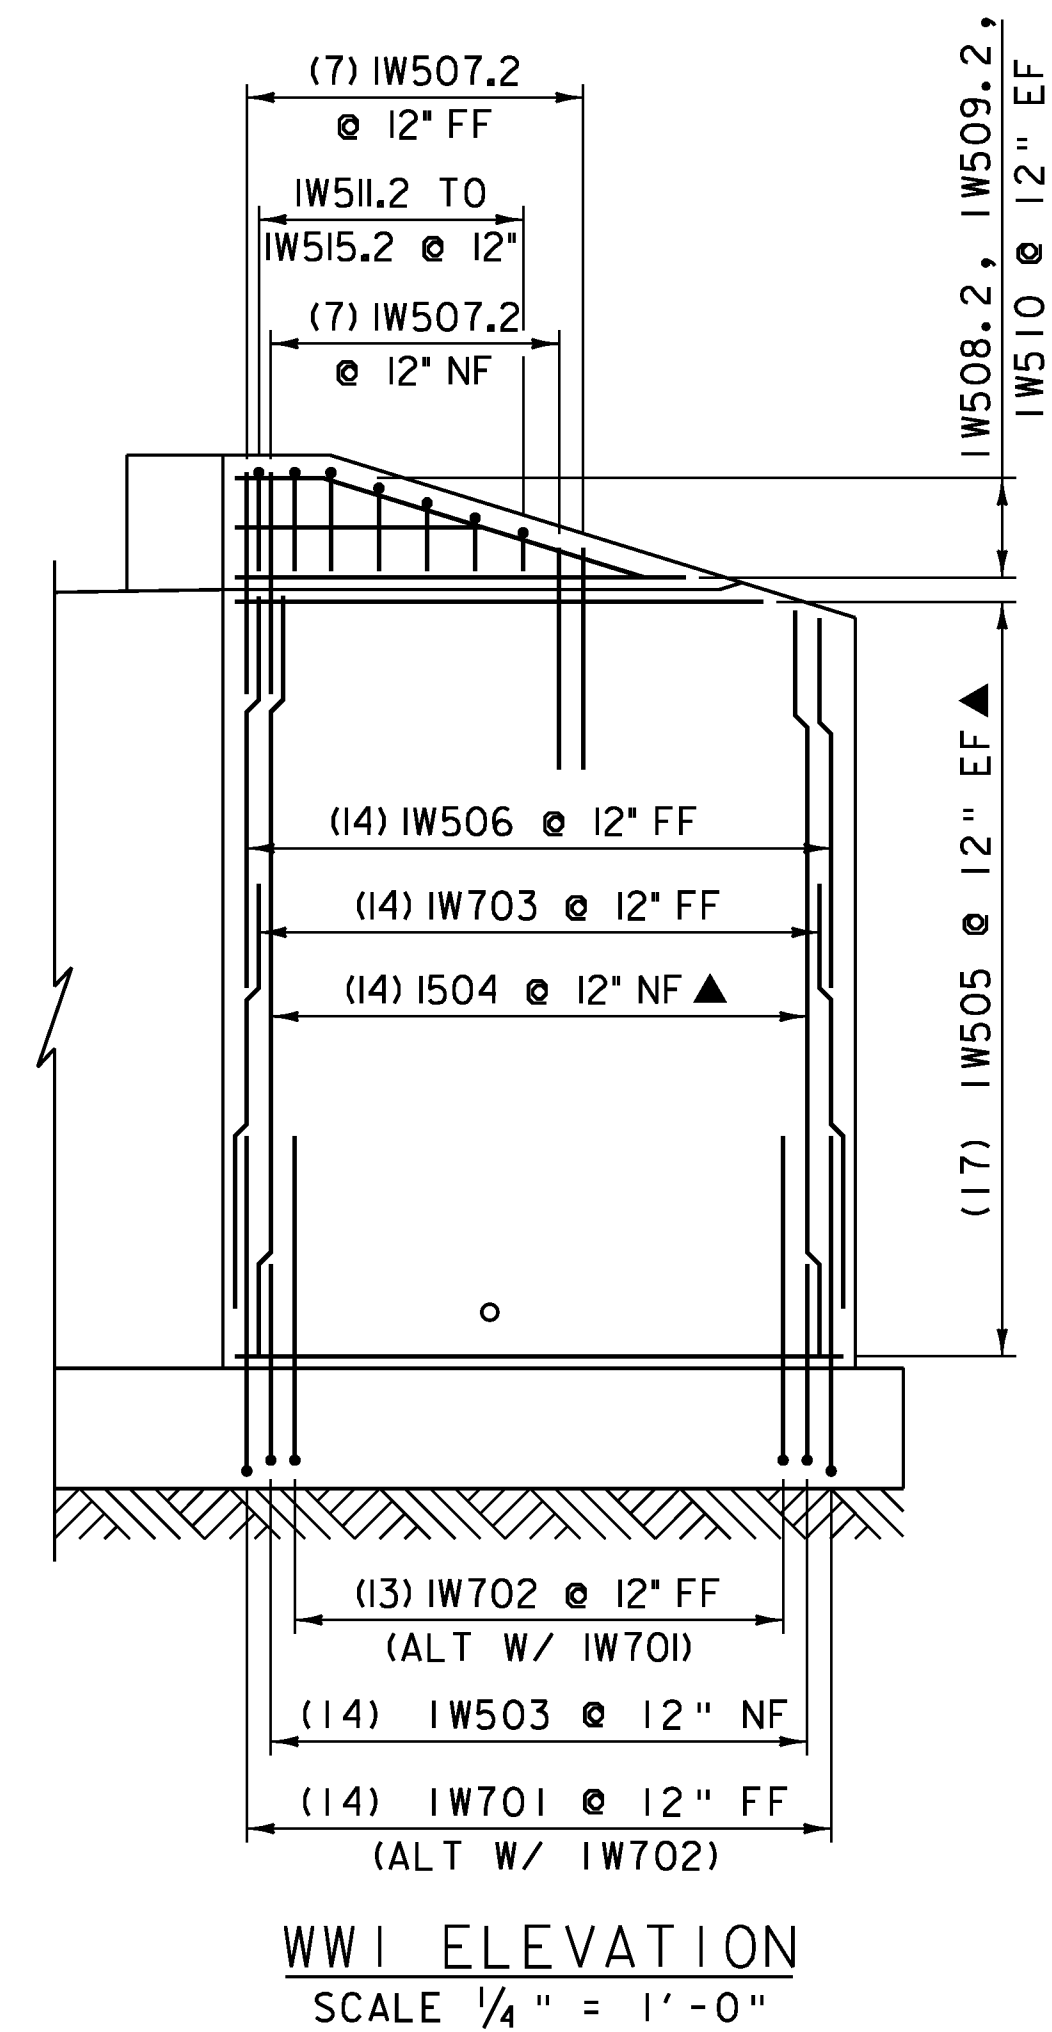

**WW1 ELEVATION**  
 SCALE 1/4" = 1'-0"

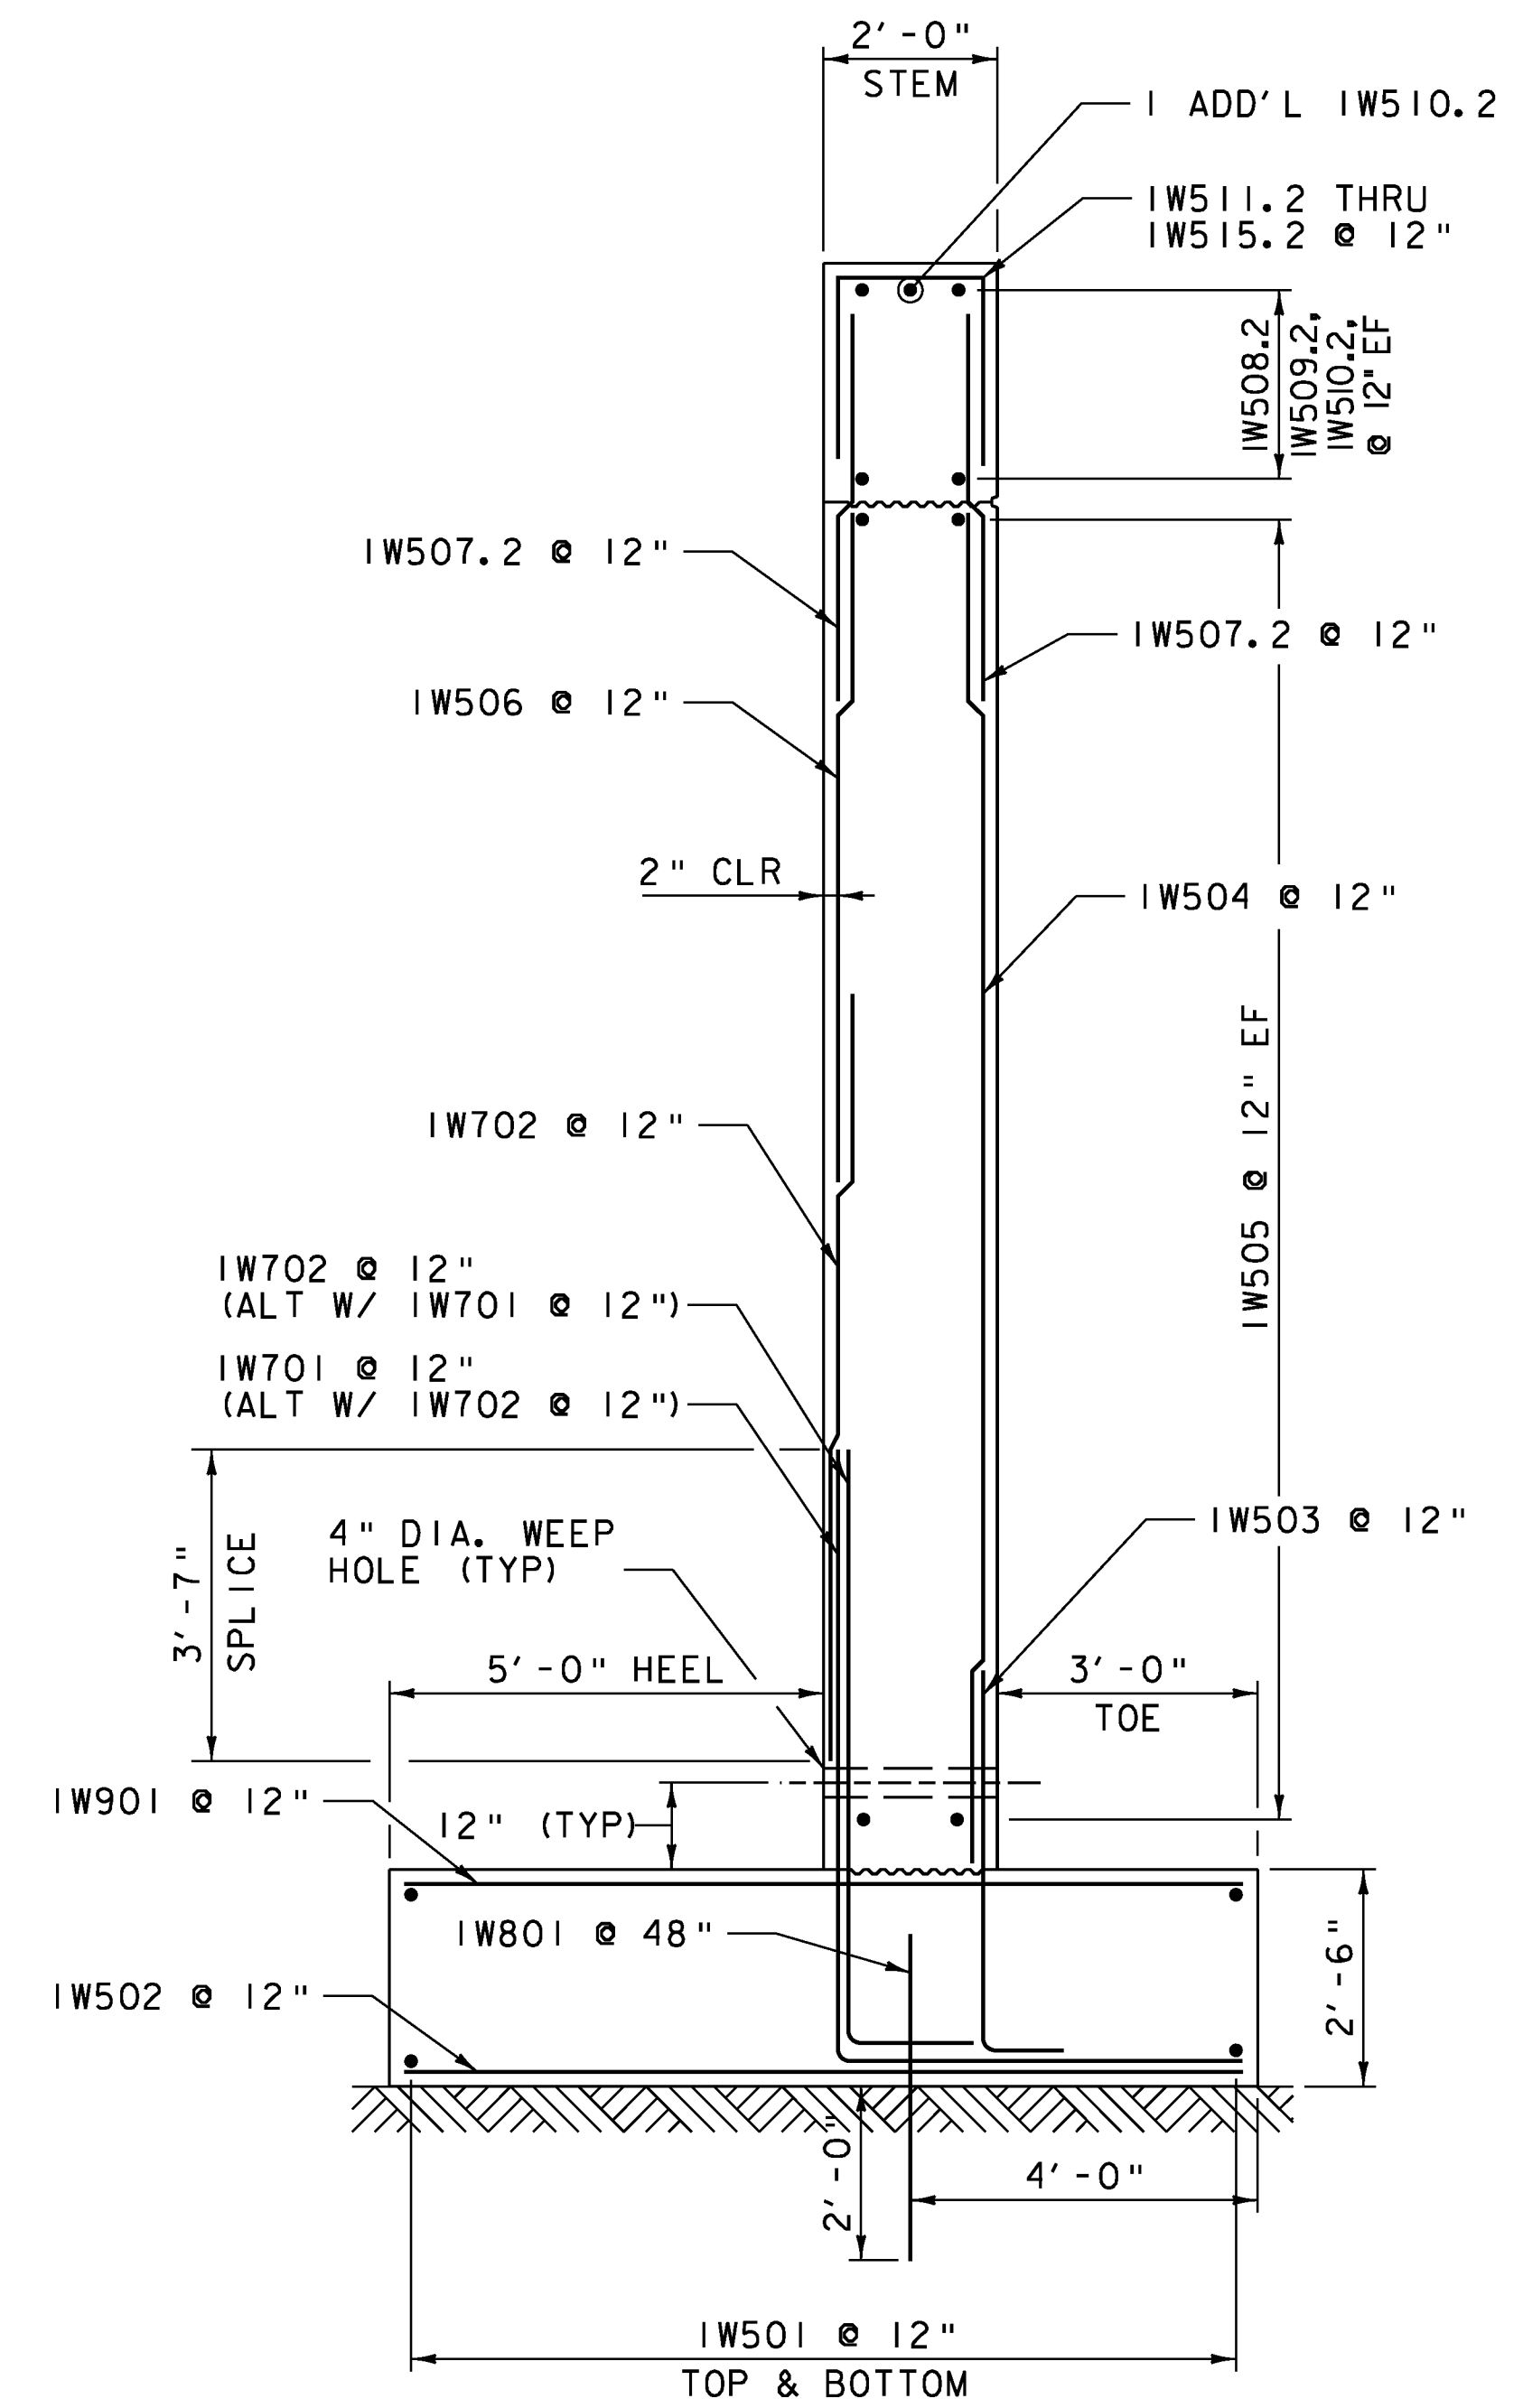

**WINGWALL NO. 1 TYPICAL**  
 SCALE 1/2" = 1'-0"

**NOTE:**

- NF = NEAR FACE
- FF = FAR FACE
- EF = EACH FACE
- ▲ = CUT TO FIT IN FIELD


3" CLEAR, UNLESS OTHERWISE SPECIFIED ON THE PLANS.

2'-2" BAR LAP UNLESS SPECIFIED ON THE PLANS.

PROJECT NAME: BRATTLEBORO  
 PROJECT NUMBER: BRO 1442(35)


FILE NAME: z10j062subl.dgn  
 PROJECT LEADER: S.E. BURBANK  
 DESIGNED BY: C.J. HAKY  
 WINGWALL NO. 1 ELEVATION & DETAILS

PLOT DATE: 10/14/2013  
 DRAWN BY: E.A. FIALA  
 CHECKED BY: S.E. BURBANK  
 SHEET 42 OF 68

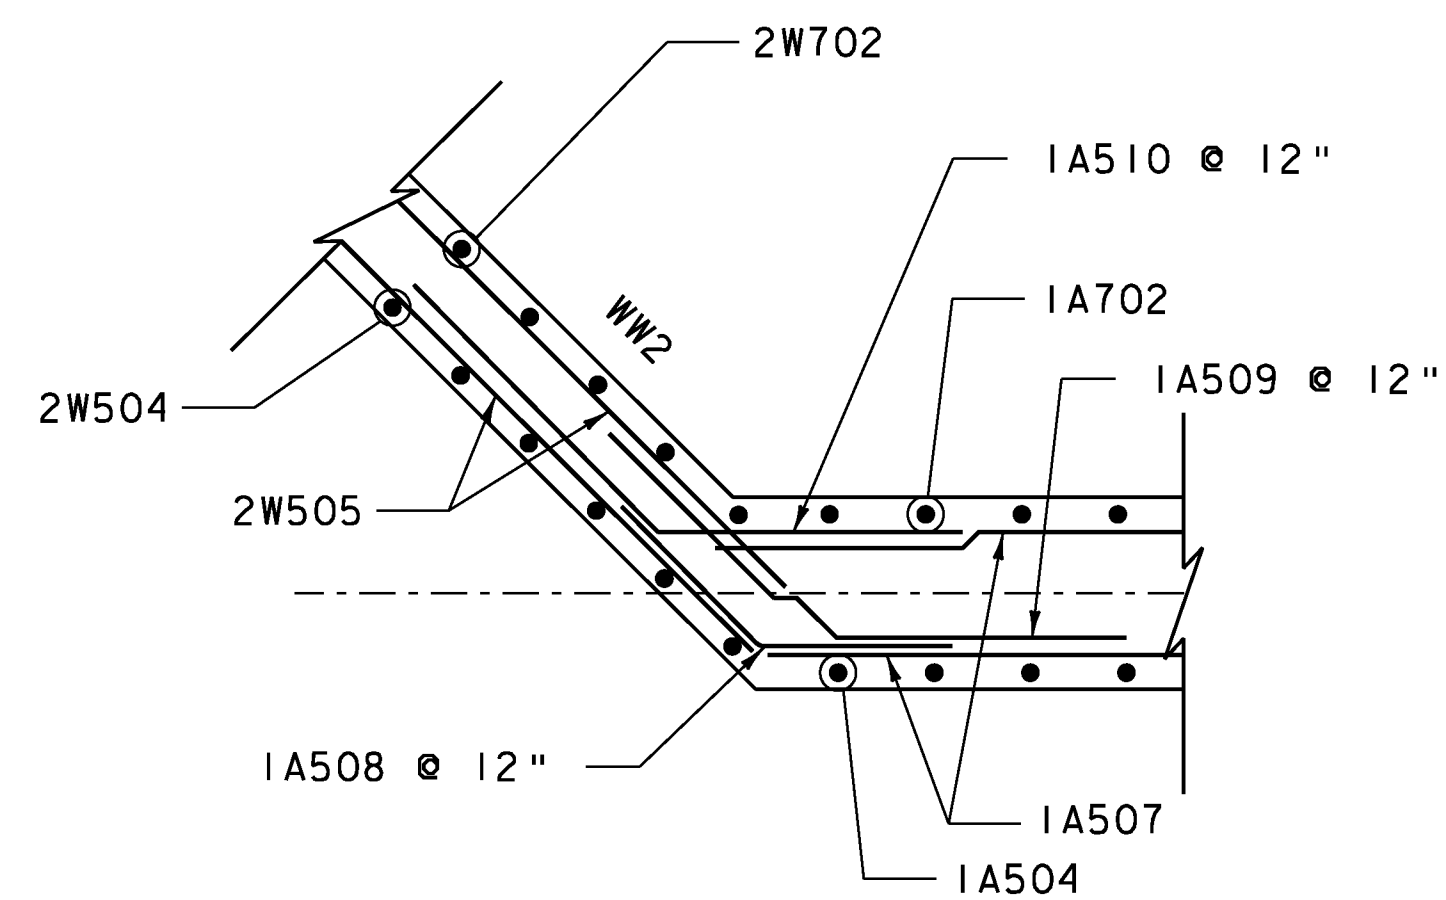


WINGWALL NO. 2 CORNER  
DETAIL BELOW SEAT

SCALE 1/2" = 1'-0"

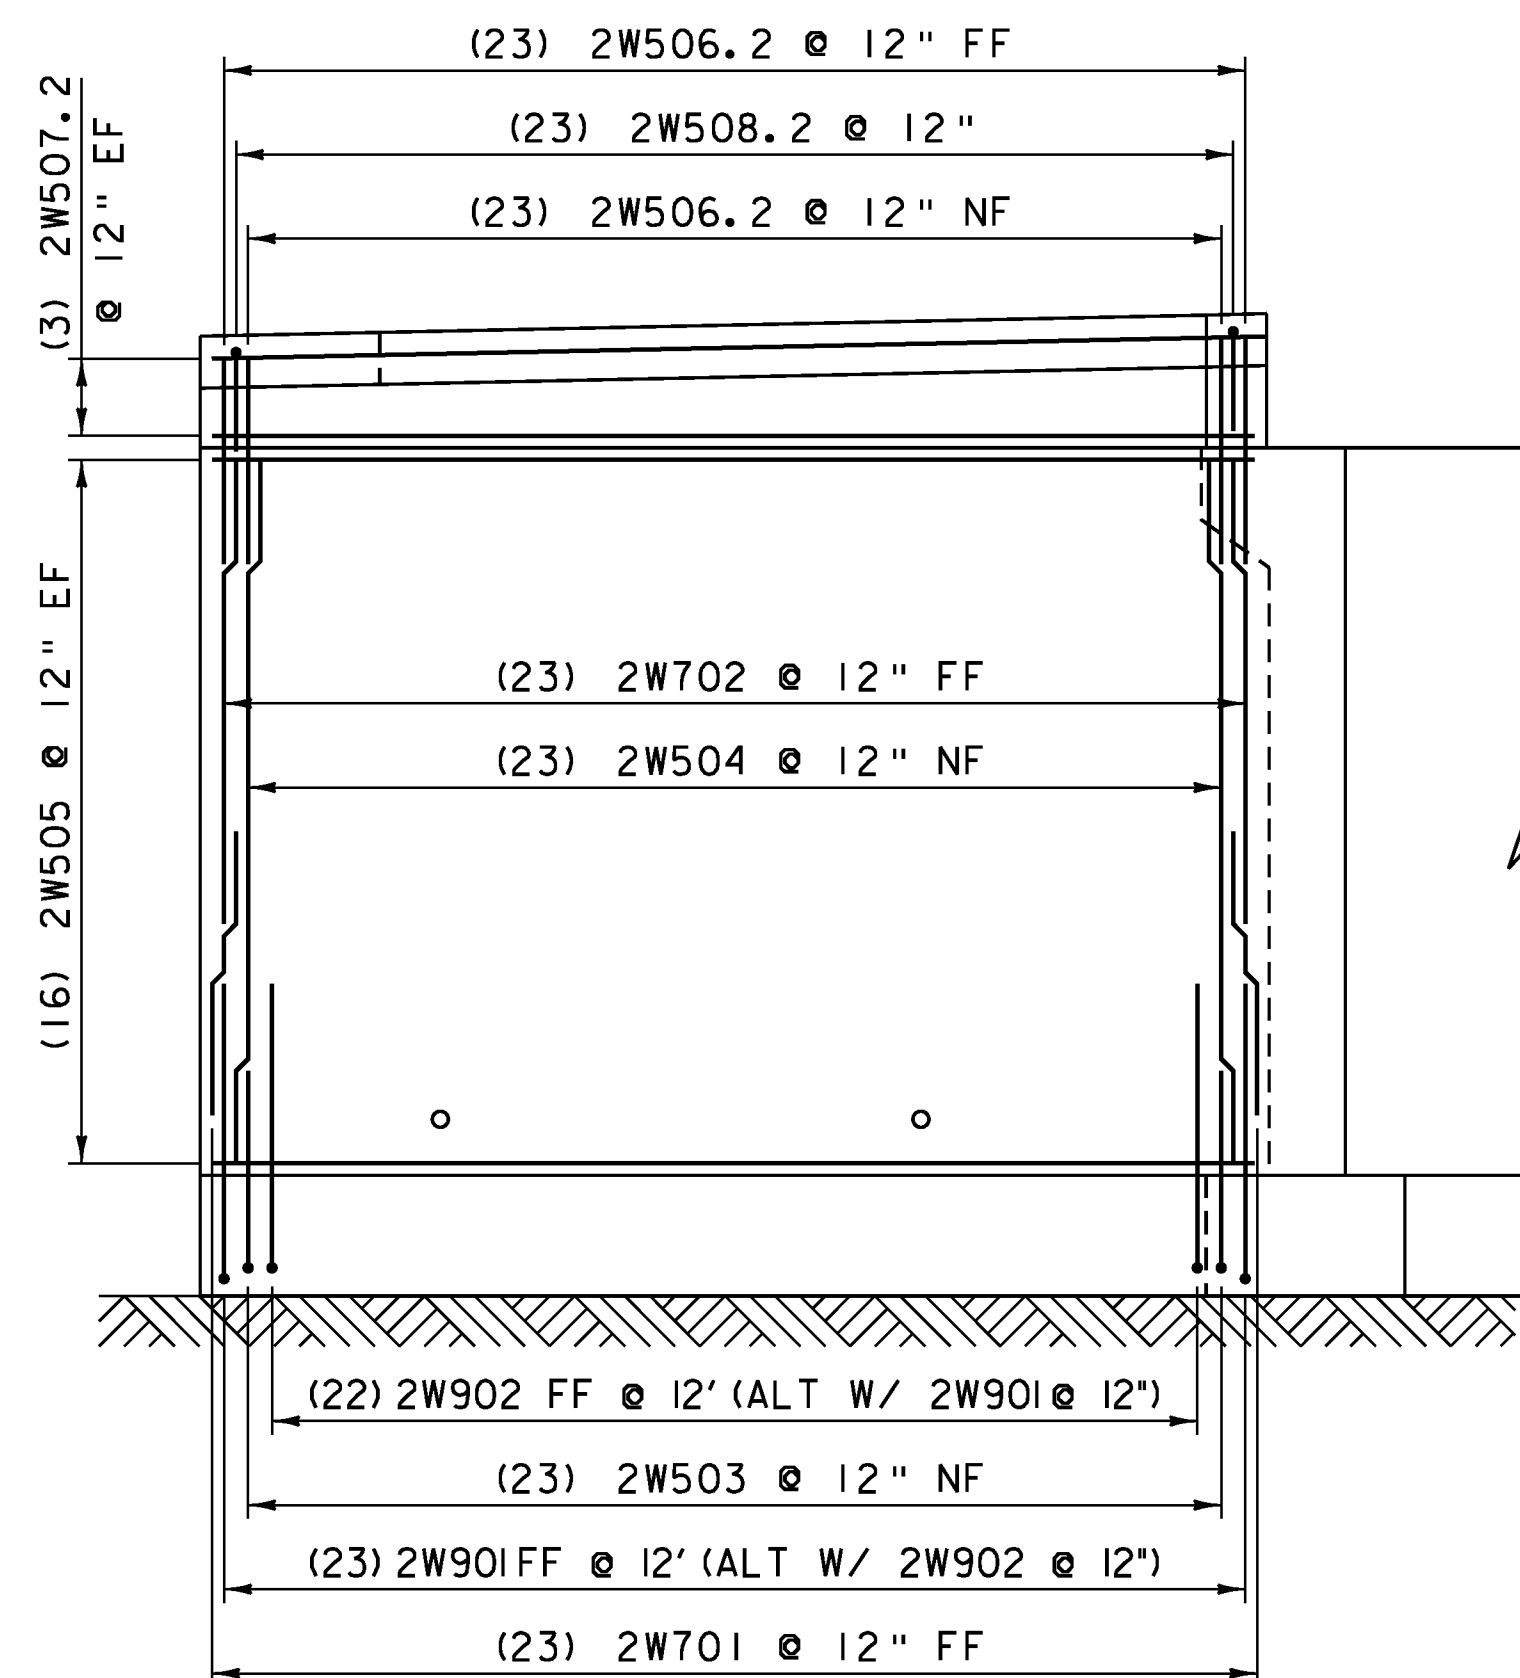

WW2 ELEVATION

SCALE 1/4" = 1'-0"

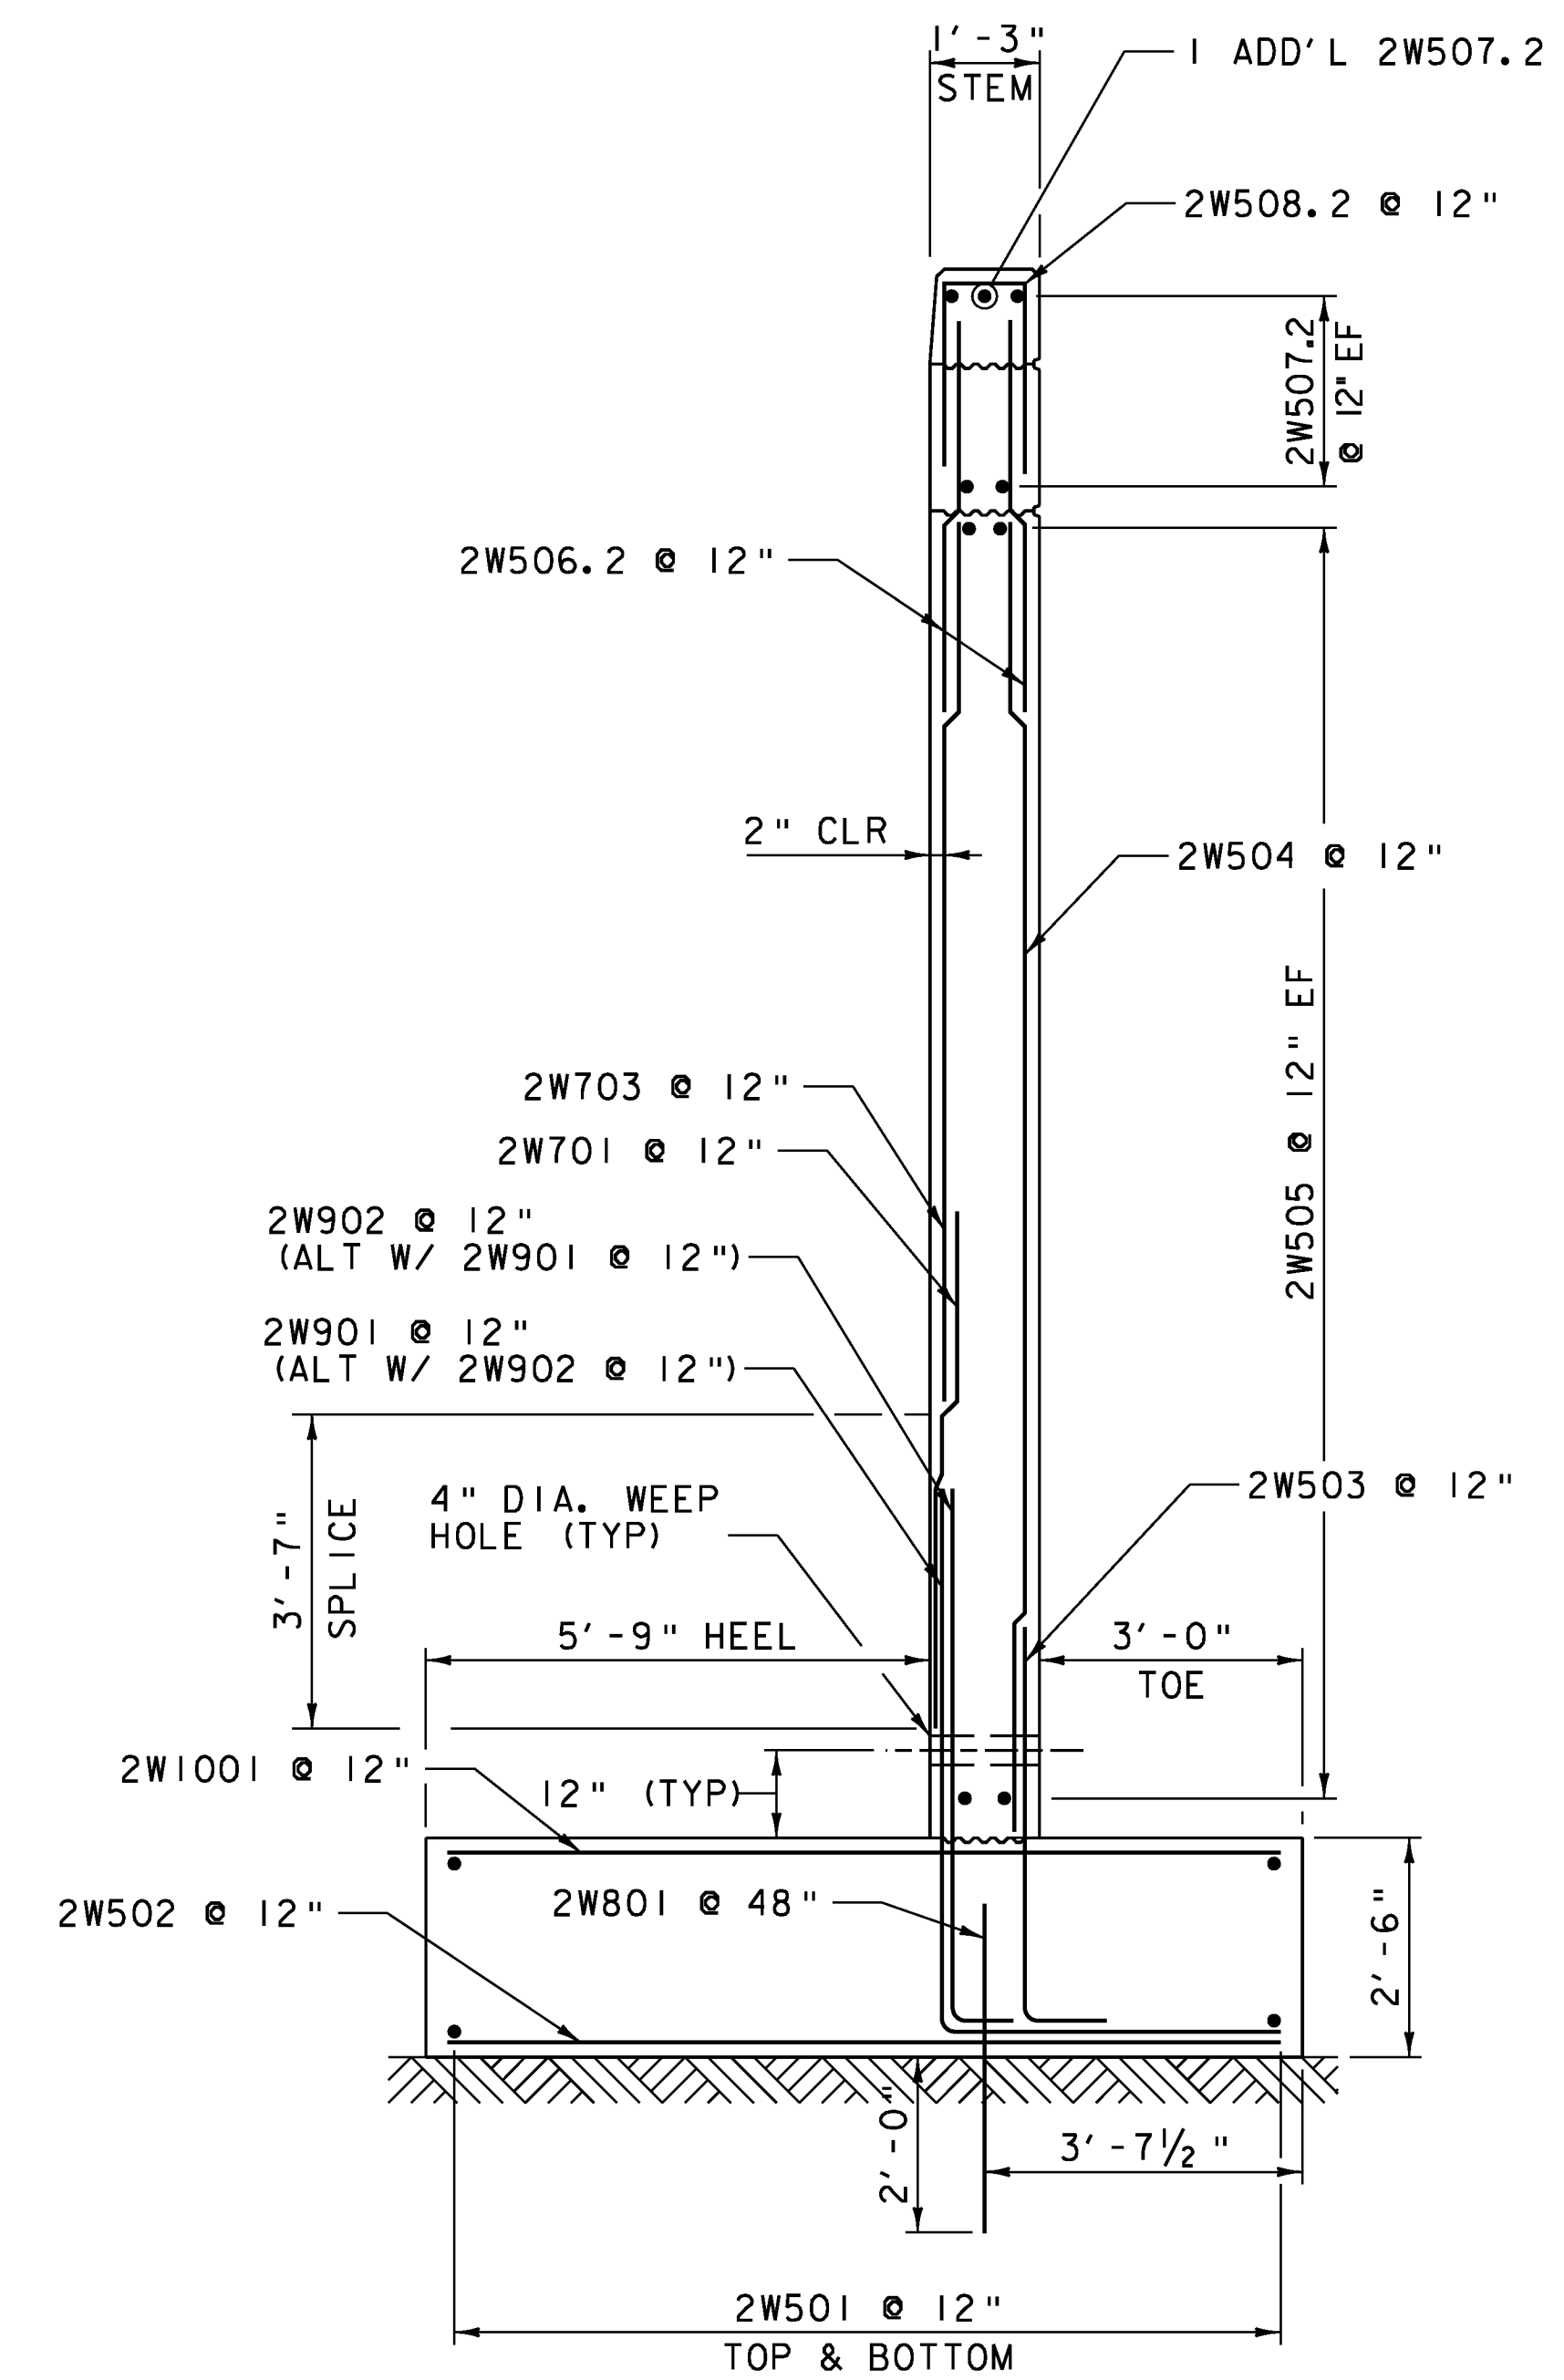

WINGWALL NO. 2 TYPICAL

SCALE 1/2" = 1'-0"

NOTE:

- NF = NEAR FACE
- FF = FAR FACE
- EF = EACH FACE
- ▲ = CUT TO FIT IN FIELD


3" CLEAR, UNLESS OTHERWISE SPECIFIED ON THE PLANS.

2'-2" BAR LAP UNLESS SPECIFIED ON THE PLANS.

PROJECT NAME: BRATTLEBORO  
PROJECT NUMBER: BRO 1442(35)

FILE NAME: z10j062subl.dgn  
PROJECT LEADER: S.E. BURBANK  
DESIGNED BY: C.J. HAKY  
WINGWALL NO. 2 ELEVATION & DETAILS


PLOT DATE: 10/14/2013  
DRAWN BY: E.A. FIALA  
CHECKED BY: S.E. BURBANK  
SHEET 43 OF 68

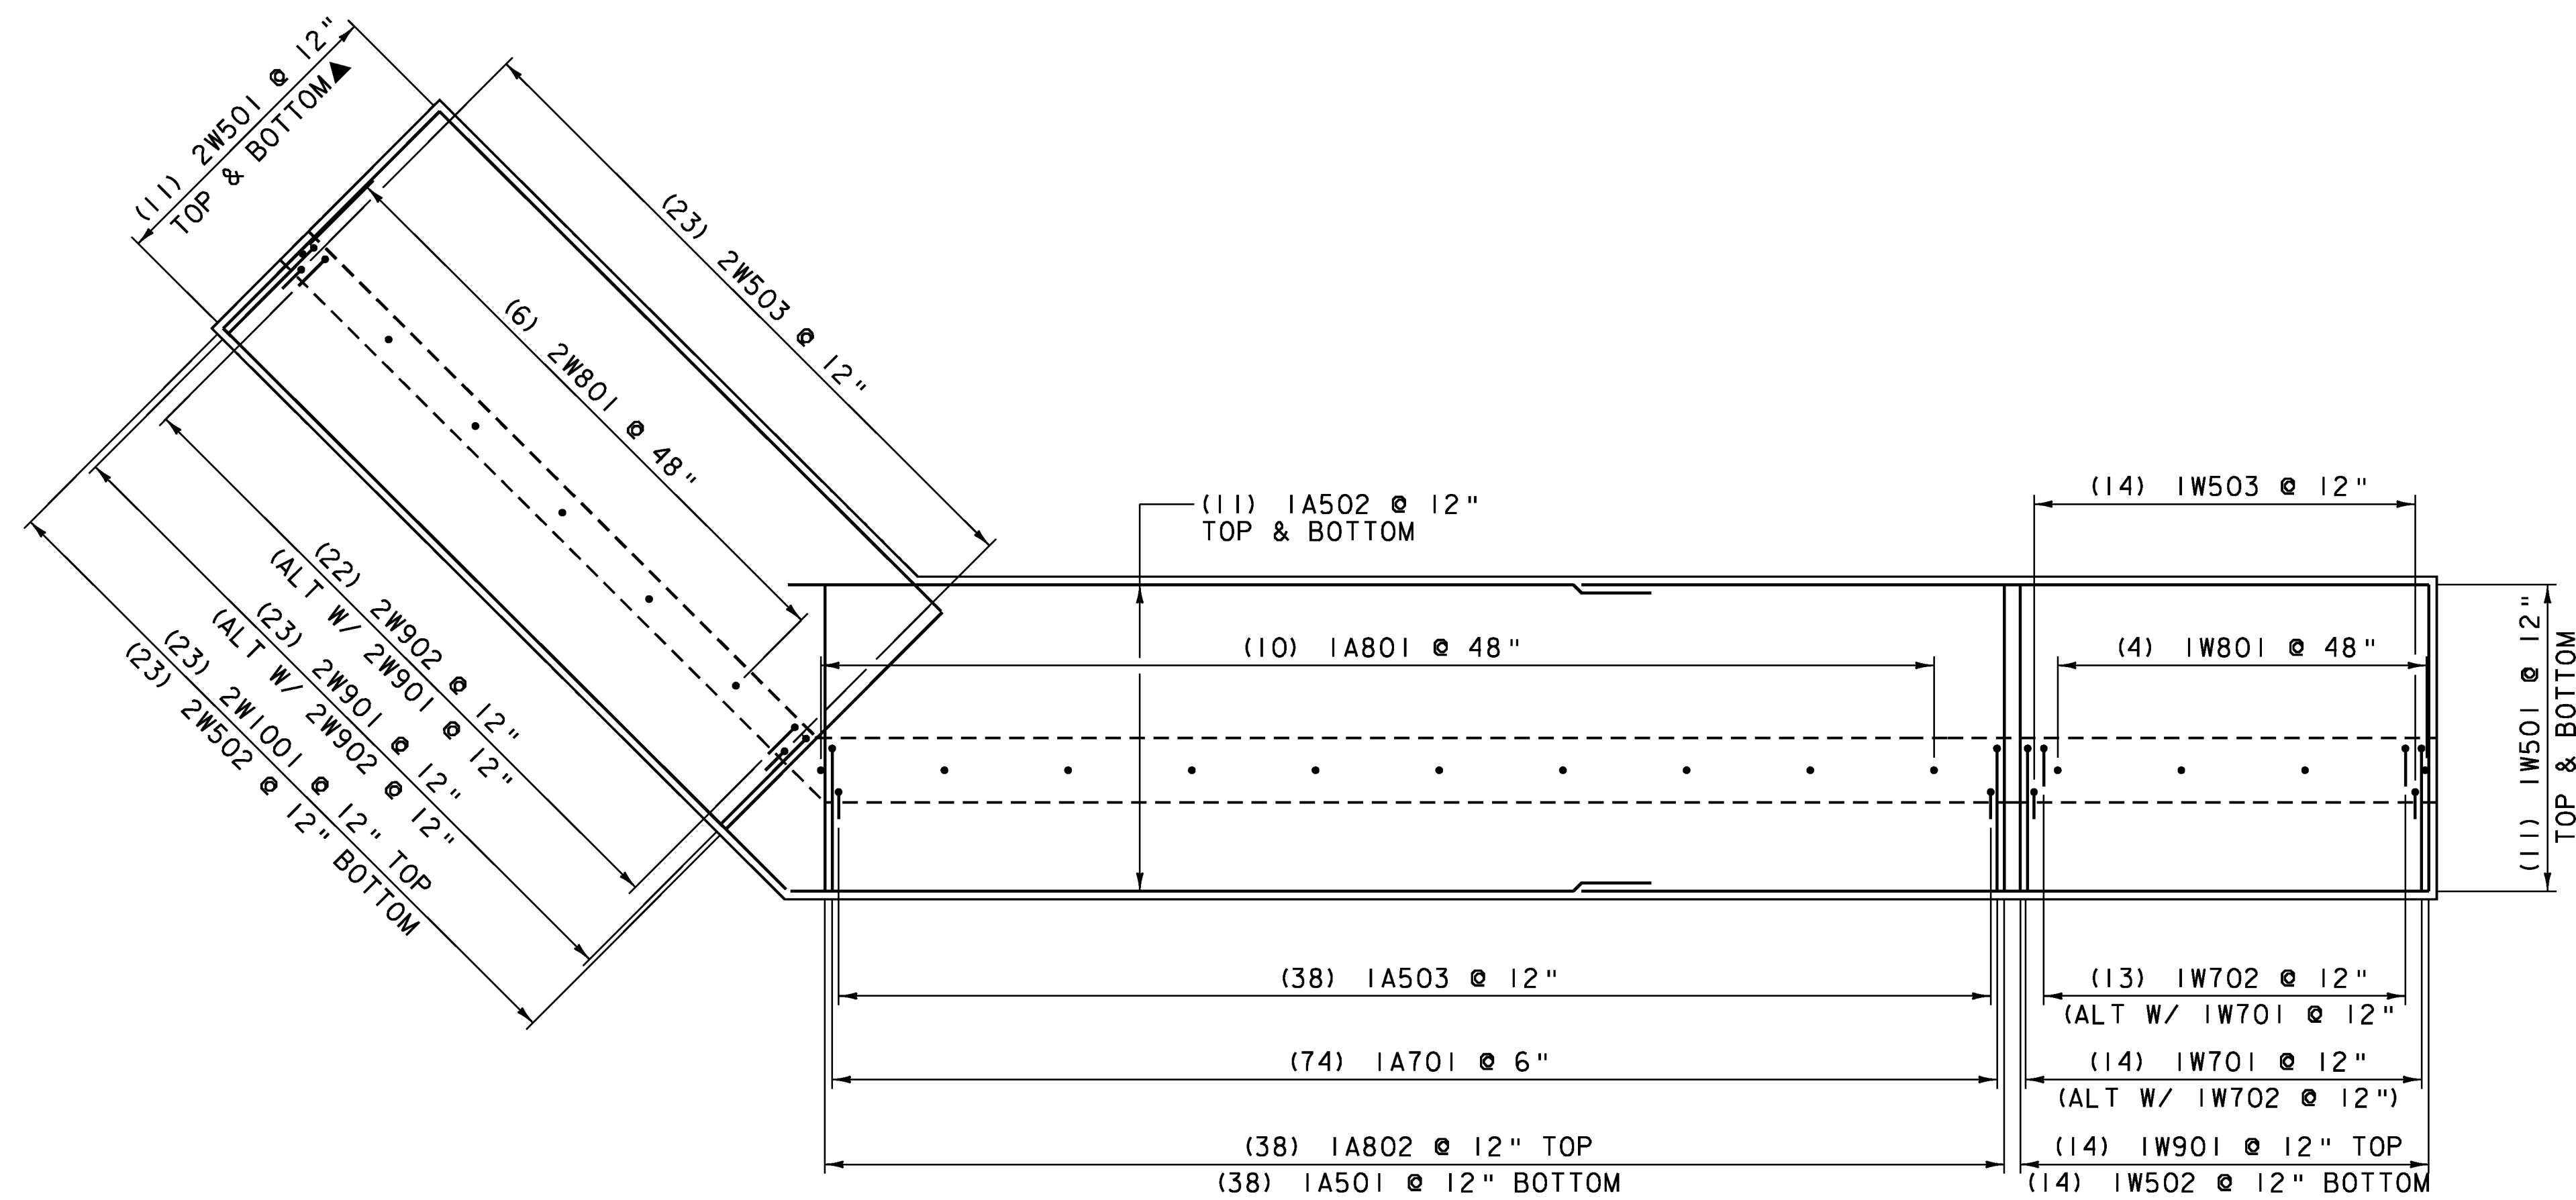


ABUTMENT NO. 1 FOOTING REINFORCING PLAN VIEW  
SCALE 1/4" = 1'-0"

**NOTE:**  
 NF = NEAR FACE  
 FF = FAR FACE  
 EF = EACH FACE  
 ▲ = CUT TO FIT IN FIELD  
 3" CLEAR, UNLESS OTHERWISE SPECIFIED ON THE PLANS.  
 2'-2" BAR LAP UNLESS SPECIFIED ON THE PLANS.


PROJECT NAME: BRATTLEBORO	PROJECT NUMBER: BRO 1442(35)
FILE NAME: z10j062subl.dgn	PLOT DATE: 10/14/2013
PROJECT LEADER: S.E. BURBANK	DRAWN BY: E.A. FIALA
DESIGNED BY: C.J. HAKY	CHECKED BY: S.E. BURBANK
ABUTMENT NO. 1 FOOTING PLAN	SHEET 44 OF 68

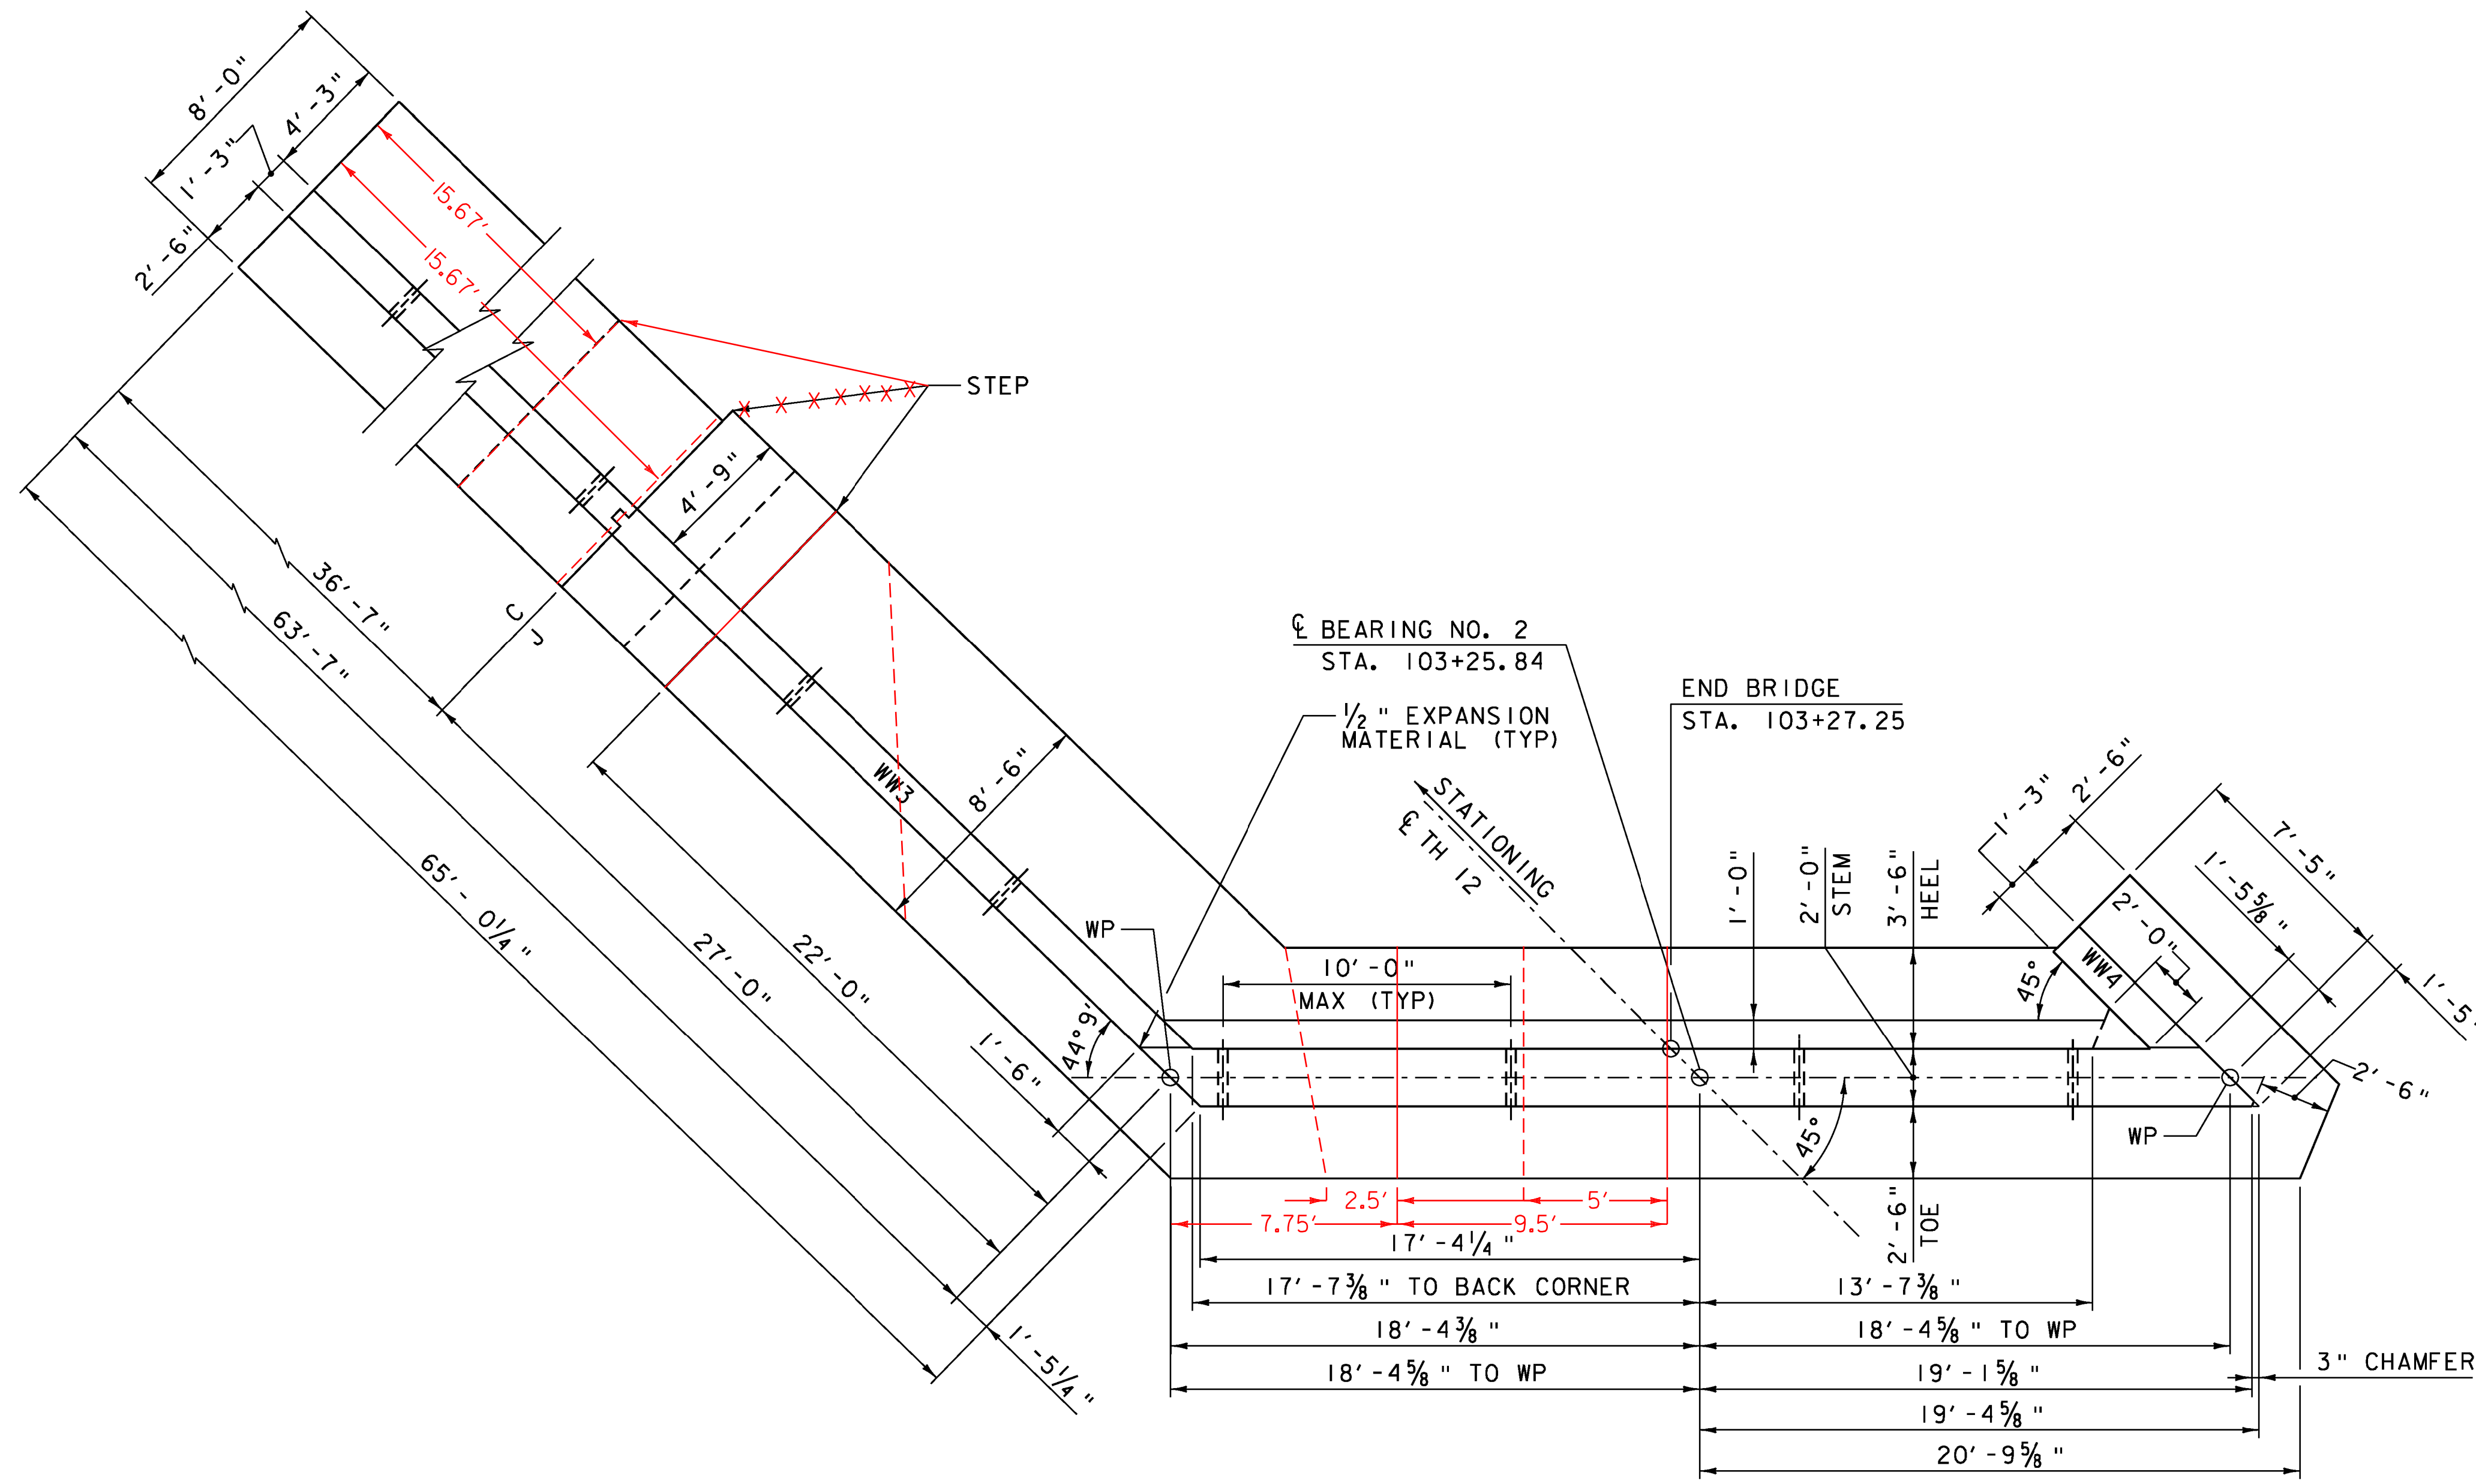

ABUTMENT NO. 2 PLAN VIEW  
SCALE 1/4" = 1'-0"

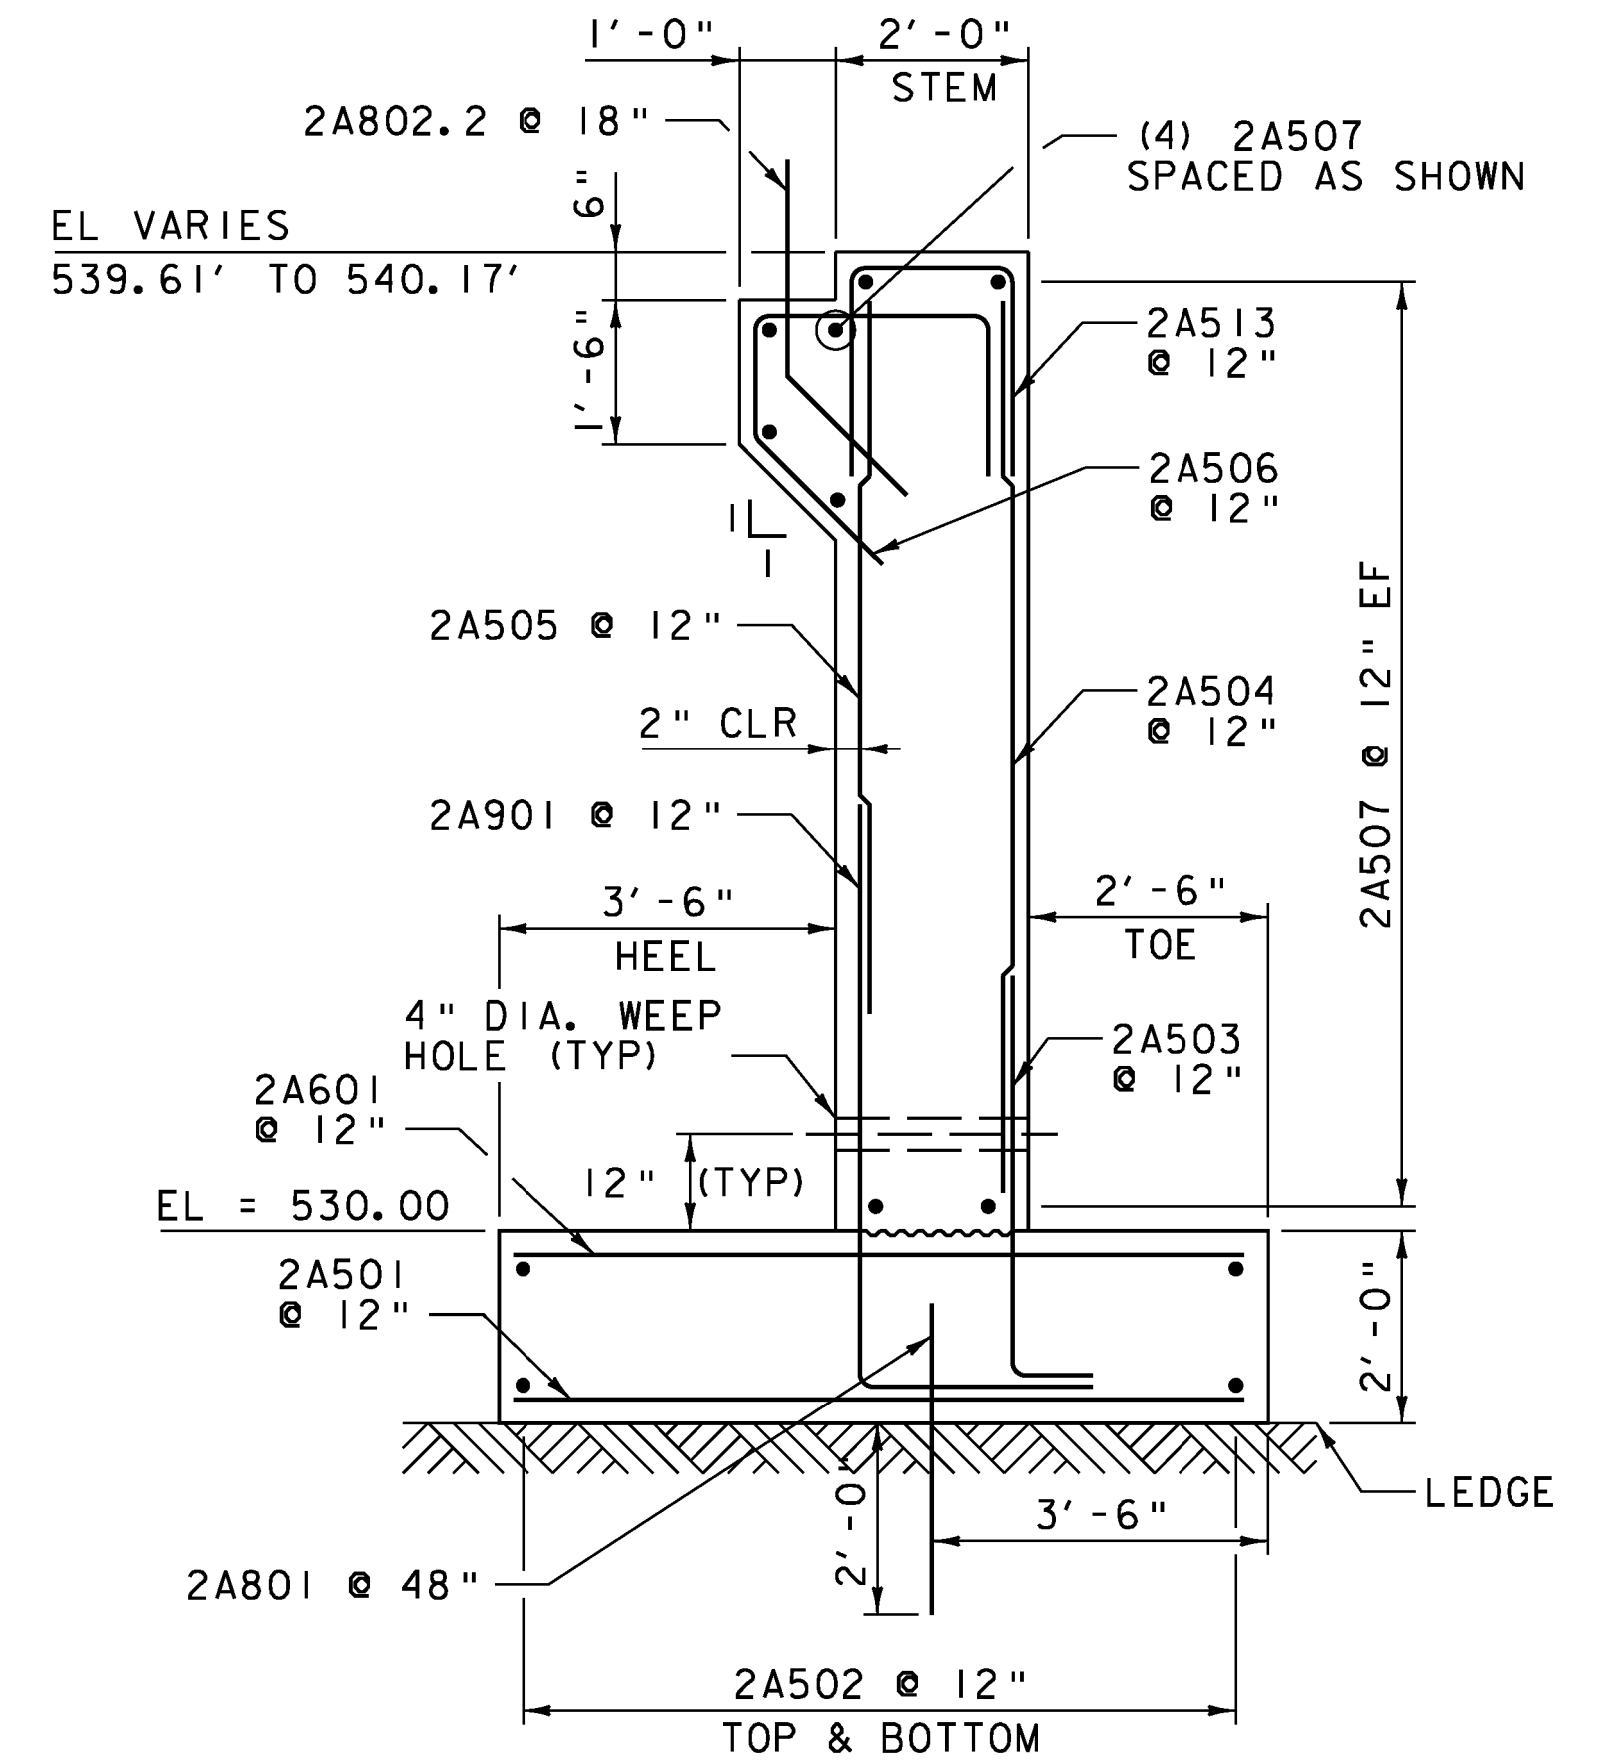

ABUTMENT NO. 2 TYPICAL  
SCALE 1/2" = 1'-0"

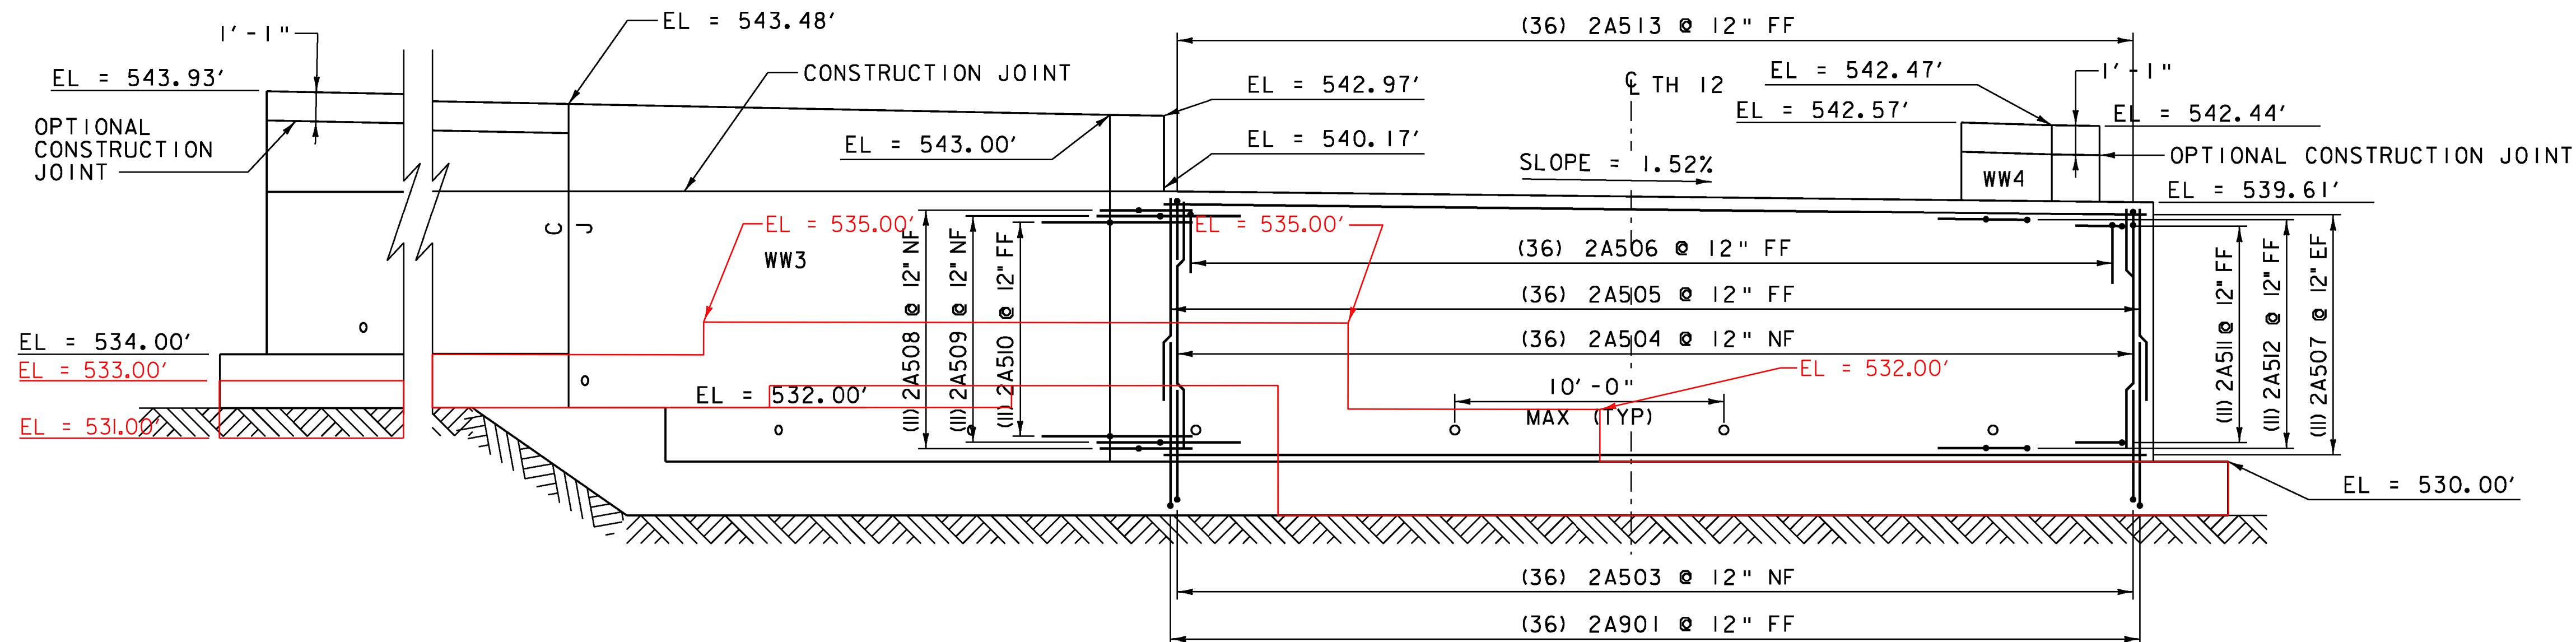

ABUTMENT NO. 2 ELEVATION  
SCALE 1/4" = 1'-0"


NOTE:  
 NF = NEAR FACE  
 FF = FAR FACE  
 EF = EACH FACE  
 ▲ = CUT TO FIT IN FIELD  
 3" CLEAR, UNLESS OTHERWISE SPECIFIED ON THE PLANS.  
 2'-2" BAR LAP UNLESS SPECIFIED ON THE PLANS.

PROJECT NAME: BRATTLEBORO  
 PROJECT NUMBER: BRO 1442(35)


FILE NAME: z10j062sub2.dgn  
 PROJECT LEADER: S.E. BURBANK  
 DESIGNED BY: C.J. HAKY  
 ABUTMENT NO. 2 PLAN & ELEVATION

PLOT DATE: 10/14/2013  
 DRAWN BY: E.A. FIALA  
 CHECKED BY: S.E. BURBANK  
 SHEET 45 OF 68




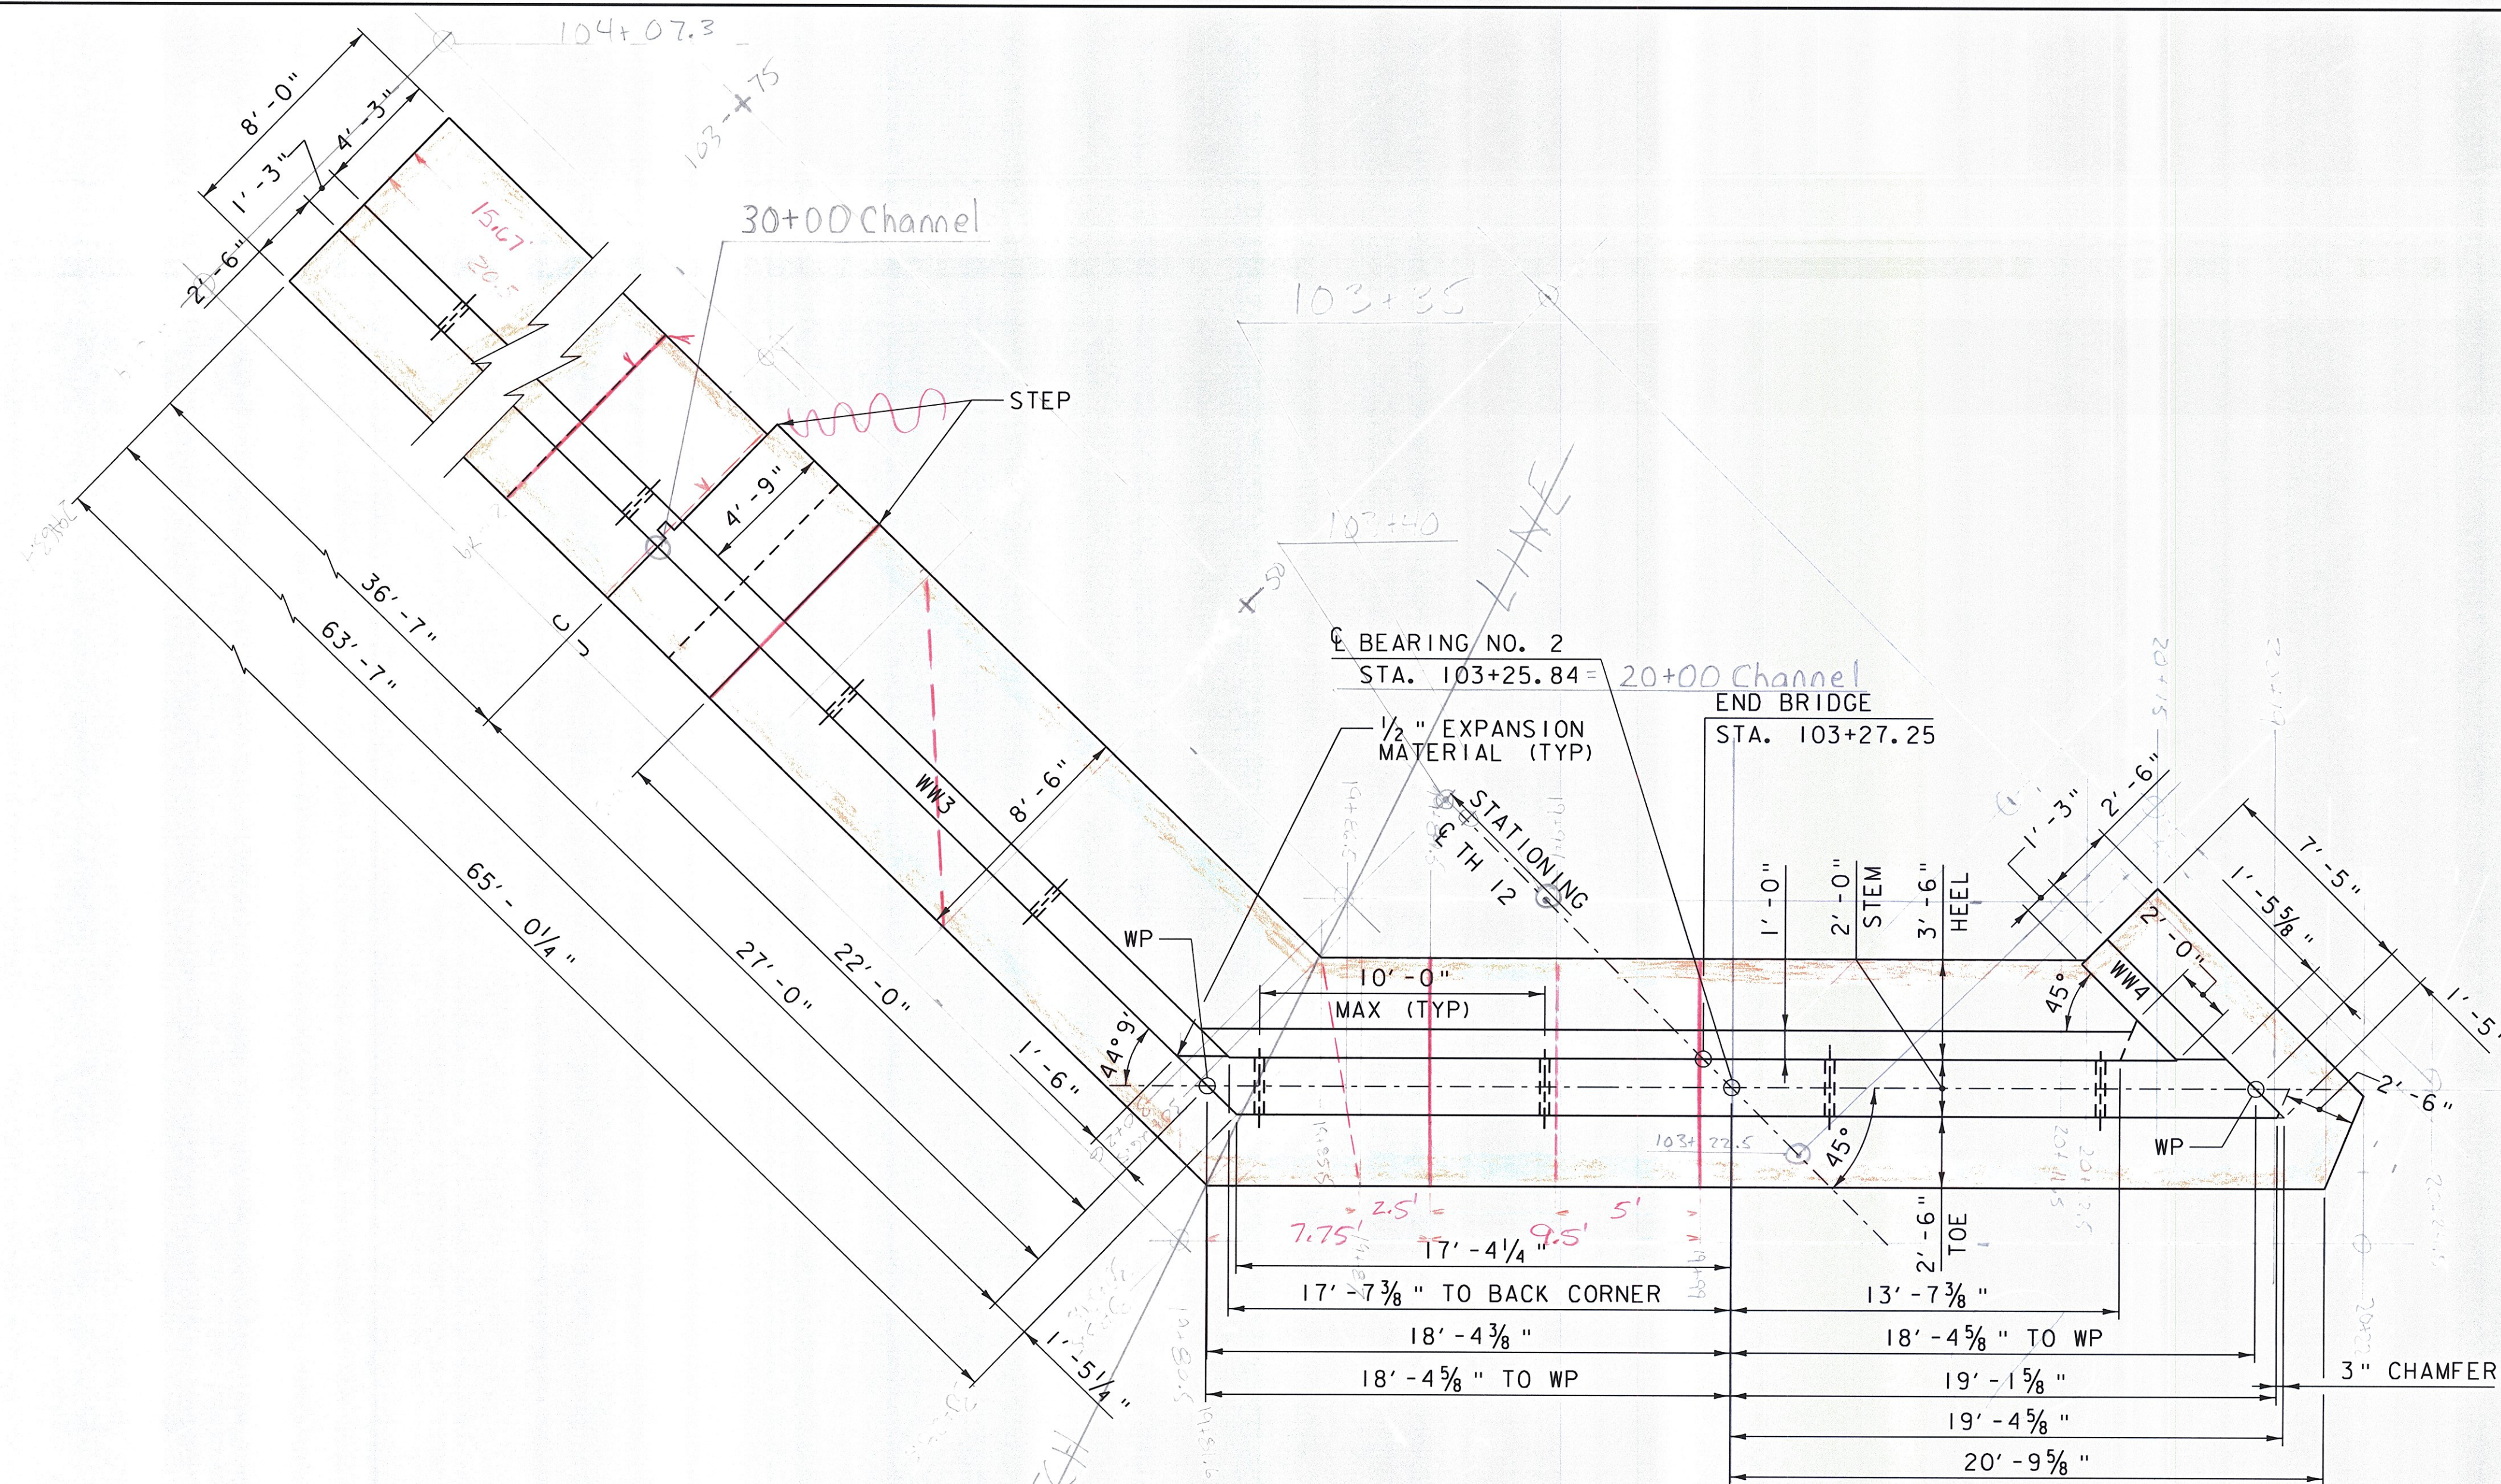

ABUTMENT NO. 2 PLAN VIEW  
SCALE 1/4" = 1'-0"

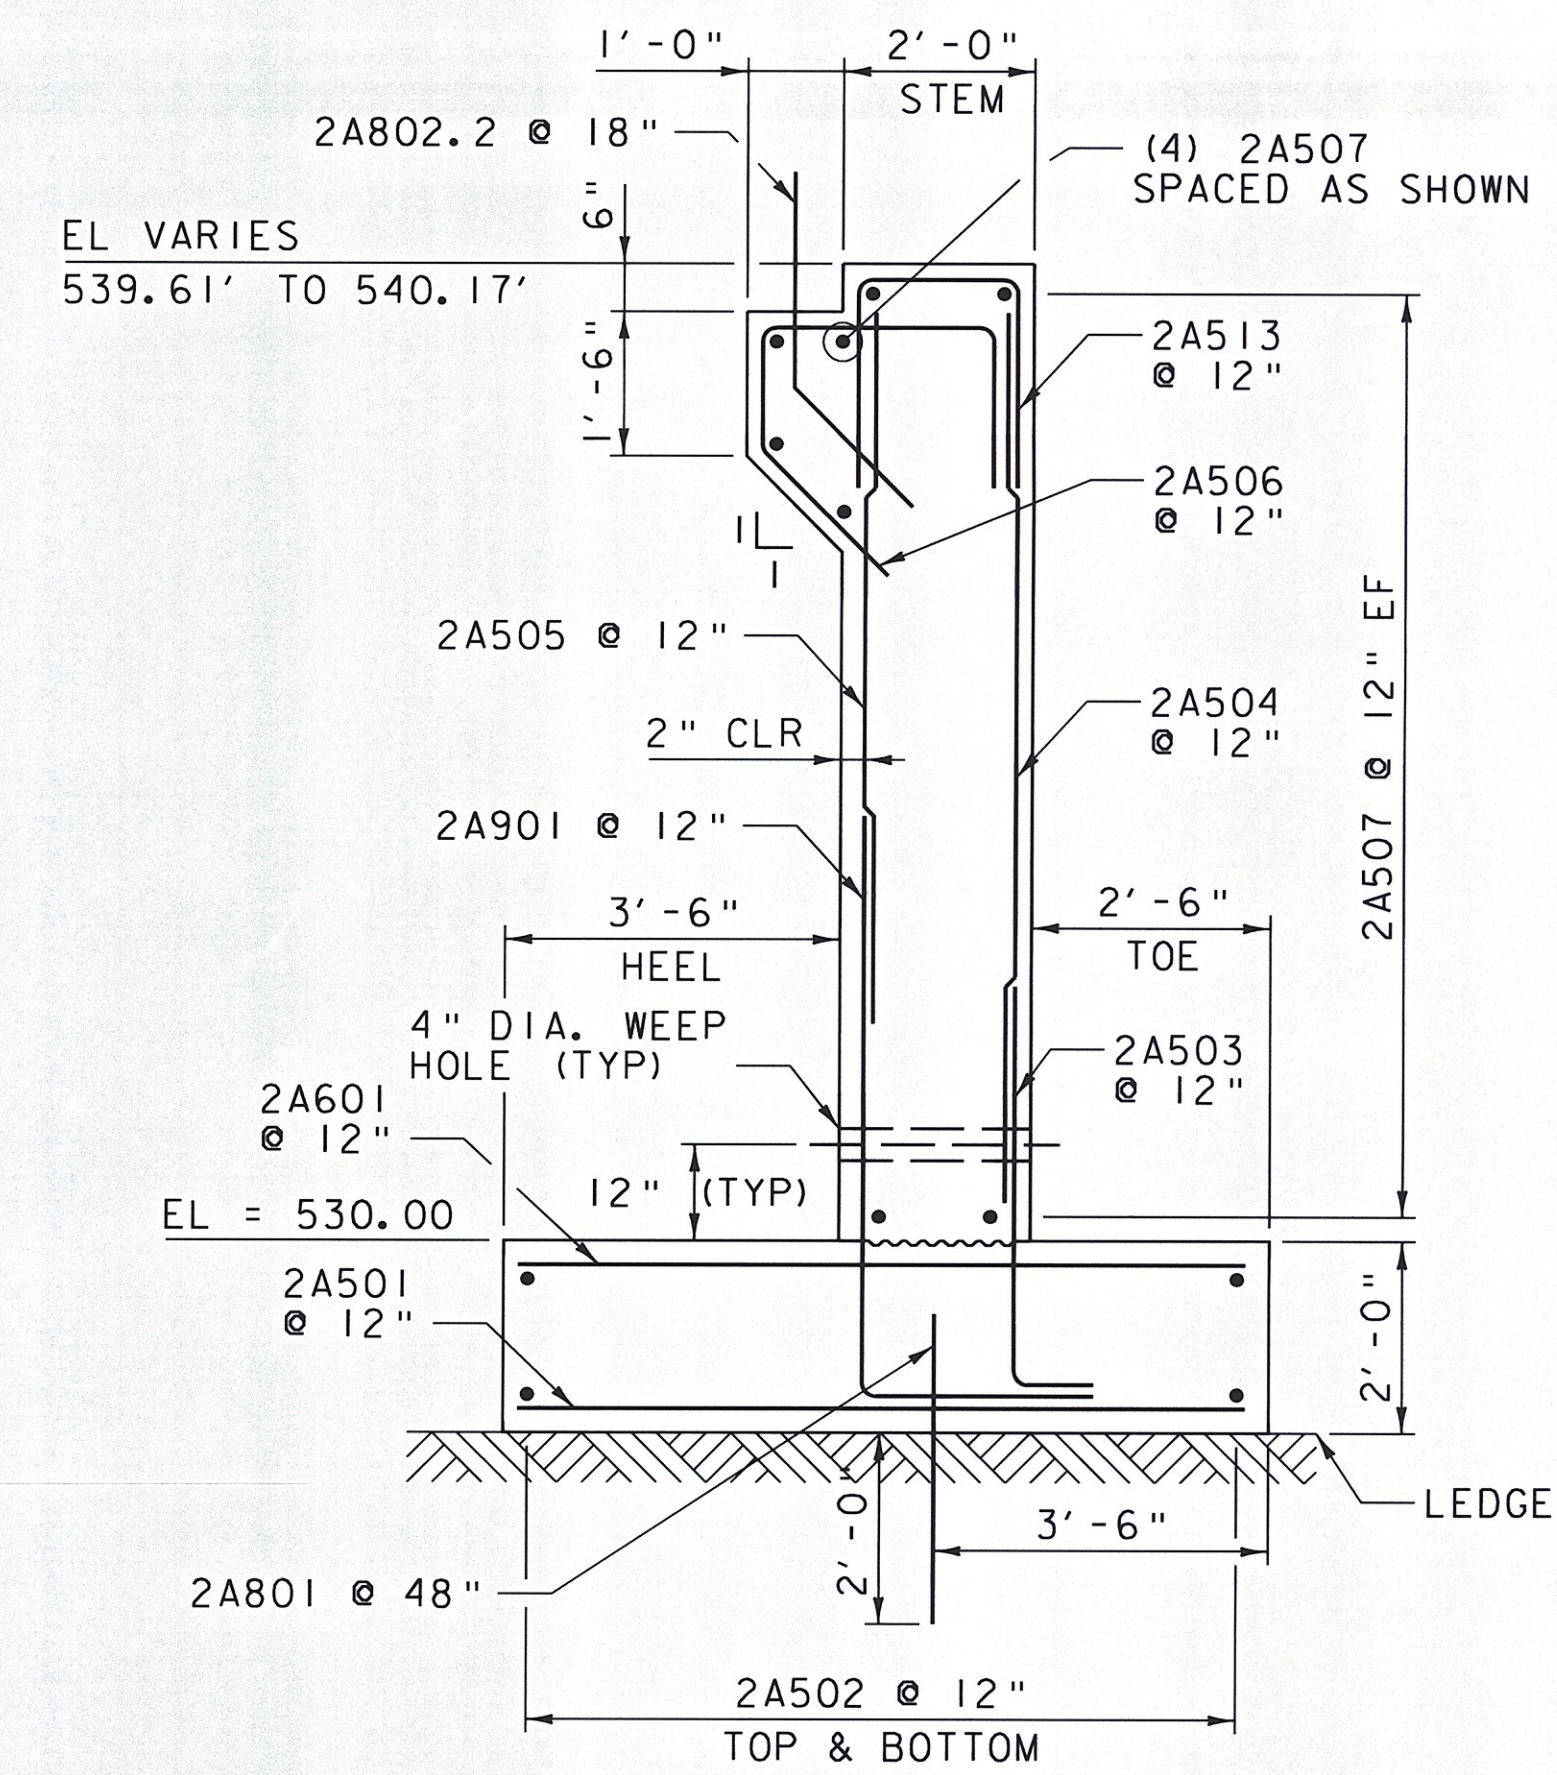

ABUTMENT NO. 2 TYPICAL  
SCALE 1/2" = 1'-0"

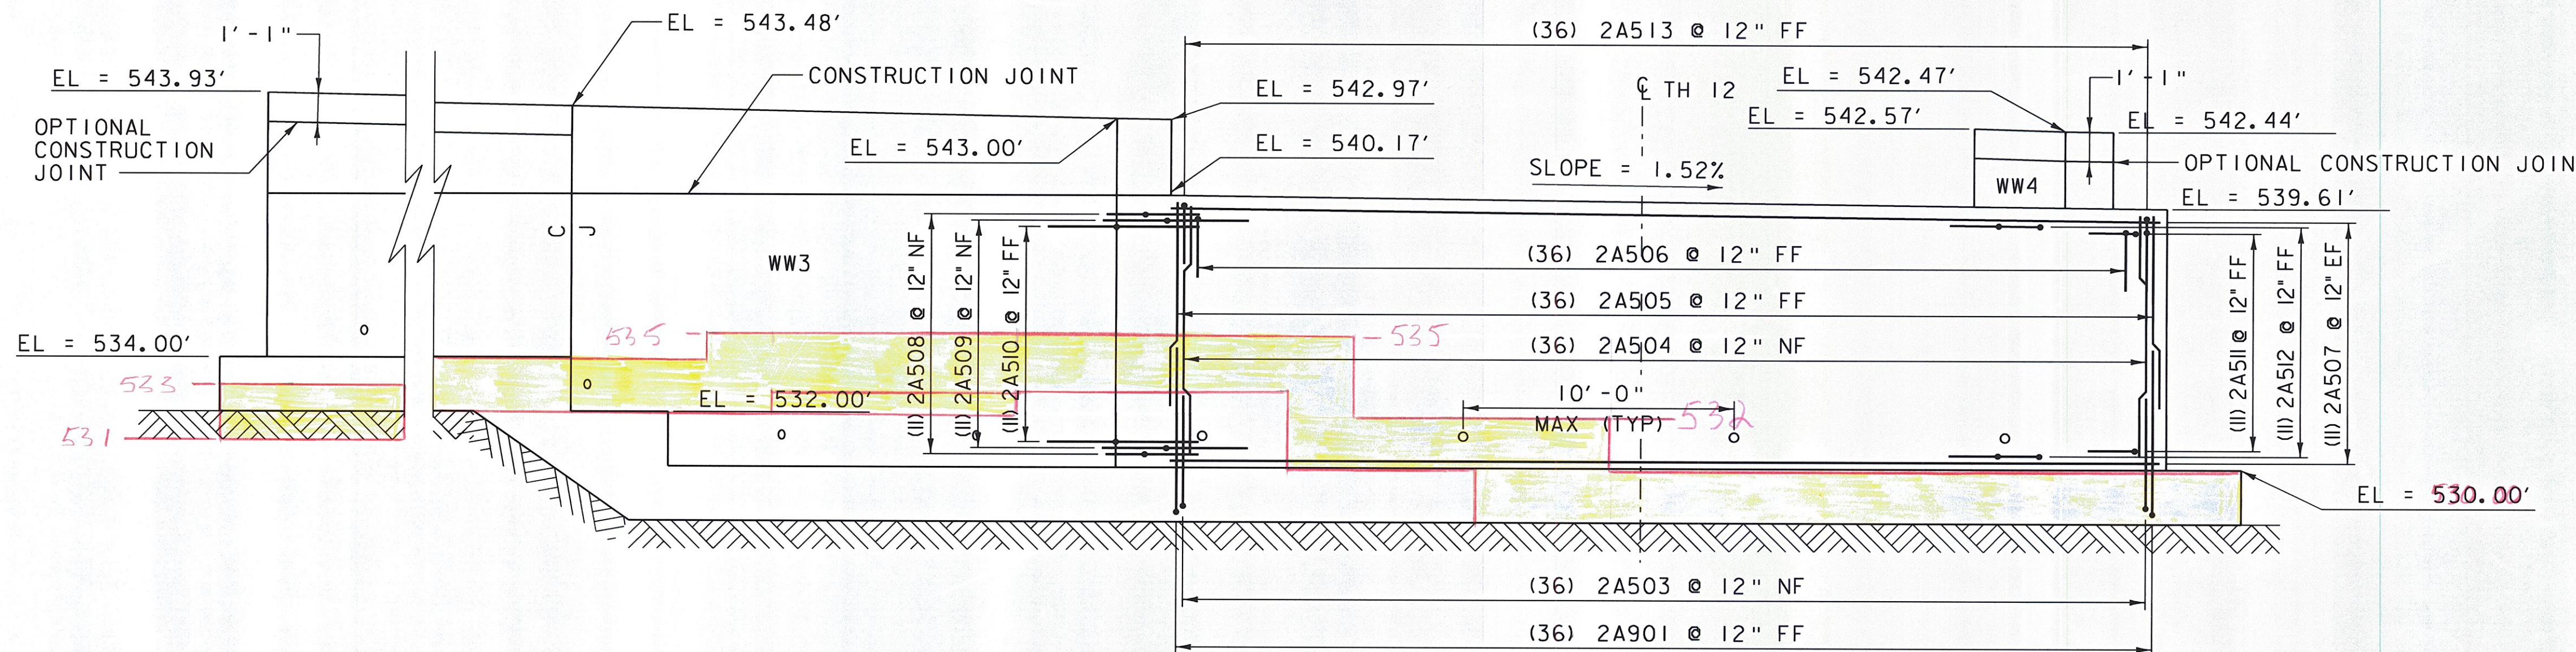

ABUTMENT NO. 2 ELEVATION  
SCALE 1/4" = 1'-0"


NOTE:  
NF = NEAR FACE  
FF = FAR FACE  
EF = EACH FACE  
▲ = CUT TO FIT IN FIELD  
3" CLEAR, UNLESS OTHERWISE SPECIFIED ON THE PLANS.  
2'-2" BAR LAP UNLESS SPECIFIED ON THE PLANS.

PROJECT NAME:	BRATTLEBORO <i>Footings - As Built</i>
PROJECT NUMBER:	BRO 1442(35)
FILE NAME:	z10j062sub2.dgn
PROJECT LEADER:	S.E. BURBANK
DESIGNED BY:	C.J. HAKKEY
ABUTMENT NO. 2 PLAN & ELEVATION	
PLOT DATE:	10/14/2013
DRAWN BY:	E.A. FIALA
CHECKED BY:	S.E. BURBANK
SHEET	45 OF 68







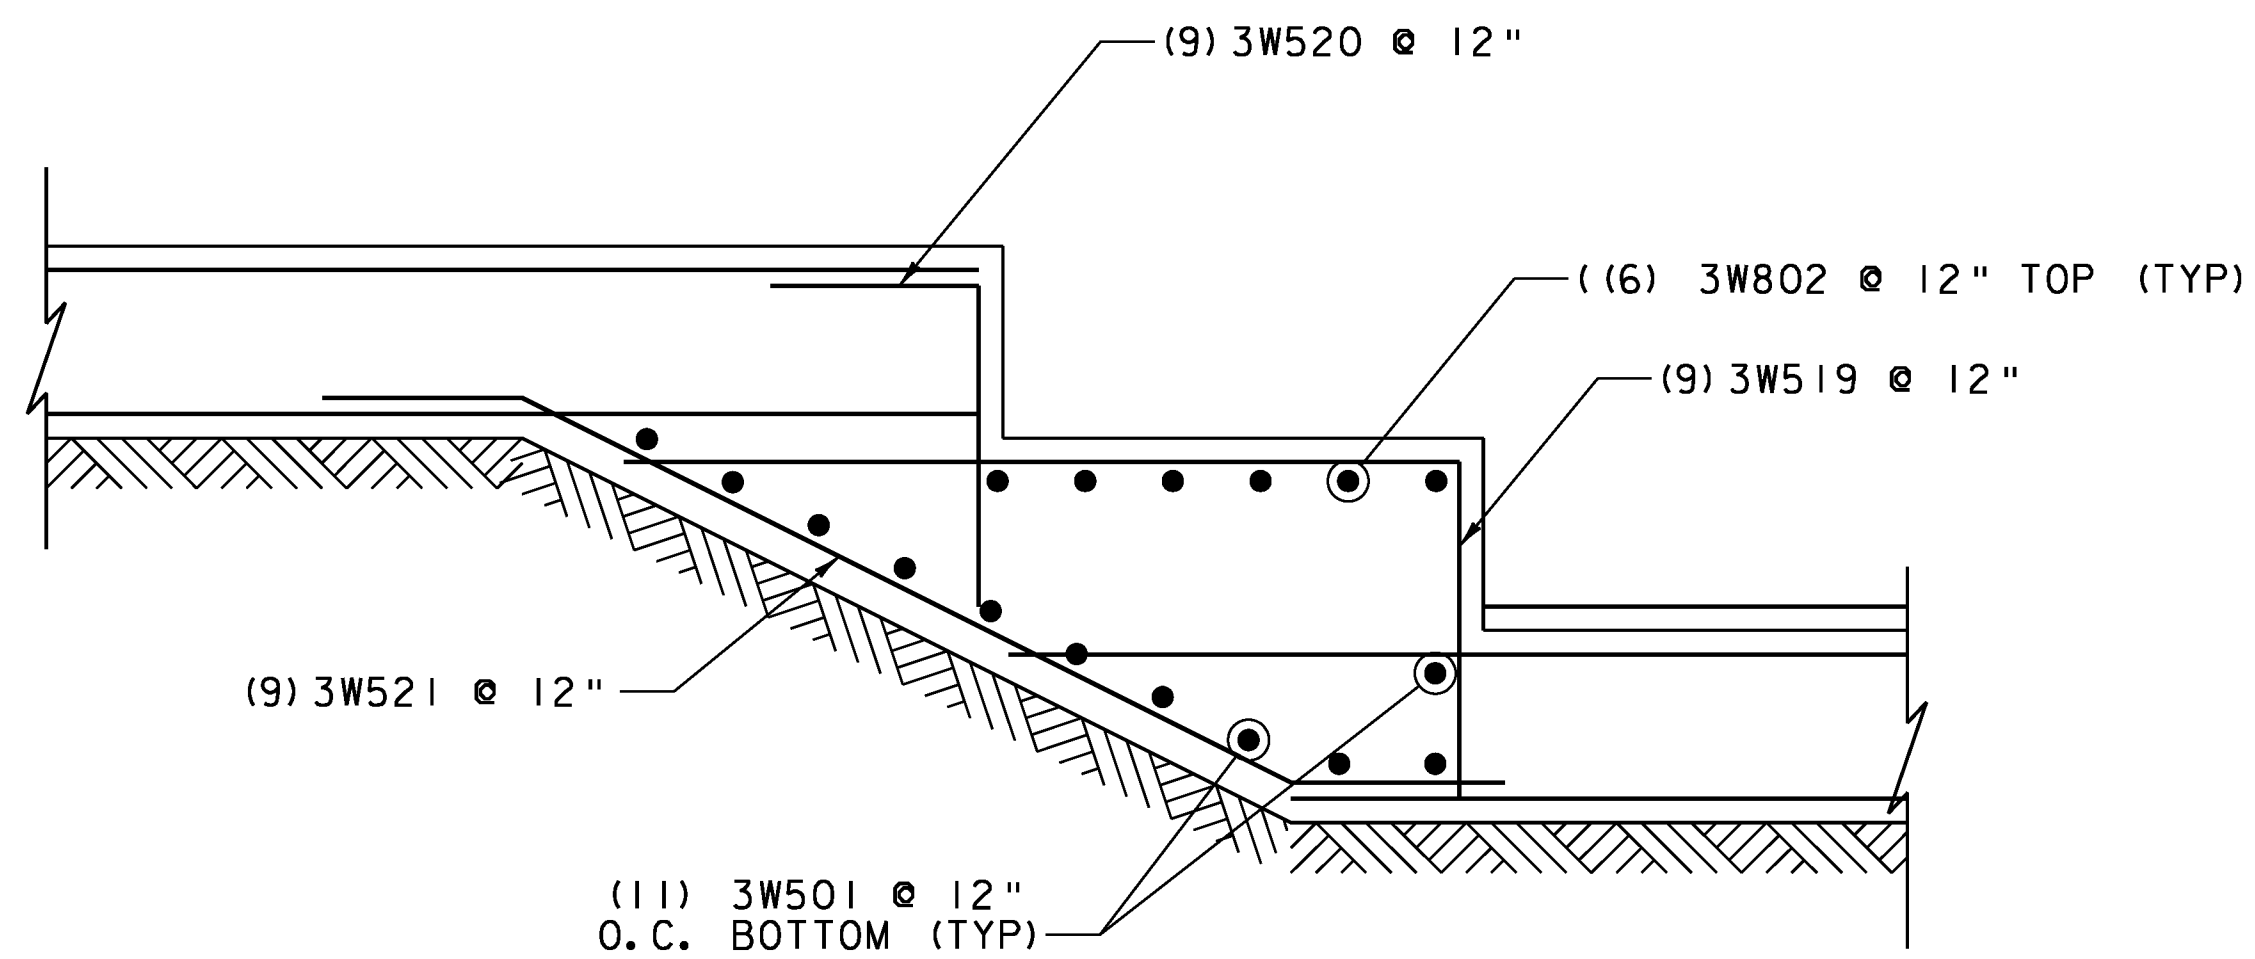

NOTE: FOR INFORMATION NOT SHOWN SEE WW3 ELEVATION AND WINGWALL NO. 3 TYPICAL SECTION B-B.


TYPICAL STEP FOOTING REBAR  
SCALE 1/2" = 1'-0"

NOTE:

NF = NEAR FACE  
FF = FAR FACE  
EF = EACH FACE  
▲ = CUT TO FIT IN FIELD

3" CLEAR, UNLESS OTHERWISE SPECIFIED ON THE PLANS.


2'-2" BAR LAP UNLESS SPECIFIED ON THE PLANS.

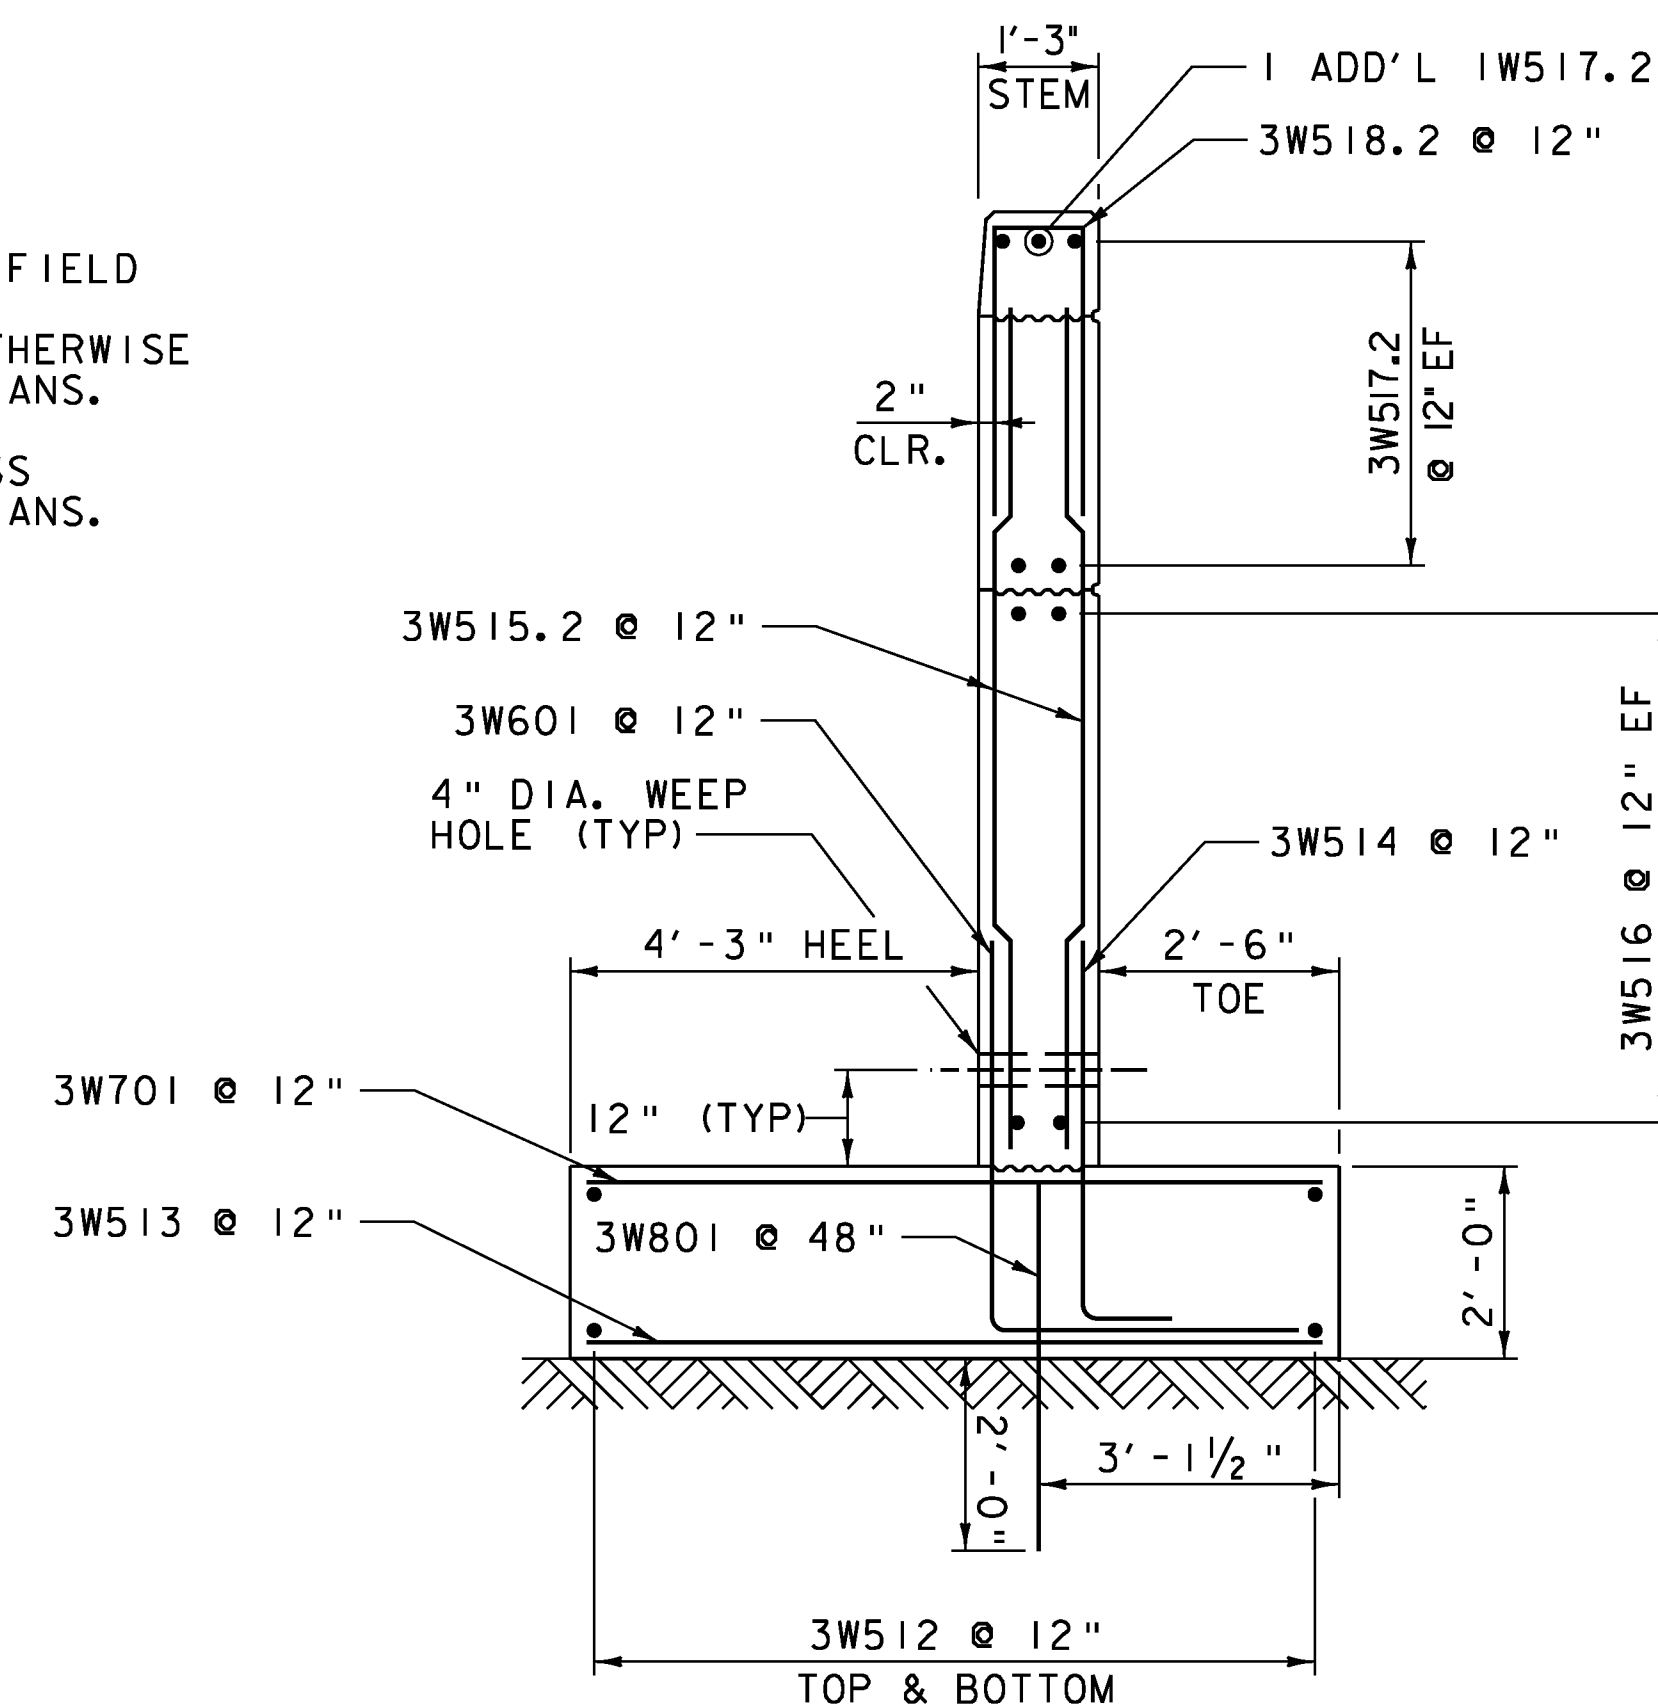

WINGWALL NO. 3  
TYPICAL SECTION A-A


SCALE 1/2" = 1'-0"

SEE WINGWALL NO. 4 ELEVATION AND DETAILS SHEET FOR SECTION B-B.

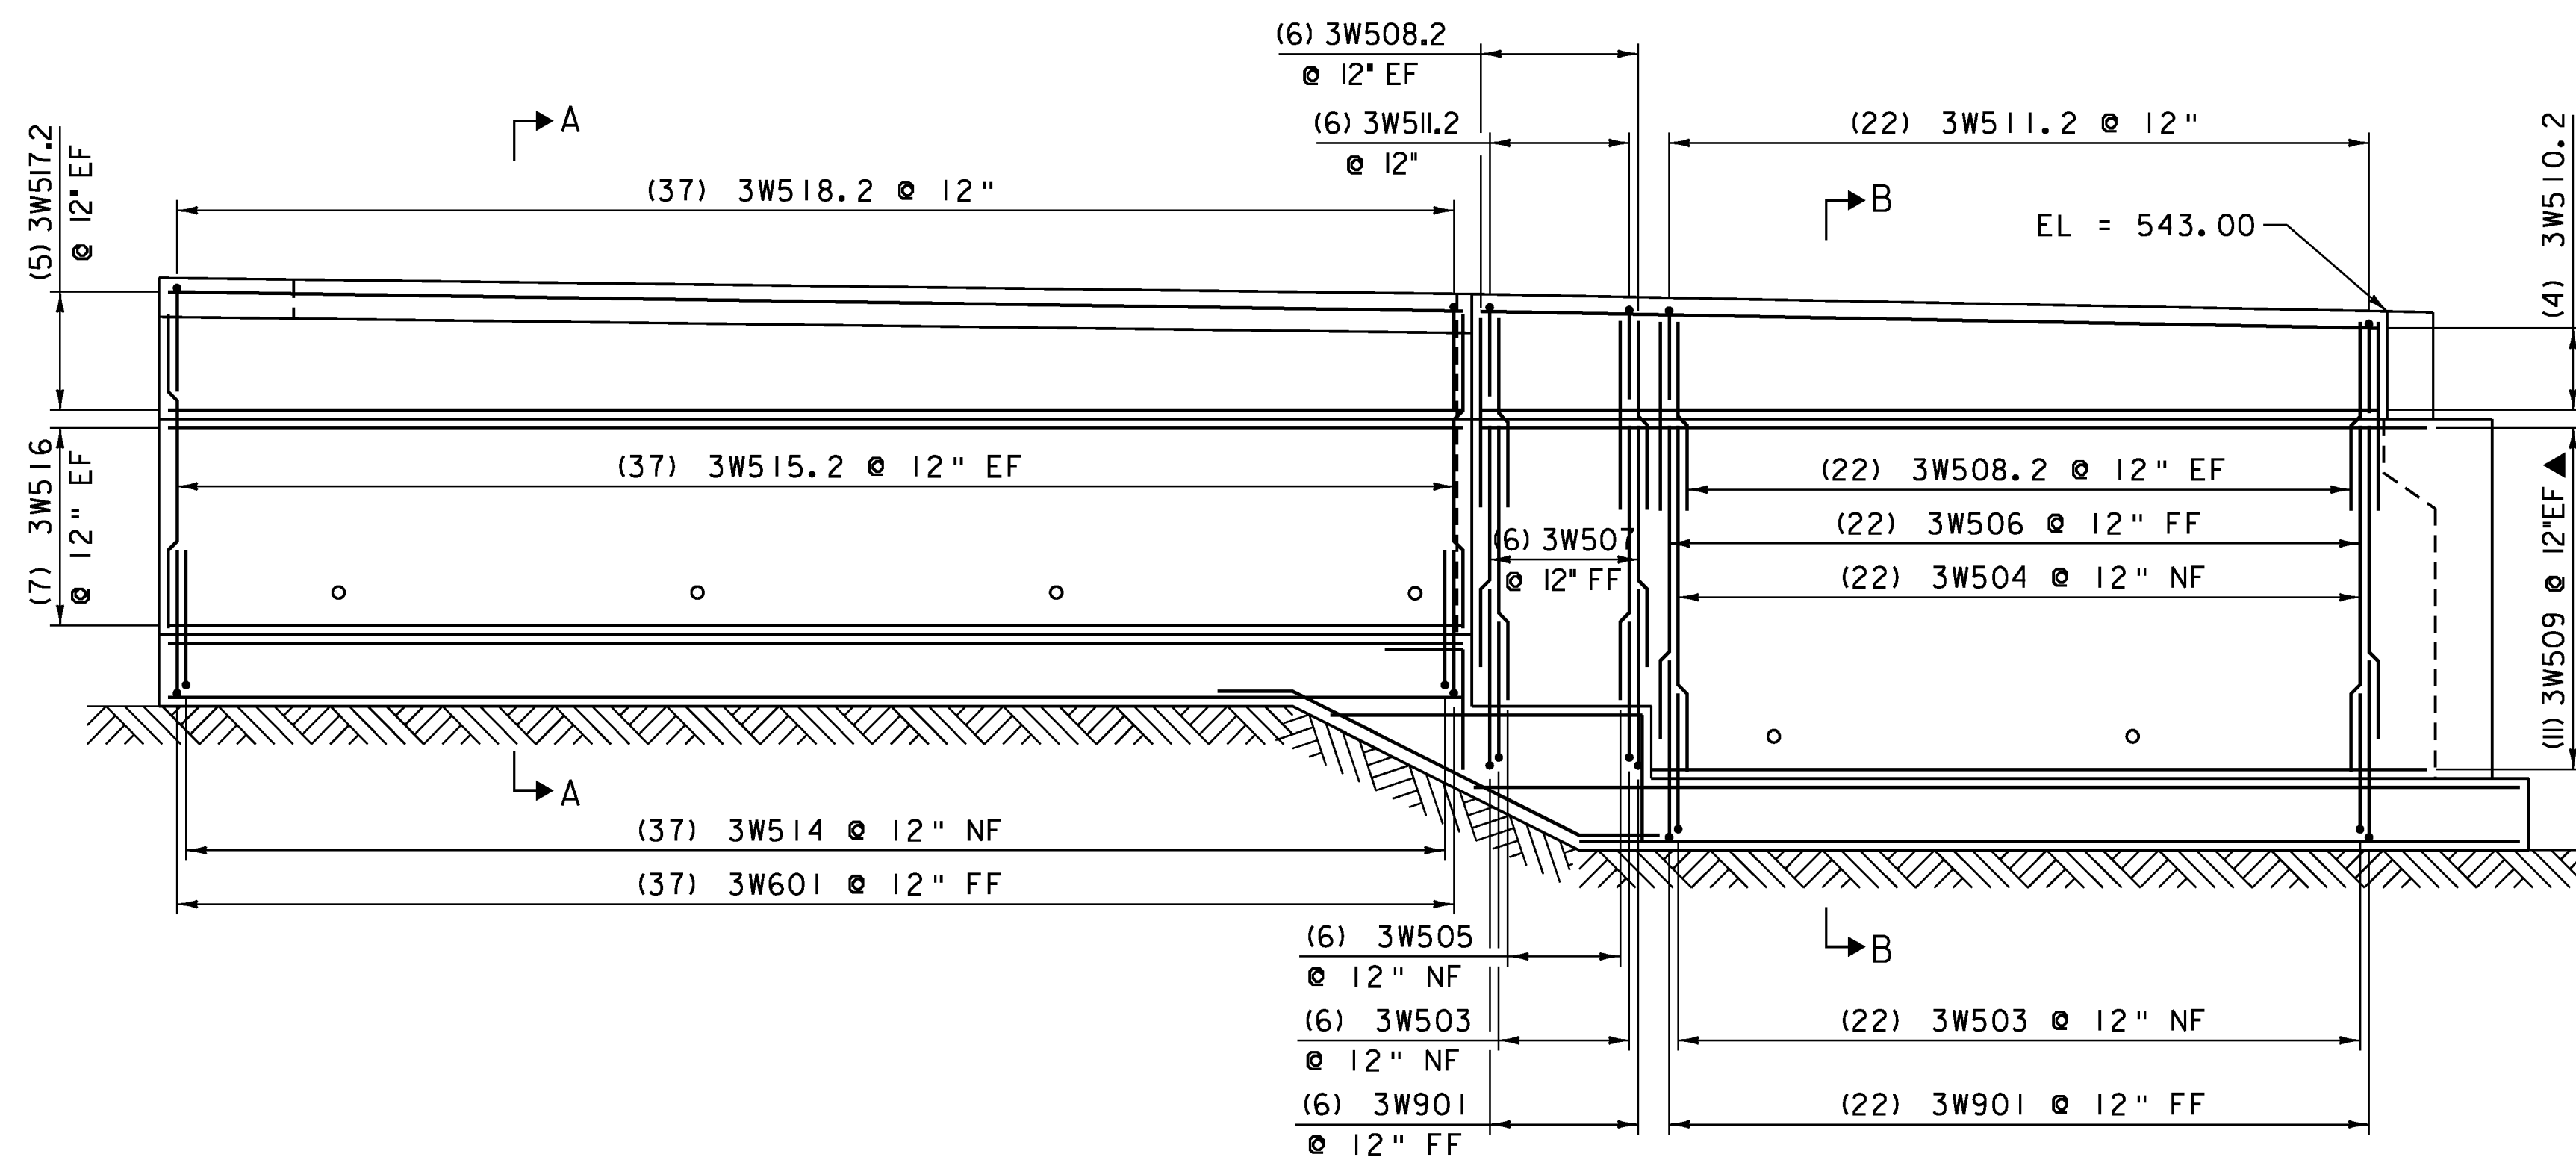

NOTE: SEE TYPICAL STEP FOOTING REBAR AND WINGWALL NO. 3 TYPICAL SECTION A-A AND B-B FOR DETAILS NOT SHOWN.

WW3 ELEVATION  
SCALE 1/4" = 1'-0"

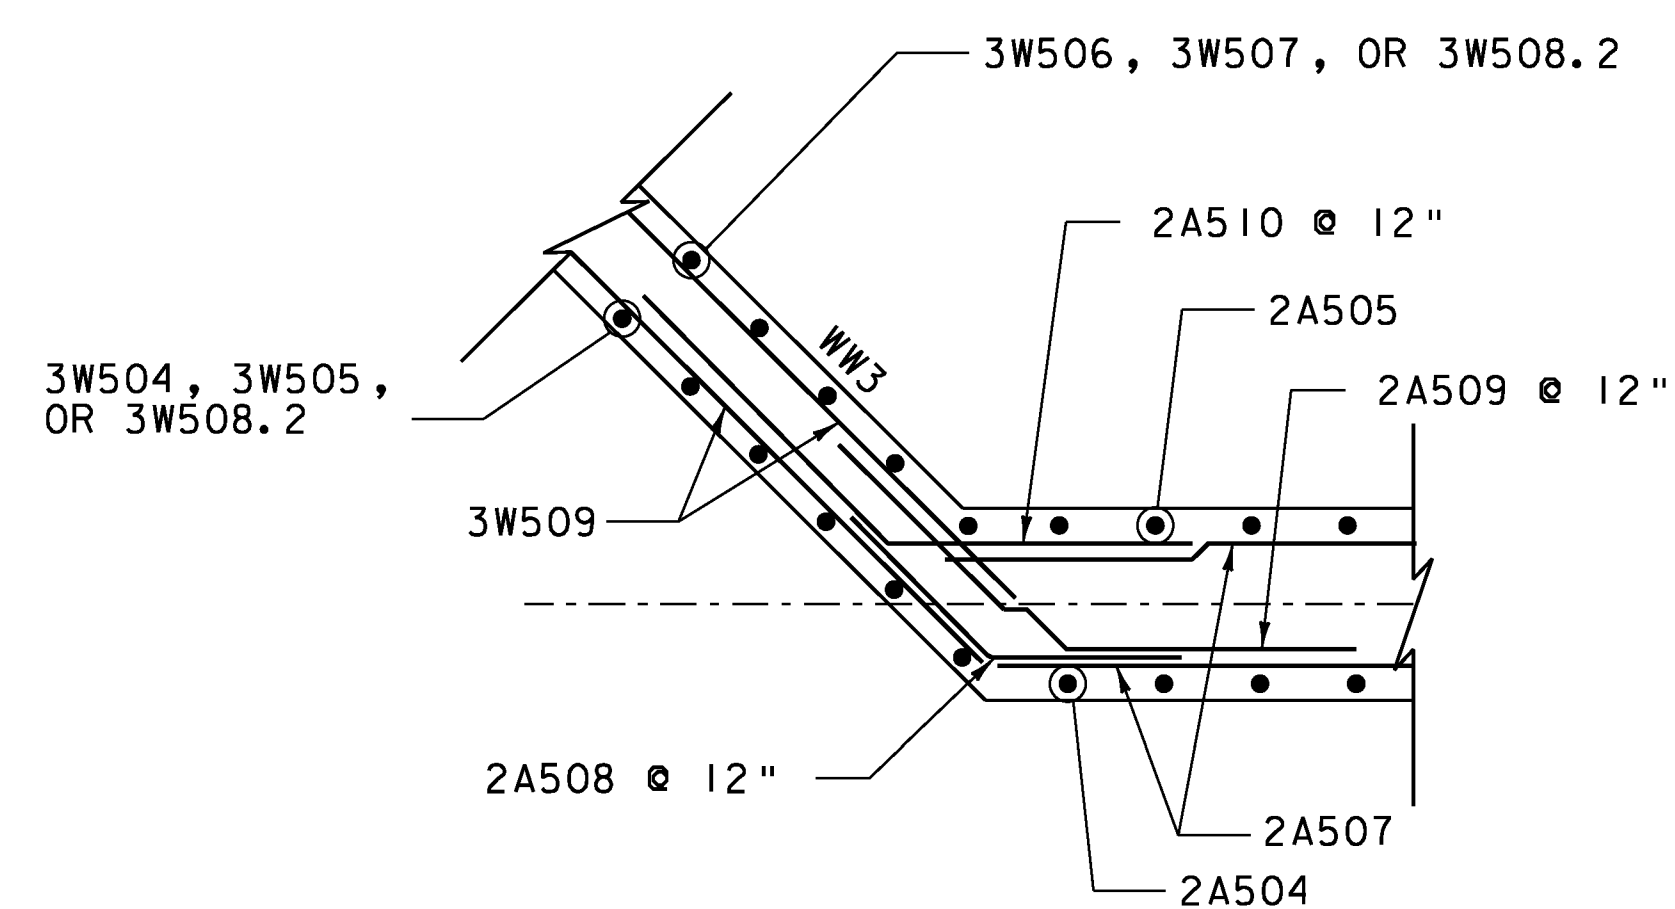


WINGWALL NO. 3 CORNER DETAIL BELOW SEAT  
SCALE 1/2" = 1'-0"


PROJECT NAME: BRATTLEBORO  
PROJECT NUMBER: BRO 1442(35)

FILE NAME: z10j062sub2.dgn  
PROJECT LEADER: S.E. BURBANK  
DESIGNED BY: C.J. HAKY  
WINGWALL NO. 3 ELEVATION & DETAILS


PLOT DATE: 10/14/2013  
DRAWN BY: E.A. FIALA  
CHECKED BY: S.E. BURBANK  
SHEET 46 OF 68

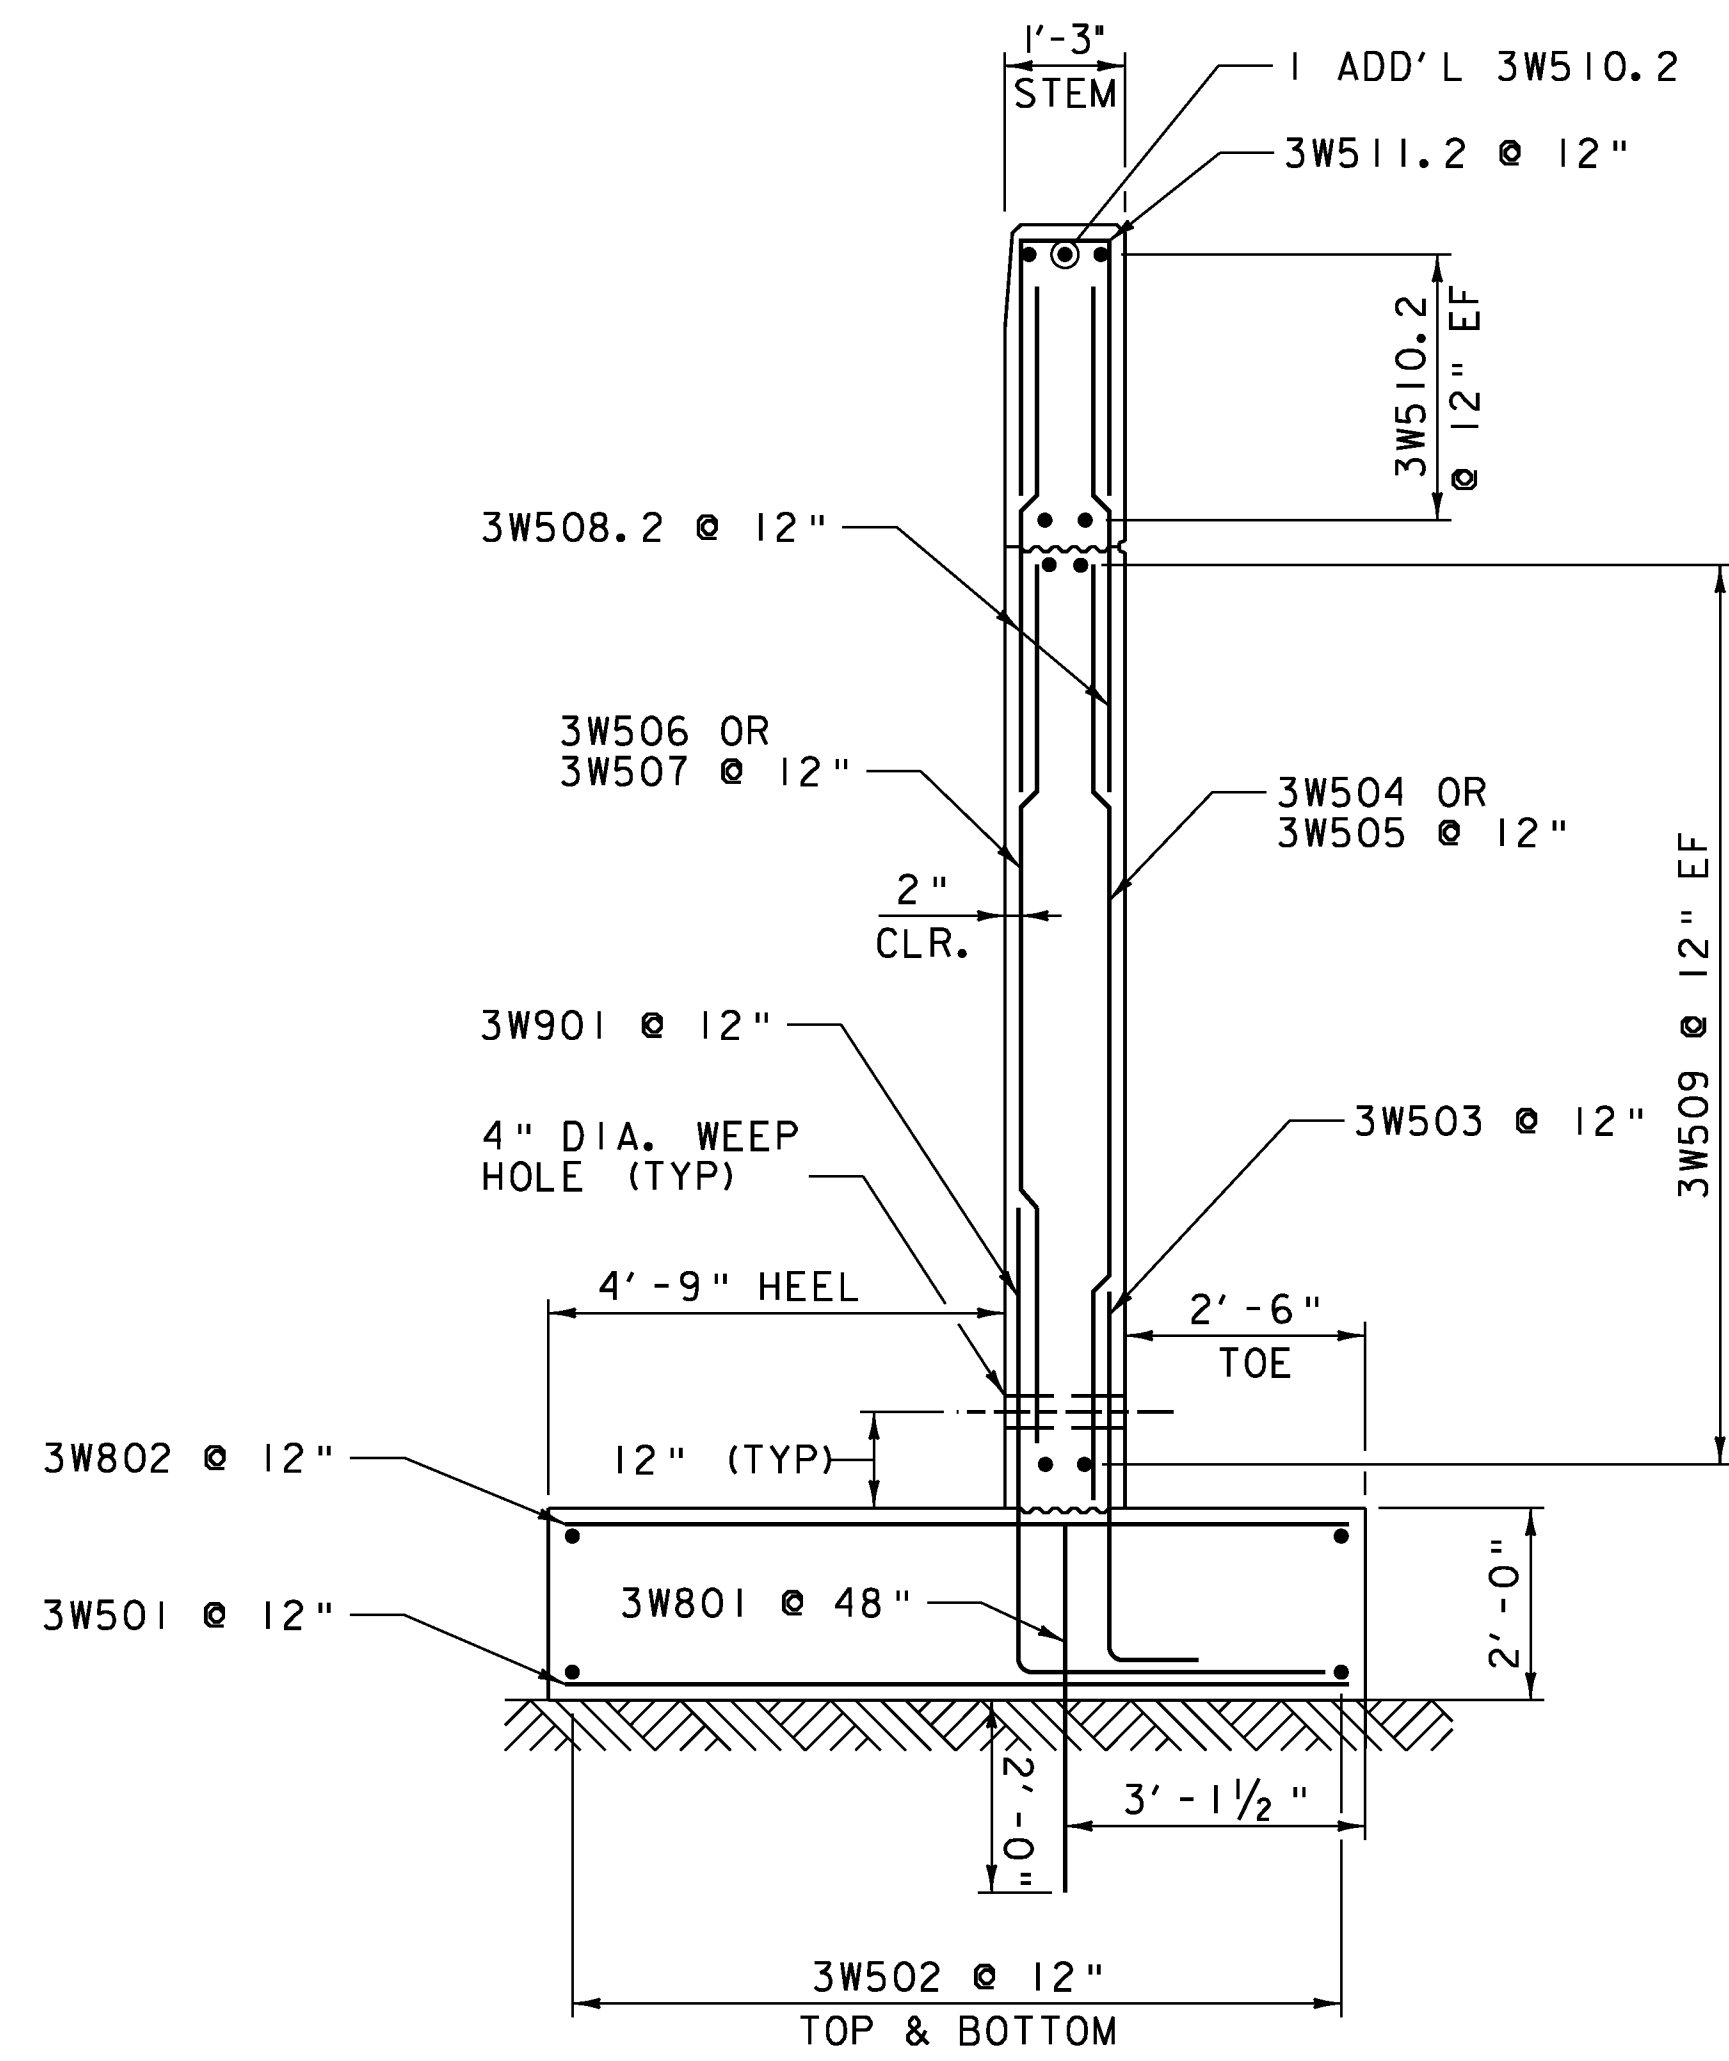


WINGWALL NO. 3  
TYPICAL SECTION B-B  
SCALE 1/2" = 1'-0"

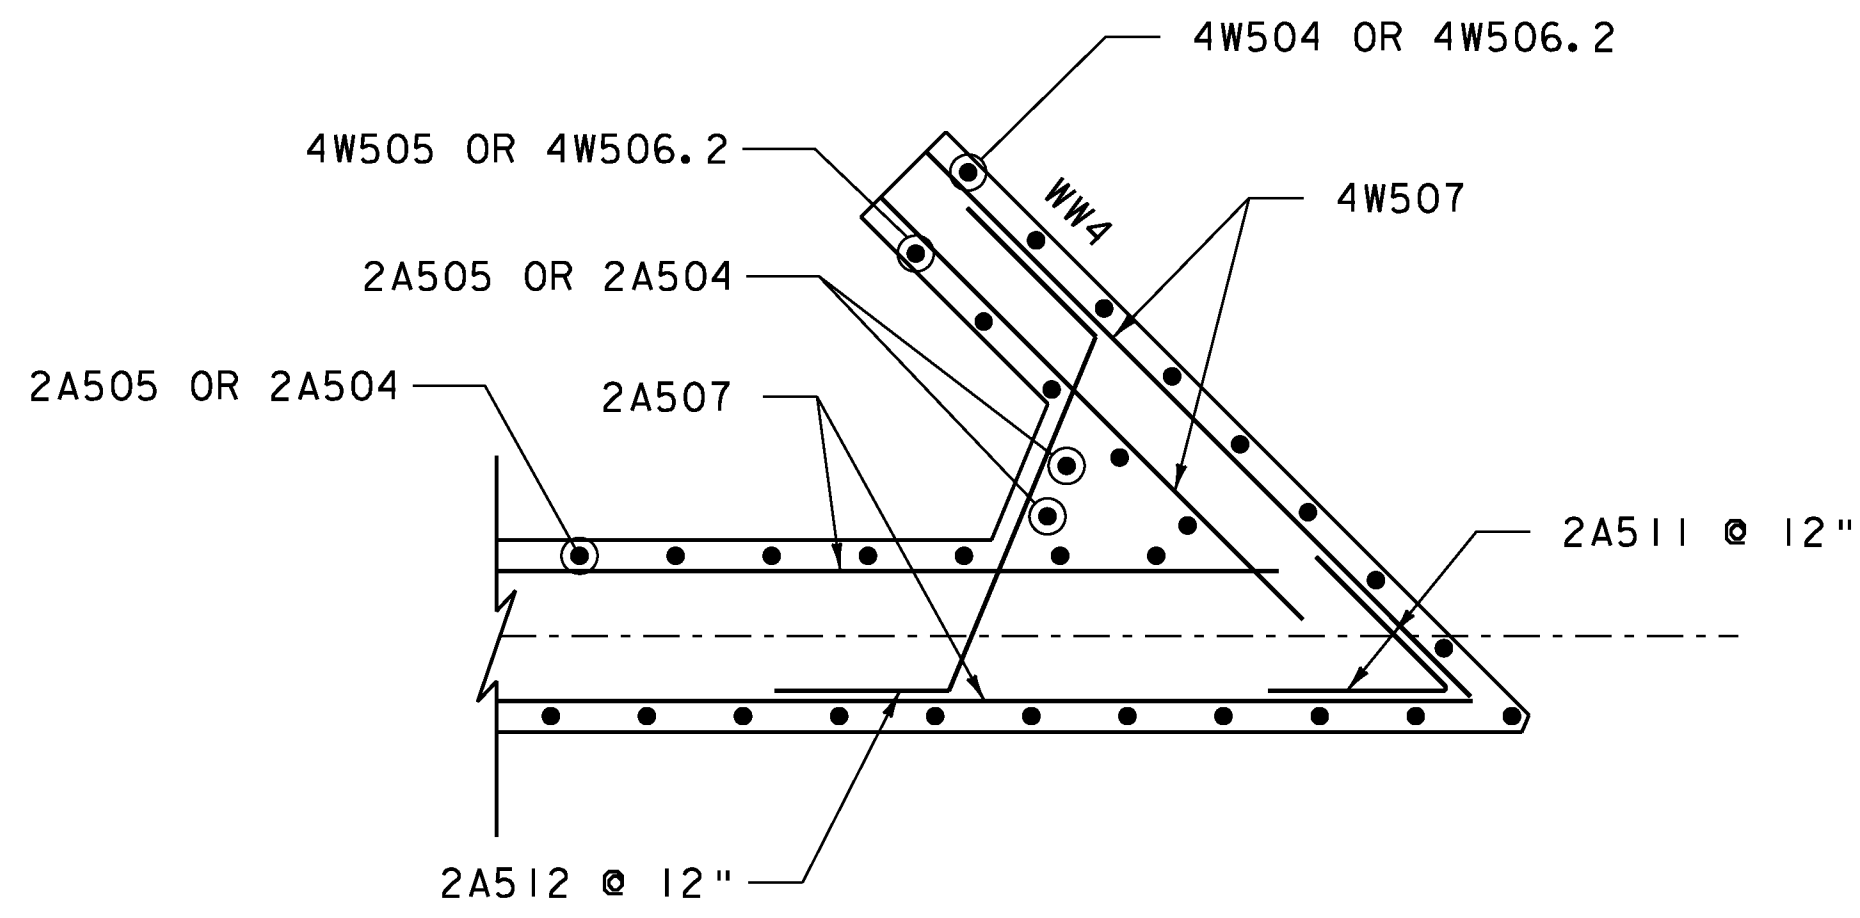

WINGWALL NO. 4 CORNER  
DETAIL BELOW SEAT  
SCALE 1/2" = 1'-0"

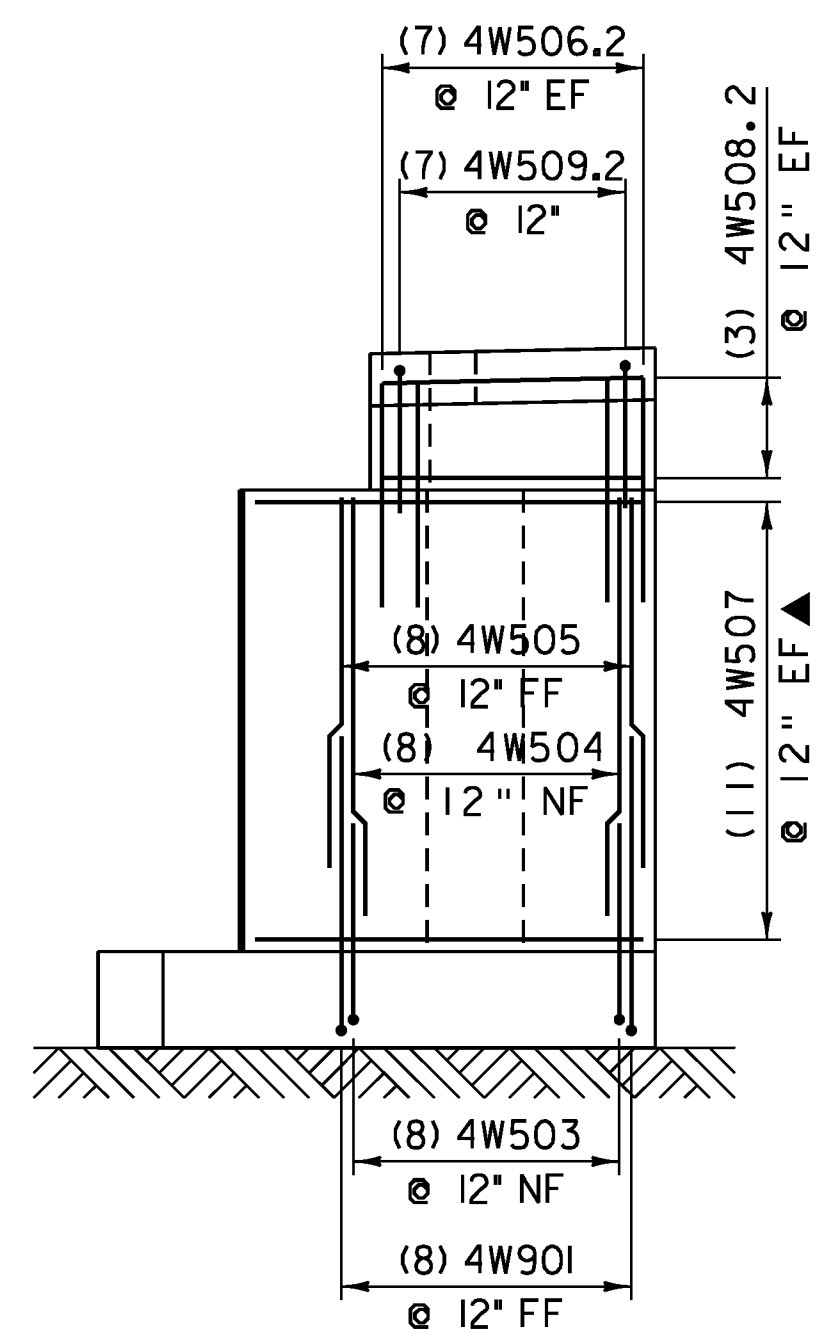

WW4 ELEVATION  
SCALE 1/4" = 1'-0"

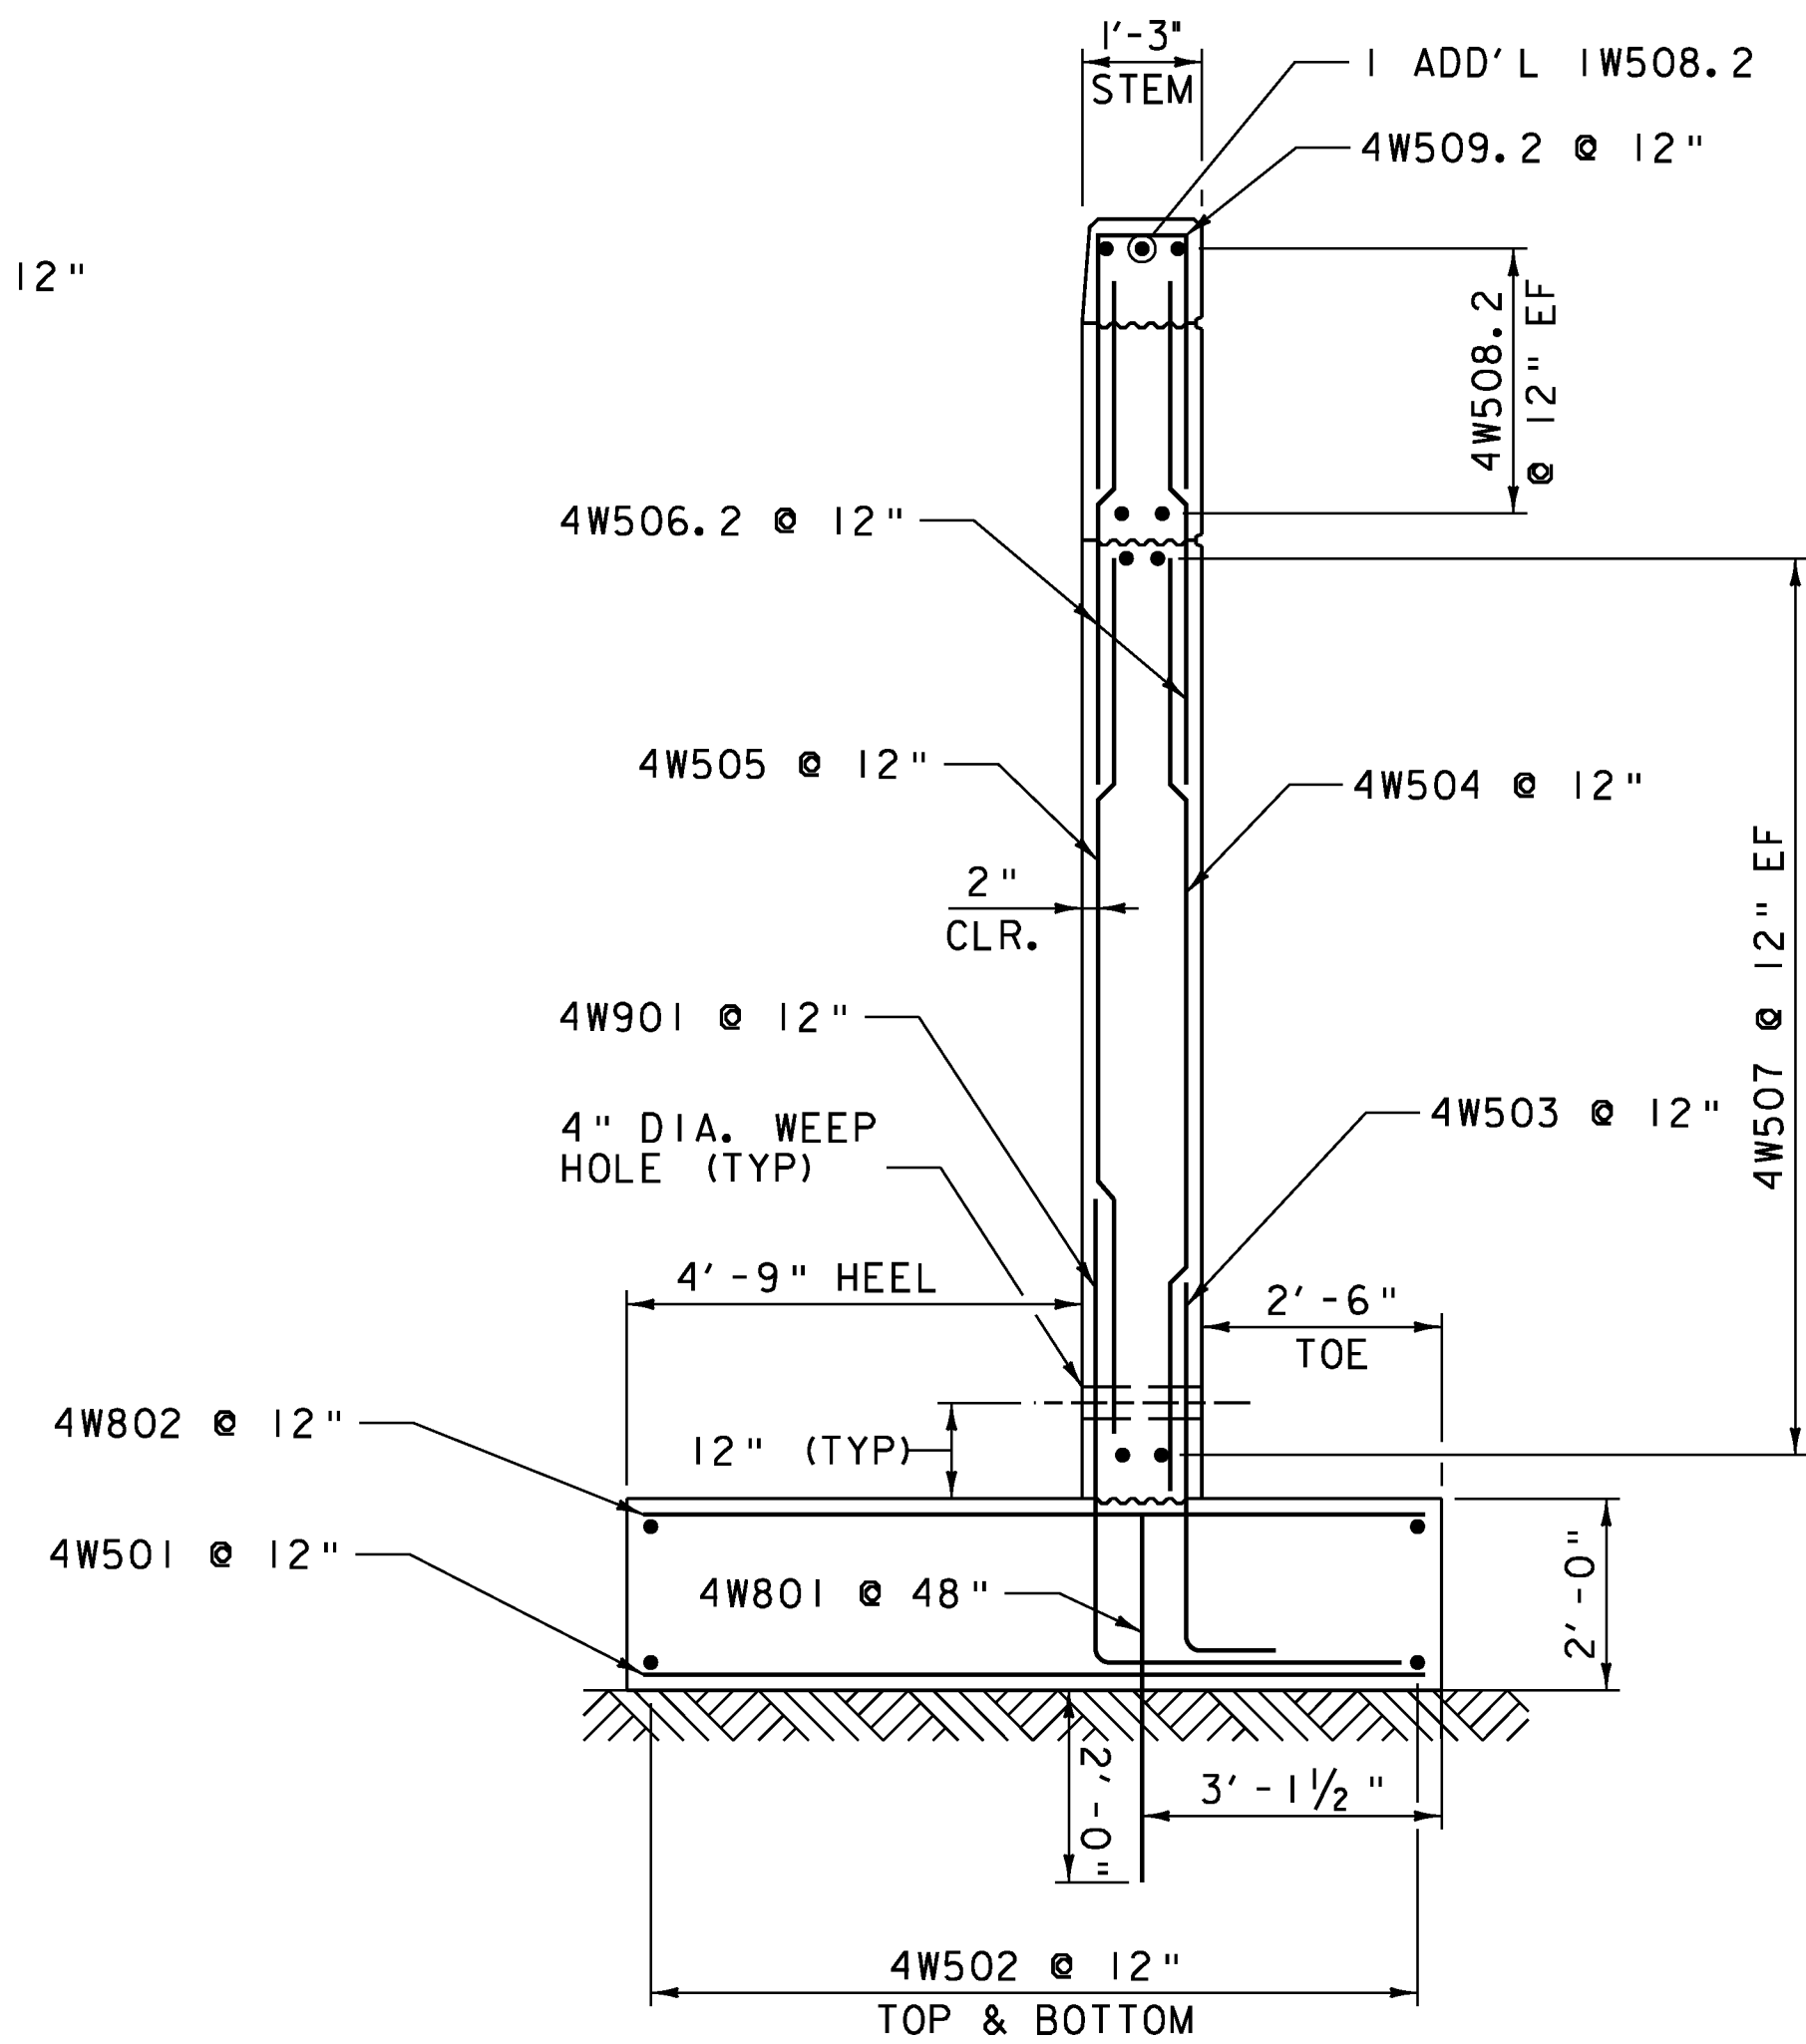


WINGWALL NO. 4 TYPICAL  
SCALE 1/2" = 1'-0"

**NOTE:**  
 NF = NEAR FACE  
 FF = FAR FACE  
 EF = EACH FACE  
 ▲ = CUT TO FIT IN FIELD  
 3" CLEAR, UNLESS OTHERWISE SPECIFIED ON THE PLANS.  
 2'-2" BAR LAP UNLESS SPECIFIED ON THE PLANS.

PROJECT NAME: BRATTLEBORO  
 PROJECT NUMBER: BRO 1442(35)

FILE NAME: z10j062sub2.dgn  
 PROJECT LEADER: S.E. BURBANK  
 DESIGNED BY: C.J. HAKY  
 WINGWALL NO. 4 ELEVATION & DETAILS

PLOT DATE: 10/14/2013  
 DRAWN BY: E.A. FIALA  
 CHECKED BY: S.E. BURBANK  
 SHEET 47 OF 68

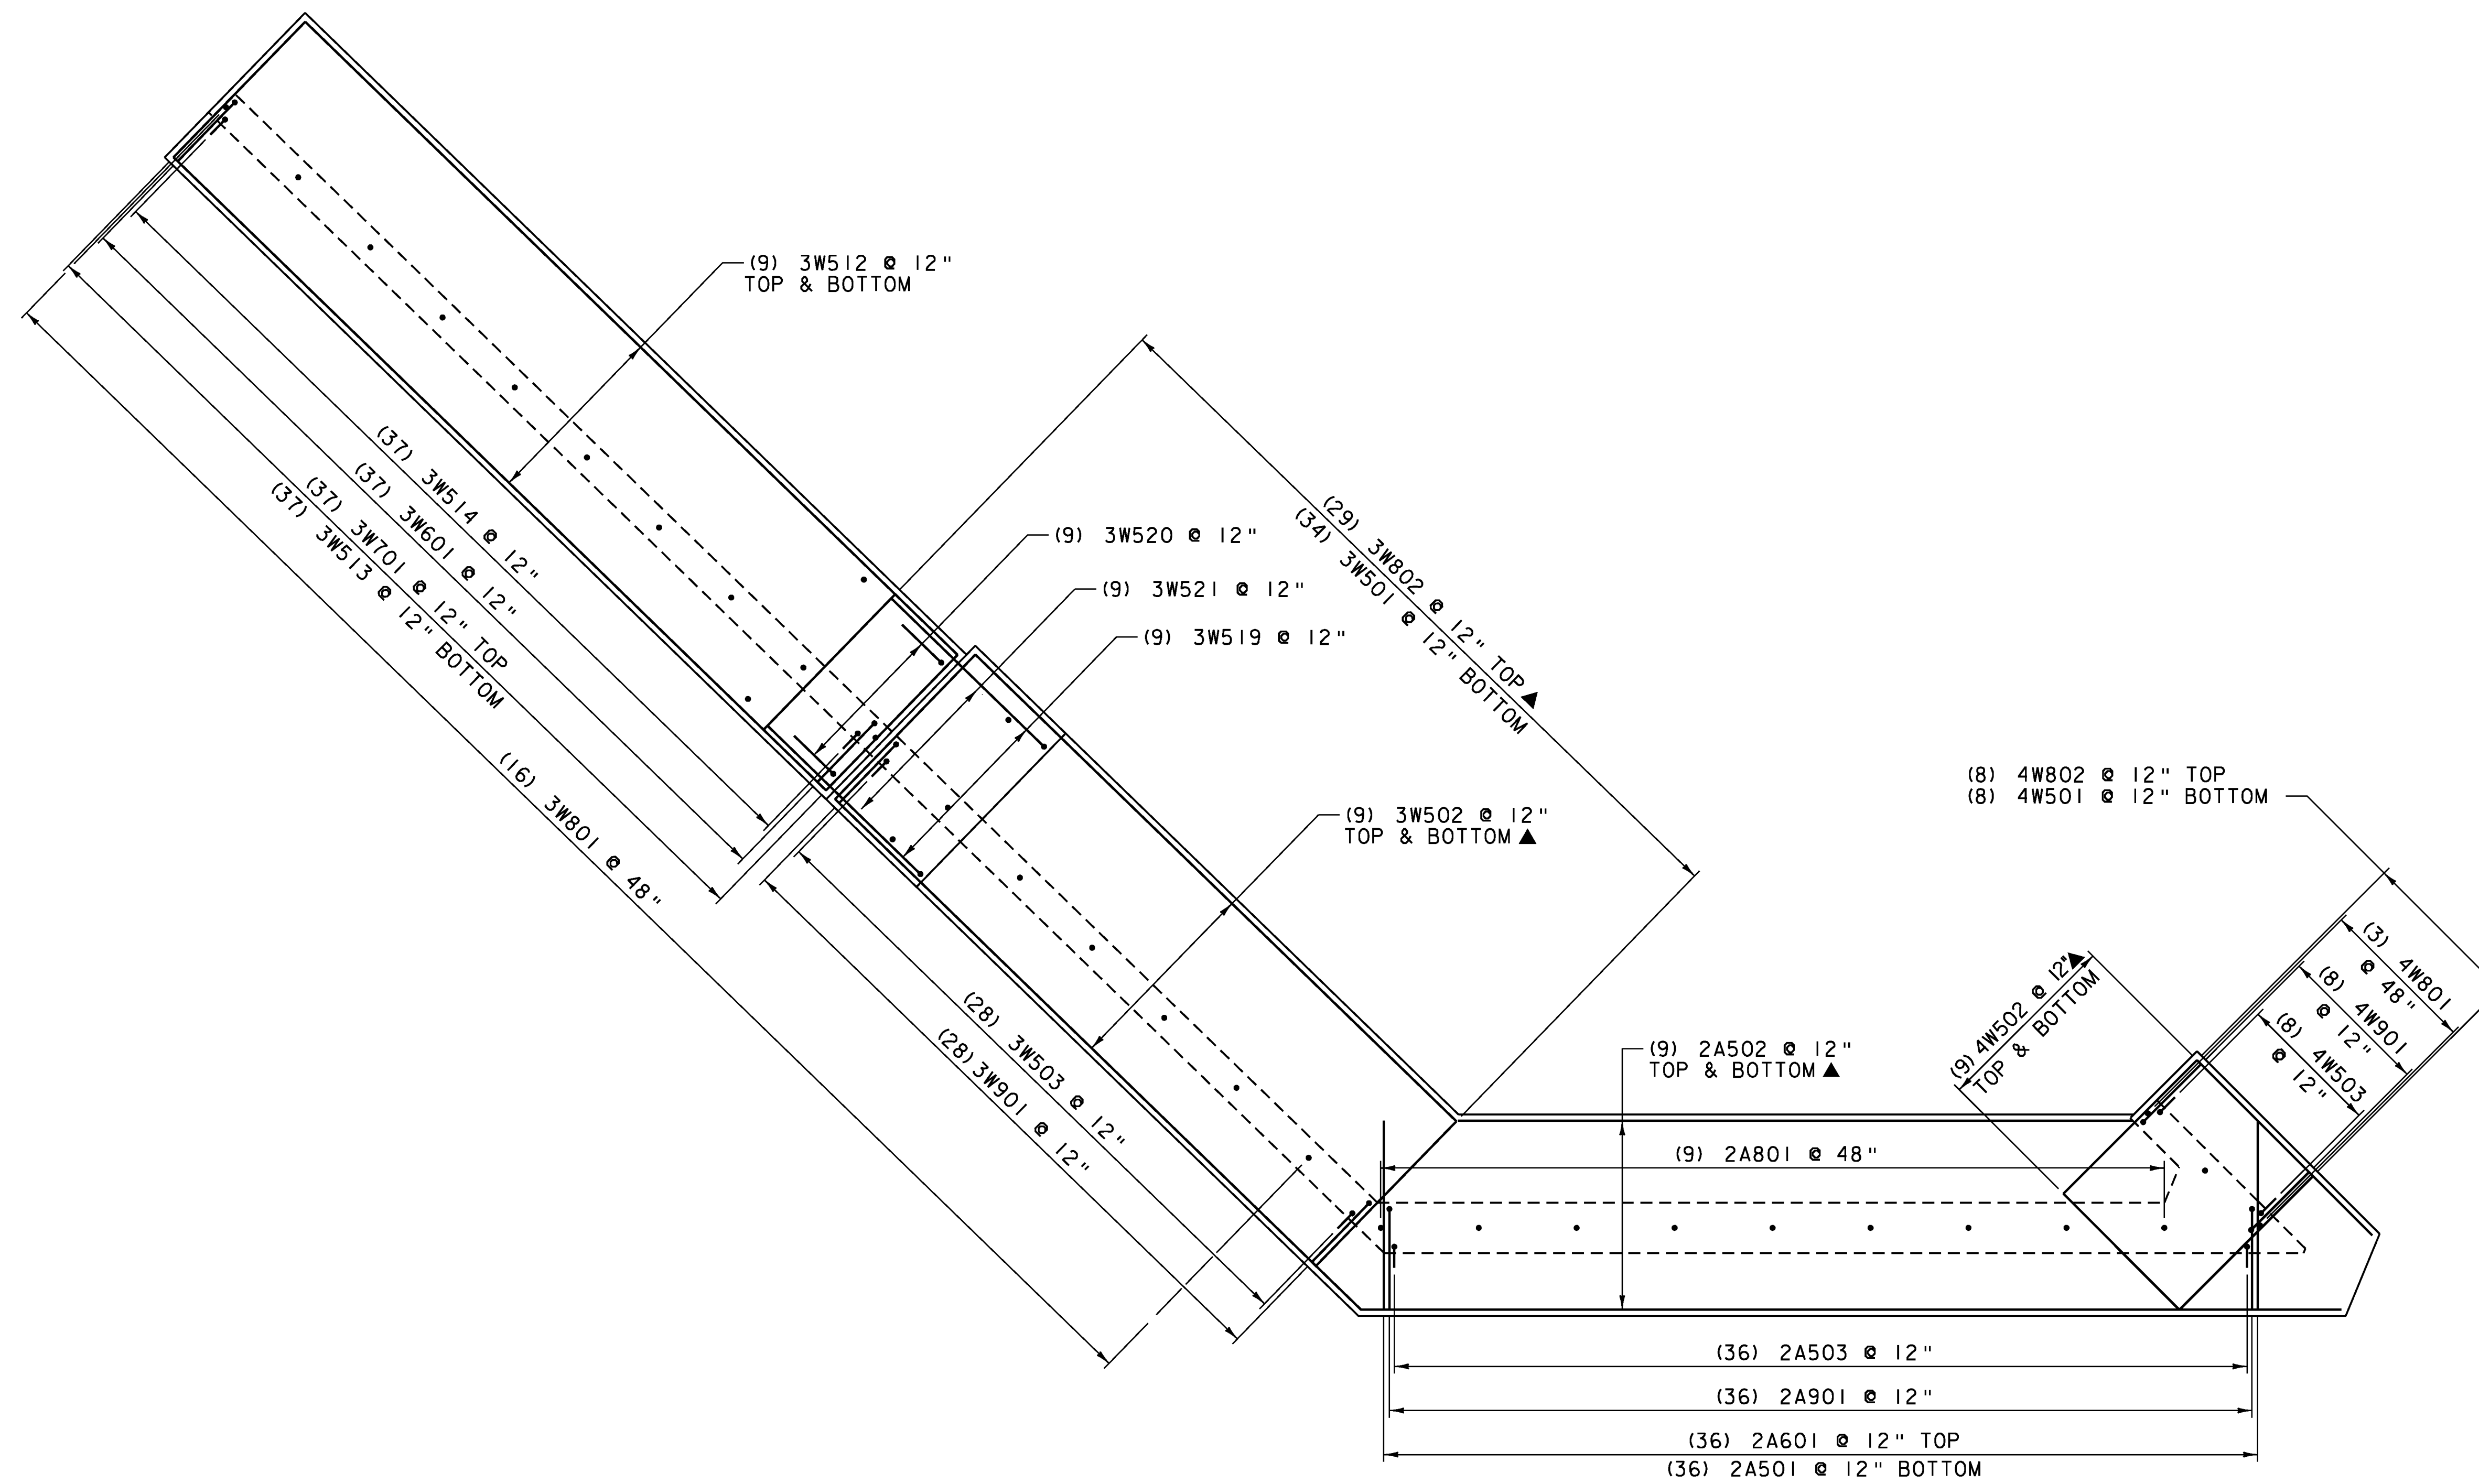

ABUTMENT NO. 2 FOOTING REINFORCING PLAN VIEW  
SCALE 1/4" = 1'-0"

**NOTE:**  
 NF = NEAR FACE  
 FF = FAR FACE  
 EF = EACH FACE  
 ▲ = CUT TO FIT IN FIELD  
 3" CLEAR, UNLESS OTHERWISE SPECIFIED ON THE PLANS.  
 2'-2" BAR LAP UNLESS SPECIFIED ON THE PLANS.



PROJECT NAME: BRATTLEBORO	PROJECT NUMBER: BRO 1442(35)
FILE NAME: z10j062sub2.dgn	PLOT DATE: 10/14/2013
PROJECT LEADER: S.E. BURBANK	DRAWN BY: E.A. FIALA
DESIGNED BY: C.J. HAKY	CHECKED BY: S.E. BURBANK
ABUTMENT NO. 2 FOOTING PLAN	SHEET 48 OF 68

STATE OF VERMONT  
AGENCY OF TRANSPORTATION

# REINFORCING STEEL SCHEDULE

ITEM	EACH	SIZE	LENGTH	MARK	TYPE	A	B	C	D	E	F	G	H	J	K	R	O	ITEM	EACH	SIZE	LENGTH	MARK	TYPE	A	B	C	D	E	F	G	H	J	K	R	O		
<b>OVERLAY &amp; CURB</b>																																					
	2	5	1'-6"	S501.2	STR													6	8	4'-3"	1W801	STR															
	2	5	2'-6"	S502.2	STR													23	9	7'-8"	2W901	17		6'-6"	1'-2"	0'-0"											
	2	5	3'-6"	S503.2	STR													22	9	9'-9"	2W902	17		6'-6"	3'-3"	0'-0"											
	2	5	4'-6"	S504.2	STR													*	24	10	9'-6"	2W1001	STR														
*	3	5	5'-6"	S505.2	STR																																
	2	5	6'-6"	S506.2	STR														46	5	4'-6"	2W506.2	STR														
	2	5	7'-6"	S507.2	STR													*	8	5	21'-8"	2W507.2	STR														
	2	5	8'-6"	S508.2	STR														23	5	5'-1"	2W508.2	S10		2'-2"	0'-9"	2'-2"										
	2	5	9'-6"	S509.2	STR														<b>APPROACH SLAB NO. 1</b>																		
	2	5	10'-6"	S510.2	STR														18	5	33'-0"	1AS501.2	STR														
	2	5	11'-6"	S511.2	STR														*	34	9	25'-6"	1AS901.2	1	1'-3"	24'-3"						0'-11"					
	2	5	12'-6"	S512.2	STR														<b>ABUTMENT NO. 2</b>																		
	2	5	13'-6"	S513.2	STR																																
	2	5	14'-6"	S514.2	STR																																
	2	5	15'-6"	S515.2	STR																																
	2	5	16'-6"	S516.2	STR																																
	2	5	17'-6"	S517.2	STR																																
	2	5	18'-6"	S518.2	STR																																
	2	5	19'-6"	S519.2	STR																																
	2	5	20'-6"	S520.2	STR																																
	2	5	21'-6"	S521.2	STR																																
	2	5	22'-6"	S522.2	STR																																
	2	5	23'-6"	S523.2	STR																																
	2	5	24'-6"	S524.2	STR																																
	20	5	25'-6"	S525.2	STR																																
	27	5	44'-9"	S526.2	STR																																
	4	5	47'-1"	S527.2	STR																																
	2	5	44'-1"	S528.2	STR																																
	2	5	46'-9"	S529.2	STR																																
<b>ABUTMENT NO. 1</b>																																					
*	39	5	9'-6"	1A501	STR																																
	22	5	26'-8"	1A502	STR																																
	38	5	7'-4"	1A503	17		6'-6"	0'-10"	0'-0"																												
	38	5	12'-10"	1A504	STR																																
	38	5	7'-8"	1A505	STR																																
	38	5	7'-3"	1A506	16	2'-2"	2'-6"	1'-2"	1'-5"			1'-0"		1'-0"																							
	38	5	40'-9"	1A507	STR																																
	17	5	4'-0"	1A508	22		2'-0"	2'-0"	0'-0"			1'-6"	0'-0"	1'-6"	0'-0"																						
	17	5	6'-4"	1A509	22		3'-0"	3'-4"	0'-0"			2'-1"	0'-0"	2'-1"	0'-0"																						
	17	5	6'-9"	1A510	22		3'-7"	3'-2"	0'-0"			2'-9"	0'-0"	2'-7"	0'-0"																						
	38	5	5'-11"	1A510	17		2'-2"	1'-7"	2'-2"																												
	74	7	11'-7"	1A701	17		7'-0"	4'-7"	0'-0"																												
*	39	7	8'-10"	1A702	STR																																
	10	8	4'-3"	1A801	STR																																
*	39	8	9'-6"	1A802	STR																																
	24	8	4'-0"	1A803.2	14	2'-3"	1'-9"	0'-0"	0'-0"	0'-0"		1'-3"		1'-3"																							
<b>WINGWALL NO. 1</b>																																					
	22	5	26'-3"	1W501	STR																																
	14	5	9'-6"	1W502	STR																																
	14	5	5'-5"	1W503	17		4'-5"	1'-0"	0'-0"																												
	▲	14	5	15'-8"	1W504	STR																															
	▲	34	5	12'-8"	1W505	STR																															
	14	5	8'-1"	1W506	STR																																
	14	7	11'-7"	1W701	17		7'-1"	4'-6"	0'-0"																												
	13	7	8'-3"	1W702	17		7'-1"	1'-2"	0'-0"																												
*	15	7	8'-10"	1W703	STR																																
	4	8	4'-3"	1W801	STR																																
*	15	9	9'-6"	1W801	STR																																
	14	5	4'-7"	1W507.2	STR																																
	2	5	9'-4"	1W508.2	STR																																
	2	5	5'-2"	1W509.2	STR																																
	3	5	8'-11"	1W510.2	19		0'-0"	1'-10"	7'-1"																												
	3	5	5'-10"	1W511.2	S10			2'-2"	1'-6"	2'-2"																											
	1	5	5'-2"	1W512.2	S10			1'-10"	1'-6"	1'-10"																											
	1	5	4'-8"	1W513.2	S10			1'-7"	1'-6"	1'-7"																											
	1	5	4'-0"	1W514.2	S10			1'-3"	1'-6"	1'-3"																											
	1	5	3'-6"	1W515.2	S10			1'-0"	1'-6"	1'-0"																											
<b>WINGWALL NO. 2</b>																																					
▲	22	5	24'-7"	2W501	STR																																
	23	5	9'-6"	2W502	STR																																
	23	5	5'-5"	2W503	17		4'-6"	0'-																													




# REINFORCING STEEL SCHEDULE

ITEM	EACH	SIZE	LENGTH	MARK	TYPE	A	B	C	D	E	F	G	H	J	K	R	O	ITEM	EACH	SIZE	LENGTH	MARK	TYPE	A	B	C	D	E	F	G	H	J	K	R	O
<b>APPROACH SLAB NO. 2</b>																																			
*	7	5	32'- 5"	2AS501.2	STR																														
	6	5	32'- 7"	2AS502.2	STR																														
	6	5	32'- 9"	2AS503.2	STR																														
	33	9	25'- 6"	2AS901.2	1	1'- 3"	24'- 3"							0'- 11"																					

~ NOTES ~

- UNLESS OTHERWISE DESIGNATED, ALL BAR REINFORCEMENT FOR CONCRETE IN SIZES UP TO AND INCLUDING NO. 18 SHALL CONFORM TO THE REQUIREMENTS OF THE "SPECIFICATIONS FOR DEFORMED BILLET-STEEL BARS FOR CONCRETE REINFORCEMENT", AASHTO M 31 (ASTM A 615-SI). ALL BARS SHALL BE GRADE 60, UNLESS OTHERWISE DESIGNATED.
- FOR TYPICAL BENDING DETAILS, RECOMMENDED PIN DIAMETER "D" OF BENDS AND HOOKS, AND OTHER STANDARD PRACTICE, SEE CURRENT CONCRETE REINFORCING STEEL INSTITUTE "MANUAL OF STANDARD PRACTICE".
- BARS WHICH REQUIRE MORE ACCURATE BENDING THAN STANDARD PRACTICES SHOULD HAVE LIMITS INDICATED.
- ALL DIMENSIONS ARE OUT TO OUT OF BAR EXCEPT "A" AND "G" ON STANDARD 180 DEGREE AND 135 DEGREE HOOKS.
- "J" DIMENSION ON 180 DEGREE HOOKS TO BE SHOWN ONLY WHERE NECESSARY TO RESTRICT HOOK SIZE. OTHERWISE, STANDARD HOOKS ARE TO BE USED.
- "H" DIMENSION ON STIRRUPS TO BE SHOWN ONLY WHEN NECESSARY TO MAINTAIN CLEARANCES.
- WHERE SLOPE DIFFERS FROM 45 DEGREES, DIMENSIONS "H" AND "K" MUST BE SHOWN.
- ▲ DENOTES BARS TO BE CUT IN FIELD.
- * DENOTES ONE EXTRA BAR ADDED FOR TESTING PURPOSES.
- △ DENOTES TWO EXTRA BARS ADDED FOR TESTING PURPOSES.
- E DENOTES EPOXY COATED REINFORCING STEEL.

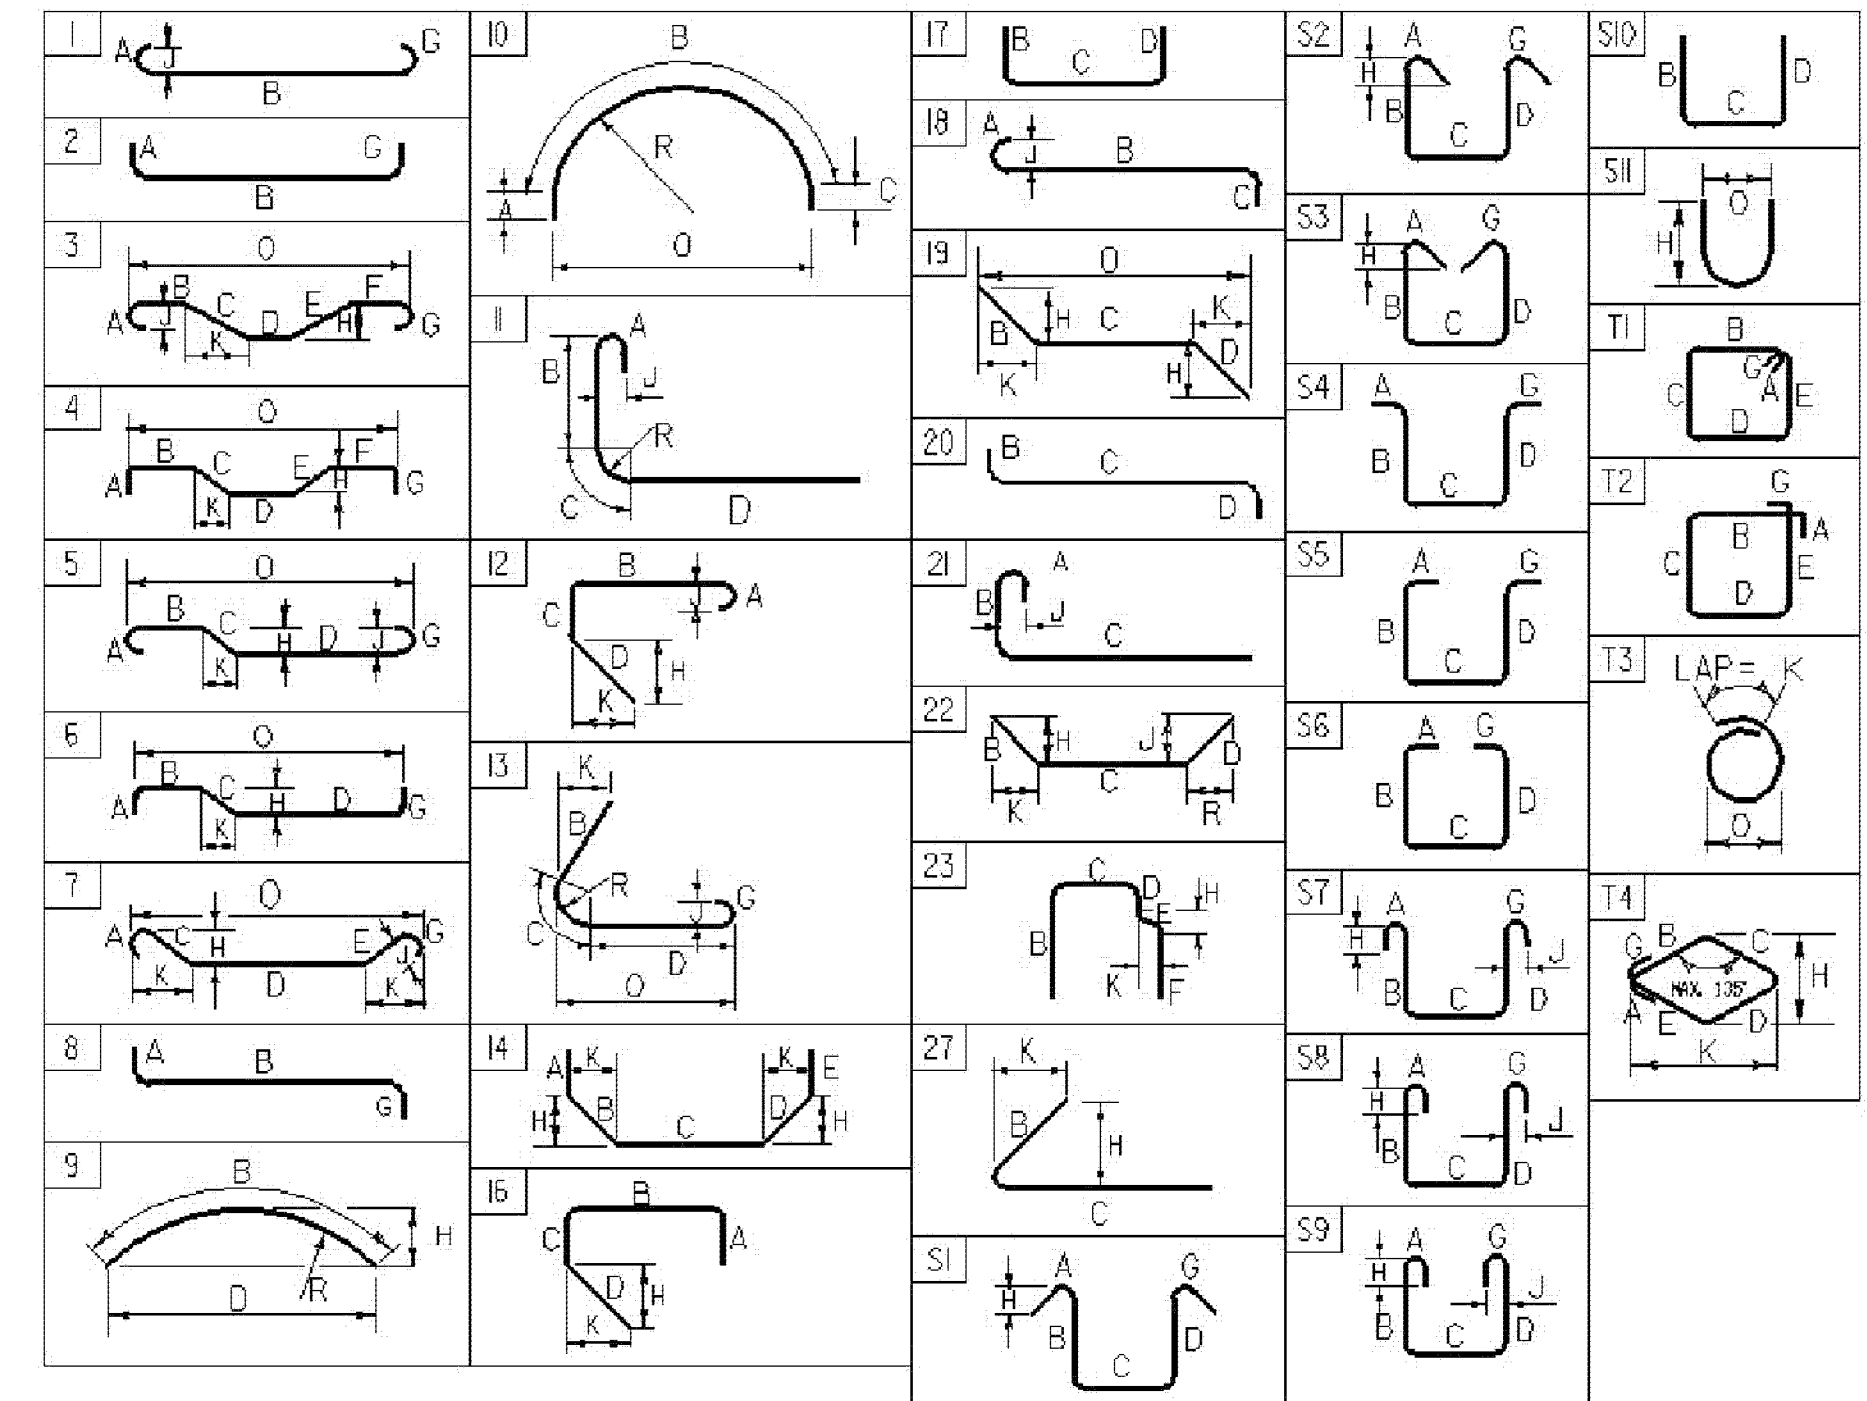


ASTM STANDARD REINFORCING BARS				
BAR SIZE DESIGNATION	WEIGHT POUNDS PER FOOT	NOMINAL DIMENSIONS ROUND SECTION DIAMETER INCHES	AREA INCHES ²	PERIMETER INCHES
#3	0.376	0.375	0.11	1.178
#4	0.668	0.500	0.20	1.571
#5	1.043	0.625	0.31	1.963
#6	1.502	0.750	0.44	2.356
#7	2.044	0.875	0.60	2.749
#8	2.670	1.000	0.79	3.142
#9	3.400	1.128	1.00	3.544
#10	4.303	1.270	1.27	3.990
#11	5.313	1.410	1.56	4.430
#14	7.65	1.693	2.25	5.32
#18	13.60	2.257	4.00	7.09

THE REINFORCING STEEL MARKS IN THIS SCHEDULE INDICATE THE REQUIRED BAR CORROSION RESISTANCE LEVEL. CORROSION RESISTANCE LEVEL IS DENOTED WITH A .2 FOR LEVEL TWO SUFFIX OR .3 FOR LEVEL THREE SUFFIX. .1 FOR LEVEL ONE IS TO BE OMITTED. THE BAR MATERIAL TYPE AND BAR STEEL GRADE PROVIDED FOR EACH CORROSION LEVEL WILL BE RECORDED ON THE PLANSET P1 SHEET FOR AS-BUILT RECORD PLAN ARCHIVES.




PROJECT NAME:	BRATTLEBORO
PROJECT NUMBER:	BRO 1442 (35)
FILE NAME: z10j062rss.dgn	PLOT DATE: 6/5/2013
PROJECT MANAGER: S.E. BURBANK	DRAWN BY: E.A FIALA
DESIGNED BY: E.A FIALA	CHECKED BY: S.E. BURBANK
REINFORCING STEEL SCHEDULE (2 OF 2)	SHEET 50 OF 68



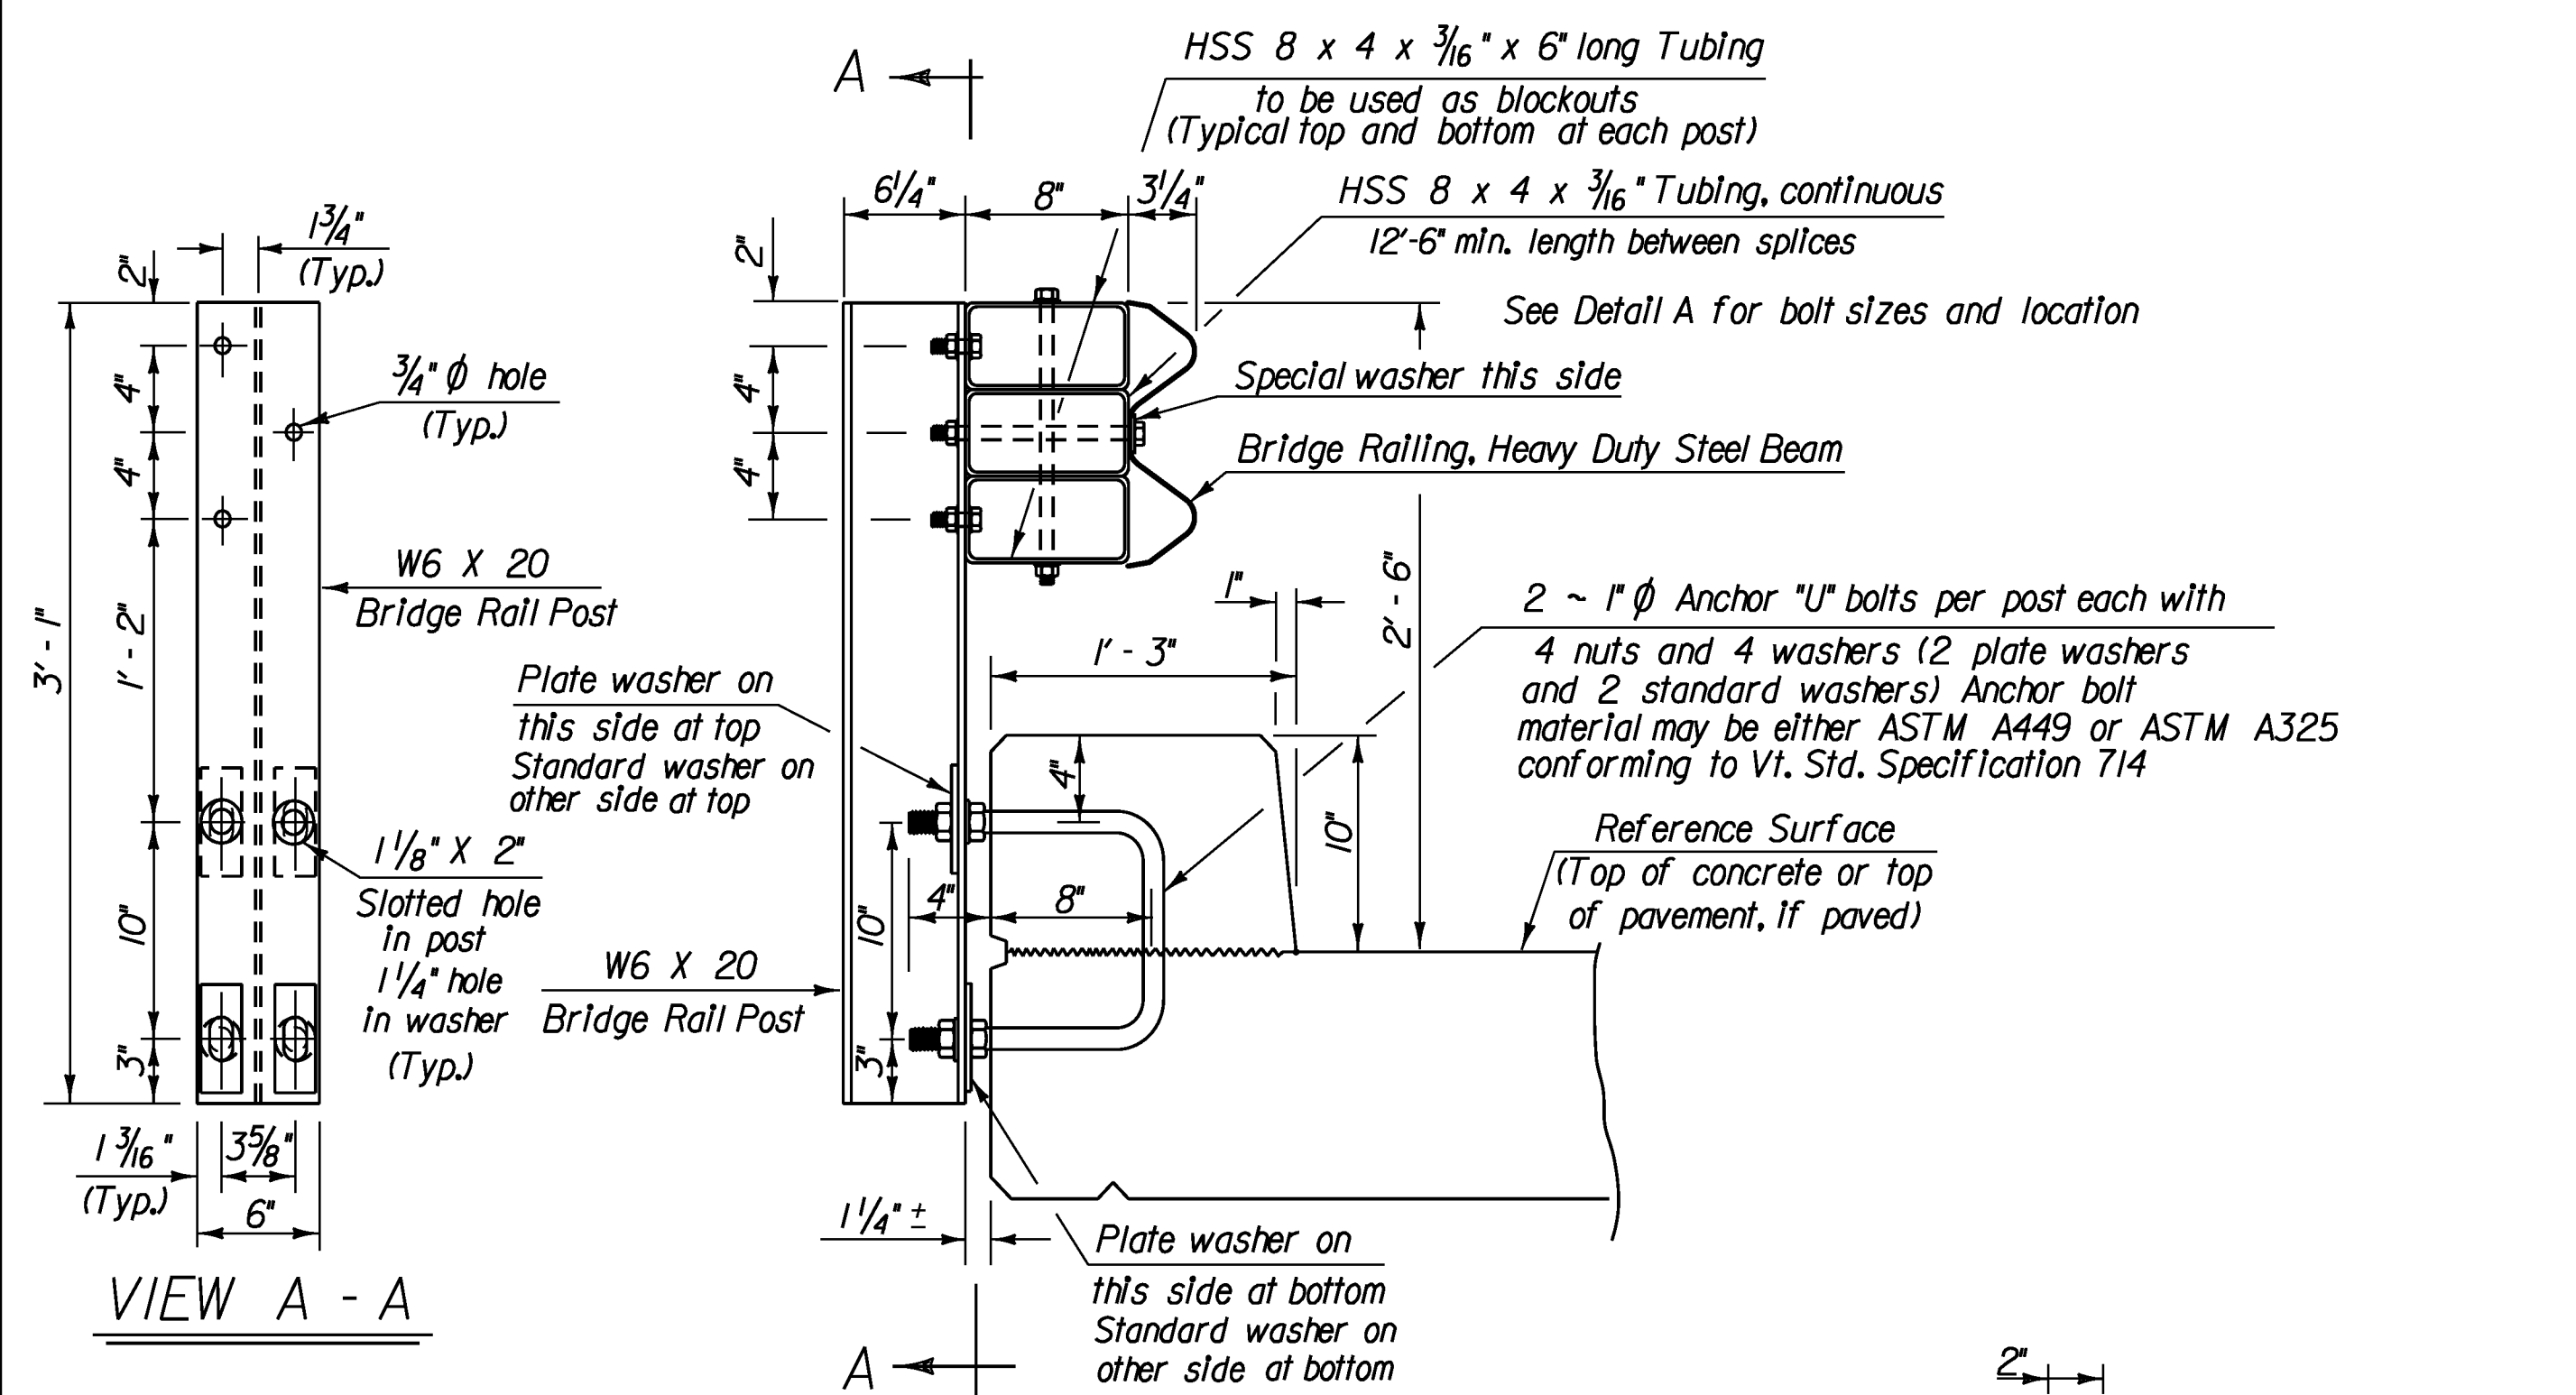

FASCIA MOUNTED WITH CURB

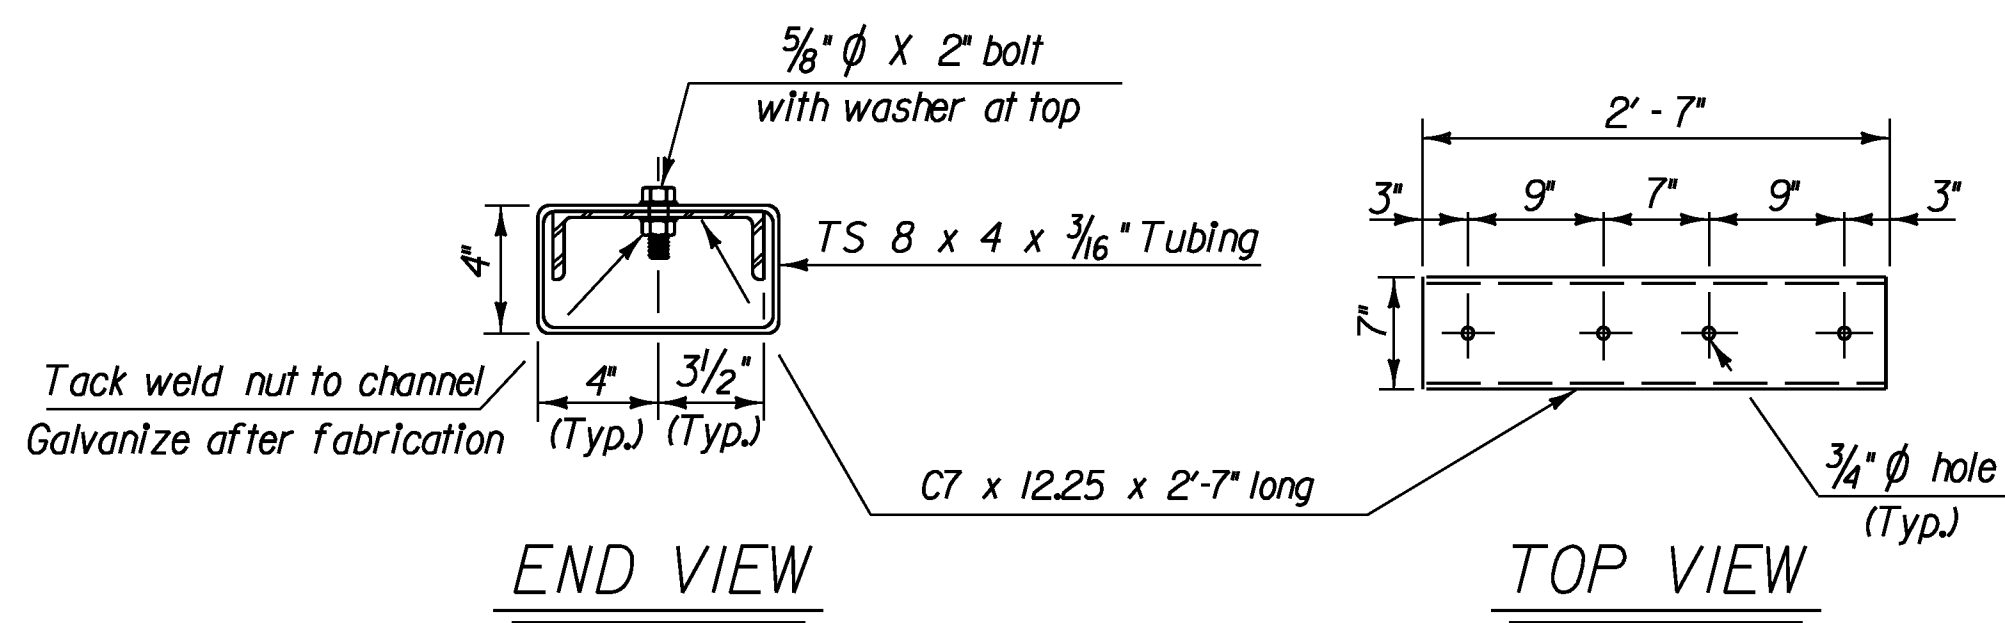

SPLICE BAR DETAILS



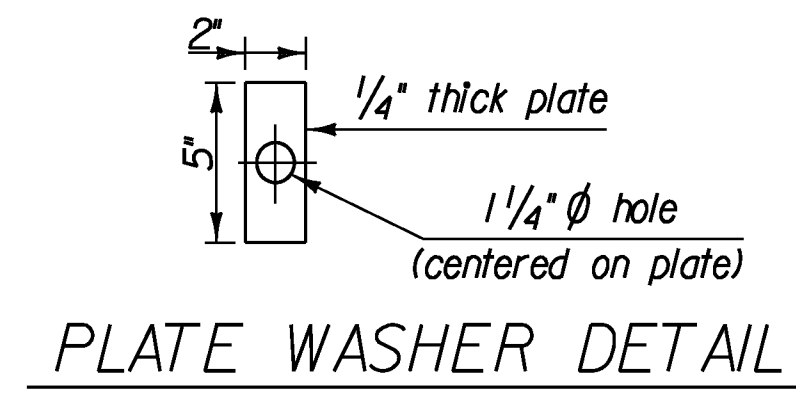



PLATE WASHER DETAIL

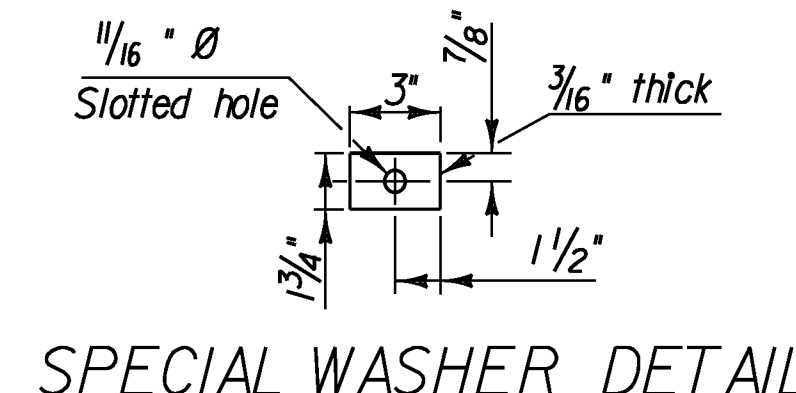

SPECIAL WASHER DETAIL

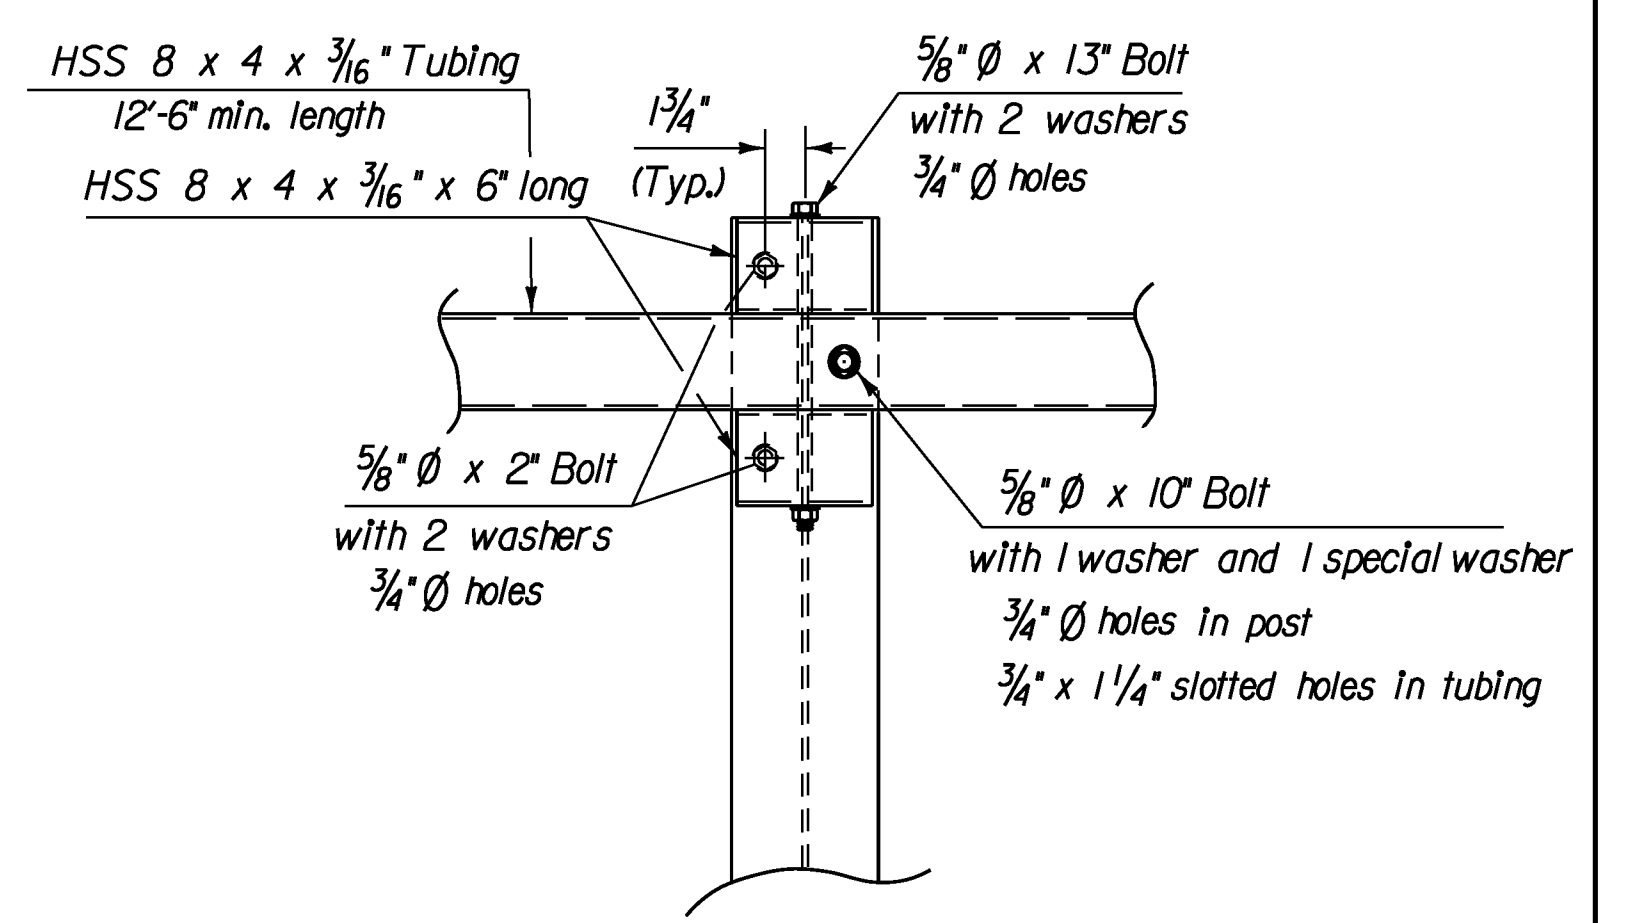


DETAIL A  
Steel Beam Guard Rail Not Shown

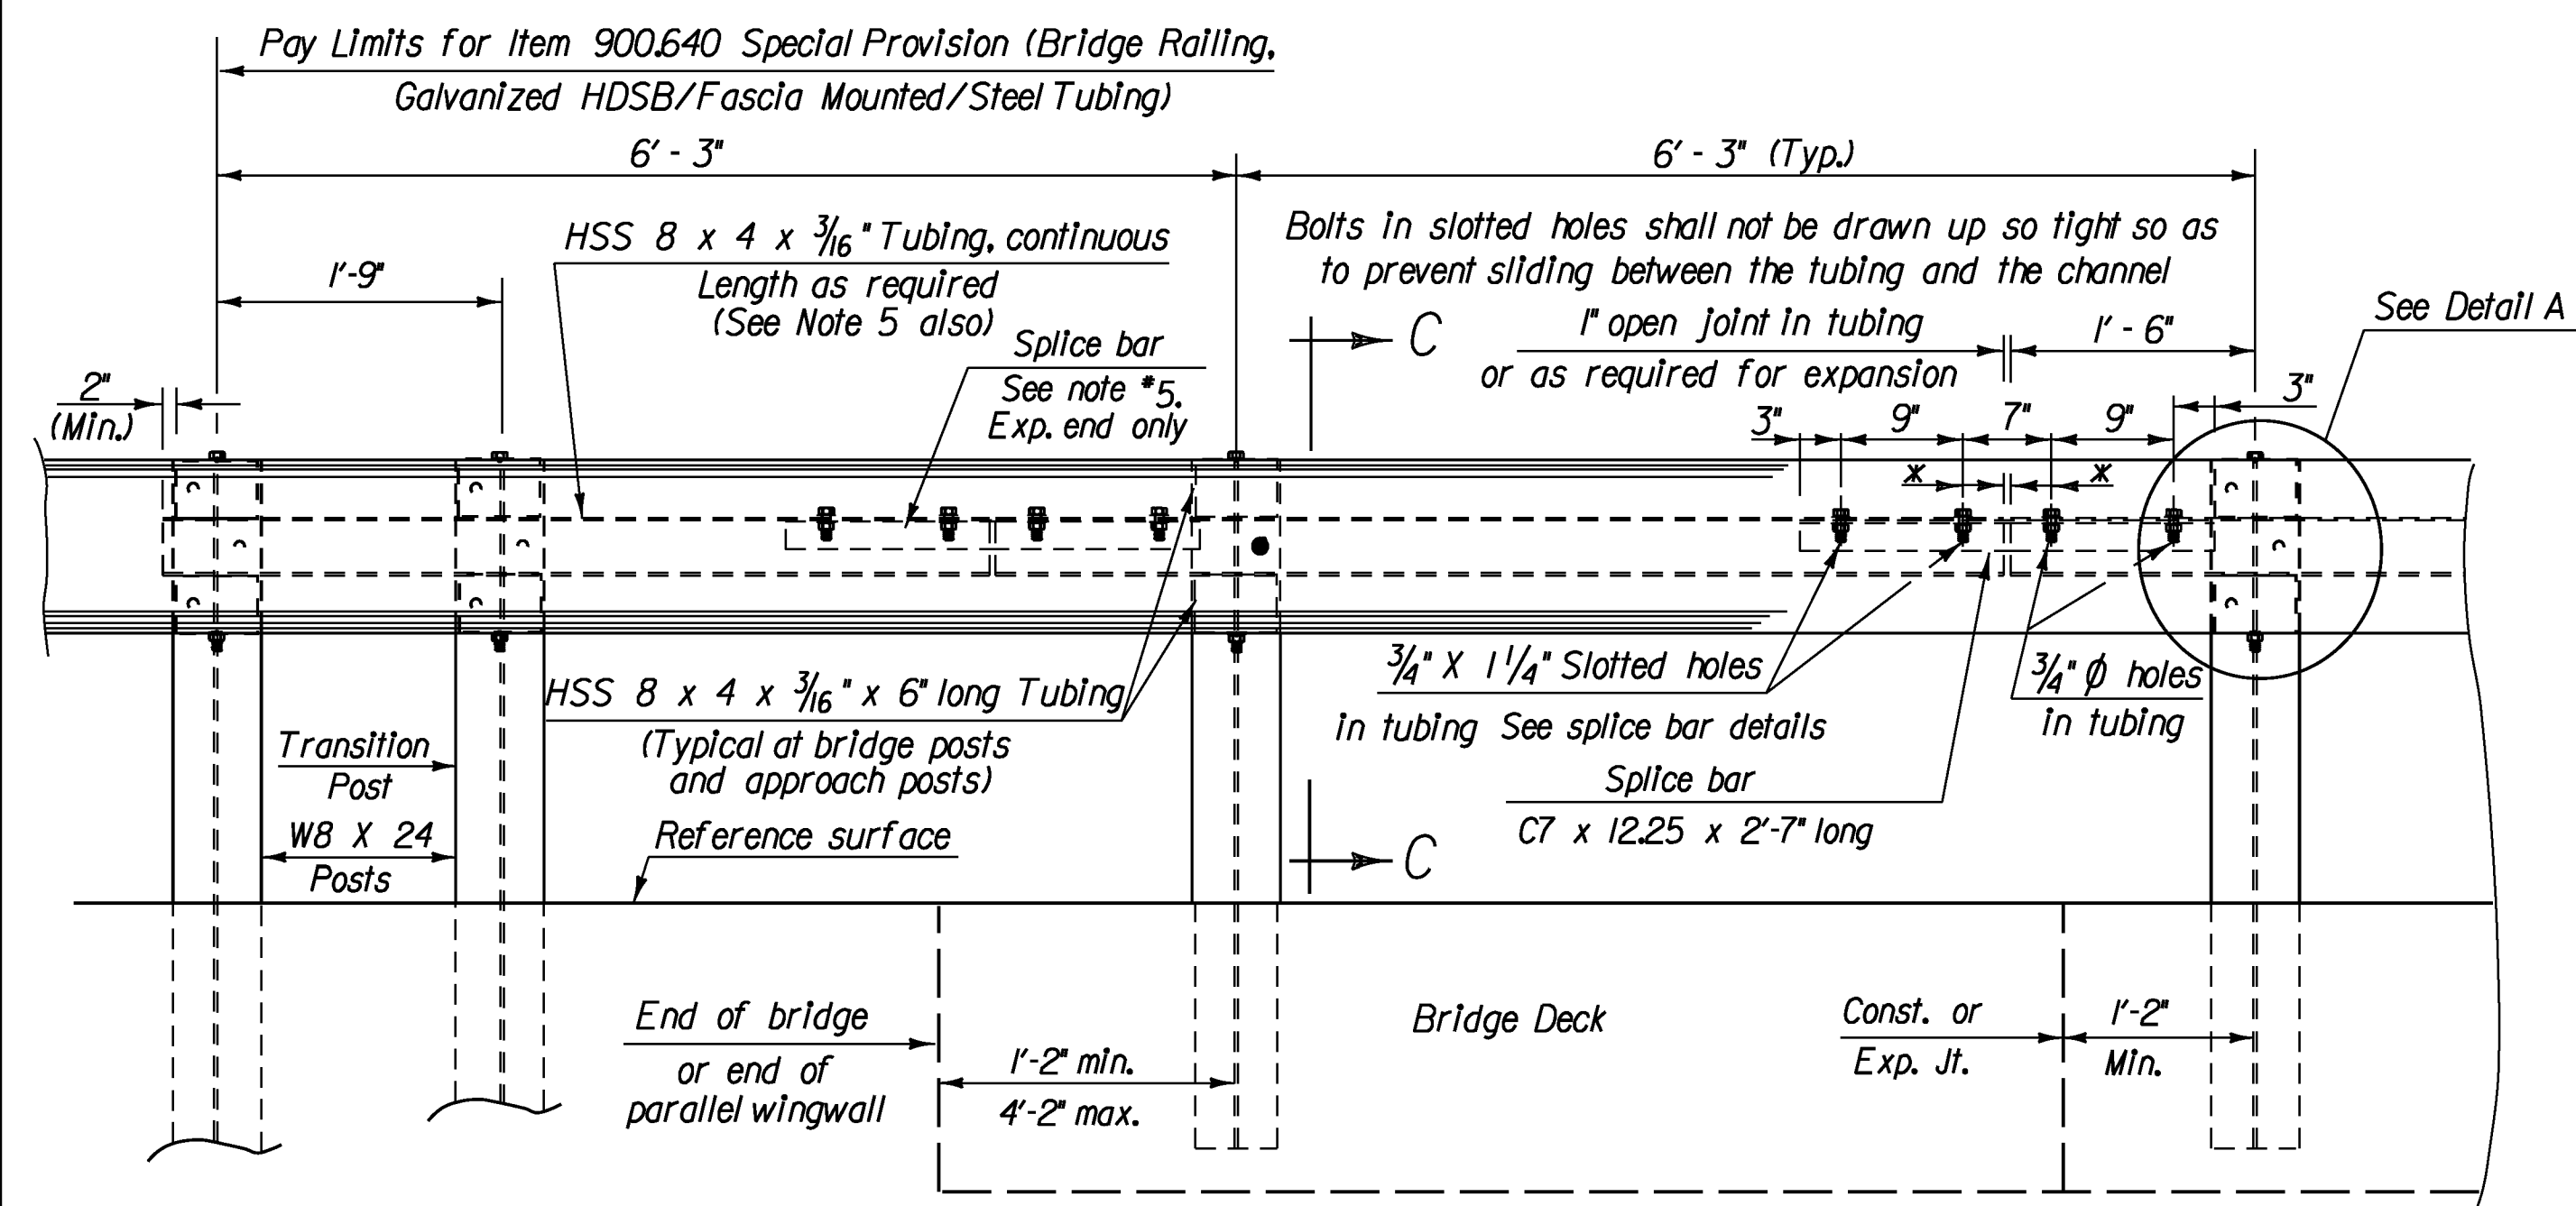

RAILING ELEVATION VIEW  
(SHOWN LOOKING FROM C WITHOUT CURB)



NOTES

1. ALL WORK AND MATERIALS SHALL CONFORM TO SECTION 525.
2. PRIOR TO GALVANIZING THE ASSEMBLED POST, GRIND ALL EDGES TO A MINIMUM RADIUS OF 1/16 IN.
3. ALL POSTS SHALL BE SET NORMAL TO GRADE.
4. SPLICES FOR THE STEEL BEAM GUARDRAIL SHALL LAP IN THE DIRECTION OF TRAFFIC.
5. A RAILING JOINT SPLICE SHALL BE PROVIDED IN ANY RAIL BAY SPANNING THE END OF AN INTEGRAL ABUTMENT BRIDGE AND AT ALL SUPERSTRUCTURE EXPANSION JOINTS.
6. SEE STANDARD DRAWING G-1 FOR DETAILS OF DELINEATORS. A DELINEATOR SHALL BE LOCATED AT EVERY FIFTH POST. WHITE IS TO BE INSTALLED ON THE DRIVER'S RIGHT. FOR ONE WAY BRIDGES, YELLOW IS TO BE INSTALLED ON THE DRIVER'S LEFT.
7. FOR RADIUS LESS THAN 950 FEET, HSS 8x4 TUBES SHALL BE SHOP BENT TO FIT THE APPLICABLE CURVE.
8. HOLES IN RAIL FOR RAIL TUBE ATTACHMENT MAY BE FIELD DRILLED. HOLES SHALL BE COATED WITH AN APPROVED ZINC-RICH PAINT PRIOR TO INSTALLATION.
9. SEE STANDARDS G-1 AND G-1d FOR ADDITIONAL DETAILS CONCERNING GUARDRAIL.

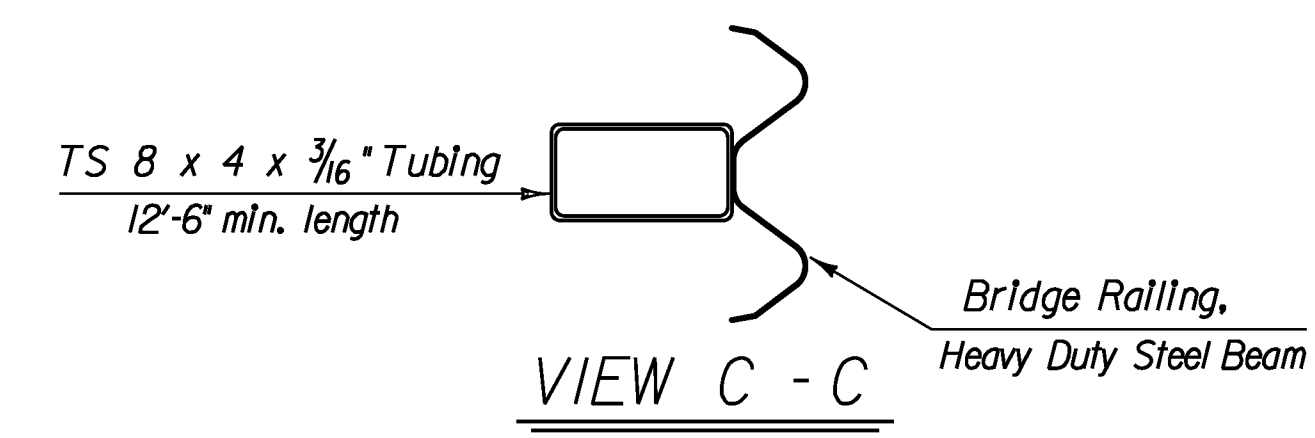

VIEW C - C

PROJECT NAME:	BRATTLEBORO
PROJECT NUMBER:	BRO 1442(35)
FILE NAME:	z10j062brail.dgn
PROJECT LEADER:	S.E. BURBANK
DESIGNED BY:	E.A. FIALA
BRIDGE RAIL DETAILS	
PLOT DATE:	10/14/2013
DRAWN BY:	VTRANS/VHB
CHECKED BY:	S.E. BURBANK
SHEET	51 OF 68

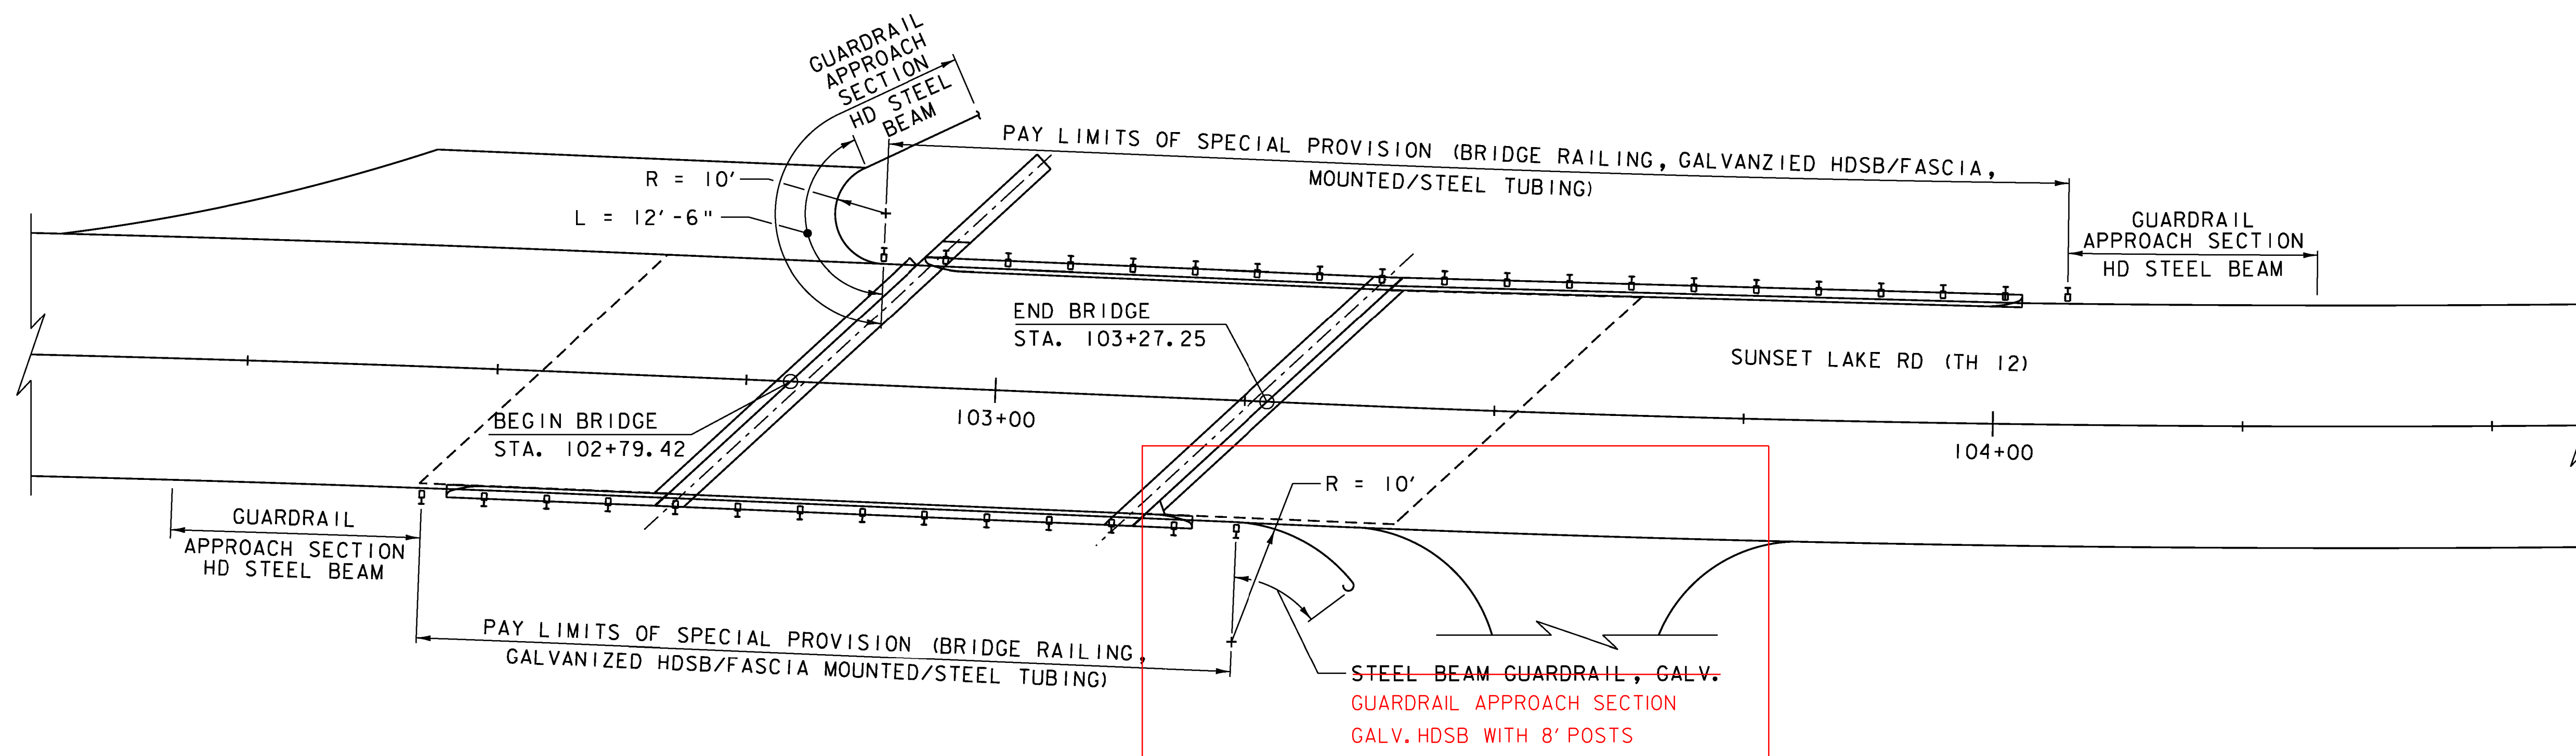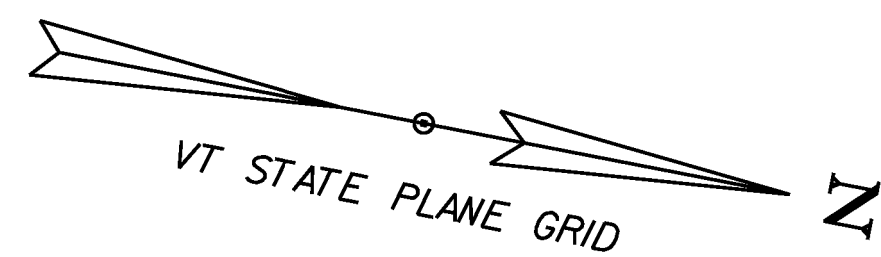


BRIDGE RAIL LAYOUT  
SCALE 1/8" = 1'-0"


NOTE: SEE VTRANS STD S-367B FOR APPROACH RAILING SPACING.

PROJECT NAME:	BRATTLEBORO
PROJECT NUMBER:	BRO 1442(35)
FILE NAME:	z10j062brail.dgn
PROJECT LEADER:	S.E. BURBANK
DESIGNED BY:	E.A. FIALA
BRIDGE RAIL LAYOUT SHEET	
PLOT DATE:	10/14/2013
DRAWN BY:	E.A. FIALA
CHECKED BY:	S.E. BURBANK
SHEET	52 OF 68




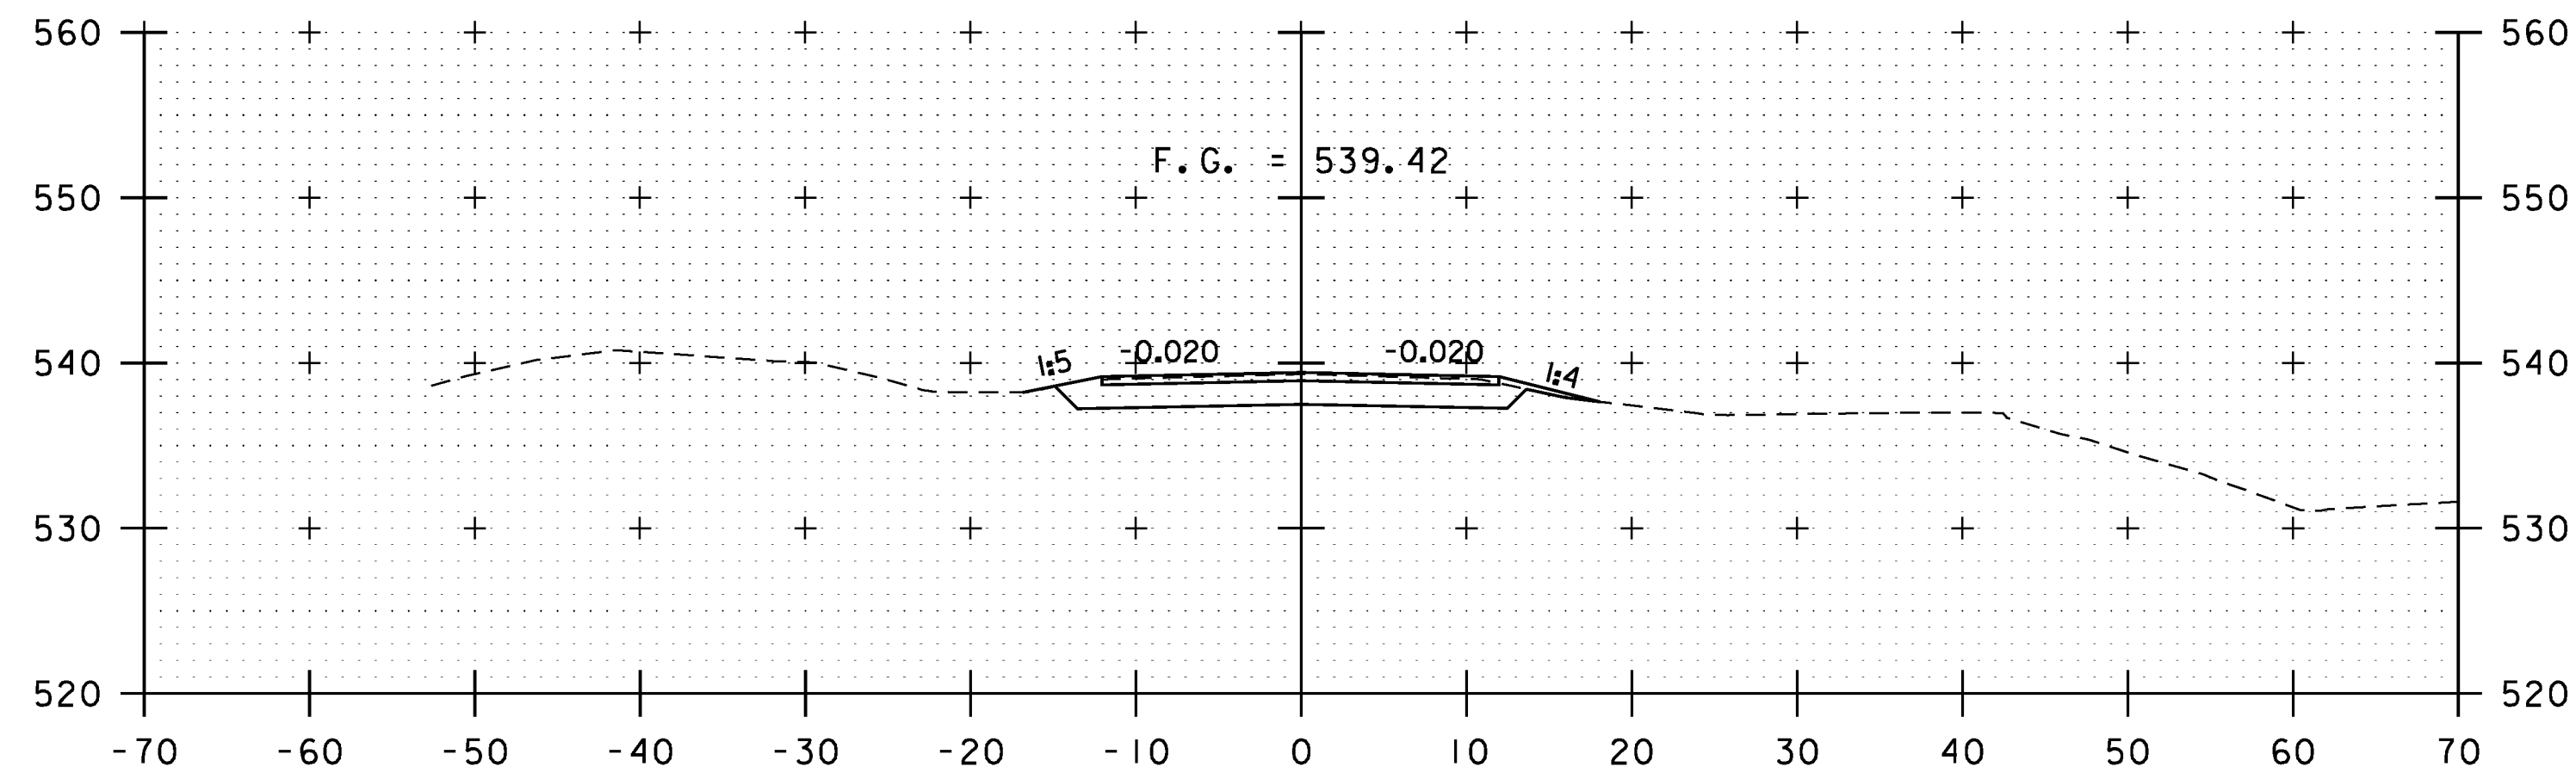


101+75

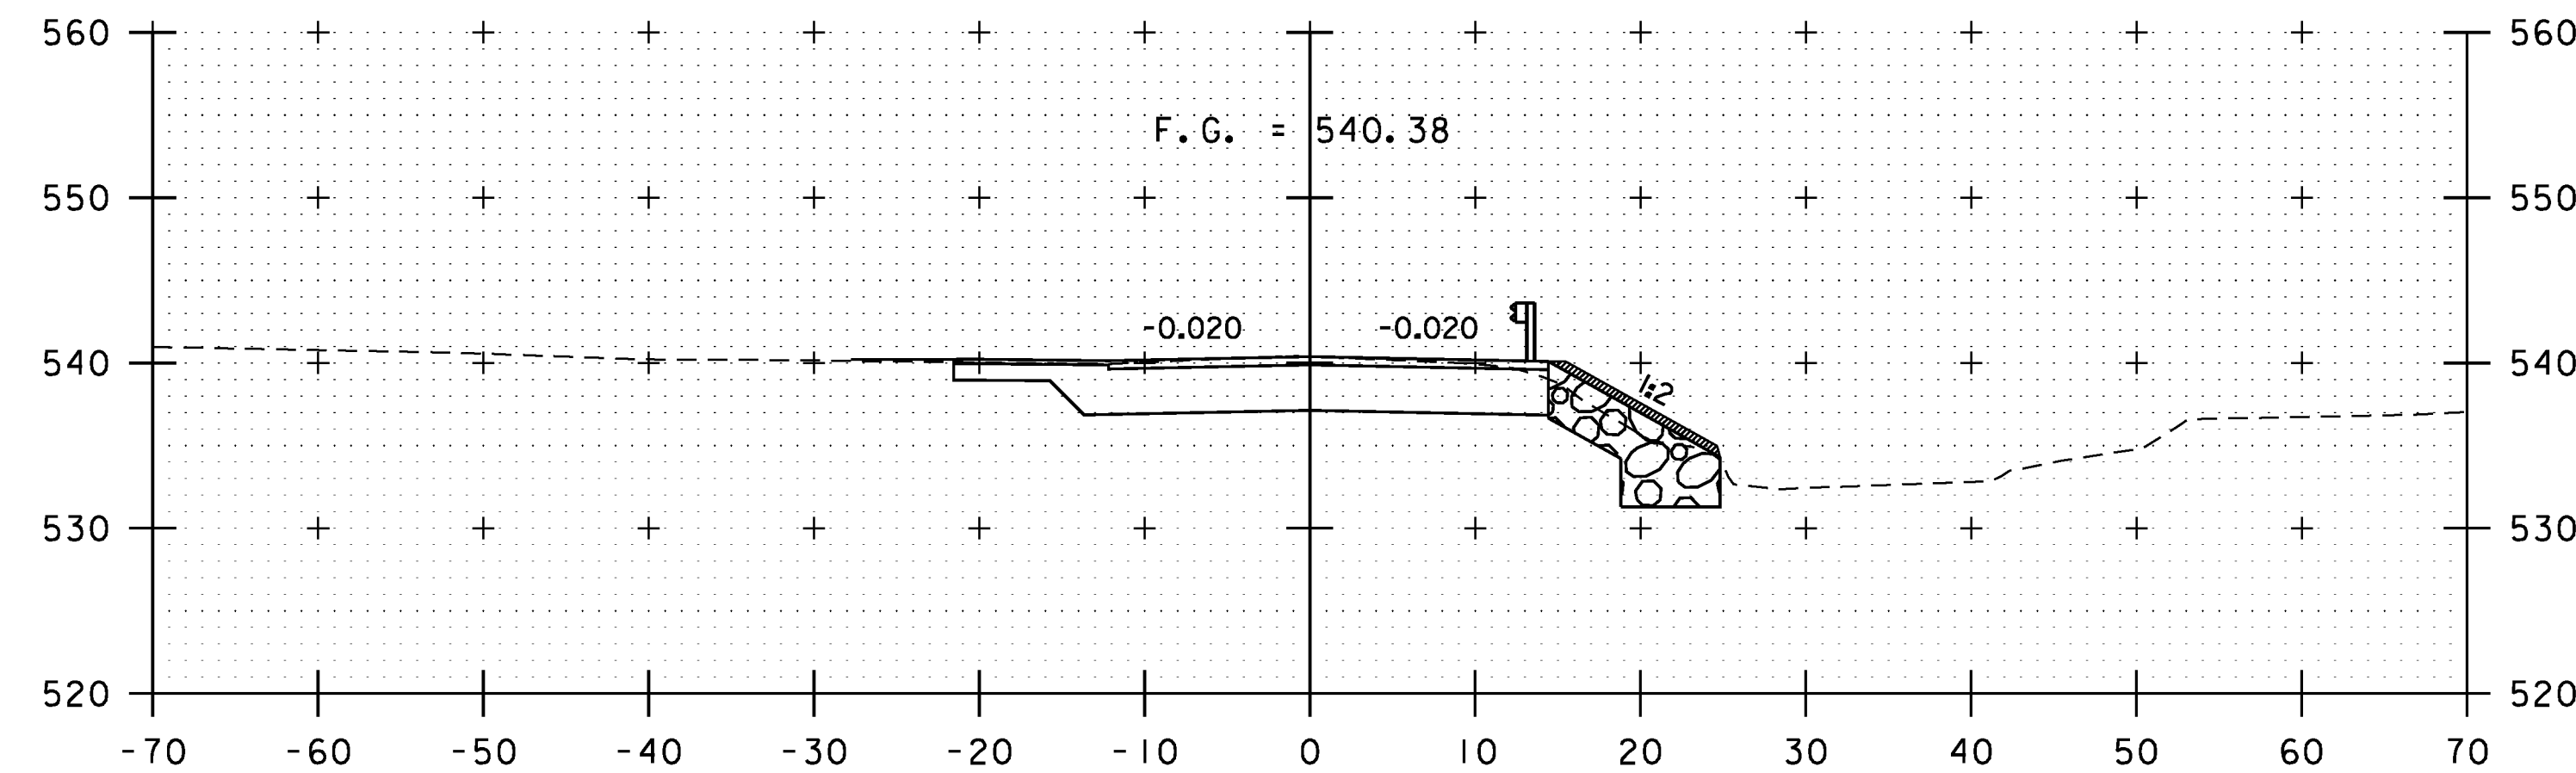


PRIVATE ROAD LT  
102+45

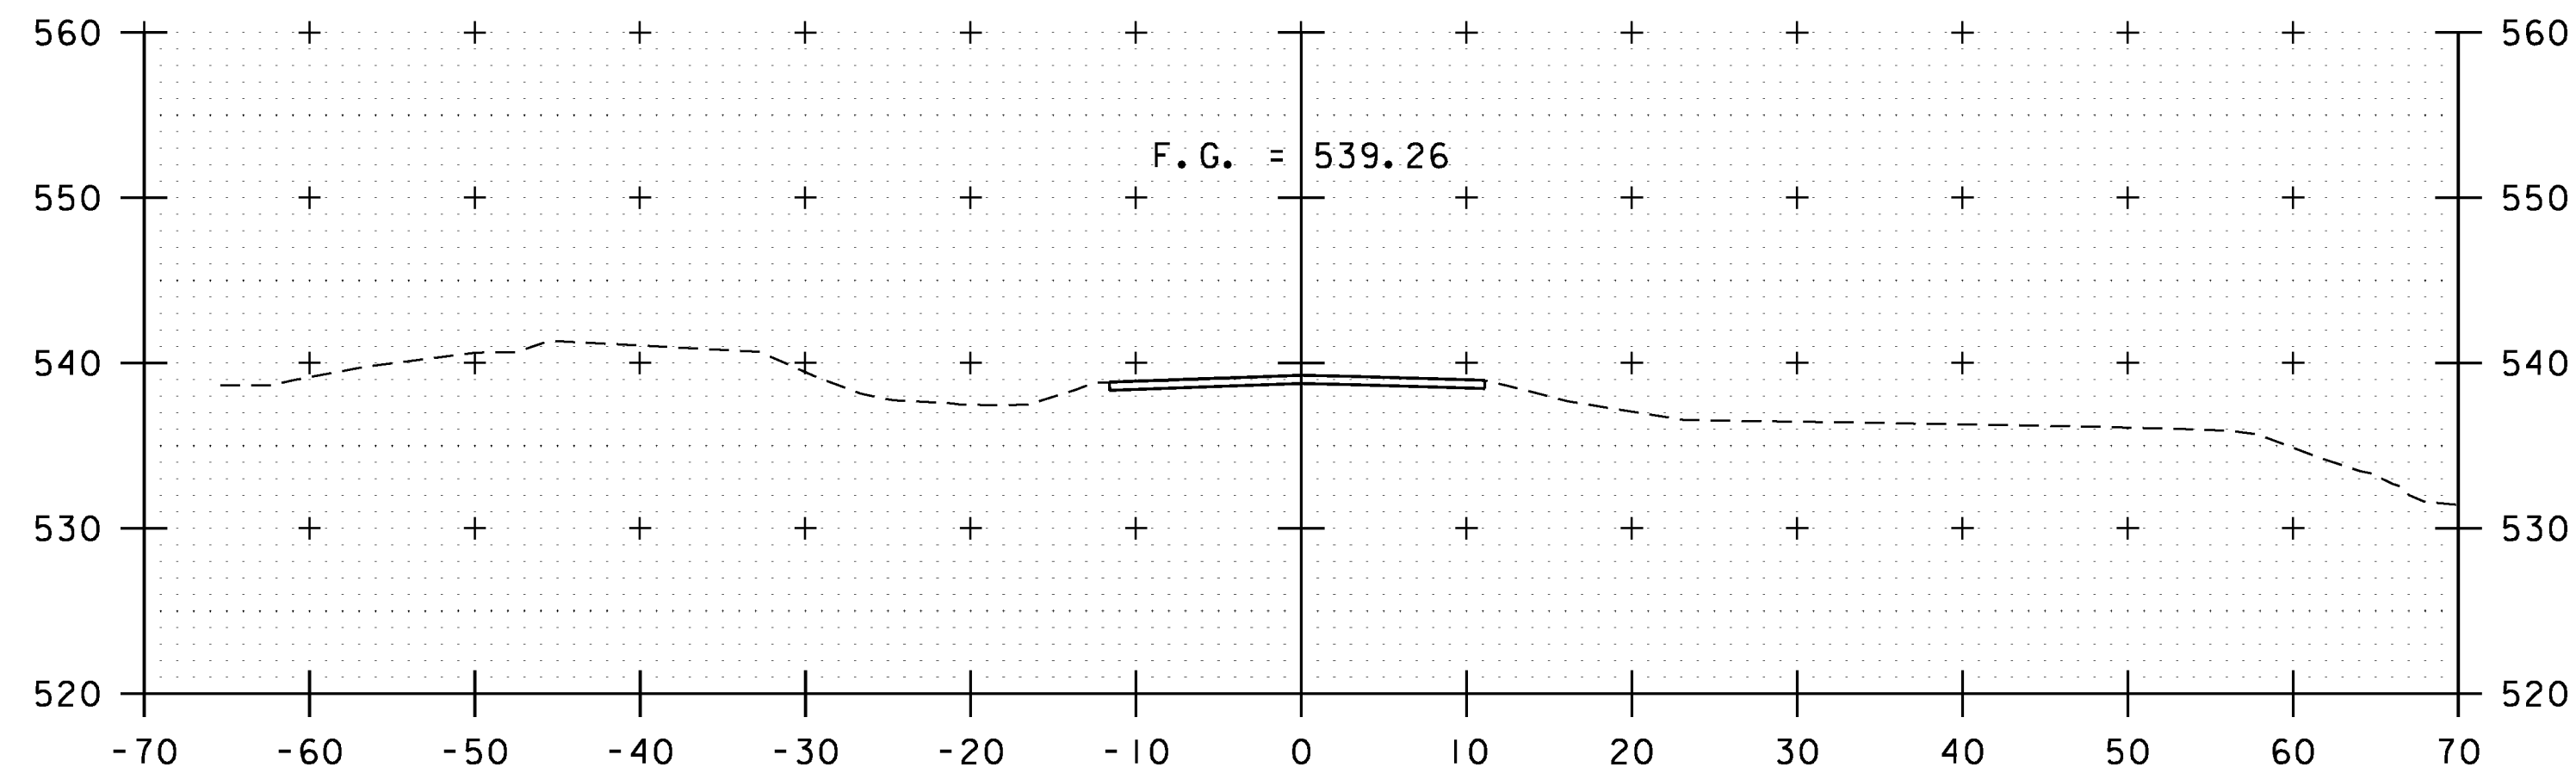


101+50

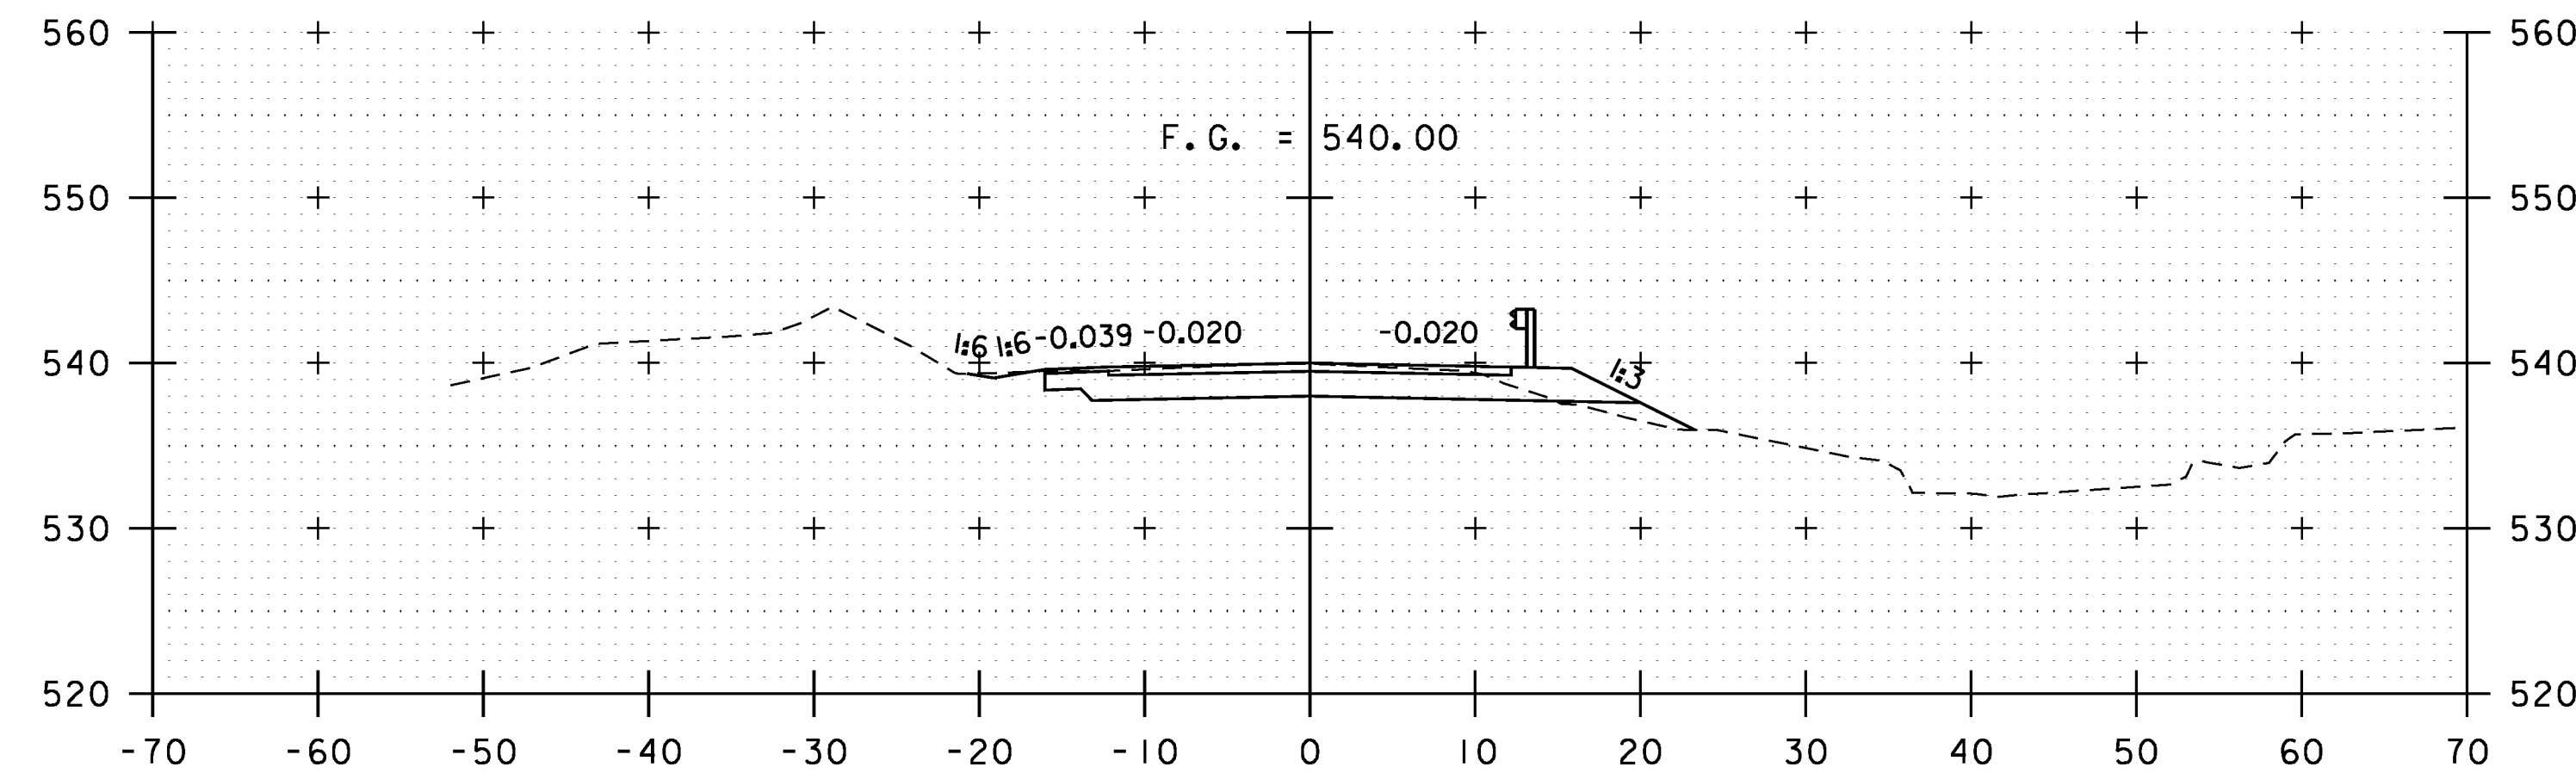

102+25

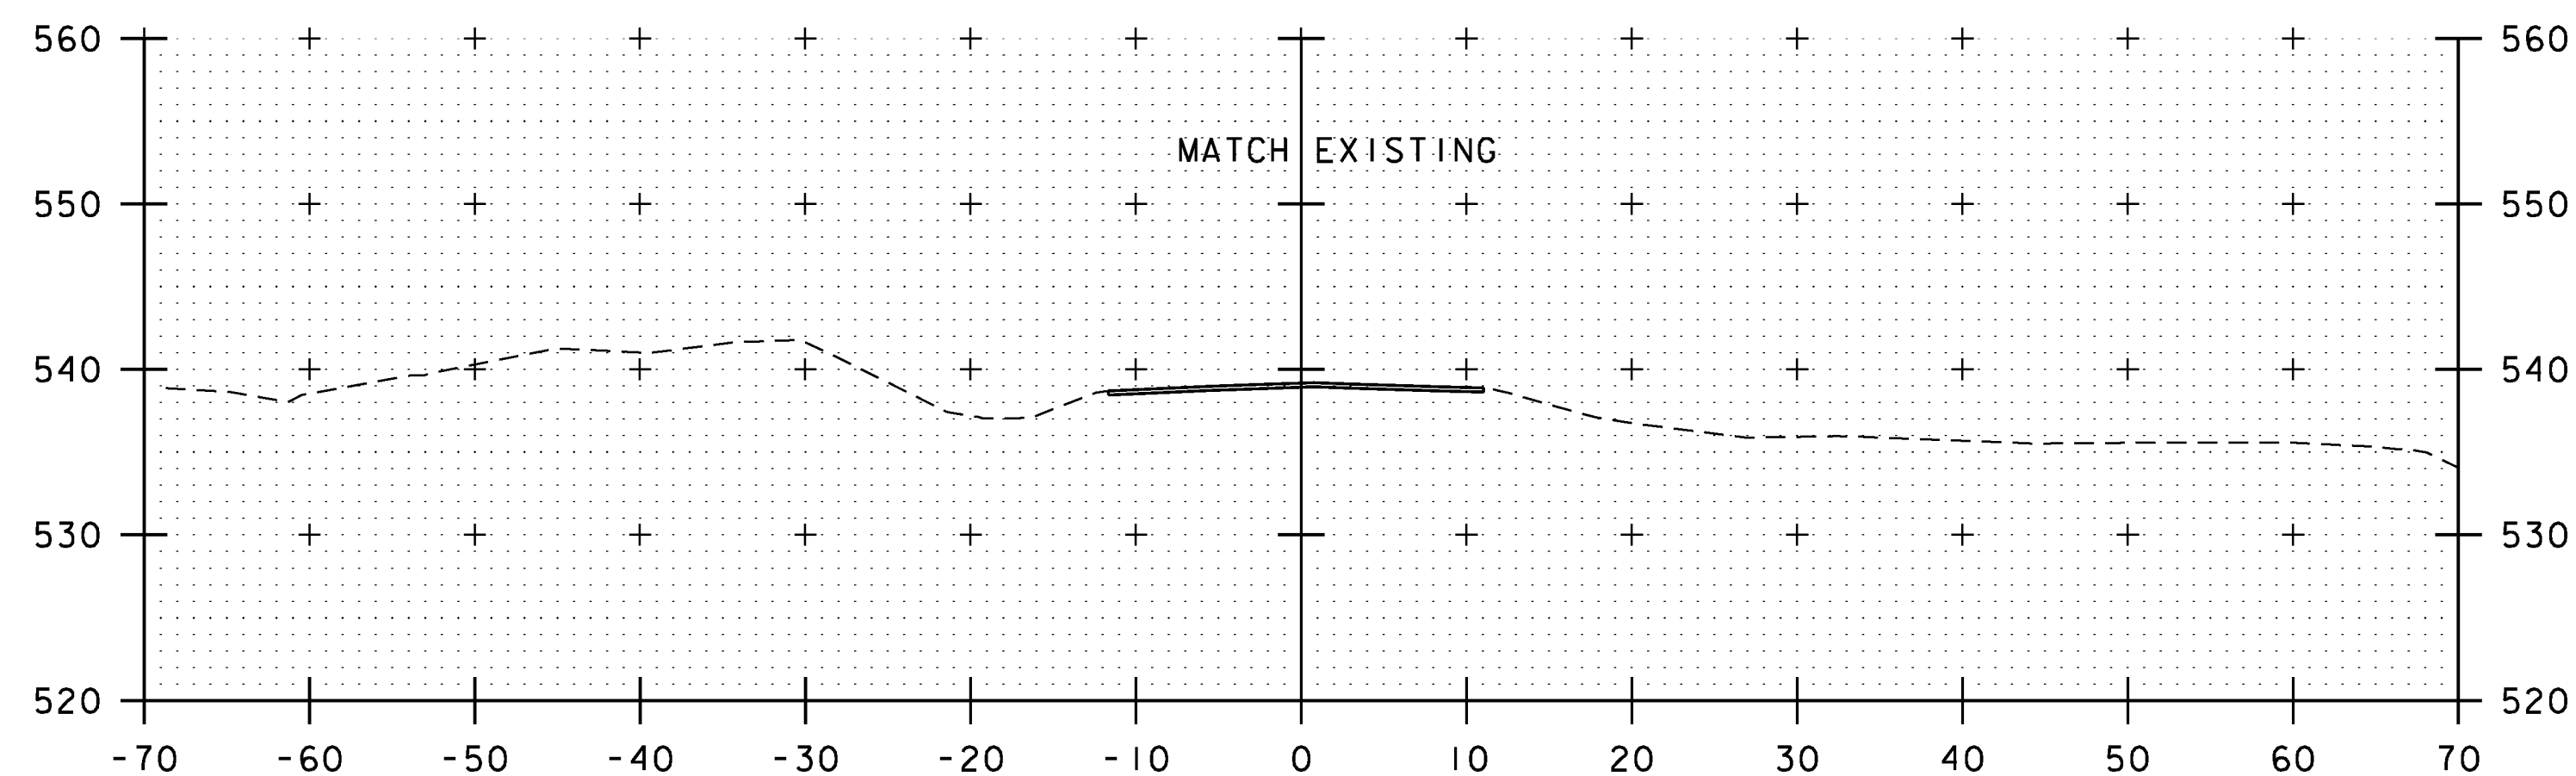

101+35  
BEGIN APPROACH  
STA 101+35.00

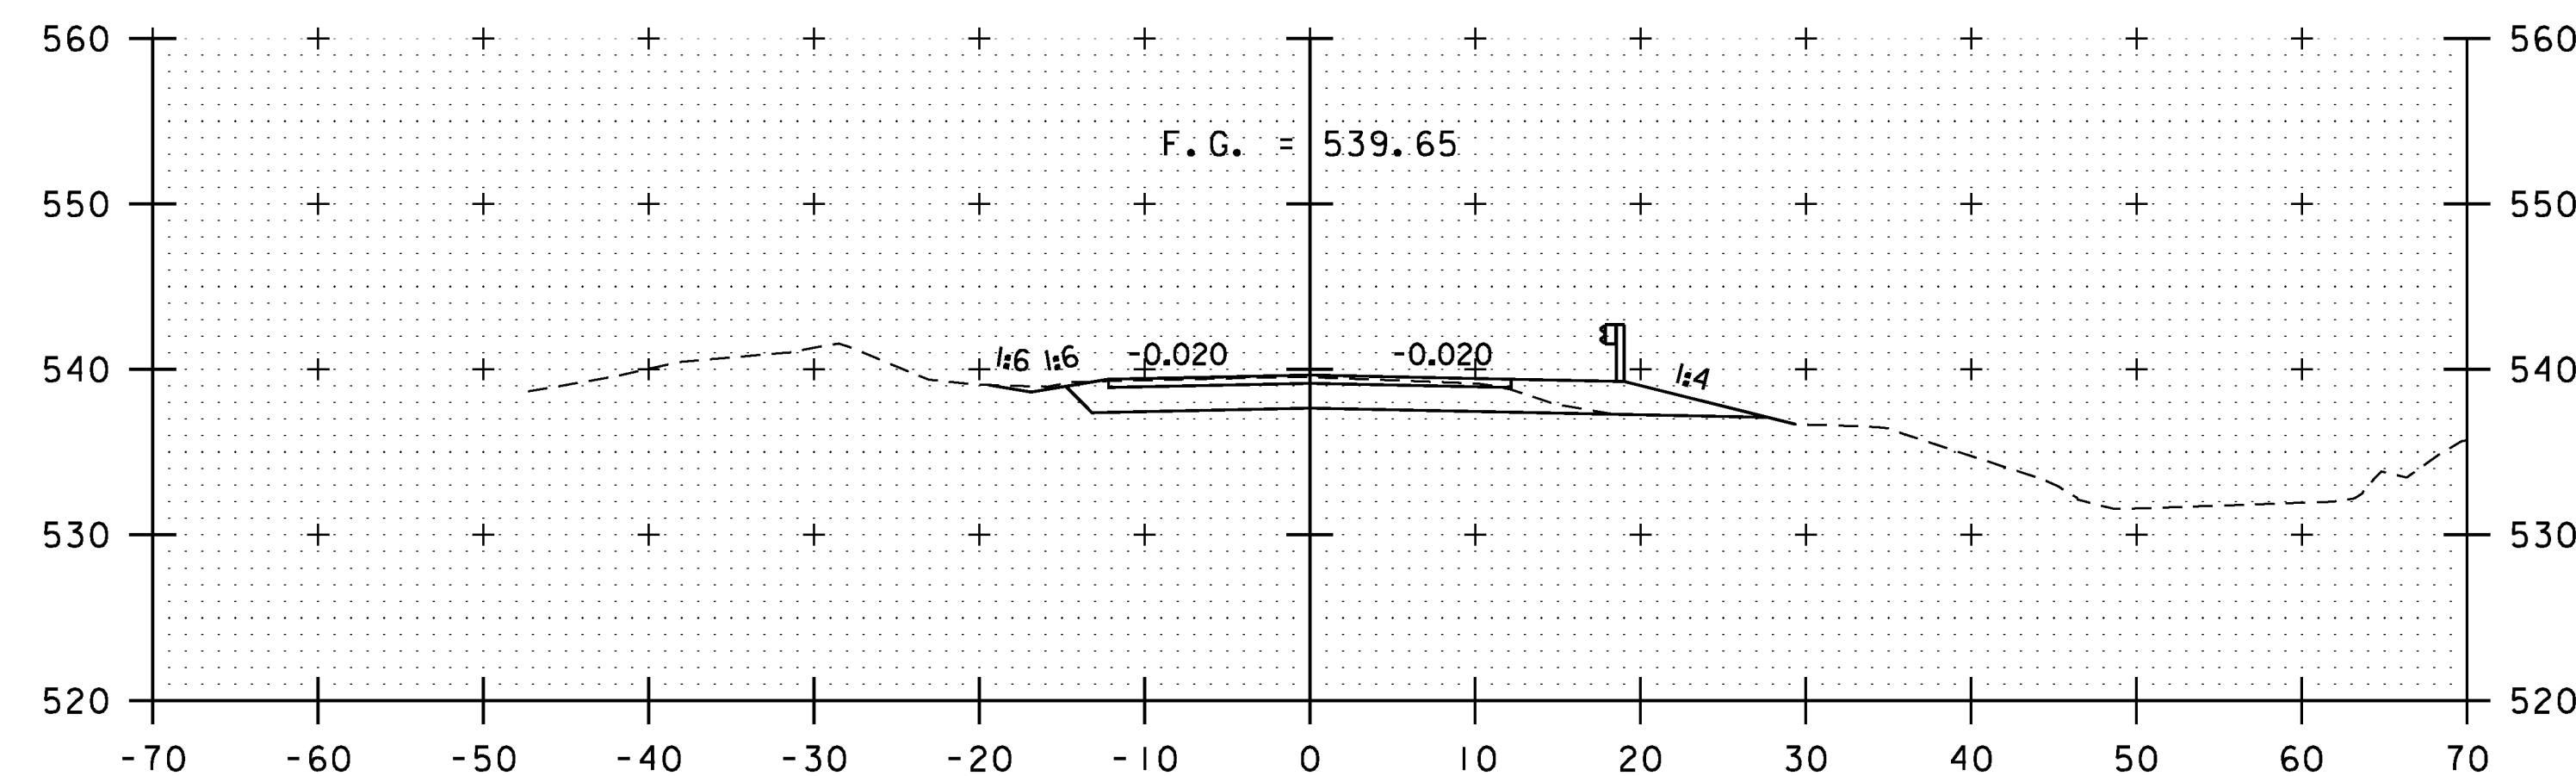

102+00  
BEGIN PROJECT  
STA 101+80.00

ROADWAY CROSS SECTIONS

SCALE 1" = 10'-0"







STA. 101+35 TO STA. 102+45

PROJECT NAME: BRATTLEBORO  
PROJECT NUMBER: BRO 1442(35)

FILE NAME: z10j062xsl.dgn  
PROJECT LEADER: S.E. BURBANK  
DESIGNED BY: E.A. FIALA  
ROADWAY CROSS SECTIONS (1 OF 4)

PLOT DATE: 10/14/2013  
DRAWN BY: E.A. FIALA  
CHECKED BY: S.E. BURBANK  
SHEET 53 OF 68



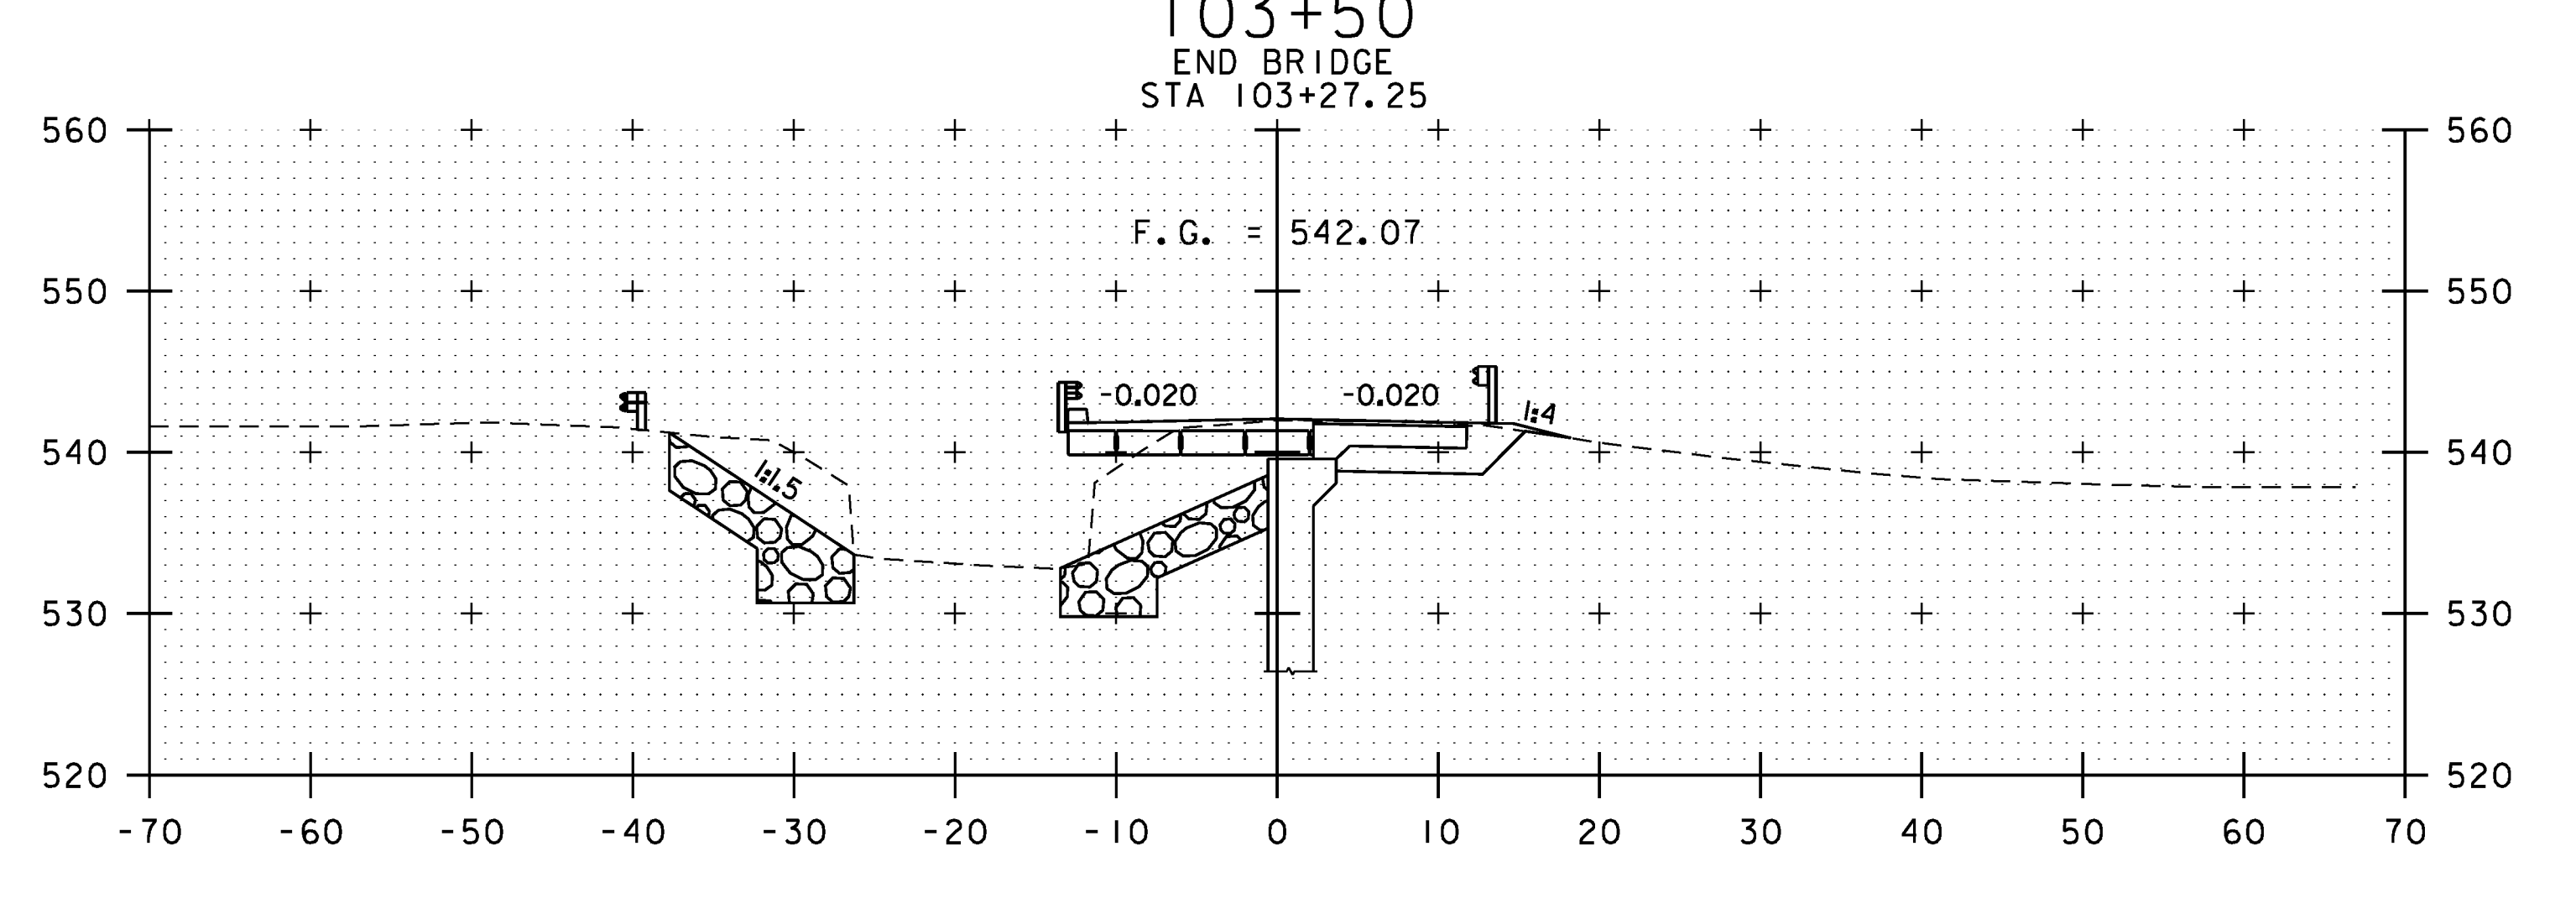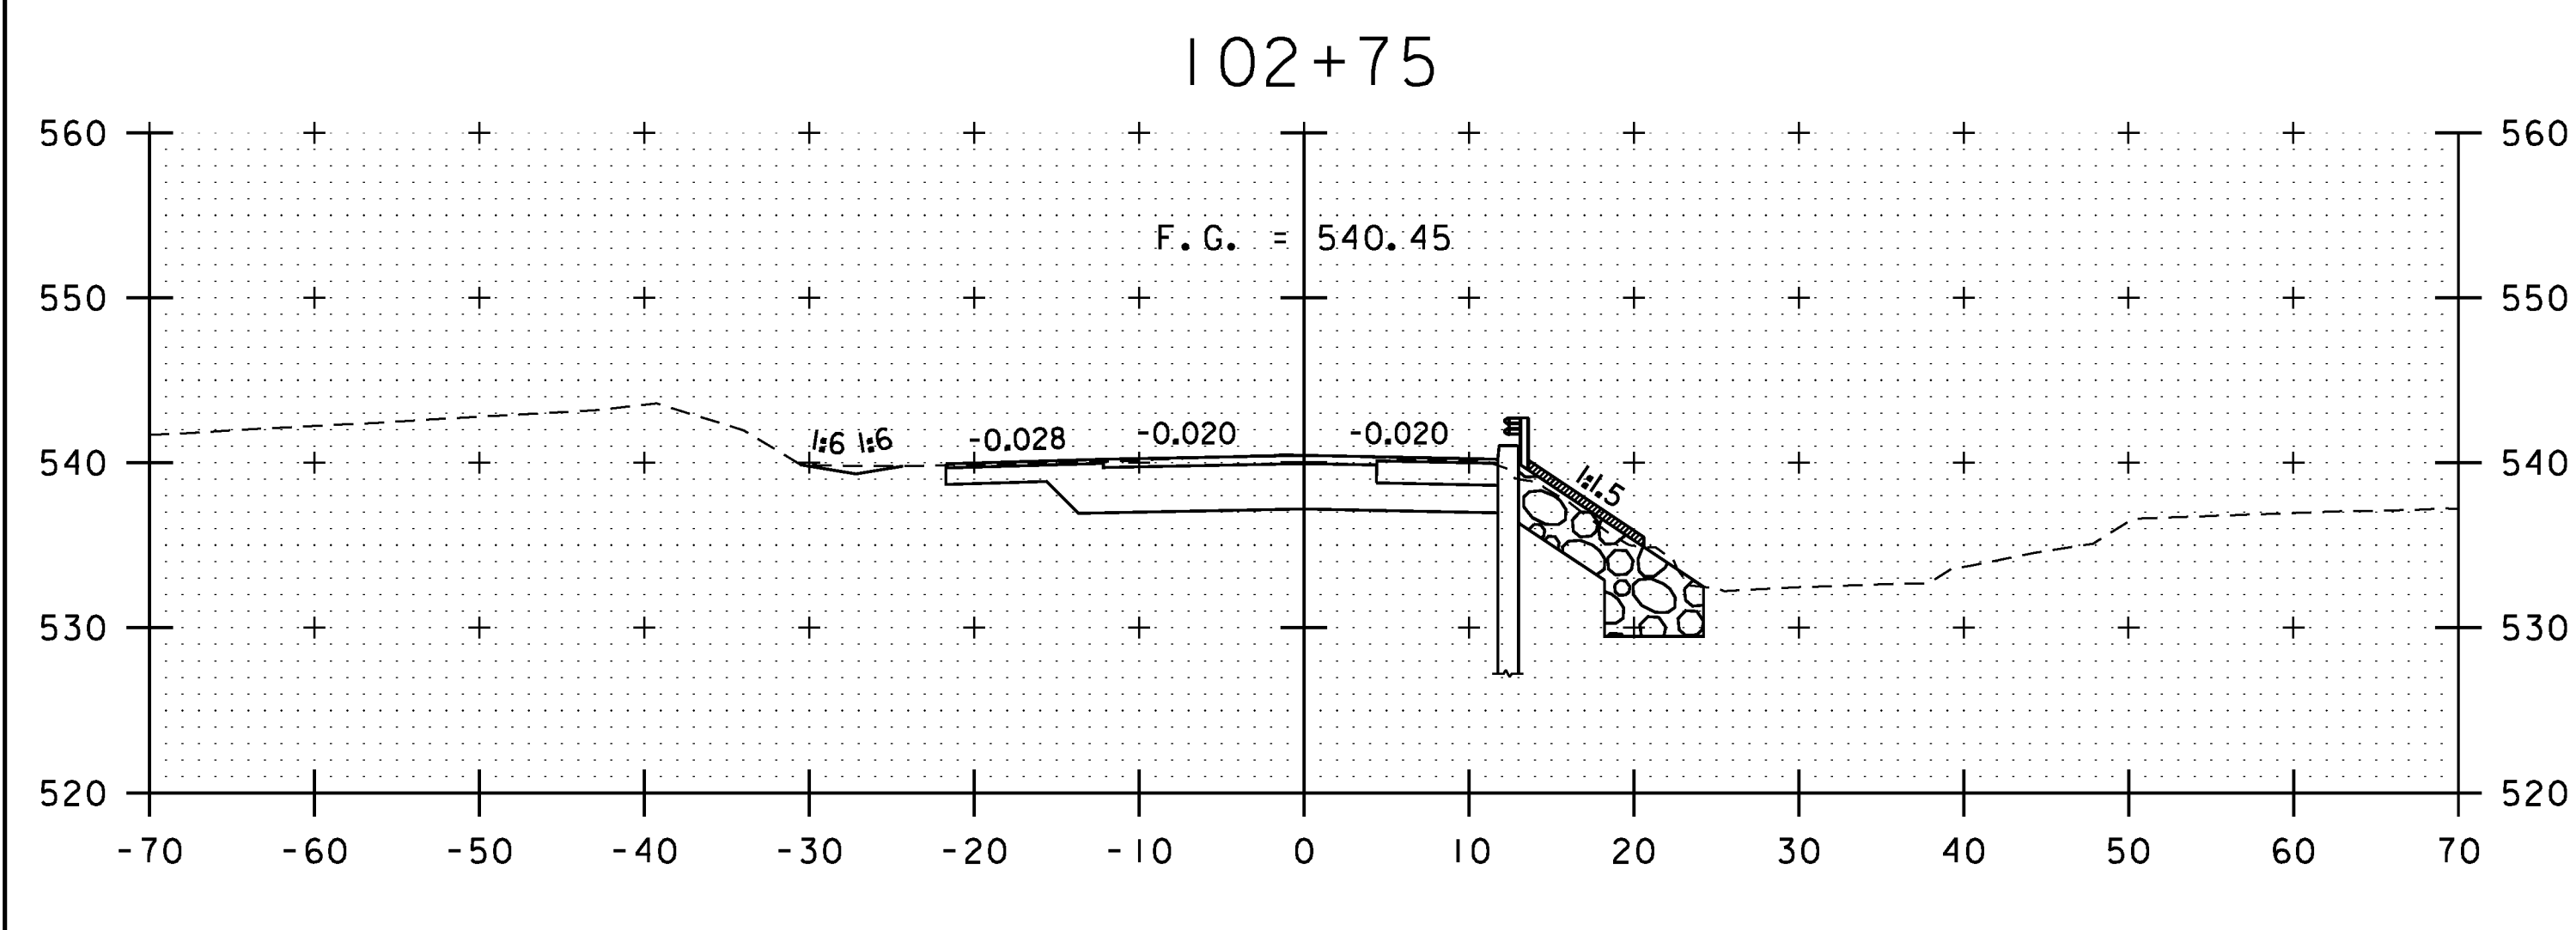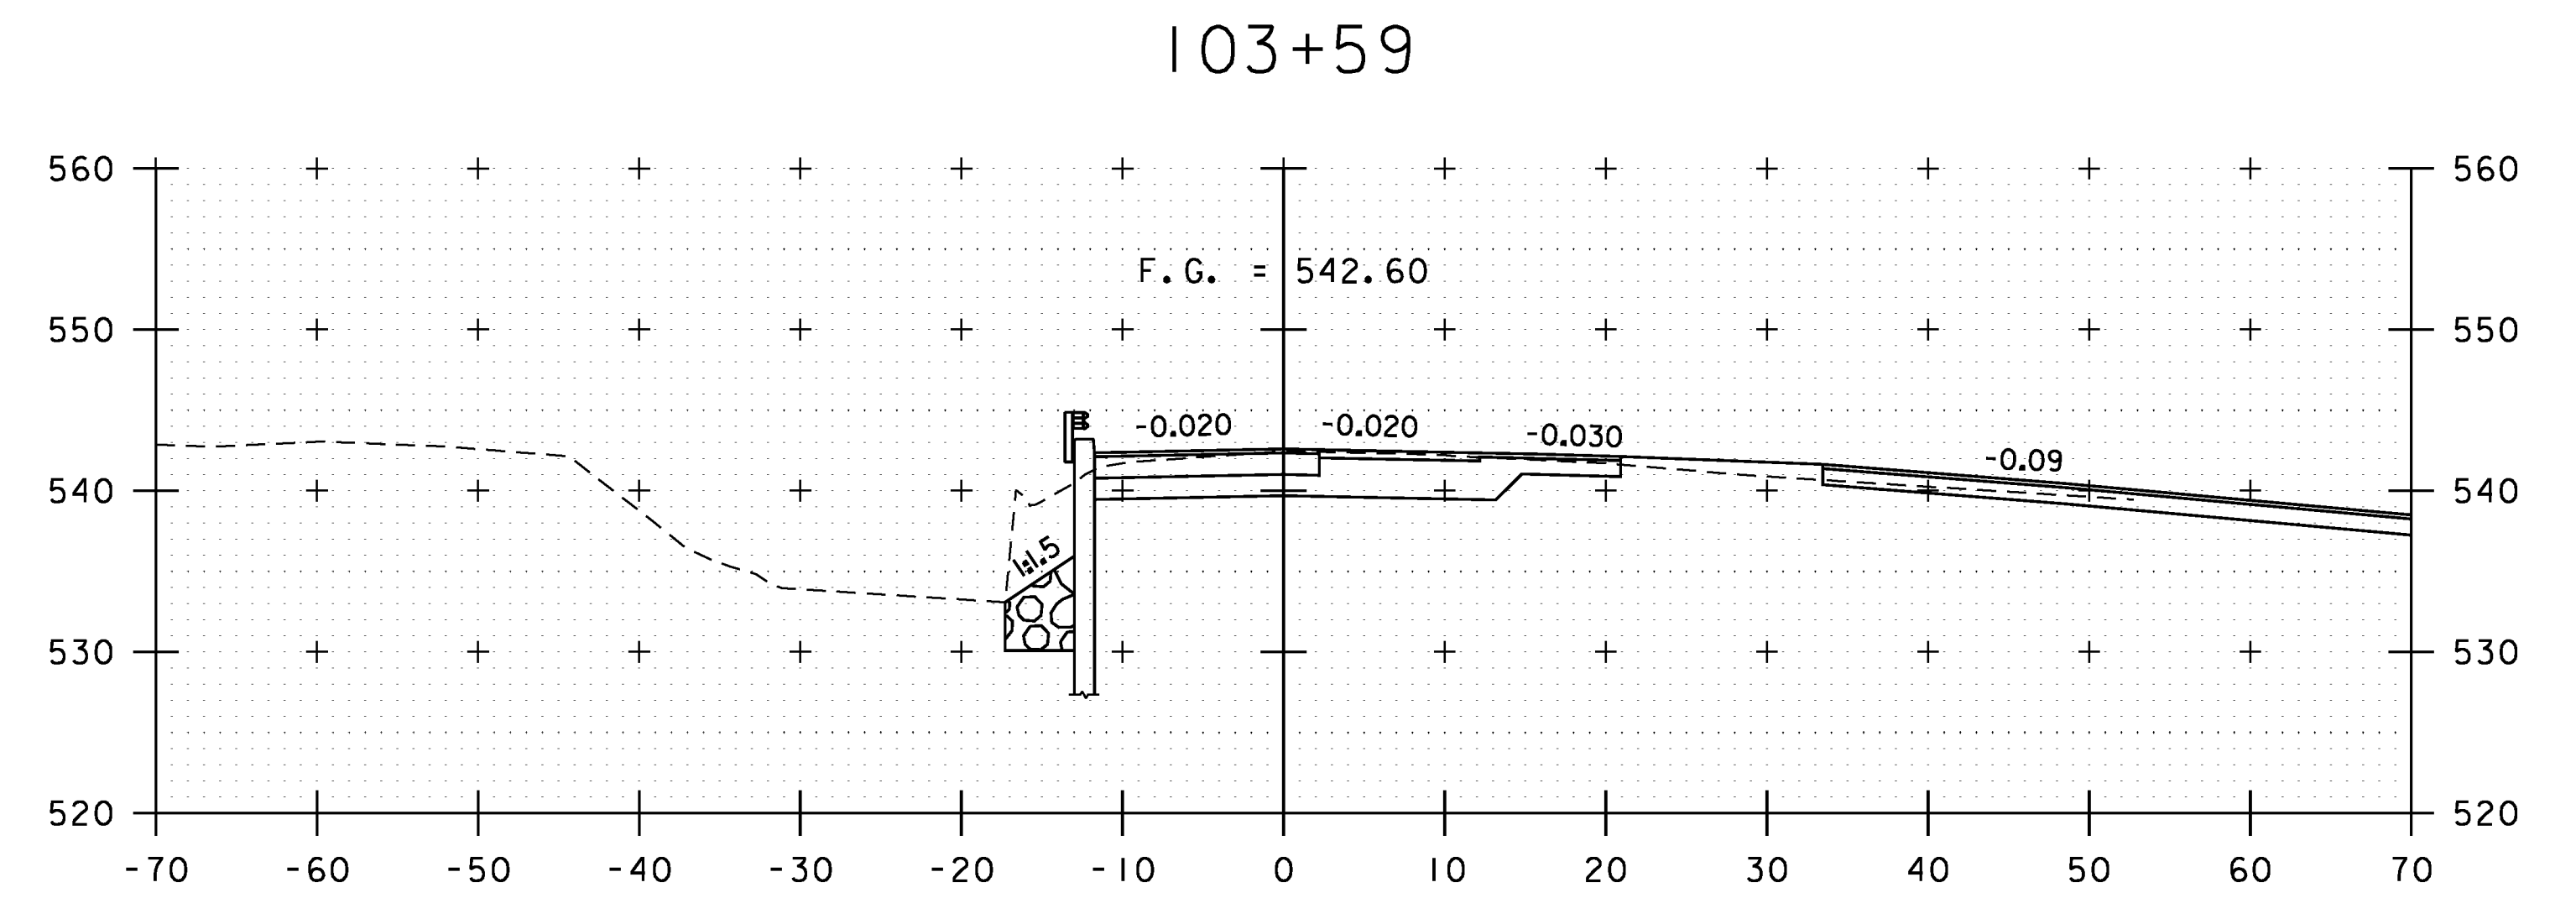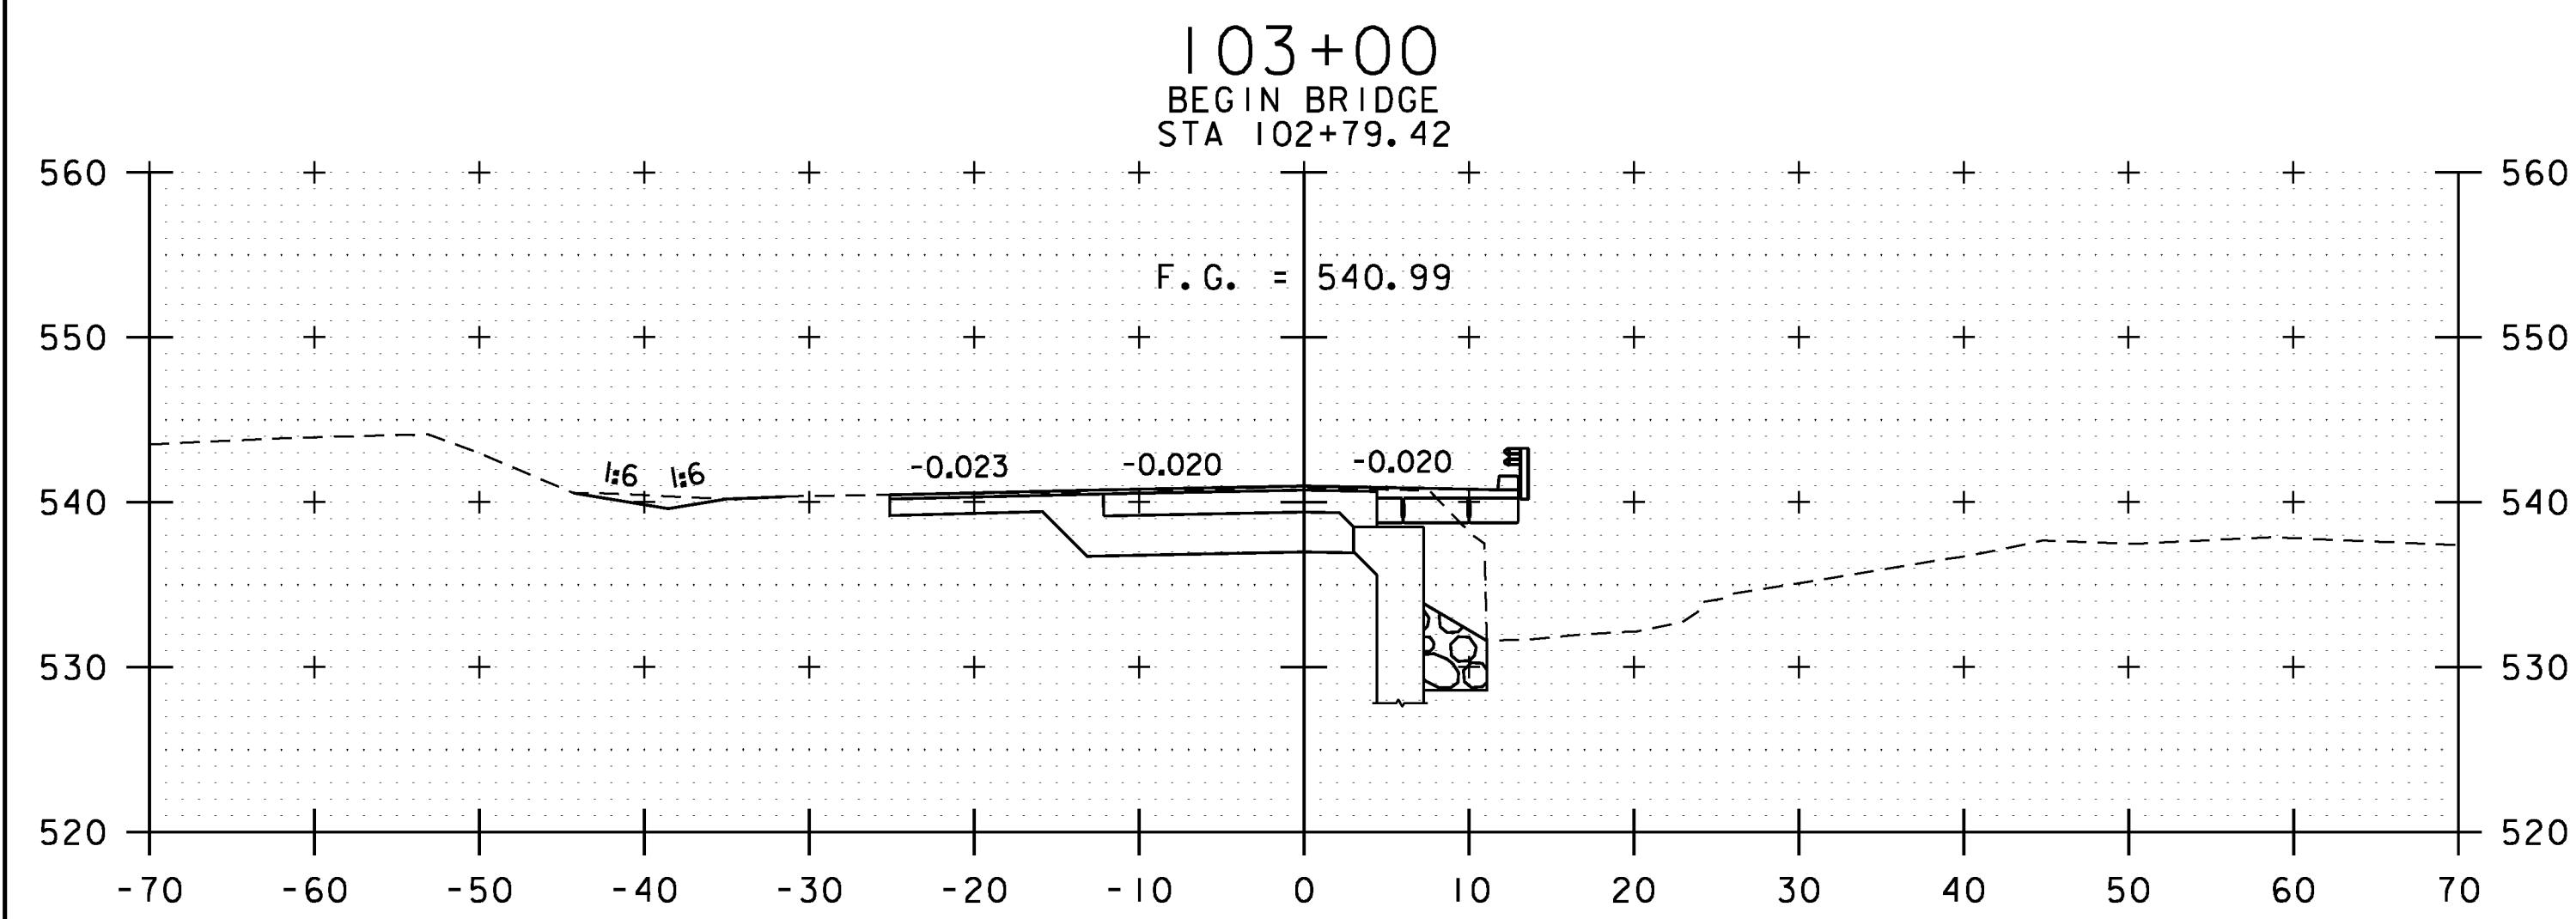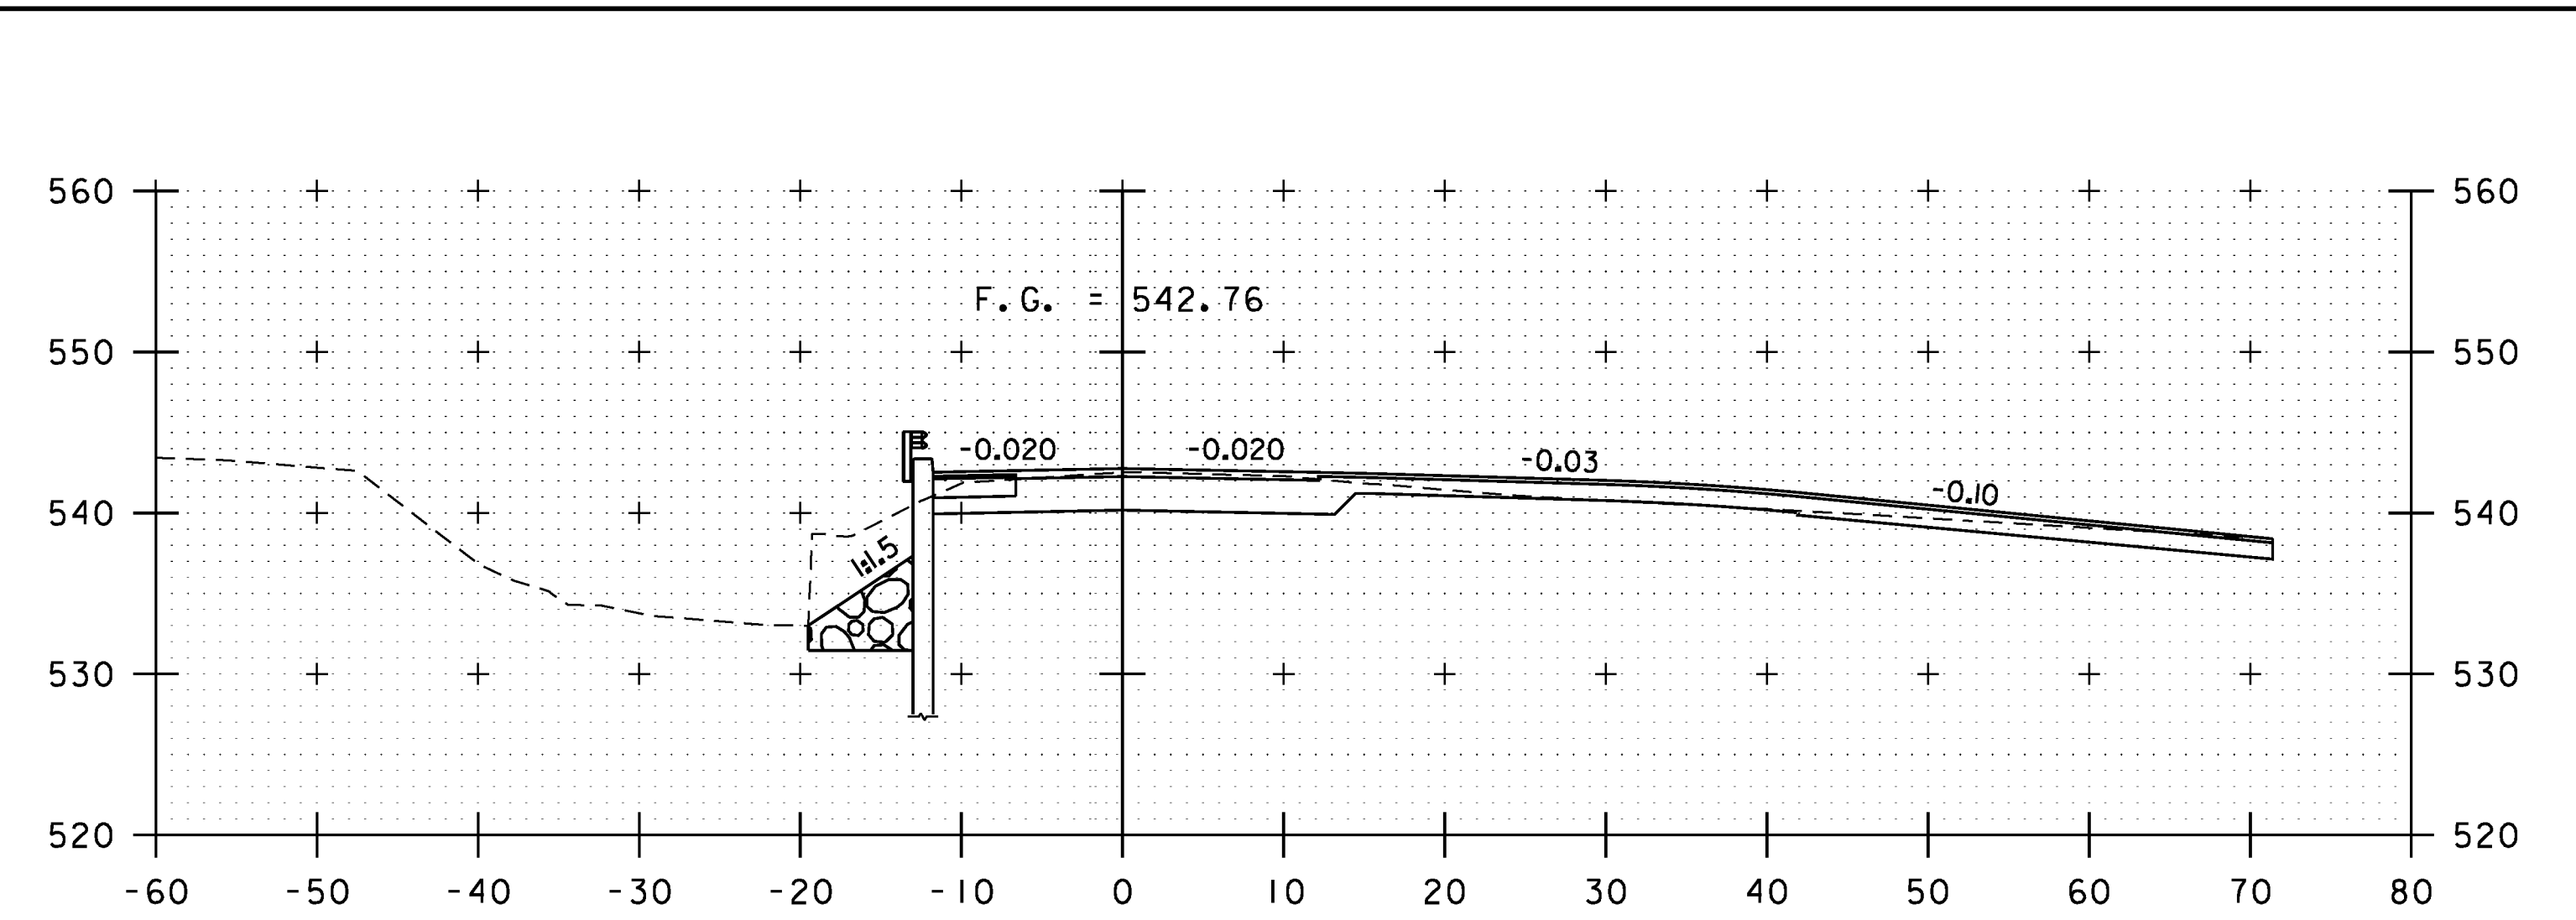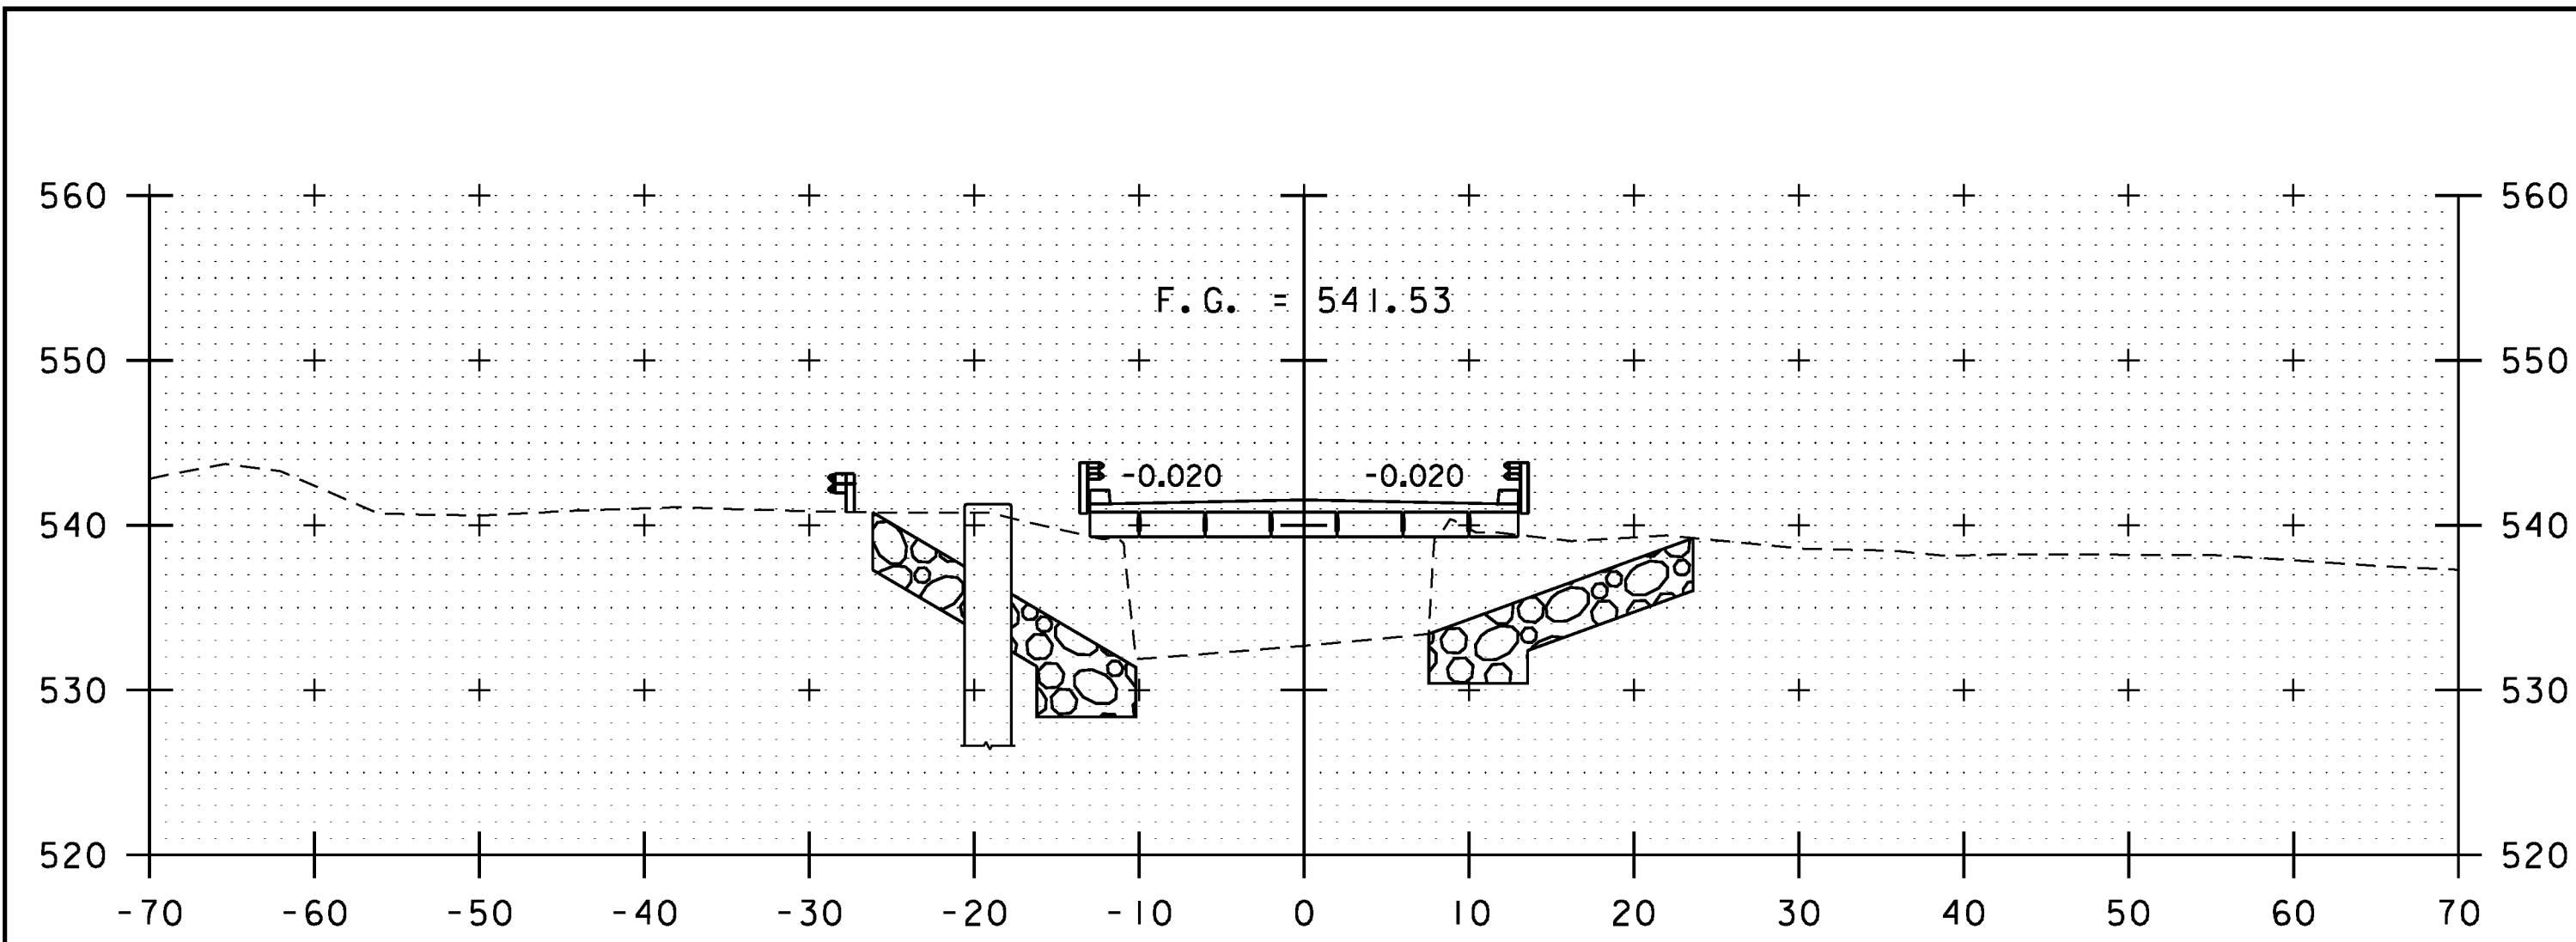

102+50

103+25

**ROADWAY CROSS SECTIONS**

SCALE 1" = 10'-0"


STA. 102+50 TO STA. 103+59

PROJECT NAME: BRATTLEBORO  
PROJECT NUMBER: BRO 1442(35)


FILE NAME: z10j062xsl.dgn  
PROJECT LEADER: S.E. BURBANK  
DESIGNED BY: E.A. FIALA  
ROADWAY CROSS SECTIONS (2 OF 4)

PLOT DATE: 10/14/2013  
DRAWN BY: E.A. FIALA  
CHECKED BY: S.E. BURBANK  
SHEET 54 OF 68




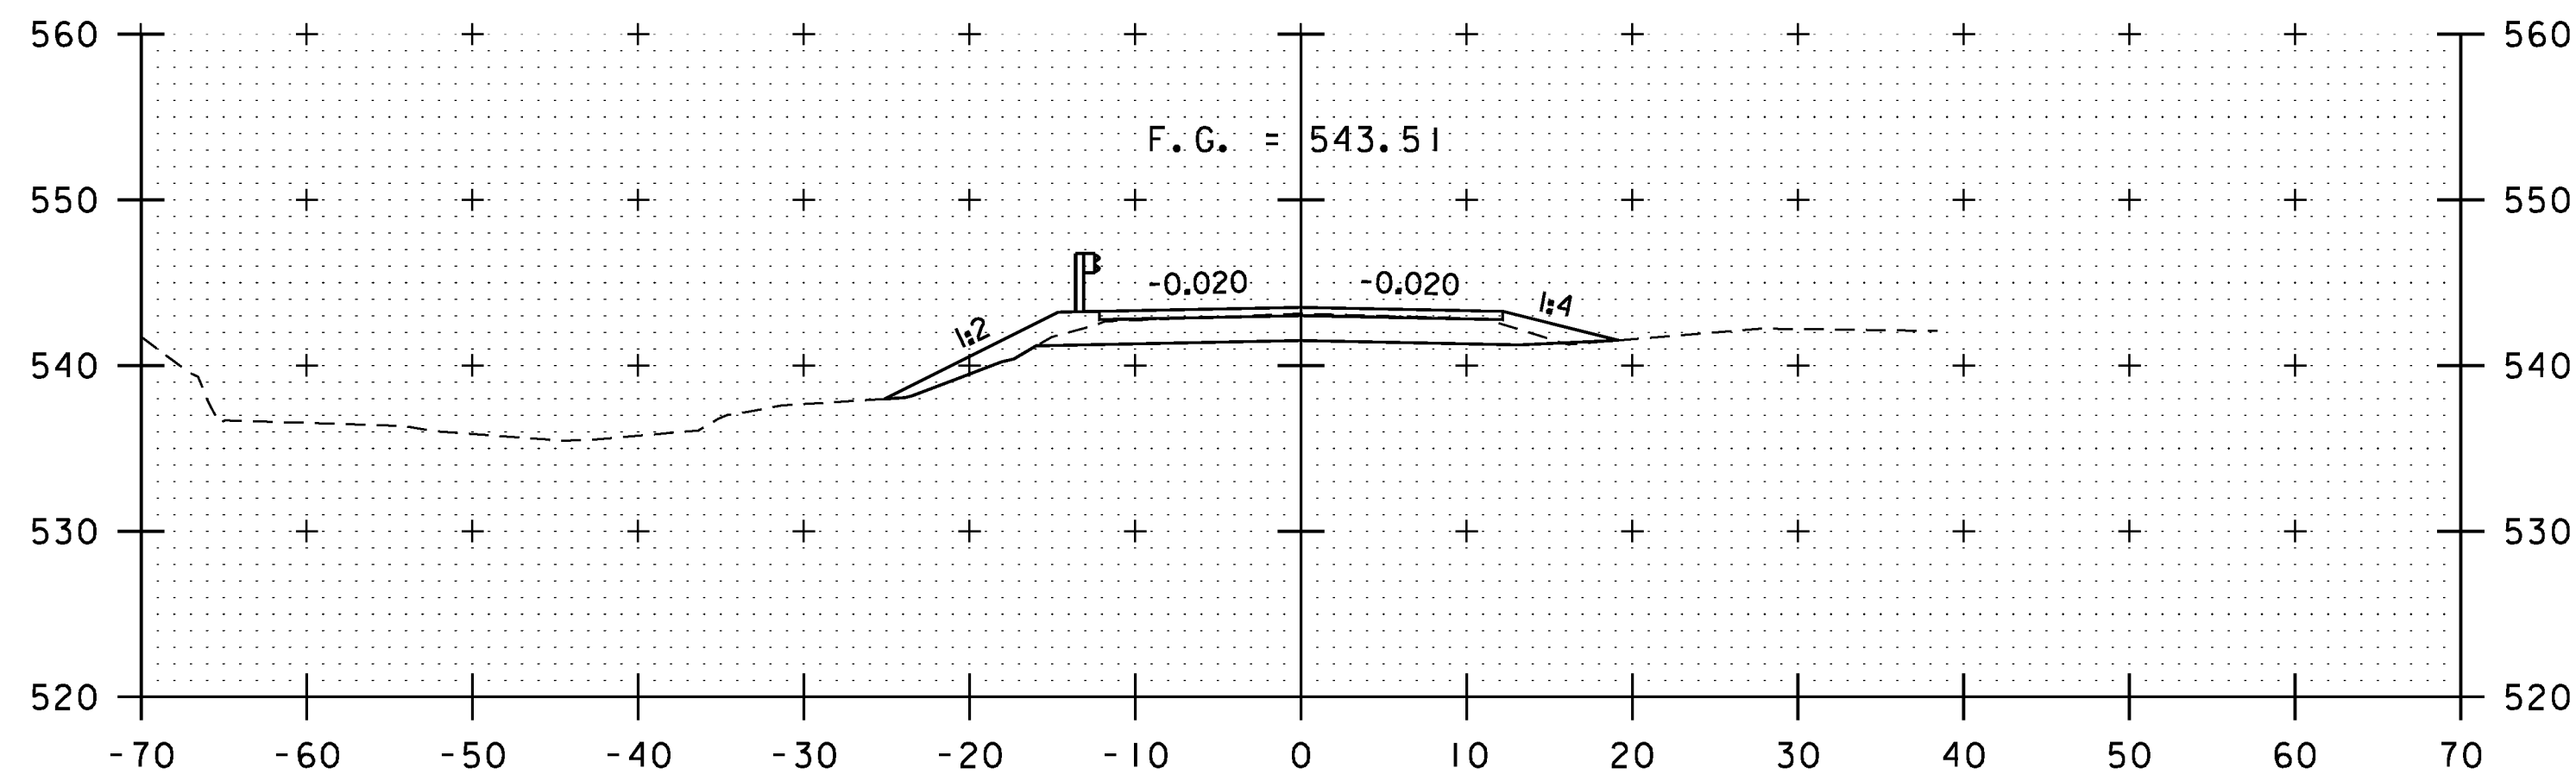


104+25

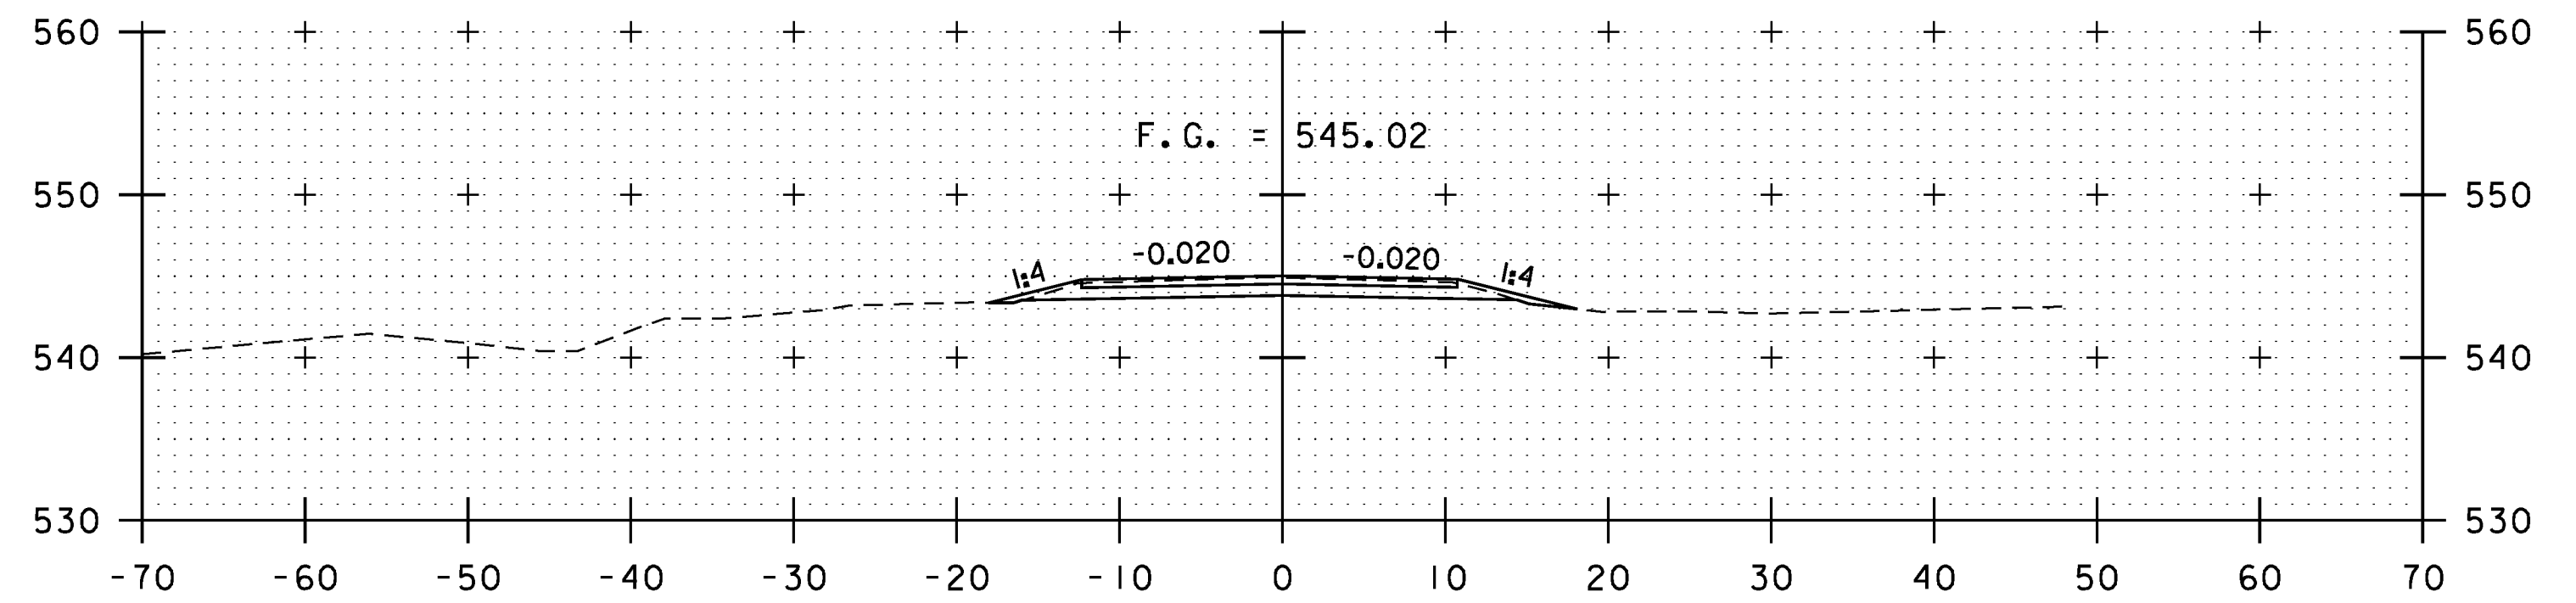


105+00  
END PROJECT

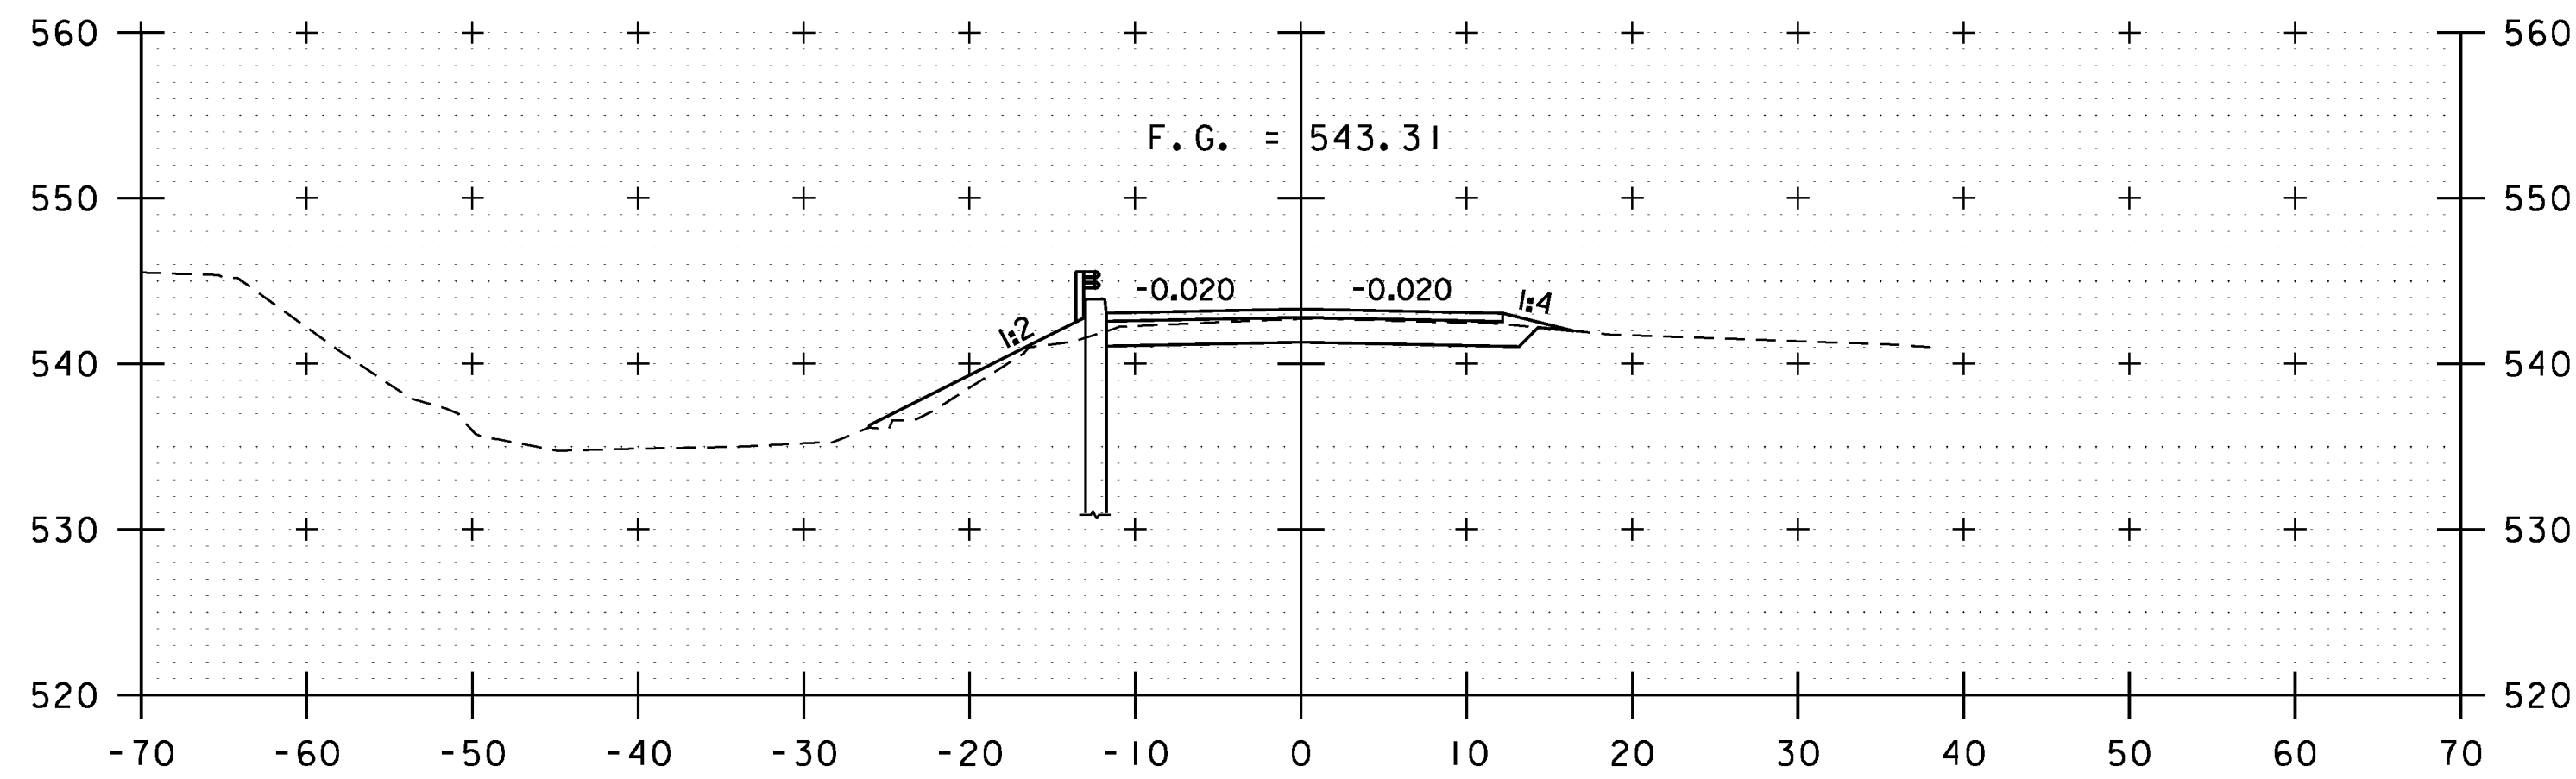


104+00

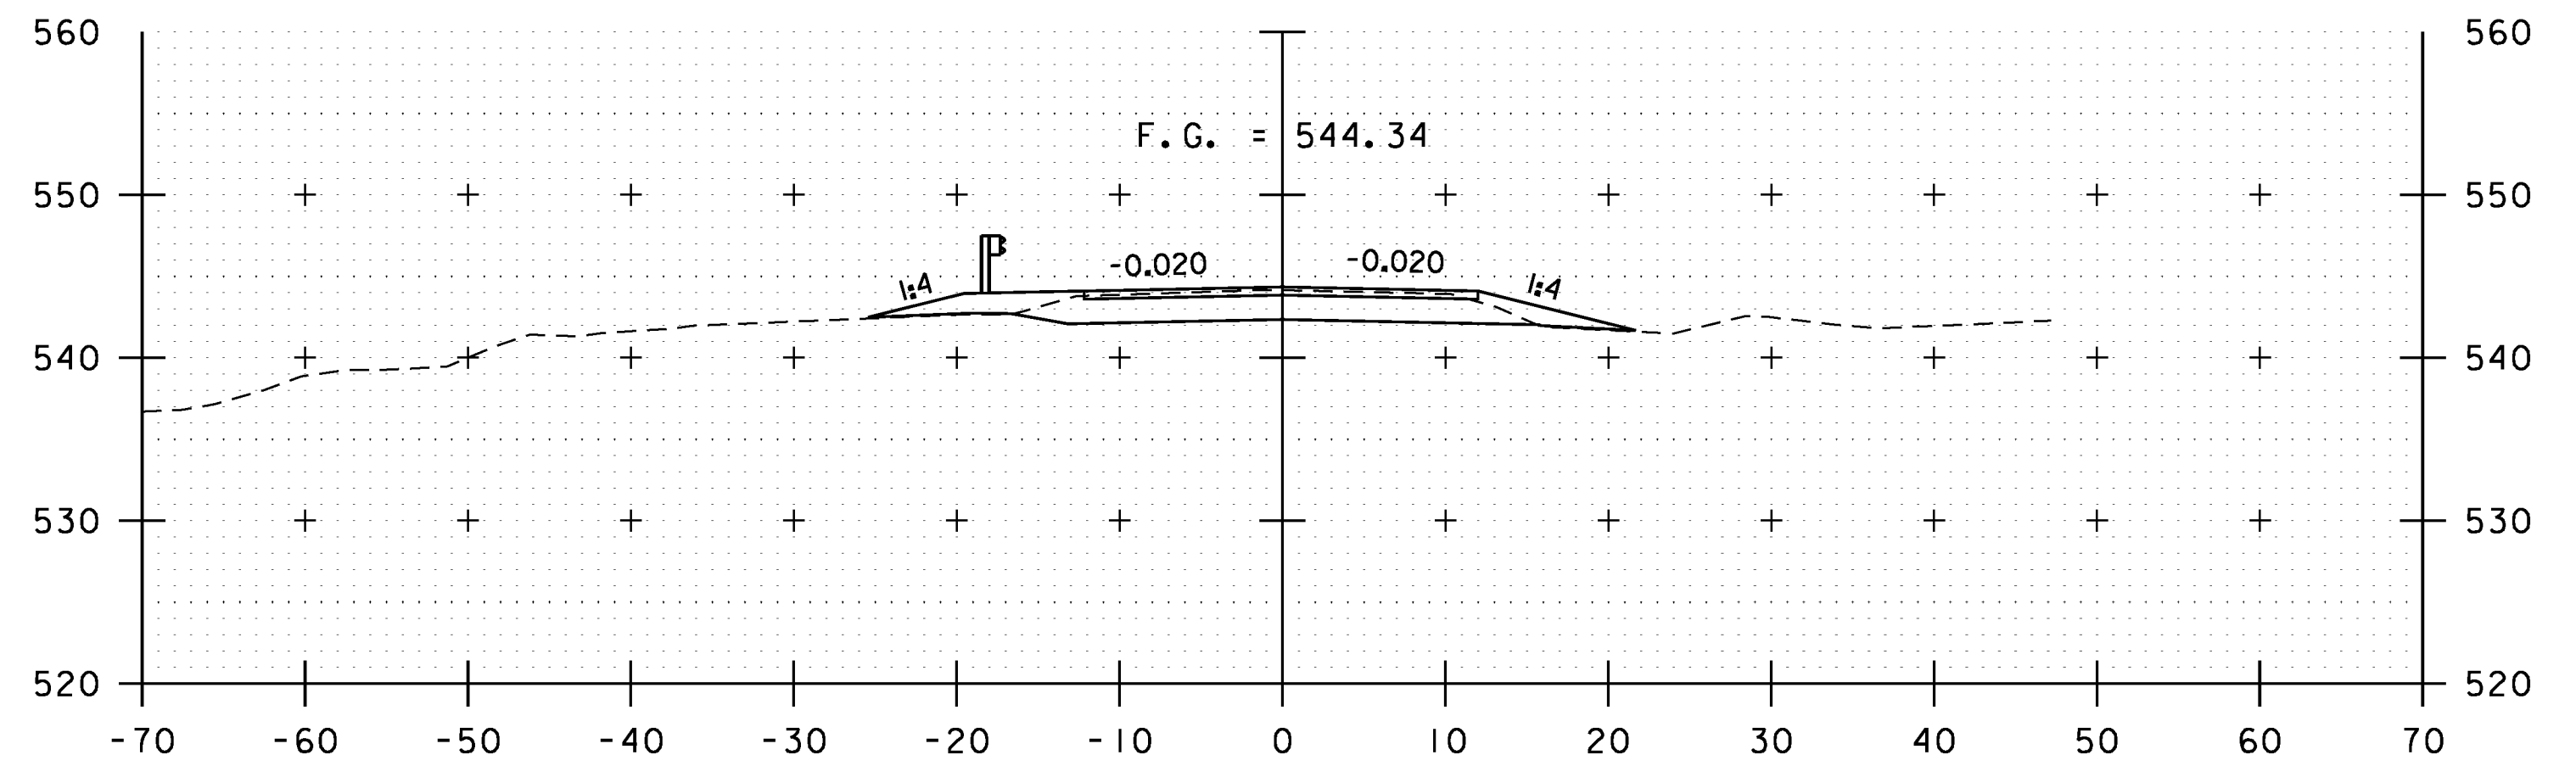

104+75

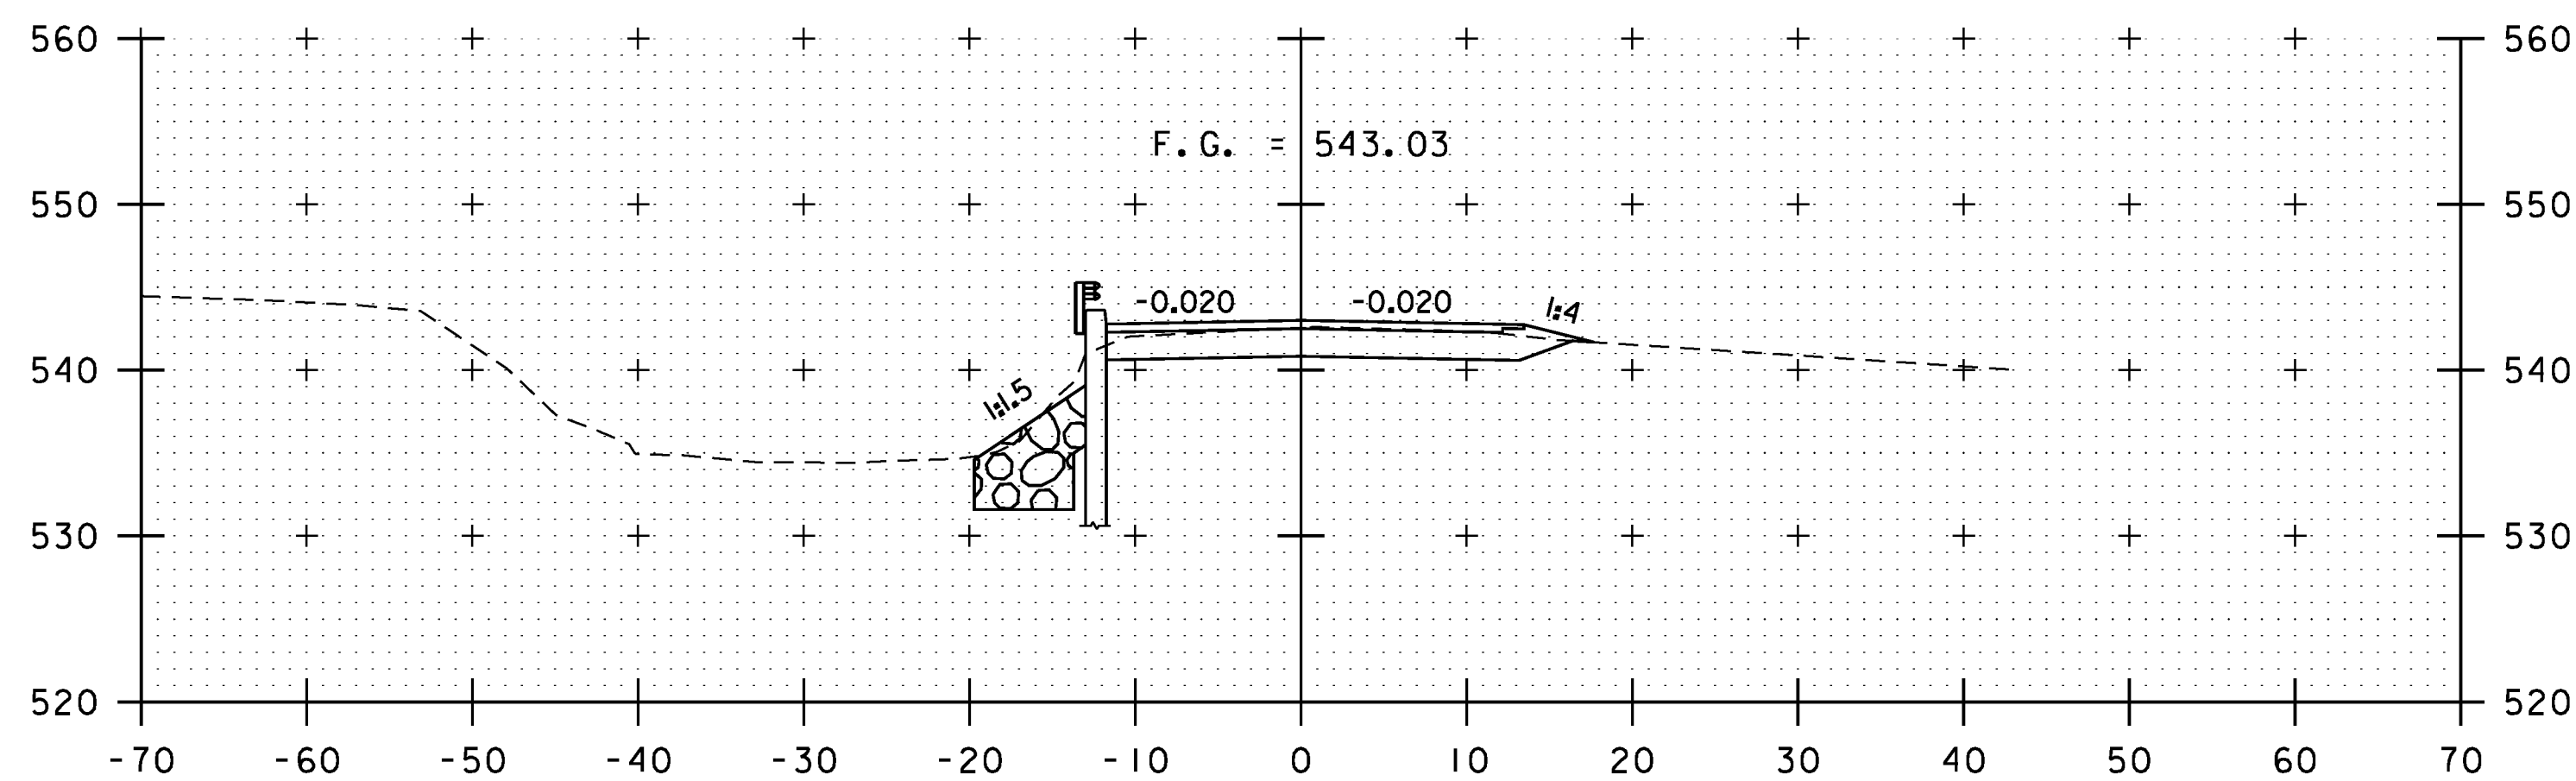

103+75

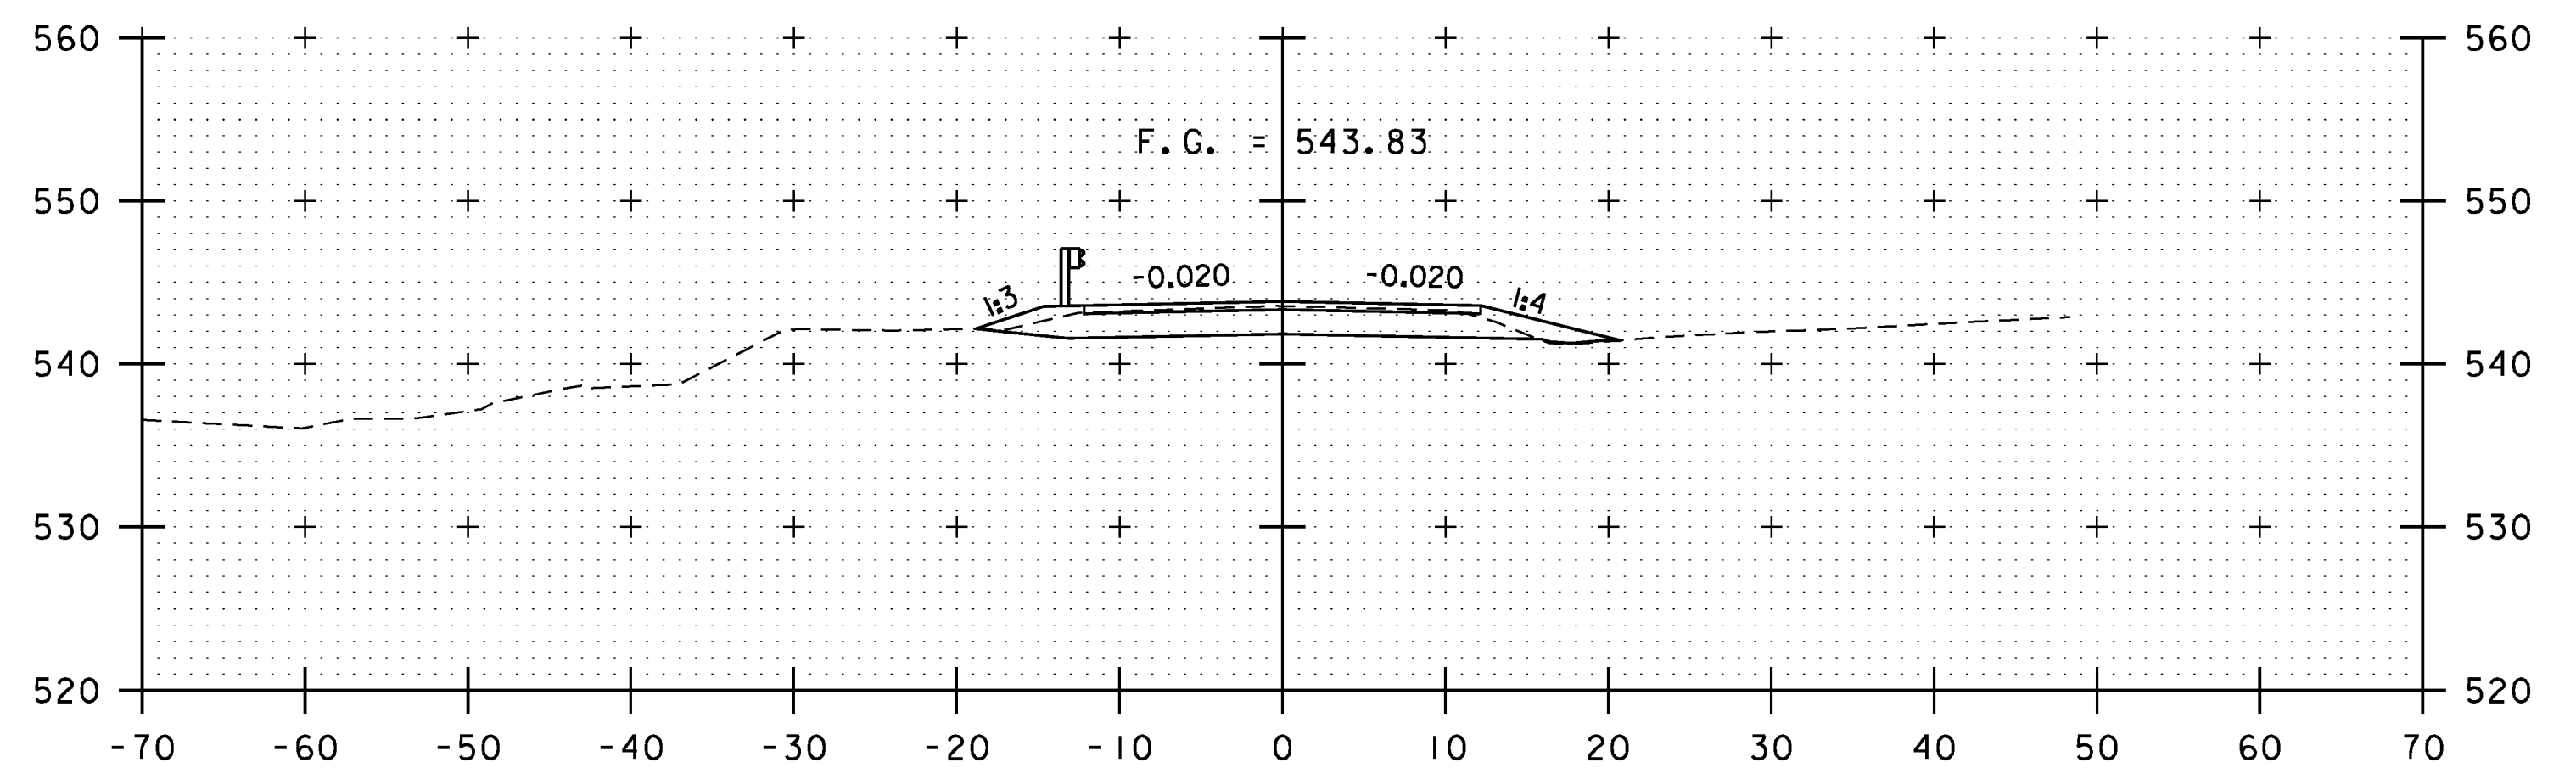

104+50

ROADWAY CROSS SECTIONS

SCALE 1" = 10'-0"


STA. 103+75 TO STA. 105+00

PROJECT NAME: BRATTLEBORO  
PROJECT NUMBER: BRO 1442(35)

FILE NAME: z10j062xsl.dgn  
PROJECT LEADER: S.E. BURBANK  
DESIGNED BY: E.A. FIALA  
ROADWAY CROSS SECTIONS (3 OF 4)


PLOT DATE: 10/14/2013  
DRAWN BY: E.A. FIALA  
CHECKED BY: S.E. BURBANK  
SHEET 55 OF 68



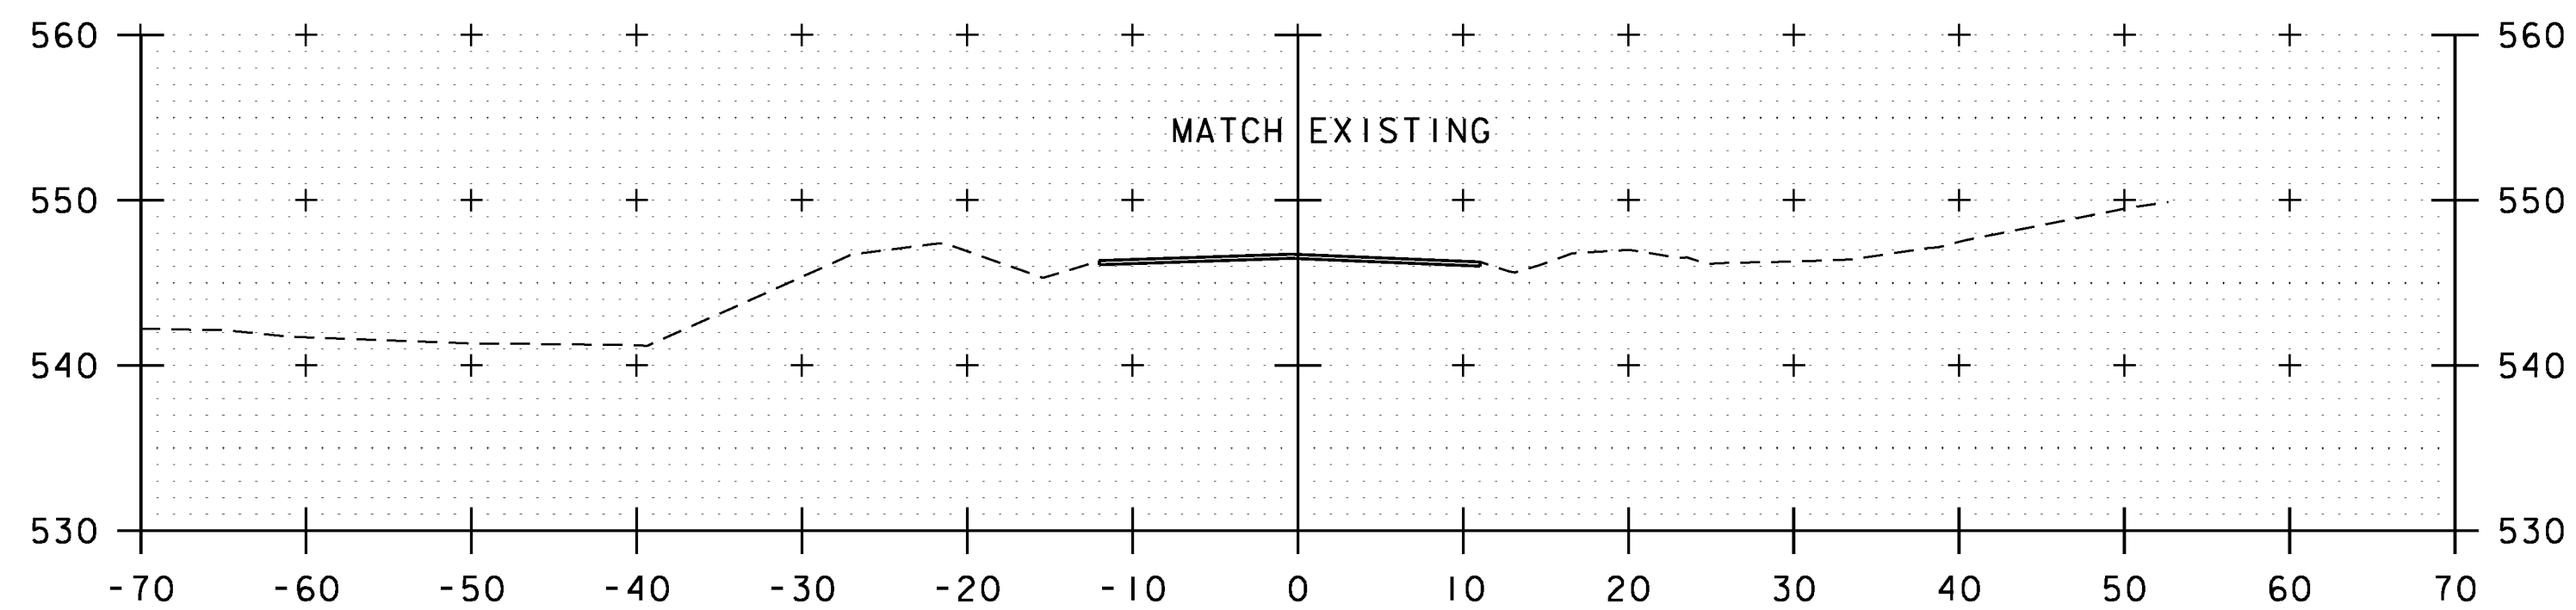

105+45  
END APPROACH

F.G. = 545.89

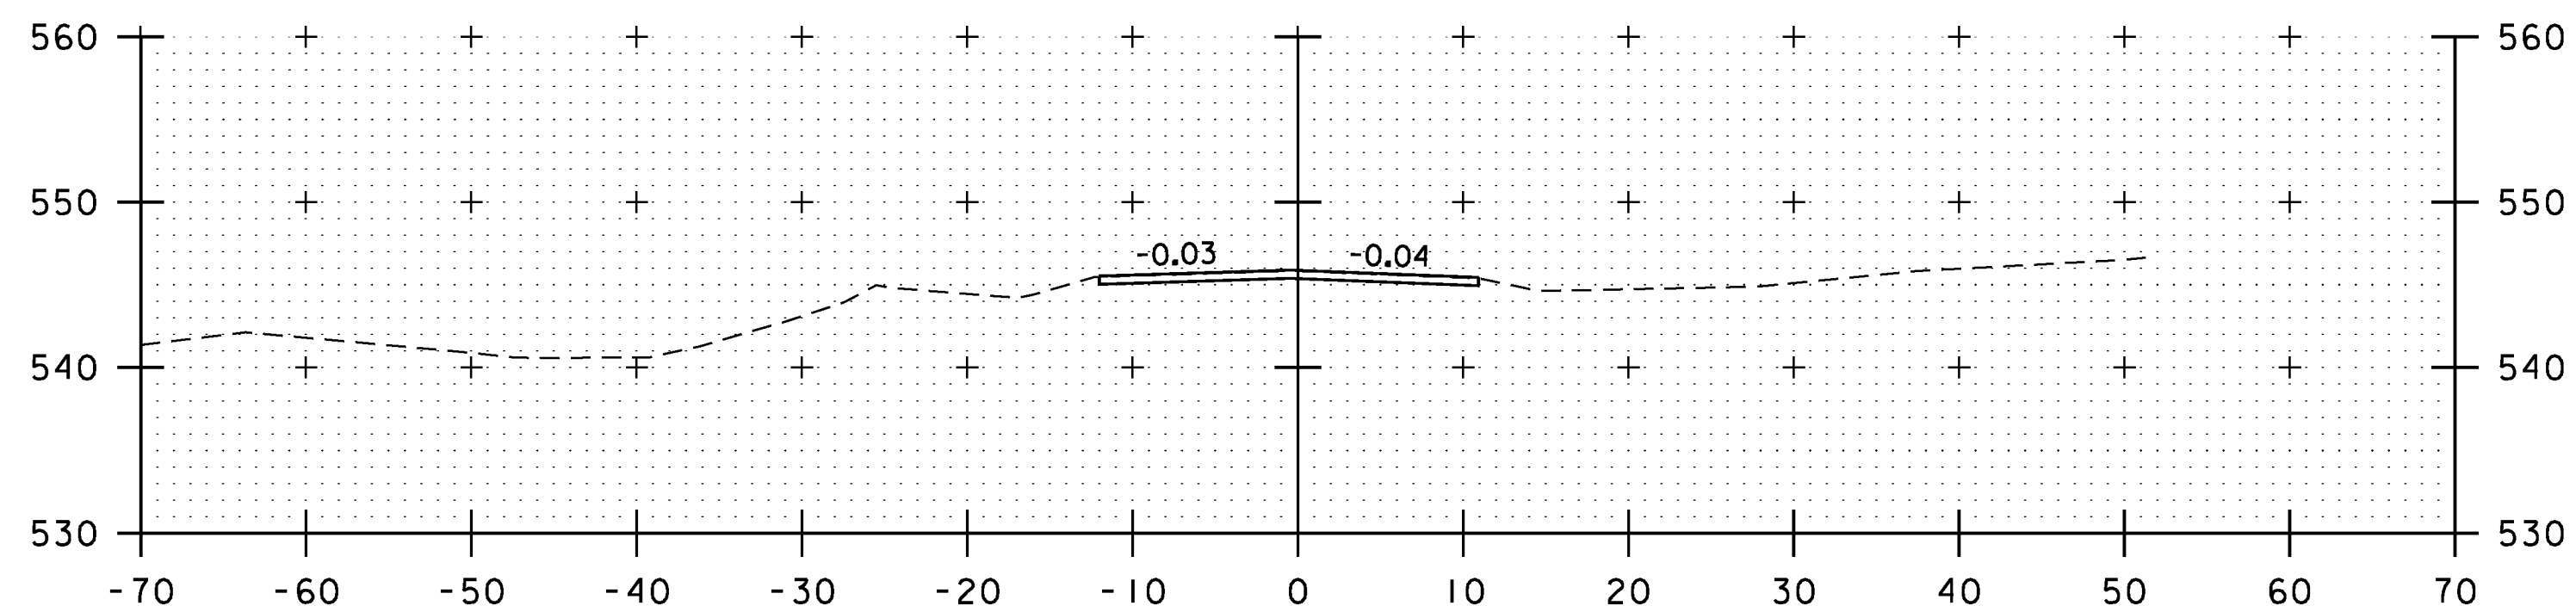

105+25

ROADWAY CROSS SECTIONS

SCALE 1" = 10'-0"

STA. 105+25 TO STA. 105+45

PROJECT NAME: BRATTLEBORO  
PROJECT NUMBER: BRO 1442(35)


FILE NAME: z10J062xsl.dgn  
PROJECT LEADER: S.E. BURBANK  
DESIGNED BY: E.A. FIALA  
ROADWAY CROSS SECTIONS (4 OF 4)

PLOT DATE: 10/14/2013  
DRAWN BY: E.A. FIALA  
CHECKED BY: S.E. BURBANK  
SHEET 56 OF 68




SEE REVISED UNCLASSIFIED CHANNEL EXCAVATION SECTIONS

STA. 11+28, LT  
END GRUBBING MATERIAL

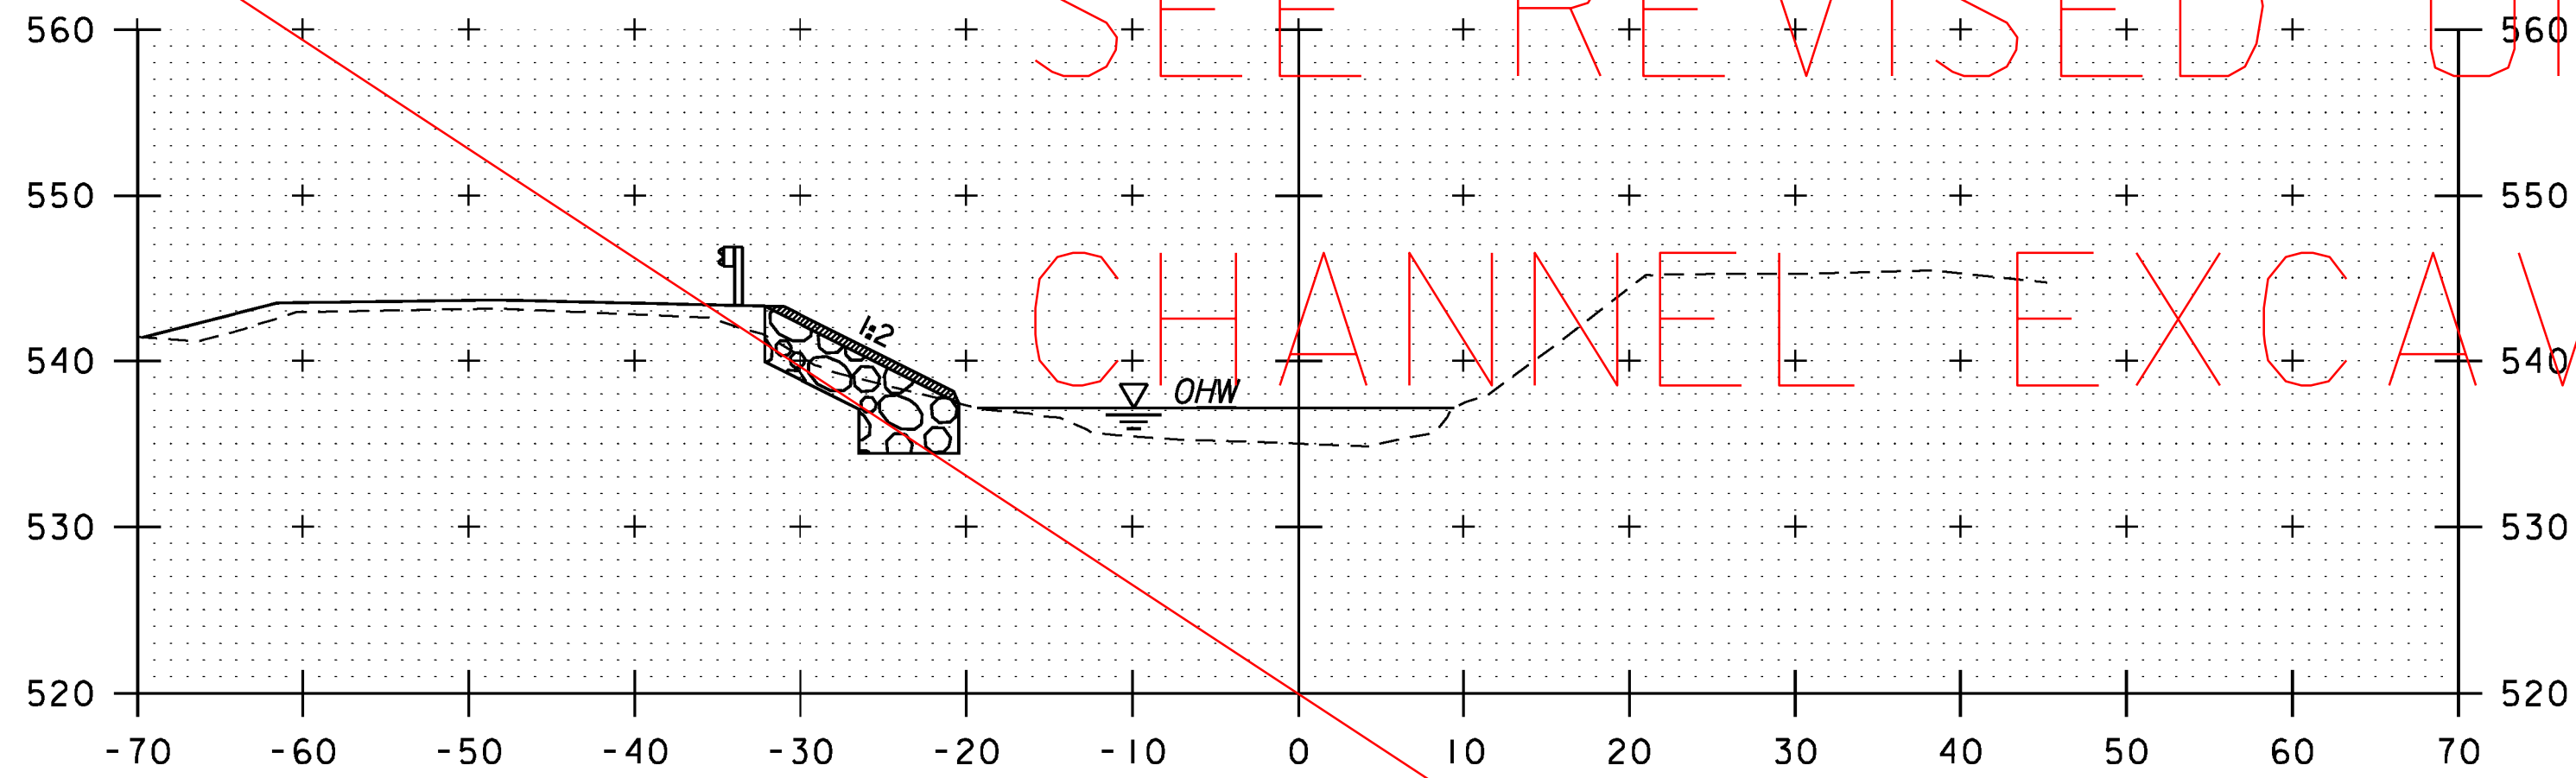


STA. 10+35, LT  
BEGIN UNCLASSIFIED CHANNEL EXCAVATION  
GEOTEXTILE UNDER STONE FILL  
STONE FILL, TYPE III  
GRUBBING MATERIAL

10+50

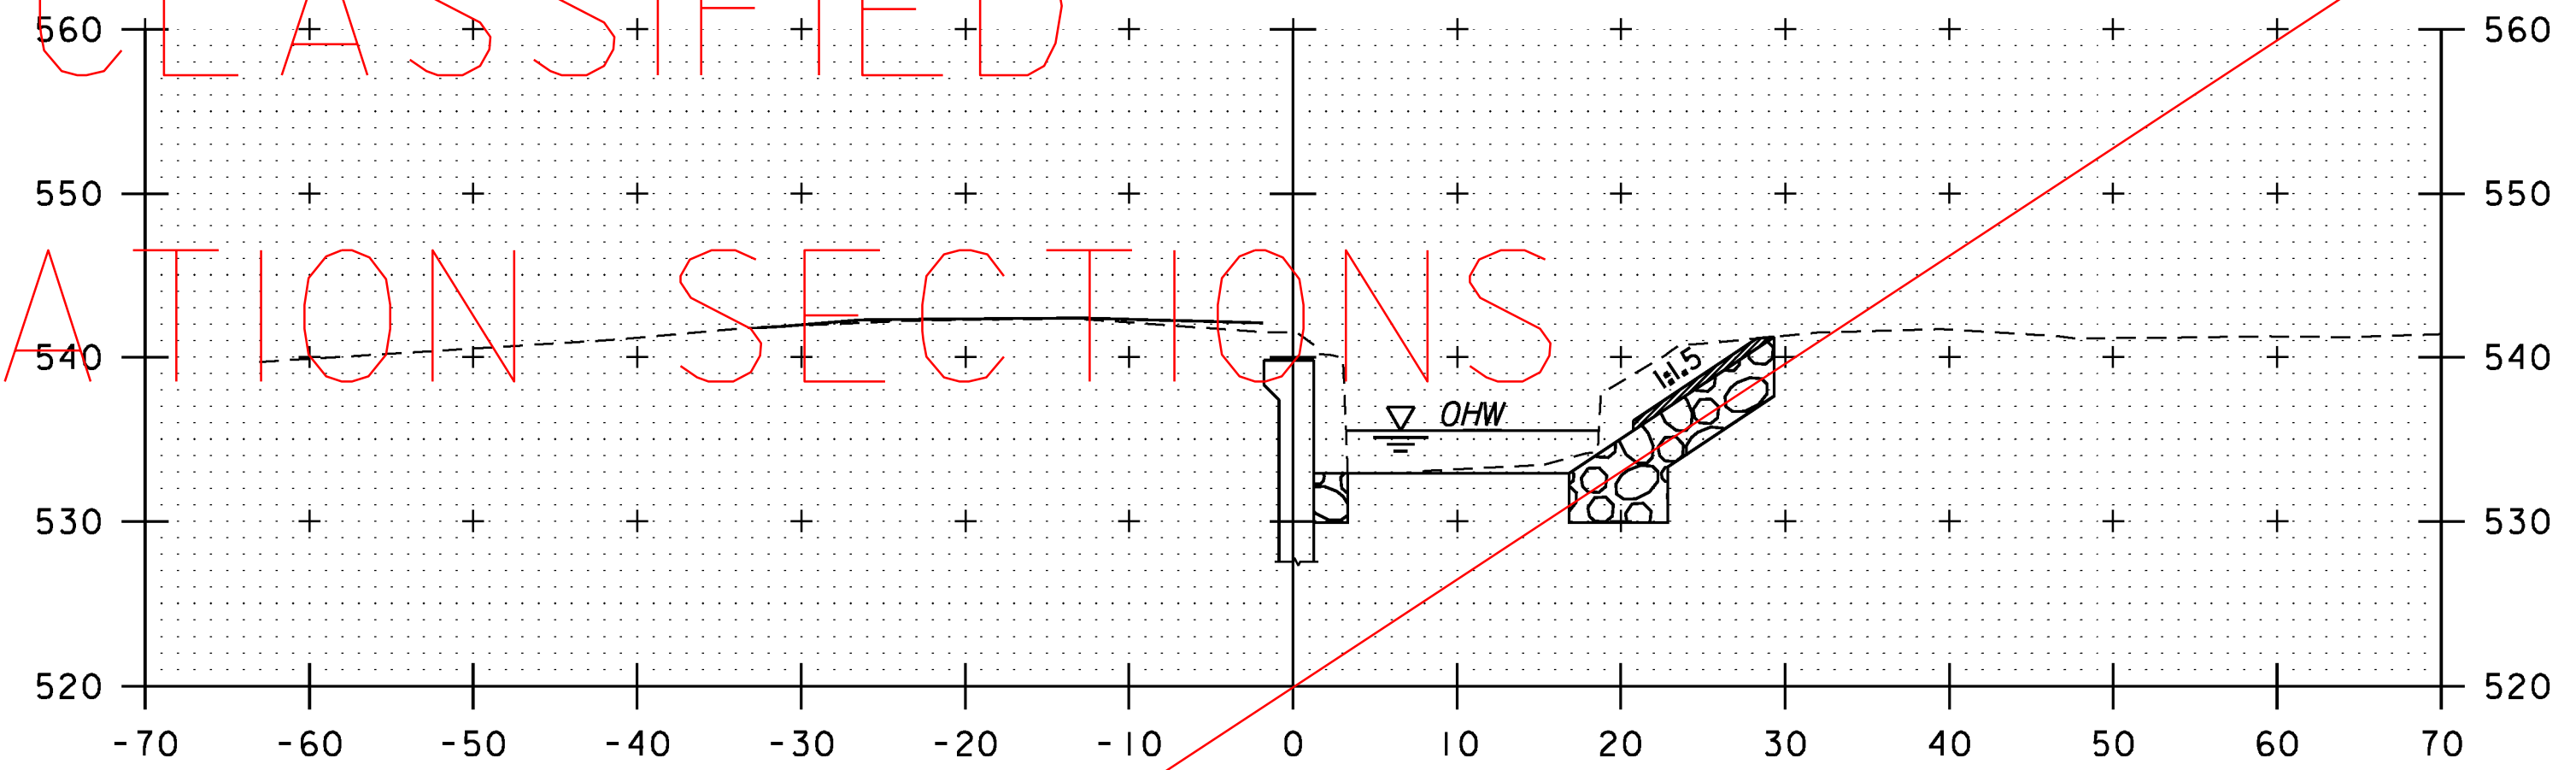


STA. 11+16, RT  
BEGIN UNCLASSIFIED CHANNEL EXCAVATION  
GEOTEXTILE UNDER STONE FILL  
STONE FILL, TYPE III  
GRUBBING MATERIAL


11+25

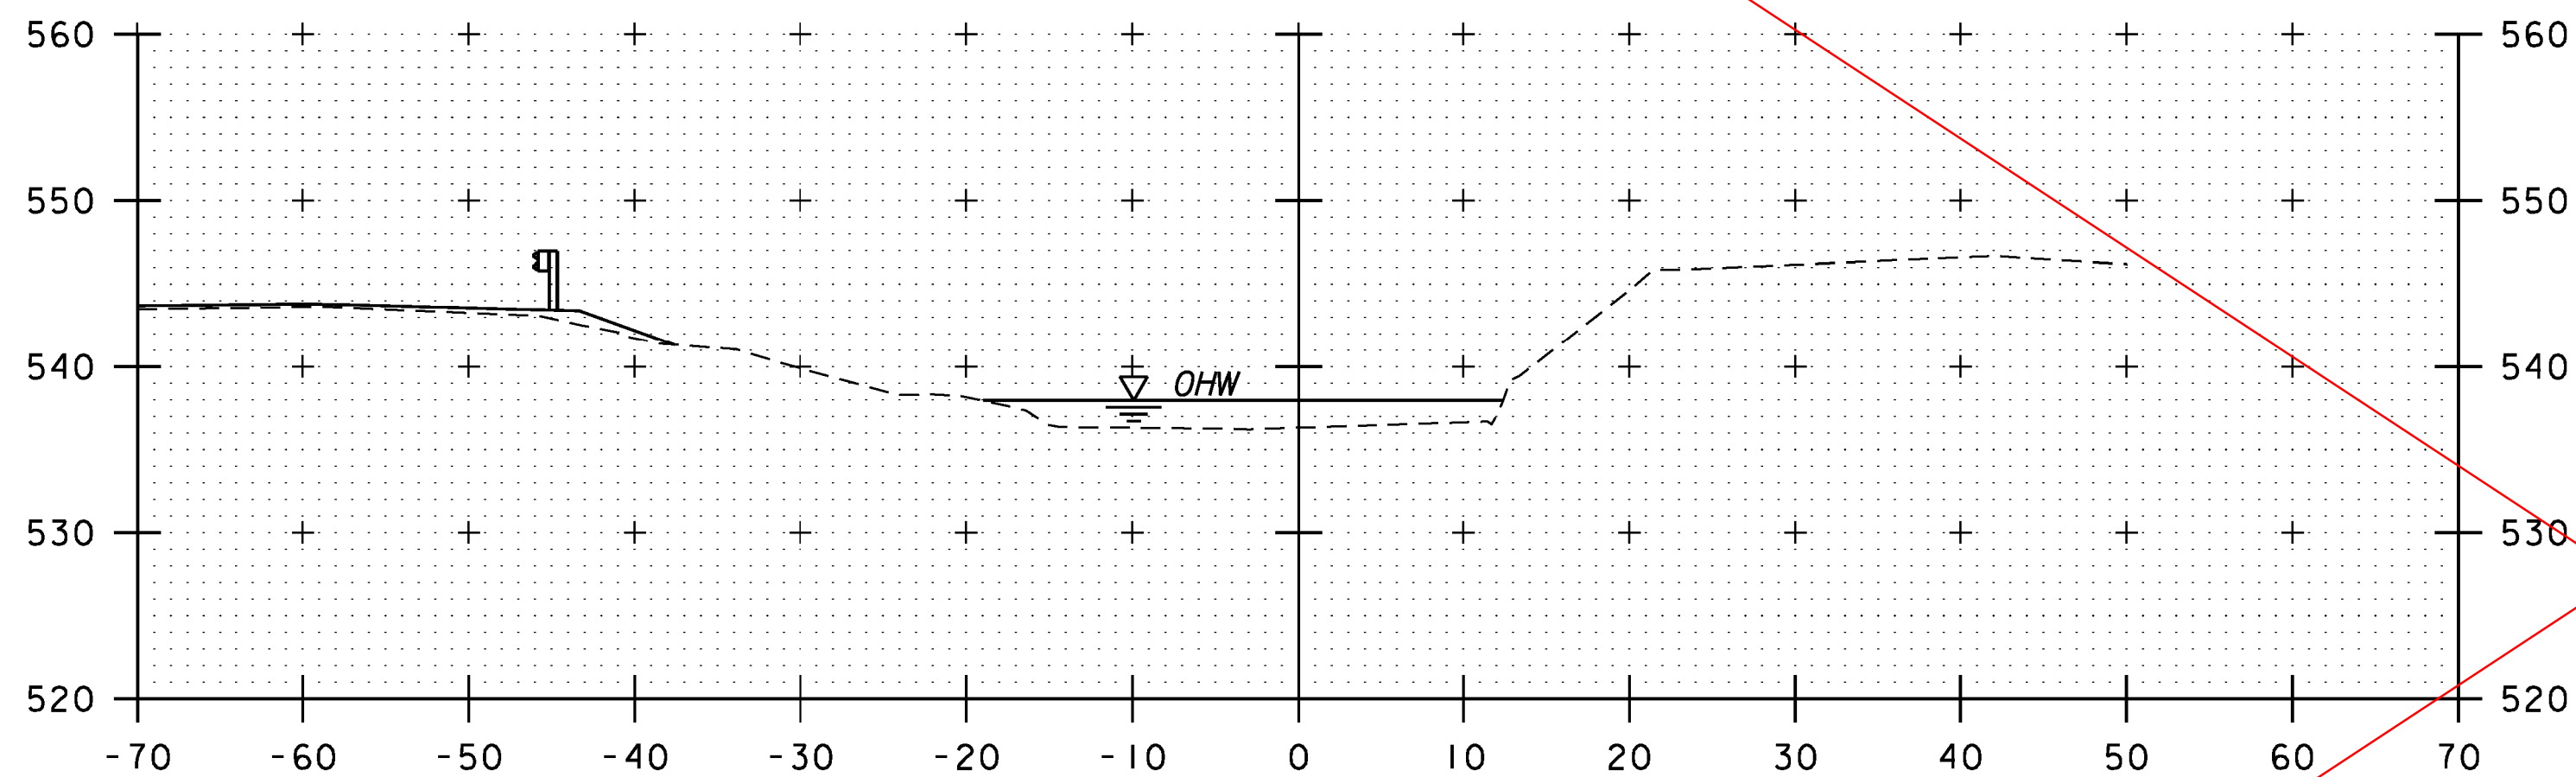


10+25

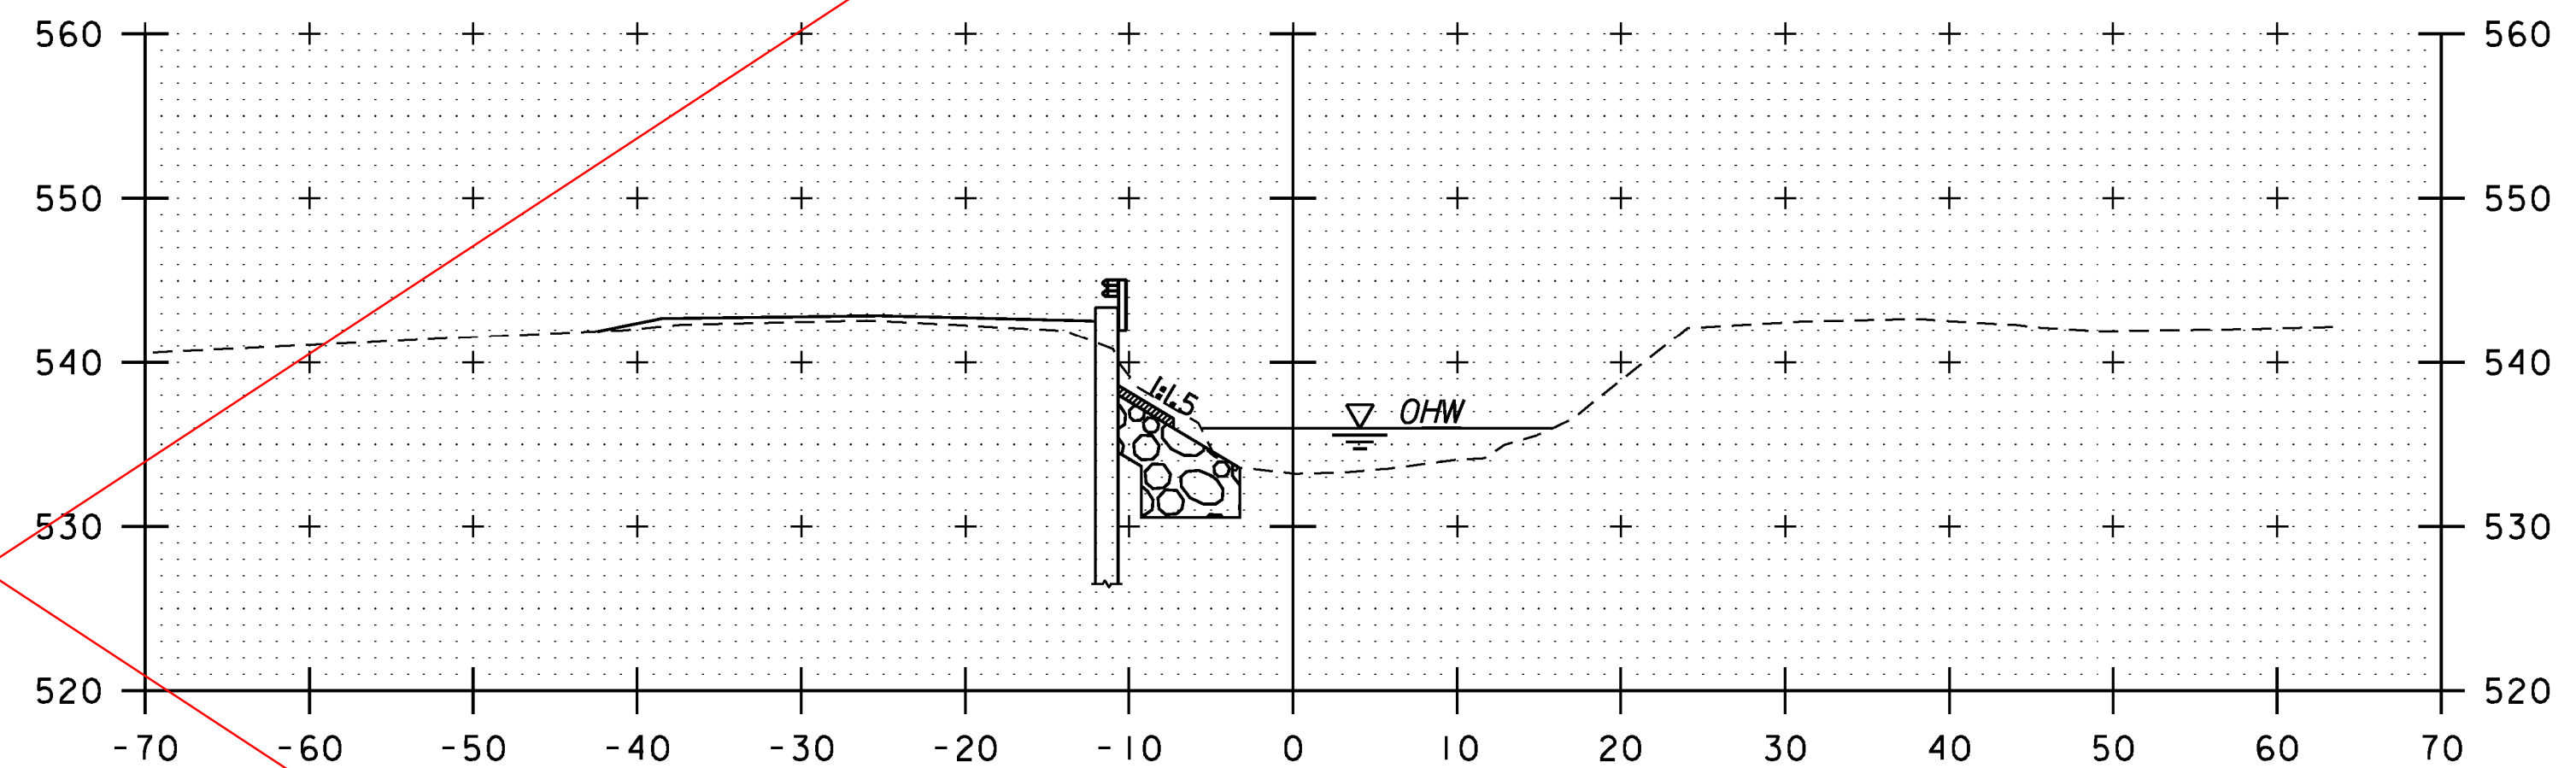

11+00

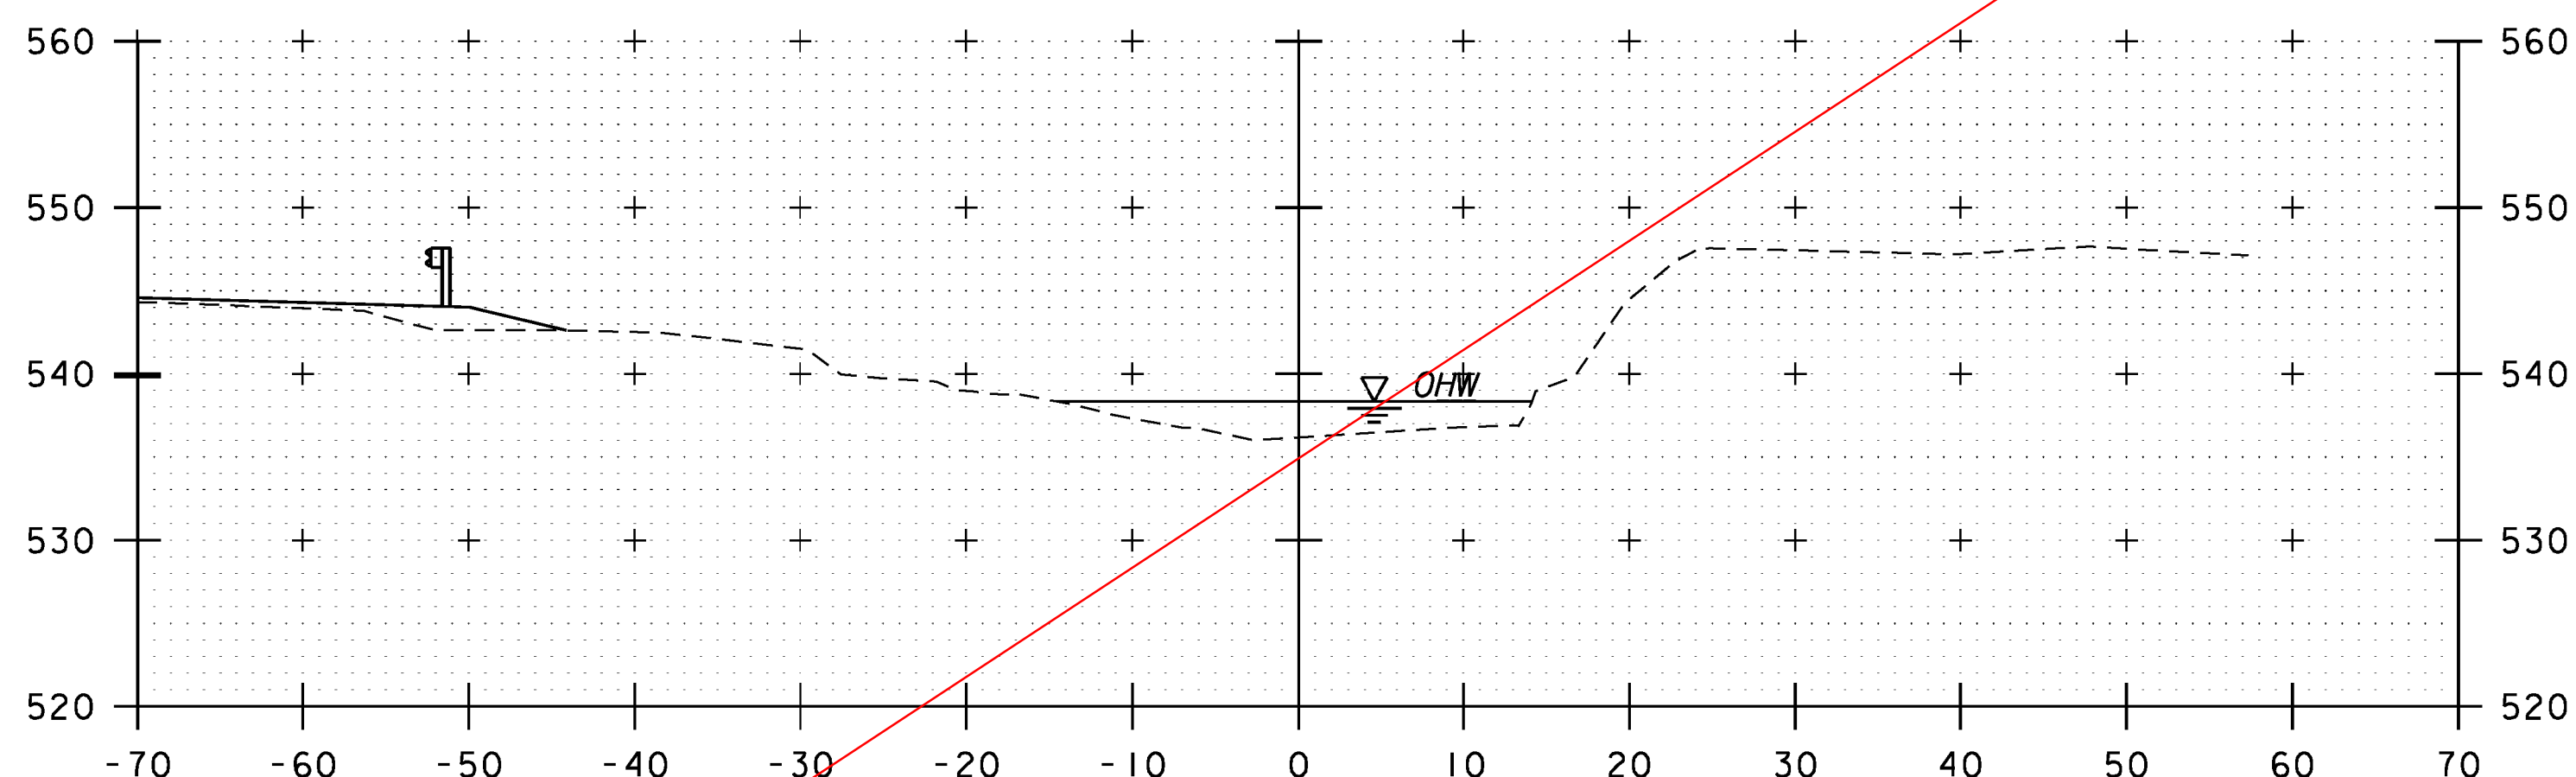

10+00

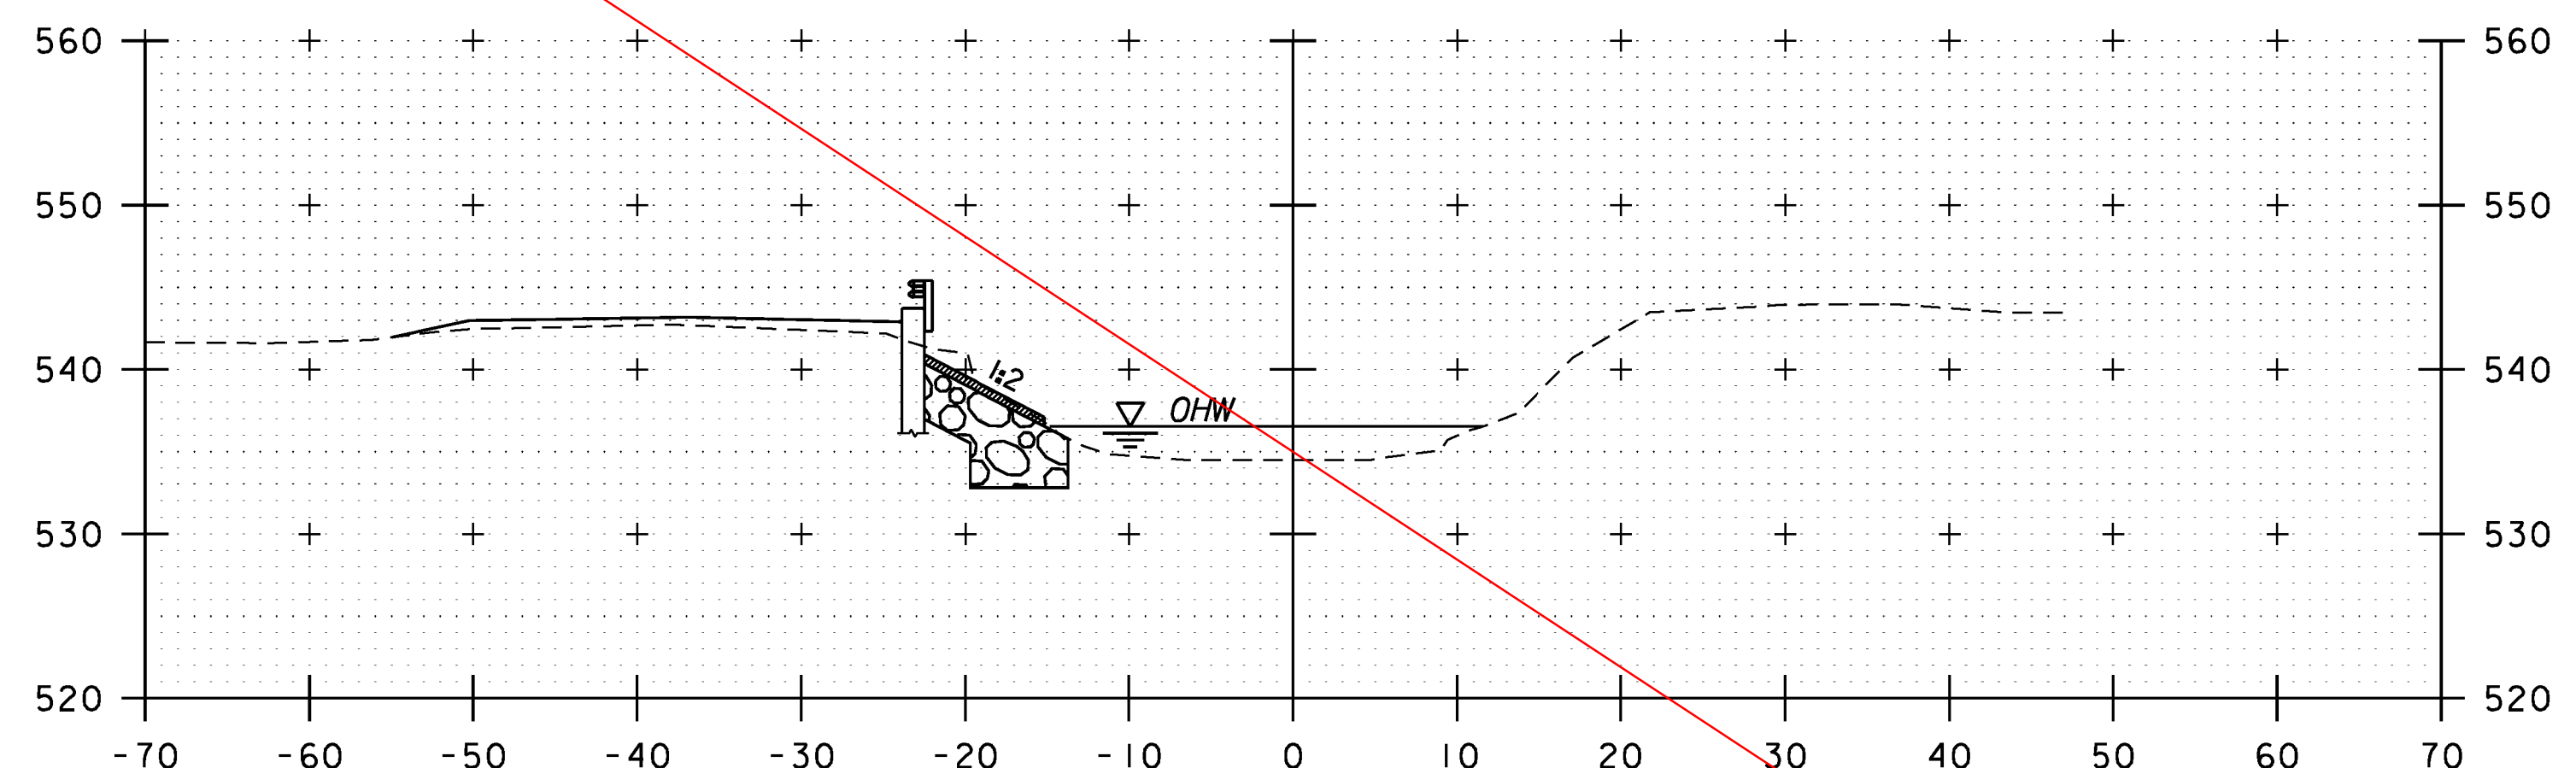







10+75

CHANNEL CROSS SECTIONS  
SCALE 1" = 10'-0"  
STA. 10+00 TO STA. 11+25



PROJECT NAME:	BRATTLEBORO	PLOT DATE:	10/14/2013
PROJECT NUMBER:	BRO 1442(35)	DRAWN BY:	E.A. FIALA
FILE NAME:	z10j062xsl.dgn	CHECKED BY:	S.E. BURBANK
PROJECT LEADER:	S.E. BURBANK	CHANNEL CROSS SECTIONS (1 OF 3)	SHEET 57 OF 68
DESIGNED BY:	E.A. FIALA		

# SEE REVISED UNCLASSIFIED CHANNEL EXCAVATION SECTIONS

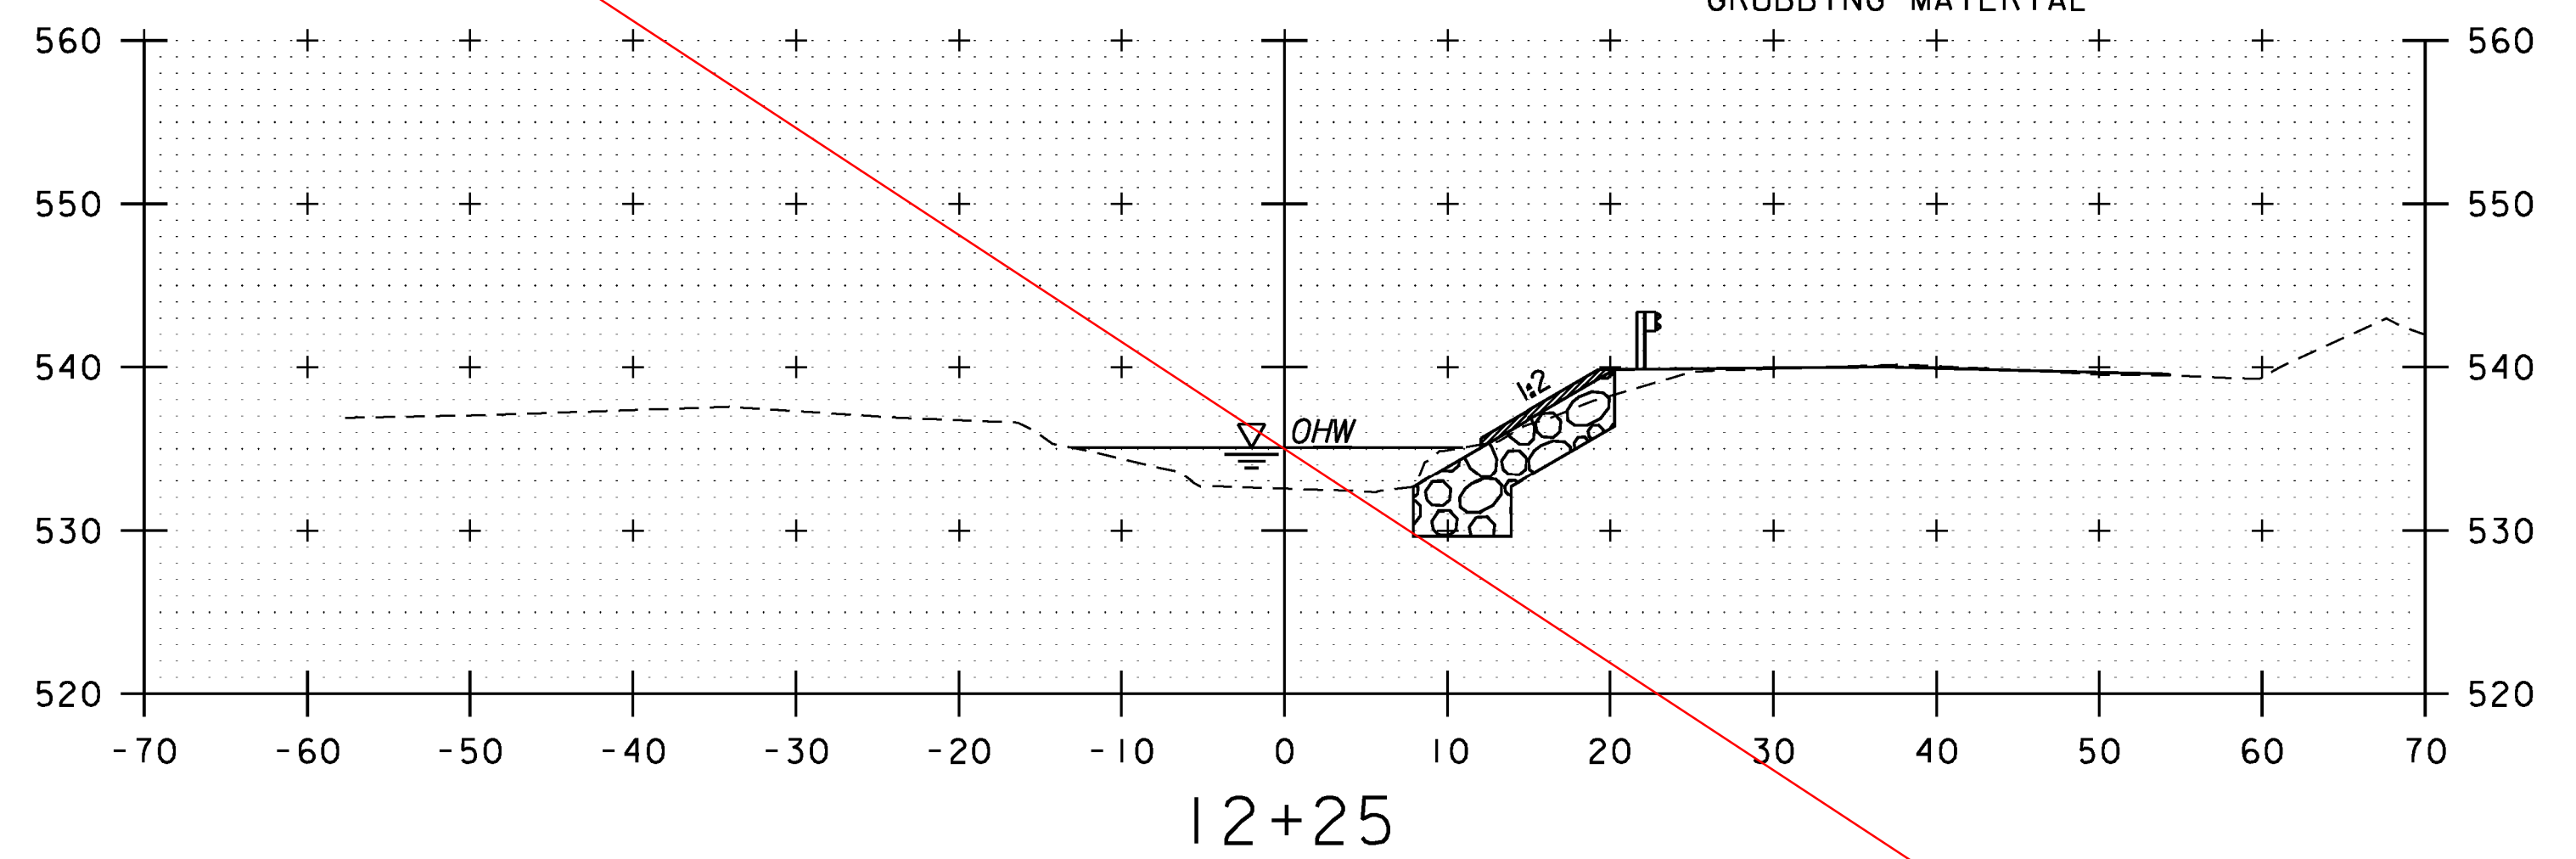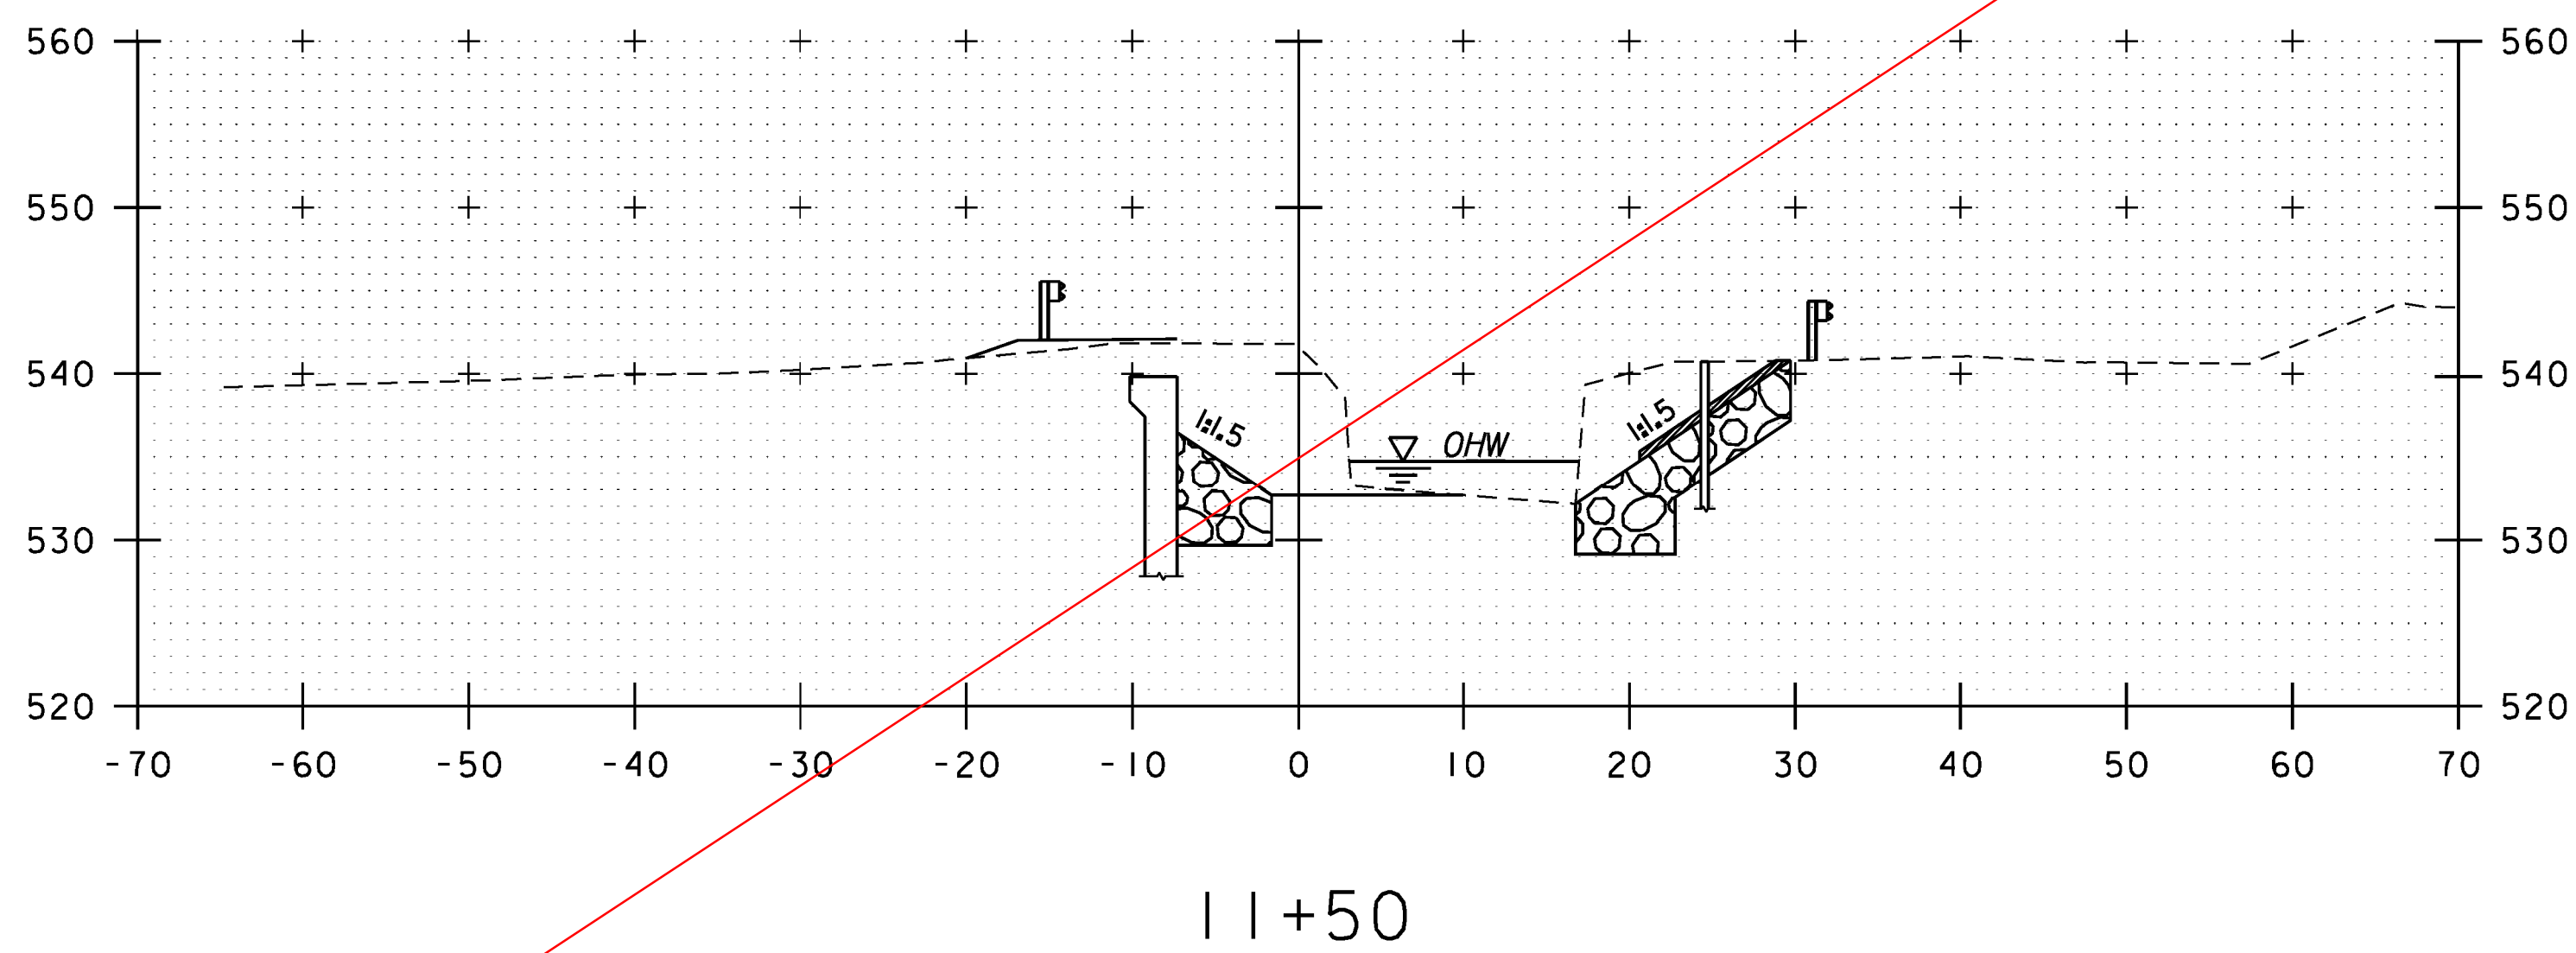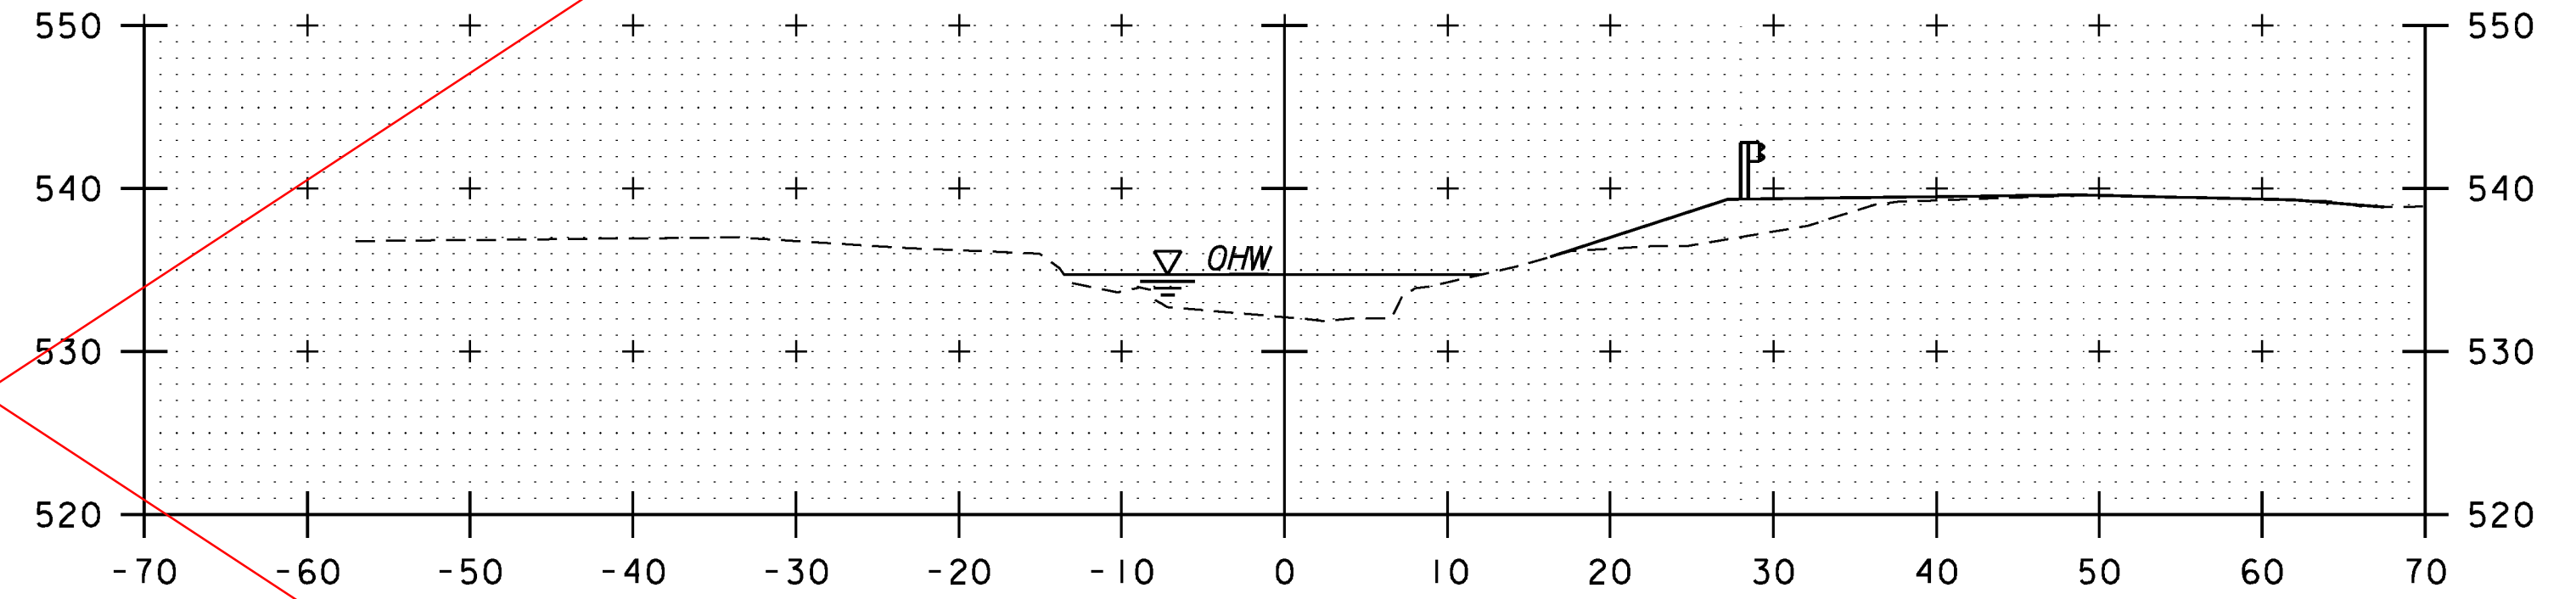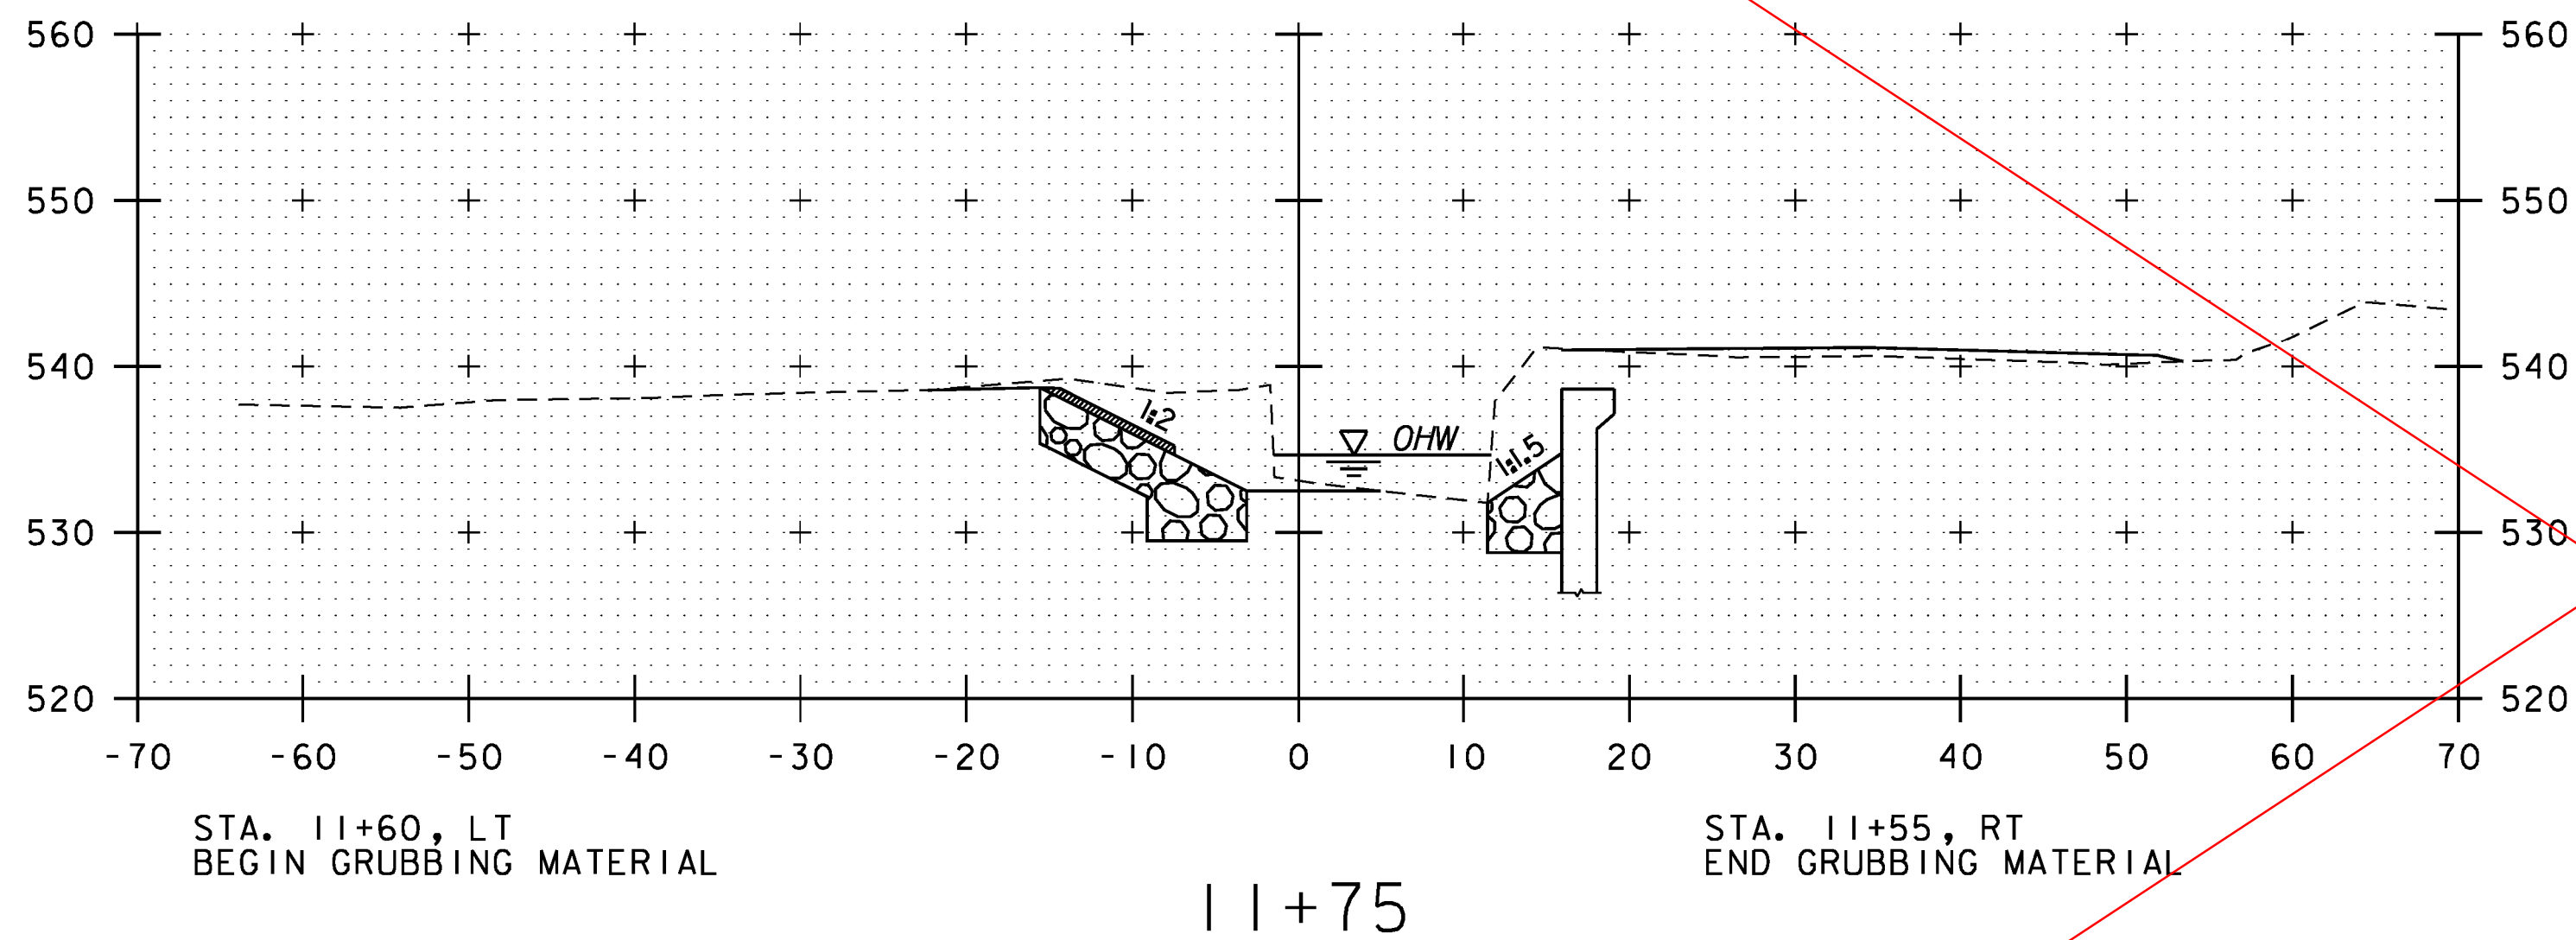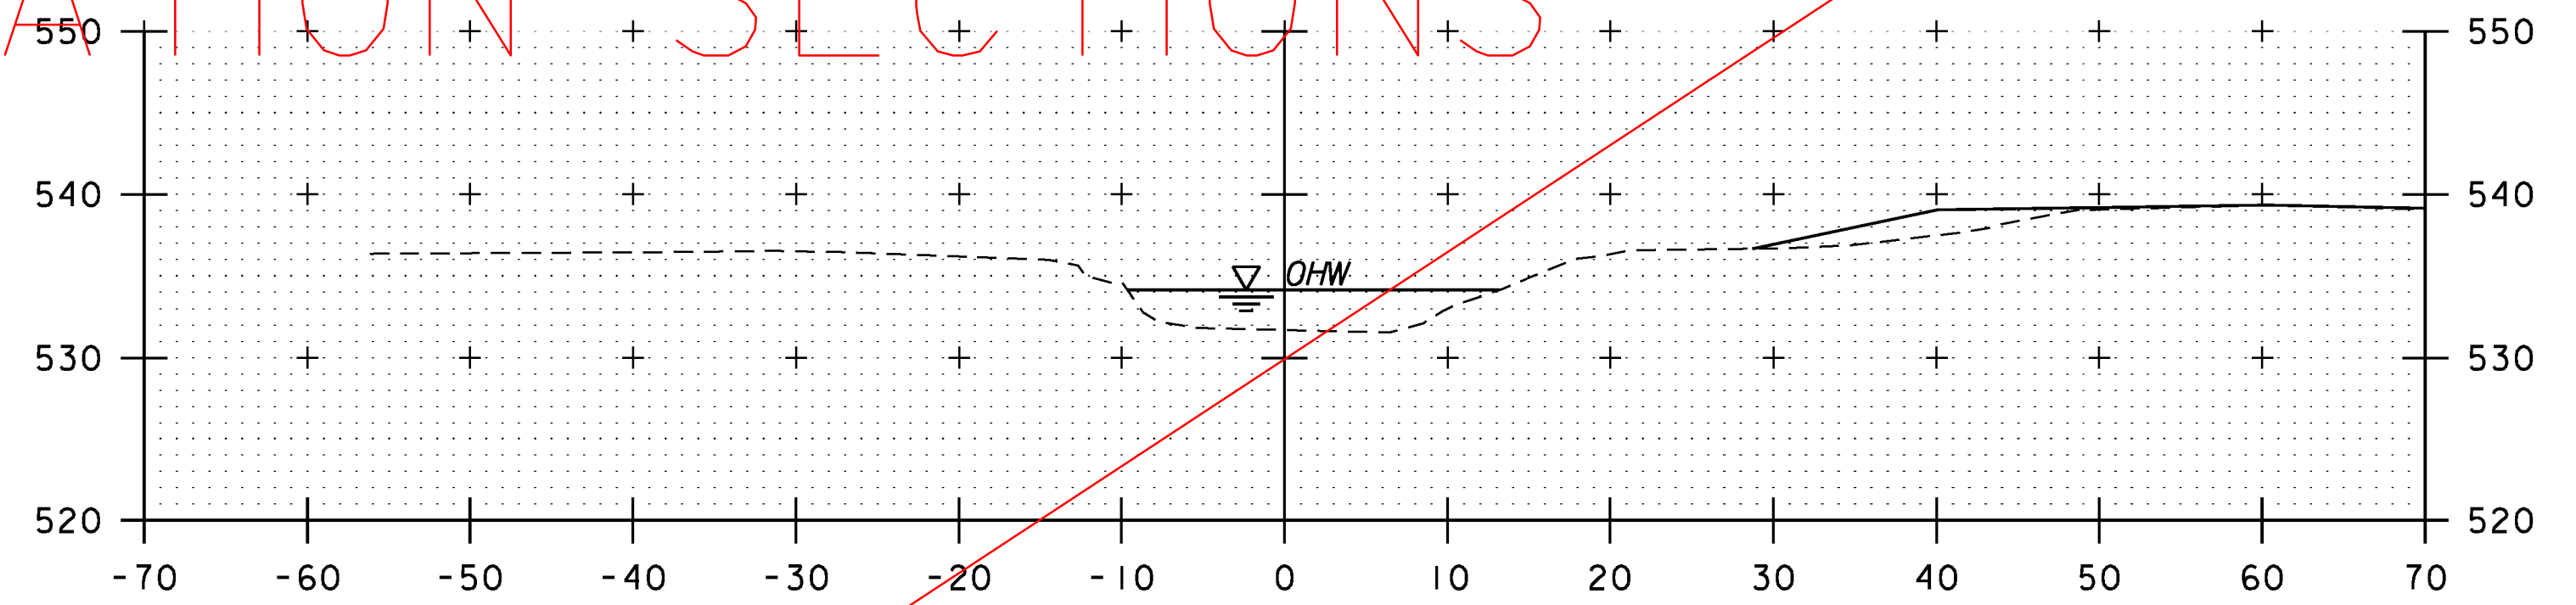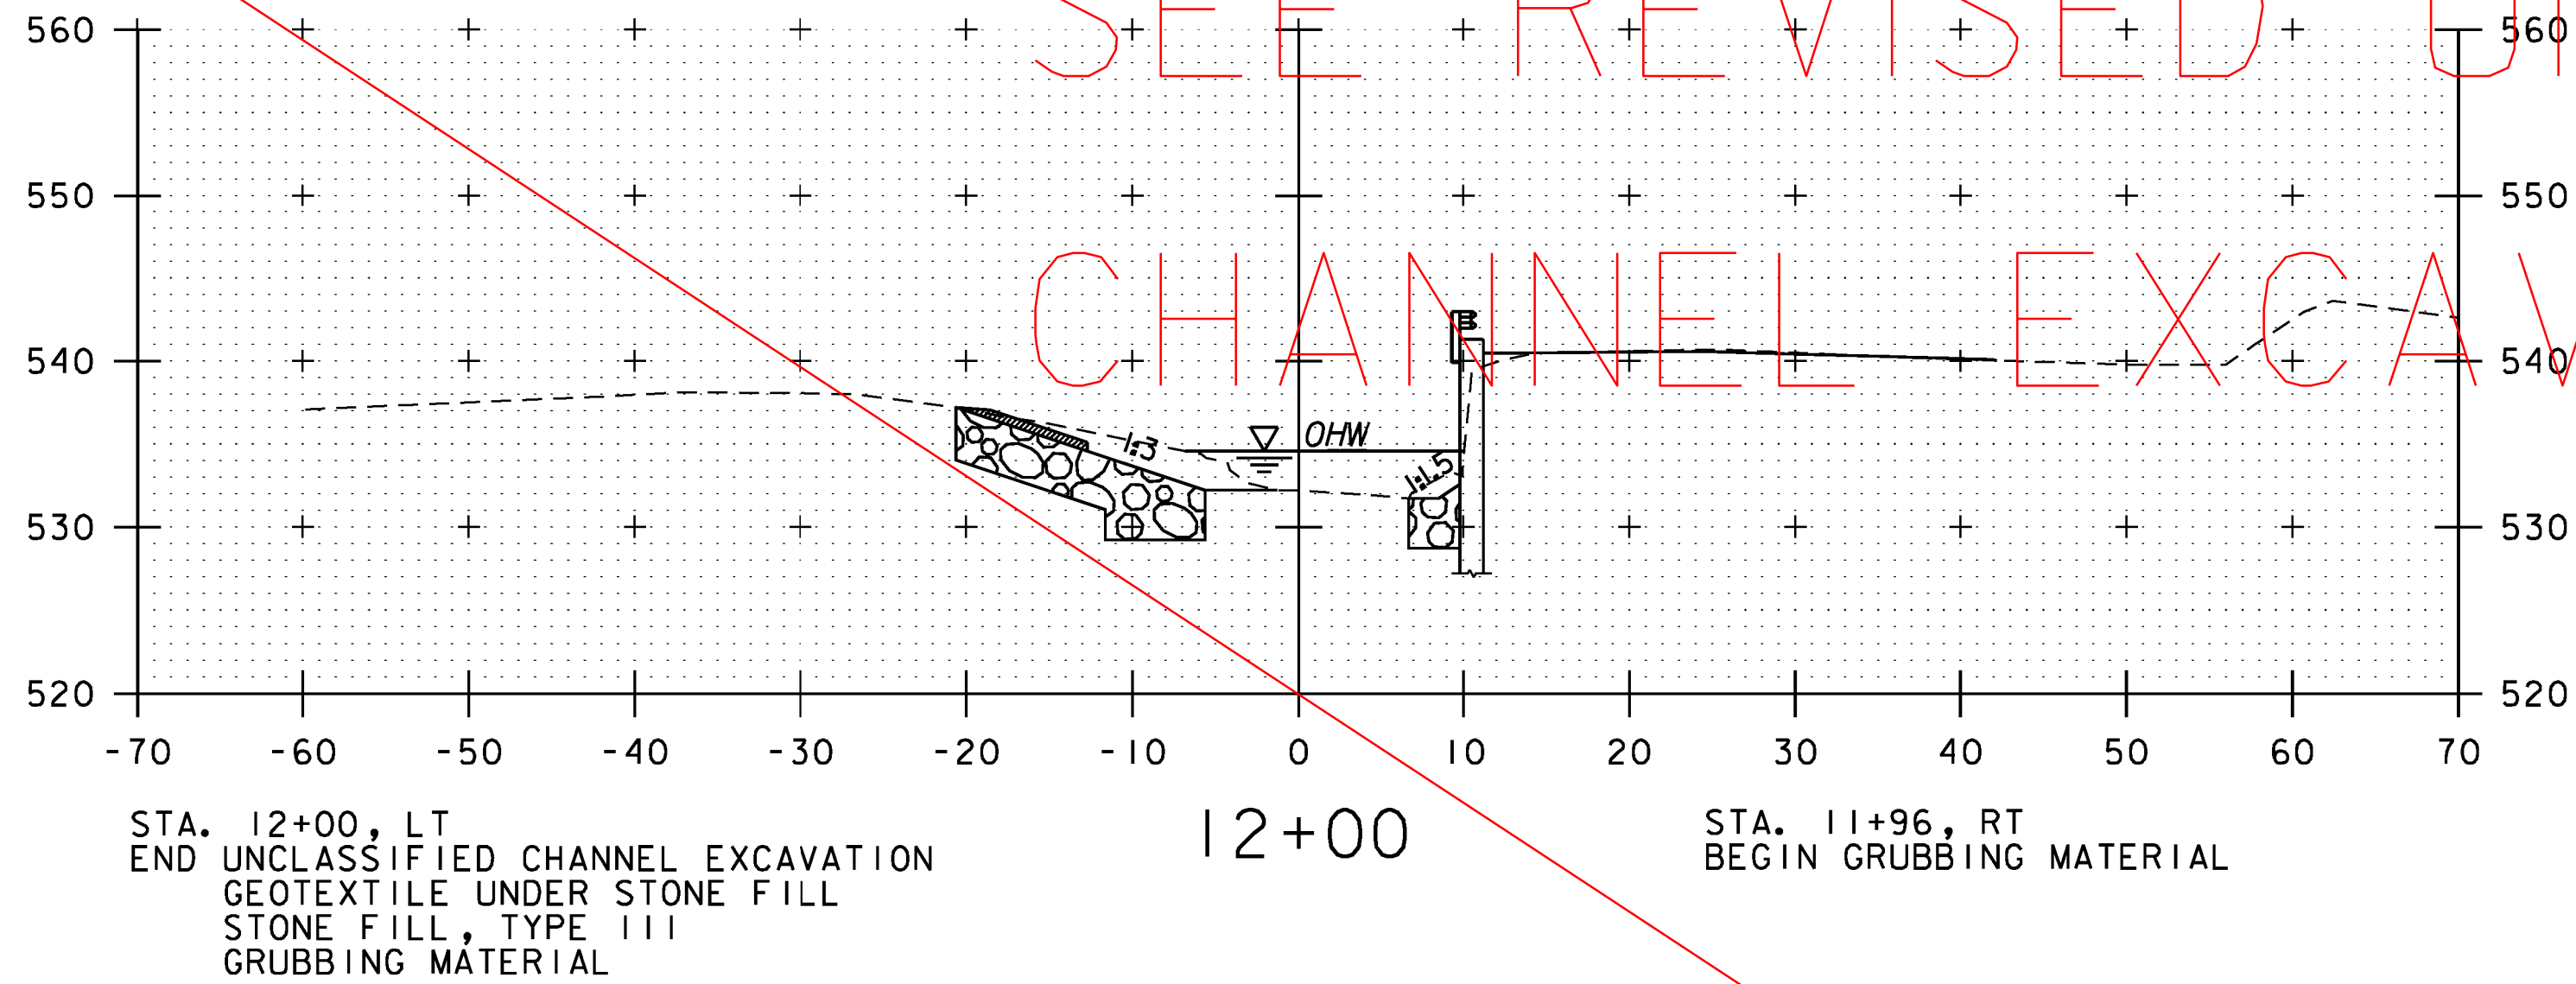


CHANNEL CROSS SECTIONS  
SCALE 1" = 10'-0"  
STA. 11+50 TO STA. 12+75



PROJECT NAME: BRATTLEBORO	
PROJECT NUMBER: BRO 1442(35)	
FILE NAME: z10j062xsl.dgn	PLOT DATE: 10/14/2013
PROJECT LEADER: S.E. BURBANK	DRAWN BY: E.A. FIALA
DESIGNED BY: E.A. FIALA	CHECKED BY: S.E. BURBANK
CHANNEL CROSS SECTIONS (2 OF 3)	SHEET 58 OF 68

# SEE REVISED UNCLASSIFIED CHANNEL EXCAVATION SECTIONS

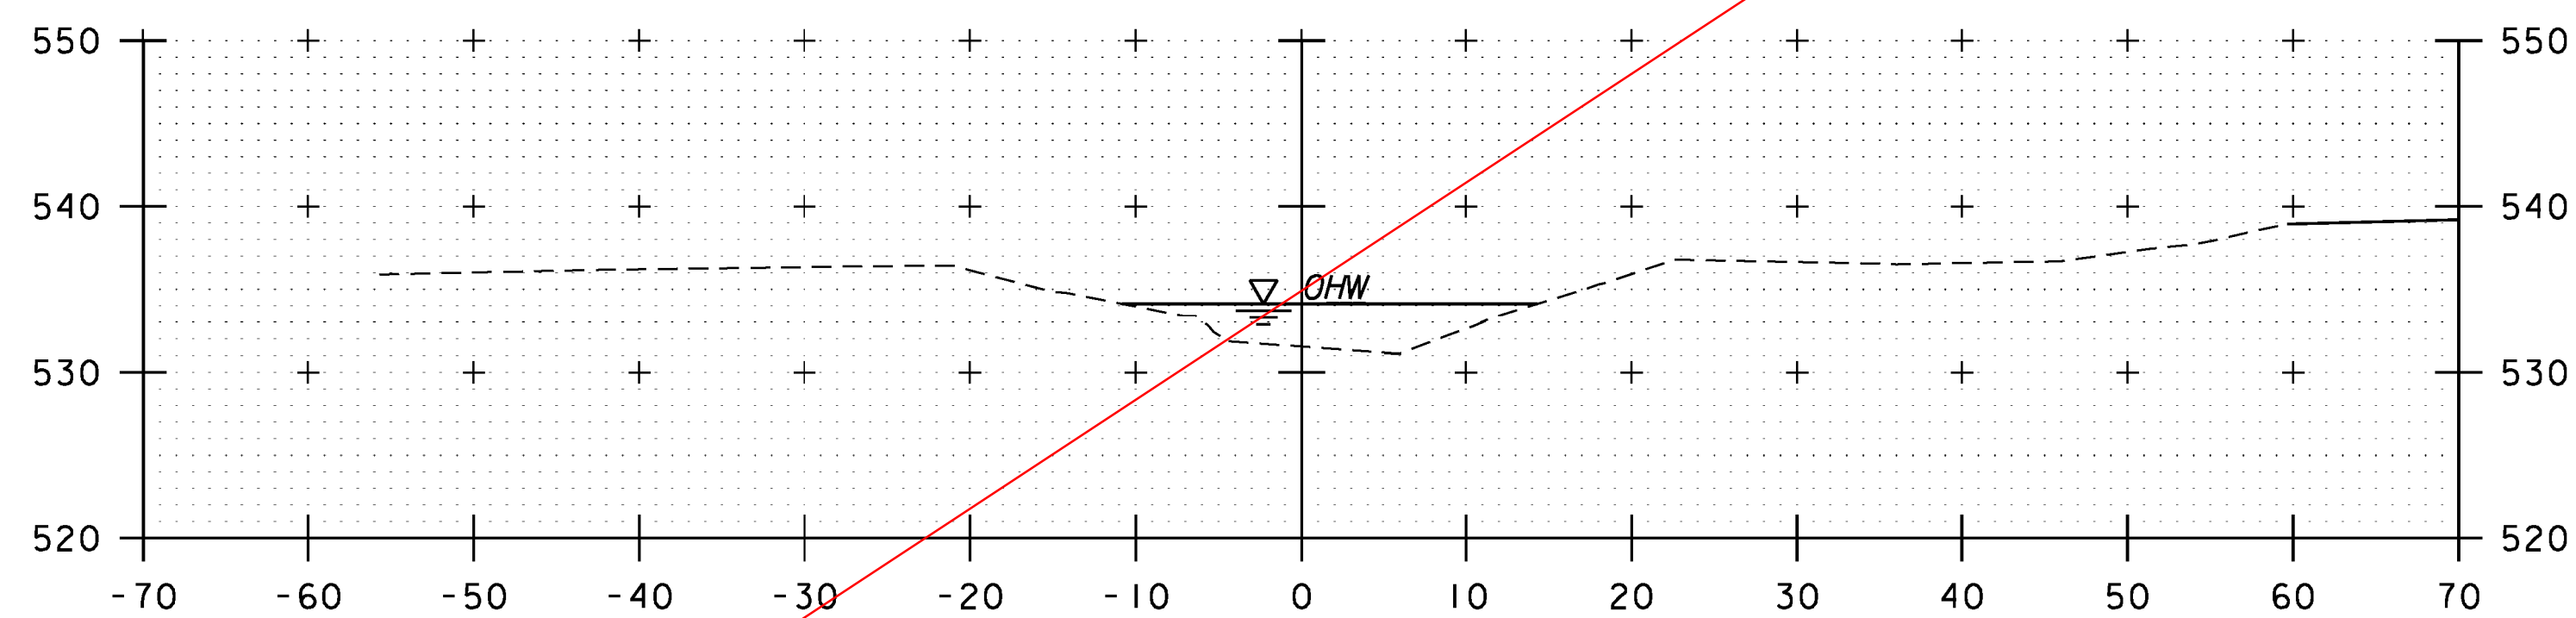

13+00

## CHANNEL CROSS SECTIONS

SCALE 1" = 10'-0"

STA. 13+00



PROJECT NAME: BRATTLEBORO  
PROJECT NUMBER: BRO 1442(35)

FILE NAME: z10j062xsl.dgn  
PROJECT LEADER: S.E. BURBANK  
DESIGNED BY: E.A. FIALA  
CHANNEL CROSS SECTIONS (3 OF 3)

PLOT DATE: 10/14/2013  
DRAWN BY: E.A. FIALA  
CHECKED BY: S.E. BURBANK  
SHEET 59 OF 68

## EPSC PLAN NARRATIVE

### 1.1 PROJECT DESCRIPTION

THIS PROJECT INVOLVES THE REMOVAL AND REPLACEMENT OF THE EXISTING CONCRETE SUPERSTRUCTURE AND ABUTMENTS WITH RELATED APPROACH AND CHANNEL WORK. DURING CONSTRUCTION, TRAFFIC WILL BE DETOURED OVER A TEMPORARY BRIDGE PLACED UPSTREAM. THIS PROJECT IS LOCATED ON A LOCAL ROAD LOCATED NORTH OF ROUTE 9 OVER HALLADAY BROOK IN THE TOWN OF BRATTLEBORO. THE EXISTING BRIDGE IS APPROXIMATELY 25 FEET LONG AND HAS A 20 FOOT WIDE CONCRETE DECK. THE EXISTING SUBSTRUCTURE CONSISTS OF STONE ABUTMENTS AND WINGWALLS.

THE BRIDGE REPLACEMENT INCLUDES THE REMOVAL OF THE EXISTING STRUCTURE IN ITS ENTIRETY AND THE CONSTRUCTION OF A NEW 45 FOOT SINGLE SPAN BRIDGE WITH PRECAST CONCRETE NON-VOIDED SLABS TO CREATE A NEW BRIDGE WIDTH OF 26 FEET. NEW CONCRETE ABUTMENTS AND WINGWALLS WILL BE FORMED IN PLACE AND ASSOCIATED APPROACH WORK INCLUDES BRIDGE APPROACH SLABS AND NEW GUARDRAIL. ONCE THE BRIDGE IS COMPLETED, THE TEMPORARY BRIDGE AND ITS APPROACHES WILL BE REMOVED AND THE PROJECT AREA WILL BE RESTORED TO THE PREVIOUS CONDITIONS.

NOTE: AREA OF DISTURBANCE INCLUDES LIMITS OF EARTH DISTURBANCE WITHIN THE PROJECT AREA, AS WELL AS WASTE, BORROW AND STAGING AREAS, AND OTHER EARTH DISTURBING ACTIVITIES WITHIN OR DIRECTLY ADJACENT TO THE PROJECT LIMITS AS SHOWN ON THE ATTACHED EPSC PLAN.

TOTAL AREA OF DISTURBANCE AS SHOWN ON THE ATTACHED EPSC PLAN IS APPROXIMATELY 0.55 ACRES.

IT IS ANTICIPATED THAT THIS PROJECT WILL LAST ONE CONSTRUCTION SEASON.

### 1.2 SITE INVENTORY

#### 1.2.1 TOPOGRAPHY

THE ROAD IN THIS PROJECT AREA IS GENERALLY FLAT AND FOLLOWS THE LAY OF THE SURROUNDING TOPOGRAPHY. THERE IS A PRIVATE GRAVEL ROAD (REGINA VISTA) THAT RUNS ALONG THE SOUTHWEST SIDE OF THE RIVER. THERE ARE 2 RESIDENCES ON EITHER END OF THE BRIDGE WITH PROPERTY THAT WILL BE WITHIN THE PROJECT AREA.

#### 1.2.2 DRAINAGE, WATERWAYS, BODIES OF WATER, AND PROXIMITY TO NATURAL OR MAN-MADE WATER FEATURES

HALLADAY BROOK IS LOCATED IN THE PROJECT AREA AND RUNS BETWEEN SUNSET LAKE AND REGINA VISTA ROAD BEFORE PASSING UNDER SUNSET LAKE ROAD. TWO MAINTAINED ORNAMENTAL PONDS ARE LOCATED WITHIN THE PROJECT INVESTIGATION AREA ON A RESIDENTIAL PROPERTY; EACH ARE MAPPED BY THE VERMONT STATE WETLAND INVENTORY AS CLASS II WETLANDS. HALLADAY BROOK GENERALLY CONSISTS OF COBBLES AND GRAVEL WITH OCCASIONAL BOULDERS. ON THE UPSTREAM SIDE OF SUNSET LAKE ROAD BRIDGE, THE EAST BANK OF THE STREAM IS VEGETATED AND RELATIVELY FLAT PROVIDING ADJACENT FLOOD STORAGE, WHILE THE WESTERN BANK IS PARTIALLY CUT AND STEEP BEFORE TRANSITIONING INTO A FORESTED BUFFER. DOWNSTREAM FROM SUNSET LAKE ROAD BRIDGE, THE EASTERN BANK IS VEGETATED FOR APPROXIMATELY 20 FEET BEFORE TRANSITIONING INTO A MAINTAINED FIELD, AND THE WESTERN BANK CONSISTS OF A MAINTAINED RESIDENTIAL LAWN WITH STRUCTURES LOCATED NEAR THE STREAM.

#### 1.2.3 VEGETATION

THE VEGETATION IN THE PROJECT AREA CONSISTS OF SPECKLED ALDER, YELLOW BIRCH, REED CANARY GRASS, AND GRASSED LAWN AREAS. UPON PROJECT COMPLETION, THE CHANNEL WILL BE ARMORED WITH STONE FILL TYPE III AS SPECIFIED ON THE PLANS. DISTURBED VEGETATION WILL BE REESTABLISHED WITH STANDARD SEED AND MULCH PRACTICES.

#### 1.2.4 SOILS

ALL SOIL DATA CAME FROM THE U.S. DEPARTMENT OF AGRICULTURE SOIL CONSERVATION SERVICE FOR THE COUNTY OF WINDSOR, VERMONT. SOILS ON THE PROJECT SITE ARE PODUNK FINE SANDY LOAM AND DEERFIELD FINE SANDY LOAM, 2% TO 8% SLOPES, "K FACTOR" = 0.24. THE SOIL IS CONSIDERED MODERATELY ERODIBLE.

NOTE: K-VALUES GENERALLY INDICATE THE FOLLOWING:

0.0-0.23 = LOW EROSION POTENTIAL  
0.24-0.36 = MODERATE EROSION POTENTIAL  
0.37 AND HIGHER = HIGH EROSION POTENTIAL

#### 1.2.5 SENSITIVE RESOURCE AREAS

CRITICAL HABITATS: NO  
HISTORICAL OR ARCHEOLOGICAL AREAS: NO  
PRIME AGRICULTURAL LAND: NO  
THREATENED AND ENDANGERED SPECIES: NO  
WATER RESOURCE: HALLADAY BROOK  
WETLANDS: THERE ARE TWO CLASS II WETLAND FEATURES MAPPED BY THE VERMONT STATE WETLAND INVENTORY WITHIN THE PROJECT INVESTIGATION AREA. A FIELD INVESTIGATION DETERMINED THAT THESE WERE ORNAMENTAL PONDS.

### 1.3 RISK EVALUATION

THIS PROJECT DOES NOT FALL UNDER THE JURISDICTION OF GENERAL PERMIT 3-9020 FOR STORM-WATER RUNOFF FROM CONSTRUCTION SITES. SHOULD CHANGES PRIOR TO OR DURING CONSTRUCTION RESULT IN ONE OR MORE ACRES OF EARTH DISTURBANCE OR SHOULD THE PROJECT BECOME PART OF A LARGER PLAN OF DEVELOPMENT, THE CONTRACTOR WILL BE RESPONSIBLE FOR ANY ADDITIONAL PERMITTING.

### 1.4 EROSION PREVENTION AND SEDIMENT CONTROL

THE EROSION CONTROL PLANS ARE MEANT AS A GUIDELINE FOR PREVENTING EROSION AND CONTROLLING SEDIMENT TRANSPORT. THE PRINCIPLES OUTLINED IN THIS NARRATIVE CONSIST OF APPLYING MEASURES THROUGHOUT CONSTRUCTION OF THE PROJECT IN ORDER TO MINIMIZE SEDIMENT TRANSPORT TO THE RECEIVING WATERS. THE MEASURES INCLUDE STABILIZATION AND STRUCTURAL PRACTICES, STORM WATER CONTROLS AND OTHER POLLUTION PREVENTION PRACTICES. THEY HAVE BEEN PROPOSED BY THE DESIGNER AS A BASIS FOR PROTECTING RESOURCES AND WILL NEED TO BE BUILT UPON BASED ON THE SPECIFIC MEANS AND METHODS OF THE CONTRACTOR. REFER TO THE LOW RISK SITE HANDBOOK AND APPROPRIATE DETAIL SHEETS FOR SPECIFIC GUIDANCE AND CONSTRUCTION DETAILING.

ALL MEASURES SHALL BE REGULARLY MAINTAINED AND SHALL BE CHECKED FOR SEDIMENT BUILD-UP. SEDIMENT SHALL BE DISPOSED OF AT AN APPROVED SITE WHERE IT WILL NOT BE SUBJECT TO EROSION.

#### 1.4.1 MARK SITE BOUNDARIES

SITE BOUNDARIES AND AREAS CONSTRUCTION EQUIPMENT CAN ACCESS SHALL BE DELINEATED.

PROJECT DEMARCATION FENCING (PDF) SHALL BE USED TO PHYSICALLY MARK SITE BOUNDARIES.

#### 1.4.2 LIMIT DISTURBANCE AREA

PREVENTING INITIAL SOIL EROSION BY MINIMIZING THE EXPOSED AREA IS MUCH MORE EFFECTIVE THAN TREATING ERODED SEDIMENT. EARTH DISTURBANCE CAN BE MINIMIZED THROUGH CONSTRUCTION PHASING BY ONLY OPENING UP EARTH AS NECESSARY. THIS CAN LIMIT THE AREA THAT WILL BE DISTURBED AND EXPOSED TO EROSION. EMPLOY TEMPORARY CONSTRUCTION STABILIZATION PRACTICES IN INCREMENTAL STAGES AS PHASES CHANGE. FOR PROJECTS WHICH FALL UNDER THE CONSTRUCTION GENERAL PERMIT, ONLY THE ACREAGE LISTED ON THE PERMIT AUTHORIZATION MAY BE EXPOSED AT ANY GIVEN TIME.

MAINTAINING VEGETATED BUFFERS ALONG STREAM BANKS, WETLANDS OR OTHER SENSITIVE AREAS IS A CRUCIAL EROSION AND SEDIMENT CONTROL MEASURE THAT SHOULD BE ESTABLISHED WHEREVER POSSIBLE.

#### 1.4.3 SITE ENTRANCE/EXIT STABILIZATION

TRACKING OF SEDIMENT ONTO PUBLIC HIGHWAYS SHALL BE MINIMIZED TO REDUCE THE POTENTIAL FOR RUNOFF ENTERING RECEIVING WATERS. INSTALLATION SHALL COINCIDE WITH THE PROGRESS SCHEDULE.

STABILIZED CONSTRUCTION ENTRANCES SHALL BE INSTALLED AS PROPOSED ON THE EPSC PLAN AND ANYWHERE EQUIPMENT WILL BE GOING FROM AREAS OF EXPOSED SOILS TO PAVED SURFACES.

#### 1.4.4 INSTALL SEDIMENT BARRIERS

SEDIMENT BARRIERS SHALL BE UTILIZED TO INTERCEPT RUNOFF AND ALLOW SUSPENDED SEDIMENT TO SETTLE OUT. THEY SHALL BE INSTALLED PRIOR TO ANY UP SLOPE WORK.

SILT FENCE SHALL BE INSTALLED AS PROPOSED ON THE EPSC PLAN.

FILTER CURTAIN SHALL BE INSTALLED WHERE WORK MUST TAKE PLACE WITHIN THE LIMITS OF HALLADAY BROOK AS PROPOSED ON THE EPSC PLAN.

#### 1.4.5 DIVERT UPLAND RUNOFF

DIVERSIONARY MEASURES SHALL BE USED TO INTERCEPT RUNOFF FROM ABOVE THE CONSTRUCTION AND DIRECT IT AROUND THE DISTURBED AREA SO THAT CLEAN WATER DOES NOT BECOME MUDDIED WHILE TRAVELING OVER EXPOSED SOILS ON THE CONSTRUCTION SITE.

THE PROJECT AREA IS RELATIVELY FLAT. THEREFORE IT IS NOT ANTICIPATED THAT DIVERSION MEASURES WILL BE NECESSARY.

#### 1.4.6 SLOW DOWN CHANNELIZED RUNOFF

CHECK STRUCTURES SHALL BE UTILIZED TO REDUCE THE VELOCITY, AND THUS THE EROSION POTENTIAL, OF CONCENTRATED FLOW IN CHANNELS.

CHECK STRUCTURES SHALL BE INSTALLED AS SHOWN ON THE PLANS.

#### 1.4.7 CONSTRUCT PERMANENT CONTROLS

PERMANENT STORM-WATER TREATMENT DEVICES SHALL BE INSTALLED AS SHOWN ON THE PLANS AND IN ACCORDANCE WITH PERMIT CONDITIONS.

PERMANENT EROSION CONTROL STRUCTURES ARE NOT ANTICIPATED FOR THIS PROJECT.

#### 1.4.8 STABILIZE EXPOSED SOILS DURING CONSTRUCTION

ALL AREAS OF DISTURBANCE MUST HAVE TEMPORARY STABILIZATION IN PLACE WITHIN 48 HOURS OF DISTURBANCE OR IN ACCORDANCE WITH THE CONSTRUCTION GENERAL PERMIT 3-9020 AUTHORIZATION.

SURFACE ROUGHENING OF ALL EXPOSED SLOPES, COMBINED WITH TEMPORARY MULCHING, SHALL BE UTILIZED ON A REGULAR BASIS. BIODEGRADABLE EROSION CONTROL MATTING OR AN EQUIVALENT SHALL BE USED TO STABILIZE ALL SLOPES STEEPER THAN 1:3.

THE FORECAST OF RAINFALL EVENTS SHALL TRIGGER IMMEDIATE PROTECTION OF EXPOSED SOILS.

#### 1.4.9 WINTER STABILIZATION

VARIOUS MEASURES SPECIFIC TO WINTER MAY BE NECESSARY SHOULD THE PROJECT EXTEND INTO WINTER (OCTOBER 15 THROUGH APRIL 15). REFER TO THE LOW RISK SITE HANDBOOK FOR GUIDANCE.

#### 1.4.10 STABILIZE SOIL AT FINAL GRADE

EXPOSED SOIL MUST BE STABILIZED WITHIN 48 HOURS OF REACHING FINAL GRADE.

SEED, MULCH, FERTILIZER AND LIME SHALL BE USED TO ESTABLISH PERMANENT VEGETATION. FOR SLOPES STEEPER THAN 1:3, BIODEGRADABLE EROSION CONTROL MATTING OR AN EQUIVALENT SHALL BE USED INSTEAD OF MULCH.

#### 1.4.11 DE-WATERING ACTIVITIES

DISCHARGE FROM DEWATERING ACTIVITIES THAT FLOWS OFF OF THE CONSTRUCTION SITE MUST NOT CAUSE OR CONTRIBUTE TO A VIOLATION OF THE VERMONT WATER QUALITY STANDARDS.

TREATMENT OF DEWATERING COFFERDAM IS ANTICIPATED. A LOCATION FOR TREATMENT HAS BEEN PROPOSED AND IS SHOWN ON THE PLANS. HOWEVER THE SPECIFIC MEANS FOR TREATMENT OF DISCHARGE SHALL BE PROVIDED BY THE CONTRACTOR.

#### 1.4.12 INSPECT YOUR SITE

INSPECT THE PROJECT SITE BASED ON SPECIAL PROVISION REQUIREMENTS OR CONSTRUCTION GENERAL PERMIT AUTHORIZATION STIPULATIONS.

### 1.5 SEQUENCE AND STAGING

THIS SECTION WILL BE DEVELOPED BY THE CONTRACTOR USING THE GUIDANCE OUTLINED IN THE VTRANS EPSC PLAN CONTRACTOR CHECKLIST.

#### 1.5.1 CONSTRUCTION SEQUENCE

#### 1.5.2 OFF-SITE ACTIVITIES

IN ADDITION TO THE CONTRACTOR CHECKLIST ANY ACTIVITIES OUTSIDE THE CONSTRUCTION LIMITS SHALL FOLLOW SUBSECTIONS 105.25- 105.29 OF THE STANDARD SPECIFICATIONS FOR CONSTRUCTION.

PROJECT NAME: BRATTLEBORO

PROJECT NUMBER: BRO 1442(35)

FILE NAME: z10j062ero_narrative.dgn

PROJECT LEADER: S.E. BURBANK

DESIGNED BY: E.A. FIALA



EPSC NARRATIVE

PLOT DATE: 10/14/2013

DRAWN BY: E.A. FIALA

CHECKED BY: S.E. BURBANK

SHEET 60 OF 68

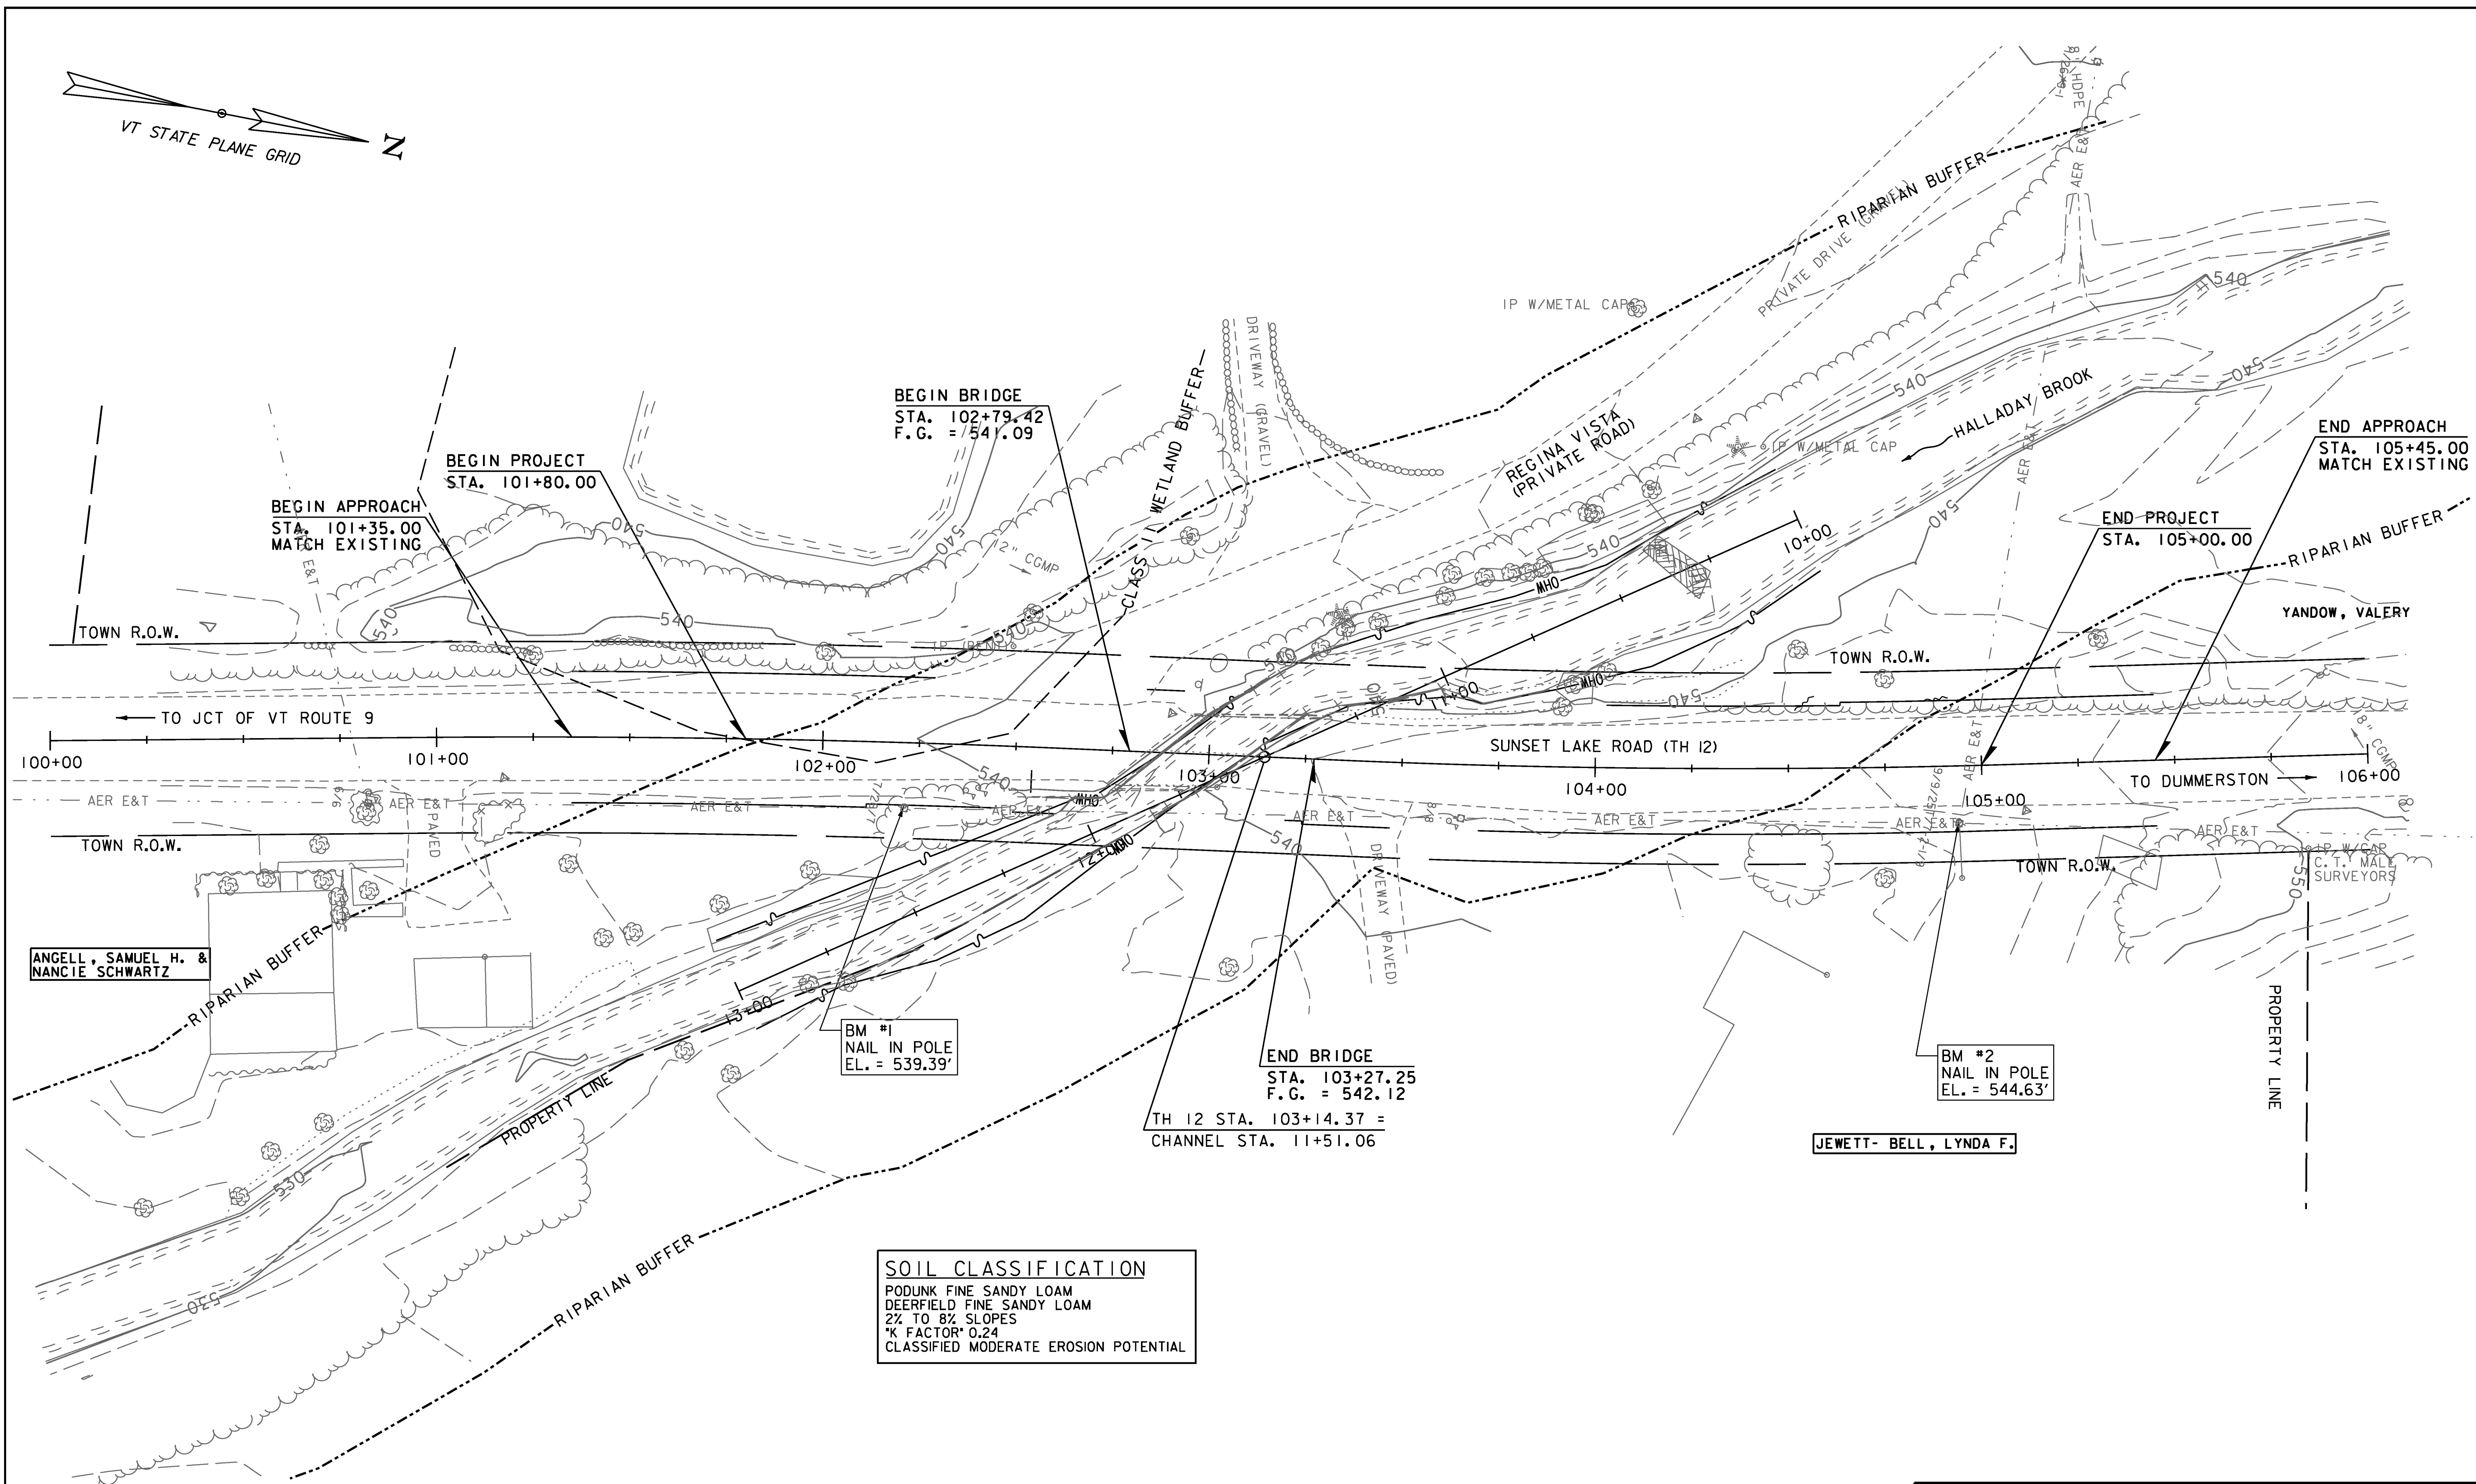
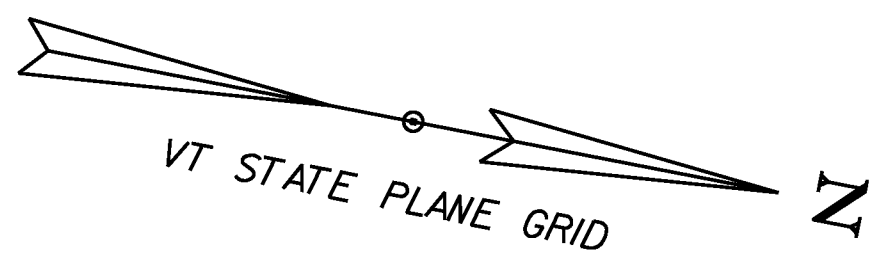


**SOIL CLASSIFICATION**  
 PODUNK FINE SANDY LOAM  
 DEERFIELD FINE SANDY LOAM  
 2% TO 8% SLOPES  
 *K FACTOR* 0.24  
 CLASSIFIED MODERATE EROSION POTENTIAL

SCALE 1" = 20'-0"  
 20 0 20



PROJECT NAME: BRATTLEBORO	PROJECT NUMBER: BRO 1442(35)
FILE NAME: z10j062bdr_ero.dgn	PLOT DATE: 10/14/2013
PROJECT LEADER: S.E. BURBANK	DRAWN BY: E.A. FIALA
DESIGNED BY: E.A. FIALA	CHECKED BY: S.E. BURBANK
EPSC EXISTING CONDITIONS PLAN	SHEET 61 OF 68

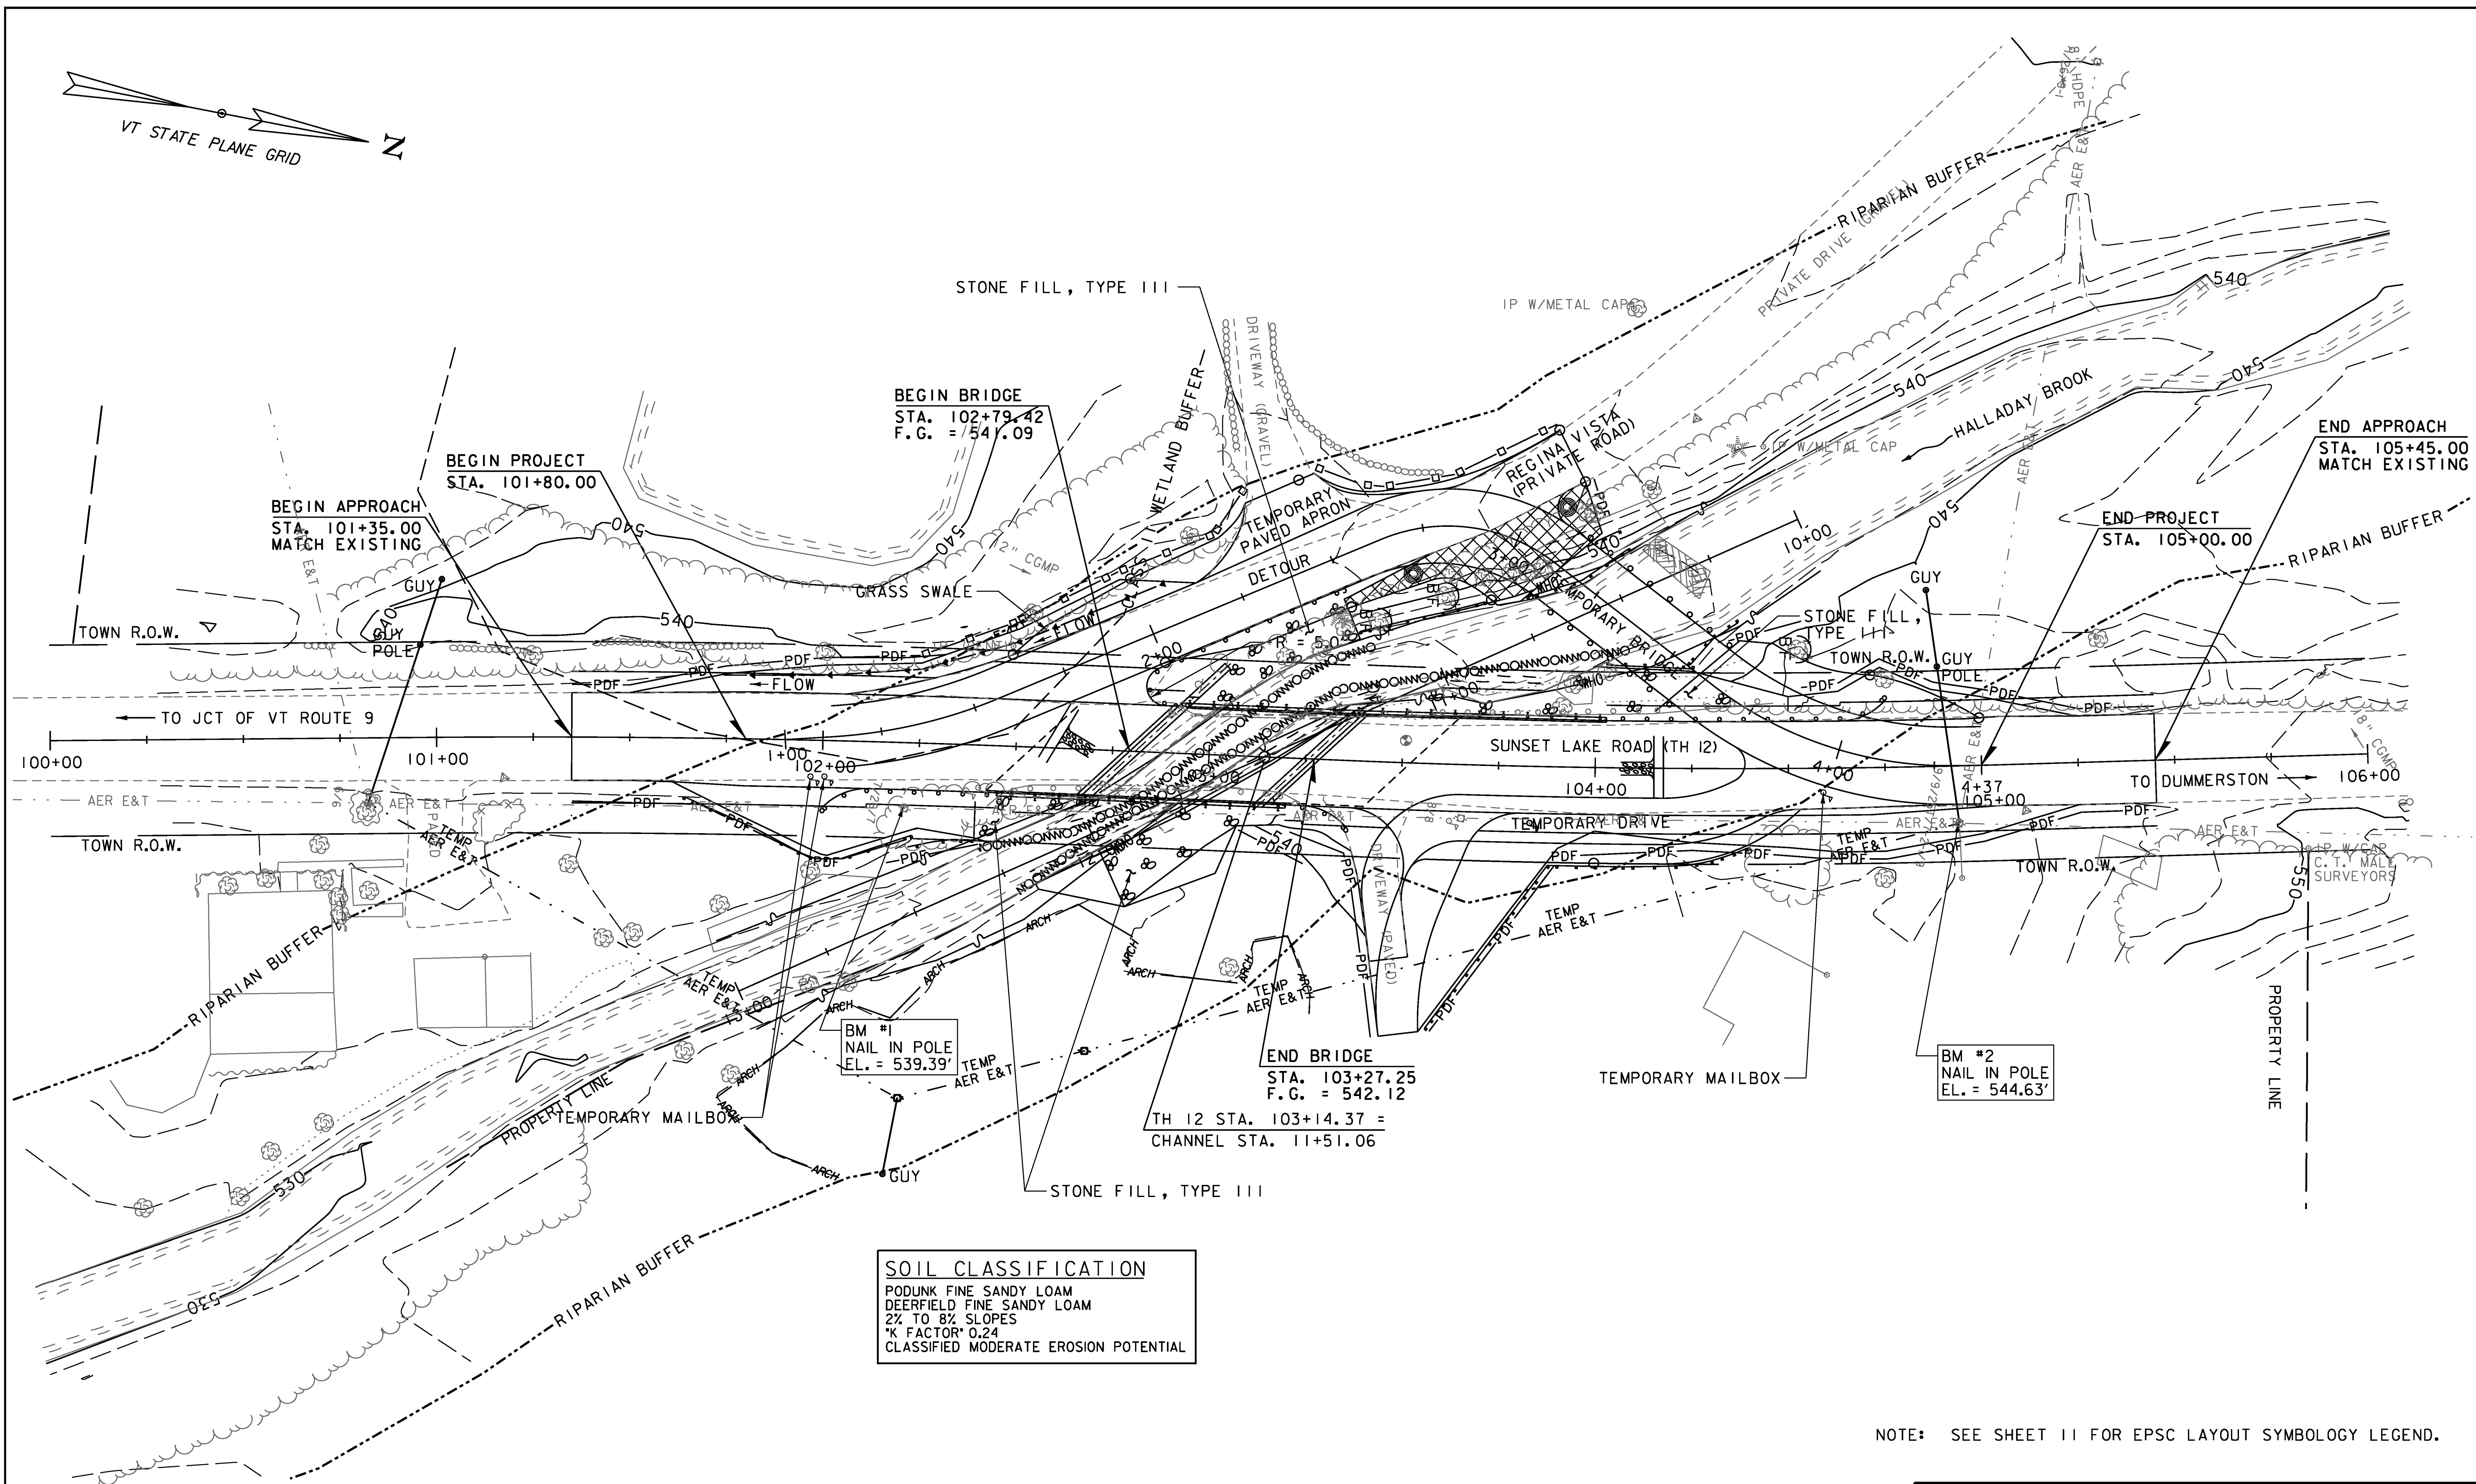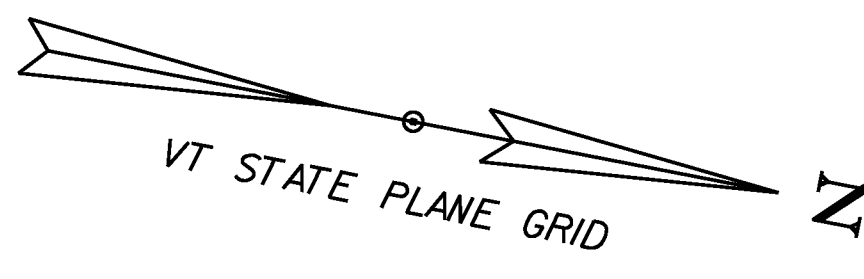

BEGIN APPROACH  
STA. 101+35.00  
MATCH EXISTING

BEGIN PROJECT  
STA. 101+80.00

BEGIN BRIDGE  
STA. 102+79.42  
F.G. = 541.09

END APPROACH  
STA. 105+45.00  
MATCH EXISTING

END PROJECT  
STA. 105+00.00

END BRIDGE  
STA. 103+27.25  
F.G. = 542.12  
TH 12 STA. 103+14.37 =  
CHANNEL STA. 11+51.06

**SOIL CLASSIFICATION**  
PODUNK FINE SANDY LOAM  
DEERFIELD FINE SANDY LOAM  
2% TO 8% SLOPES  
"K" FACTOR 0.24  
CLASSIFIED MODERATE EROSION POTENTIAL

BM #2  
NAIL IN POLE  
EL. = 544.63'



BM #1  
NAIL IN POLE  
EL. = 539.39'

NOTE: SEE SHEET 11 FOR EPSC LAYOUT SYMBOLOGY LEGEND.

SCALE 1" = 20'-0"  
20 0 20



PROJECT NAME: BRATTLEBORO	PLOT DATE: 10/14/2013
PROJECT NUMBER: BRO 1442(35)	DRAWN BY: E.A. FIALA
FILE NAME: z10j062bdr_ero.dgn	CHECKED BY: S.E. BURBANK
PROJECT LEADER: S.E. BURBANK	SHEET 62 OF 68
DESIGNED BY: E.A. FIALA	
EPSC CONSTRUCTION CONDITIONS PLAN	

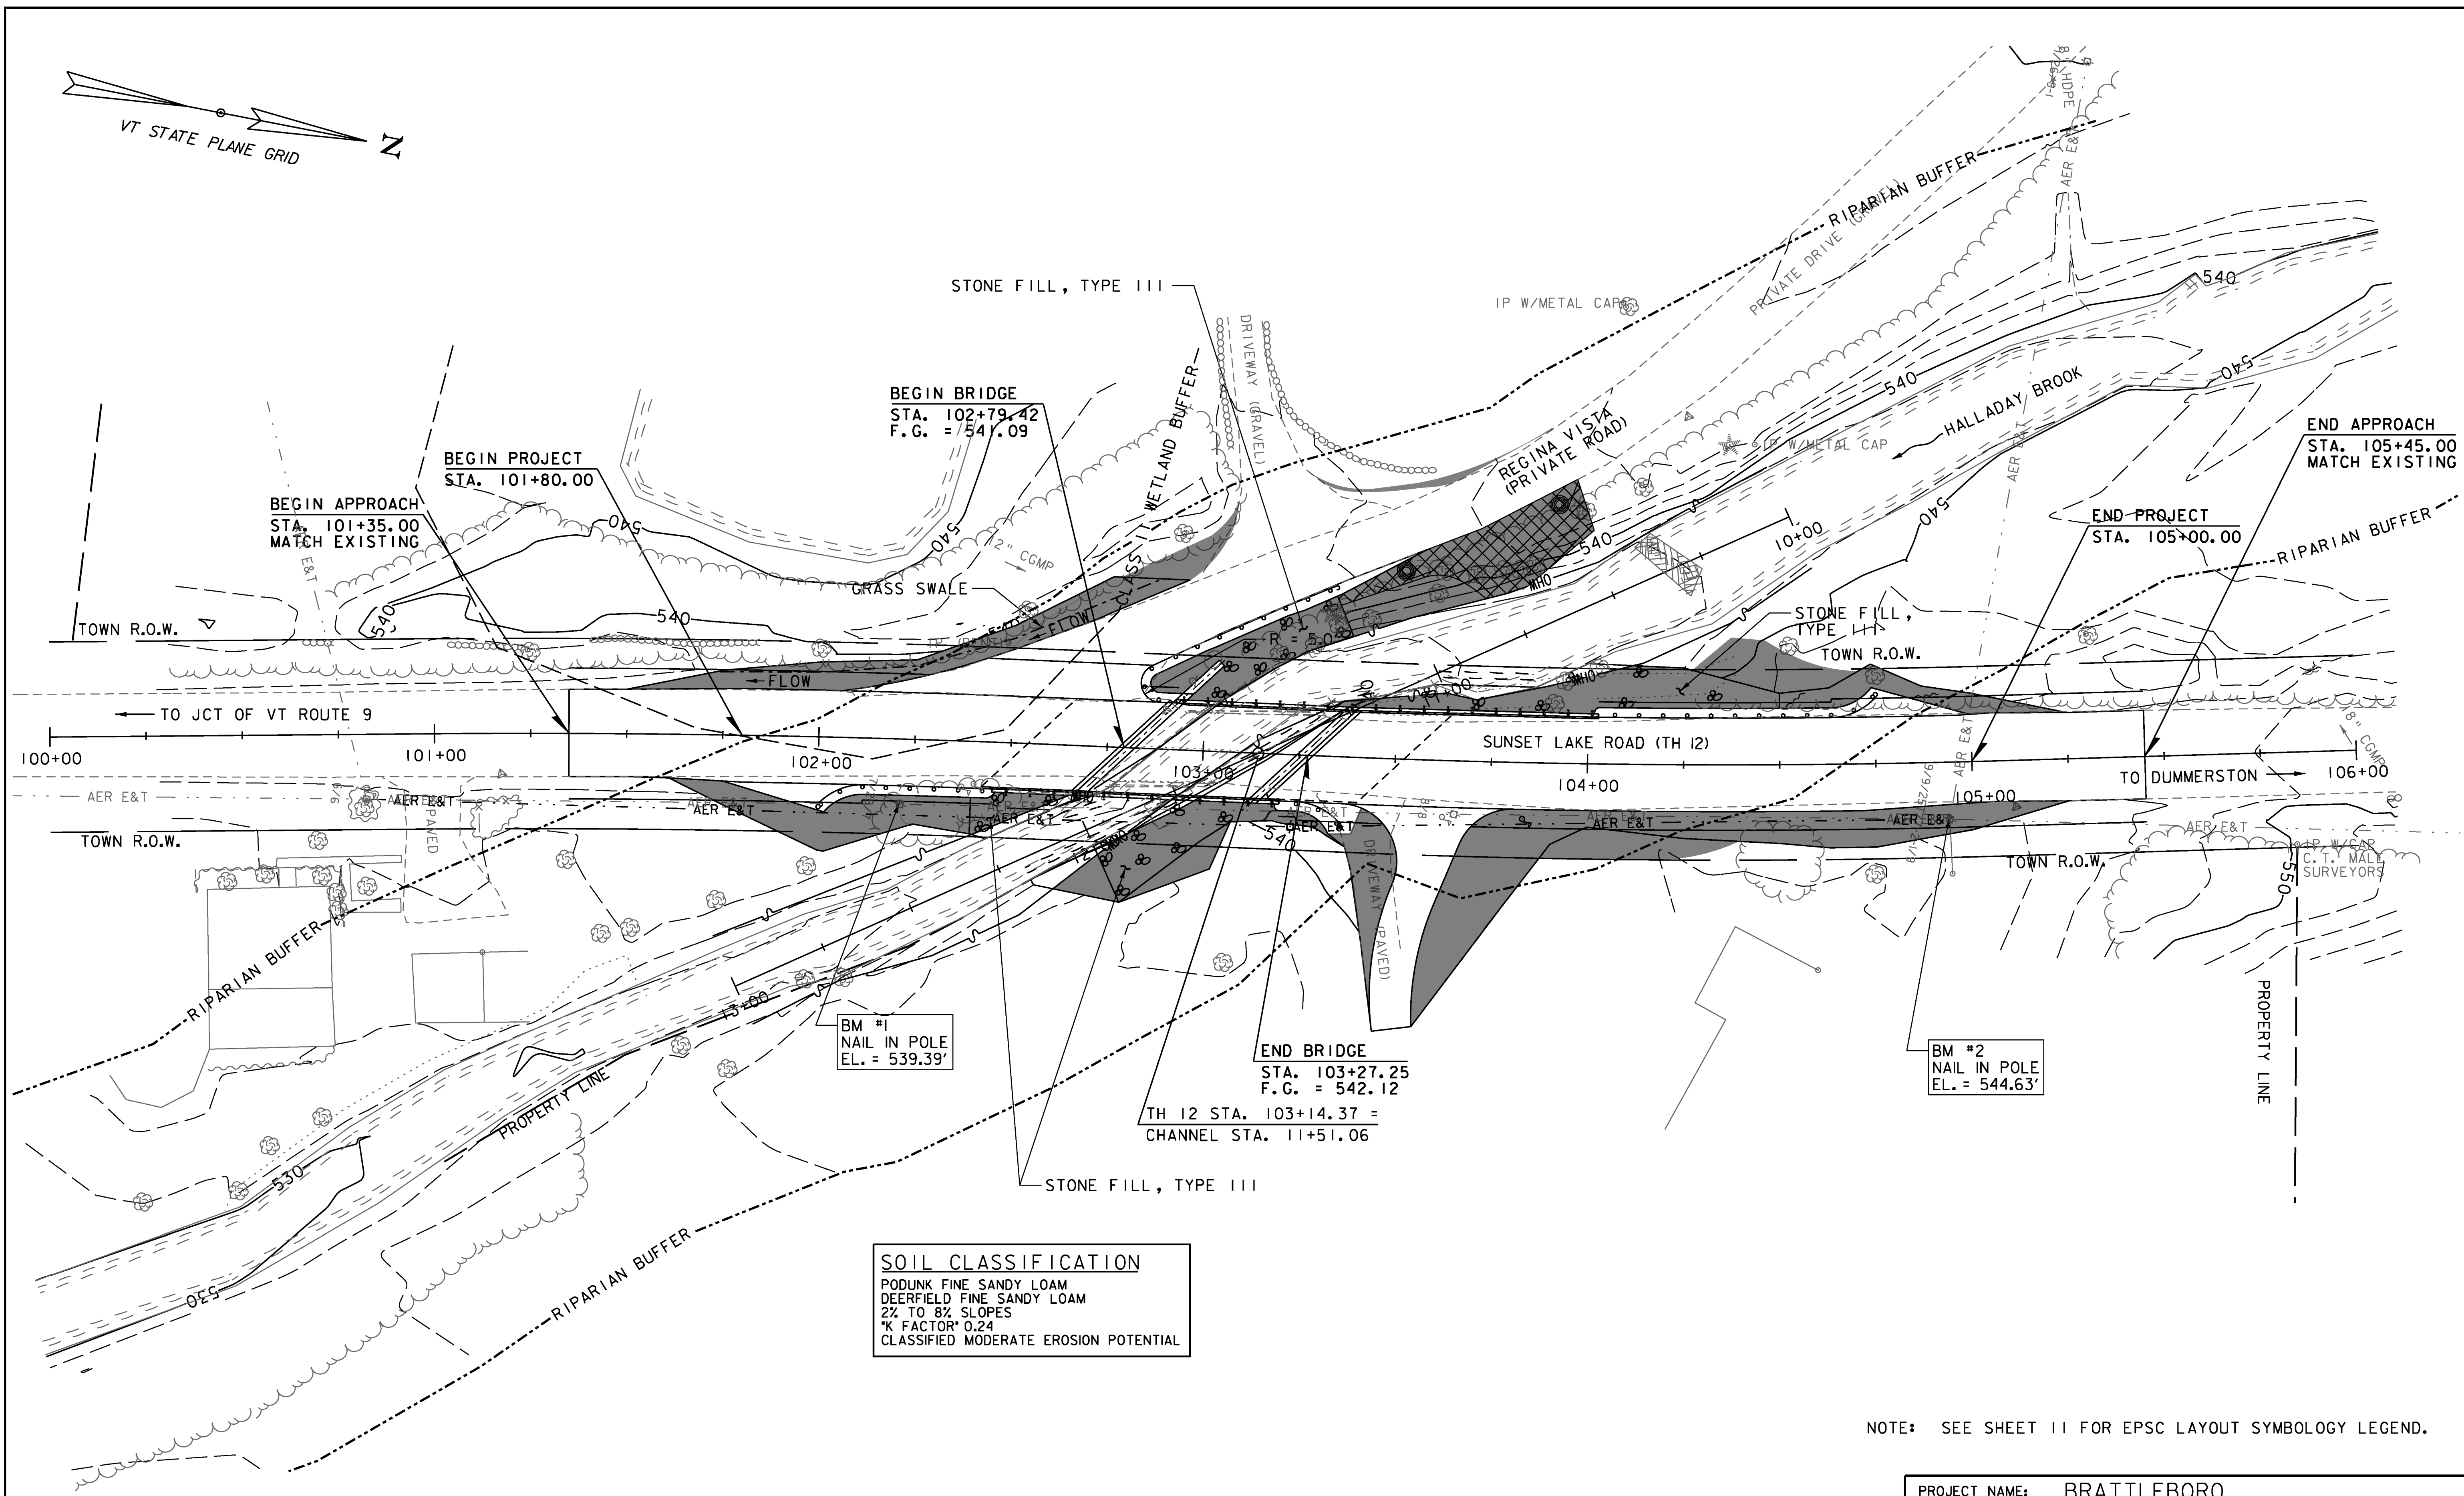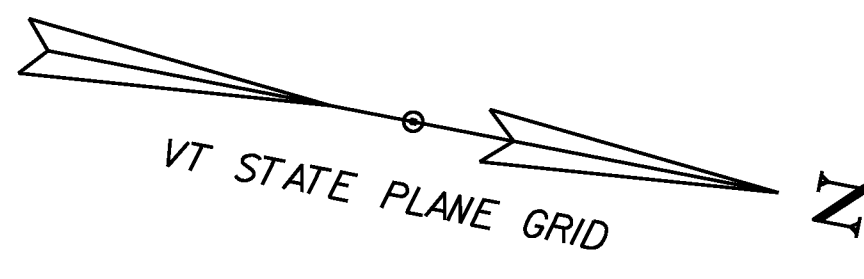

BEGIN APPROACH  
STA. 101+35.00  
MATCH EXISTING

BEGIN PROJECT  
STA. 101+80.00

BEGIN BRIDGE  
STA. 102+79.42  
F.G. = 541.09

END APPROACH  
STA. 105+45.00  
MATCH EXISTING

END PROJECT  
STA. 105+00.00

END BRIDGE  
STA. 103+27.25  
F.G. = 542.12

TH 12 STA. 103+14.37 =  
CHANNEL STA. 11+51.06

BM #1  
NAIL IN POLE  
EL. = 539.39'

BM #2  
NAIL IN POLE  
EL. = 544.63'


**SOIL CLASSIFICATION**  
PODUNK FINE SANDY LOAM  
DEERFIELD FINE SANDY LOAM  
2% TO 8% SLOPES  
*K FACTOR* 0.24  
CLASSIFIED MODERATE EROSION POTENTIAL

NOTE: SEE SHEET 11 FOR EPSC LAYOUT SYMBOLGY LEGEND.

SCALE 1" = 20'-0"  
20 0 20



PROJECT NAME: BRATTLEBORO	PLOT DATE: 10/14/2013
PROJECT NUMBER: BRO 1442(35)	DRAWN BY: E.A. FIALA
FILE NAME: z10j062bdr_ero.dgn	CHECKED BY: S.E. BURBANK
PROJECT LEADER: S.E. BURBANK	SHEET 63 OF 68
DESIGNED BY: E.A. FIALA	
EPSC FINAL CONDITIONS PLAN	

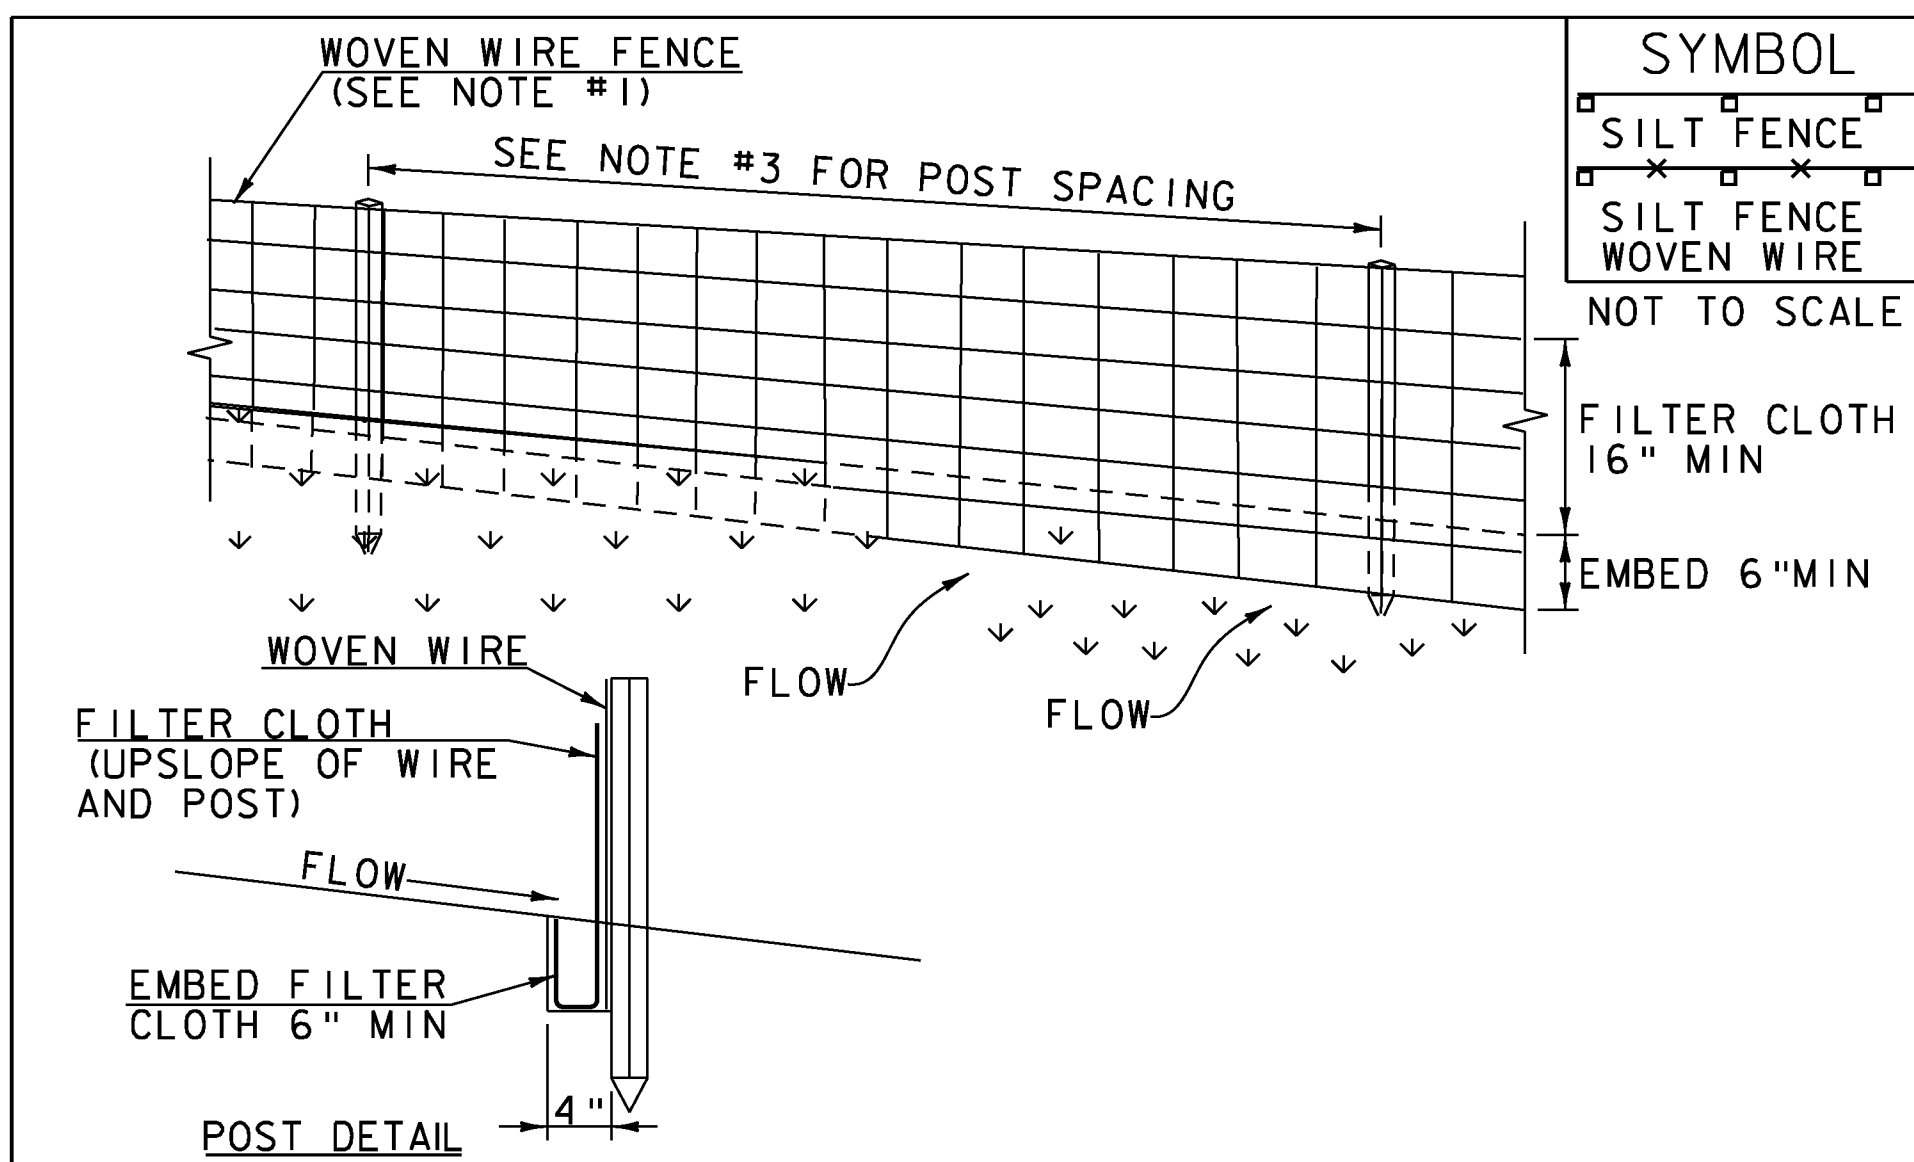

SYMBOL	
[Symbol]	SILT FENCE
[Symbol]	SILT FENCE WOVEN WIRE

**CONSTRUCTION SPECIFICATIONS**

- WOVEN WIRE REINFORCED FENCE IS REQUIRED WITHIN 100' UPSLOPE OF RECEIVING WATERS WHEN THE PROJECT FALLS UNDER A CONSTRUCTION STORMWATER PERMIT. WOVEN WIRE SHALL BE A MIN. 14 GAUGE WITH A 6" MAX. MESH OPENING.
- FILTER CLOTH SHALL BE EITHER FILTER X, MIRAF1100X, STABILINKA T140N OR APPROVED EQUIVALENT.
- POST SPACING FOR WIRE-BACKED FENCE SHALL BE 10' MAXIMUM. FOR FILTER-CLOTH FENCE, WHEN ELONGATION IS >50%, POST SPACING SHALL NOT EXCEED 4' AND WHEN ELONGATION IS <50%, POST SPACING SHALL NOT EXCEED 6'.
- WOVEN WIRE FENCE IS TO BE FASTENED SECURELY TO FENCE POSTS WITH WIRE TIES. FILTER CLOTH IS TO BE FASTENED SECURELY TO WOVEN WIRE FENCE WITH TIES SPACED EVERY 24" AT TOP AND MID SECTION.
- WHEN TWO SECTIONS OF FILTER CLOTH ADJOIN EACH OTHER THEY SHALL BE OVER-LAPPED BY 6" AND FOLDED.
- MAINTENANCE SHALL BE PERFORMED AS NEEDED AND MATERIAL REMOVED WHEN SEDIMENT REACHES HALF OF FABRIC HEIGHT.

ADAPTED FROM DETAILS PROVIDED BY: NEW YORK STATE DEC  
ORIGINALLY DEVELOPED BY USDA-NRCS  
VERMONT DEPARTMENT OF ENVIRONMENTAL CONSERVATION

**SILT FENCE**

NOTES:  
REFER TO "THE VERMONT STANDARDS & SPECIFICATIONS FOR EROSION PREVENTION & SEDIMENT CONTROL -2006-" FROM THE VT AGENCY OF NATURAL RESOURCES FOR ADDITIONAL GUIDANCE.

THIS WORK SHALL BE PERFORMED IN ACCORDANCE WITH SECTION 649 AND AS SHOWN IN THE PLANS FOR GEOTEXTILE FOR SILT FENCE (PAY ITEM 649.5) OR GEOTEXTILE FOR SILT FENCE, WOVEN WIRE REINFORCED (PAY ITEM 649.515).

REVISIONS	
MARCH 21, 2008	WHF
DECEMBER 11, 2008	WHF
JANUARY 13, 2009	WHF

VAOT RURAL AREA MIX					
% WEIGHT	LBS/AC		NAME	GERM %	PURITY %
	BROADCAST	HYDROSEED			
37.5%	22.5	45	CREeping RED FESCUE	85%	98%
37.5%	22.5	45	TALL FESCUE	90%	95%
5.0%	3	6	RED TOP	90%	95%
15.0%	9	18	BIRDSFOOT TREFOIL	85%	98%
5.0%	3	6	ANNUAL RYE GRASS	85%	95%
100%	60	120			

VAOT URBAN AREA MIX					
% WEIGHT	LBS/AC		NAME	GERM %	PURITY %
	BROADCAST	HYDROSEED			
42.5%	34	68	CREeping RED FESCUE	85%	98%
10.0%	8	16	PERENNIAL RYE GRASS	90%	95%
42.5%	34	68	KENTUCKY BLUE GRASS	85%	85%
5.0%	4	8	ANNUAL RYE GRASS	85%	95%
100%	80	160			

SOIL AMENDMENT GUIDANCE			
FERTILIZER		LIME	
BROADCAST	HYDROSEED	BROADCAST	HYDROSEED
10-20-10	FOLLOW	PELLETIZED	FOLLOW
500 LBS/AC	MANUFACTURER	2 TONS/AC	MANUFACTURER


**CONSTRUCTION GUIDANCE**

- RURAL SEED MIX: USE AS INDICATED IN THE PLANS AND/OR FOR ALL ESTABLISHED UPLAND (NON WETLAND) AREAS DISTURBED BY THE CONTRACTOR.
- URBAN SEED MIX: USE AS INDICATED IN THE PLANS AND/OR FOR ALL ESTABLISHED LAWN AREAS DISTURBED BY THE CONTRACTOR.
- ALL SEED MIXTURES: SHALL NOT HAVE A WEED CONTENT EXCEEDING 0.40% BY WEIGHT AND SHALL BE FREE OF ALL NOXIOUS SEED.
- FERTILIZER AND LIMESTONE: SHALL FOLLOW RATES SHOWN ON PLAN OR AS DIRECTED BY THE ENGINEER
- HAY MULCH: TO BE PLACED ON EARTH SLOPES AT THE RATE OF 2 TONS/ACRE, ACHIEVE 90% GROUND COVER OR AS DIRECTED BY THE ENGINEER.
- TOPSOIL: TO BE USED WITH SEED AS INDICATED ON THE PLANS, OR AS DIRECTED BY THE ENGINEER.
- HYDROSEEDING: ALTHOUGH GUIDANCE IS GIVEN ABOVE THE SITE CONDITIONS AND THE TYPE OF HYDROSEED WILL ULTIMATELY DICTATE THE AMOUNTS AND TYPES OF SOIL AMENDMENTS TO BE APPLIED
- TURF ESTABLISHMENT: PLACING SEED, FERTILIZER, LIME AND MULCH PRIOR TO SEPTEMBER 15 AND AFTER APRIL 15 CAN BETTER ENSURE A VIGOROUS GROWTH OF GRASS.

ADAPTED FROM VTRANS TECHNICAL LANDSCAPE MANUAL FOR ROADWAYS AND TRANSPORTATION FACILITIES

**TURF ESTABLISHMENT**

REVISIONS	
JUNE 23, 2009	WHF
JANUARY 15, 2010	WHF
FEBRUARY 16, 2011	WHF

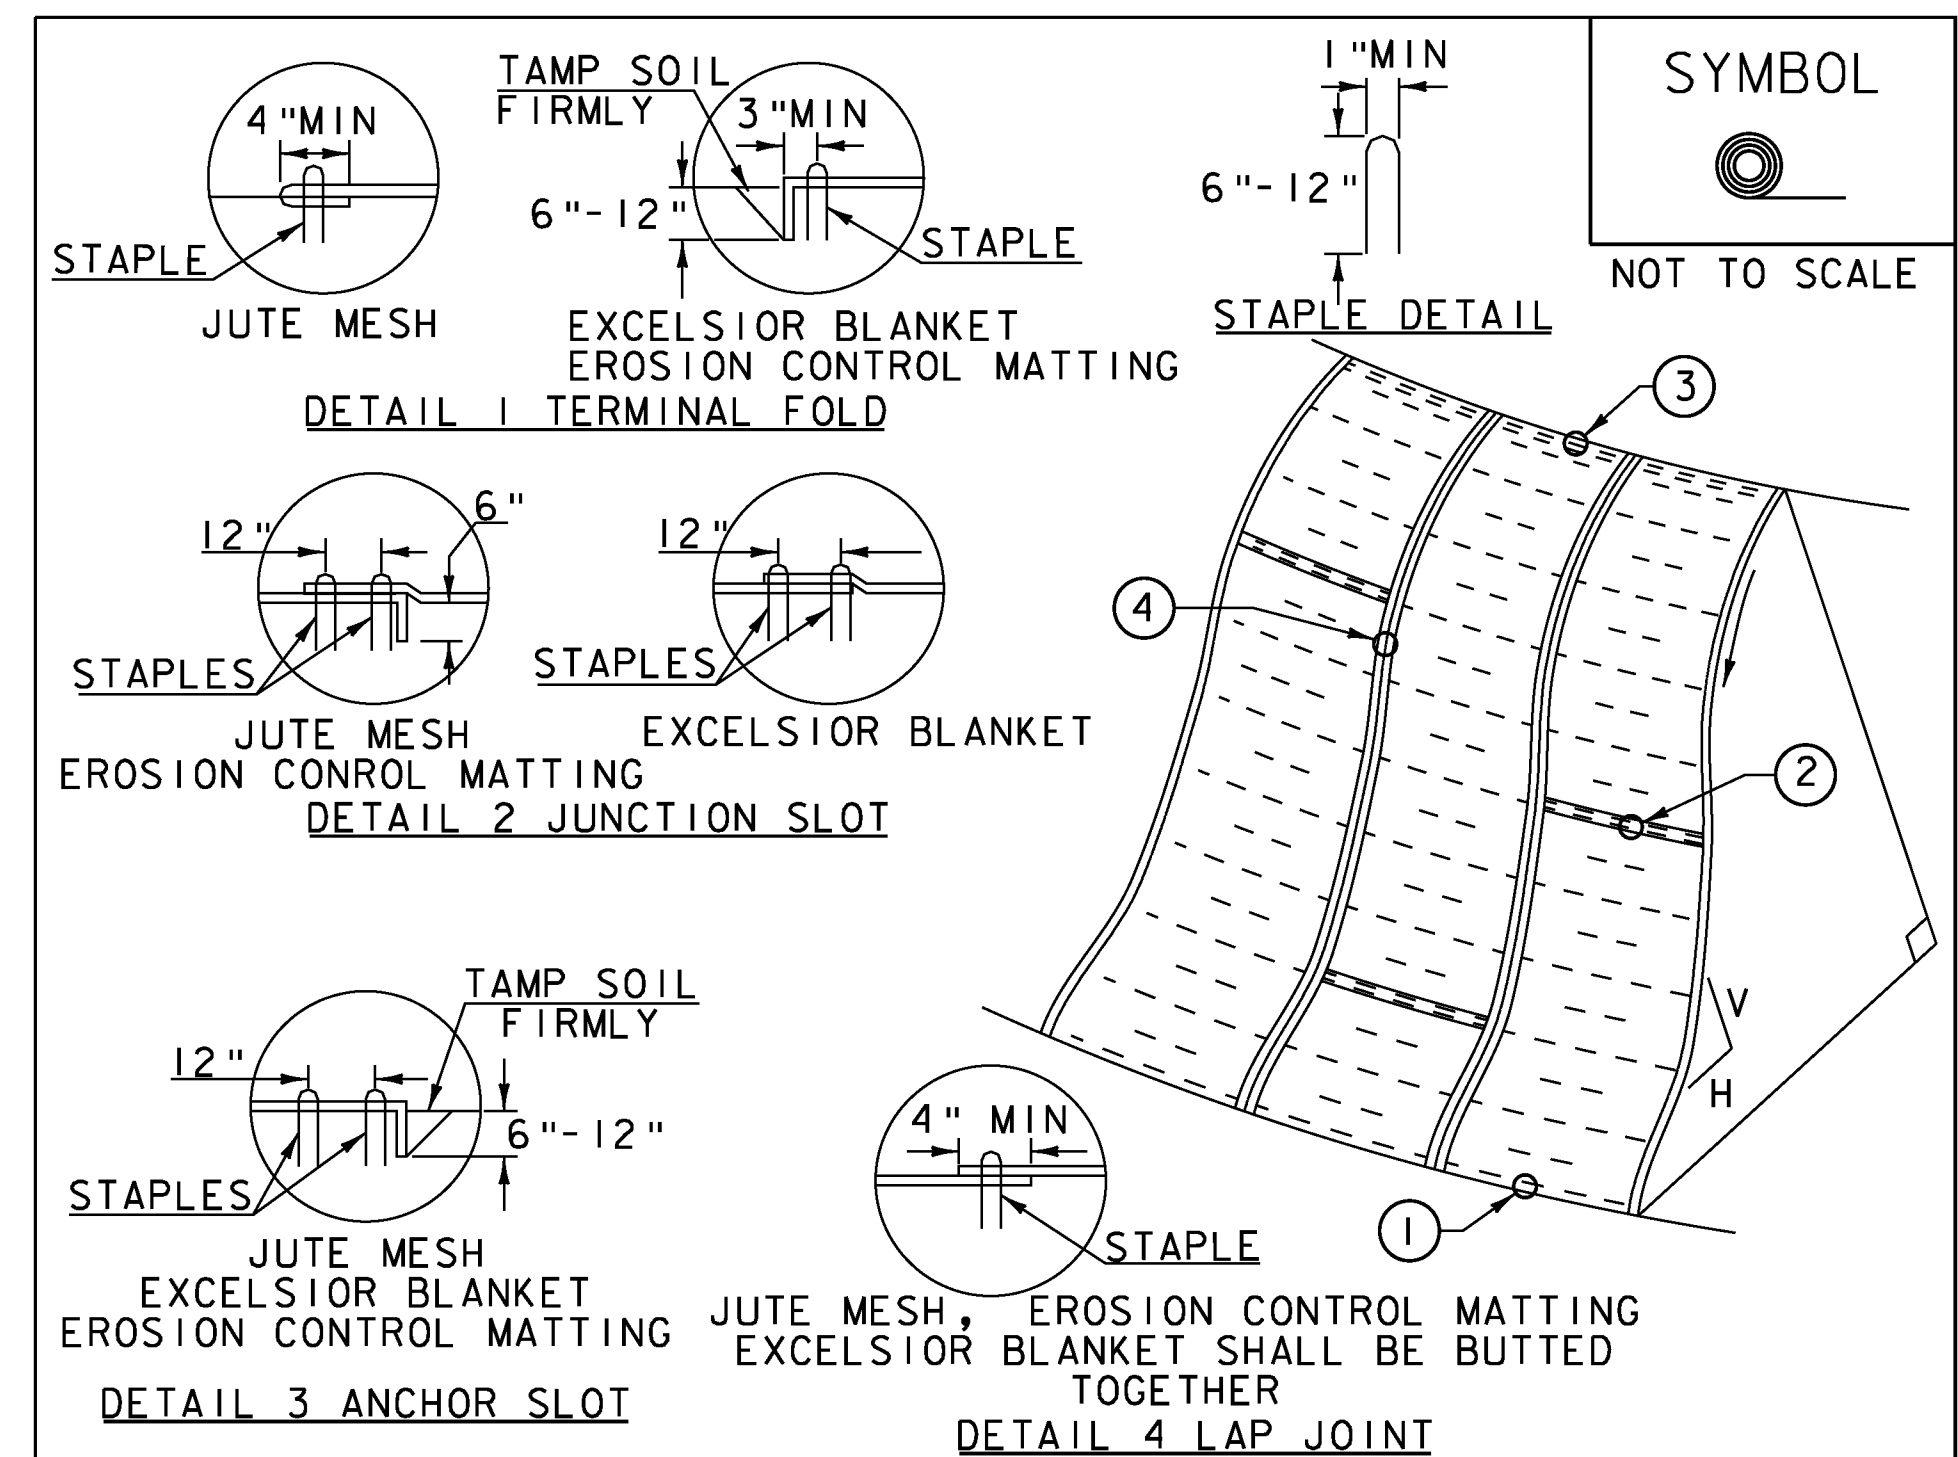

SYMBOL	
[Symbol]	NOT TO SCALE

**CONSTRUCTION SPECIFICATIONS**

- APPLY TO SLOPES GREATER THAN 3H:1V OR WHERE NECESSARY TO AID IN ESTABLISHING VEGETATION.
- APPLY FERTILIZER, LIME SEED PRIOR TO PLACING MATTING.
- STAPLES ARE TO BE PLACED ALTERNATELY, IN COLUMNS APPROXIMATELY 2' APART AND IN ROWS APPROXIMATELY 3' APART. APPROXIMATELY 175 STAPLES ARE REQUIRED PER 4' X 225' ROLL OF MATERIAL AND 125 STAPLES ARE REQUIRED PER 4' X 150' ROLL OF MATERIAL.
- DISTURBED AREAS SHALL BE SMOOTHLY GRADED. EROSION CONTROL MATERIAL SHALL BE PLACED LOOSELY OVER GROUND SURFACE. DO NOT STRETCH.
- ALL TERMINAL ENDS AND TRANSVERSE LAPS SHALL BE STAPLED AT APPROXIMATELY 12" INTERVALS.

ADAPTED FROM DETAILS PROVIDED BY: NEW YORK STATE DEC  
ORIGINALLY DEVELOPED BY USDA-NRCS  
VERMONT DEPARTMENT OF ENVIRONMENTAL CONSERVATION

**ROLLED EROSION CONTROL PRODUCT (RECP) SIDE SLOPE**


NOTES:  
REFER TO "THE VERMONT STANDARDS & SPECIFICATIONS FOR EROSION PREVENTION & SEDIMENT CONTROL -2006-" FROM THE VT AGENCY OF NATURAL RESOURCES FOR ADDITIONAL GUIDANCE.  
THIS WORK SHALL BE PERFORMED IN ACCORDANCE WITH SECTION 653 AND AS SHOWN IN THE PLANS FOR TEMPORARY EROSION MATTING (PAY ITEM 653.20) OR PERMANENT EROSION MATTING (PAY ITEM 653.21).

REVISIONS	
APRIL 16, 2007	JMF
JANUARY 13, 2009	WHF


PROJECT NAME: BRATTLEBORO  
PROJECT NUMBER: BRO 1442(35)

FILE NAME: z10j062details_ero.dgn  
PROJECT LEADER: S.E. BURBANK  
DESIGNED BY: VTRANS  
EROSION CONTROL DETAILS (1 OF 3)

PLOT DATE: 10/14/2013  
DRAWN BY: E.A. FIALA  
CHECKED BY: S.E. BURBANK  
SHEET 64 OF 68

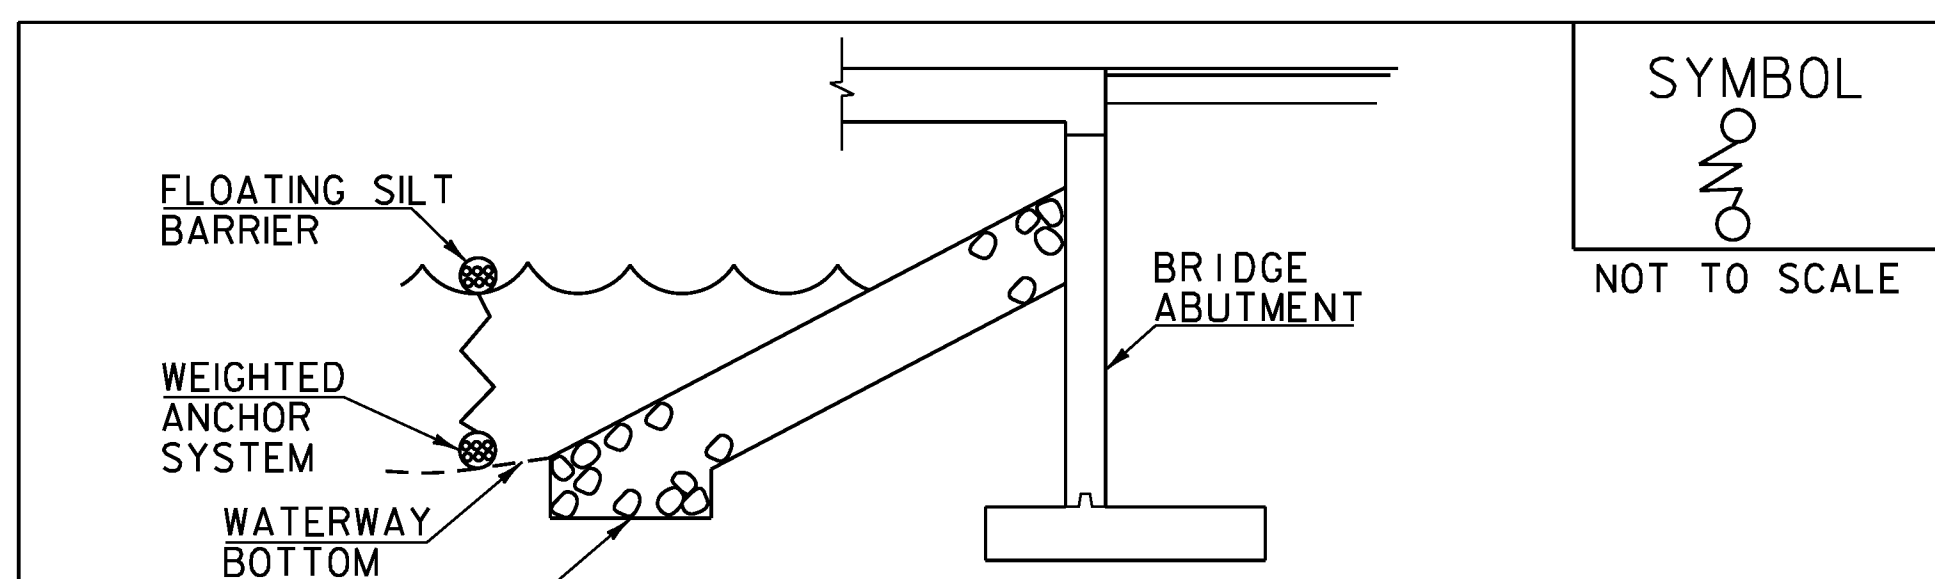

SYMBOL  
  
 NOT TO SCALE

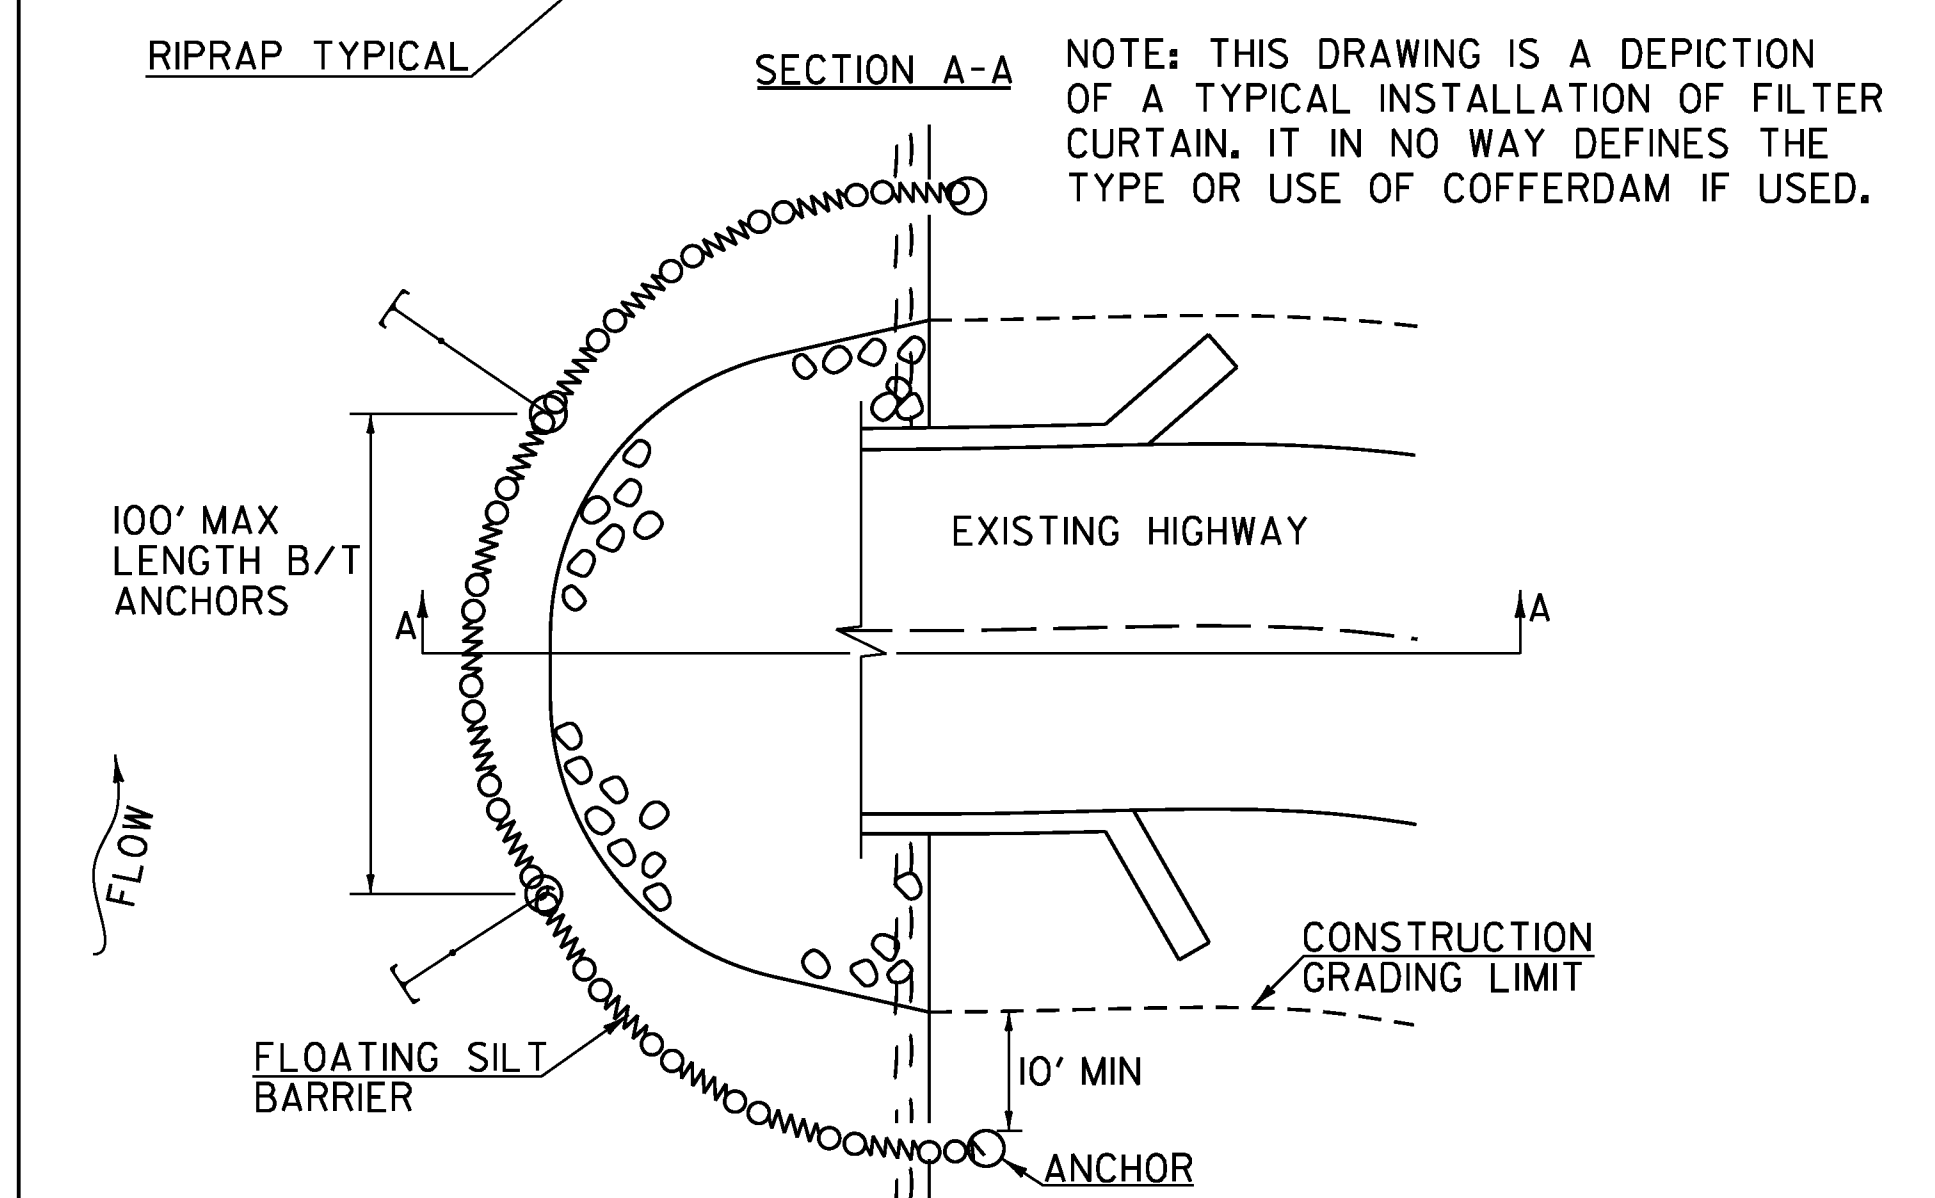


**CONSTRUCTION SPECIFICATIONS**

1. FILTER CURTAIN SHALL NOT BE PLACED ACROSS A FLOWING WATERWAY, OR IN A WATERWAY WITH STREAM VELOCITIES GREATER THAN 1.5 FEET/SECOND.
2. MAXIMUM 100' LENGTH BETWEEN ANCHORS.
3. LAST SECTION SHALL TERMINATE A MINIMUM OF 10' BEYOND LIMIT OF DISTURBANCE.
4. THE WEIGHTED ANCHOR SYSTEM SHALL BE A TYPE WHICH ALLOWS THE CURTAIN TO CONFORM TO THE BOTTOM OF THE WATERWAY.
5. THE CURTAIN SHALL BE REMOVED BY SLOWLY PULLING TOWARD THE SHORE MINIMIZING THE ESCAPE OF SEDIMENTS INTO WATERWAY.

**FILTER CURTAIN**

THIS WORK SHALL BE PERFORMED IN ACCORDANCE WITH SECTION 649 FOR GEOTEXTILE FOR FILTER CURTAIN (PAY ITEM 649.6).

REVISIONS	
APRIL 1, 2008	WHF
JANUARY 13, 2009	WHF
SEPTEMBER 4, 2009	WHF

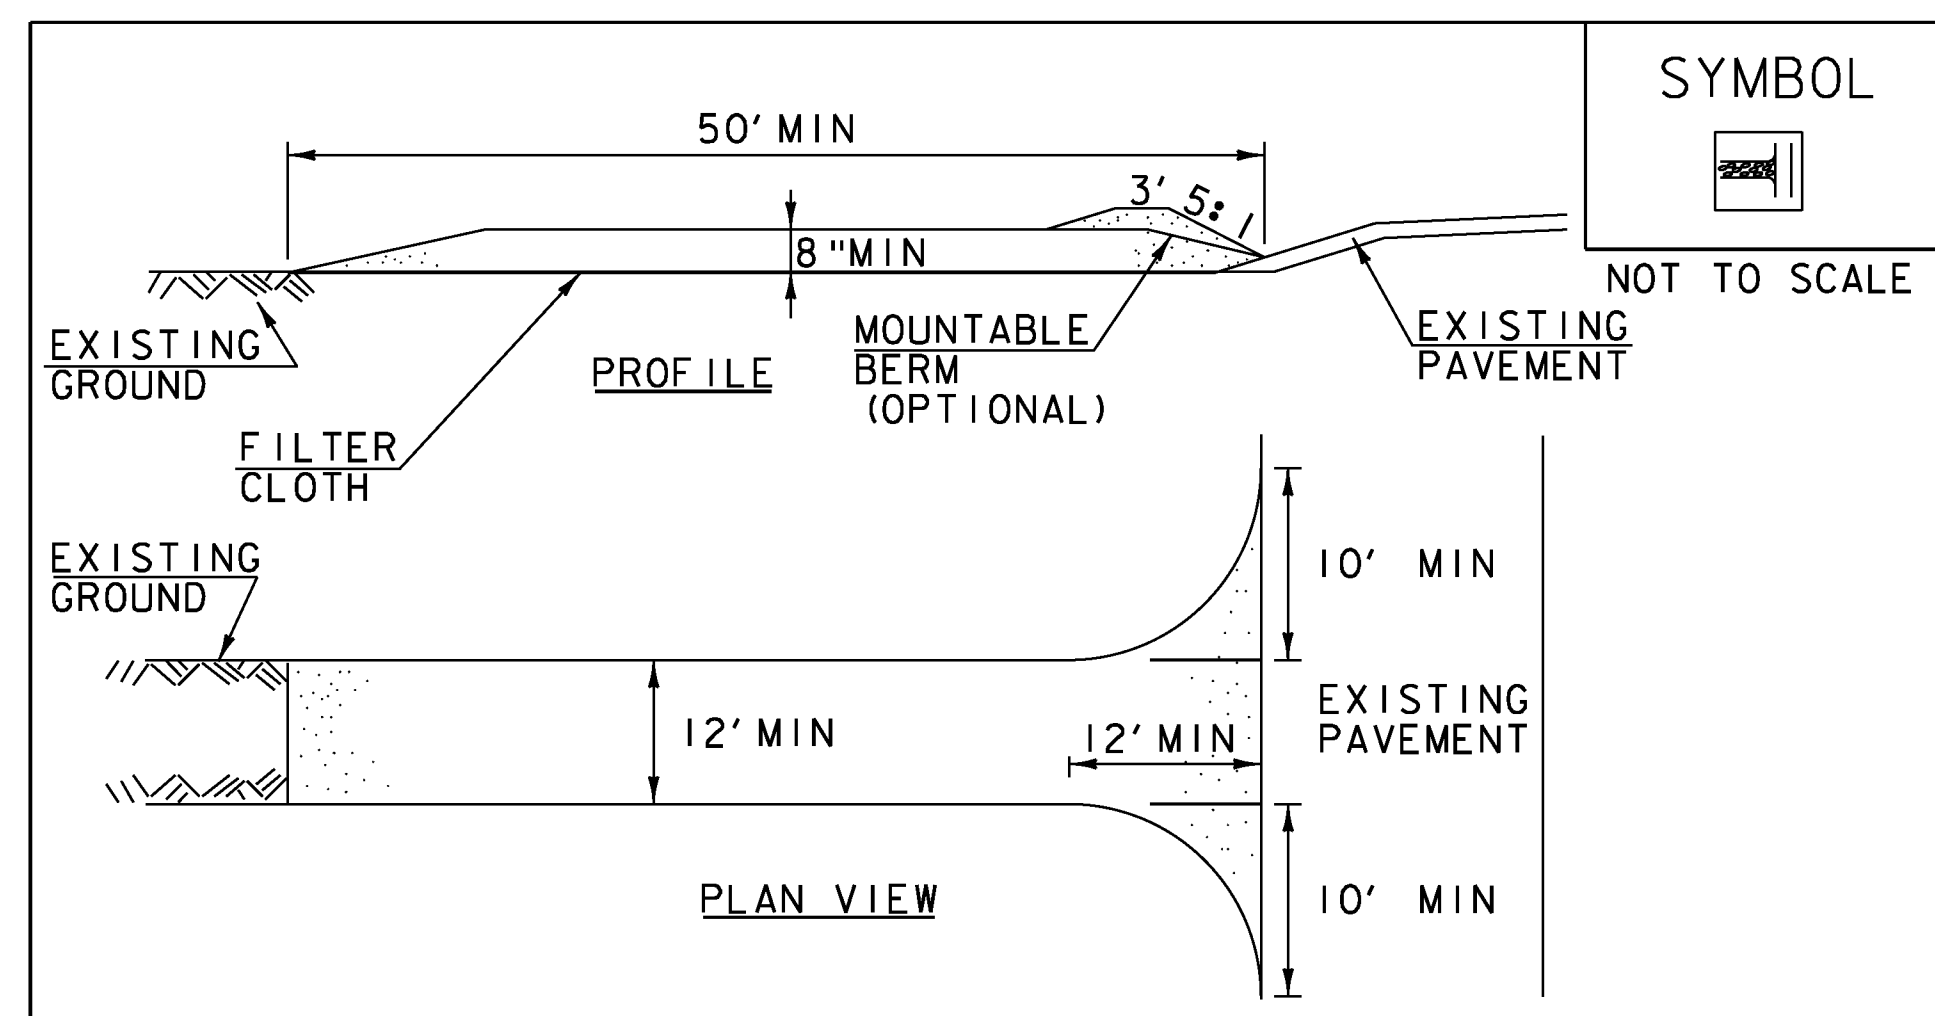

SYMBOL  
  
 NOT TO SCALE

**CONSTRUCTION SPECIFICATIONS**

1. STONE SIZE- USE 1-4" STONE, RECLAIMED OR RECYCLED CONCRETE EQUIVALENT.
2. LENGTH- NOT LESS THAN 50' (EXCEPT ON A SINGLE RESIDENCE LOT WHERE A 30' MINIMUM LENGTH APPLIES).
3. THICKNESS- NOT LESS THAN 8".
4. WIDTH- 12' MINIMUM, BUT NOT LESS THAN THE FULL WIDTH AT POINTS WHERE INGRESS OR EGRESS OCCURS. 24" IF SINGLE ENTRANCE TO SITE.
5. GEOTEXTILE MUST BE PLACED OVER THE ENTIRE AREA PRIOR TO PLACING STONE.
6. SURFACE WATER- ALL SURFACE WATER FLOWING OR DIVERTED TOWARD CONSTRUCTION ENTRANCES SHALL BE PIPED BENEATH THE ENTRANCE. IF PIPING IS IMPRACTICAL, A MOUNTABLE BERM WITH 5:1 SLOPES WILL BE PERMITTED.
7. MAINTENANCE- THE ENTRANCE SHALL BE MAINTAINED IN A CONDITION WHICH WILL PREVENT TRACKING OR FLOWING OF SEDIMENT ONTO PUBLIC RIGHTS-OF-WAY, ALL SEDIMENT SPILLED, DROPPED, WASHED OR TRACKED ONTO PUBLIC RIGHTS-OF-WAY MUST BE REMOVED IMMEDIATELY.
8. WHEN WASHING IS REQUIRED, IT SHALL BE DONE ON AN AREA STABILIZED WITH STONE AND WHICH DRAINS INTO AN APPROVED SEDIMENT TRAPPING DEVICE.
9. PERIODIC INSPECTION AND NEEDED MAINTENANCE SHALL BE PROVIDED ACCORDING TO PERMIT REQUIREMENTS.


ADAPTED FROM DETAILS PROVIDED BY: NEW YORK STATE DEC  
 ORIGINALLY DEVELOPED BY USDA-NRCS  
 VERMONT DEPARTMENT OF ENVIRONMENTAL CONSERVATION

**STABILIZED CONSTRUCTION ENTRANCE**

NOTES:  
 REFER TO "THE VERMONT STANDARDS & SPECIFICATIONS FOR EROSION PREVENTION & SEDIMENT CONTROL -2006- " FROM THE VT AGENCY OF NATURAL RESOURCES FOR ADDITIONAL GUIDANCE.


THIS WORK SHALL BE PERFORMED IN ACCORDANCE WITH SECTION 653 FOR VEHICLE TRACKING PAD (PAY ITEM 653.35) OR AS SPECIFIED IN THE CONTRACT.

REVISIONS	
MARCH 24, 2008	WHF
JANUARY 13, 2009	WHF

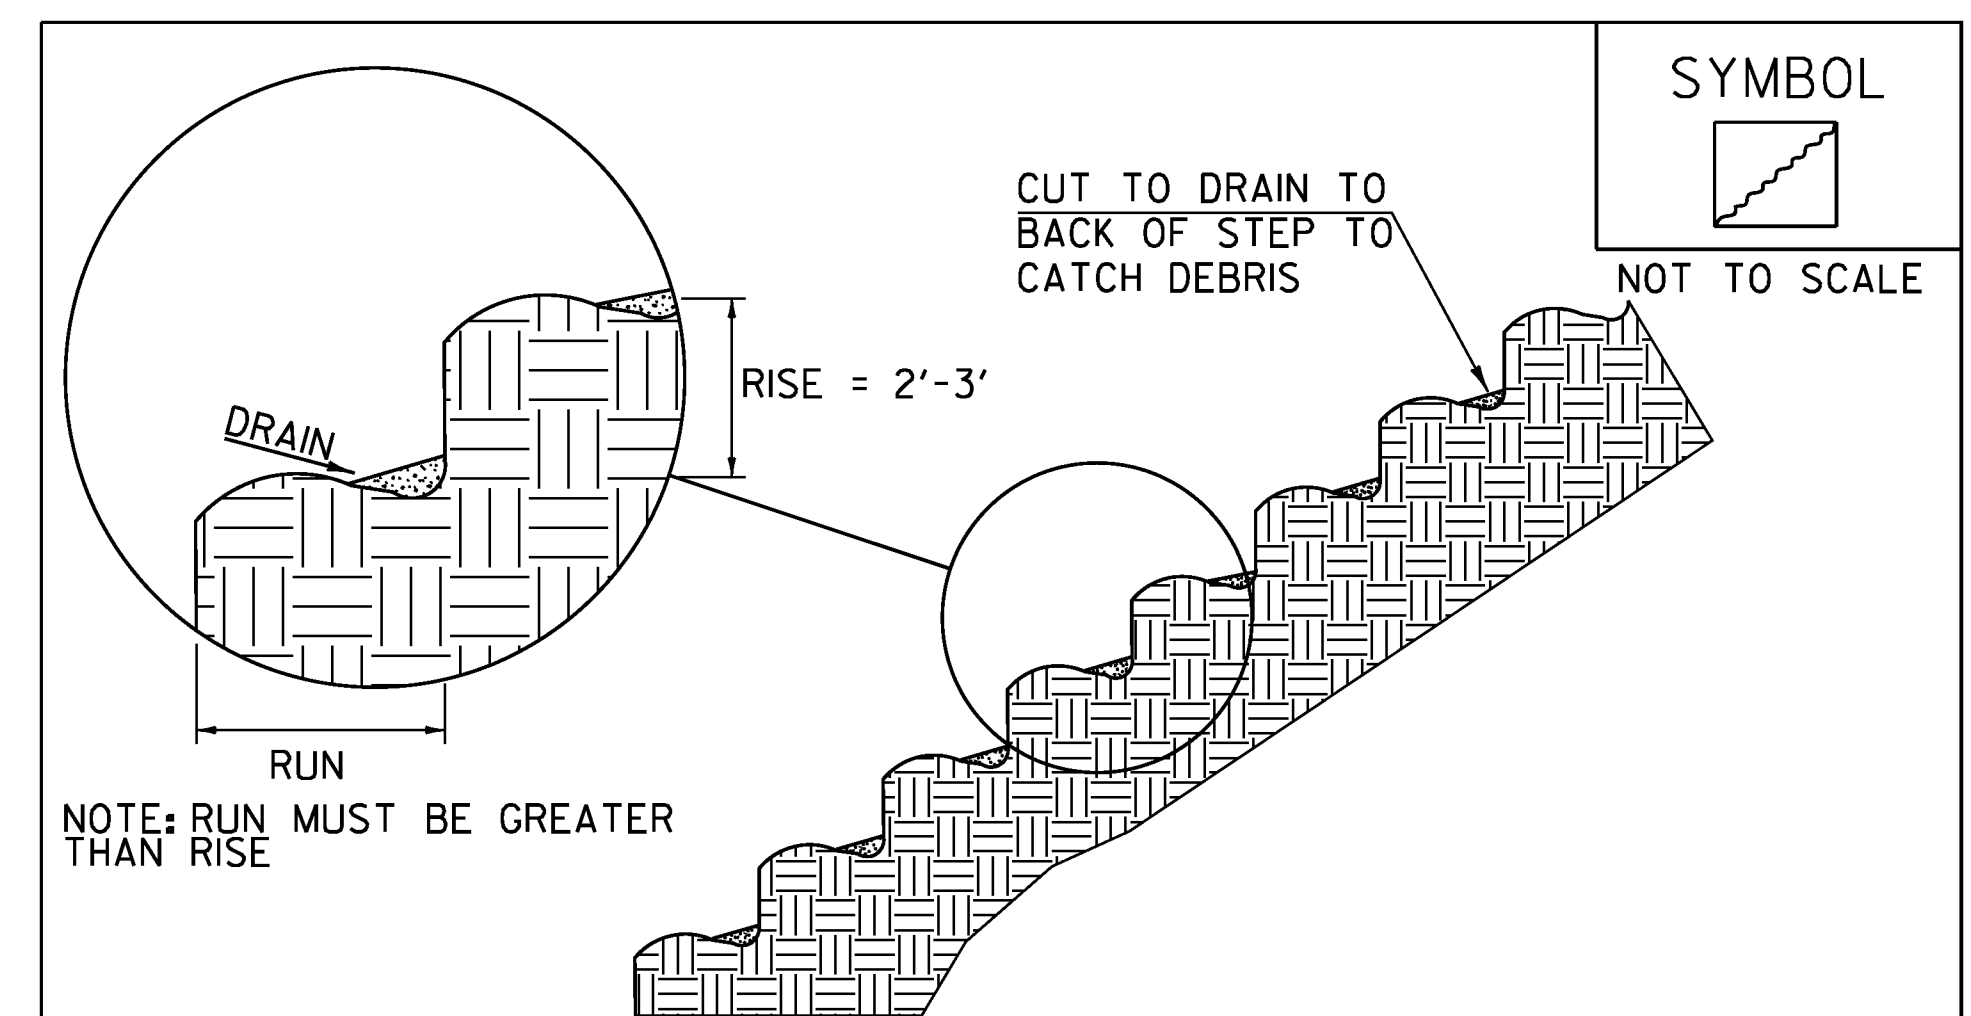

SYMBOL  
  
 NOT TO SCALE

**STAIR STEPPING CUT SLOPES**

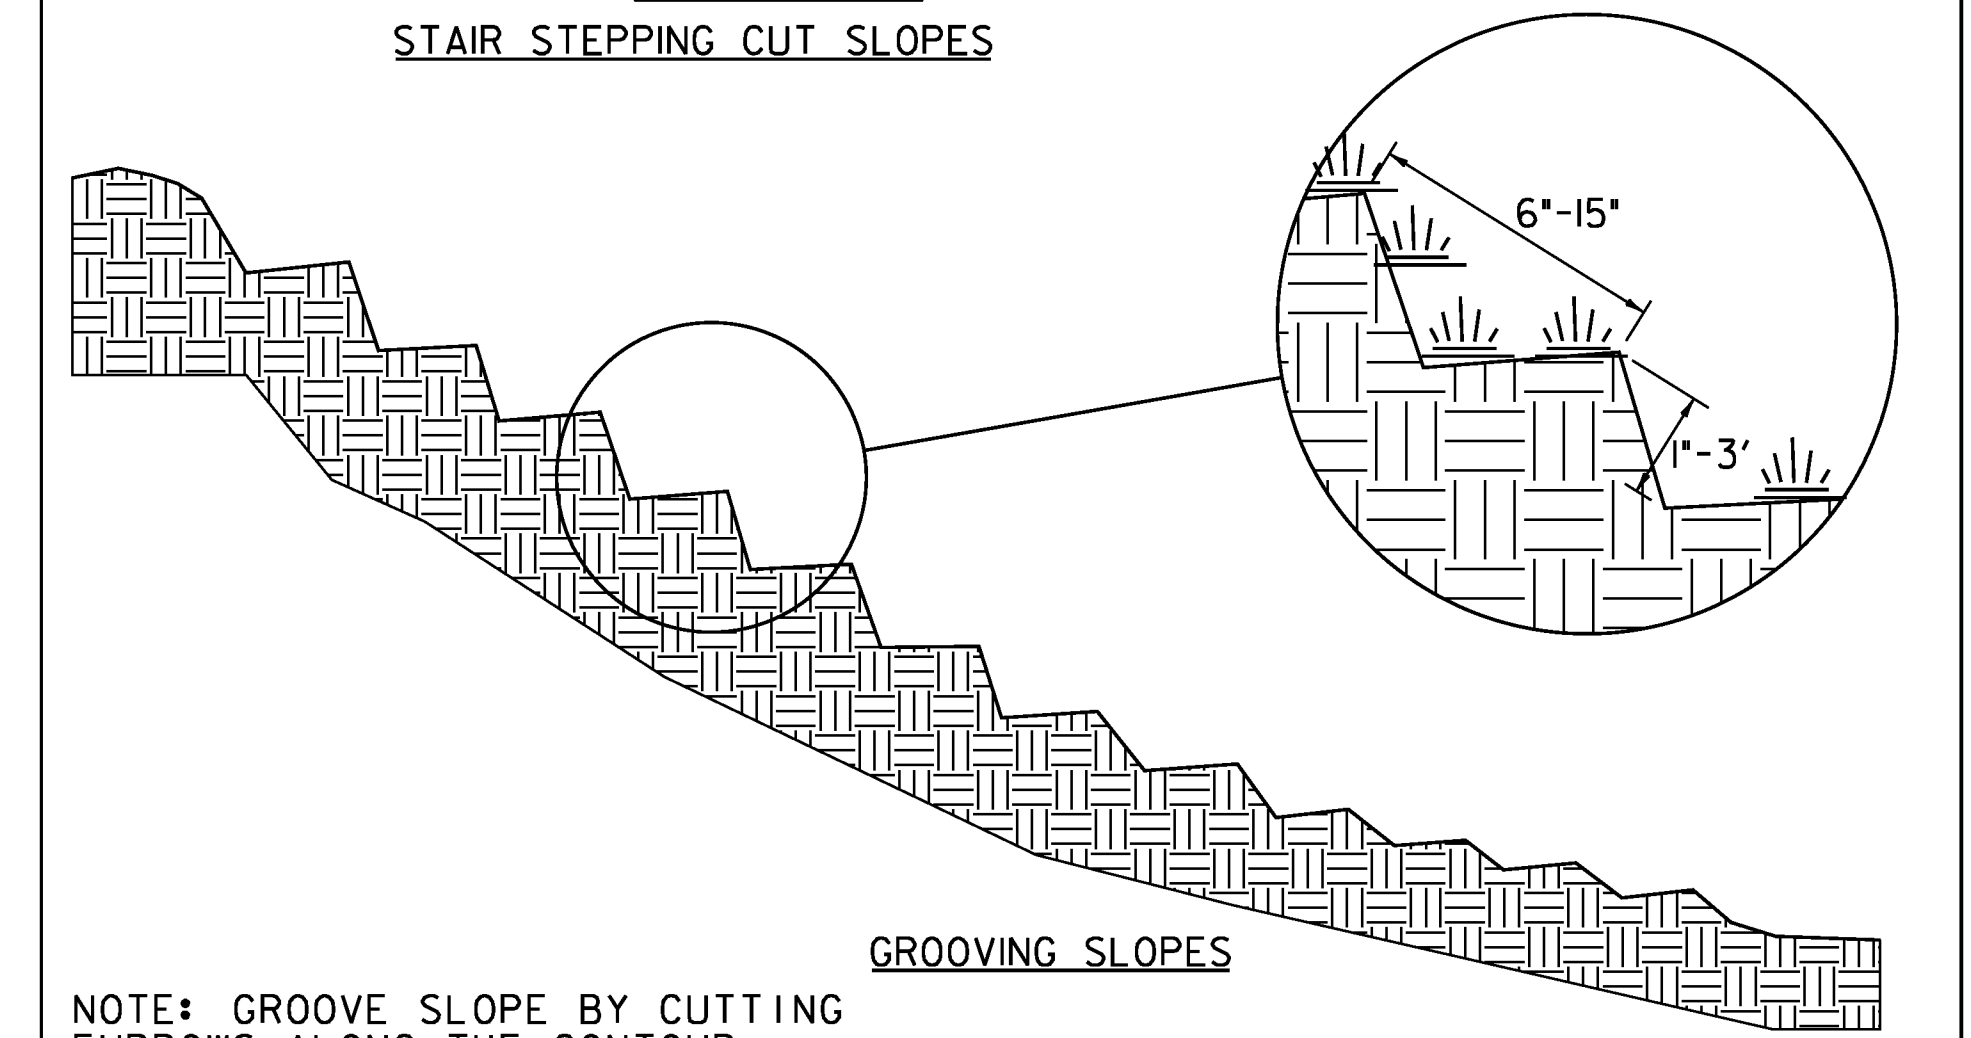

**GROOVING SLOPES**

NOTE: GROOVE SLOPE BY CUTTING FURROWS ALONG THE CONTOUR. IRREGULARITIES IN THE SOIL SURFACE CATCH RAINWATER AND RETAIN LIME, FERTILIZER AND SEED.

ADAPTED FROM DETAILS PROVIDED BY: NEW YORK STATE DEC  
 ORIGINALLY DEVELOPED BY USDA-NRCS  
 VERMONT DEPARTMENT OF ENVIRONMENTAL CONSERVATION

**SURFACE ROUGHENING**

NOTES:  
 REFER TO "THE VERMONT STANDARDS & SPECIFICATIONS FOR EROSION PREVENTION & SEDIMENT CONTROL -2006- " FROM THE VT AGENCY OF NATURAL RESOURCES FOR ADDITIONAL GUIDANCE.

THIS WORK SHALL BE CONSIDERED INCIDENTAL TO THE CONTRACT


REVISIONS	
APRIL 1, 2008	WHF
JANUARY 13, 2009	WHF

PROJECT NAME: BRATTLEBORO  
 PROJECT NUMBER: BRO 1442(35)

FILE NAME: z10j062details_ero.dgn  
 PROJECT LEADER: S.E. BURBANK  
 DESIGNED BY: VTRANS  
 EROSION CONTROL DETAILS (2 OF 3)

PLOT DATE: 10/14/2013  
 DRAWN BY: E.A. FIALA  
 CHECKED BY: S.E. BURBANK  
 SHEET 65 OF 68



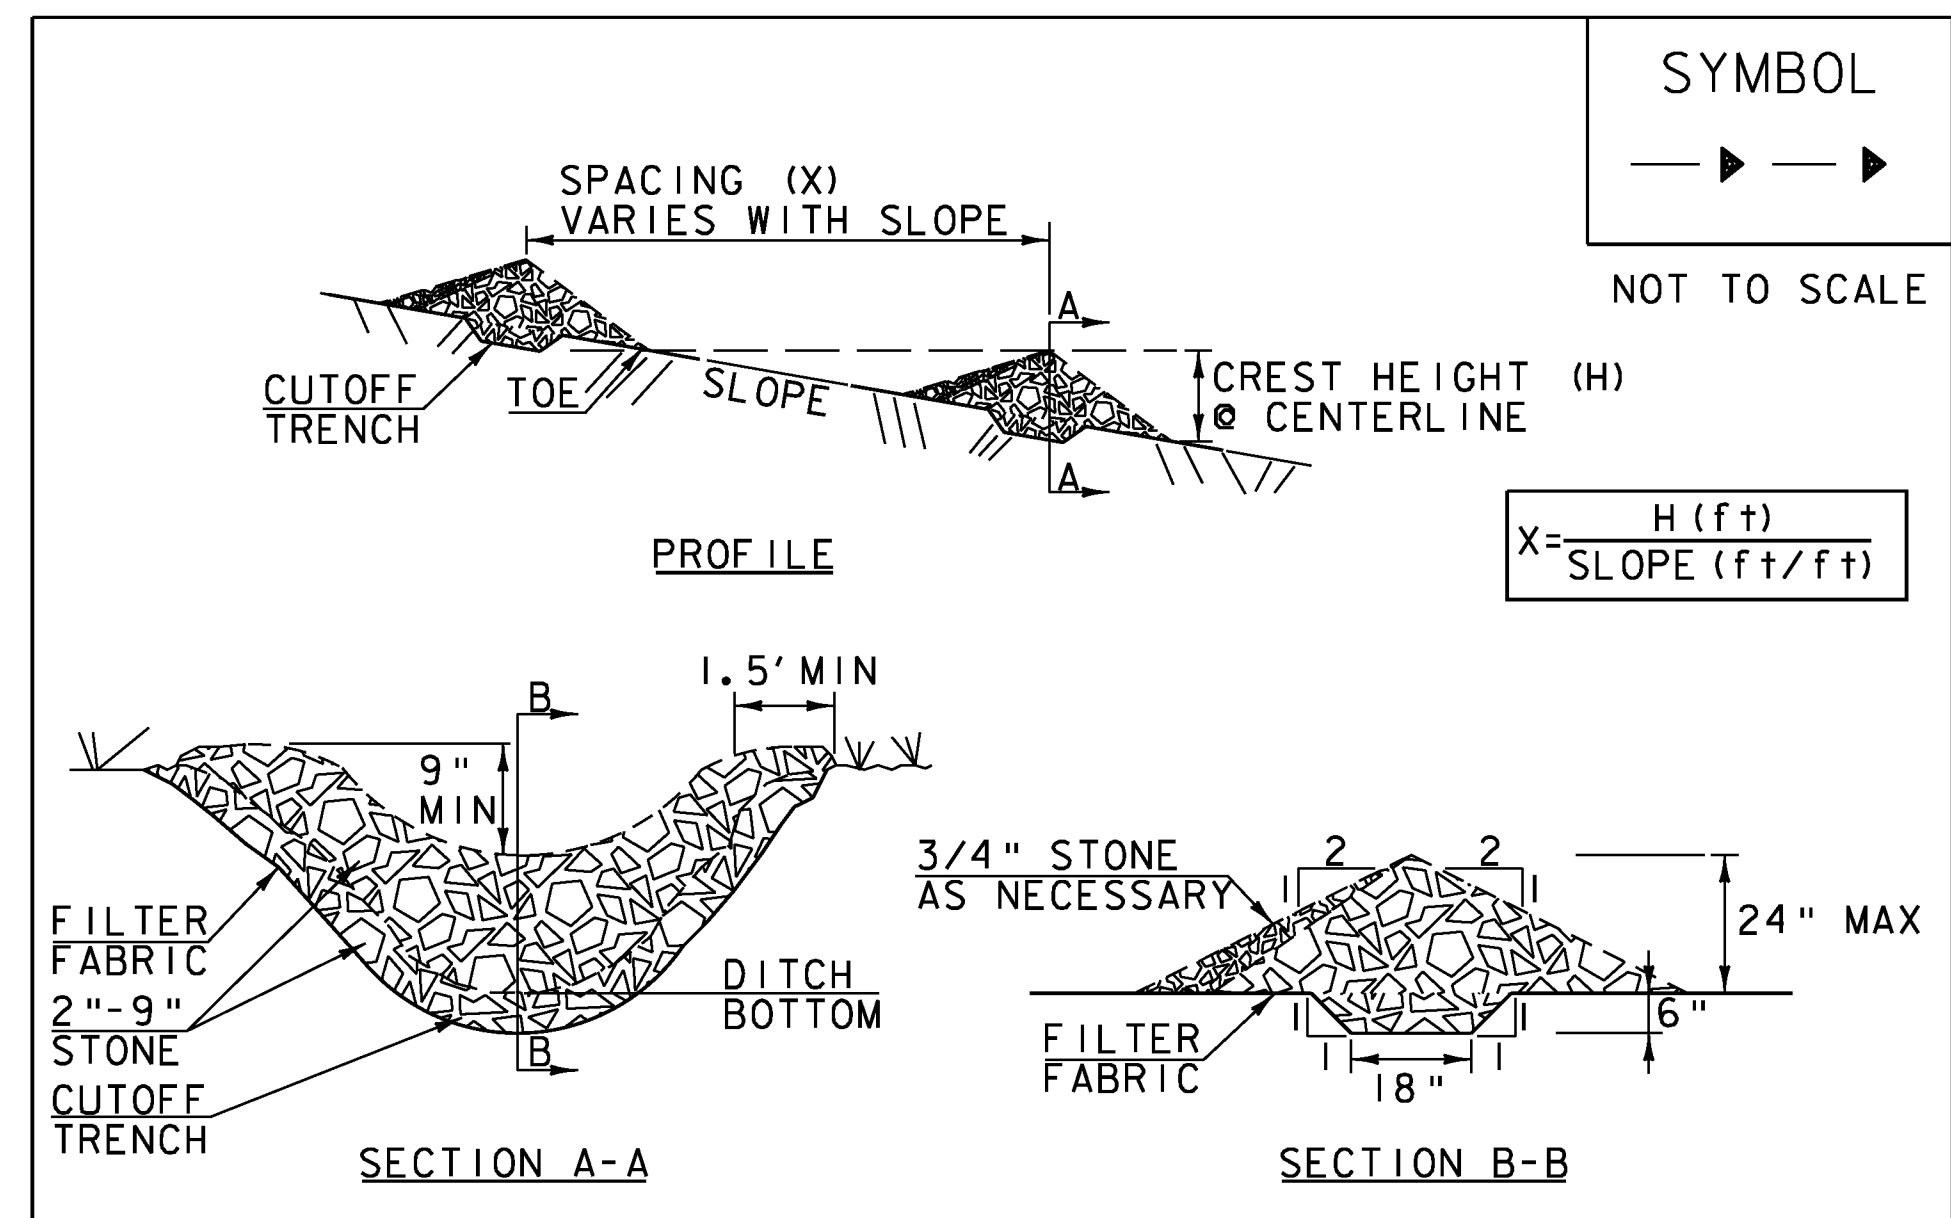

**CONSTRUCTION SPECIFICATIONS**

1. STONE WILL BE PLACED ON A FILTER FABRIC FOUNDATION.
2. CHECK DAMS SHALL BE SPACED SO THAT THE ELEVATION OF THE CREST OF THE DOWNSTREAM DAM IS AT THE SAME ELEVATION AS THE TOE OF THE UPSTREAM DAM.
3. 3/4" FILTERING STONE MAY BE ADDED TO THE FACE OF THE CHECK DAM AS NECESSARY.
4. EXTEND THE STONE A MINIMUM OF 1.5' BEYOND THE DITCH BANKS TO PREVENT CUTTING AROUND THE DAM.
5. PROTECT CHANNEL DOWNSTREAM OF THE LOWEST CHECK DAM FROM SCOUR AND EROSION WITH STONE OR LINER AS APPROPRIATE.
6. ENSURE THAT CHANNEL APPURTENANCES SUCH AS CULVERT ENTRANCES BELOW CHECK DAMS ARE NOT SUBJECT TO DAMAGE OR BLOCKAGE FROM DISPLACED STONE.
7. MAXIMUM DRAINAGE AREA 2 ACRES.

ADAPTED FROM DETAILS PROVIDED BY: NEW YORK STATE DEC ORIGINALLY DEVELOPED BY USDA-NRCS VERMONT DEPARTMENT OF ENVIRONMENTAL CONSERVATION	<b>CHECK DAM</b>
-----------------------------------------------------------------------------------------------------------------------------------------------	------------------


NOTES:  
 REFER TO "THE VERMONT STANDARDS & SPECIFICATIONS FOR EROSION PREVENTION & SEDIMENT CONTROL -2006-" FROM THE VT AGENCY OF NATURAL RESOURCES FOR ADDITIONAL GUIDANCE.  
  
 THIS WORK SHALL BE PERFORMED IN ACCORDANCE WITH SECTION 653 FOR TEMPORARY STONE CHECK DAM, TYPE 1(PAY ITEM 653.25)

REVISIONS	
MARCH 21, 2008	WHF
JANUARY 8, 2009	WHF

PROJECT NAME: BRATTLEBORO	PLOT DATE: 10/14/2013
PROJECT NUMBER: BRO 1442(35)	DRAWN BY: E.A. FIALA
FILE NAME: z10j062details_ero.dgn	DESIGNED BY: VTRANS
PROJECT LEADER: S.E. BURBANK	EROSION CONTROL DETAILS (3 OF 3)
CHECKED BY: S.E. BURBANK	SHEET 66 OF 68





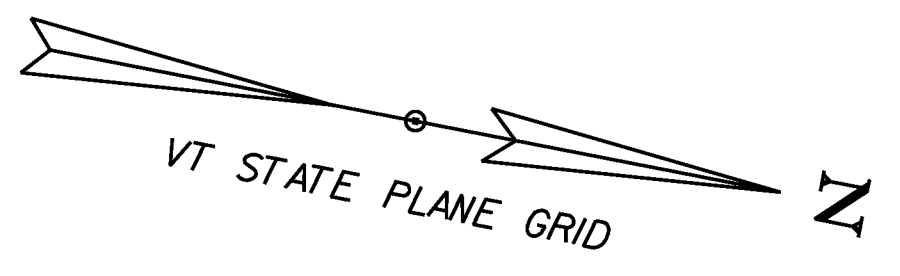

STEEL BEAM GUARDRAIL, GALV.  
 STA. 102+00 - 102+12, RT  
 STA. 103+20, 38.4' LT - 103+34, 44.5' LT  
 STA. 103+25 - 103+36, RT  
 STA. 104+63 - 104+76, LT

CONSTRUCT 11.5' PAVED APRON  
 STA. 102+69, LT - 41.5' WIDE

CONSTRUCT 12' PAVED DRIVE  
 STA. 103+59, RT - 12' WIDE

REMOVAL AND DISPOSAL OF GUARDRAIL  
 STA. 102+43 - 102+73, RT  
 STA. 102+92 - 102+96, LT  
 STA. 103+03 - 103+27, RT  
 STA. 103+31 - 104+46, LT

GUARDRAIL APPROACH SECTION, GALVANIZED  
 HD STEEL BEAM W/8 FEET POSTS

STA. 102+18 - 102+43, RT  
 STA. 102+92, 24.58' LT - 102+88, LT  
 STA. 104+08 - 104+33, LT

RELOCATE MAILBOX, MULTIPLE SUPPORT  
 STA. 102+39, RT

RELOCATE MAILBOX, SINGLE SUPPORT  
 STA. 103+83, RT

STEEL BEAM GUARDRAIL,  
 GALVANIZED W/8 FEET POSTS

STA. 102+12 - 102+18, RT  
 STA. 102+92, 24.58' LT - 103+20, 38.4' LT  
 STA. 104+33 - 104+63, LT

ANCHOR FOR STEEL BEAM RAIL  
 STA. 102+06, RT  
 STA. 103+25, 40.75' LT  
 STA. 103+30, RT  
 STA. 104+69, LT

**END R.O.W. PROJECT**  
**BRO 1442 (35)**  
**STA. 104+89.02**  
**25.83' RT.**

COLD PLANING, BITUMINOUS PAVEMENT  
 STA. 101+35 - 101+55, LT & RT  
 STA. 105+25 - 105+45, LT & RT

SPECIAL PROVISION (BRIDGE  
 RAILING, GALVANIZED HDSB/FASCIA  
 MOUNTED/STEEL TUBING)

STA. 102+43 - 103+25, RT  
 STA. 102+88 +3904908, LT

N 134835.91 FT  
 E 1607460.82 FT  
 STA 100+00.00  
 24.75' LT.


BEGIN PROJECT  
 STA. 101+80.00

BEGIN APPROACH  
 STA. 101+35.00  
 MATCH EXISTING

BEGIN BRIDGE  
 STA. 102+79.42  
 F.G. = 541.09

END PROJECT  
 STA. 105+00.00

END APPROACH  
 STA. 105+45.00  
 MATCH EXISTING

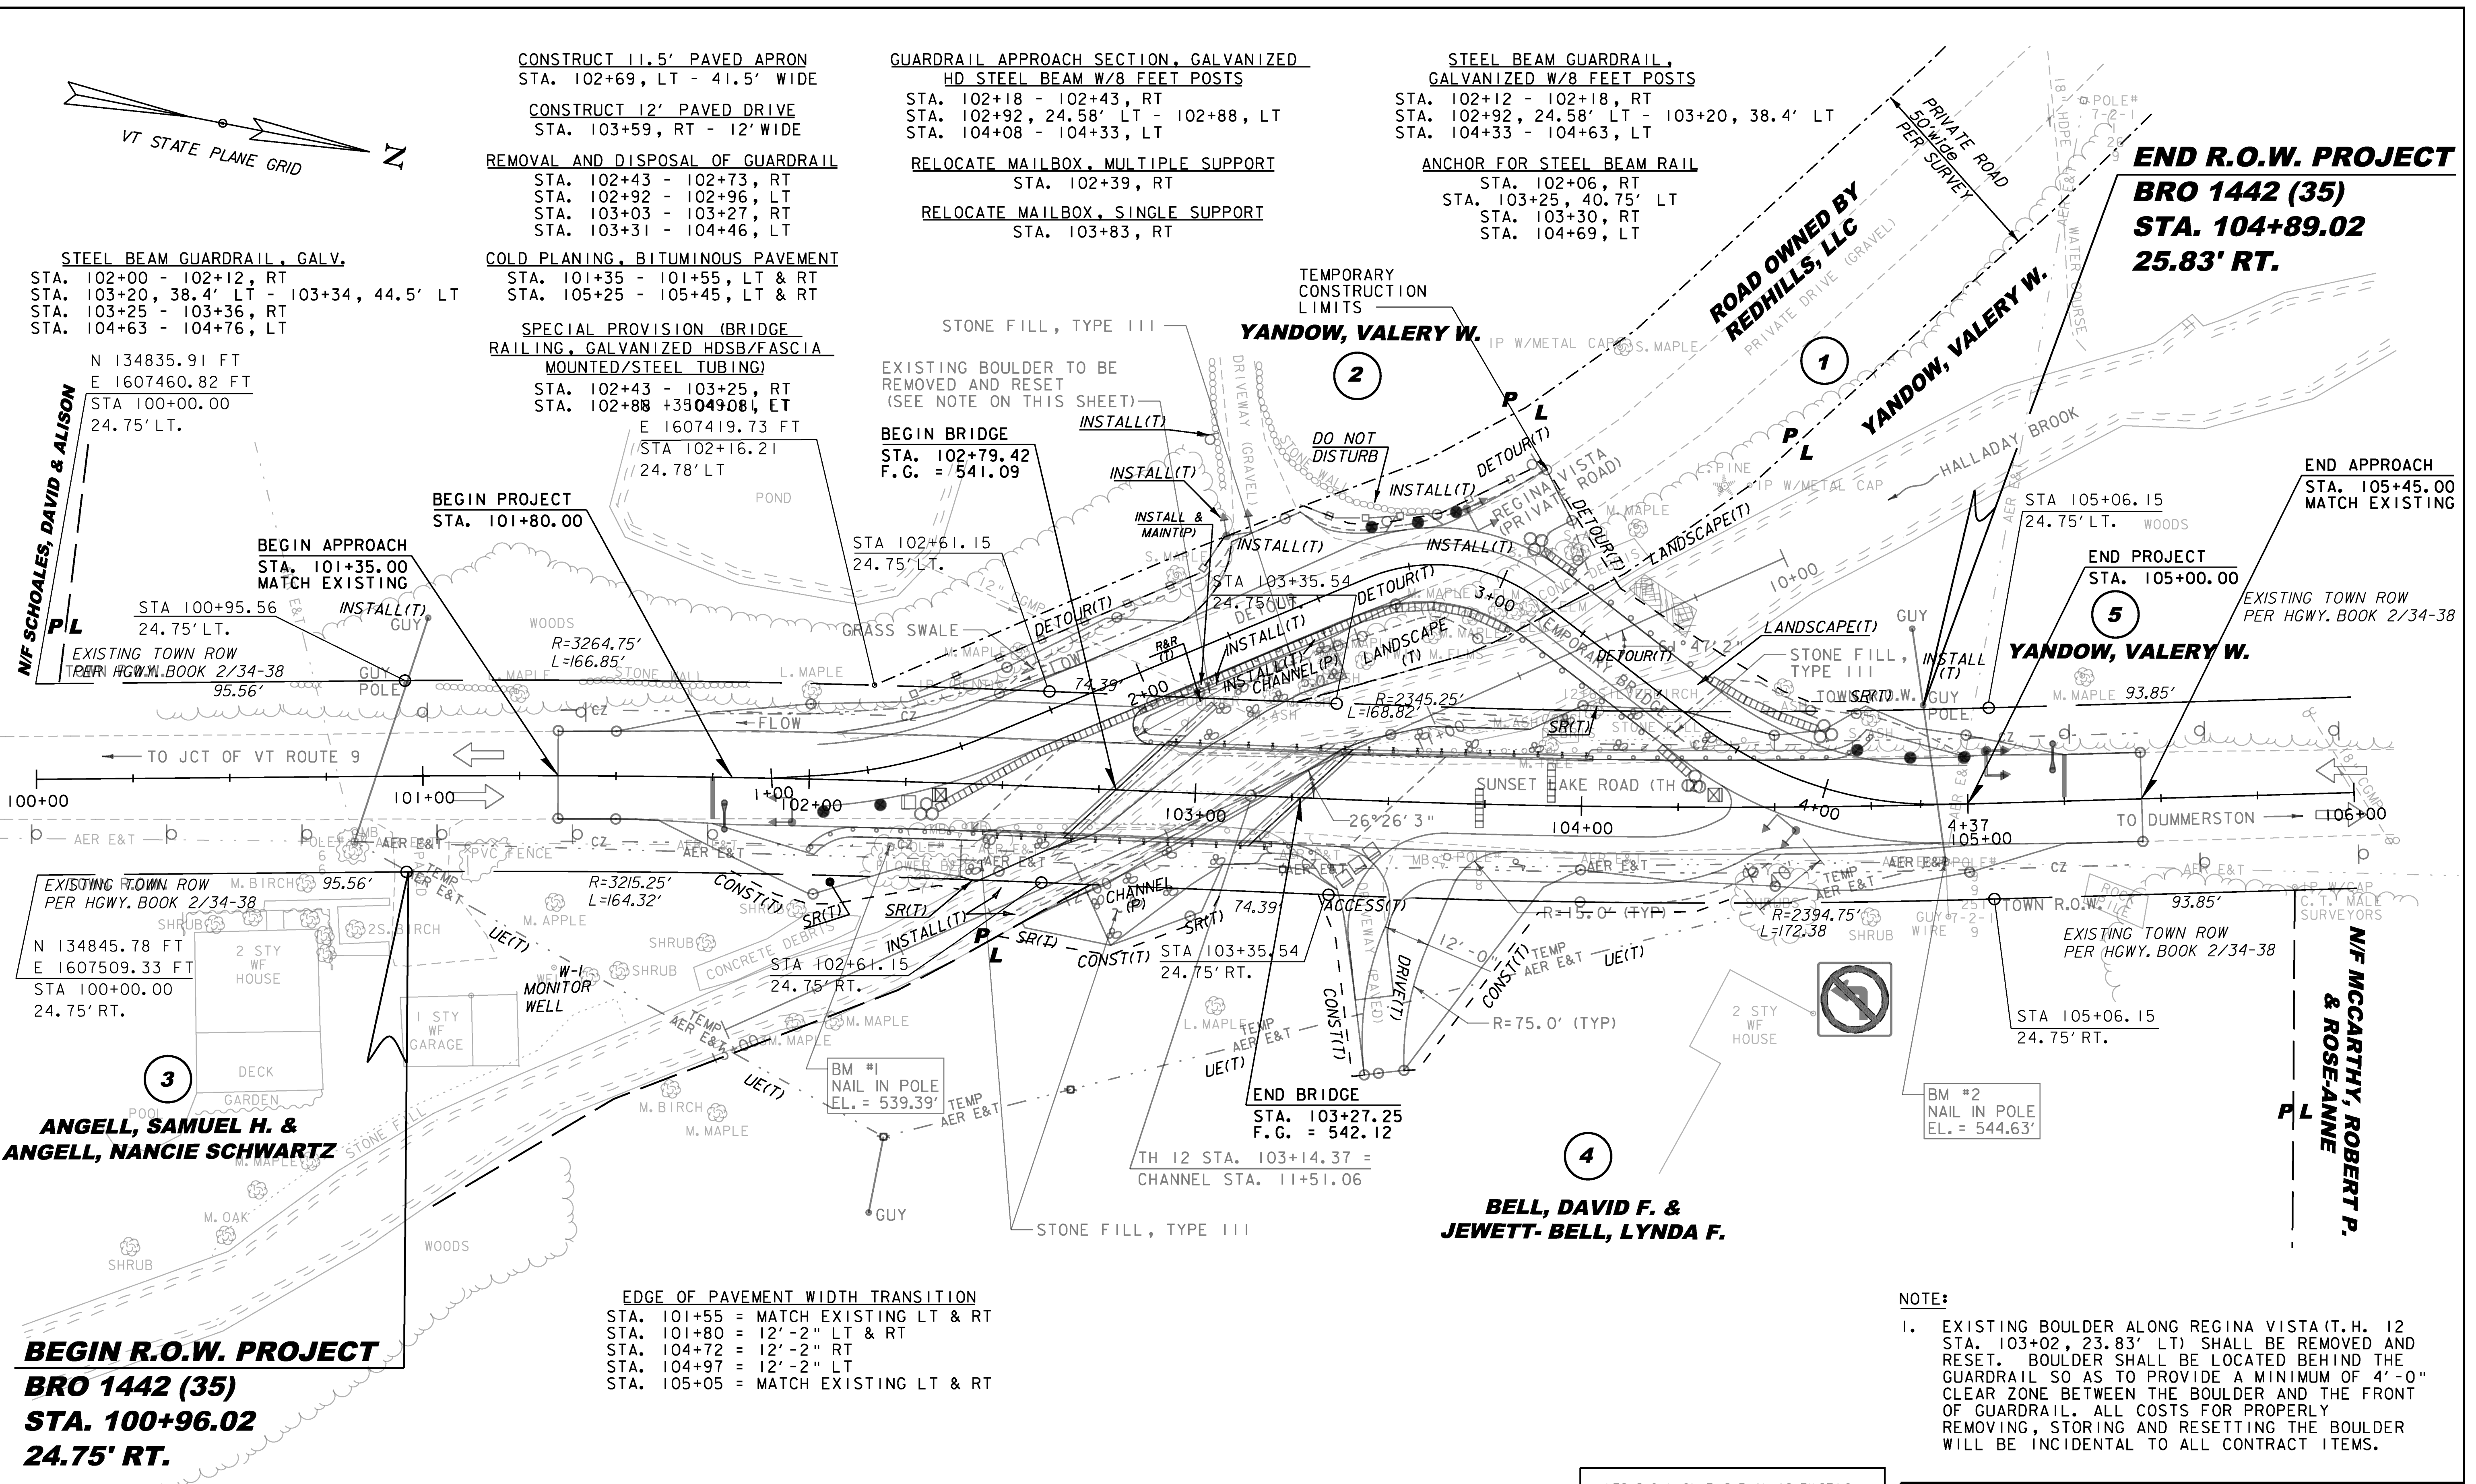

EXISTING TOWN ROW  
 PER HWY. BOOK 2/34-38  
 N 134845.78 FT  
 E 1607509.33 FT  
 STA 100+00.00  
 24.75' RT.

**BEGIN R.O.W. PROJECT**  
**BRO 1442 (35)**  
**STA. 100+96.02**  
**24.75' RT.**

EDGE OF PAVEMENT WIDTH TRANSITION  
 STA. 101+55 = MATCH EXISTING LT & RT  
 STA. 101+80 = 12'-2" LT & RT  
 STA. 104+72 = 12'-2" RT  
 STA. 104+97 = 12'-2" LT  
 STA. 105+05 = MATCH EXISTING LT & RT

SCALE 1" = 20'-0"  
 20 0 20

LINES SHOWN ON THIS PLAN AS EXISTING  
 PROPERTY LINES P/L ARE BELIEVED TO  
 BE ACCURATE BUT SHOULD NOT BE RELIED  
 UPON FOR PURPOSES UNRELATED TO THE  
 STATE OF VERMONT'S ACQUISITION OF LAND  
 AND RIGHTS FOR THIS PROJECT.

NOTE:  
 1. EXISTING BOULDER ALONG REGINA VISTA (T.H. 12  
 STA. 103+02, 23.83' LT) SHALL BE REMOVED AND  
 RESET. BOULDER SHALL BE LOCATED BEHIND THE  
 GUARDRAIL SO AS TO PROVIDE A MINIMUM OF 4'-0"  
 CLEAR ZONE BETWEEN THE BOULDER AND THE FRONT  
 OF GUARDRAIL. ALL COSTS FOR PROPERLY  
 REMOVING, STORING AND RESETTING THE BOULDER  
 WILL BE INCIDENTAL TO ALL CONTRACT ITEMS.

PROJECT NAME: BRATTLEBORO  
 PROJECT NUMBER: BRO 1442(35)


FILE NAME: NAME#DGN  
 PROJECT LEADER: M. CHANETTE  
 DESIGNED BY: S.E. BURBANK  
 ROW LAYOUT SHEET 1 OF 1

PLOT DATE: 10/14/2013  
 DRAWN BY: B. FERLAZO  
 CHECKED BY: H. PETROVS  
 SHEET 68 OF 68

**FOR R.O.W.  
 USE ONLY**


**CONCRETE GENERAL NOTES**

- ALL EXPOSED EDGES OF CONCRETE SHALL BE CHAMFERED 1" x 1"

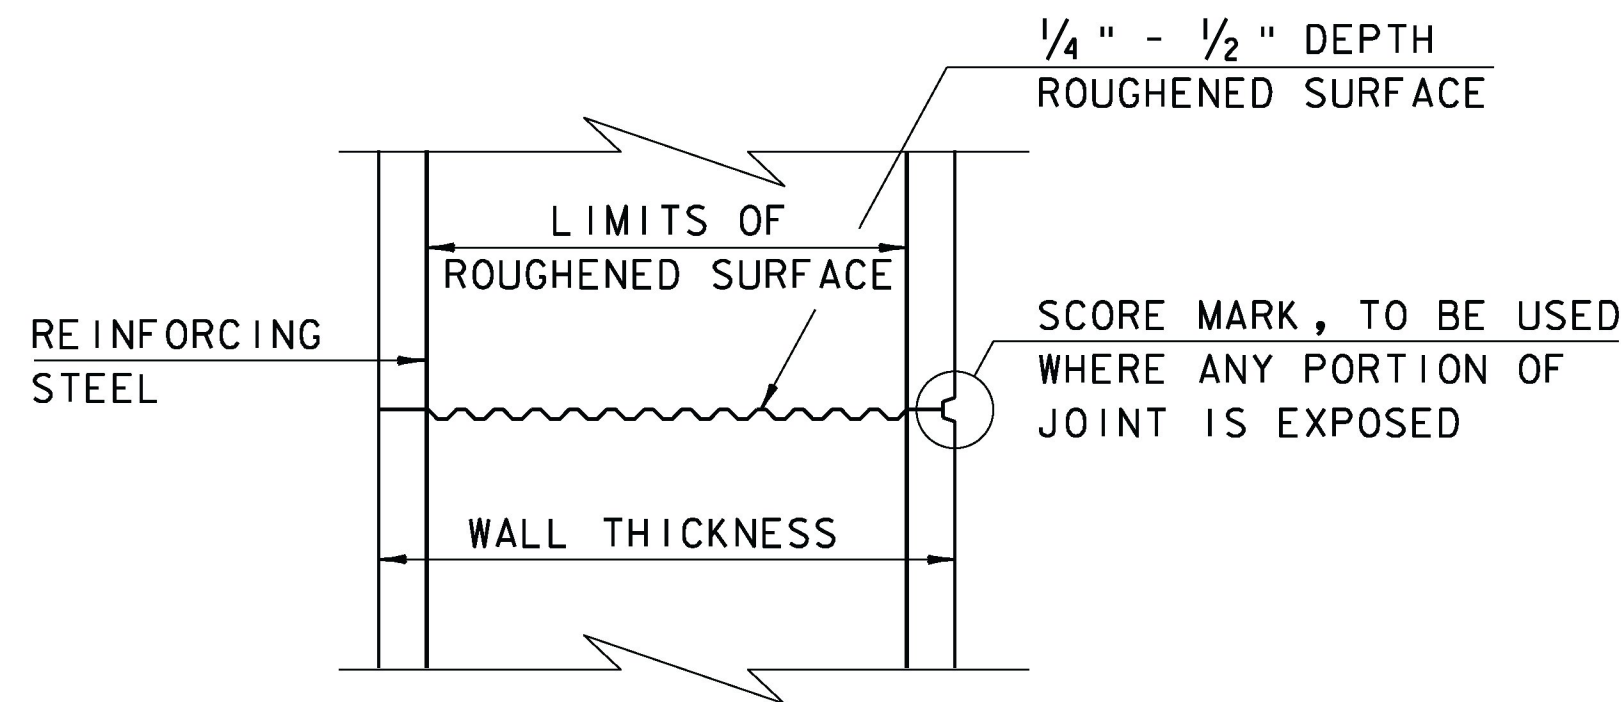


**TYPICAL HORIZONTAL CONSTRUCTION JOINT**  
(NOT TO SCALE)


- THE SURFACE OF THE CONCRETE CONSTRUCTION JOINTS SHALL BE CLEANED AND FREE OF LAITANCE.
- IMMEDIATELY BEFORE NEW CONCRETE IS PLACED, ALL CONSTRUCTION JOINTS SHALL BE WETTED AND STANDING WATER REMOVED.

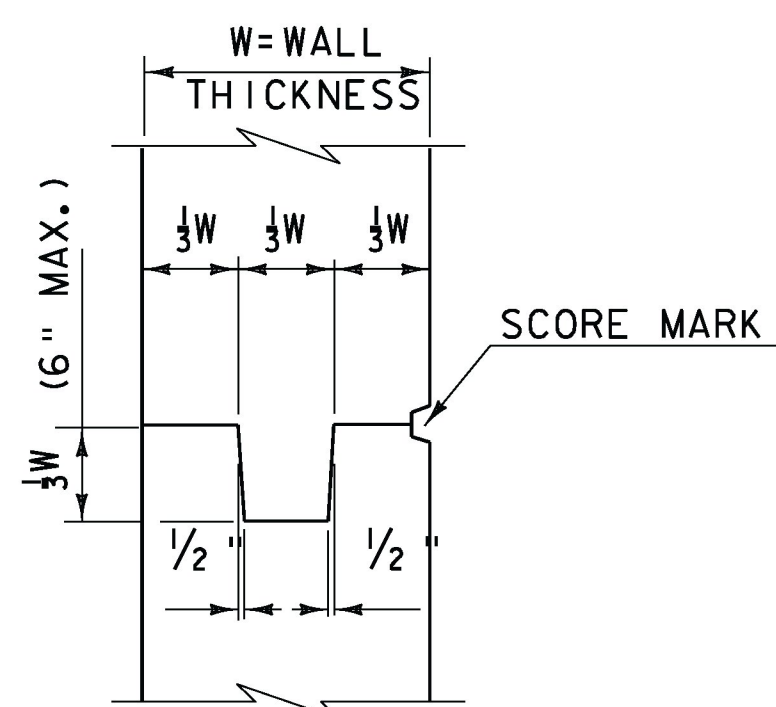


**TYPICAL CONCRETE CONSTRUCTION JOINT**  
(NOT TO SCALE)

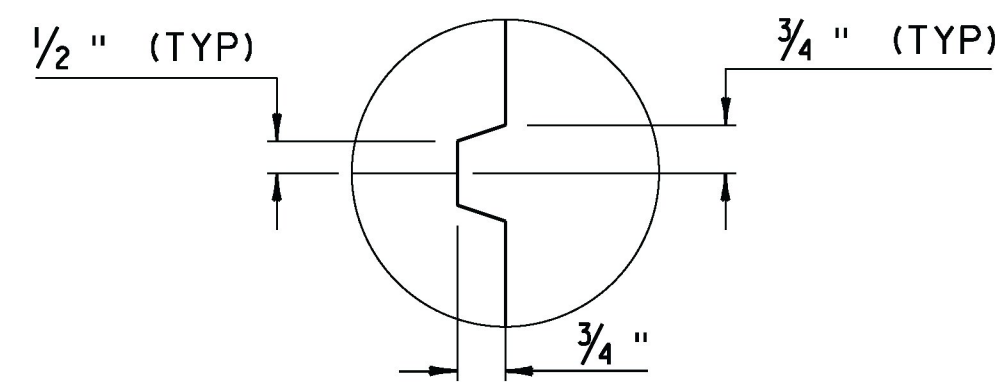

**SCORE MARK DETAIL**  
(NOT TO SCALE)

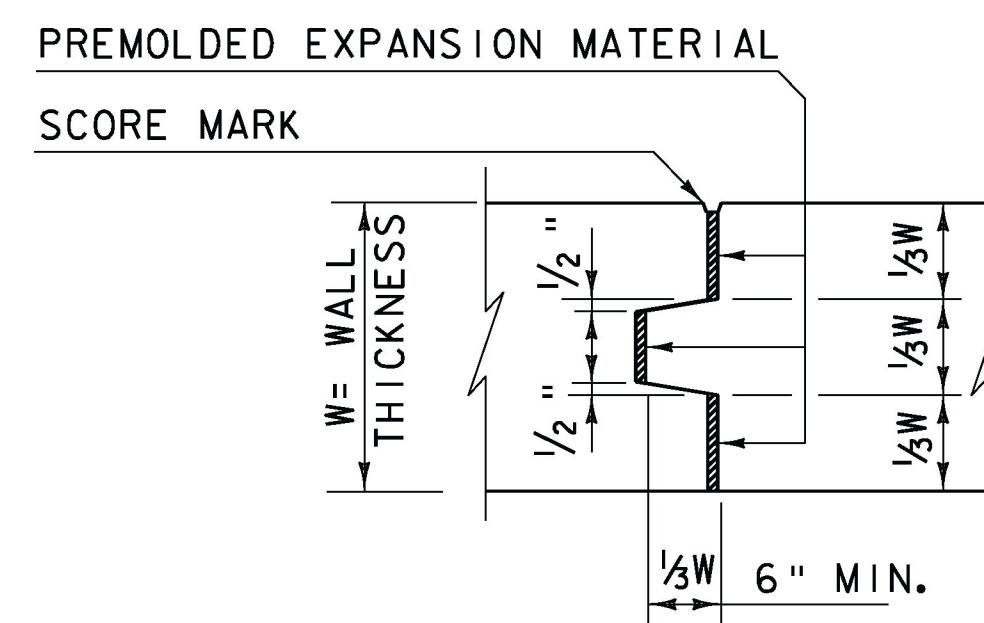

**TYPICAL CONCRETE EXPANSION JOINT**  
(NOT TO SCALE)

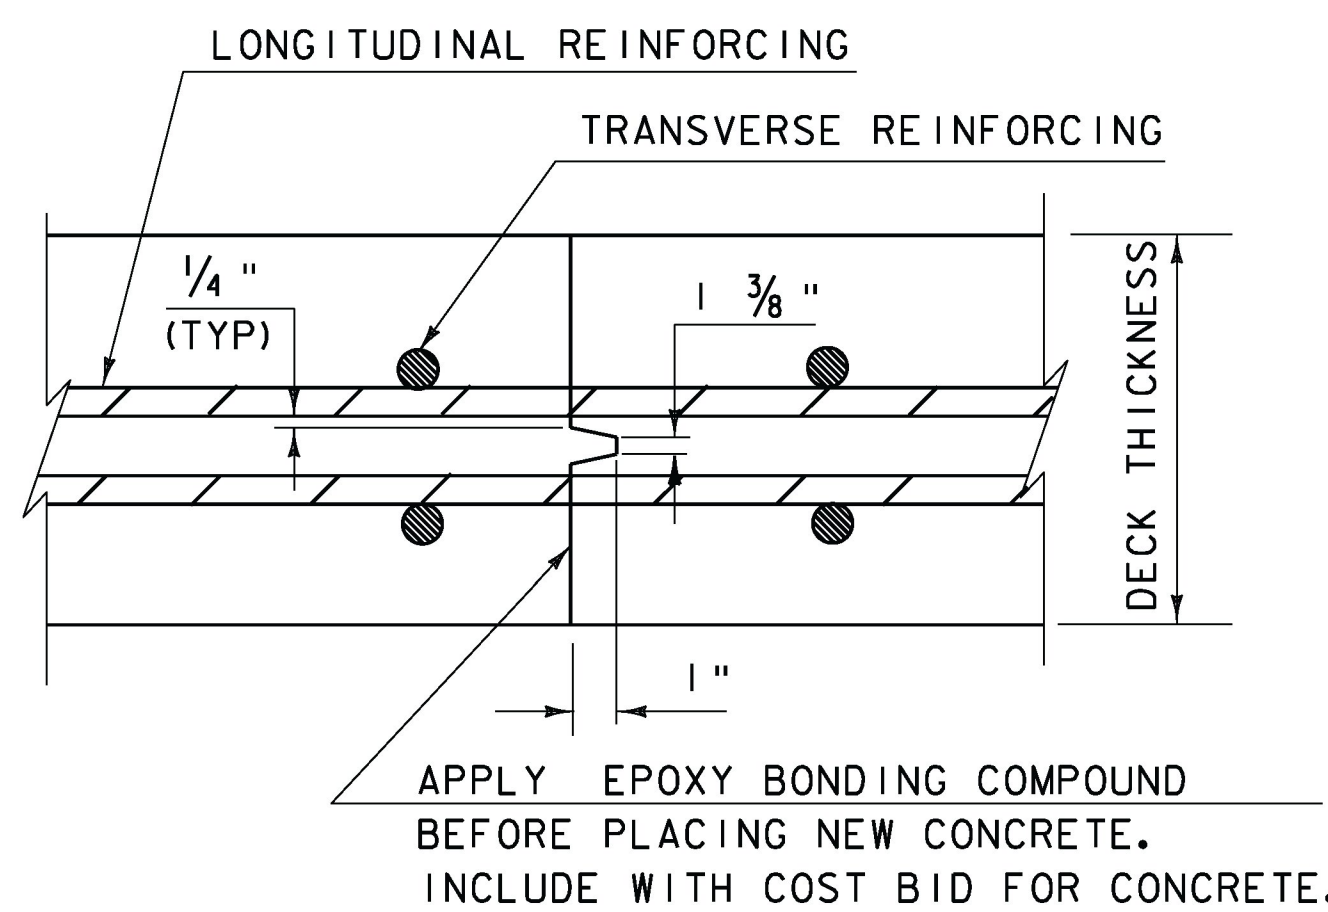


**TRANSVERSE BRIDGE SLAB CONSTRUCTION JOINT DETAILS**  
(NOT TO SCALE)



**P.V.C. WATERSTOP FOR CONSTRUCTION JOINTS**  
(NOT TO SCALE)

PAYMENT FOR THE P.V.C. WATERSTOP SHALL BE INCIDENTAL TO THE UNIT BID PRICE FOR THE ADJACENT CONCRETE.


OTHER CONFIGURATIONS OF WATERSTOP MAY BE USED UPON APPROVAL OF THE ENGINEER.

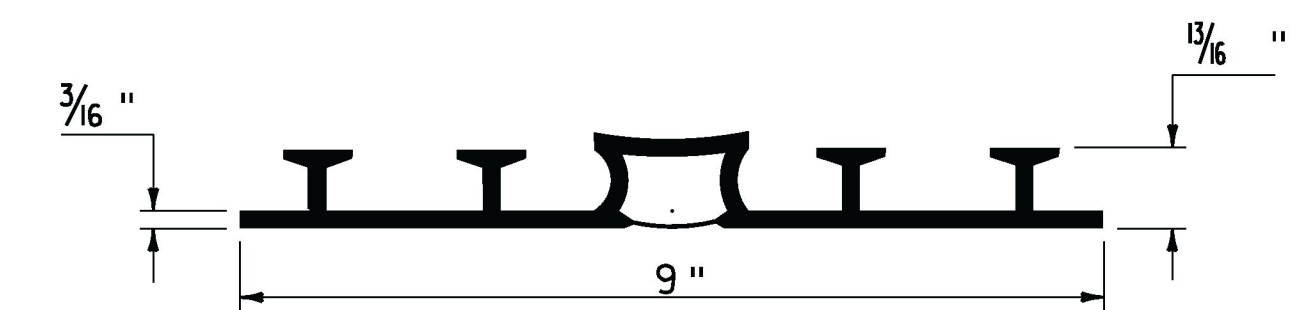

**P.V.C. WATERSTOP FOR EXPANSION JOINTS**  
(NOT TO SCALE)

PAYMENT FOR THE P.V.C. WATERSTOP SHALL BE INCIDENTAL TO THE UNIT BID PRICE FOR THE ADJACENT CONCRETE.


OTHER CONFIGURATIONS OF WATERSTOP MAY BE USED UPON APPROVAL OF THE ENGINEER.

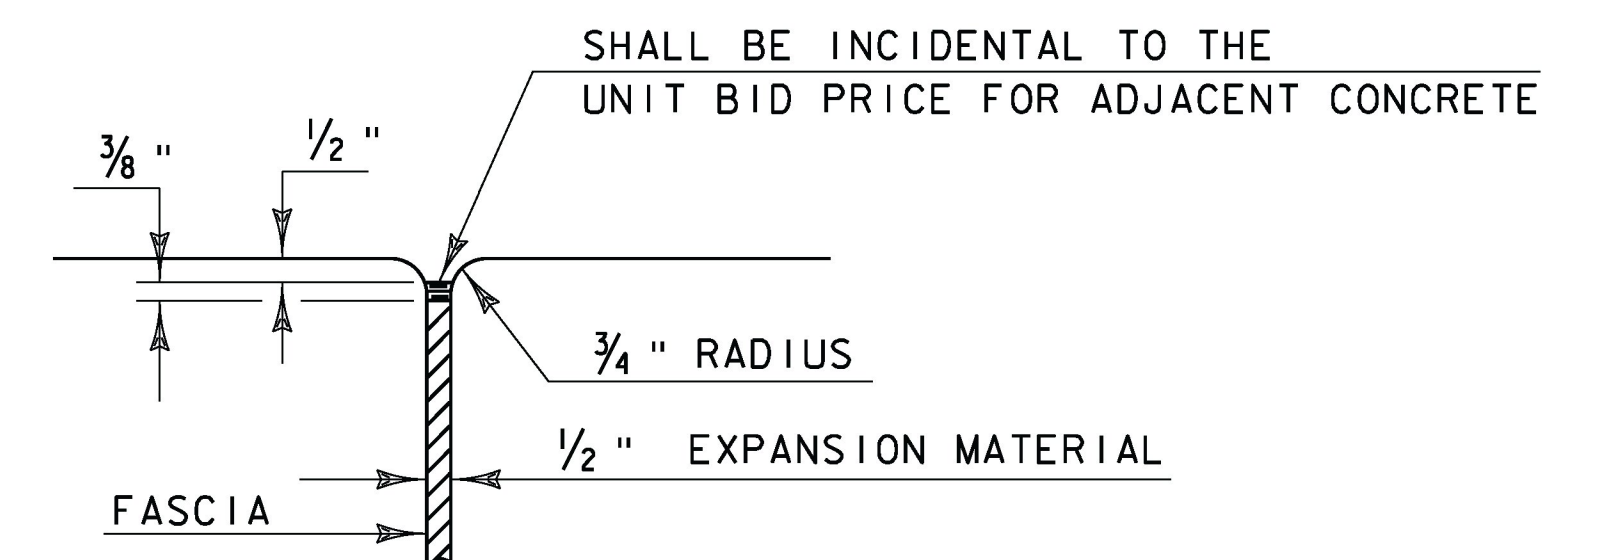


**JOINT BETWEEN FASCIA AND WINGWALL**  
(NOT TO SCALE)

REVISIONS	
MAY 7, 2010	APPROVED FOR USE BY VAOT STRUCTURES SECTION


**CONCRETE  
DETAILS AND NOTES**

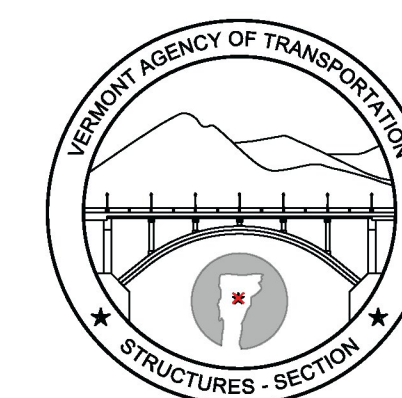


**STRUCTURES  
DETAIL  
SD-5 01.00**

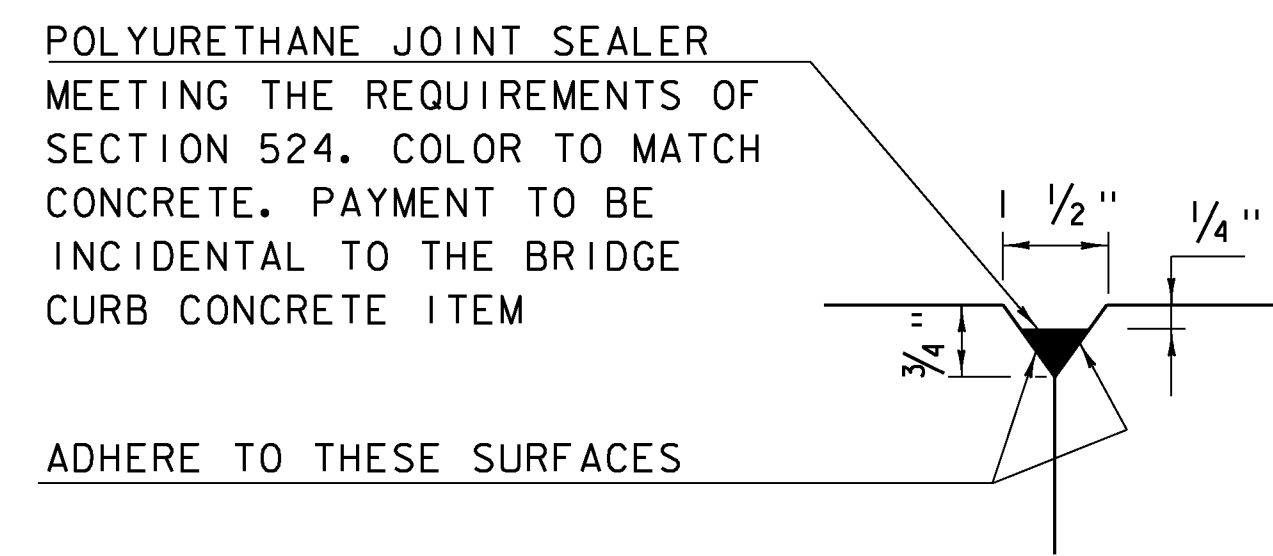


DETAIL "B"  
(NOT TO SCALE)

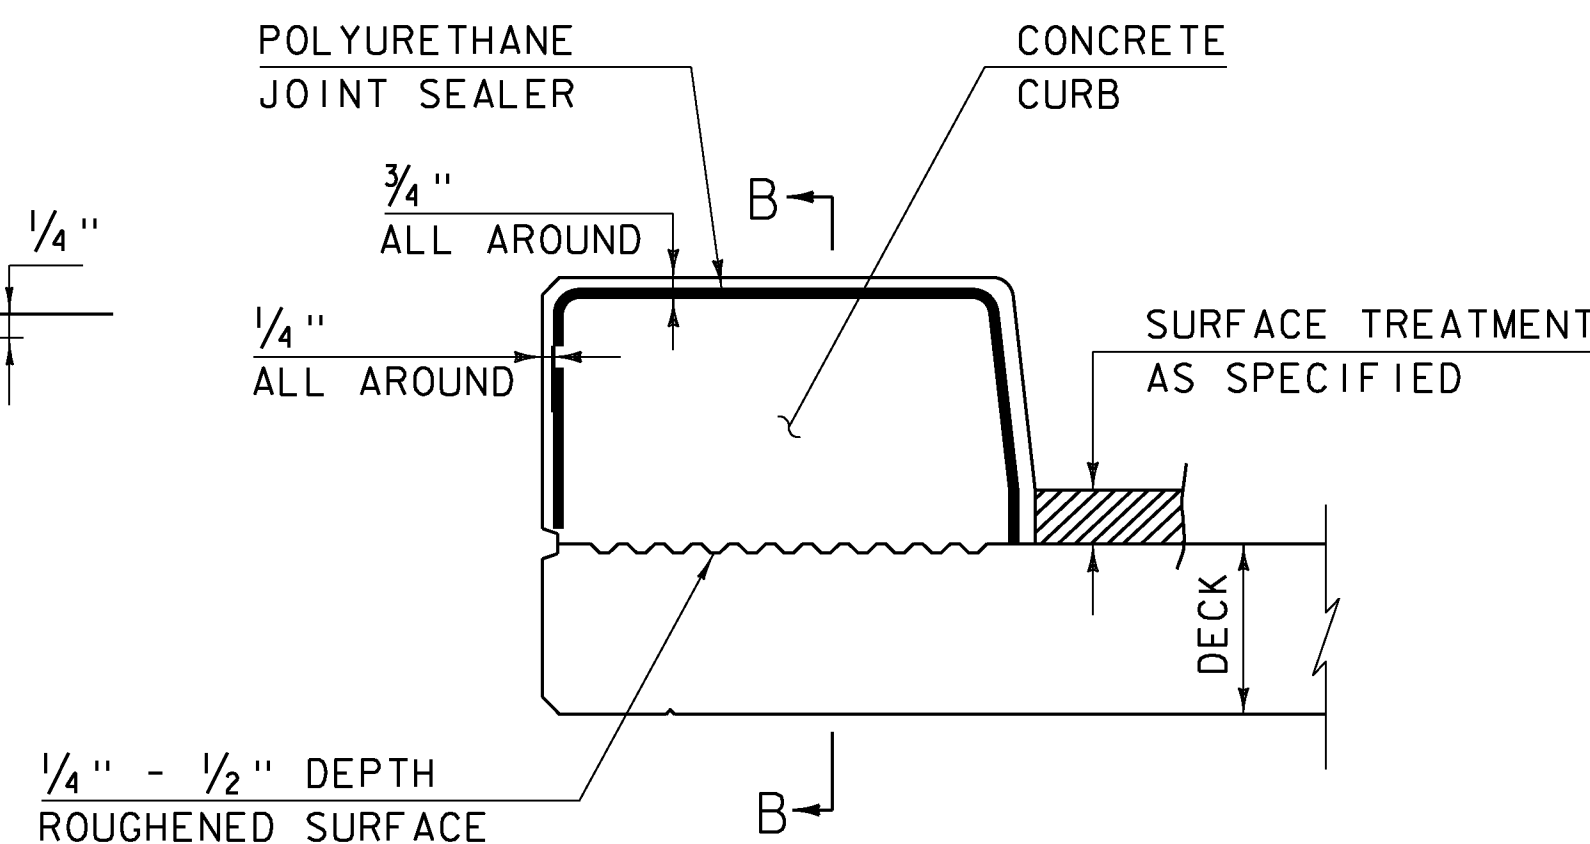

CONCRETE CURB JOINT SECTION  
(NOT TO SCALE)

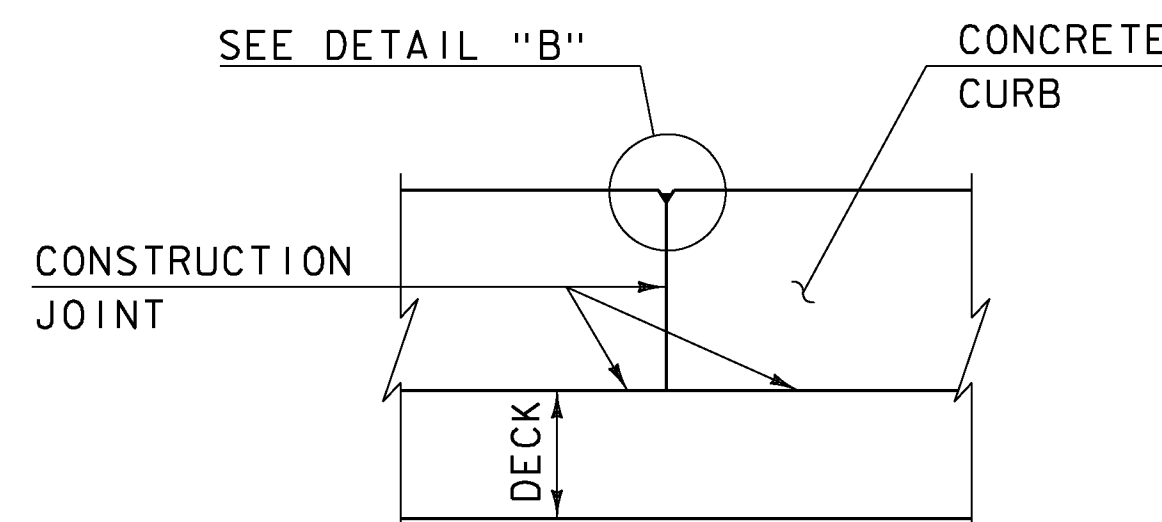


SECTION B - B  
(NOT TO SCALE)

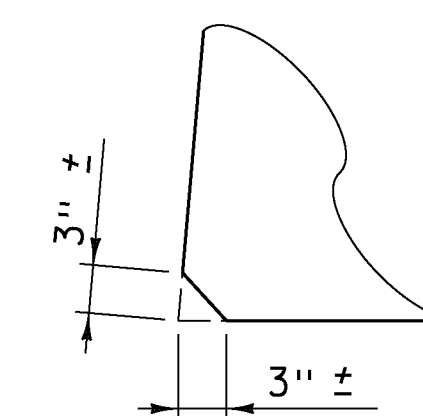


ACUTE ANGLE  
CLIP DETAIL  
(NOT TO SCALE)



1. SEE TYPICAL HORIZONTAL CONSTRUCTION JOINT DETAIL FOR ADDITIONAL INFORMATION

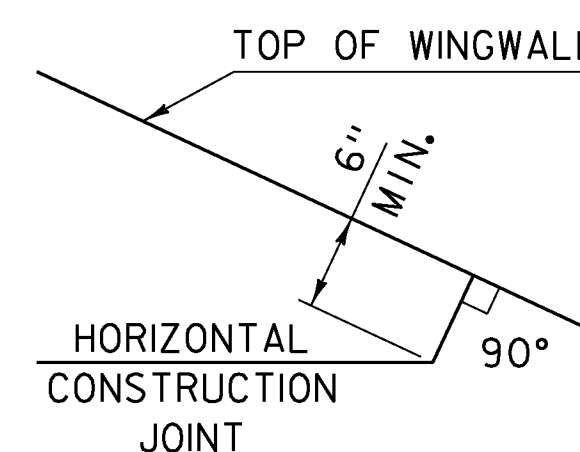

HORIZONTAL WINGWALL  
CONSTRUCTION JOINT  
(NOT TO SCALE)

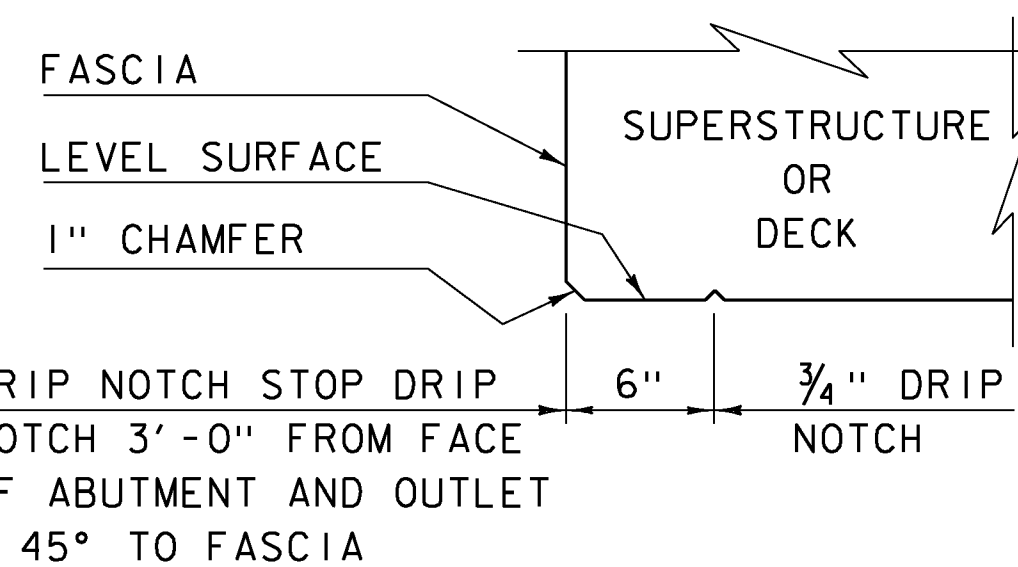

DRIP NOTCH DETAIL  
(NOT TO SCALE)

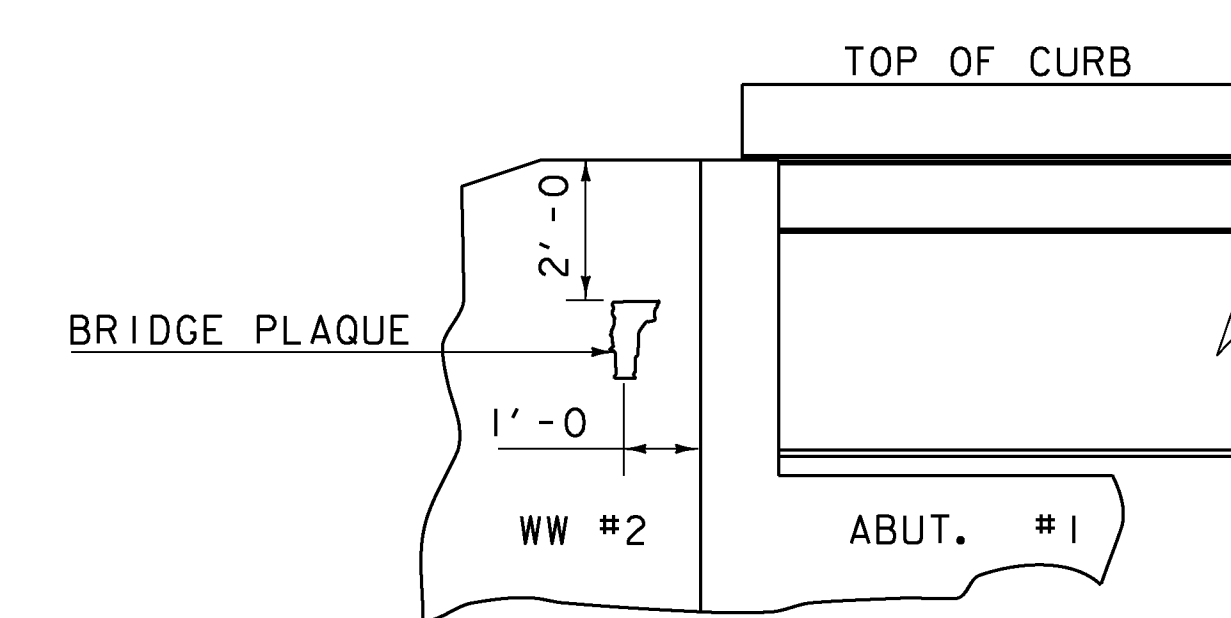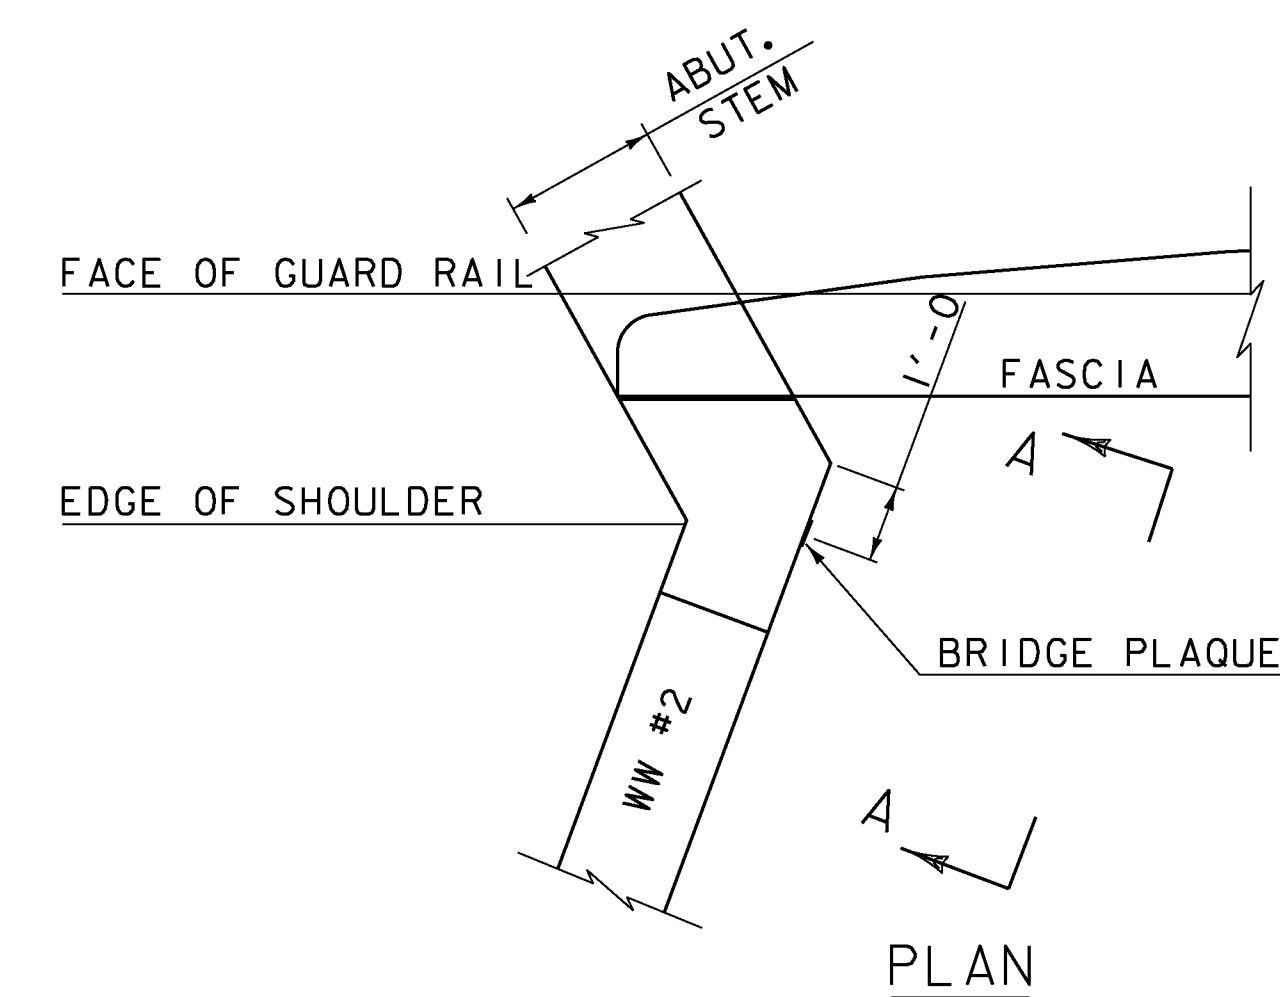

THE BRIDGE PLAQUE WILL BE SUPPLIED BY THE AGENCY OF TRANSPORTATION AND SHALL BE INSTALLED BY THE CONTRACTOR AT ABUTMENT #1 ON THE RIGHT SIDE AS SHOWN OR AS DIRECTED BY THE ENGINEER.

PAYMENT FOR INSTALLATION OF THE BRIDGE PLAQUE SHALL BE INCIDENTAL TO THE ADJACENT CONCRETE.


### CONCRETE CURB JOINT NOTES

1. CONCRETE CURBS MAY BE PLACED IN ONE CONTINUOUS OPERATION IF AN APPROVED SHRINKAGE REDUCING ADMIXTURE LISTED IN THE SPECIAL PROVISIONS IS USED WITH THE CONCRETE MIX DESIGN. PAYMENT FOR THE SHRINKAGE REDUCING ADMIXTURE WILL BE INCIDENTAL TO THE BRIDGE CURB CONCRETE ITEM.
2. IF THE CONTRACTOR CHOOSES NOT TO USE AN APPROVED SHRINKAGE REDUCING ADMIXTURE, THE CURBS SHALL BE CONSTRUCTED WITH CONSTRUCTION JOINTS SPACED AT A MAXIMUM OF 15'-0" CENTER TO CENTER AND 2'-0" MINIMUM FROM THE CENTER OF NEAREST BRIDGE RAILING POST.
3. ON MULTI-SPAN CONTINUOUS SUPERSTRUCTURES, REGARDLESS OF WHETHER APPROVED SHRINKAGE REDUCING ADMIXTURE IS USED, CURB JOINTS SHALL BE LOCATED OVER THE CENTERLINE OF PIERS AND 7'-0" EACH SIDE OF THE CENTERLINE OF EACH PIER.
4. WHEN CURB JOINTS ARE USED THE CURBS SHALL BE PLACED IN ALTERNATE SECTIONS WITH A MINIMUM OF 48 HOUR DELAY BETWEEN ADJACENT PLACEMENTS.
5. LONGITUDINAL REINFORCING SHALL BE CONTINUOUS THROUGH CURB CONSTRUCTION JOINTS. CURB STIRRUP BARS SHALL BE TURNED AS NECESSARY TO MAINTAIN COVER IN THE FLARED CURB ENDS.
6. THE JOINT SPACING AND DETAILS SHOWN SHALL APPLY TO SIDEWALKS WHEN SHOWN IN THE PLANS.


### REVISIONS

MAY 7, 2010	APPROVED FOR USE BY VAOT STRUCTURES SECTION
JUNE 4, 2010	MODIFIED AND ADDED TWO DETAILS
OCTOBER 10, 2012	MODIFIED HORZ. JOINT WINGWALL ADD 6" MIN. DIMENSION

# CONCRETE DETAILS AND NOTES

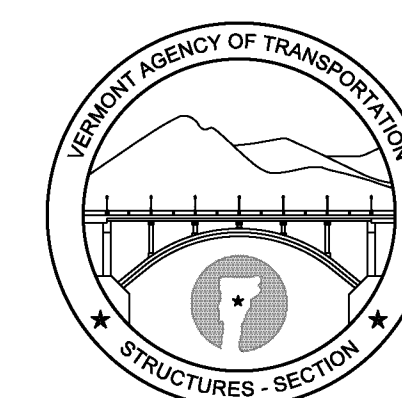


STRUCTURES  
DETAIL  
SD-502.00

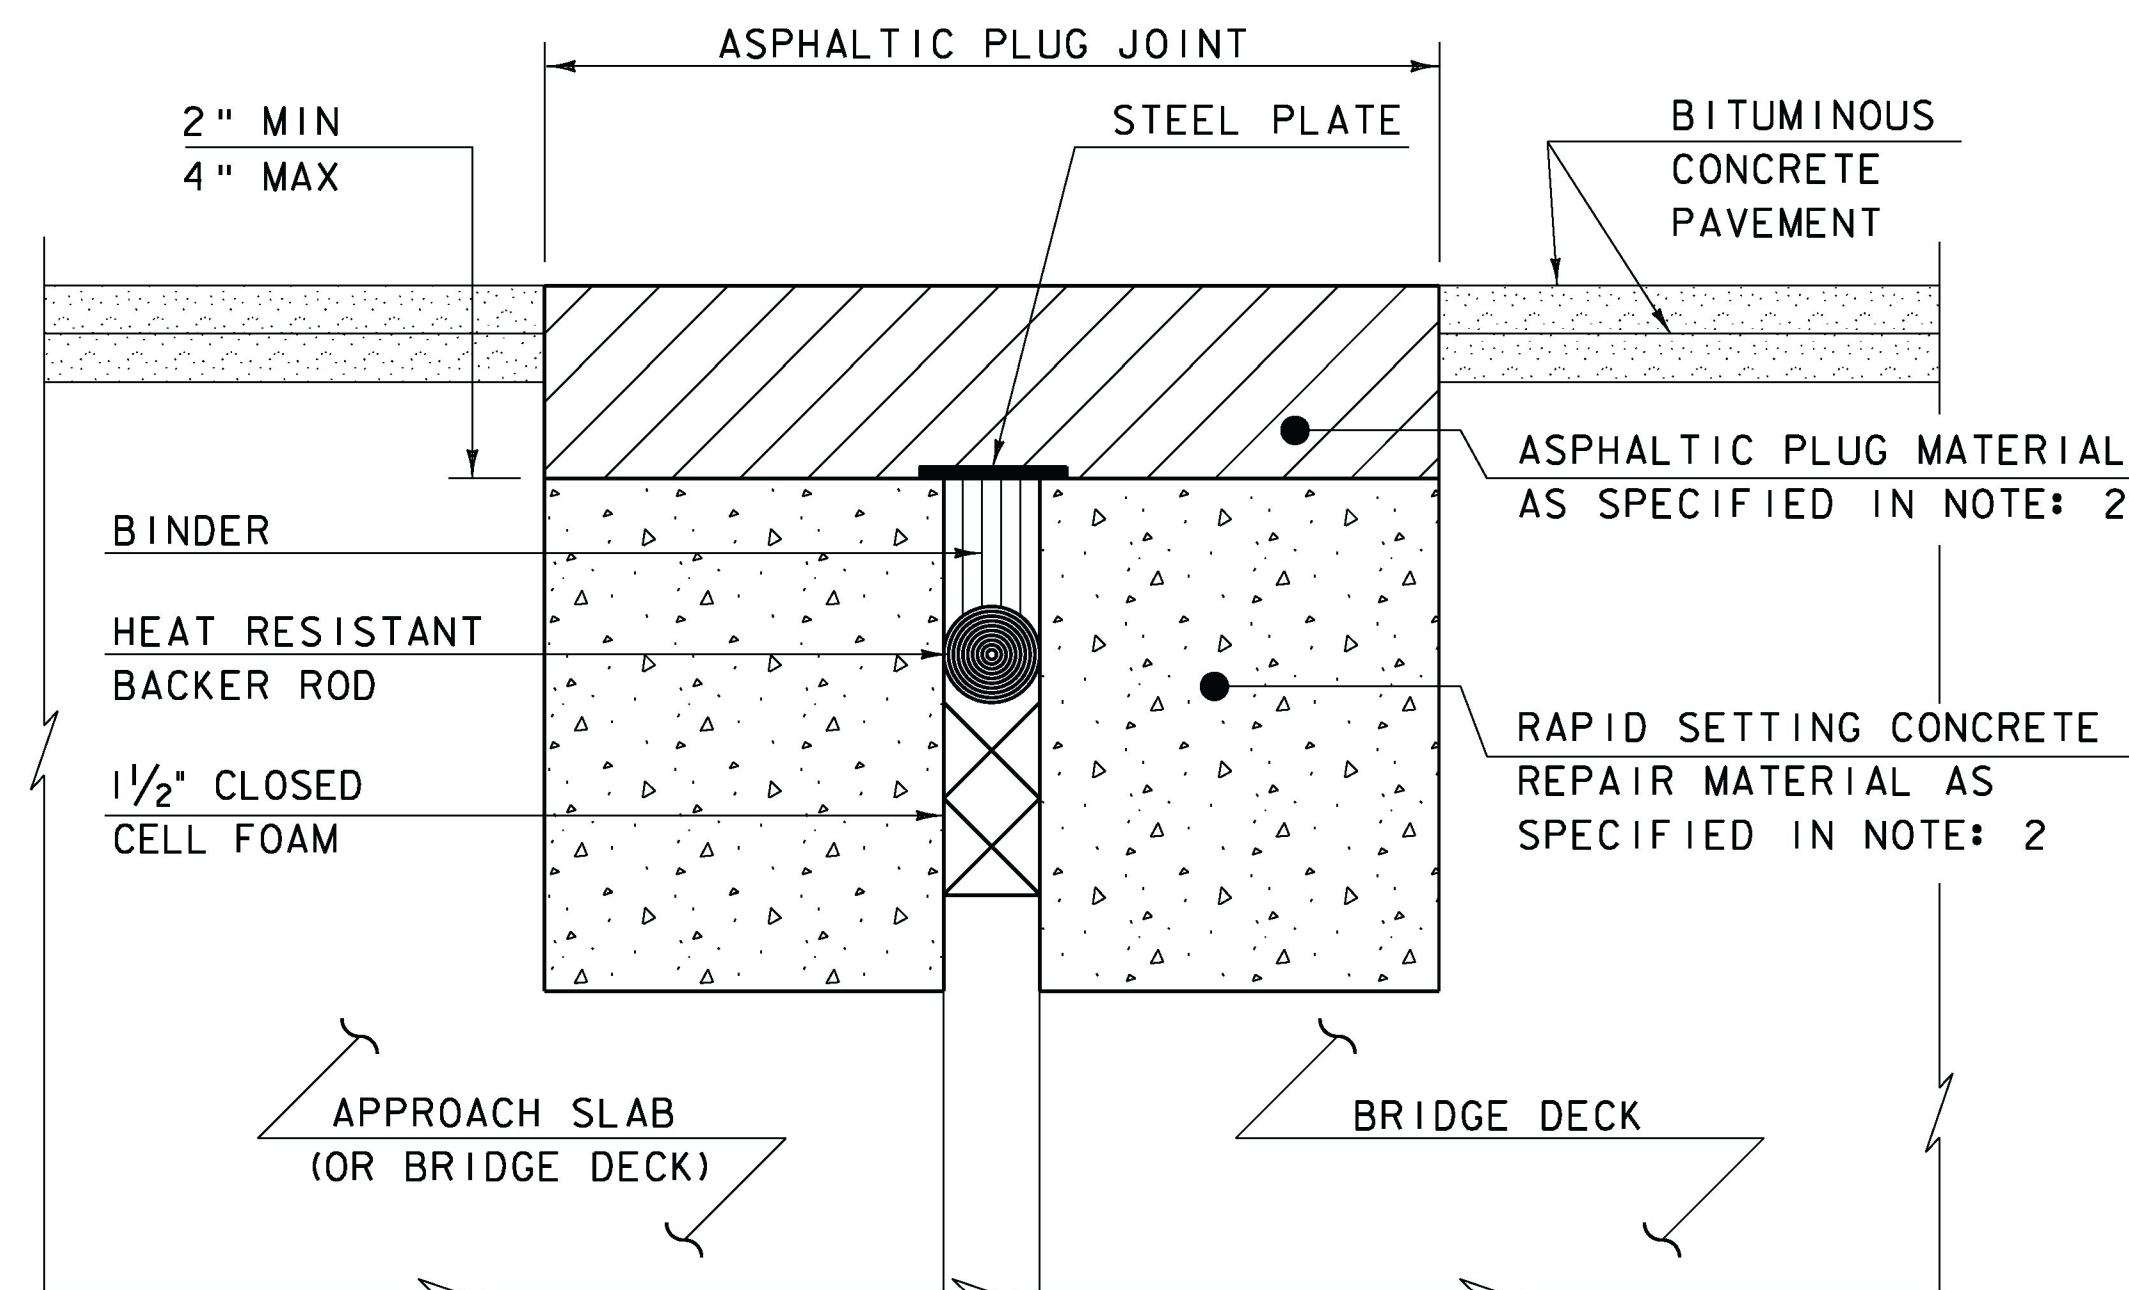

**ASPHALTIC PLUG-TYPE JOINT DETAIL - REHAB**

NOTES: (NOT TO SCALE)

1. THE CONTRACTOR SHALL REMOVE ALL ASPHALTIC PLUG JOINT MATERIAL AND DETERIORATED CONCRETE AS DIRECTED BY THE ENGINEER. REMOVAL OF THE FIRST 4 INCHES OF MATERIAL SHALL BE INCLUDED IN THE BID PRICE FOR ITEM 516.10 BRIDGE EXPANSION JOINT, ASPHALTIC PLUG. ANY REMOVAL OF MATERIAL GREATER THAN 4 INCHES SHALL BE INCLUDED IN THE BID PRICE OF ITEM 580.20 RAPID SETTING CONCRETE REPAIR MATERIAL WITH COURSE AGGREGATE.
2. THE CONTRACTOR SHALL REPLACE REMOVED MATERIAL THAT IS LESS THAN 4" FROM FINISHED GRADE WITH ASPHALTIC PLUG JOINT MATERIAL MEETING THE REQUIREMENTS OF SUBSECTION 707.15. ALL REMOVED MATERIAL THAT IS GREATER THAN 4 INCHES FROM FINISHED GRADE SHALL BE REPLACED WITH RAPID SETTING CONCRETE REPAIR MATERIAL WITH COURSE AGGREGATE MEETING THE REQUIREMENTS OF SUBSECTION 780.04.
3. REINFORCING STEEL NOT SHOWN FOR CLARITY.

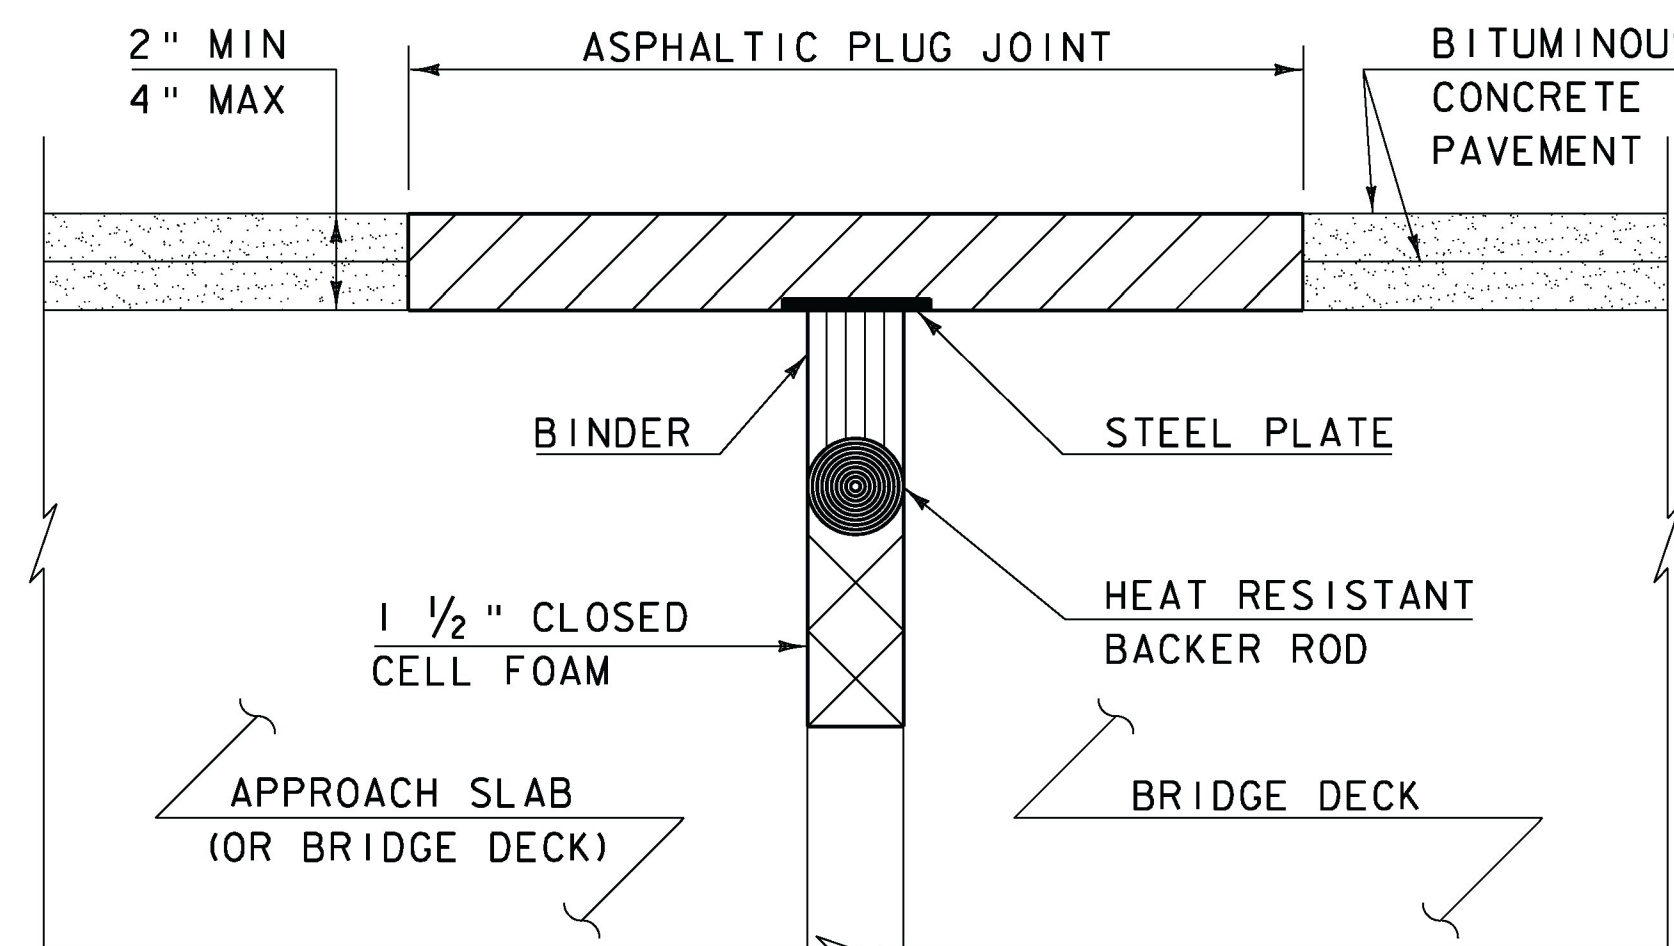

**ASPHALTIC PLUG-TYPE JOINT DETAIL - NEW**

(NOT TO SCALE)

**ASPHALTIC PLUG JOINT NOTES**

**INSTALLATION:**

1. LOCATE THE JOINT CENTRALLY OVER THE DECK OVERLAY EXPANSION GAP OR FIXED JOINT, MARKED OUT TO THE MANUFACTURER'S RECOMMENDED WIDTH.
2. REMOVE THE BITUMINOUS CONCRETE PAVEMENT FULL DEPTH AS SHOWN ON THE PLANS. THE PAVEMENT SHALL BE DRY AND SAW CUT TO THE LIMITS REQUIRED TO PLACE THE JOINT. A PNEUMATIC HAMMER AND CHISEL MAY BE USED ADJACENT TO THE CURB ONLY WHEN SAW CUTTING IS NOT POSSIBLE.
3. BLAST CLEAN THE JOINT AREA OF DEBRIS, ASPHALT AND SHEET MEMBRANE. THOROUGHLY DRY THE JOINT AREA WITH COMPRESSED AIR PRIOR TO APPLYING BINDER MATERIAL.
4. REPAIR MATERIAL GREATER THAN 4 INCHES FROM FINISHED GRADE WITH RAPID SETTING CONCRETE REPAIR MATERIAL WITH COURSE AGGREGATE MEETING THE REQUIREMENTS OF SUBSECTION 780.04.
5. PLACE PROPERLY SIZED HEAT RESISTANT BACKER ROD IN THE MOVEMENT GAP ALLOWING FOR 1" +/- OF BINDER ABOVE THE ROD.
6. HEAT AND PLACE THE BINDER MATERIAL AS RECOMMENDED BY THE MANUFACTURER.
7. PLACE 1/4" THICK BY 8" WIDE SECTIONS OF STEEL PLATE OVER THE CENTER OF THE MOVEMENT GAP. SECURE THE PLATES FROM MOVING BY INSERTING LOCATING PINS THROUGH THE PRE-STAMPED HOLES INTO BACKER ROD AND COVER WITH HOT BINDER. THE STEEL PLATES MAY BE OMITTED WHERE THE ENGINEER DETERMINES THAT THE APPROACH SLAB OR BRIDGE DECK WILL PROVIDE INADEQUATE SUPPORT AND WHERE VERTICAL MOVEMENT OF THE PLATES MIGHT OCCUR.
8. HEAT AND MIX THE BINDER MATERIAL AND AGGREGATE AS RECOMMENDED BY THE MANUFACTURER.
9. INSTALLATION OF MATERIAL, COMPACTION, AND TOP COATING SHALL BE AS RECOMMENDED BY THE MANUFACTURER.
10. IMMEDIATELY AFTER TOP COATING, CAST AN ANTI-SKID MATERIAL OVER THE JOINT TO REDUCE THE RISK OF TRACKING.
11. ONCE THE JOINT REACHES 82 DEG C (180 DEG F) +/-, WATER MAY BE USED TO EXPEDITE THE COOLING PROCESS.
12. PROTECT JOINT FROM TRAFFIC UNTIL THE MATERIAL HAS COOLED TO 51 DEG C (125 DEG F) +/-.

**WEATHER LIMITATIONS**


APPLY BINDER MATERIAL ONLY WHEN THE FOLLOWING CONDITIONS PREVAIL OR AS RECOMMENDED BY THE MANUFACTURER:

1. THE AMBIENT AIR TEMPERATURE IS AT LEAST 10 DEG C (50 DEG F) AND RISING.
2. THE ROAD SURFACE IS DRY.
3. WEATHER CONDITIONS OR OTHER CONDITIONS ARE FAVORABLE AND ARE EXPECTED TO REMAIN SO FOR THE PERFORMANCE OF SATISFACTORY WORK.

**REVISIONS**

MAY 7, 2010 APPROVED FOR USE BY VAOT STRUCTURES SECTION

**BRIDGE JOINT  
ASPHALTIC PLUG**

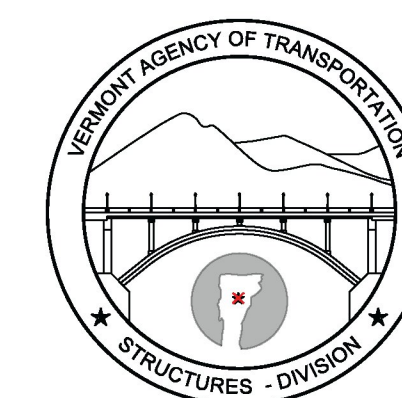



**STRUCTURES  
DETAIL  
SD-516.10**

IN ACCORDANCE WITH CONTRACT PLAN SHEET 39 OF 68, 10/2013.

**GENERAL NOTES**

- ALL BEARINGS SHALL CONFORM TO THE STATE OF VERMONT AGENCY OF TRANSPORTATION STANDARD SPECIFICATIONS, SECTIONS 531 AND 731, UNLESS NOTED OTHERWISE.
- MATERIALS:**  
 ELASTOMER.....50 ± 5 DURO NATURAL, GRADE 4  
  
 CARBON STEEL SHIMS.....ASTM A1011, GR. 40 (QUOTED 10 GA. IN LIEU OF 1/8" DUE TO AVAILABILITY)  
  
 TAPERED SHIM.....ASTM A36 OR BETTER
- TOLERANCES:**  
**LAMINATED PADS:**  
 VERTICAL.....-0, +1/4"  
 HORIZONTAL.....-0, +1/4"  
 THICKNESS OF LAYERS.....±1/8"  
 PARALLELISM TOP.....0.005 rad  
 PARALLELISM SIDES.....1/4"  
 EDGE COVER.....-0, +1/8"
- MARKINGS:**  
 EACH BEARING SHALL BE PERMANENTLY MARKED IN A LOCATION THAT IS VISIBLE WHEN THE DEVICE IS INSTALLED IN THE COMPLETED STRUCTURE. MARKING SHALL BE SEP STANDARD:  
 CONTRACT/ORDER #  
 LOT#  
 BEARING ID # (MK. #)  
 LOCATION/BRIDGE #  
 ELASTOMER TYPE AND GRADE  
 ORIENTATION (WHERE APPLICABLE)
- TESTING:** IN ACCORDANCE WITH THE VERMONT AOT SPECIFICATIONS. DESIGN METHOD A
- REPRESENTATIVE**  
 CUSTOMER SERVICE: STEVE BOWMAN.....903-677-4318  
 TECHNICAL: MIKE SPELLMAN.....903-677-4342

REVISIONS		
REV.	DESCRIPTION	DATE
A	SUBMITTAL	3/25/14

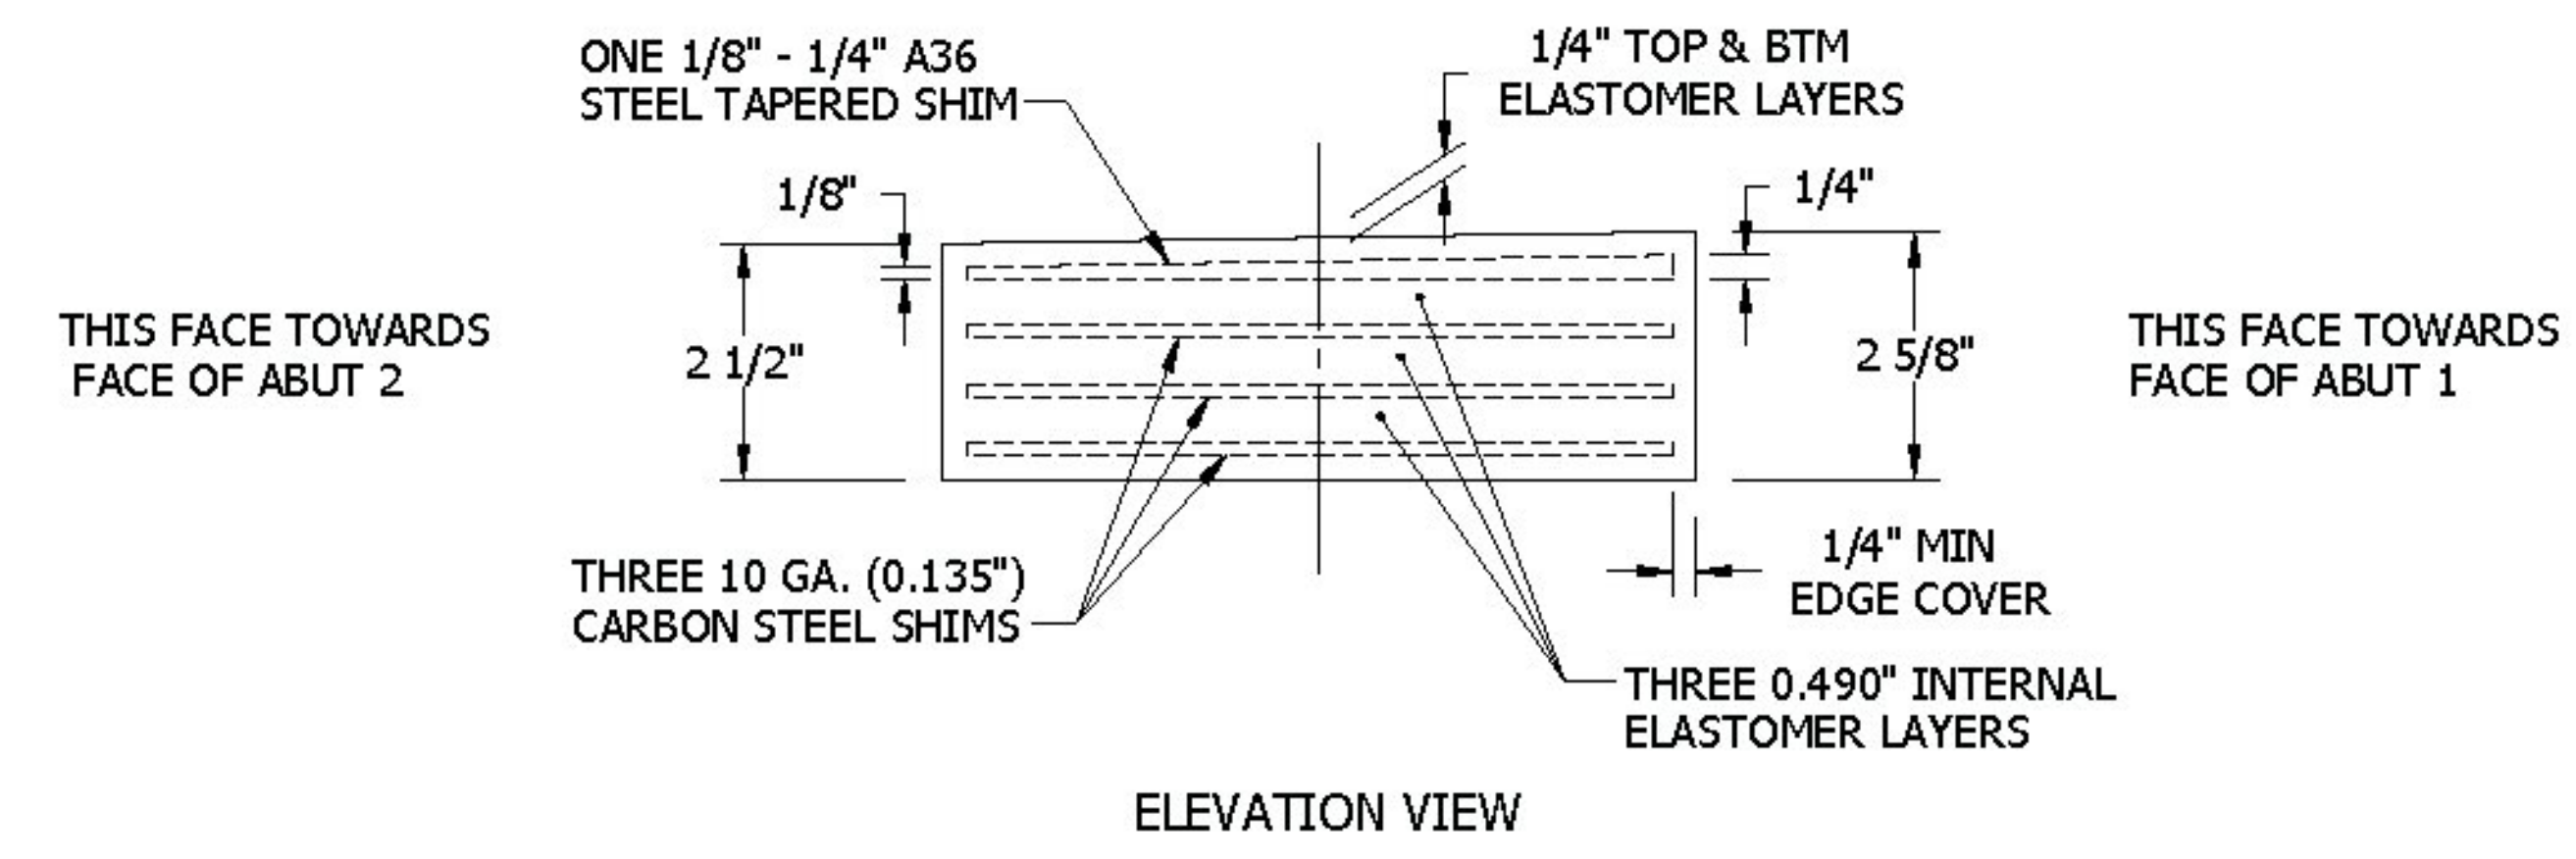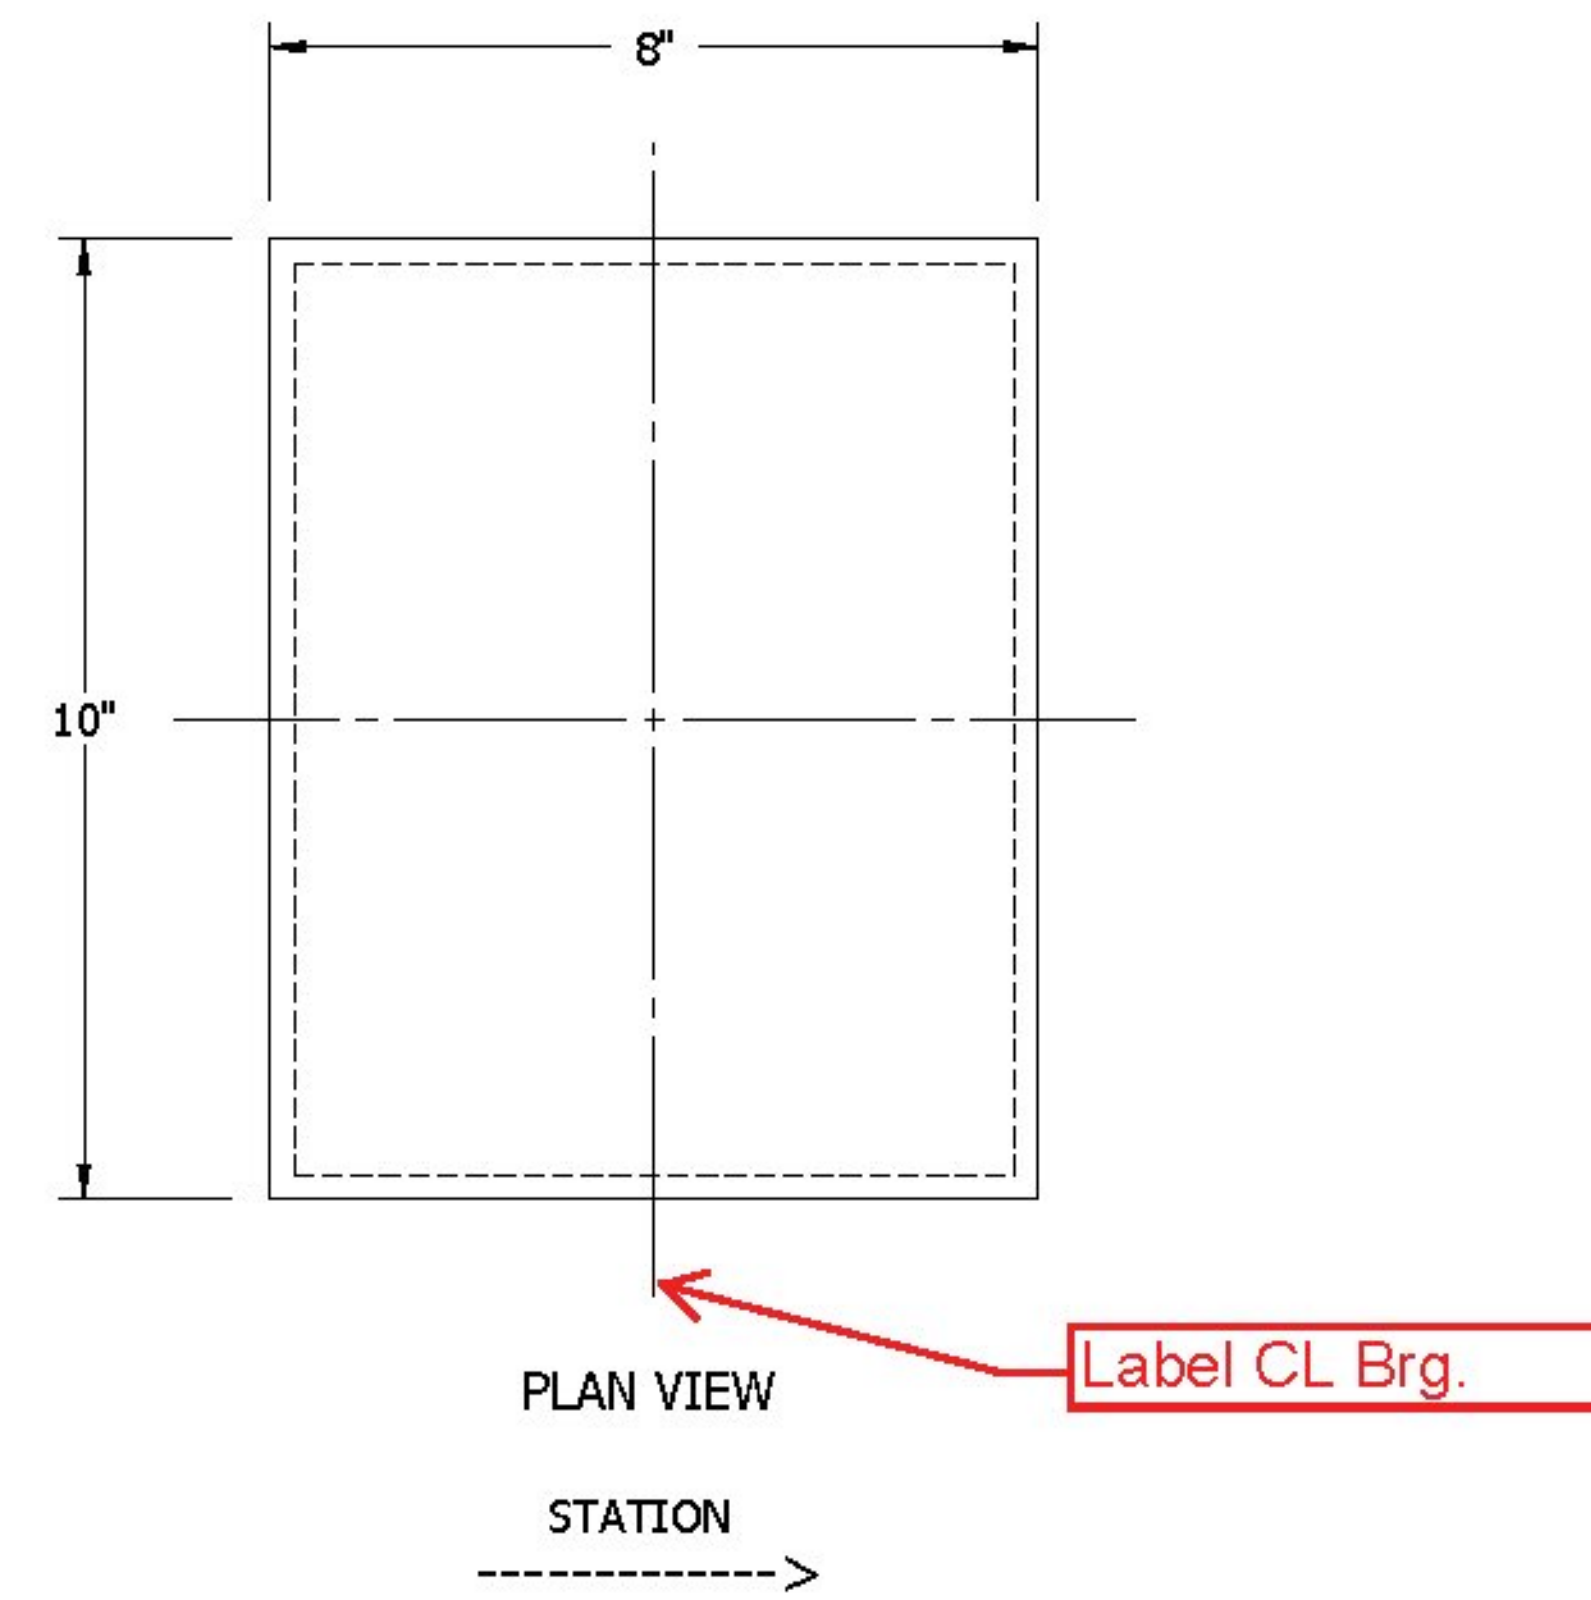

**MK.03**  
**LAMINATED BEARING PADS**  
 ITEM 531.17  
 @ BRATTLEBORO, BRO 1442(35)  
**(28) REQ'D**

DL: 15 kips  
 LL: 25 kips W/O IMPACT

Vermont Agency of Transportation  
**RECEIVED**  
 CK'D BY MJC OK'D BY TAS  
 March 26, 2014  
 RESUBMIT No Approved AsNoted  
 BY M. J. Chenette DATE 04/15/2014

### SHOP DRAWING REVIEW

REVIEWED AS REQUIRED BY THE CONSTRUCTION CONTRACT DOCUMENTS AND APPROVED, BUT ONLY FOR CONFORMANCE TO THE DESIGN CONCEPT OF THE WORK, AND SUBJECT TO FURTHER LIMITATIONS AND REQUIREMENTS CONTAINED IN THE CONSTRUCTION CONTRACT DOCUMENTS.

REJECTED       REVISE AND RESUBMIT       FURNISH AS CORRECTED

CORRECTIONS OR COMMENTS MADE ON THE SHOP DRAWINGS DURING THIS REVIEW DO NOT RELIEVE CONTRACTOR FROM COMPLIANCE WITH REQUIREMENTS OF THE DRAWINGS AND SPECIFICATIONS. THIS CHECK IS ONLY FOR REVIEW OF GENERAL CONFORMANCE WITH THE DESIGN CONCEPT OF THE PROJECT AND GENERAL COMPLIANCE WITH THE INFORMATION GIVEN IN THE CONTRACT DOCUMENTS. THE CONTRACTOR IS RESPONSIBLE FOR: CONFIRMING AND CORRELATING ALL QUANTITIES AND DIMENSIONS; SELECTING FABRICATION PROCESSES AND TECHNIQUES OF CONSTRUCTION; COORDINATING HIS WORK WITH THAT OF ALL OTHER TRADES; AND PERFORMING HIS WORK IN A SAFE AND SATISFACTORY MANNER.

	Vanasse Hangen Brustlin, Inc.	Job Number: <u>57428.00</u>
	7056 US Route 7 North Ferrisburgh, VT 05473 802.425.7788	Reviewed By: <u>E.A. FIALA</u> Date: <u>04-15-2014</u>

*Seismic Energy Products, Inc.*



STRUCTURAL BEARINGS FOR BRIDGES & BUILDINGS  
ATHENS, TX      PHONE: 903-675-8571

BEARING ASSY FOR:  
STATE OF VERMONT AGENCY OF TRANSPORTATION

PROJECT NAME: BRATTLEBORO  
PROJECT NO.: BRO 1442(35)

CONTRACTOR: **RENAUD BROS**

DRAWN CWILLIAMS	DATE 2/11/13	PO # S. QTE
CHECKED	DATE	SO NO. & ST. <b>58878 VT</b>
REVIEWED MSPELLMAN	DATE 3/25/14	SHEET 1 OF 1

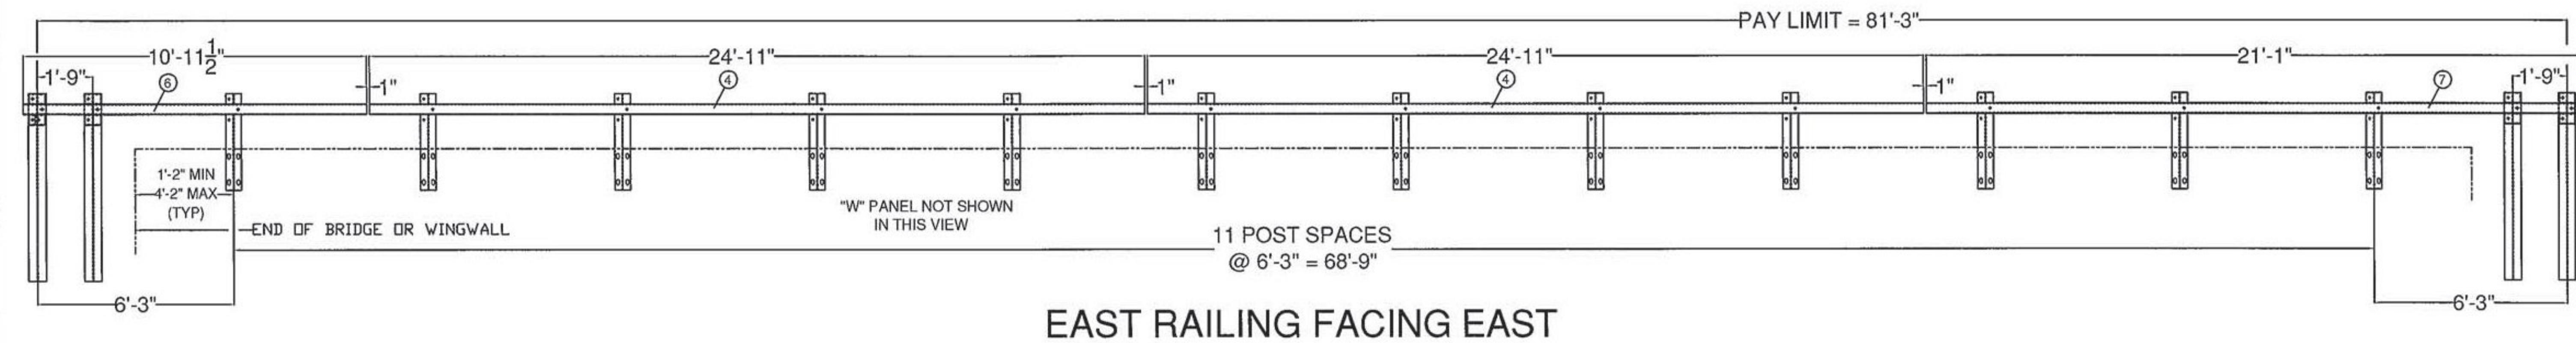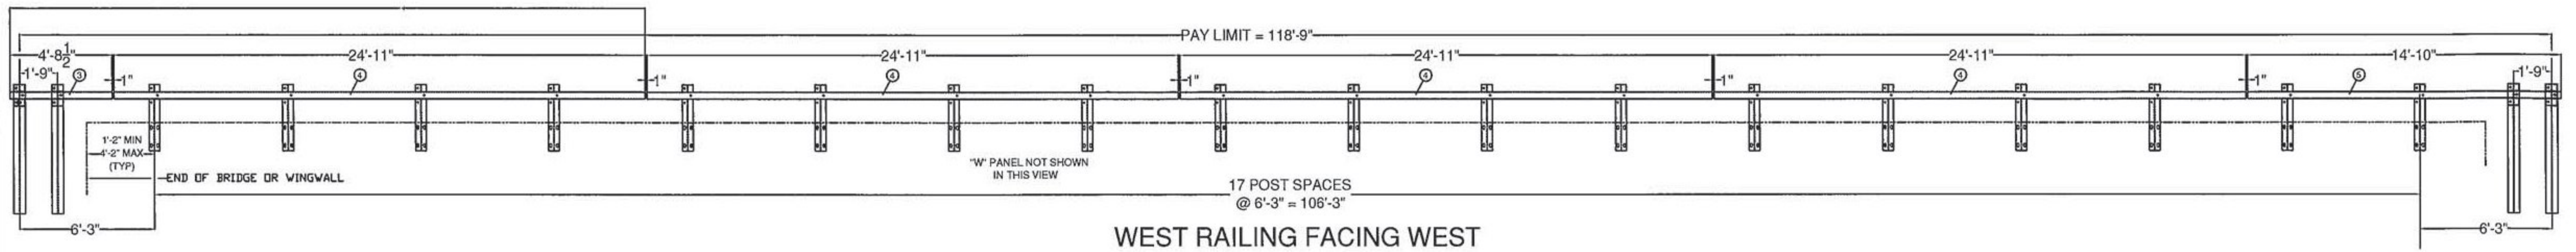

BILL OF MATERIALS				
ITEM NUMBER	DET. #	QTY	DESCRIPTION	MATERIAL
0033.90043	1	30	W6x20 FASCIA MOUNTED POST, GALVANIZED, @ 3' 1"	ASTM A572 Gr 345
0033.90044	2	8	W8x24 TRANSITION POST, GALVANIZED, @ 6' 0"	ASTM A572 Gr 345
0033.91112	3	1	TS8x4x3/16" TUBING @ 4'8-1/2" w/WELDED CAP	ASTM A500 Gr B
0033.91113	4	6	TS8x4x3/16" TUBING @ 24'-11"	ASTM A500 Gr B
0033.91114	5	1	TS8x4x3/16" TUBING @ 14'-10" w/WELDED CAP	ASTM A500 Gr B
0033.91115	6	1	TS8x4x3/16" TUBING @ 10'11-1/2" w/WELDED CAP	ASTM A500 Gr B
0033.91116	7	1	TS8x4x3/16" TUBING @ 21'-1" w/WELDED CAP	ASTM A500 Gr B
0033.90045	8	76	TS8x4x3/16" TUBING @ 6'	ASTM A500 Gr B
0033.90046	9	8	C7x12.25 CHANNEL @ 2' 7" (SPLICE)	ASTM A572 Gr 345
0080.15550	10	38	5/8"x10" HEX BOLT	ASTM A325
0080.15595	11	38	5/8"x13" HEX BOLT	ASTM A325
0080.15036	12	108	5/8"x2" HEX BOLT	ASTM A325
0080.15990	13	38	3/16"x1 3/4"x3" SPECIAL WASHER	ASTM A572 Gr 345
0080.15901	14	152	5/8" HEX NUT	ASTM A563
0080.15911	15	336	5/8" FLAT WASHER	ASTM A436
0080.18960	16	120	1/4"x2"x5" PLATE WASHER	ASTM A572 Gr 345
6043.00012	17	17	10 GAUGE "W" BEAM @ 12' 6"	AASHTO M180-C1 B, TYPE II
0080.05020	18	144	5/8"x1-1/4" SPLICE BOLT/RECESSED NUT (PANEL ASS'Y)	ASTM A307
0080.18851	19	60	Ø 1", 10" x 12" "U" ANCHORS	ASTM A449
0080.18901	20	240	1" HEX NUT	ASTM A563
0080.18911	21	120	1" FLAT WASHER	ASTM F436
XXX	22	9	DELINEATOR	ALUMINUM

- NOTES:
- ALL WORK AND MATERIALS
  - PRIOR TO GALVANIZING THE
  - ALL POSTS SHALL BE SET N
  - SPLICES FOR STEEL BEAM (
  - A RAILING JOINT SPLICE SH
  - SEE STANDARD DRAWING C
  - AT EVERY FIFTH POST. WHI
  - BRIDGES, YELLOW IS TO BE
  - FOR RADII LESS THAN 950 F
  - HOLES IN RAIL FOR RAIL TU
  - WITH AN APPROVED ZINC-R
  - SEE STANDARDS G-1 AND C

### SHOP DRAWING REVIEW

REVIEWED AS REQUIRED BY THE CONSTRUCTION CONTRACT DOCUMENTS AND APPROVED, BUT ONLY FOR CONFORMANCE TO THE DESIGN CONCEPT OF THE WORK, AND SUBJECT TO FURTHER LIMITATIONS AND REQUIREMENTS CONTAINED IN THE CONSTRUCTION CONTRACT DOCUMENTS.

REJECTED       REVISE AND RESUBMIT       FURNISH AS CORRECTED

CORRECTIONS OR COMMENTS MADE ON THE SHOP DRAWINGS DURING THIS REVIEW DO NOT RELIEVE CONTRACTOR FROM COMPLIANCE WITH REQUIREMENTS OF THE DRAWINGS AND SPECIFICATIONS. THIS CHECK IS ONLY FOR REVIEW OF GENERAL CONFORMANCE WITH THE DESIGN CONCEPT OF THE PROJECT AND GENERAL COMPLIANCE WITH THE INFORMATION GIVEN IN THE CONTRACT DOCUMENTS. THE CONTRACTOR IS RESPONSIBLE FOR: CONFIRMING AND CORRELATING ALL QUANTITIES AND DIMENSIONS; SELECTING FABRICATION PROCESSES AND TECHNIQUES OF CONSTRUCTION; COORDINATING HIS WORK WITH THAT OF ALL OTHER TRADES; AND PERFORMING HIS WORK IN A SAFE AND SATISFACTORY MANNER.

**VHB Vanasse Hangen Brustlin, Inc.**  
7056 US Route 7  
North Ferrisburgh, VT 05473  
802.425.7788

Job Number: 57428.00  
Reviewed By: S.E. Burbank  
Date: 7/24/2014

Vermont Agency of Transportation  
**RECEIVED**

CK'D BY MJC      OK'D BY TAS  
July 23, 2014

RESUBMIT No      Approved  
BY M. J. Chenette      DATE 07/24/2014

ITEM #: 900.640      SOLD TO: F.R. LAFAYETTE (PO#28720)      SHEET 1 OF 2


APPROVED BY: _____

**SPECIAL PROVISION BRIDGE RAIL, GALV. HDSB/FM/ST**  
BRATTLEBORO BRO 1442 (35) TH 12, CLASS III (LOCAL ROAD), BRIDGE NO. 7  
TOWN OF BRATTLEBORO, COUNTY OF WINDHAM, VERMONT


R NO.	DATE	DESCRIPTION	BY	R NO.	DATE	DESCRIPTION	BY
E 1	5/23/14	REVISED PER 5/22/14 MARK-UP	EP	E			
V 2	6/18/14	REVISED PER 6/12/14 MARK-UP	EP	V			

**ELDERLEE, INC.**  
OAKS CORNERS, NEW YORK 14518  
E-Mail: [dlong@elderlee.com](mailto:dlong@elderlee.com)  
Tel: 315-789-6670 Fax: 315-789-6615

SCALE: SCHEMATIC  
DRAWING NO. FRL BRATTLEBORO

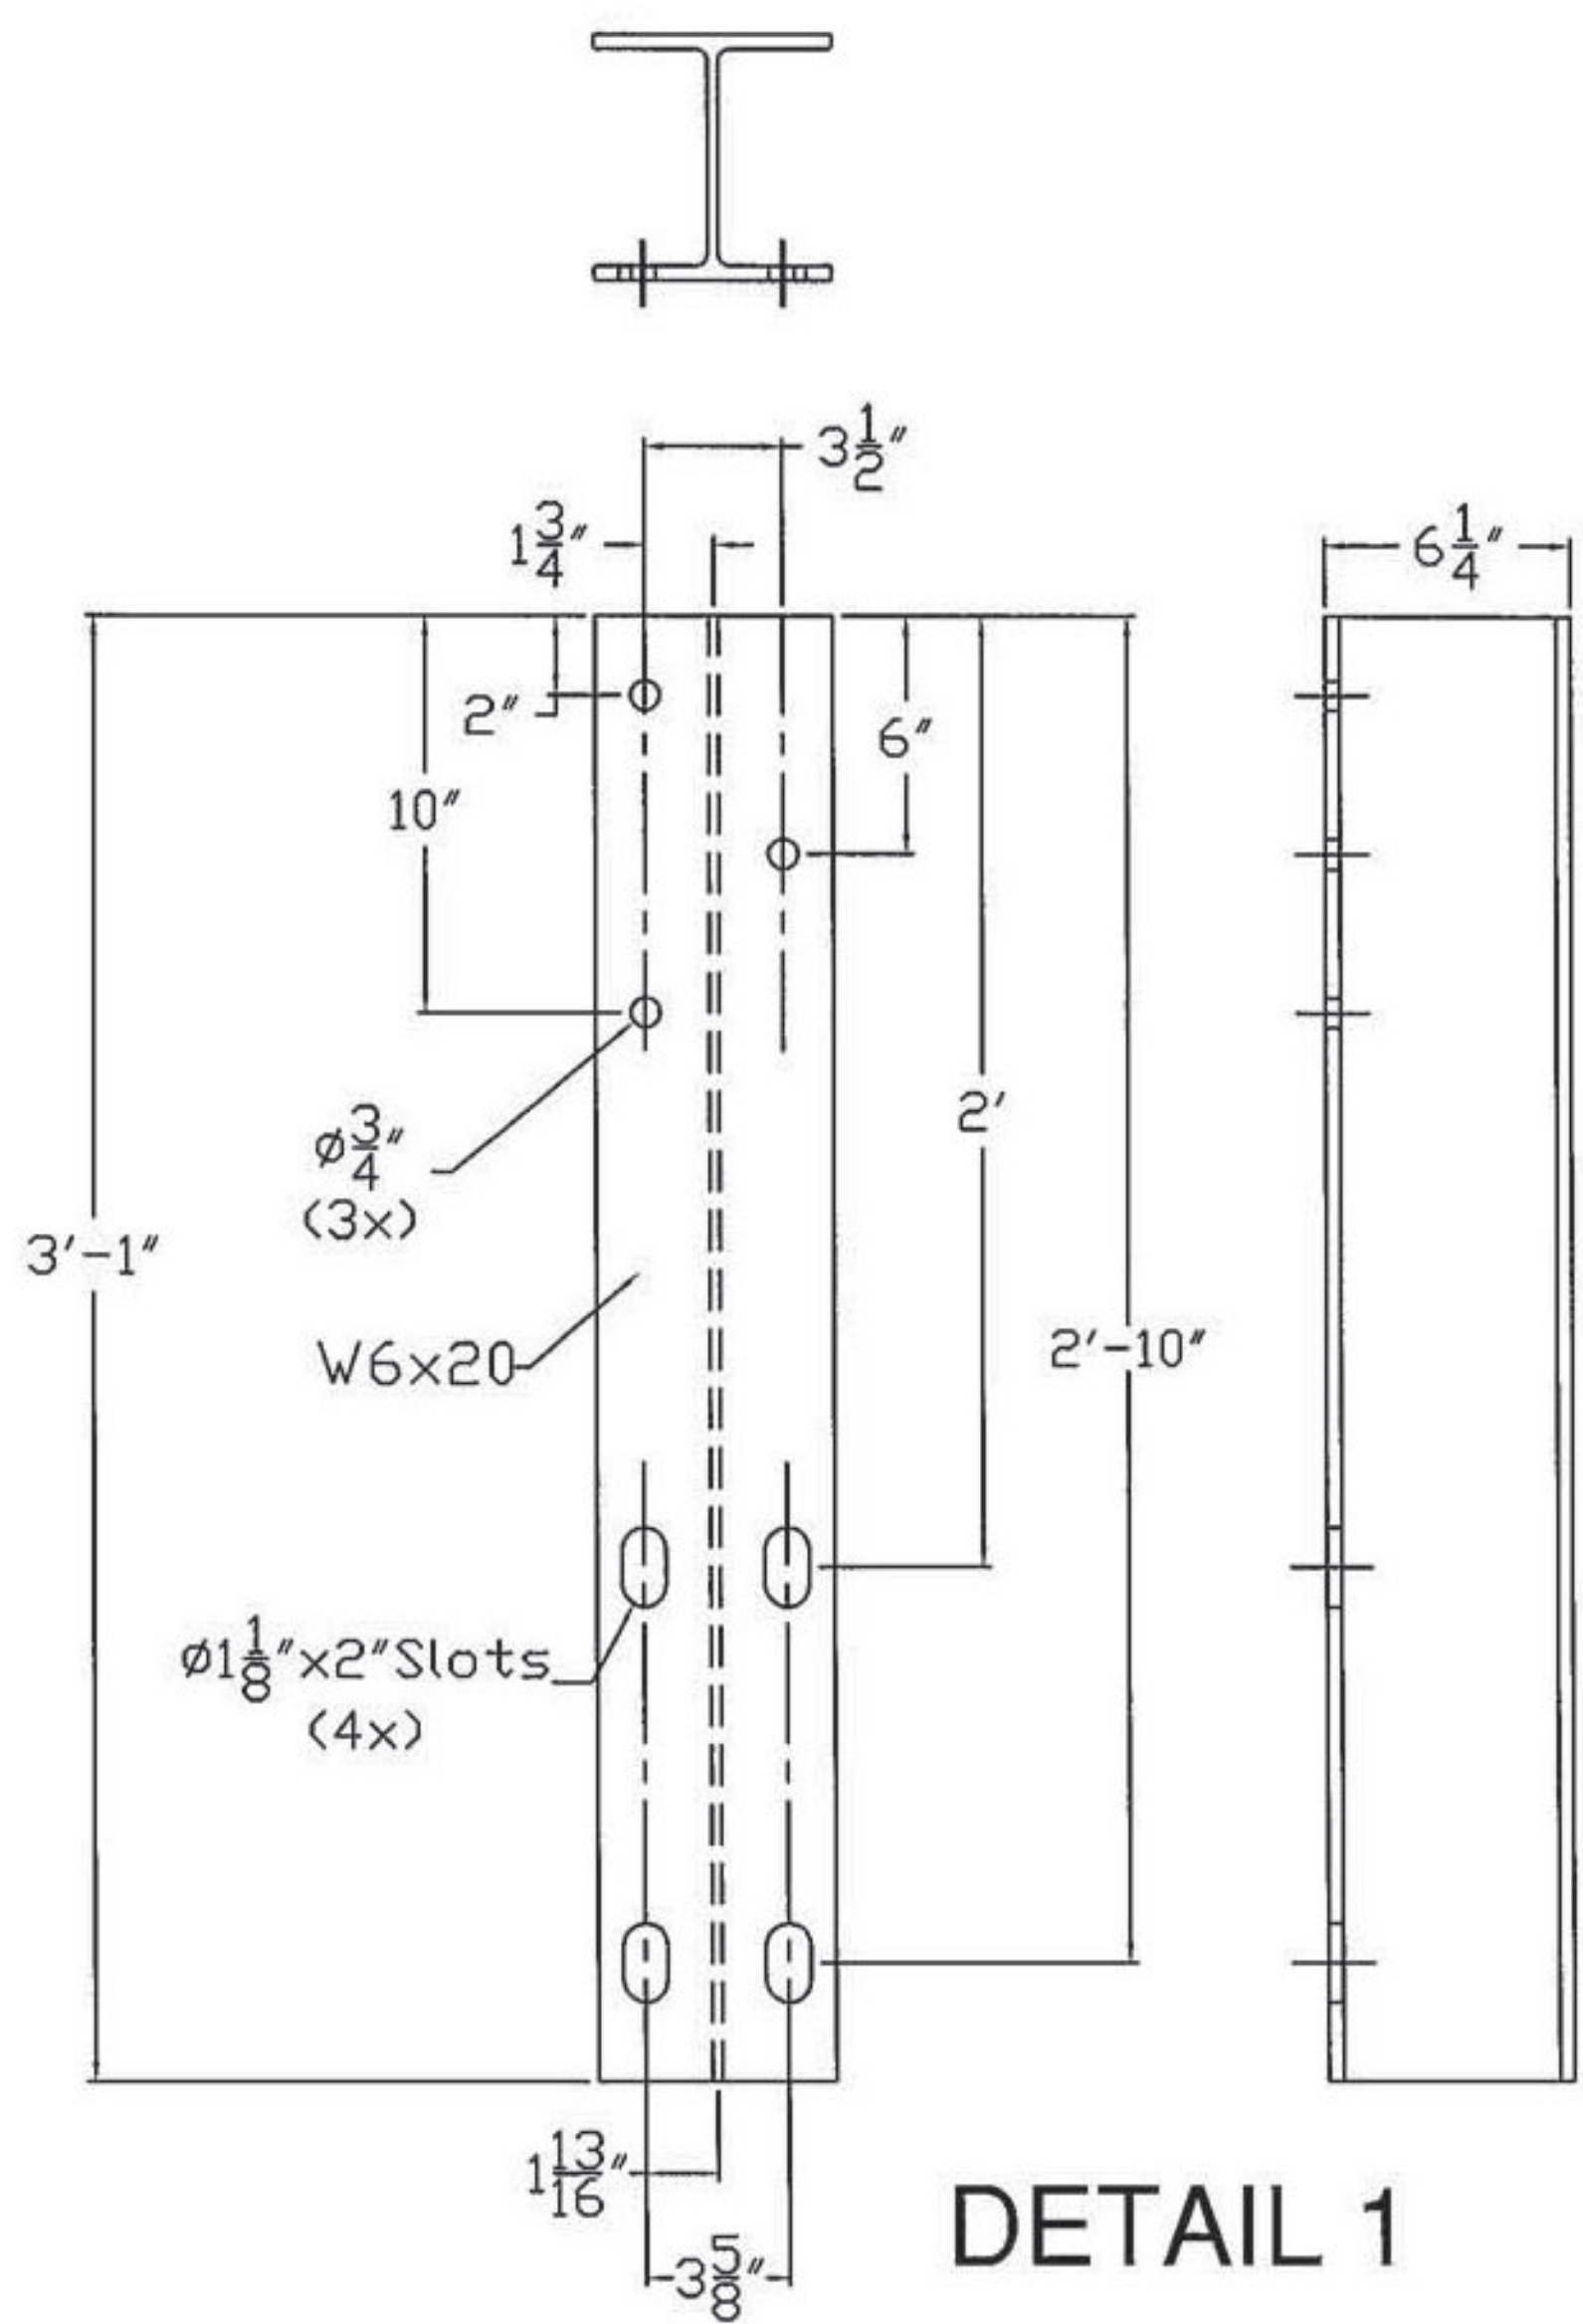


DETAIL 1

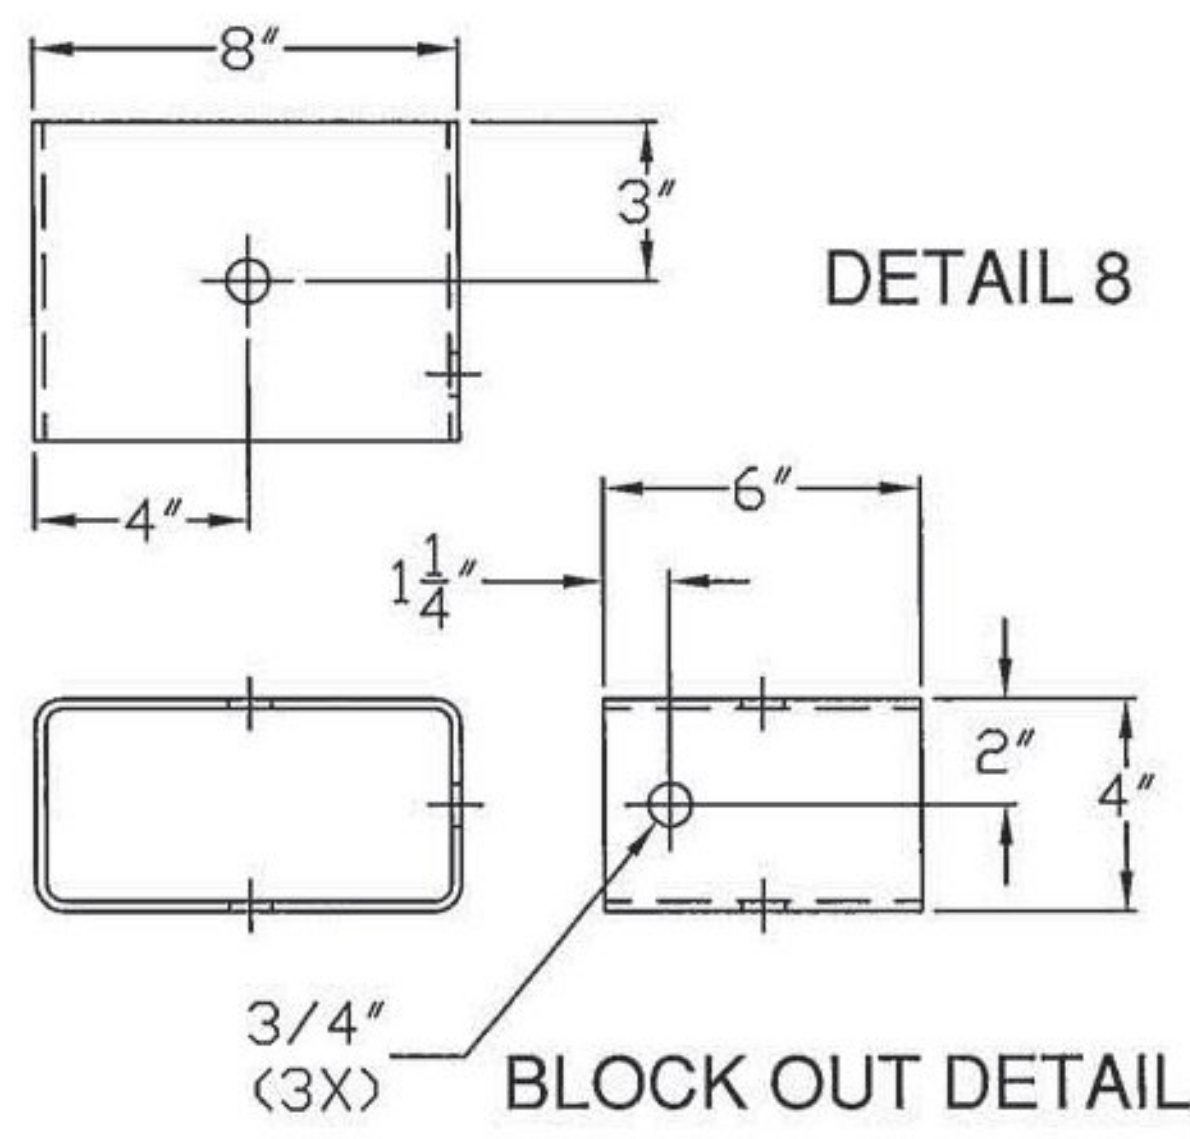


DETAIL 8

3/4" (3X) BLOCK OUT DETAIL

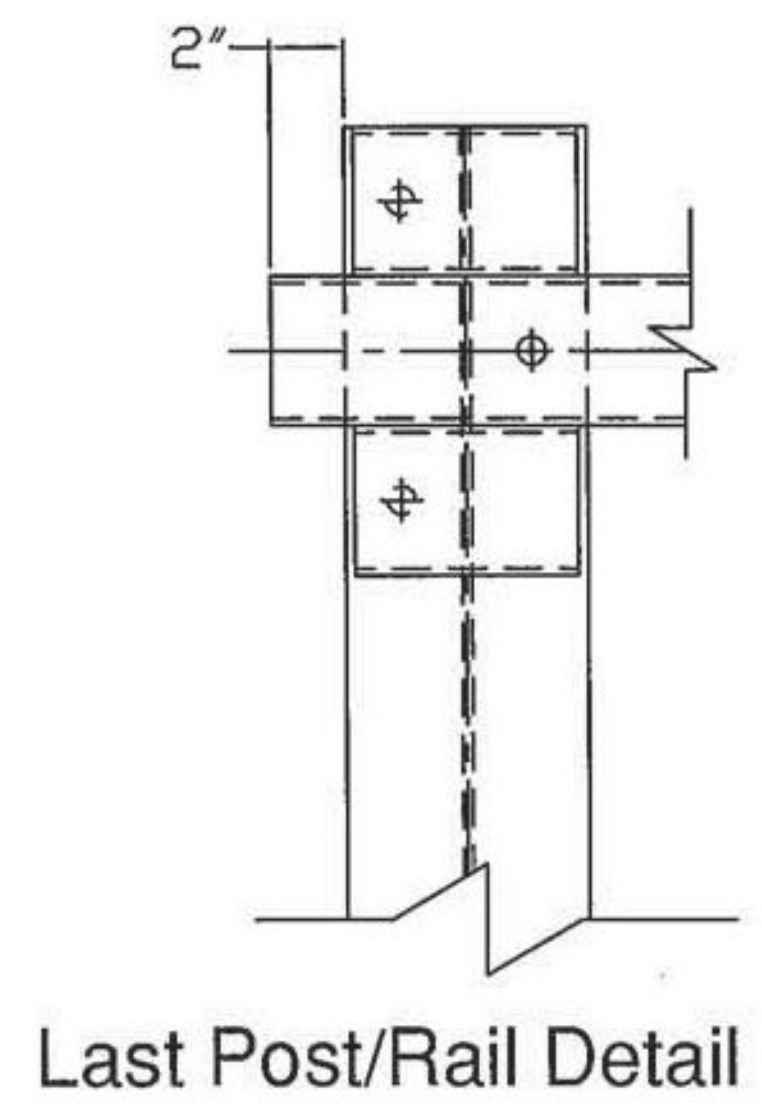

Last Post/Rail Detail

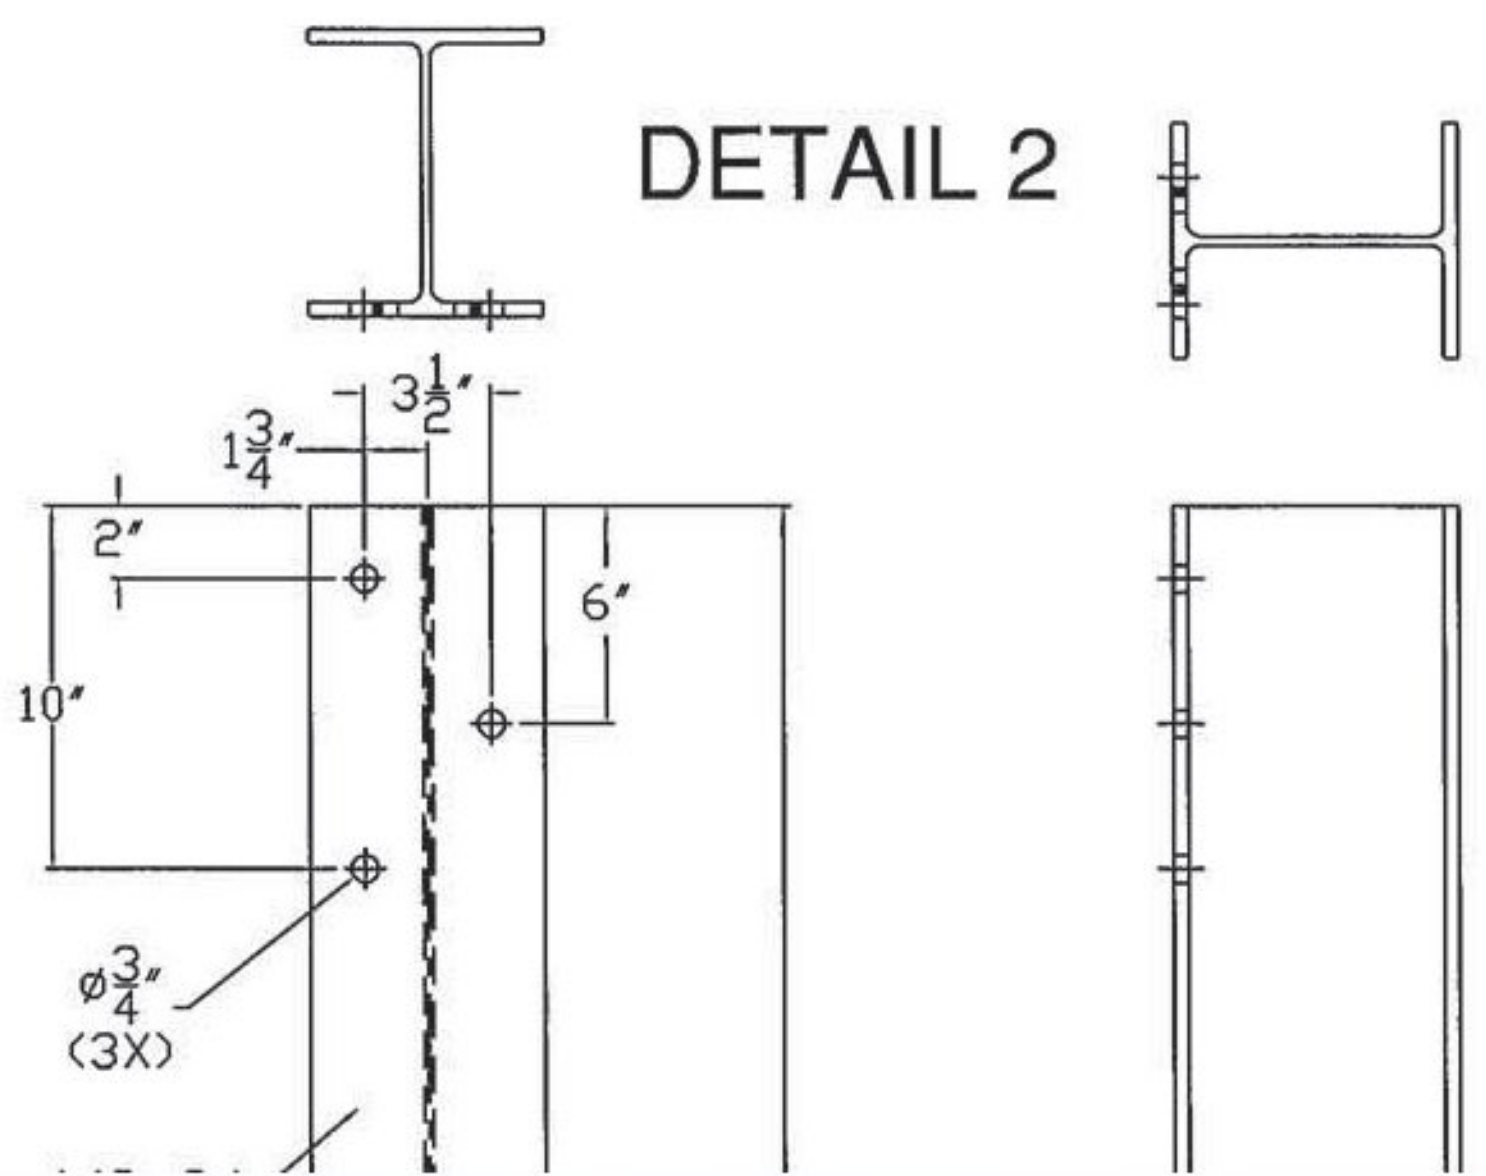

DETAIL 2

### SHOP DRAWING REVIEW


REVIEWED AS REQUIRED BY THE CONSTRUCTION CONTRACT DOCUMENTS AND APPROVED, BUT ONLY FOR CONFORMANCE TO THE DESIGN CONCEPT OF THE WORK, AND SUBJECT TO FURTHER LIMITATIONS AND REQUIREMENTS CONTAINED IN THE CONSTRUCTION CONTRACT DOCUMENTS.

REJECTED       REVISE AND RESUBMIT       FURNISH AS CORRECTED

CORRECTIONS OR COMMENTS MADE ON THE SHOP DRAWINGS DURING THIS REVIEW DO NOT RELIEVE CONTRACTOR FROM COMPLIANCE WITH REQUIREMENTS OF THE DRAWINGS AND SPECIFICATIONS. THIS CHECK IS ONLY FOR REVIEW OF GENERAL CONFORMANCE WITH THE DESIGN CONCEPT OF THE PROJECT AND GENERAL COMPLIANCE WITH THE INFORMATION GIVEN IN THE CONTRACT DOCUMENTS. THE CONTRACTOR IS RESPONSIBLE FOR: CONFIRMING AND CORRELATING ALL QUANTITIES AND DIMENSIONS; SELECTING FABRICATION PROCESSES AND TECHNIQUES OF CONSTRUCTION; COORDINATING HIS WORK WITH THAT OF ALL OTHER TRADES; AND PERFORMING HIS WORK IN A SAFE AND SATISFACTORY MANNER.

**Vanasse Hangen Brustlin, Inc.**  
7056 US Route 7  
North Ferrisburgh, VT 05473  
802.425.7788

Job Number: 57428.00  
Reviewed By: S.E. Burbank  
Date: 7/24/2014

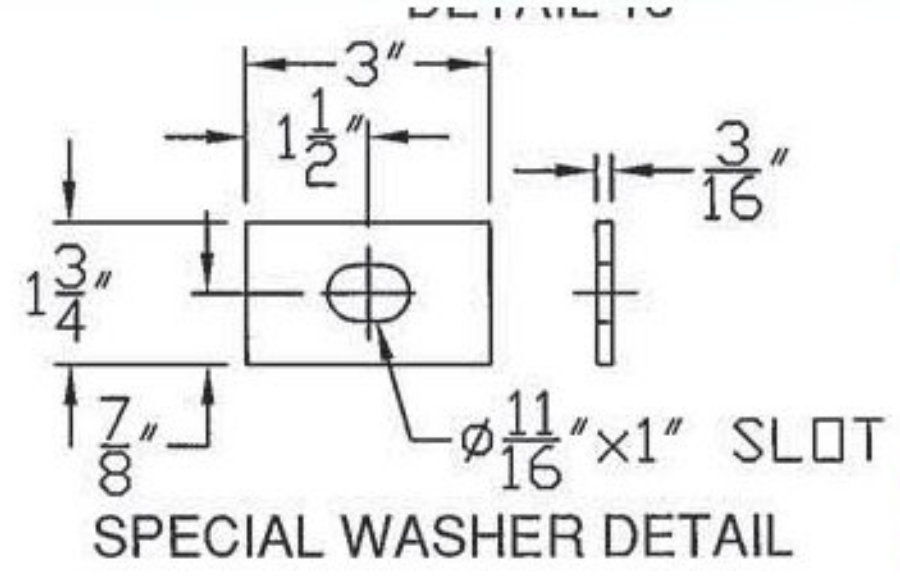

SPECIAL WASHER DETAIL

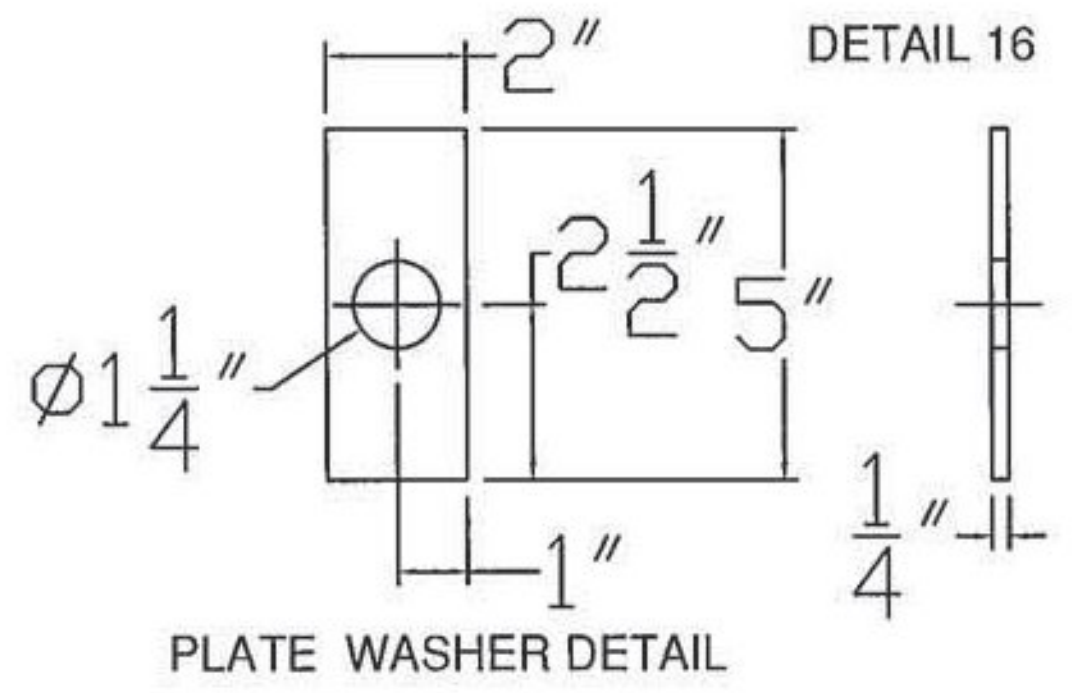


PLATE WASHER DETAIL


Vermont Agency of Transportation  
**RECEIVED**

CK'D BY MJC      OK'D BY TAS

July 23, 2014



RESUBMIT No      Approved

BY M. J. Chenette      DATE 07/24/2014

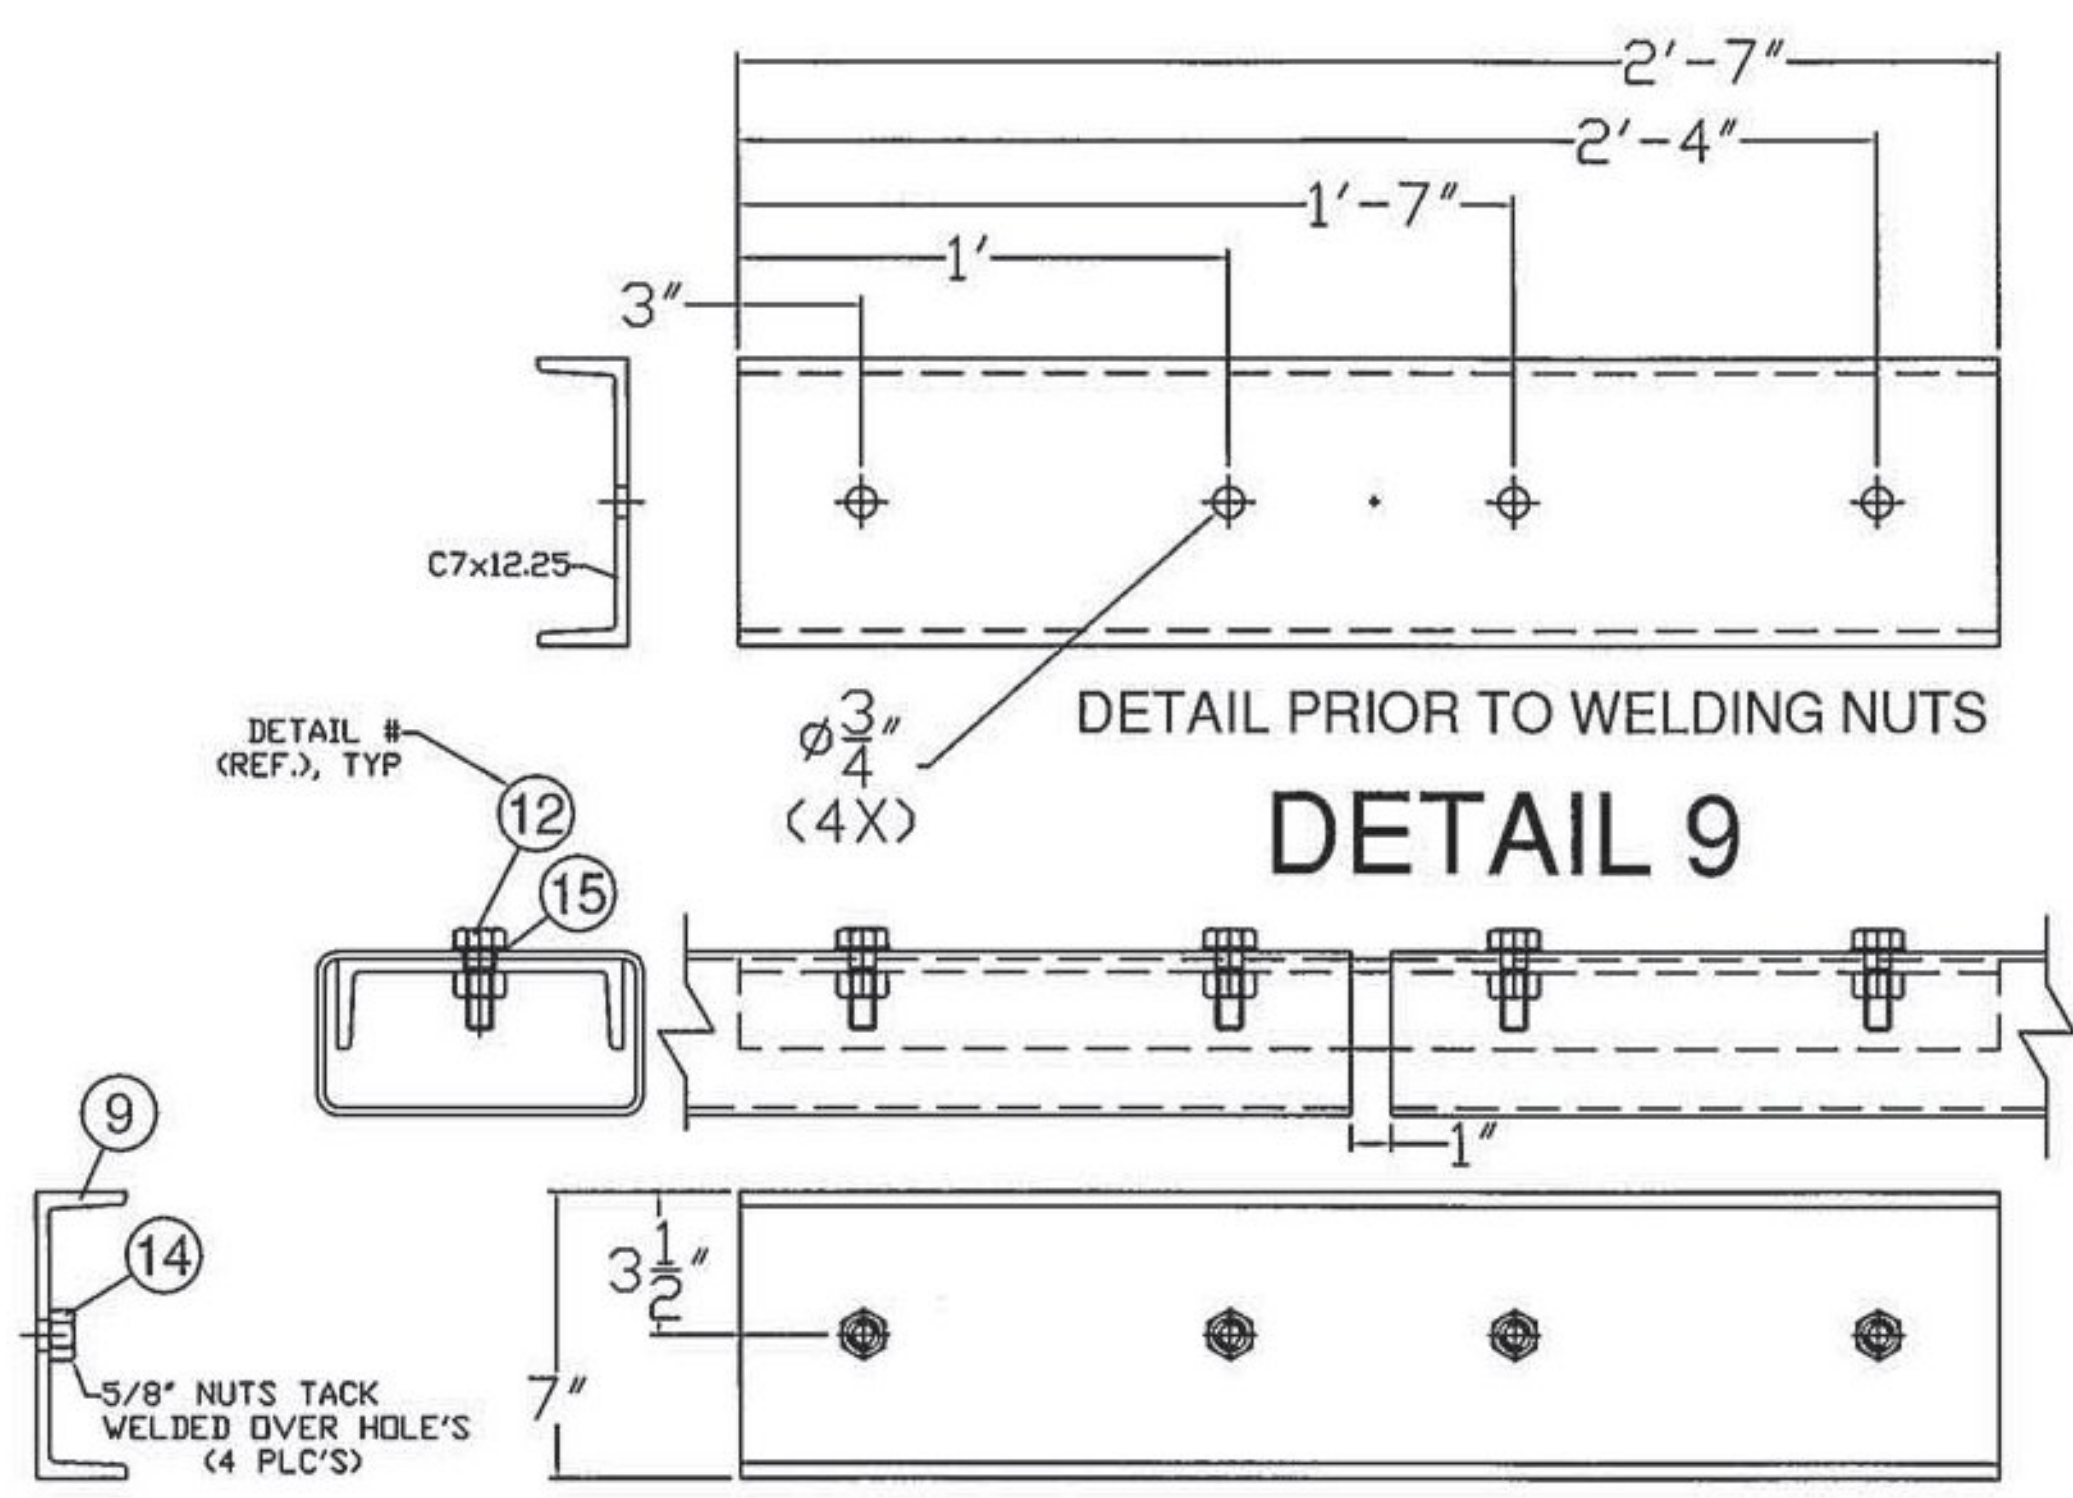

DETAIL 9

RAIL SPLICE HOLES (HARDWARE NOT SHOWN FOR CLARITY)

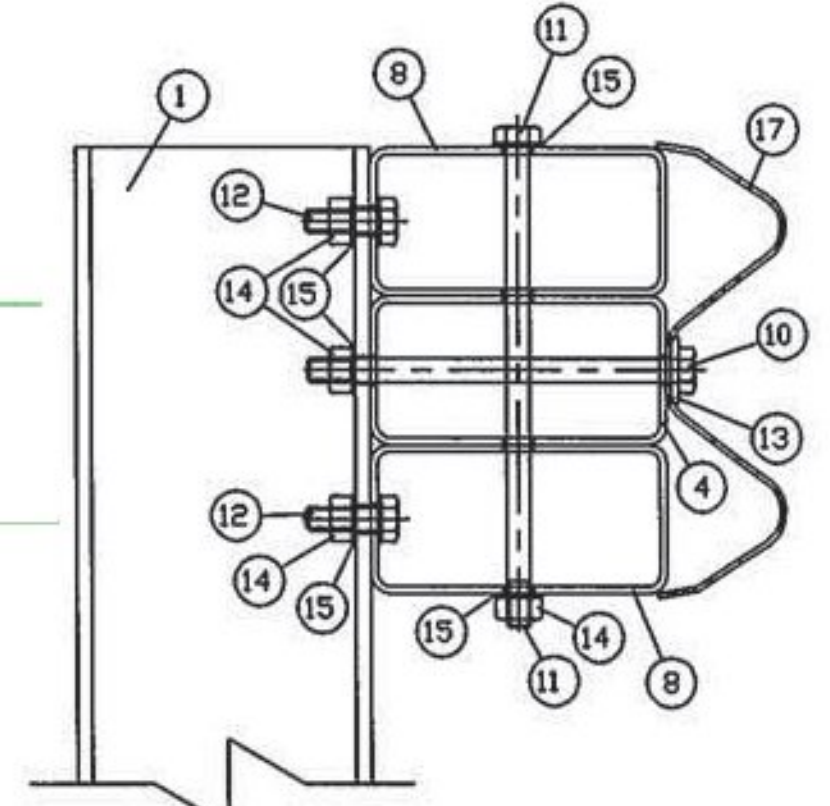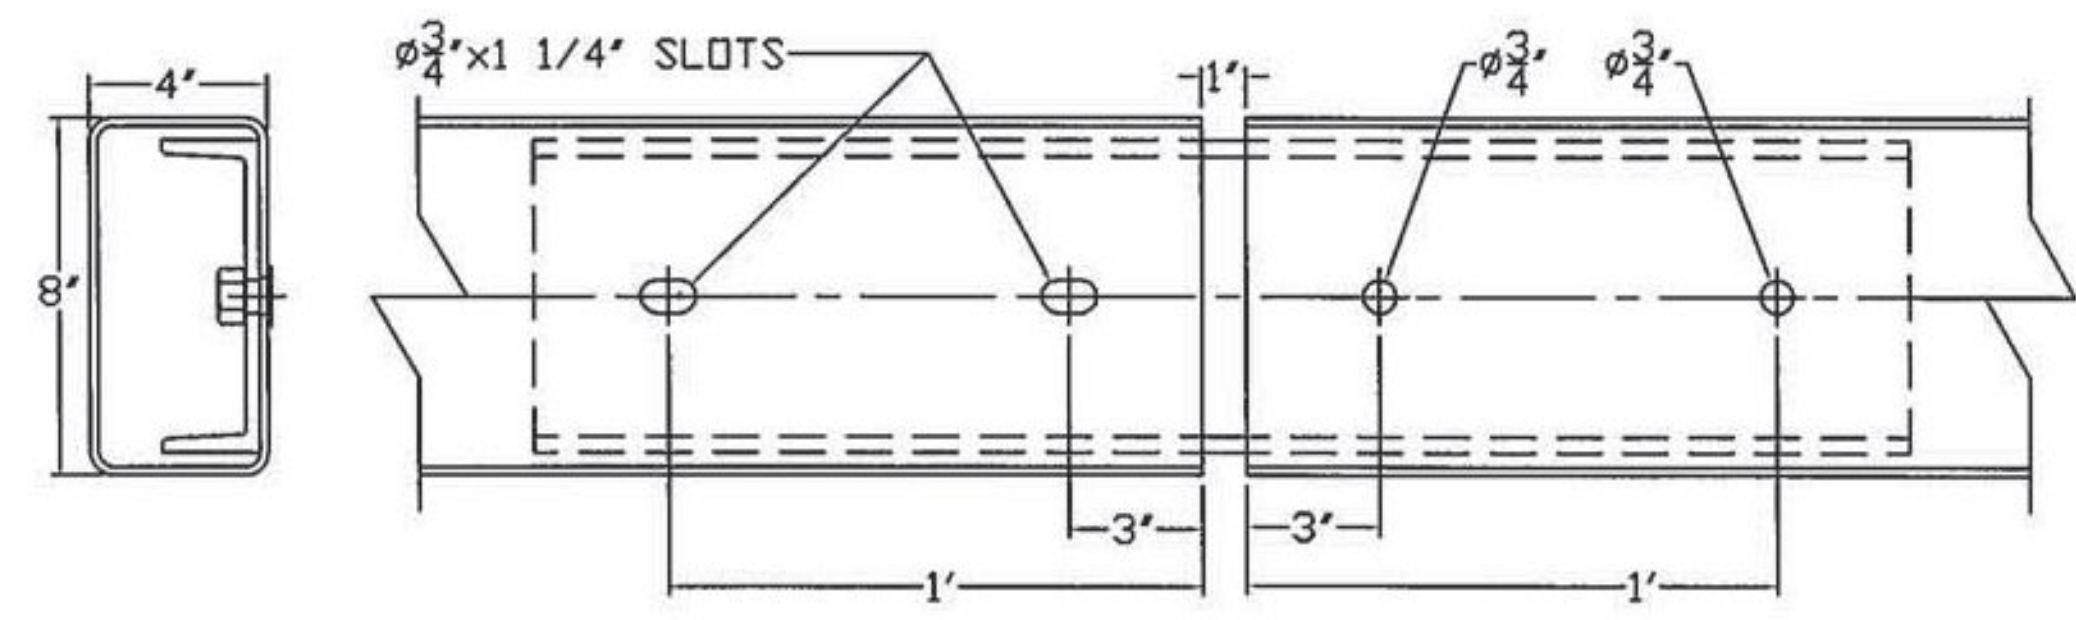

DETAIL 16

ITEM #: 900.640      SOLD TO: F.R. LAFAYETTE (PO#28720)      SHEET 2 OF 2


APPROVED BY: _____

**SPECIAL PROVISION BRIDGE RAIL, GALV. HDSB/FM/ST**  
BRATTLEBORO BRO 1442 (35) TH 12, CLASS III (LOCAL ROAD), BRIDGE NO. 7  
TOWN OF BRATTLEBORO, COUNTY OF WINDHAM, VERMONT



R NO.	DATE	DESCRIPTION	BY	R NO.	DATE	DESCRIPTION	BY
E 1	5/23/14	REVISED PER 5/22/14 MARK-UP	EP	E			
V 2	6/18/14	REVISED PER 6/12/14 MARK-UP	EP	V			

**ELDERLEE, INC.**  
OAKS CORNERS, NEW YORK 14518  
E-Mail: dlong@elderlee.com  
Tel: 315-789-6670 Fax: 315-789-6615

DRAWN	D.L.	05/07/2014
CHECKED	E.P.	05/07/2014
APPROVED		
SCALE	SCHEMATIC	
DRAWING NO.	FRL BRATTLEBORO	

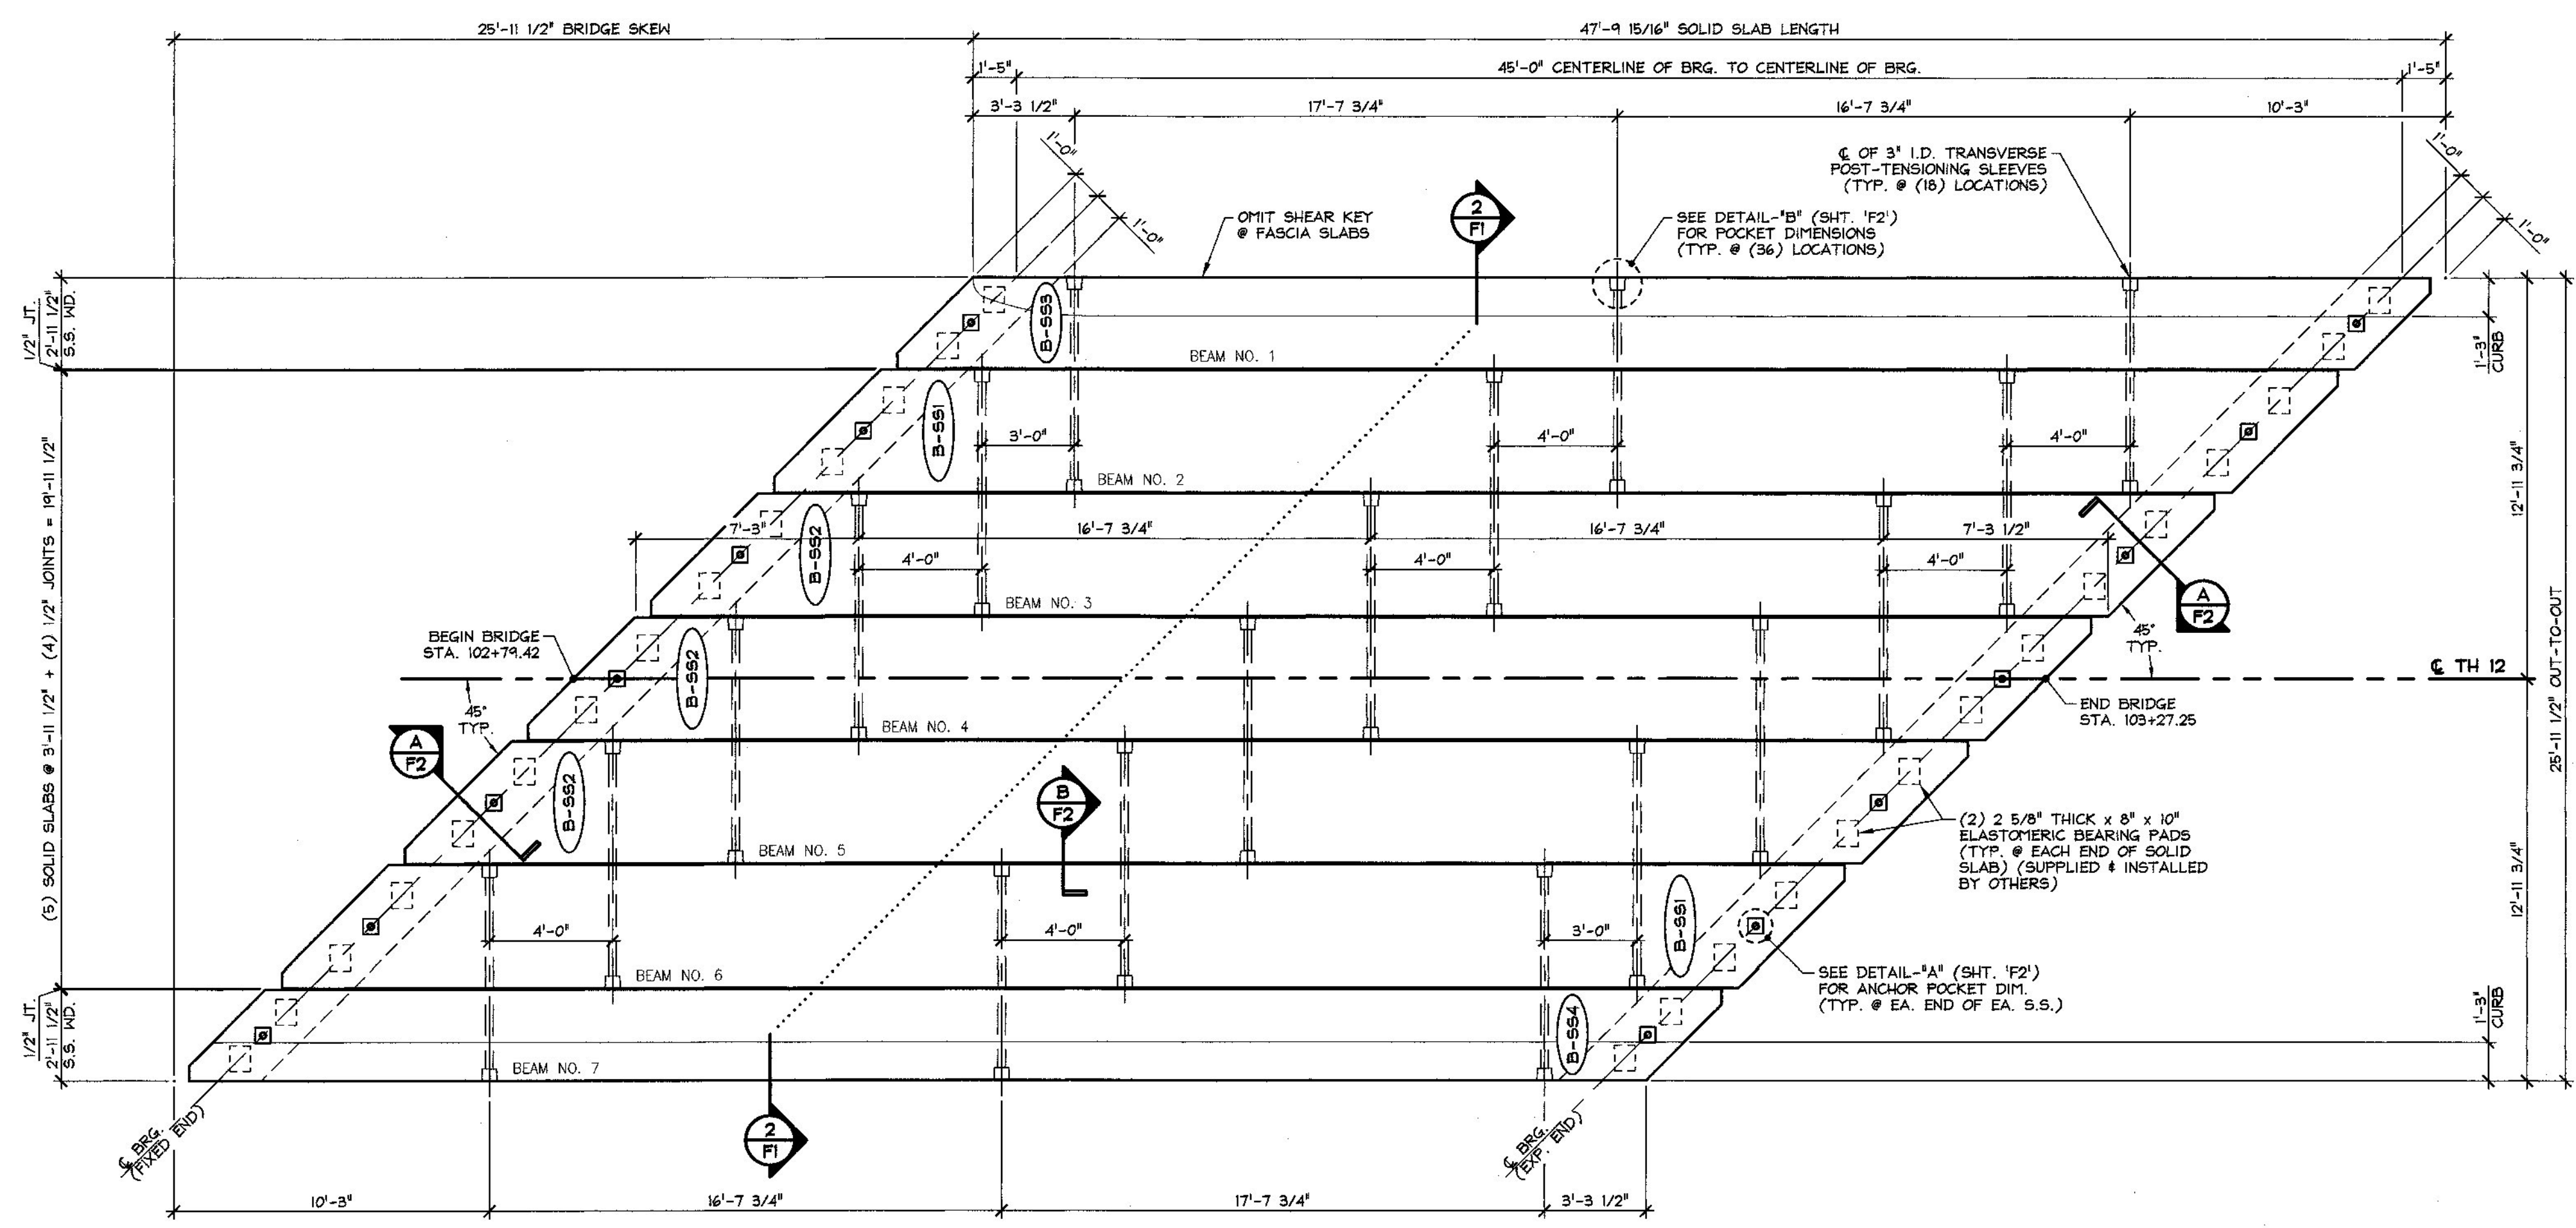

1 PRECAST SOLID SLAB LAYOUT  
1/4" = 1'-0"

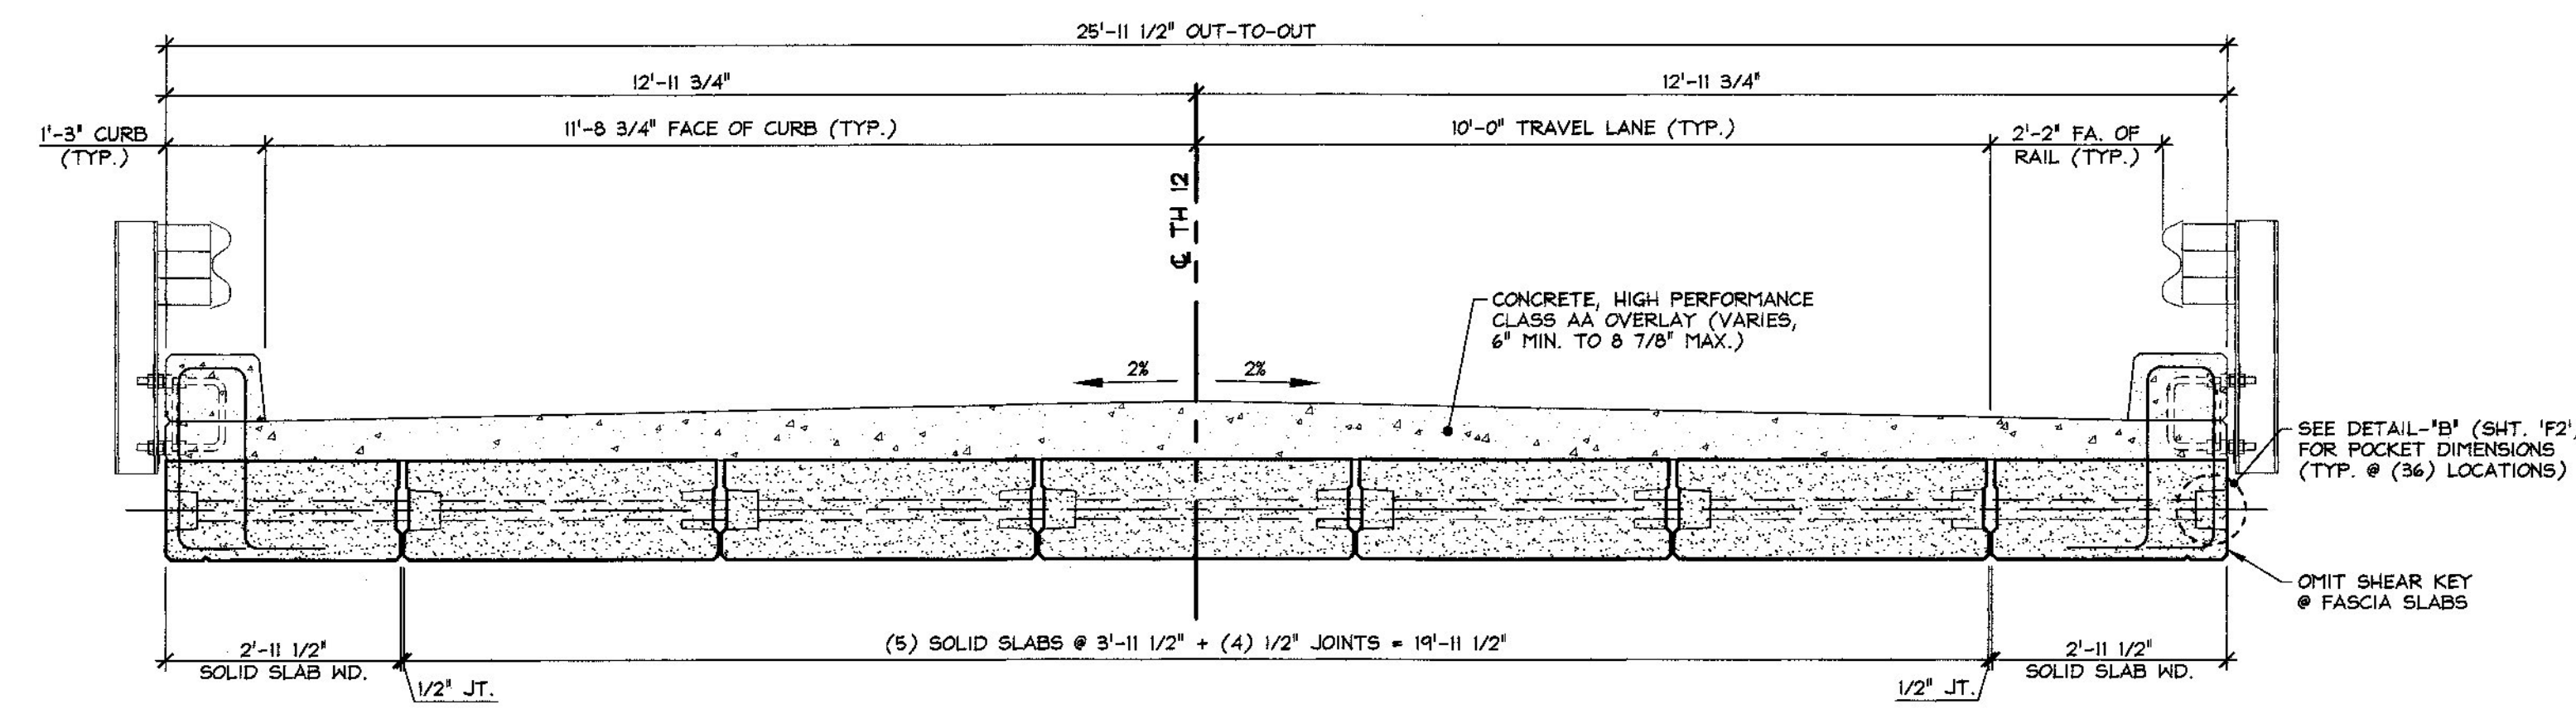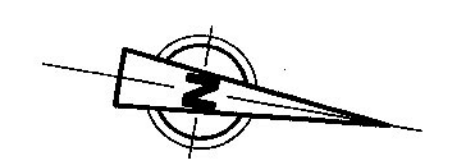

2 TRANSVERSE SECTION  
1/2" = 1'-0"

- ### CONSTRUCTION SEQUENCE
- ERECT SLABS STARTING AT THE LOWER EXTERIOR SLAB, PLACING ONE SLAB AT A TIME:
    - PLACE SLABS TO FIT WITHIN THE WORKING LINES.
    - PRIOR TO INSTALLING INTERIOR SLABS IN EACH PHASE OF CONSTRUCTION, INSTALL ANCHORED END OF THREADED STEEL ROD WITH ENOUGH ROD TO PASS THROUGH THE NEXT SLAB TO BE PLACED IN THE FOLLOWING PHASE OF CONSTRUCTION.
    - AS WORK PROGRESSES, INSTALL HARDWOOD WEDGES BETWEEN ADJACENT SLABS TO MAINTAIN PROPER JOINT OPENING (A MINIMUM OF ONE WEDGE AT EACH POST-TENSIONING DUCT).
    - DRILL ANCHOR BOLT HOLES.
    - PLACE ANCHOR BOLTS.
  - INSTALL BACKER ROD; PLACE FILLER BELOW THE KEYWAY BOTTOM, AS SHOWN ON THE PLANS.
  - INSTALL THREADED STEEL RODS:
    - FEED THREADED STEEL RODS THROUGH DUCTS.
    - VERIFY THAT HARDWOOD WEDGES ARE IN PLACE AS REQUIRED TO PREVENT SLIPPAGE OF SLABS.
    - USING A CALIBRATED JACK, POST-TENSION THE THREADED STEEL RODS TO APPROXIMATELY 5 KIPS TO SEAT THE ANCHOR NUT.
  - GROUT SHEAR KEYS:
    - CLEAN JOINTS WITH AN OIL FREE AIR-BLAST IMMEDIATELY BEFORE GROUT PLACEMENT. VERIFY THAT THE BACKER ROD IS STILL IN PLACE.
    - FOLLOW MANUFACTURER'S RECOMMENDATIONS FOR ADDITIONAL JOINT PREPARATION AND GROUT PLACEMENT.
    - CAREFULLY ROD JOINTS TO ELIMINATE ANY POSSIBILITY OF VOIDS.
  - POST-TENSION THREADED STEEL RODS:
    - GROUT SHALL ATTAIN A MINIMUM COMPRESSIVE STRENGTH OF 1,500 PSI, BASED ON THE MANUFACTURER'S RECOMMENDATIONS, PRIOR TO STRESSING. THE GROUT NEED NOT BE CURED FOR THREE DAYS PRIOR TO THE COMMENCING OF POST-TENSIONING.
    - PROVIDE APPROPRIATE CUBE MOLDS AS DESCRIBED IN AASHTO T106 FOR 3 SETS OF 3 DAY CUBES, 3 SETS OF 28 DAY CUBES AND AT A MINIMUM OF 3 MORE CUBES TO TEST FOR THE 1,500 PSI MINIMUM COMPRESSIVE STRENGTH (BY OTHERS).
    - POST-TENSION THREADED STEEL RODS TO 47 KIPS USING A CALIBRATED JACK OPERATED BY QUALIFIED PERSONNEL.
  - FOR EACH SOLID SLAB, REPEAT THE SEQUENCE SPECIFIED IN NOTES 1-7.

- ### GENERAL NOTES
- MIN. CONCRETE STRENGTH AT 28 DAYS SHALL BE 6,000 PSI.
  - MIN. CONCRETE STRENGTH AT STRESS TRANSFER SHALL BE 4,800 PSI.
  - REINFORCING STEEL SHALL BE GR-60, ASTM A-615 (AASHTO M31) AND SHALL BE LEVEL II, DUAL COATED.
  - PRESTRESSING STRANDS SHALL CONFORM TO ASTM A-416 (AASHTO M203) AND SHALL CONSIST OF 0.60" x 270 KSI 7-WIRE LOW RELAXATION STRANDS.
  - PRESTRESSING STRANDS SHALL EACH BE PULLED TO HAVE A NET TENSION OF 44.0 K AFTER ACCOUNTING FOR CHUCK SLIPPAGE. TENSION SHALL BE VERIFIED BY MEASURING STRAND ELONGATION (SEE EXAMPLE ELONGATION CALCULATION AND TENSIONING PROCEDURE, THIS SHEET.)
  - ENDS OF PRESTRESSING STRANDS SHALL BE RECESSED # GROUTED.
  - ALL EXPOSED CORNERS SHALL BE CHAMFERED 3/4".
  - THE TOP OF SLABS SHALL RECEIVE A TRANSVERSE RAKE FINISH ROUGHENED TO 1/4" AMPLITUDE.
  - SHEAR KEY SURFACES SHALL BE SAND BLASTED CLEAN.
  - SLABS SHALL BE HANDLED AND ERECTED USING THE LIFTING LOOPS ONLY. THE MINIMUM SLING ANGLE FROM THE HORIZONTAL SHALL BE 60°. THE PINS OF THE SHACKLES SHALL BE PLACED THROUGH THE LIFTING LOOPS. SEE DETAIL, SHEET 'F2'. SLABS SHALL BE STORED AND TRANSPORTED WITH TIMBER SUPPORTS WITHIN 2'-0" OF THE SLAB ENDS, UNLESS APPROVED BY J.P. CARRARA & SONS, INC.
  - MATERIAL SPECIFICATION AND MIX DESIGN SHALL CONFORM TO VERMONT SPEC. F510.02 AND F510.05 RESPECTIVELY.  
DESIGN MIX: J.P.C. BRIDGE MIX #425M
  - QUALITY CONTROL PROCEDURES ARE IN ACCORDANCE WITH PCI REQUIREMENTS. J.P. CARRARA & SONS, INC. IS A PCI CERTIFIED PLANT.
  - CURING METHOD: AS SOON AS THE TOP OF SLAB IS FINISHED, A COVER OF POLY AND A LAYER OF HOMOSOTE (OR BLUE BOARD) WILL BE PLACED OVER THE SLAB. THE DESIRED CURING TEMPERATURE RANGE SHALL NOT DROP BELOW 70°. THE TEMPERATURE SHALL BE MONITORED BY AUTOMATIC SENSOR INSTRUMENTS ON GRAPH CHARTS, SPACED NOT MORE THAN 100' APART, AND WILL CONTINUE UNTIL RELEASE STRENGTH IS ACHIEVED. (NATURAL CURE WITH NO EXTERNAL HEAT APPLIED). EACH CHART SHALL BE MARKED.
  - OWNER SHALL PROVIDE APPROPRIATE WATERPROOFING TO GROUTED SHEAR KEYS. J.P. CARRARA & SONS, INC. SHALL NOT BE HELD LIABLE FOR PROBLEMS ASSOCIATED WITH MOISTURE INFILTRATING GROUTED SHEAR KEYS.

### EXAMPLE PRESTRESSING STRAND ELONGATION CALC. AND TENSIONING

(NOT TO BE USED FOR CONSTRUCTION)

SIZE & GRADE: 0.60" x 270 KSI  
AREA: 0.217 in²  
TENSION: 44,000 LB. EACH STRANDS  
GRIP-TO-GRIP: 192'-9 3/4" = 192.813'  
E_s = 28,600,000 PSI (ASSUMED FOR THESE CALCULATIONS; VALUE TO BE OBTAINED FOR STRAND SPOOL ACTUALLY USED)

EXAMPLE:  
$$\Delta = \frac{PL}{AE} = \frac{(44,000 - 3,000) \times 192.813 \times 12}{0.217 \times 28,600,000} = 15.29"$$

THEREFORE: (TOLERANCES ± 5%)  
 $\Delta$  UPPER LIMIT = 1.05 x 15.29" = 16.05" = 16 1/16"  
 $\Delta$  LOWER LIMIT = 0.95 x 15.29" = 14.53" = 14 1/2"

EXTRA FORCE REQUIRED TO COMPENSATE FOR 1/2" CHUCK SLIPPAGE:  
 $\Delta P = \frac{0.5 \times 41,000}{15.29} = 1,340$  LBS.

TOTAL TENSIONING FORCE = 44,000 + 1,340 = 45,340 LBS.

- ### STRAND TENSIONING PROCEDURE:
- PULL EACH STRAND INITIALLY TO 3,000* LBS. AND MARK STRAND.
  - THEN PULL EACH STRAND TO A TOTAL TENSION OF 45,340 LBS. AND MEASURE ELONGATION AFTER SEATING. IT MUST BE BETWEEN 14 1/2" & 16 1/16".
- * NOTE: FORCES READ ON STRESSING JACK GAUGES MUST BE MADE TO CORRESPOND TO ABOVE VALUES BASED ON CALIBRATION DATA FOR SPECIFIC JACK USED.

Vermont Agency of Transportation  
**RECEIVED**  
CK'D BY MJC OK'D BY TAS  
April 24, 2014  
RESUBMIT No Approved AsNoted  
BY M. J. Chenette DATE 04/29/2014

### SHOP DRAWING REVIEW


REVIEWED AS REQUIRED BY THE CONSTRUCTION CONTRACT DOCUMENTS AND APPROVED, BUT ONLY FOR CONFORMANCE TO THE DESIGN CONCEPT OF THE WORK, AND SUBJECT TO FURTHER LIMITATIONS AND REQUIREMENTS CONTAINED IN THE CONSTRUCTION CONTRACT DOCUMENTS.  
 REJECTED  REVISE AND RESUBMIT  FURNISH AS CORRECTED

CORRECTIONS OR COMMENTS MADE ON THE SHOP DRAWINGS DURING THIS REVIEW DO NOT RELIEVE CONTRACTOR FROM COMPLIANCE WITH REQUIREMENTS OF THE DRAWINGS AND SPECIFICATIONS. THIS CHECK IS ONLY FOR REVIEW OF GENERAL CONFORMANCE WITH THE DESIGN CONCEPT OF THE PROJECT AND GENERAL COMPLIANCE WITH THE INFORMATION GIVEN IN THE CONTRACT DOCUMENTS. THE CONTRACTOR IS RESPONSIBLE FOR CONFIRMING AND CORRELATING ALL QUANTITIES AND DIMENSIONS, SELECTING FABRICATION PROCESSES AND TECHNIQUES OF CONSTRUCTION, COORDINATING HIS WORK WITH THAT OF ALL OTHER TRADES, AND PERFORMING HIS WORK IN A SAFE AND SATISFACTORY MANNER.


**Vanasse Hangen Brustlin, Inc.**  
7056 US Route 7  
North Ferrisburgh, VT 05473  
802-425-7788

Job Number: 57528.00  
Reviewed By: E.A. FIALA  
Date: 04/29/2014


APPROVAL STAMP:	<b>J.P. CARRARA &amp; SONS INC.</b> Precast & Prestress Manufacturer 244 ODE SR., MIDDLEBURY, VERMONT 05753 Phone:(802)388-6361 Fax:(802)388-9010	<b>RENAUD BRO., INC.</b> Contractor VERNON, VERMONT
	STATE OF VERMONT AGENCY OF TRANSPORTATION COUNTY OF WINDHAM	DATE: MAR. 24, 2014 SCALE: NOTED
	TOWN OF BRATTLEBORO TH 12, CLASS III (LOCAL ROAD) OVER HALLADAY BROOK BRIDGE NO.: 7 PROJECT NO.: BRO 1442(95)	CHKD: M.D. DFTM: B.L. JOB NO: 23424-014
	<b>SUPERSTRUCTURE PLAN &amp; SECTION</b>	DWG. NO: <b>F1</b>

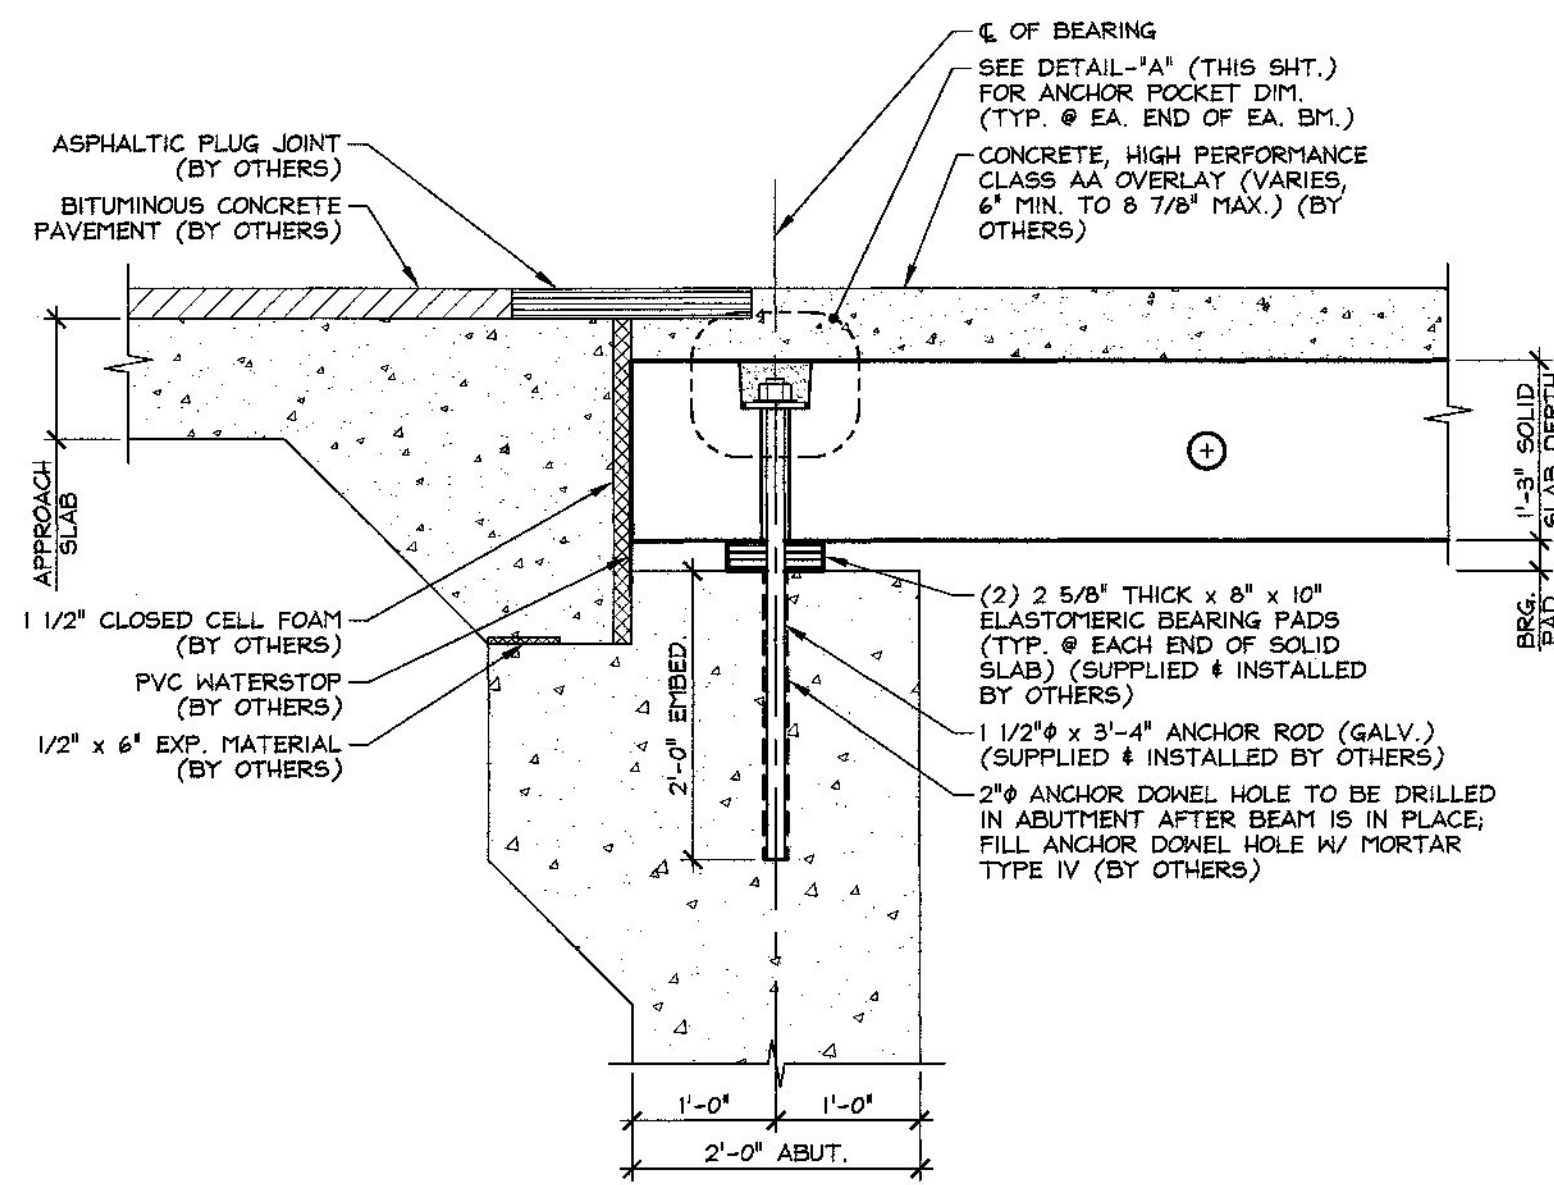


**A BEARING SECTION**  
F2  
3/4" = 1'-0"

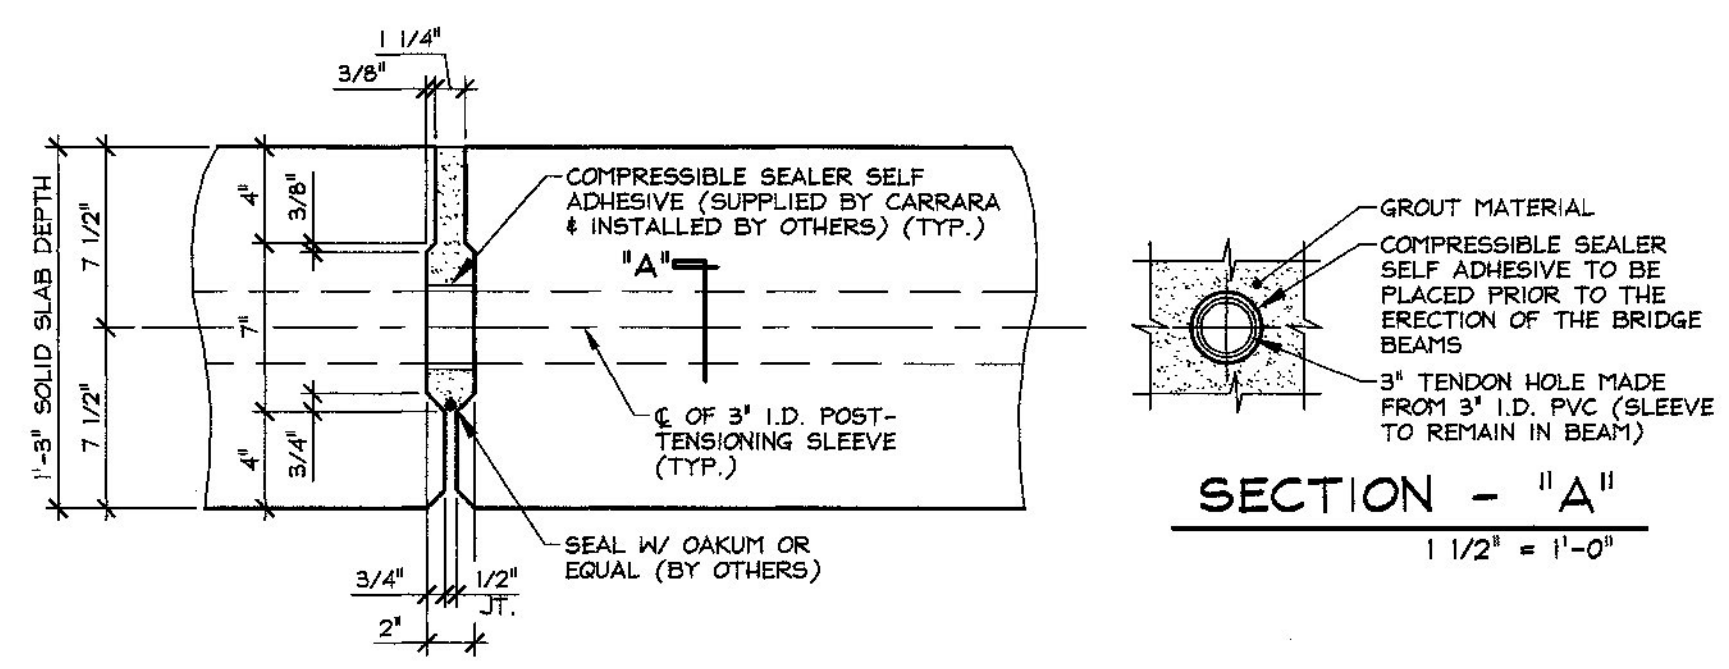


**B SHEAR KEY SECTION @ P.T. SLEEVE**  
F2  
1 1/2" = 1'-0"

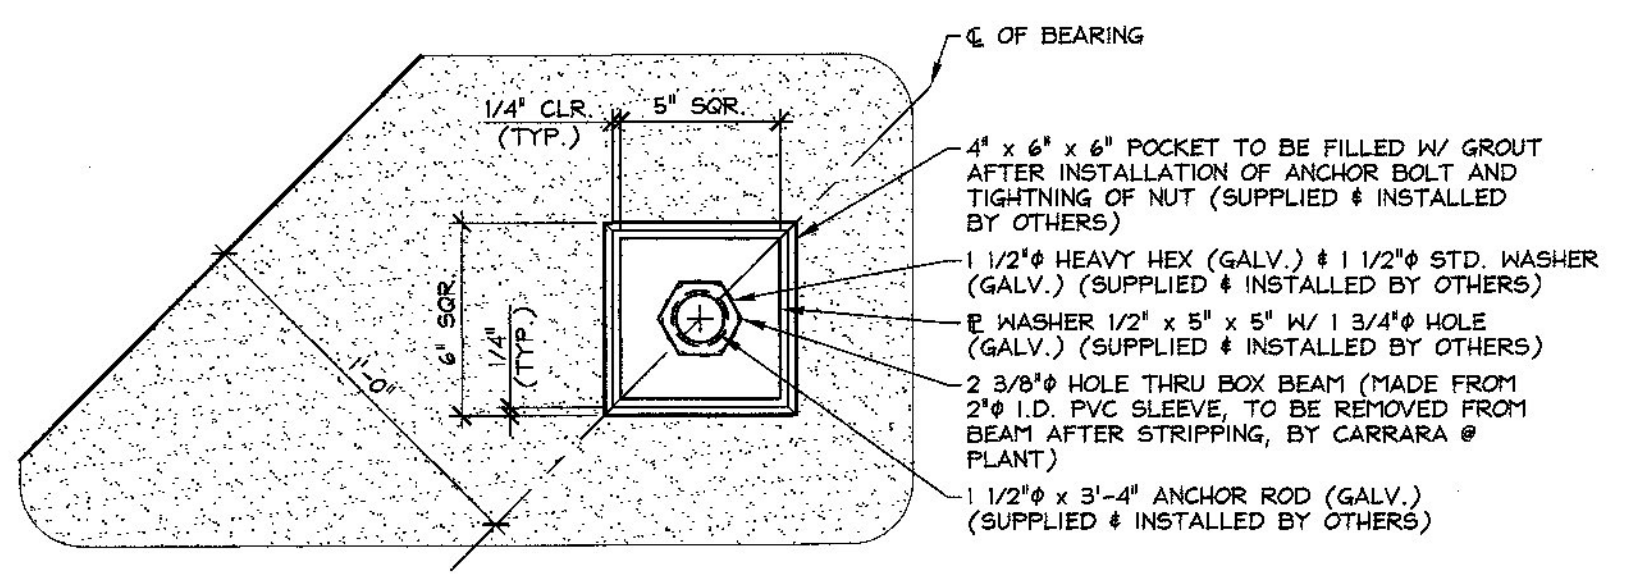


**PLAN OF BEAM C**

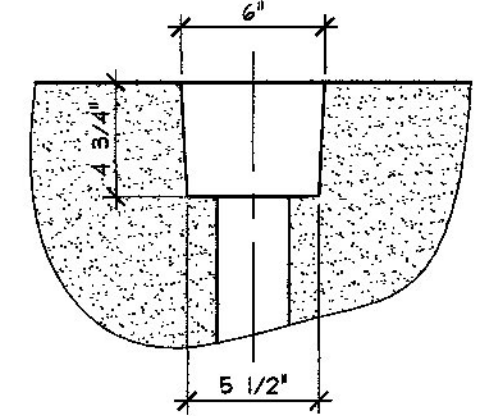


**PLAN OF POCKET**

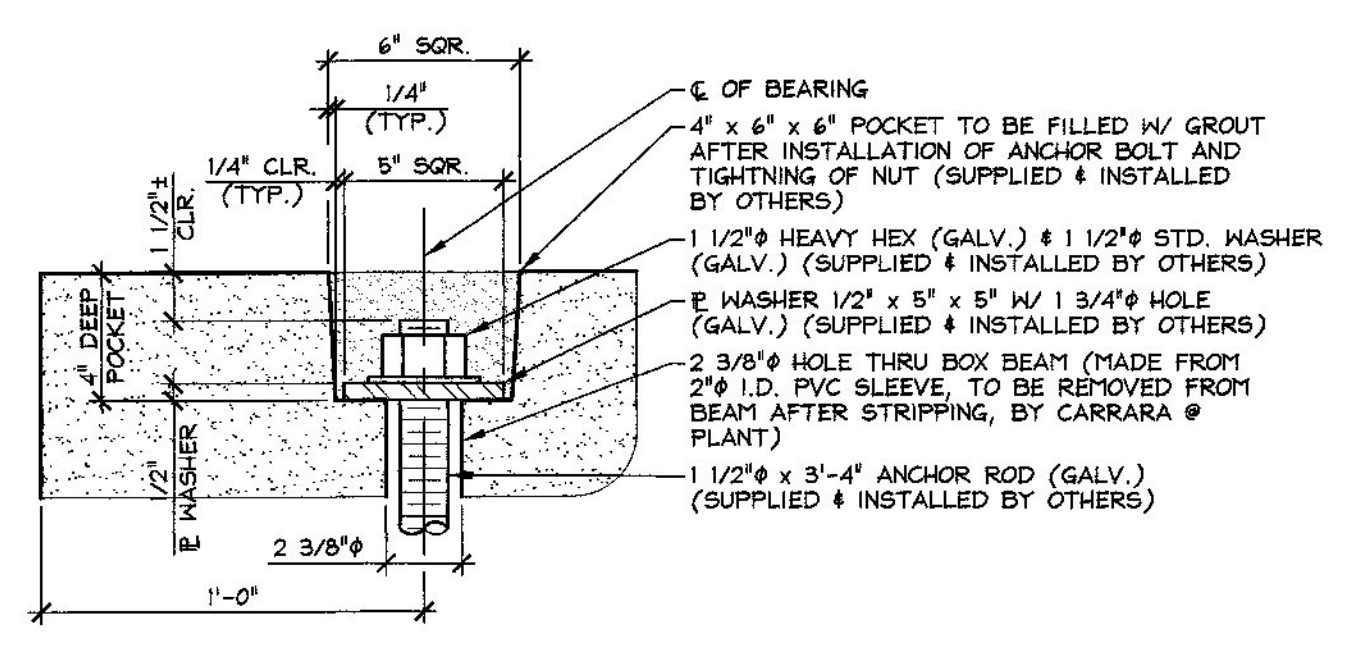

**SECTION OF BEAM C**  
DETAIL - "A"  
2" = 1'-0"

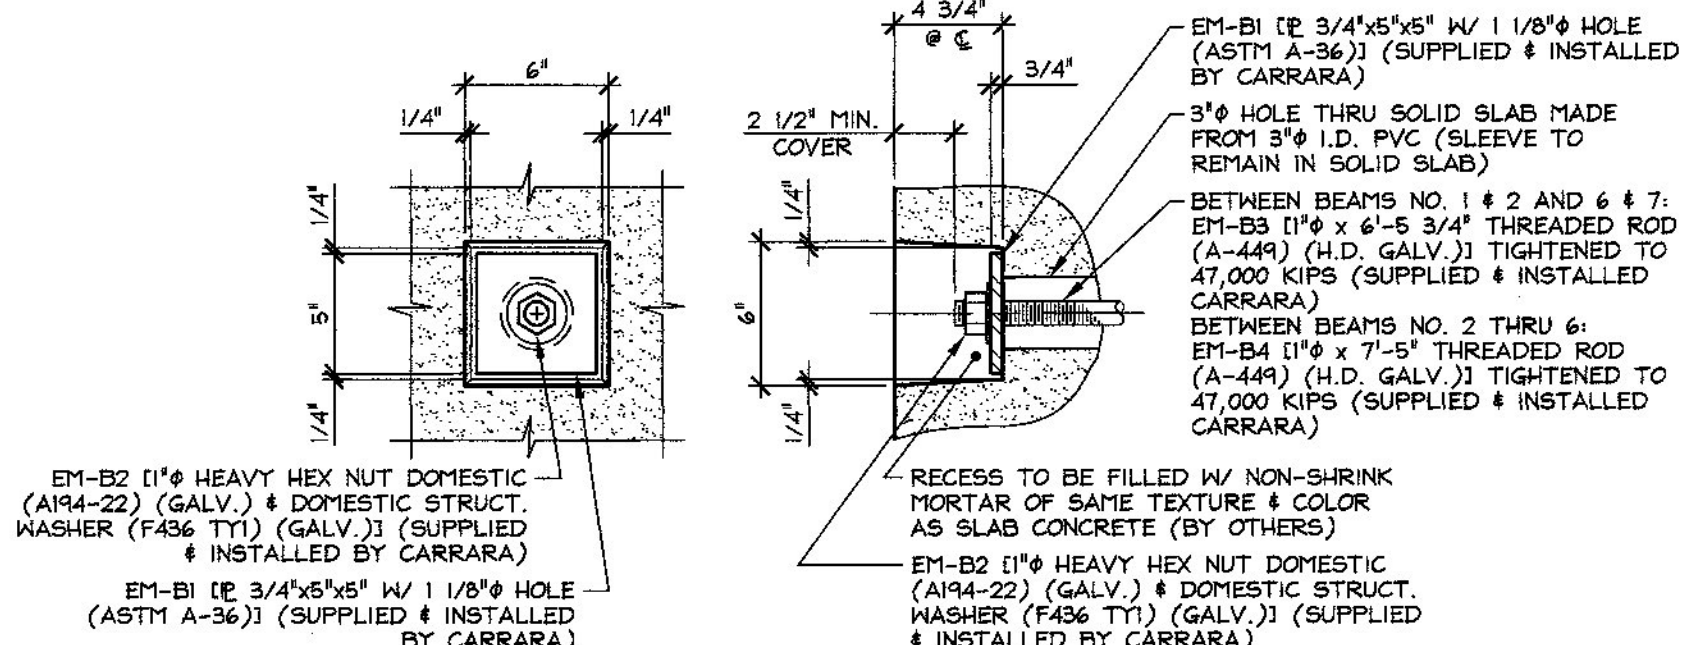

**FASCIA ELEVATION**  
**SECTION AT CENTERLINE**  
DETAIL - "B"  
1 1/2" = 1'-0"

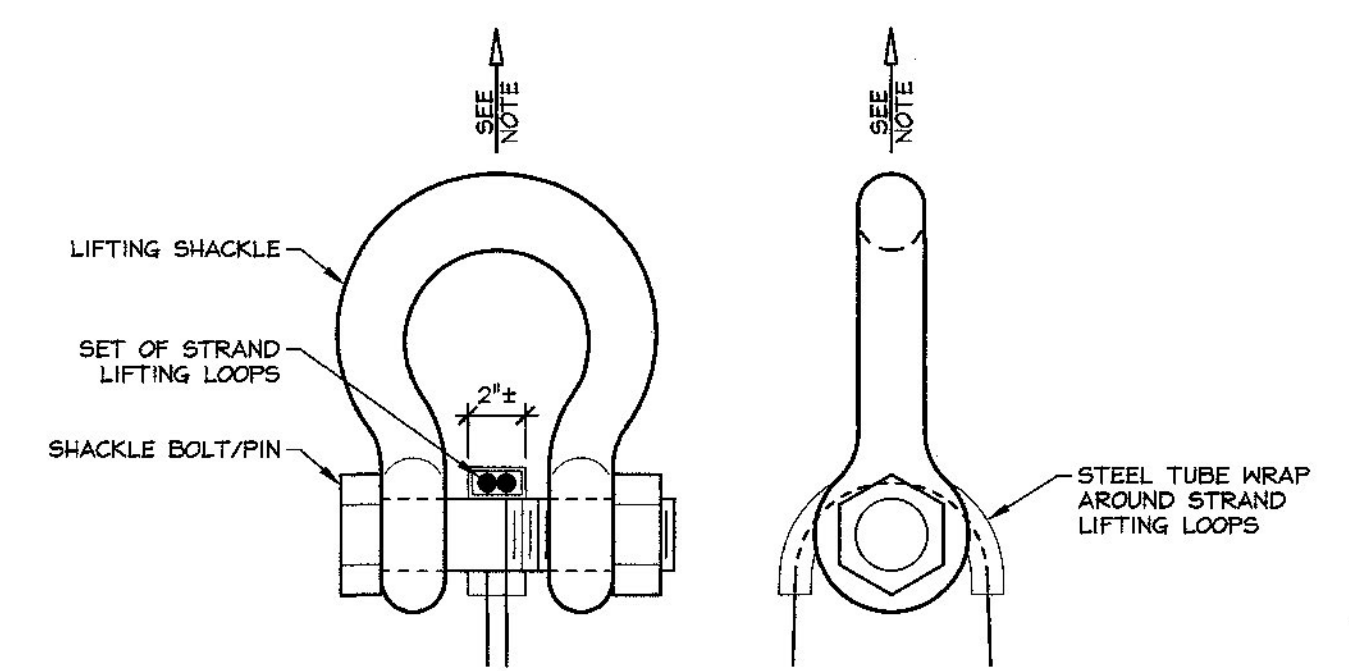


NOTE: SLAB SHALL BE HANDLED AND ERECTED USING THE LIFTING LOOPS ONLY. RIGGING SHALL BE CONFIGURED SUCH THAT EQUAL FORCES ARE APPLIED TO EACH SET OF LIFTING LOOPS AT EACH END OF THE SLAB. SHACKLE BOLT/PIN SHALL BE PLACED UNDER LIFT LOOPS AS SHOWN. DESIGN AND CONFIGURATION OF RIGGING BY PURCHASER.

**LIFTING SHACKLE DETAILS**  
N.T.S.


Vermont Agency of Transportation  
**RECEIVED**  
CK'D BY MJC OK'D BY TAS  
April 24, 2014  
RESUBMIT No Approved AsNoted  
BY M. J. Chenette DATE 04/29/2014

SHOP DRAWING REVIEW	
<input type="checkbox"/> REVIEWED AS REQUIRED BY THE CONSTRUCTION CONTRACT DOCUMENTS AND APPROVED, BUT ONLY FOR CONFORMANCE TO THE DESIGN CONCEPT OF THE WORK, AND SUBJECT TO FURTHER LIMITATIONS AND REQUIREMENTS CONTAINED IN THE CONSTRUCTION CONTRACT DOCUMENTS.	<input type="checkbox"/> REJECT
<input type="checkbox"/> REJECTED	<input type="checkbox"/> REVISE AND RESUBMIT
<input checked="" type="checkbox"/> FURNISH AS CORRECTED	
CORRECTIONS OR COMMENTS MADE ON THE SHOP DRAWINGS DURING THIS REVIEW DO NOT RELIEVE CONTRACTOR FROM COMPLIANCE WITH REQUIREMENTS OF THE DRAWINGS AND SPECIFICATIONS. THIS CHECK IS ONLY FOR REVIEW OF GENERAL CONFORMANCE WITH THE DESIGN CONCEPT OF THE PROJECT AND GENERAL COMPLIANCE WITH THE INFORMATION GIVEN IN THE CONTRACT DOCUMENTS. THE CONTRACTOR IS RESPONSIBLE FOR CONFIRMING AND CORRELATING ALL QUANTITIES AND DIMENSIONS, SELECTING FABRICATION PROCESSES AND TECHNIQUES OF CONSTRUCTION, COORDINATING HIS WORK WITH THAT OF ALL OTHER TRADES, AND PERFORMING HIS WORK IN A SAFE AND SATISFACTORY MANNER.	
<b>Vanasse Hangen Brustlin, Inc.</b> 7056 US Route 7 North Ferrisburgh, VT 05473 802.425.7788	Job Number: 57528.00 Reviewed By: E.A. FIALA Date: 04/28/2014

APPROVAL STAMP:	<b>J.P. CARRARA &amp; SONS INC.</b> Precast & Prestress Manufacturer 244 OASE ST., MIDDLEBURY, VERMONT 05753 Phone: (802)388-6361 Fax: (802)388-9010	<b>RENAUD BRO., INC.</b> CONTRACTOR VERNON, VERMONT
STATE OF VERMONT AGENCY OF TRANSPORTATION COUNTY OF WINDHAM		DATE: MAR. 24, 2014
TOWN OF BRATTLEBORO TH 12, CLASS III (LOCAL ROAD) OVER HALLADAY BROOK BRIDGE NO.: 7 PROJECT NO.: BRO 1442(35)		SCALE: NOTED
SUPERSTRUCTURE DETAILS		CHKD: M.D. DFTM: B.L. JOB NO: 23424-014 DWG. NO: F2

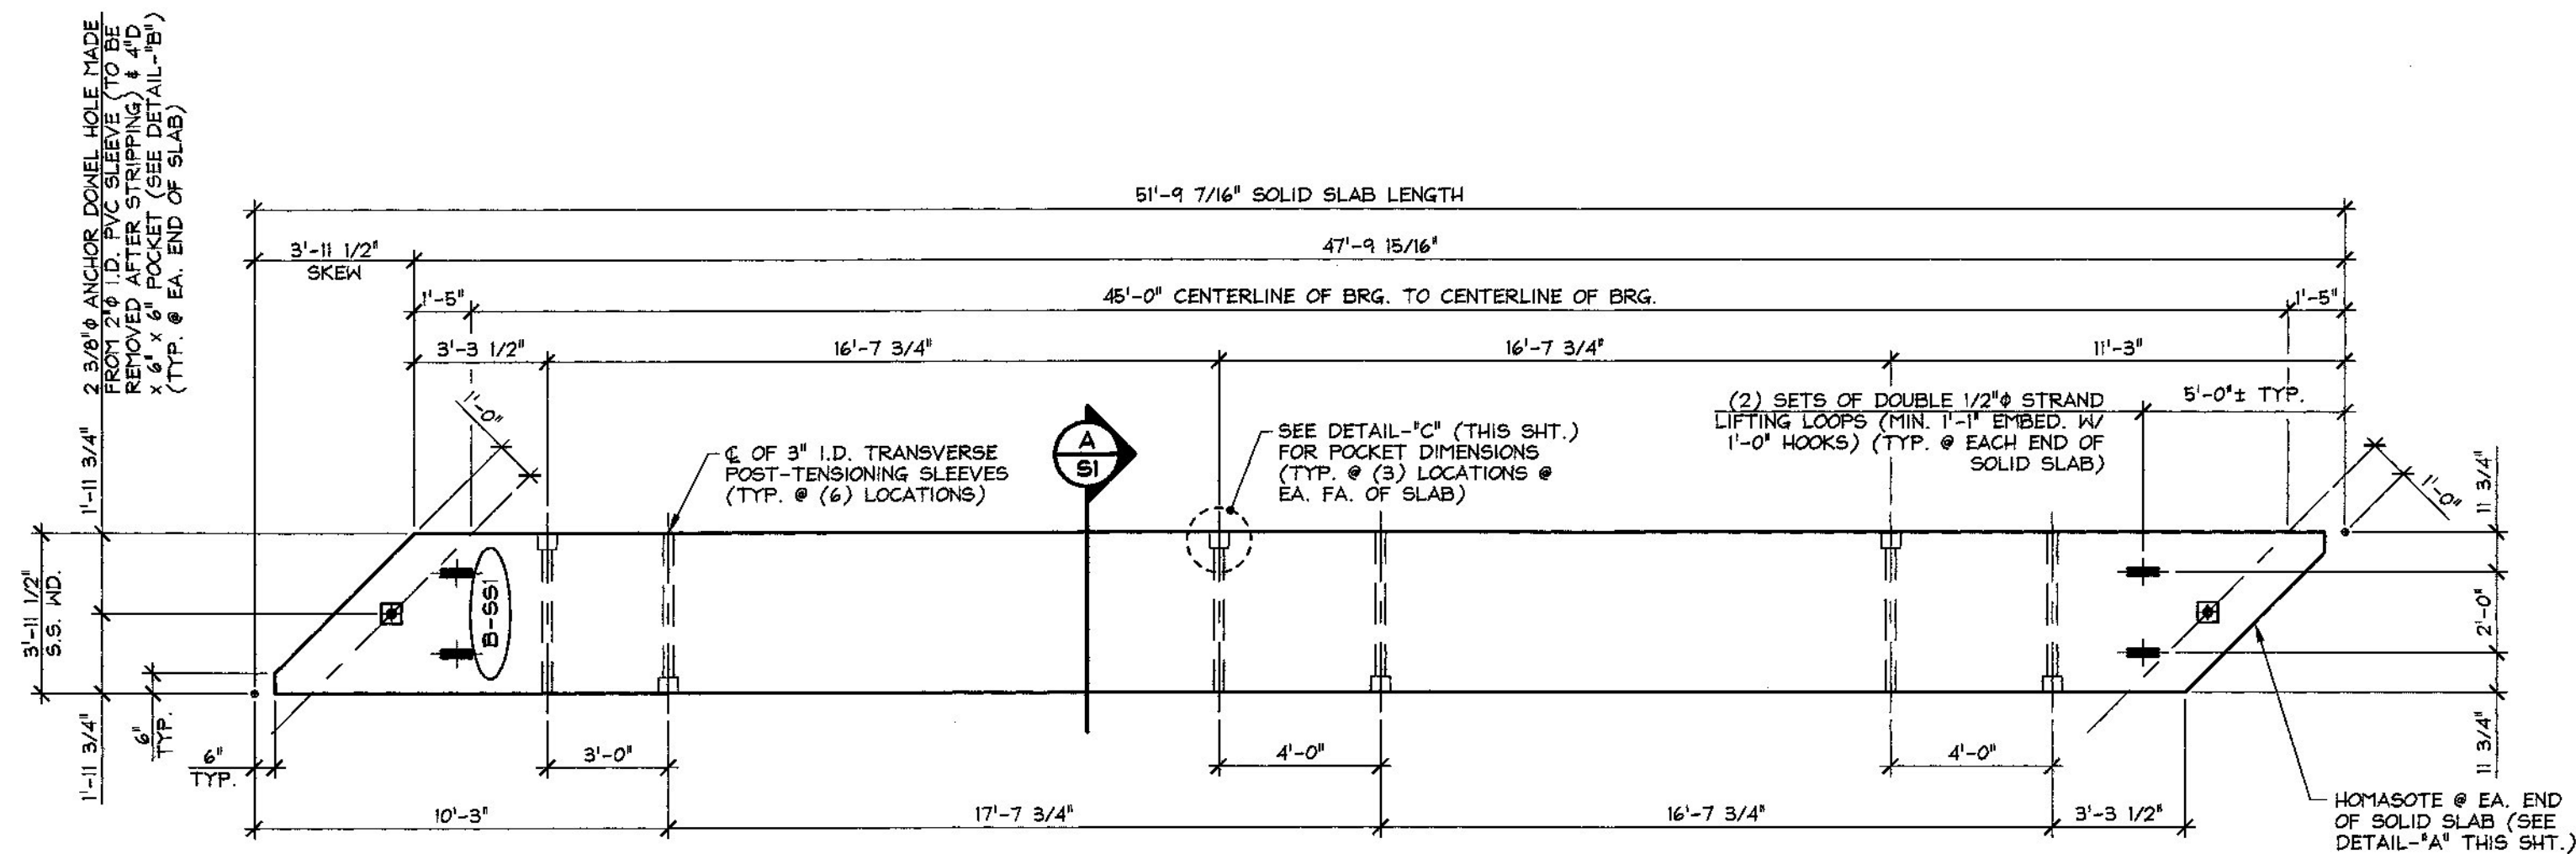

1 DIMENSIONAL PLAN VIEW IN FORM  
SI 1/4" = 1'-0"

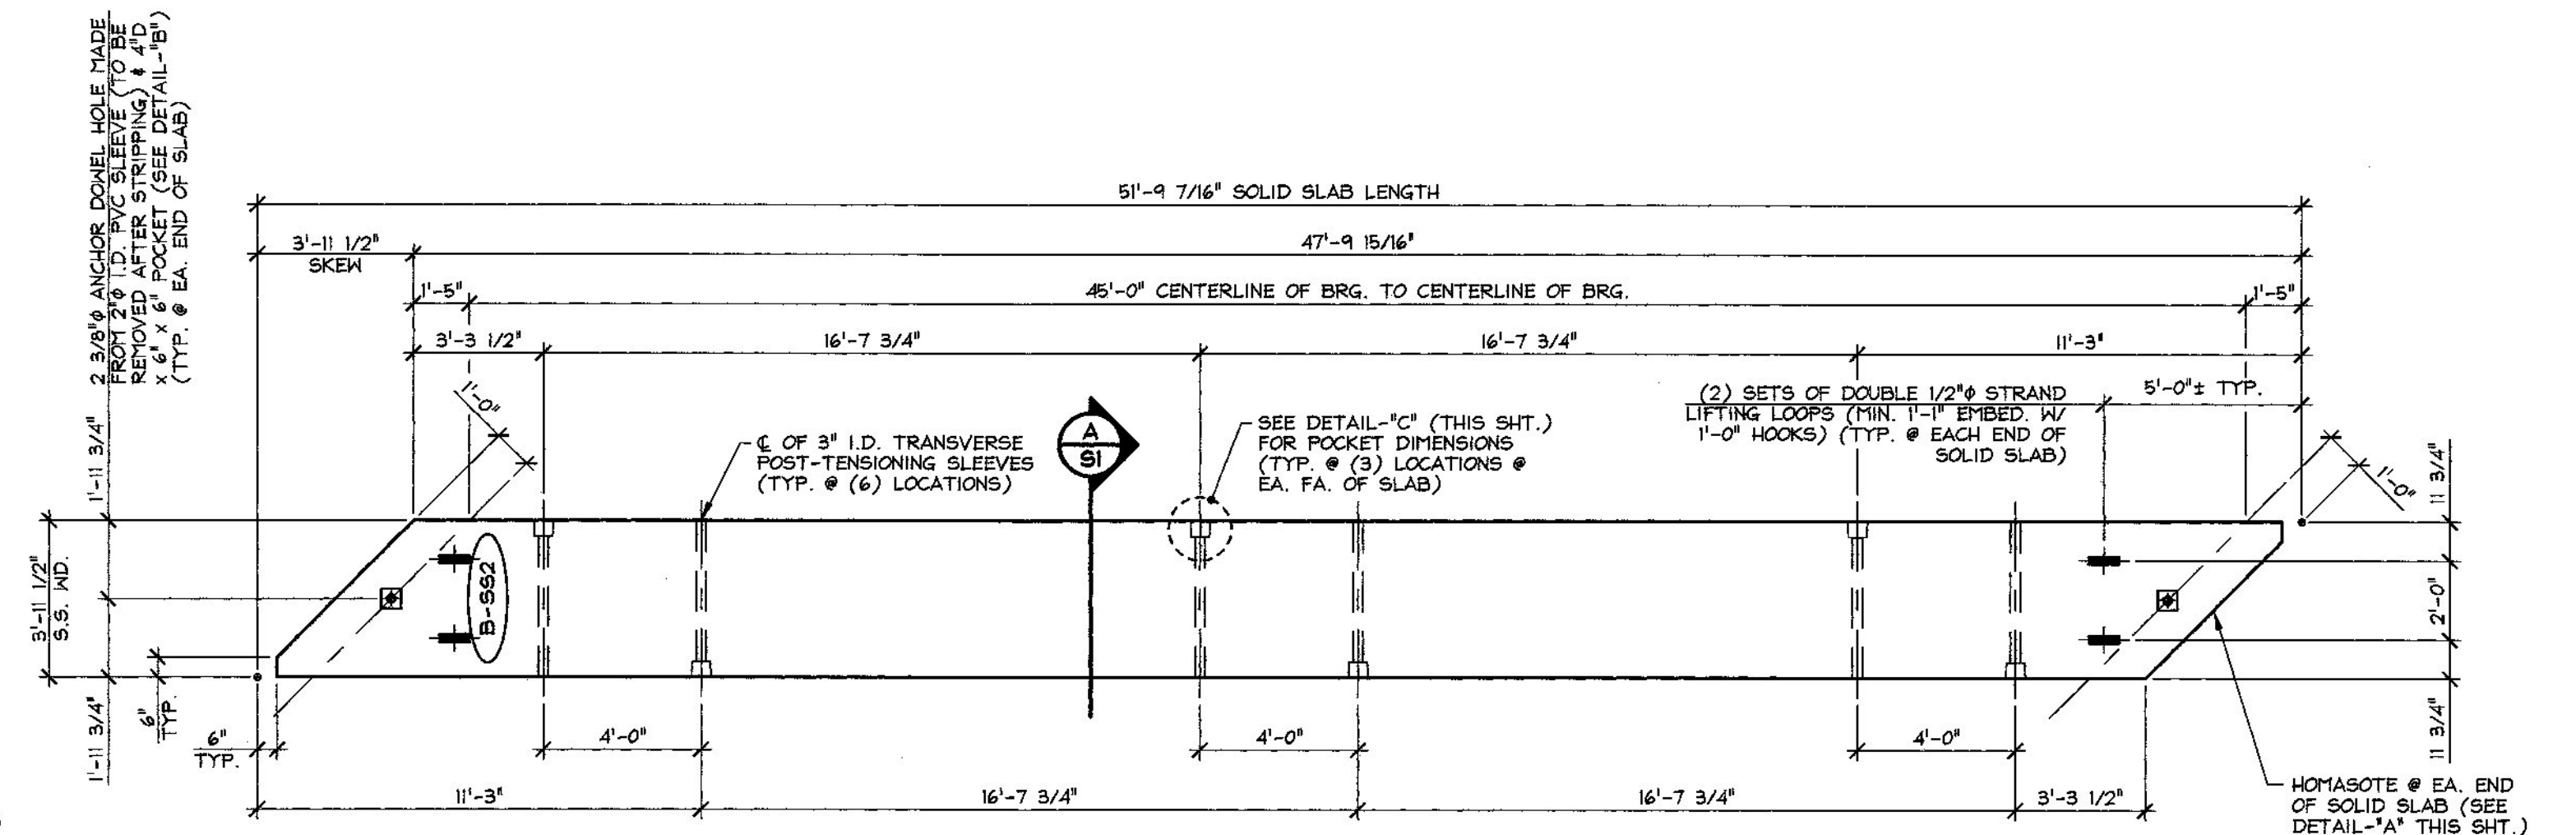


2 DIMENSIONAL PLAN VIEW IN FORM  
SI 1/4" = 1'-0"

Vermont Agency of Transportation  
**RECEIVED**

CK'D BY MJC OK'D BY TAS


April 24, 2014

RESUBMIT No Approved AsNoted  
BY M. J. Chenette DATE 04/29/2014

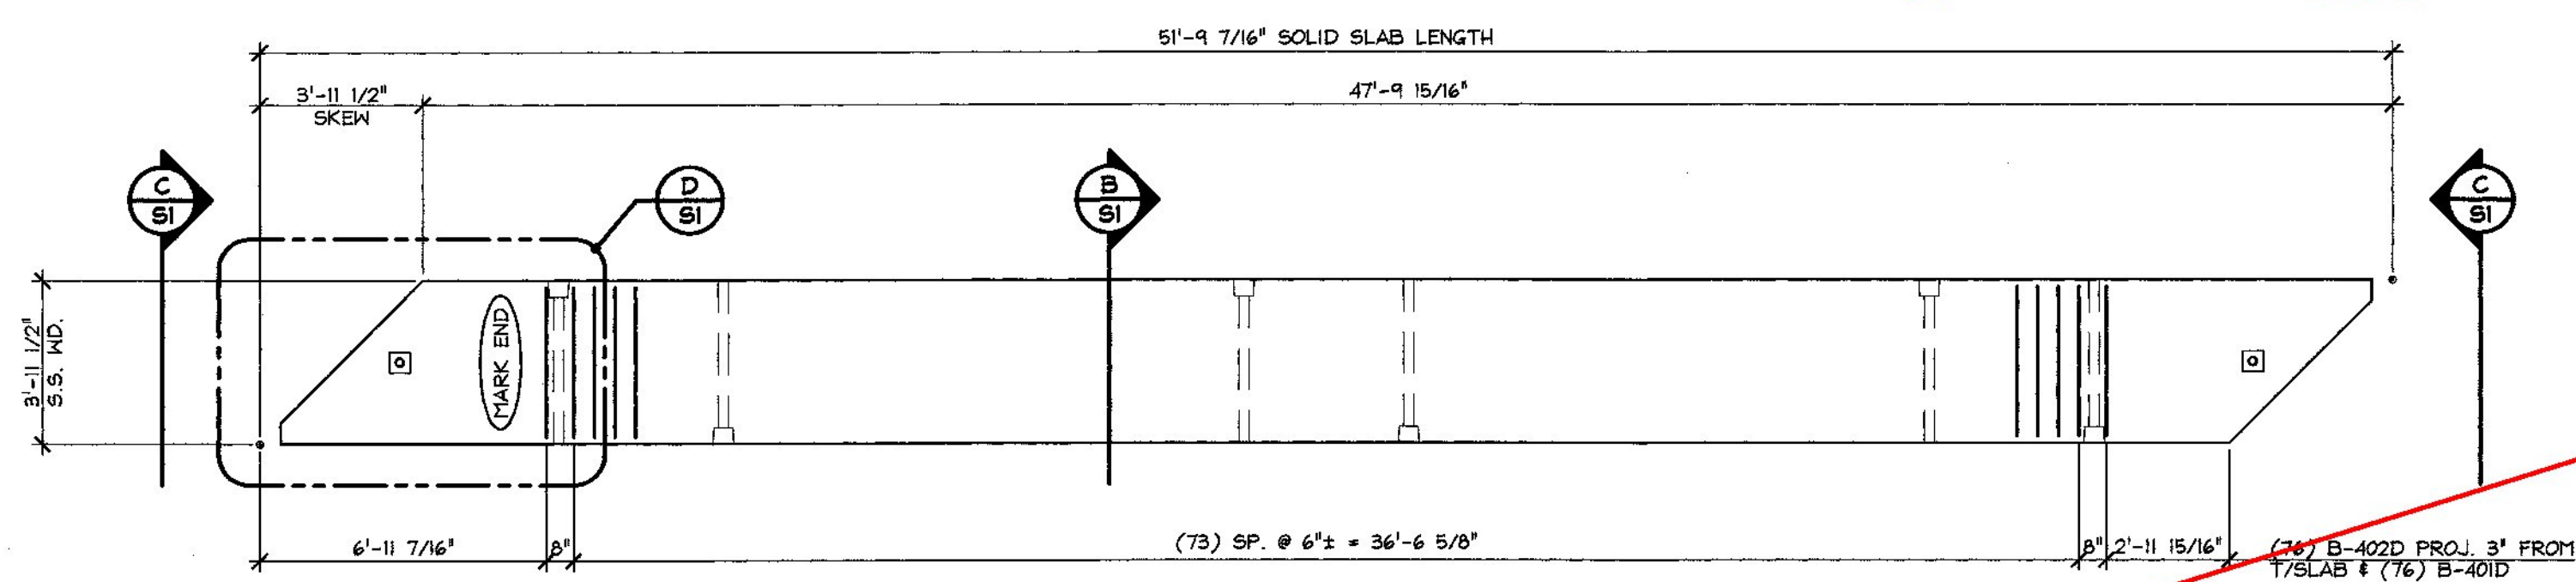


3 REINFORCING PLAN VIEW IN FORM  
SI 1/4" = 1'-0"


SHOP NOTE:  
ADJUST REINFORCING AS REQUIRED TO CLEAR INSERTS, SLEEVES, ETC.

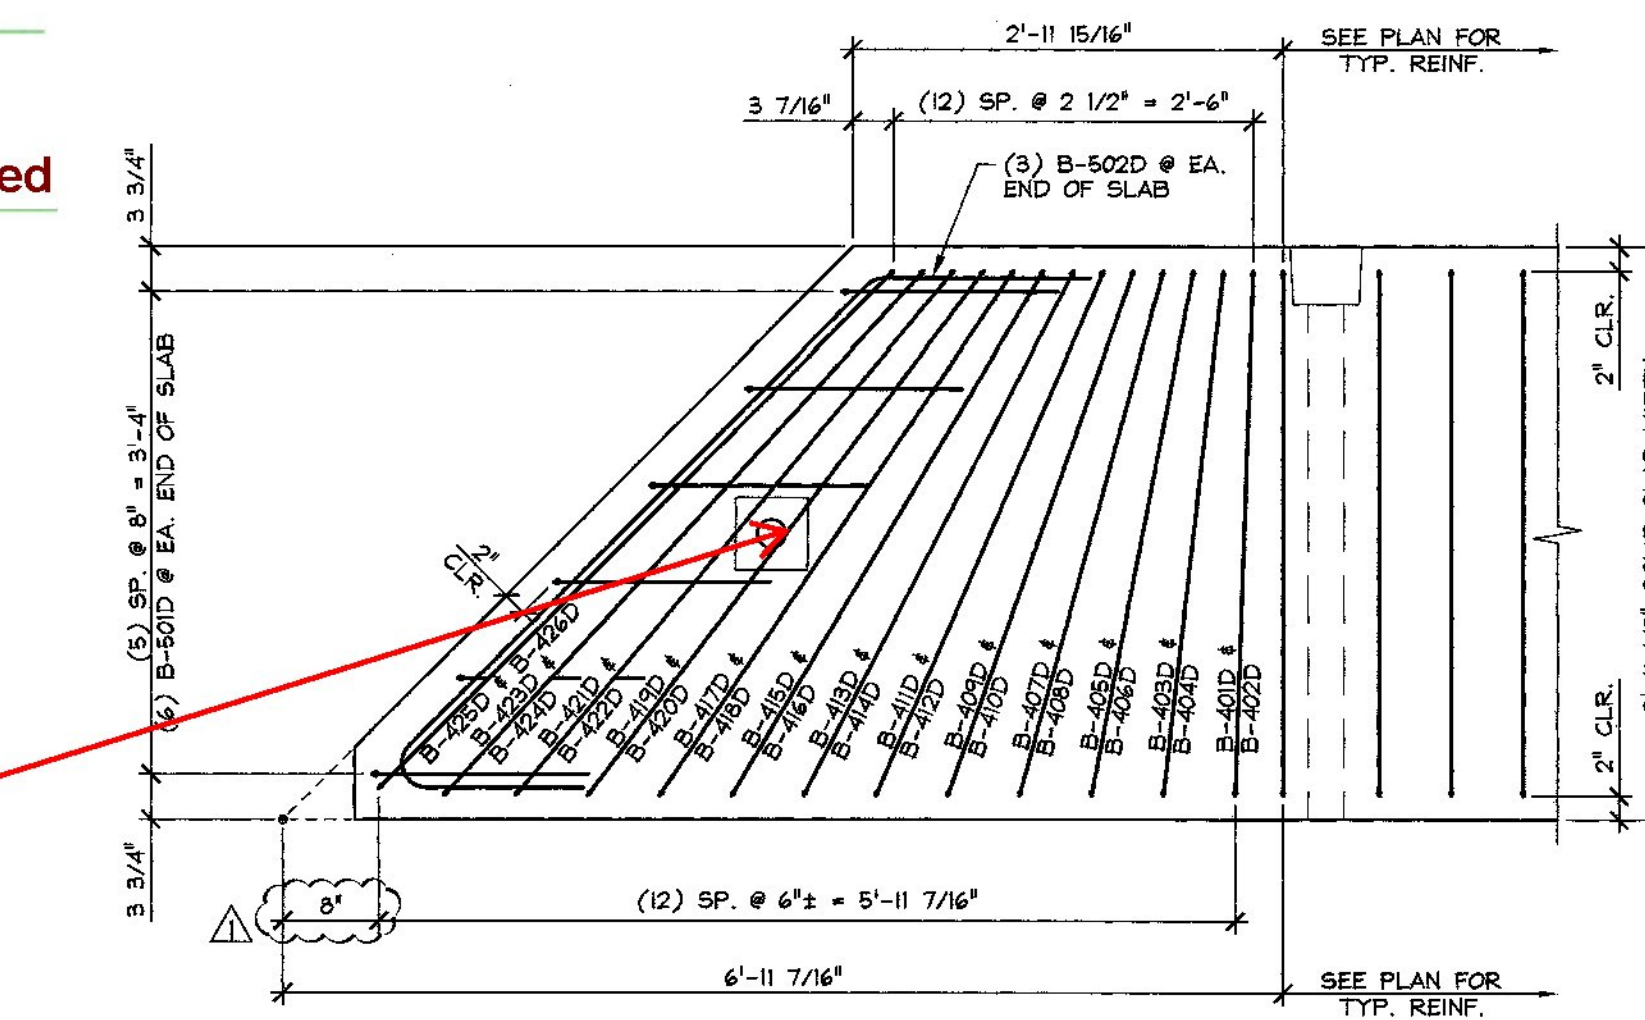


D END BLOCK REINFORCING PLAN  
SI 3/4" = 1'-0"

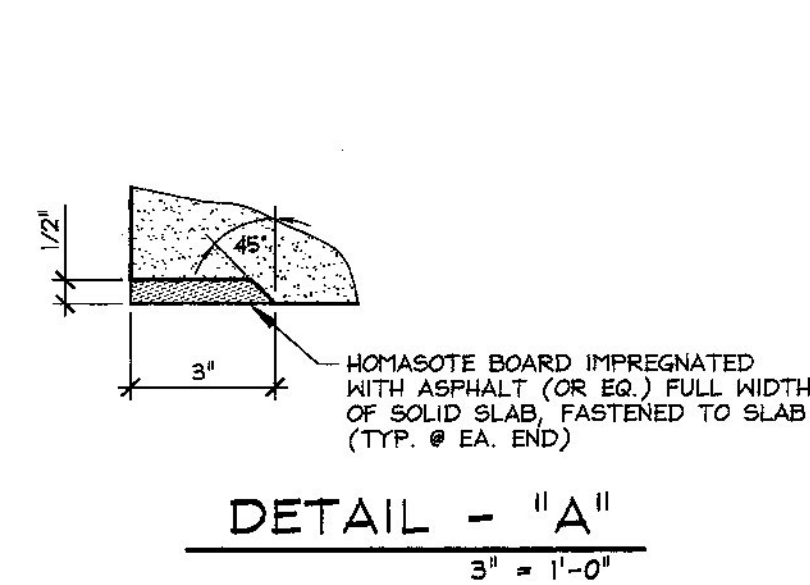


DETAIL - "A"  
3" ± = 1'-0"

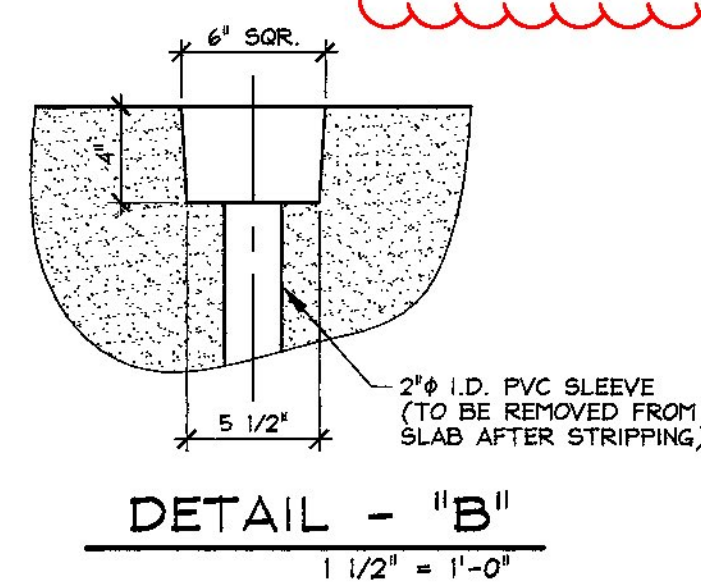

DETAIL - "B"  
1 1/2" ± = 1'-0"

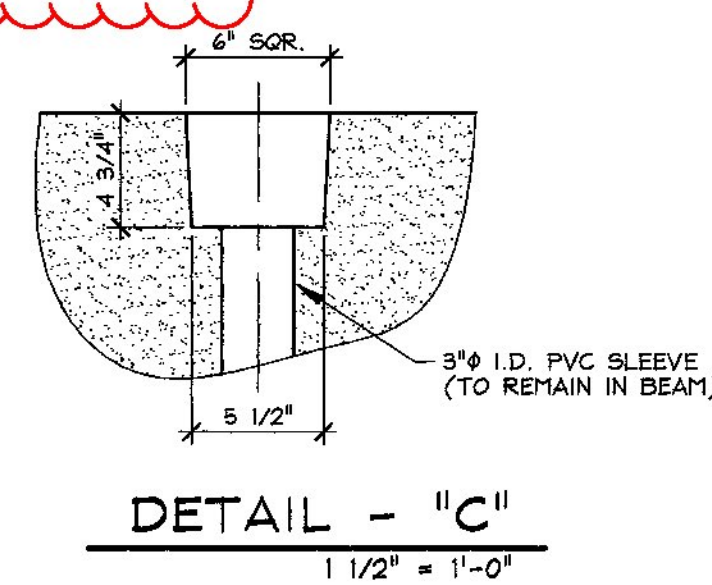

DETAIL - "C"  
1 1/2" ± = 1'-0"

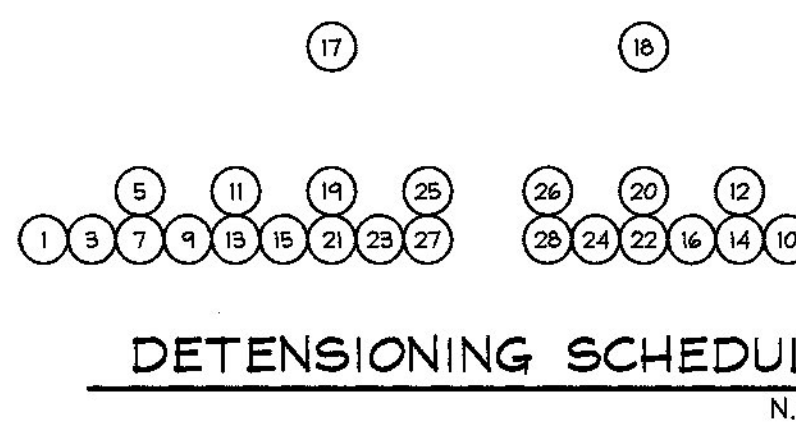

**SHOP DRAWING REVIEW**

REVIEWED AS REQUIRED BY THE CONSTRUCTION CONTRACT DOCUMENTS AND APPROVED, BUT ONLY FOR CONFORMANCE TO THE DESIGN CONCEPT OF THE WORK, AND SUBJECT TO FURTHER LIMITATIONS AND REQUIREMENTS CONTAINED IN THE CONSTRUCTION CONTRACT DOCUMENTS.

REJECTED  REVISE AND RESUBMIT  FURNISH AS CORRECTED

CORRECTIONS OR COMMENTS MADE ON THE SHOP DRAWINGS DURING THIS REVIEW DO NOT RELIEVE CONTRACTOR FROM COMPLIANCE WITH REQUIREMENTS OF THE DRAWINGS AND SPECIFICATIONS. THIS CHECK IS ONLY FOR REVIEW OF GENERAL CONFORMANCE WITH THE DESIGN CONCEPT OF THE PROJECT AND GENERAL COMPLIANCE WITH THE INFORMATION GIVEN IN THE CONTRACT DOCUMENTS. THE CONTRACTOR IS RESPONSIBLE FOR CONFIRMING AND CORRELATING ALL QUANTITIES AND DIMENSIONS, SELECTING FABRICATION PROCESSES AND TECHNIQUES OF CONSTRUCTION, COORDINATING HIS WORK WITH THAT OF ALL OTHER TRADES, AND PERFORMING HIS WORK IN A SAFE AND SATISFACTORY MANNER.

**Vanasse Hangen Brustlin, Inc.** Job Number: 57528.00  
7056 US Route 7 North Ferrisburgh, VT 05473 Reviewed By: E.A. FIALA  
802.425.7788 Date: 04/28/2014

MARK:	B-SS1	QTY:	2	WT.:	17.4 T	VOL.:	8.6 cy
MARK:	B-SS2	QTY:	3	WT.:	17.4 T	VOL.:	8.6 cy
MATERIAL LIST / SOLID SLAB							
ITEM	MARK	DESCRIPTION	QTY./SLAB				
			B-SS1	B-SS2			
1	B-401D	#4 BENT BAR (LEVEL II, DUAL COATED)	76	76			
2	B-402D	#4 BENT BAR (LEVEL II, DUAL COATED)	76	76			
3	B-403D	#4 BENT BAR (LEVEL II, DUAL COATED)	2	2			
4	B-404D	#4 BENT BAR (LEVEL II, DUAL COATED)	2	2			
5	B-405D	#4 BENT BAR (LEVEL II, DUAL COATED)	2	2			
6	B-406D	#4 BENT BAR (LEVEL II, DUAL COATED)	2	2			
7	B-407D	#4 BENT BAR (LEVEL II, DUAL COATED)	2	2			
8	B-408D	#4 BENT BAR (LEVEL II, DUAL COATED)	2	2			
9	B-409D	#4 BENT BAR (LEVEL II, DUAL COATED)	2	2			
10	B-410D	#4 BENT BAR (LEVEL II, DUAL COATED)	2	2			
11	B-411D	#4 BENT BAR (LEVEL II, DUAL COATED)	2	2			
12	B-412D	#4 BENT BAR (LEVEL II, DUAL COATED)	2	2			
13	B-413D	#4 BENT BAR (LEVEL II, DUAL COATED)	2	2			
14	B-414D	#4 BENT BAR (LEVEL II, DUAL COATED)	2	2			
15	B-415D	#4 BENT BAR (LEVEL II, DUAL COATED)	2	2			
16	B-416D	#4 BENT BAR (LEVEL II, DUAL COATED)	2	2			
17	B-417D	#4 BENT BAR (LEVEL II, DUAL COATED)	2	2			
18	B-418D	#4 BENT BAR (LEVEL II, DUAL COATED)	2	2			
19	B-419D	#4 BENT BAR (LEVEL II, DUAL COATED)	2	2			
20	B-420D	#4 BENT BAR (LEVEL II, DUAL COATED)	2	2			
21	B-421D	#4 BENT BAR (LEVEL II, DUAL COATED)	2	2			
22	B-422D	#4 BENT BAR (LEVEL II, DUAL COATED)	2	2			
23	B-423D	#4 BENT BAR (LEVEL II, DUAL COATED)	2	2			
24	B-424D	#4 BENT BAR (LEVEL II, DUAL COATED)	2	2			
25	B-425D	#4 BENT BAR (LEVEL II, DUAL COATED)	2	2			
26	B-426D	#4 BENT BAR (LEVEL II, DUAL COATED)	2	2			
27							
28	B-501D	#5 BENT BAR (LEVEL II, DUAL COATED)	12	12			
29	B-502D	#5 BENT BAR (LEVEL II, DUAL COATED)	6	6			
30							
31							
32		SET OF DOUBLE 1/2" x 270 KSI STRAND LIFTING LOOPS	4	4			
33							
34							
35							

4-24-14 REVISE REINFORCING

APPROVAL STAMP:

**J.P. CARRARA & SONS INC.**  
Precast & Prestress Manufacturer  
264 OZE STR., MIDDLEBURY, VERMONT 05753 Phone:(802)388-6361 Fax:(802)388-9010

**RENAUD BRO., INC.**  
CONTRACTOR  
VERNON, VERMONT

STATE OF VERMONT AGENCY OF TRANSPORTATION  
COUNTY OF WINDHAM

TOWN OF BRATTLEBORO  
TH 12, CLASS III (LOCAL ROAD) OVER HALLADAY BROOK  
BRIDGE NO.: 7 PROJECT NO.: BRO 1442(35)


DATE: MAR. 24, 2014  
SCALE: NOTED  
CHKD: M.D. DFTM: B.L.  
JOB NO: 23424-014  
DWG. NO: S1

A DIMENSIONAL SECTION  
SI 1" = 1'-0"


B REINFORCING SECTION  
SI 1" = 1'-0"

C END BLOCK REINF. SECTION  
SI 1" = 1'-0"

⚡ DENOTES STRAIGHT STRANDS TO BE DEBONDED 10'-0" FROM EA. END OF EA. SLAB  
⚡ DENOTES STRAIGHT STRANDS TO BE DEBONDED 12'-0" FROM EA. END OF EA. SLAB  
⚡ DENOTES STRAIGHT STRANDS TO BE DEBONDED 14'-0" FROM EA. END OF EA. SLAB

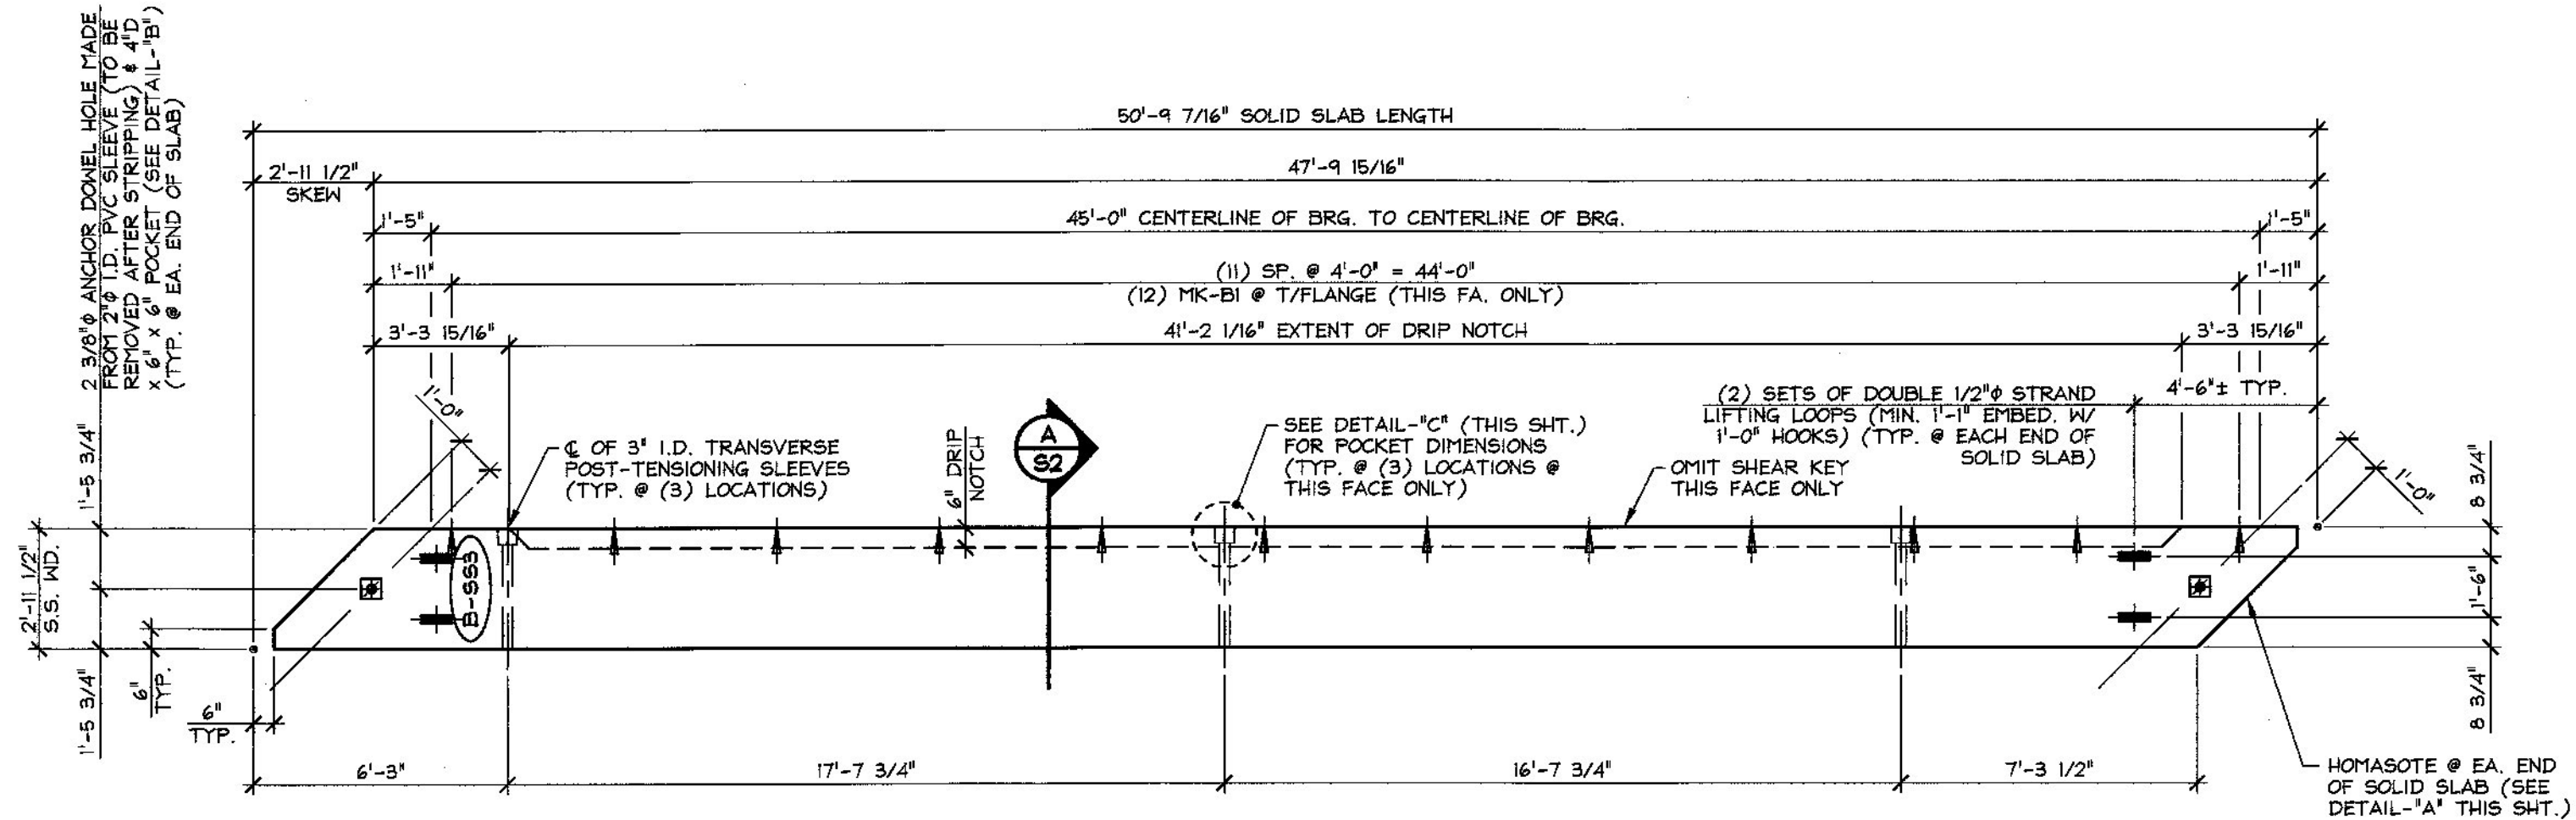

1 DIMENSIONAL PLAN VIEW IN FORM  
S2 1/4" = 1'-0"

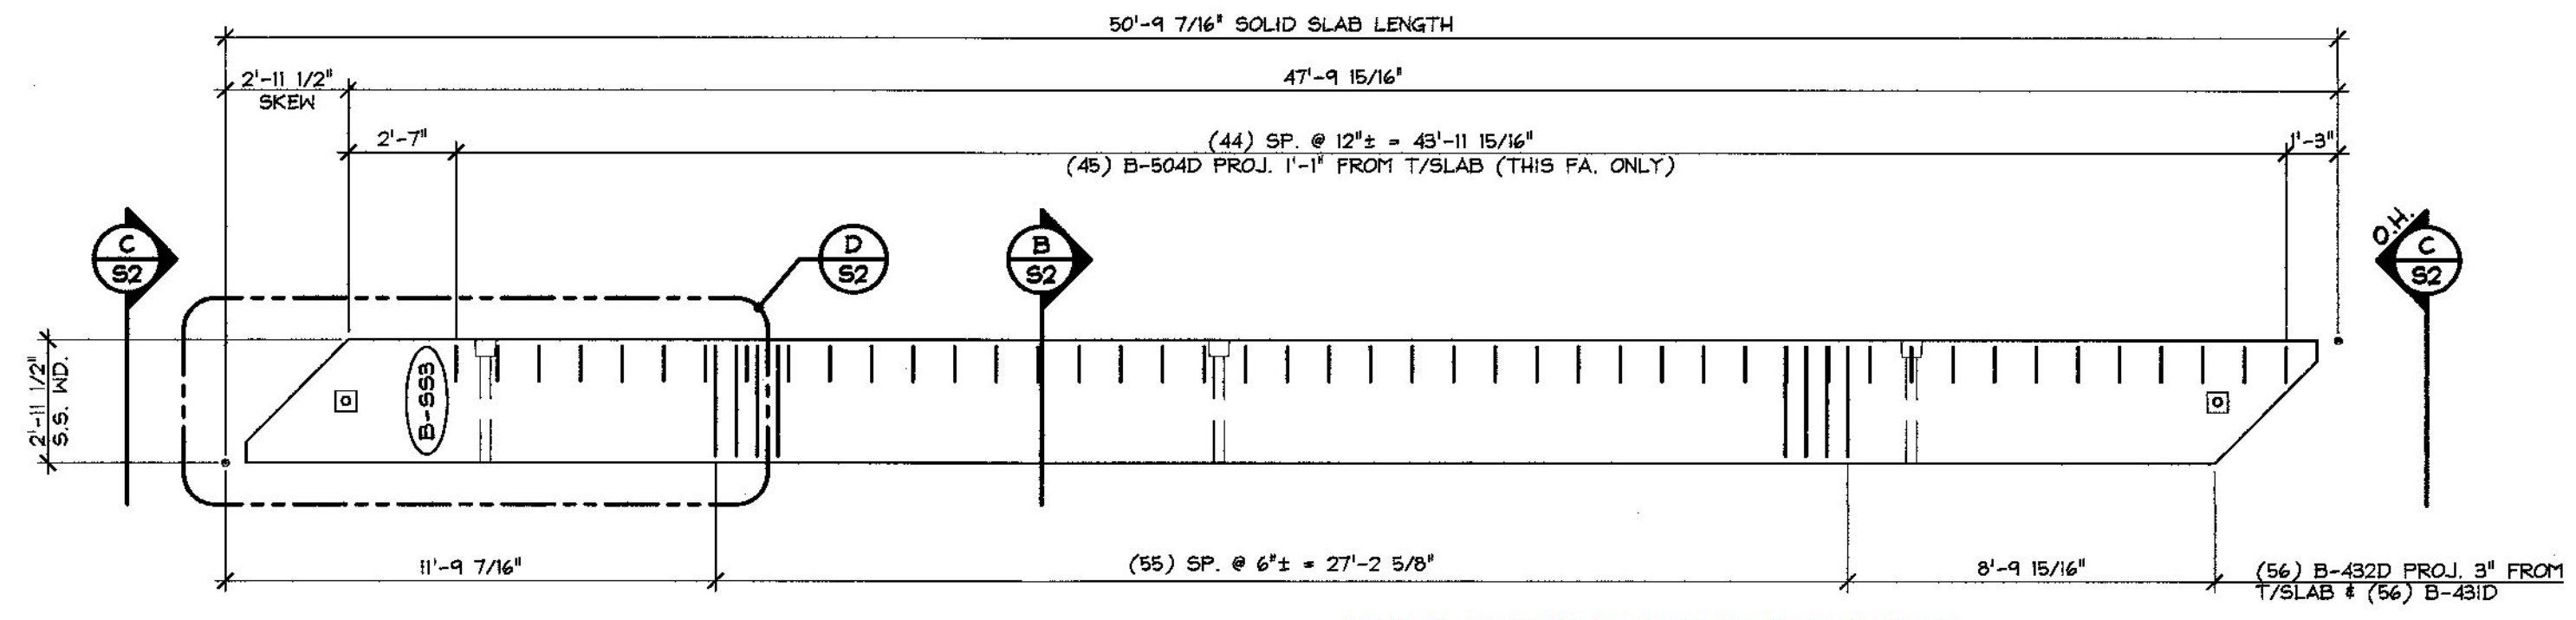

2 REINFORCING PLAN VIEW IN FORM  
S2 1/4" = 1'-0"

SHOP NOTE:  
ADJUST REINFORCING AS REQUIRED  
TO CLEAR INSERTS, SLEEVES, ETC.

Vermont Agency of Transportation  
**RECEIVED**  
CK'D BY JMC OK'D BY TAS  
April 24, 2014  
RESUBMIT No Approved  
By M. J. Chenette DATE 04/29/2014

**SHOP DRAWING REVIEW**

REVIEWED AS REQUIRED BY THE CONSTRUCTION CONTRACT DOCUMENTS AND APPROVED, BUT ONLY FOR CONFORMANCE TO THE DESIGN CONCEPT OF THE WORK, AND SUBJECT TO FURTHER LIMITATIONS AND REQUIREMENTS CONTAINED IN THE CONSTRUCTION CONTRACT DOCUMENTS.

REJECTED  REVISE AND RESUBMIT  FURNISH AS CORRECTED


CORRECTIONS OR COMMENTS MADE ON THE SHOP DRAWINGS DURING THIS REVIEW DO NOT RELIEVE CONTRACTOR FROM COMPLIANCE WITH REQUIREMENTS OF THE DRAWINGS AND SPECIFICATIONS. THIS CHECK IS ONLY FOR REVIEW OF GENERAL CONFORMANCE WITH THE DESIGN CONCEPT OF THE PROJECT AND GENERAL COMPLIANCE WITH THE INFORMATION GIVEN IN THE CONTRACT DOCUMENTS. THE CONTRACTOR IS RESPONSIBLE FOR CONFIRMING AND CORRECTING ALL QUANTITIES AND DIMENSIONS, SELECTING FABRICATION PROCESSES AND TECHNIQUES OF CONSTRUCTION, COORDINATING HIS WORK WITH THAT OF ALL OTHER TRADES, AND PERFORMING HIS WORK IN A SAFE AND SATISFACTORY MANNER.

Vannasse Hangen Brustlin, Inc.  
7056 US Route 7  
North Ferrisburgh, VT 05473  
802-425-7789




Job Number: 57528.00  
Reviewed By: E.A. FIALA  
Date: 04/28/2014

MARK:	B-S53	QTY.:	1	WT.:	13.1 T	VOL.:	6.5 cy
MARK:	-	QTY.:	-	WT.:	-	VOL.:	-


MATERIAL LIST / SOLID SLAB			
ITEM	MARK	DESCRIPTION	QTY./SLAB
1	B-403D	#4 BENT BAR (LEVEL II, DUAL COATED)	2
2	B-404D	#4 BENT BAR (LEVEL II, DUAL COATED)	2
3	B-431D	#4 BENT BAR (LEVEL II, DUAL COATED)	58
4	B-432D	#4 BENT BAR (LEVEL II, DUAL COATED)	58
5	B-433D	#4 BENT BAR (LEVEL II, DUAL COATED)	34
6	B-434D	#4 BENT BAR (LEVEL II, DUAL COATED)	34
7	B-435D	#4 BENT BAR (LEVEL II, DUAL COATED)	2
8	B-436D	#4 BENT BAR (LEVEL II, DUAL COATED)	2
9	B-437D	#4 BENT BAR (LEVEL II, DUAL COATED)	2
10	B-438D	#4 BENT BAR (LEVEL II, DUAL COATED)	2
11	B-439D	#4 BENT BAR (LEVEL II, DUAL COATED)	2
12	B-440D	#4 BENT BAR (LEVEL II, DUAL COATED)	2
13	B-441D	#4 BENT BAR (LEVEL II, DUAL COATED)	2
14	B-442D	#4 BENT BAR (LEVEL II, DUAL COATED)	2
15	B-443D	#4 BENT BAR (LEVEL II, DUAL COATED)	2
16	B-444D	#4 BENT BAR (LEVEL II, DUAL COATED)	2
17	B-445D	#4 BENT BAR (LEVEL II, DUAL COATED)	2
18	B-446D	#4 BENT BAR (LEVEL II, DUAL COATED)	2
19	B-447D	#4 BENT BAR (LEVEL II, DUAL COATED)	2
20	B-448D	#4 BENT BAR (LEVEL II, DUAL COATED)	2
21	B-449D	#4 BENT BAR (LEVEL II, DUAL COATED)	2
22	B-450D	#4 BENT BAR (LEVEL II, DUAL COATED)	2
23	B-451D	#4 BENT BAR (LEVEL II, DUAL COATED)	2
24	B-452D	#4 BENT BAR (LEVEL II, DUAL COATED)	2
25	B-501D	#5 BENT BAR (LEVEL II, DUAL COATED)	12
26	B-503D	#5 BENT BAR (LEVEL II, DUAL COATED)	6
27	B-504D	#5 BENT BAR (LEVEL II, DUAL COATED)	45
28			
29	MK-BI	DAYTON C-24 TYPE 4-APR DECK FORM HANGER (GALV.)	12
30		SET OF DOUBLE 1/2" x 270 KSI STRAND LIFTING LOOPS	4

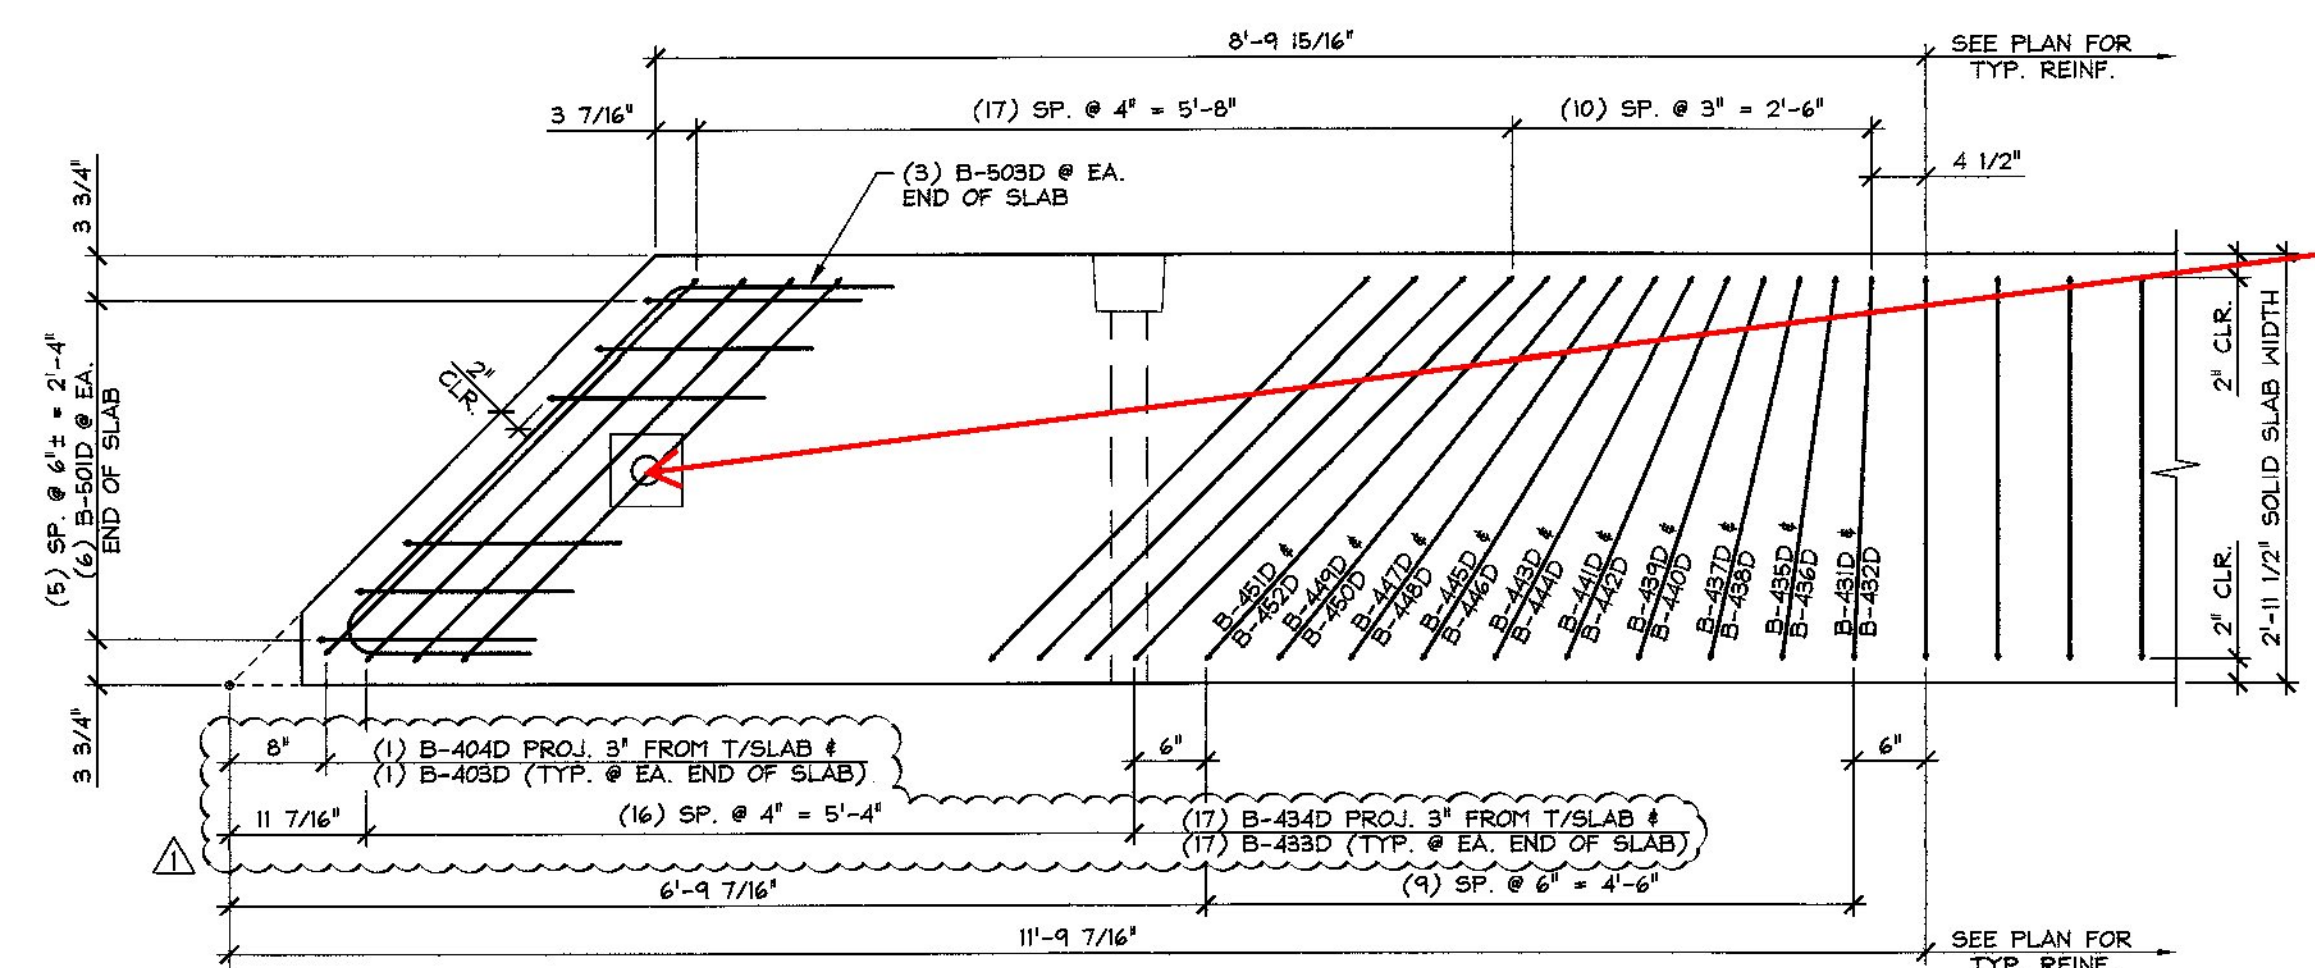


D END BLOCK REINFORCING PLAN  
S2 CURB REINFORCING NOT SHOWN FOR CLARITY 3/4" = 1'-0"

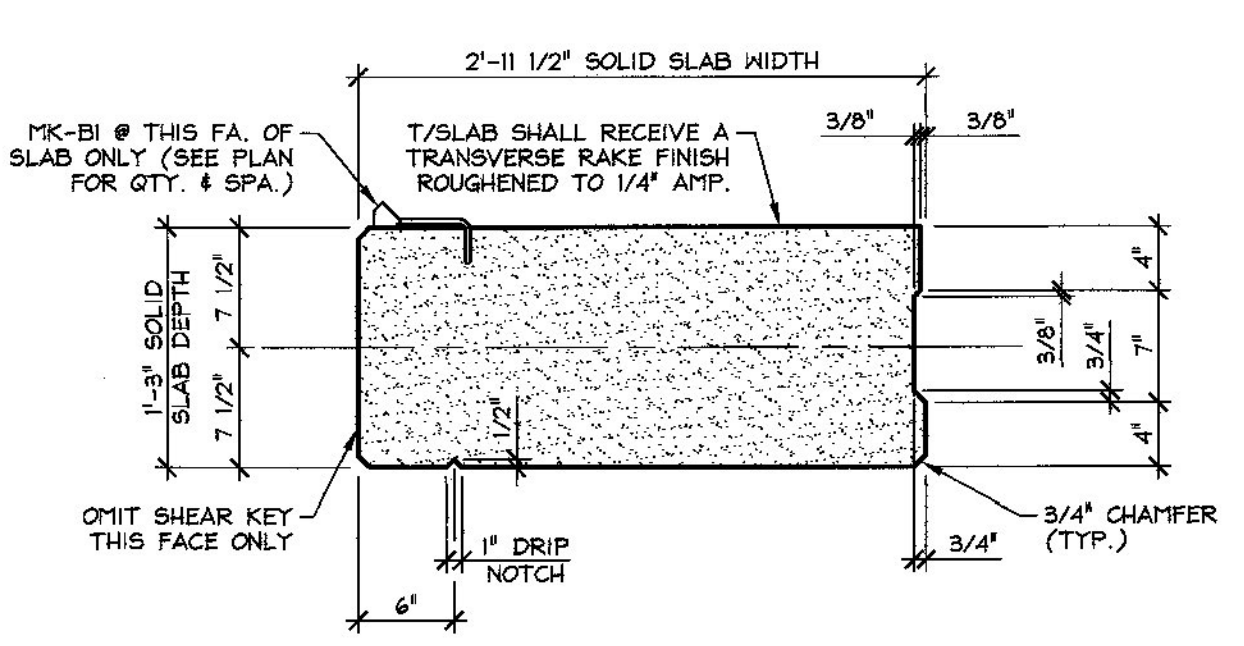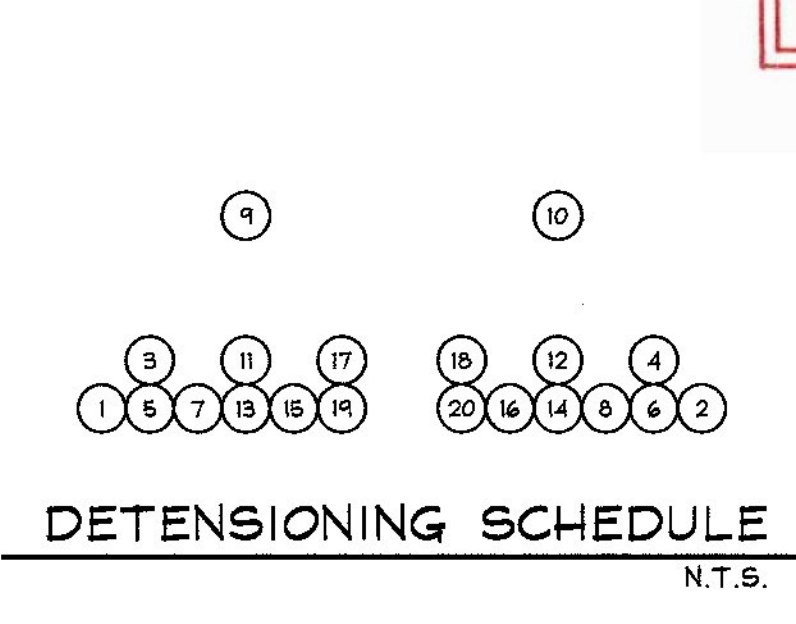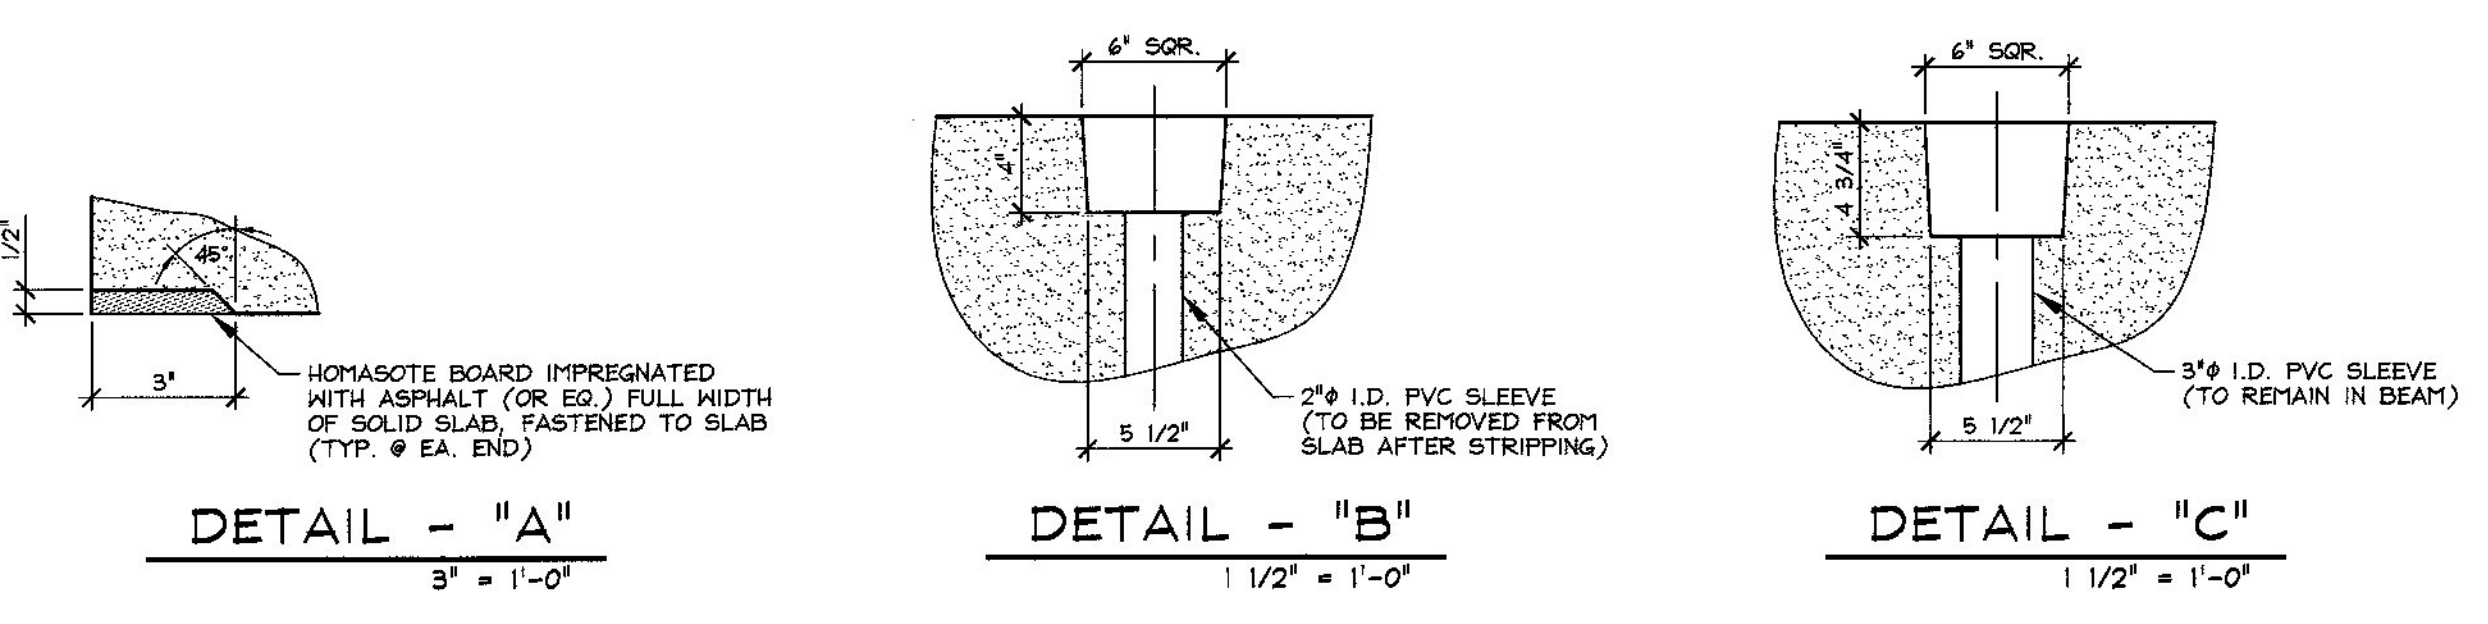

A DIMENSIONAL SECTION  
S2 1" = 1'-0"

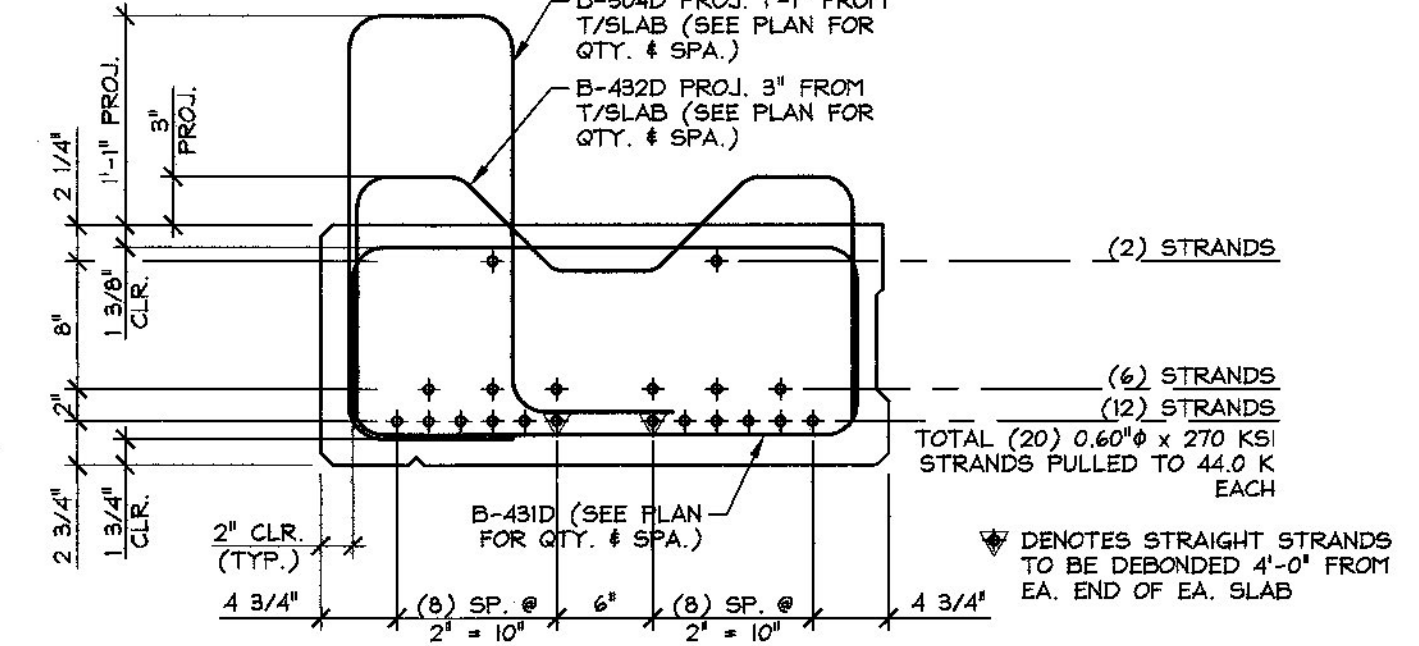

B REINFORCING SECTION  
S2 1" = 1'-0"

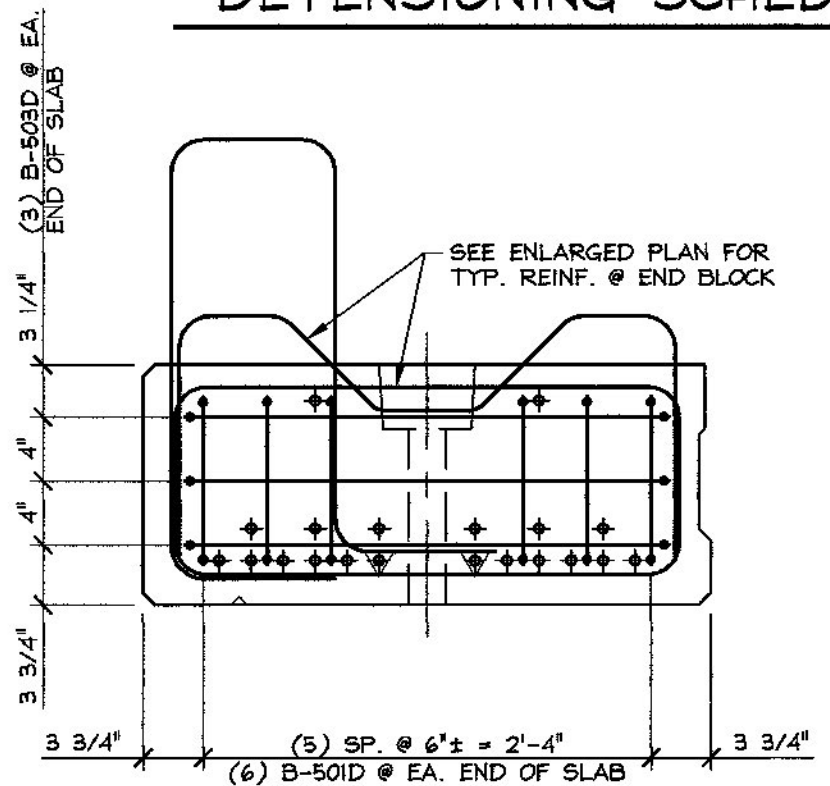


C END BLOCK REINF. SECTION  
S2 1" = 1'-0"


4-24-14 REVISE REINFORCING

APPROVAL STAMP:

<b>J.P. CARRARA &amp; SONS INC.</b> Precast & Prestress Manufacturer 244 GEE ST., MIDDLEBURY, VERMONT 05753 Phone: (802)388-6361 Fax: (802)388-9010	RENAUD BRO., INC. CONTRACTOR VERNON, VERMONT
	DATE: MAR. 24, 2014 SCALE: NOTED
STATE OF VERMONT AGENCY OF TRANSPORTATION COUNTY OF WINDHAM	TH 12, CLASS III (LOCAL ROAD) OVER HALLADAY BROOK BRIDGE NO.: 7 PROJECT NO.: BRO 1442(35)
CHKD: M.D. DFTM: B.L. JOB NO: 23424-014	PRESTRESSED SOLID SLAB DETAILS DWG. NO: S2

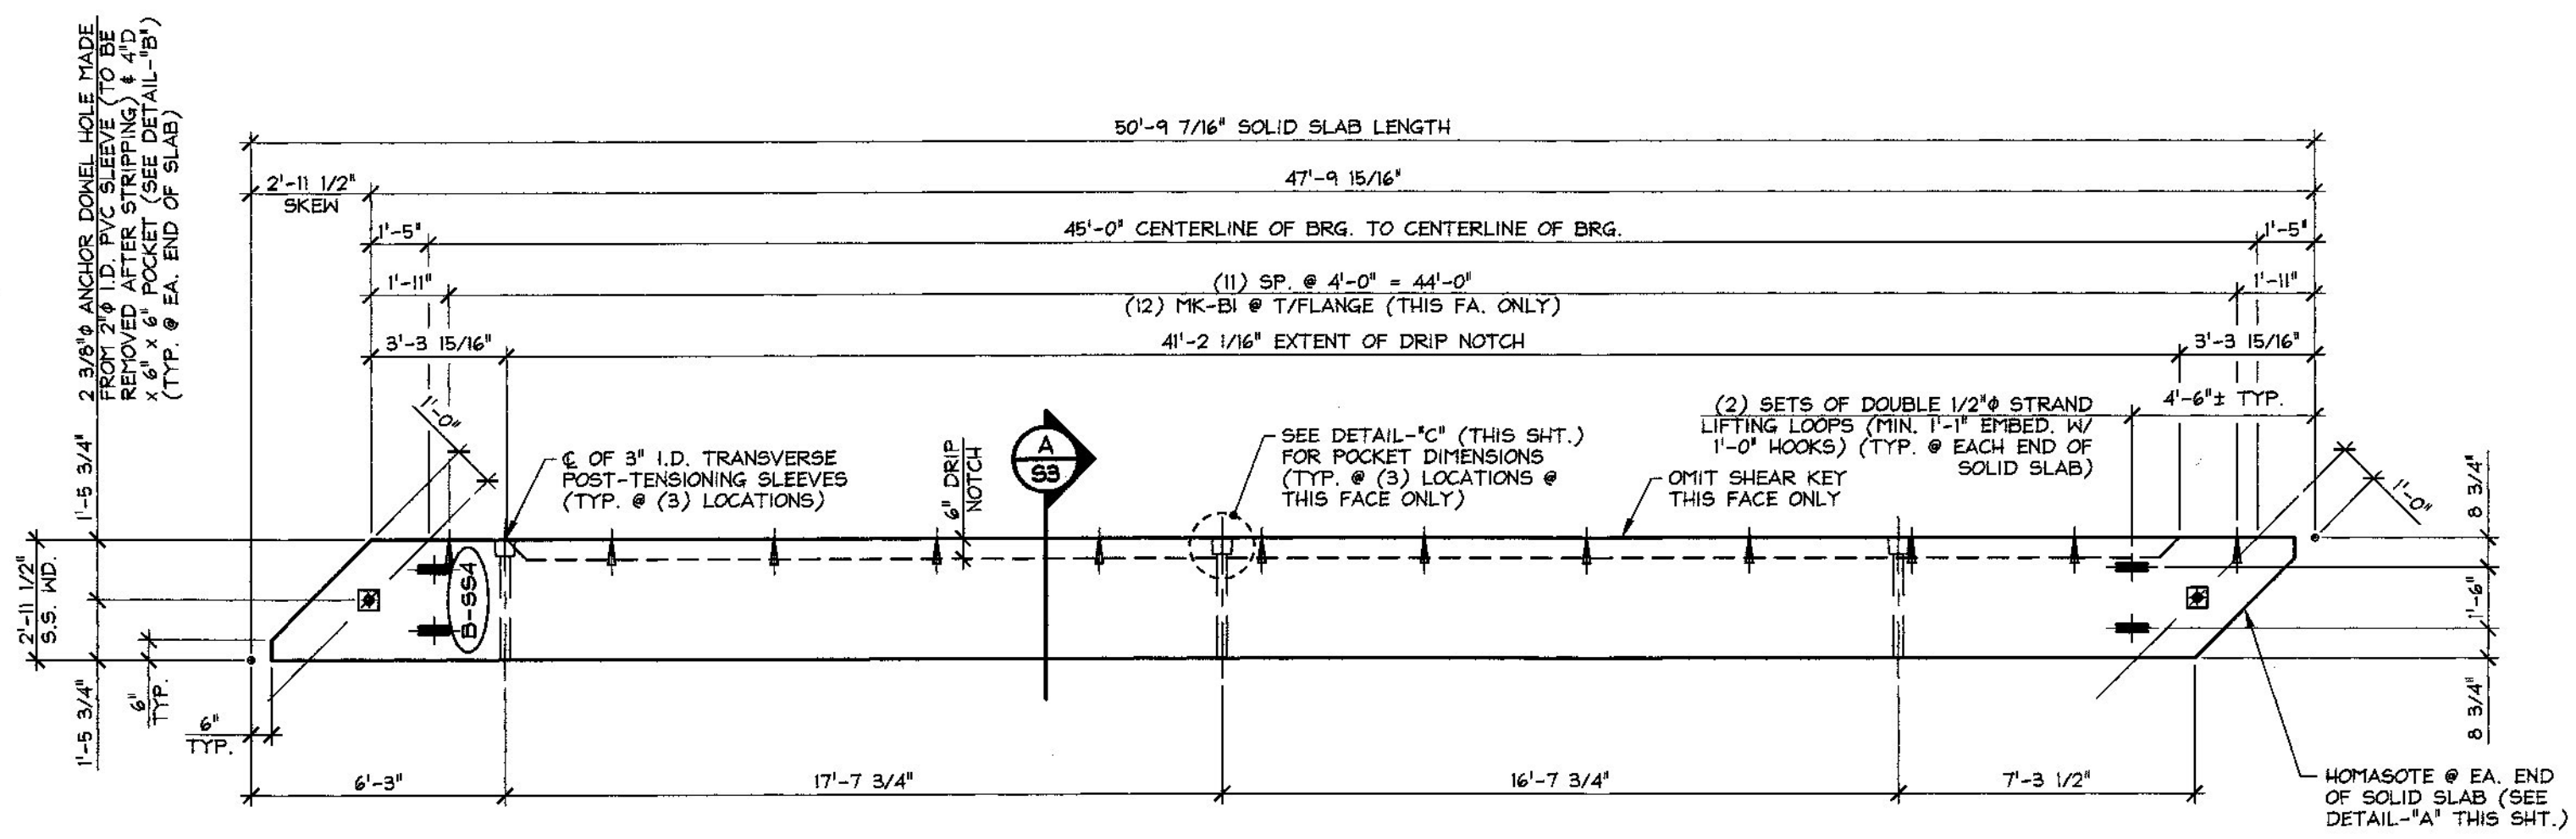

1 DIMENSIONAL PLAN VIEW IN FORM  
S3  
1/4" = 1'-0"

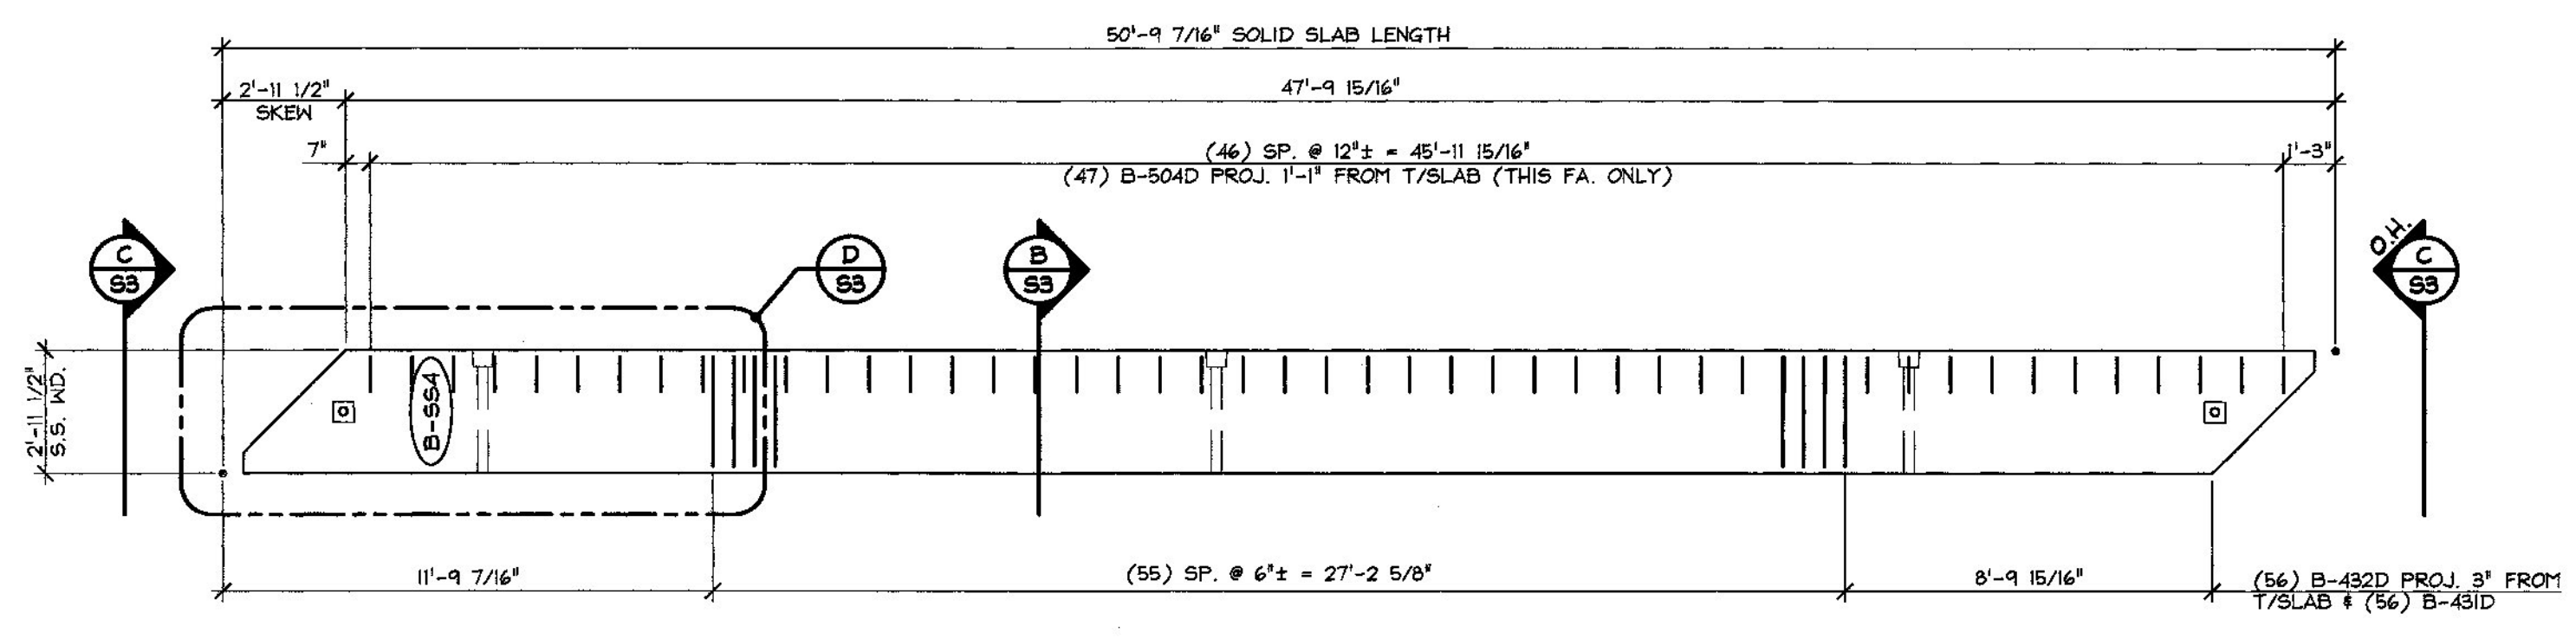

2 REINFORCING PLAN VIEW IN FORM  
S3  
1/4" = 1'-0"

SHOP NOTE:  
ADJUST REINFORCING AS REQUIRED  
TO CLEAR INSERTS, SLEEVES, ETC.

Vermont Agency of Transportation  
**RECEIVED**

CK'D BY MJC OK'D BY TAS  
April 24, 2014  
RESUBMIT No Approved AsNoted  
BY M. J. Chenette DATE 04/29/2014

**SHOP DRAWING REVIEW**


REVIEWED AS REQUIRED BY THE CONSTRUCTION CONTRACT DOCUMENTS AND APPROVED, BUT ONLY FOR CONFORMANCE TO THE DESIGN CONCEPT OF THE WORK, AND SUBJECT TO FURTHER LIMITATIONS AND REQUIREMENTS CONTAINED IN THE CONSTRUCTION CONTRACT DOCUMENTS.

REJECTED  REVISE AND RESUBMIT  FURNISH AS CORRECTED

CORRECTIONS OR COMMENTS MADE ON THE SHOP DRAWINGS DURING THIS REVIEW DO NOT RELIEVE CONTRACTOR FROM COMPLIANCE WITH REQUIREMENTS OF THE DRAWINGS AND SPECIFICATIONS. THIS CHECK IS ONLY FOR REVIEW OF GENERAL CONFORMANCE WITH THE DESIGN CONCEPT OF THE PROJECT AND GENERAL COMPLIANCE WITH THE INFORMATION GIVEN IN THE CONTRACT DOCUMENTS. THE CONTRACTOR IS RESPONSIBLE FOR CONFIRMING AND CORRELATING ALL QUANTITIES AND DIMENSIONS; SELECTING FABRICATION PROCESSES AND TECHNIQUES OF CONSTRUCTION; COORDINATING HIS WORK WITH THAT OF ALL OTHER TRADES; AND PERFORMING HIS WORK IN A SAFE AND SATISFACTORY MANNER.



**VHB Vanasse Hangen Brustlin, Inc.** Job Number 57528.00  
7056 US Route 7 North Ferrisburgh, VT 05473 Reviewed By E.A. FIALA  
802.425.7798 Date 04/28/2014

MARK:	B-SS4	QTY.:	1	WT.:	13.1 T	VOL.:	6.5 cy
MARK:	-	QTY.:	-	WT.:	-	VOL.:	-
MATERIAL LIST / SOLID SLAB							
ITEM	MARK	DESCRIPTION	QTY./SLAB				
1	B-409D	#4 BENT BAR (LEVEL II, DUAL COATED)	2				
2	B-404D	#4 BENT BAR (LEVEL II, DUAL COATED)	2				
3	B-431D	#4 BENT BAR (LEVEL II, DUAL COATED)	58				
4	B-432D	#4 BENT BAR (LEVEL II, DUAL COATED)	58				
5	B-433D	#4 BENT BAR (LEVEL II, DUAL COATED)	34				
6	B-434D	#4 BENT BAR (LEVEL II, DUAL COATED)	34				
7	B-435D	#4 BENT BAR (LEVEL II, DUAL COATED)	2				
8	B-436D	#4 BENT BAR (LEVEL II, DUAL COATED)	2				
9	B-437D	#4 BENT BAR (LEVEL II, DUAL COATED)	2				
10	B-438D	#4 BENT BAR (LEVEL II, DUAL COATED)	2				
11	B-439D	#4 BENT BAR (LEVEL II, DUAL COATED)	2				
12	B-440D	#4 BENT BAR (LEVEL II, DUAL COATED)	2				
13	B-441D	#4 BENT BAR (LEVEL II, DUAL COATED)	2				
14	B-442D	#4 BENT BAR (LEVEL II, DUAL COATED)	2				
15	B-443D	#4 BENT BAR (LEVEL II, DUAL COATED)	2				
16	B-444D	#4 BENT BAR (LEVEL II, DUAL COATED)	2				
17	B-445D	#4 BENT BAR (LEVEL II, DUAL COATED)	2				
18	B-446D	#4 BENT BAR (LEVEL II, DUAL COATED)	2				
19	B-447D	#4 BENT BAR (LEVEL II, DUAL COATED)	2				
20	B-448D	#4 BENT BAR (LEVEL II, DUAL COATED)	2				
21	B-449D	#4 BENT BAR (LEVEL II, DUAL COATED)	2				
22	B-450D	#4 BENT BAR (LEVEL II, DUAL COATED)	2				
23	B-451D	#4 BENT BAR (LEVEL II, DUAL COATED)	2				
24	B-452D	#4 BENT BAR (LEVEL II, DUAL COATED)	2				
25	B-501D	#5 BENT BAR (LEVEL II, DUAL COATED)	12				
26	B-503D	#5 BENT BAR (LEVEL II, DUAL COATED)	6				
27	B-504D	#5 BENT BAR (LEVEL II, DUAL COATED)	47				
28							
29	MK-BI	DAYTON C-24 TYPE 4-APR DECK FORM HANGER (GALV.)	12				
30		SET OF DOUBLE 1/2" x 270 KSI STRAND LIFTING LOOPS	4				

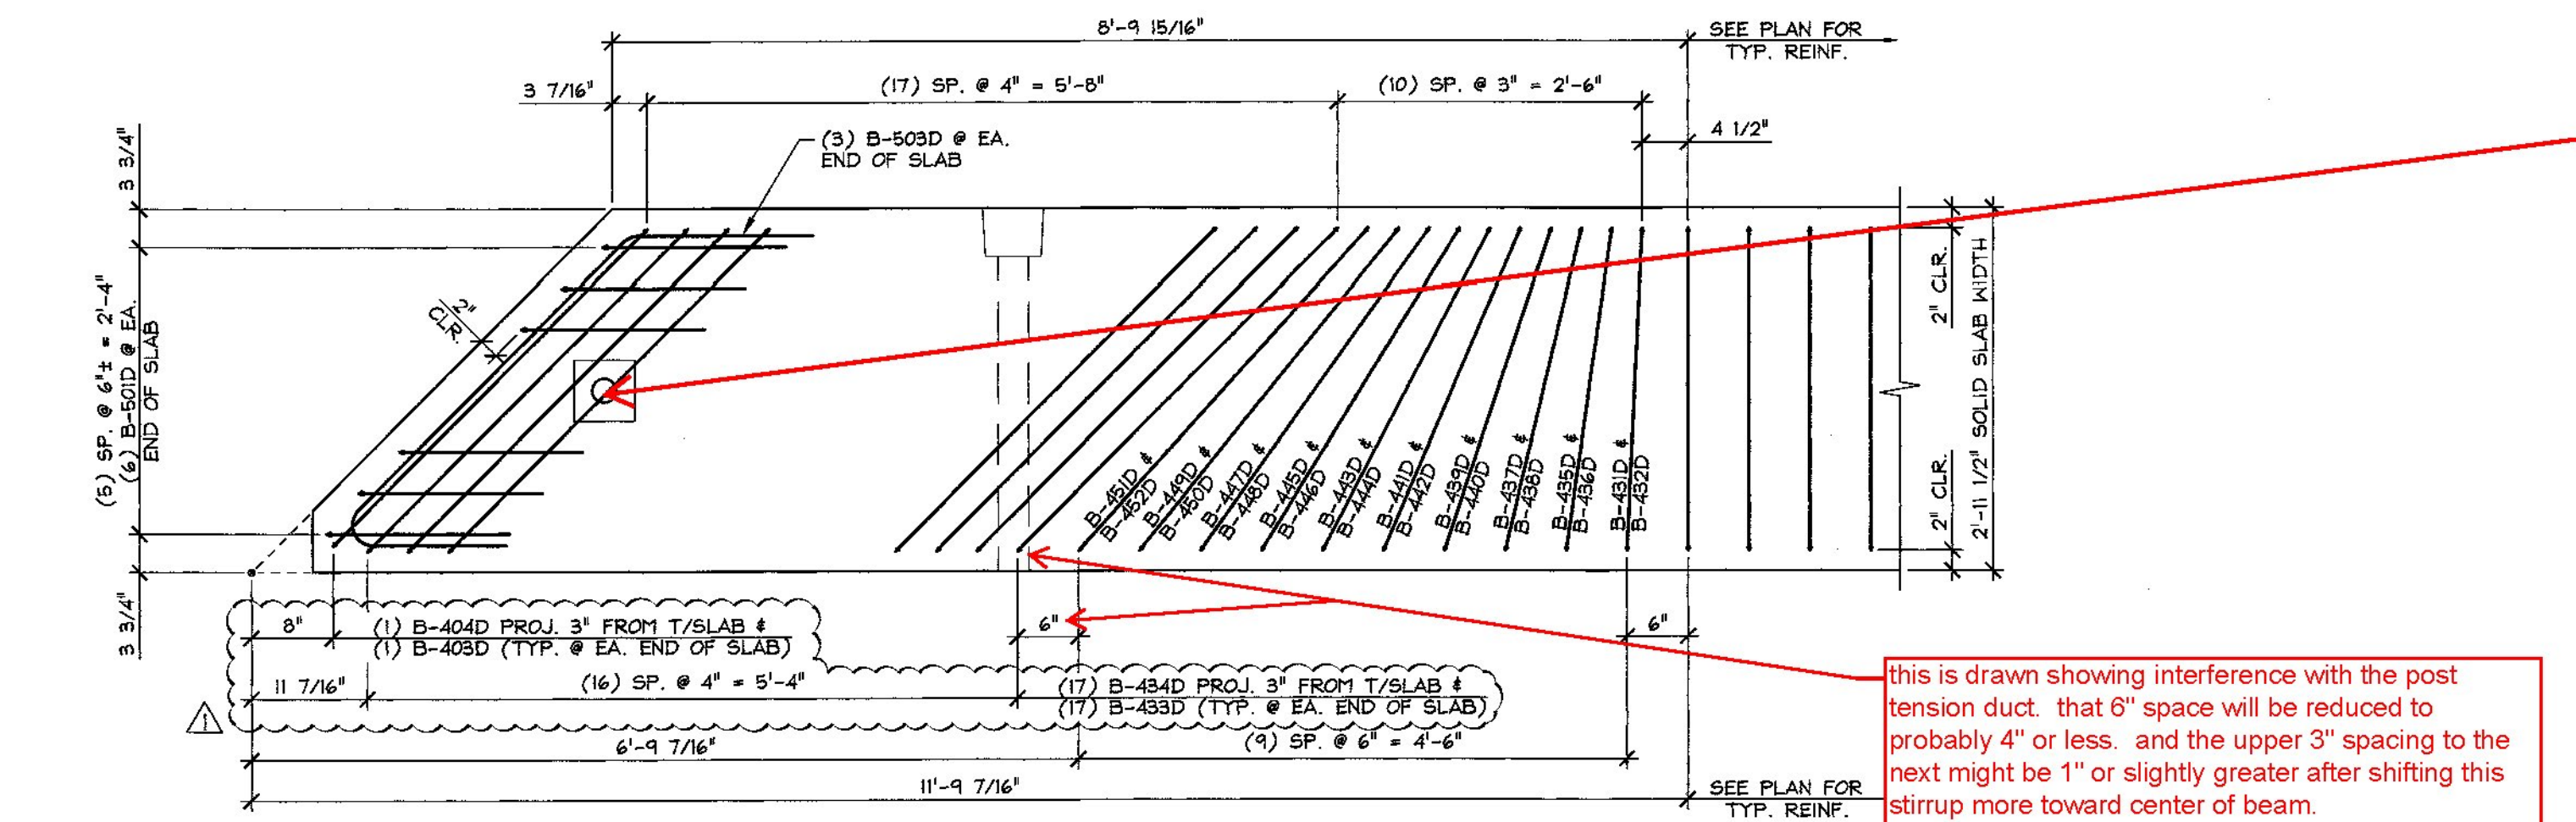


D END BLOCK REINFORCING PLAN  
S3  
3/4" = 1'-0"



this is drawn showing interference with the post tension duct. that 6" space will be reduced to probably 4" or less. and the upper 3" spacing to the next might be 1" or slightly greater after shifting this stirrup more toward center of beam.

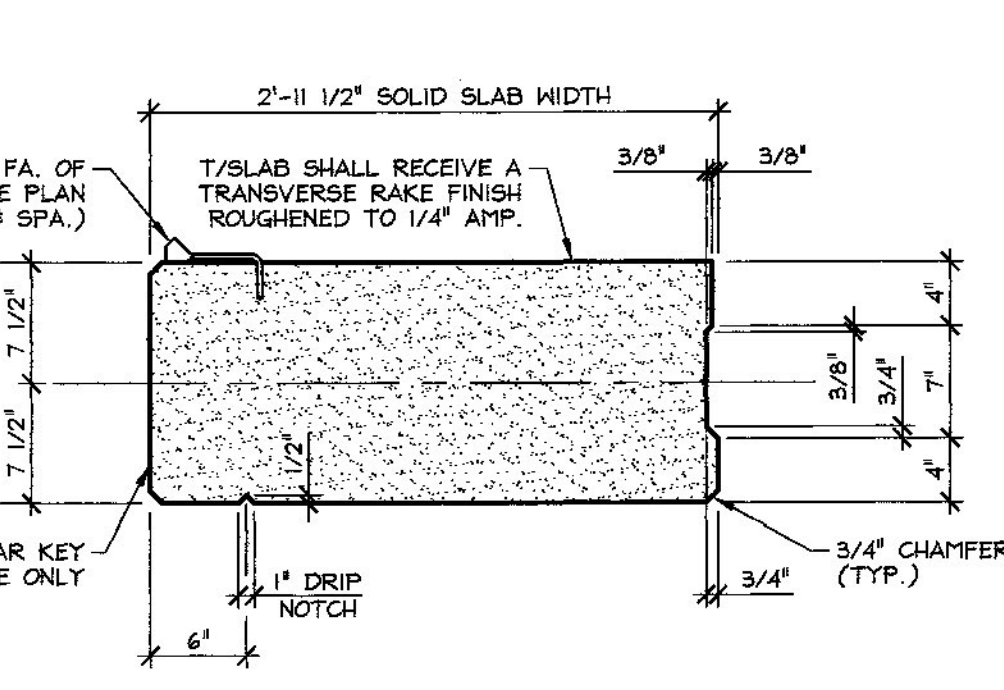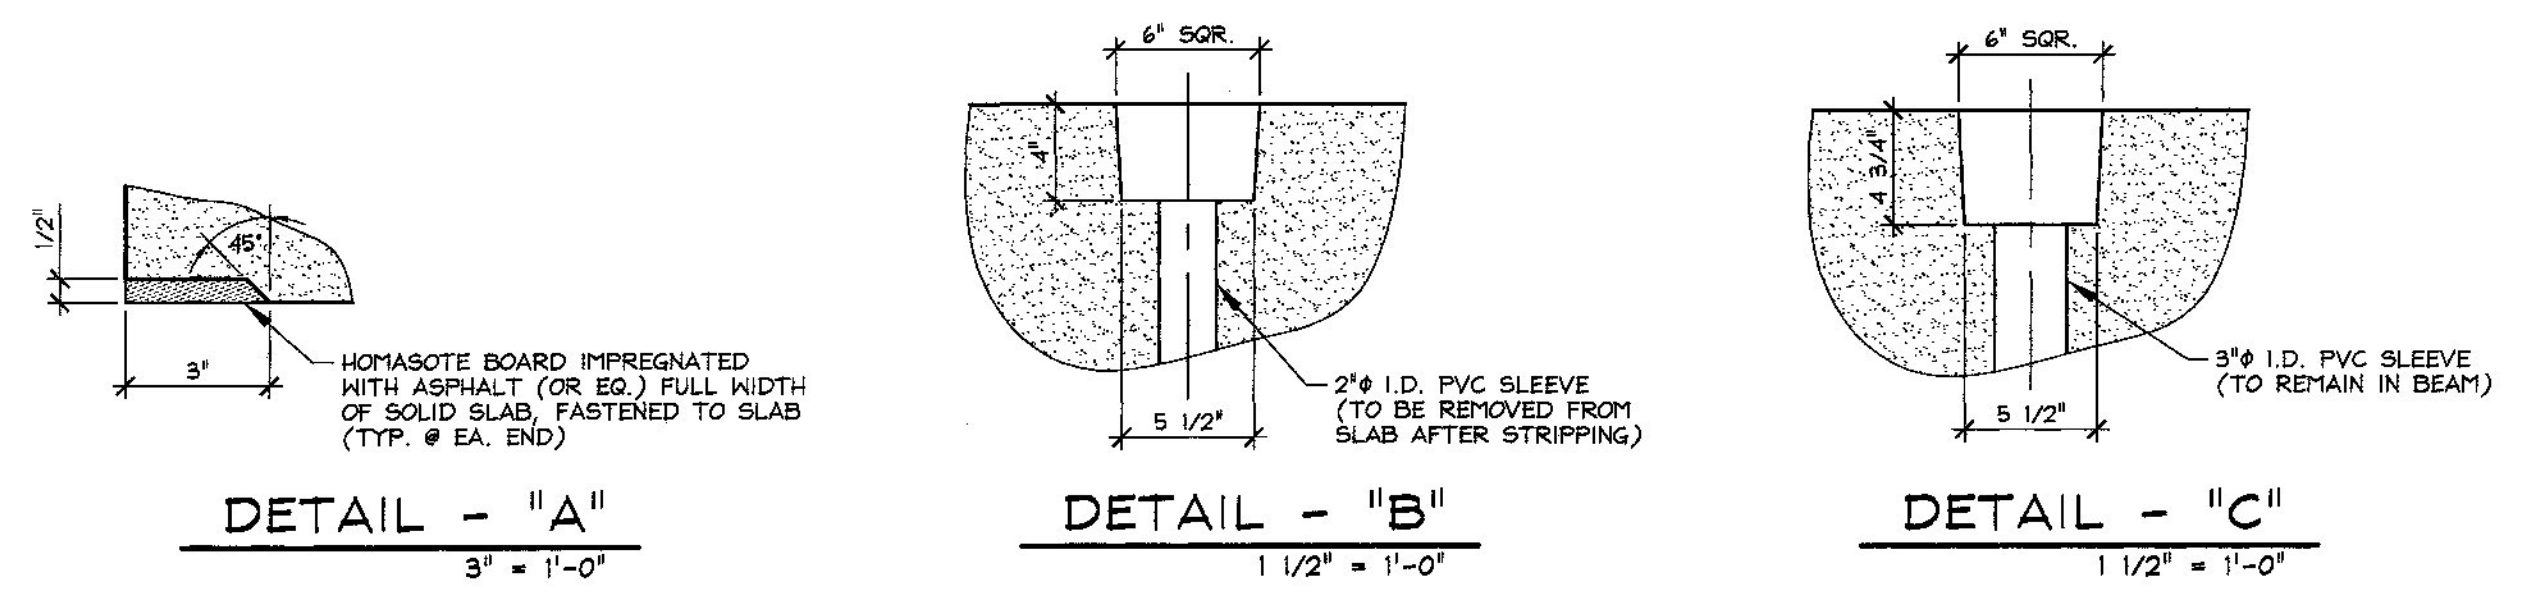

A DIMENSIONAL SECTION  
S3  
1" = 1'-0"

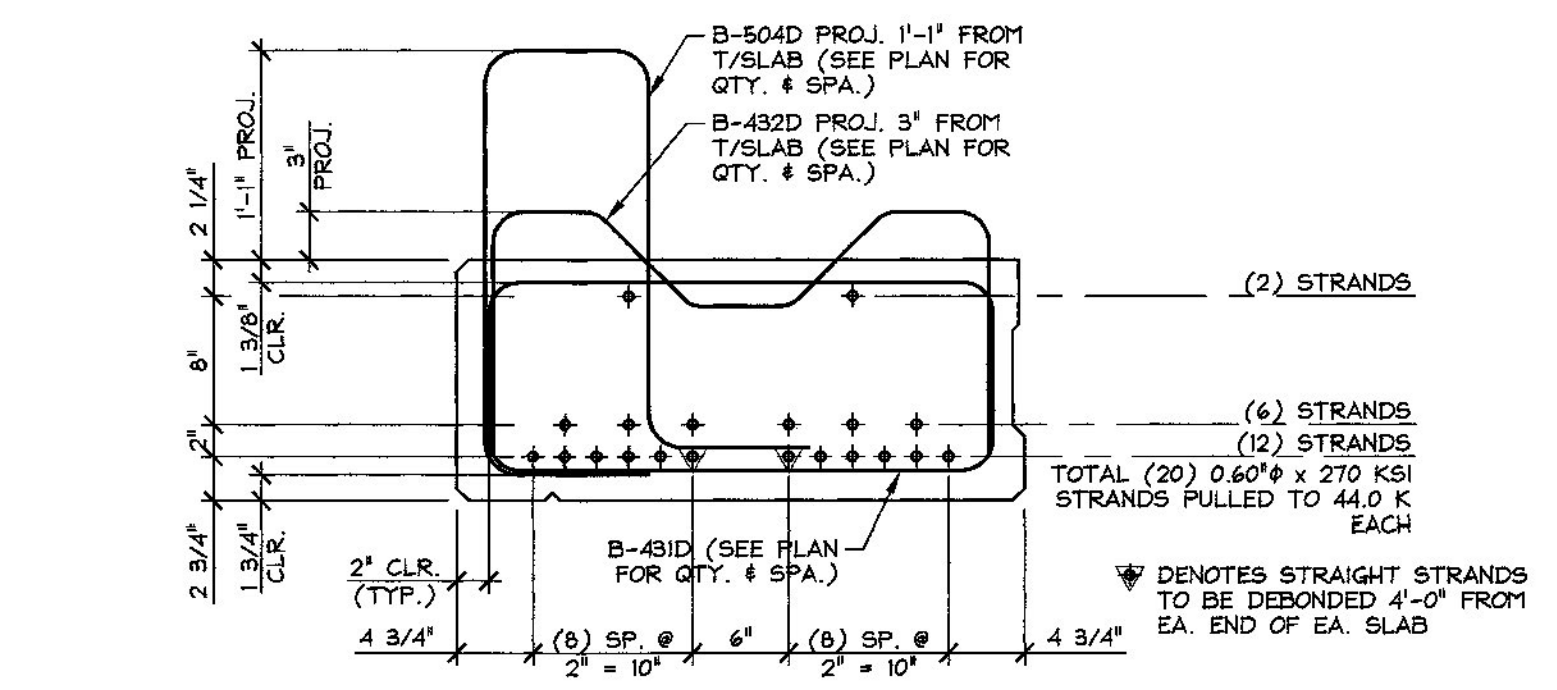

B REINFORCING SECTION  
S3  
1" = 1'-0"

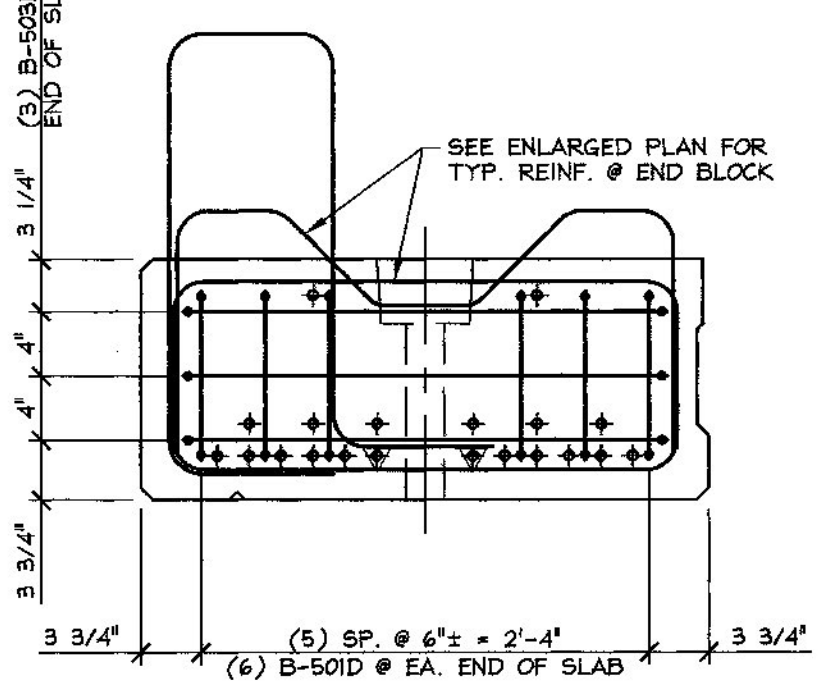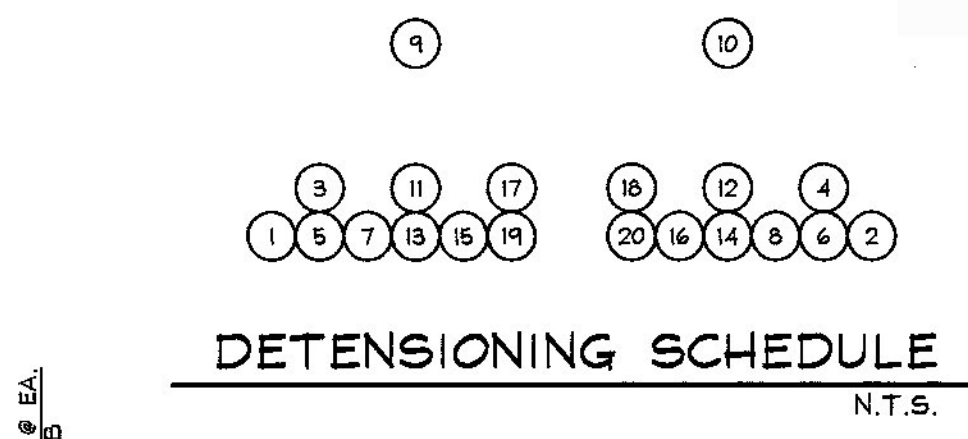

C END BLOCK REINF. SECTION  
S3  
1" = 1'-0"

4-24-14 REVISE REINFORCING

APPROVAL STAMP:


**J.P. CARRARA & SONS INC.**  
Precast & Prestress Manufacturer  
2464 CASE ST., MIDDLEBURY, VERMONT 05753 Phone: (802)388-6361 Fax: (802)388-8010

**RENAUD BRO., INC.**  
CONTRACTOR  
VERNON, VERMONT


STATE OF VERMONT AGENCY OF TRANSPORTATION  
COUNTY OF WINDHAM

TOWN OF BRATTLEBORO  
TH 12, CLASS III (LOCAL ROAD) OVER HALLADAY BROOK  
BRIDGE NO.: 7 PROJECT NO.: BRO 1442(35)

DATE: MAR. 24, 2014  
SCALE: NOTED  
CHKD: M.D. DFTM: B.L.  
JOB NO: 23424-014  
DWG. NO: S3

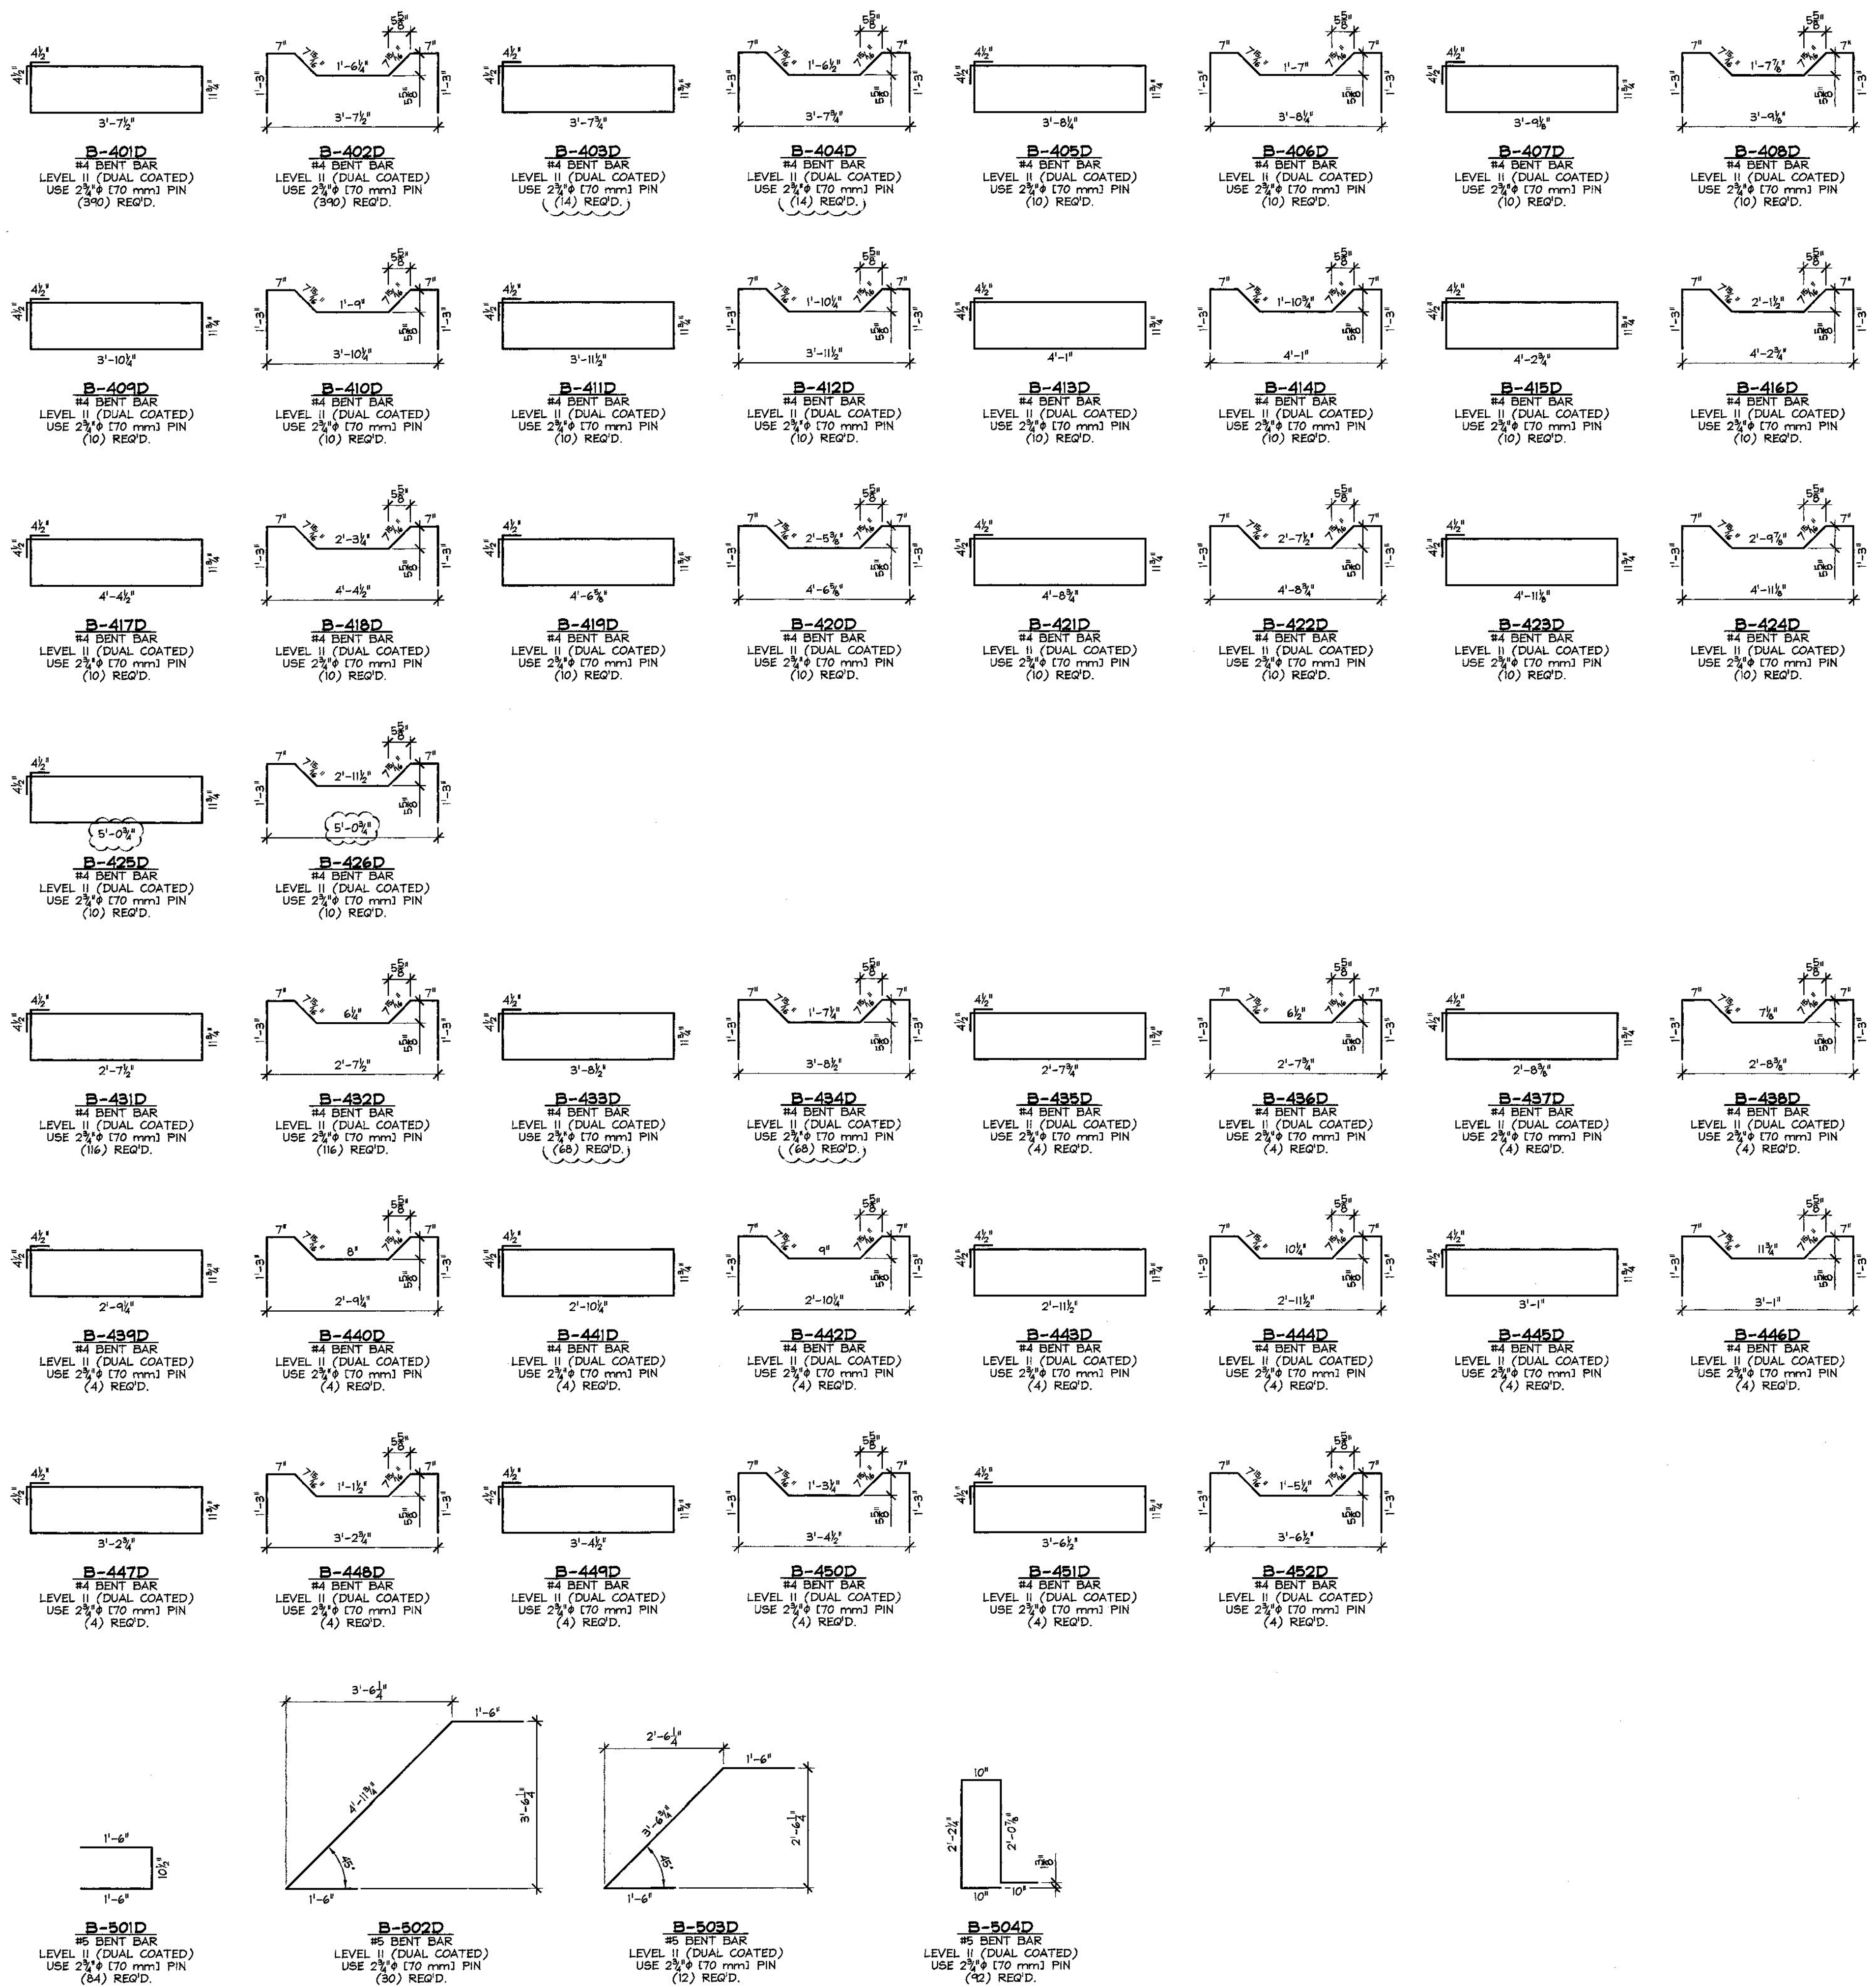

MISCELLANEOUS MATERIALS				
ITEM	MARK	QTY.	DESCRIPTION	REMARKS
1				
2				
3				
4	EM-B1	36	E 3/4" x 5" x 5" W/ 1/8" HOLE (GALV.) (ASTM A-36)	FOR ERECTION, SEE DETAIL THIS SHEET
5	EM-B2	36	1" HEAVY HEX NUT DOMESTIC (A194-22) (GALV.) & DOMESTIC STRUCTURAL WASHER (F436 T1) (GALV.)	FOR ERECTION
6	EM-B3	6	1" x 6'-5 3/4" THREADED ROD (A-449) (H.D. GALV.)	FOR ERECTION
7	EM-B4	12	1" x 7'-5" THREADED ROD (A-449) (H.D. GALV.)	FOR ERECTION
8		18	COMPRESSIBLE SEALER SELF ADHESIVE	FOR ERECTION
9				
10				
11				
12				
13				
14				
15	PK-B1	24	DATTON C-24 TYPE 4-APR DECK FORM HANGER (GALV.)	
16		26	SET OF DOUBLE 1/2" x 270 KSI STRAND LIFTING LOOPS	
17				
18				
19				
20				

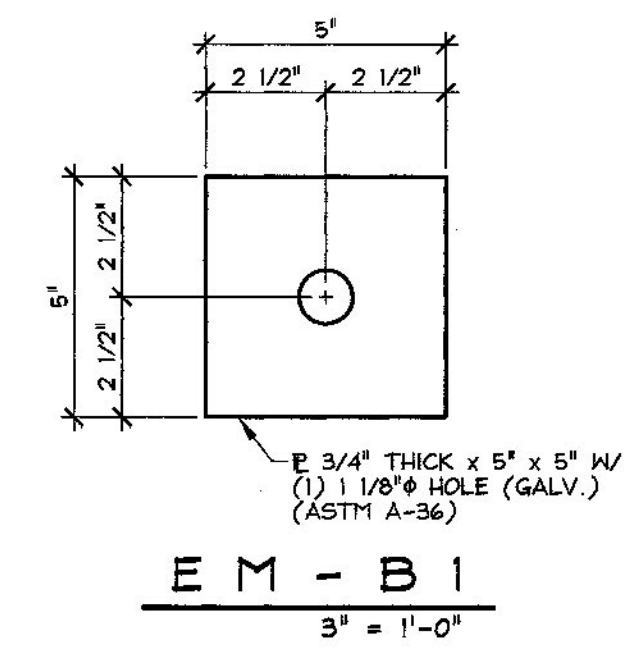

Vermont Agency of Transportation  
**RECEIVED**  
 CK'D BY MJC OK'D BY TAS  
 April 24, 2014  
 RESUBMIT No Approved AsNoted  
 BY M. J. Chenette DATE 04/29/2014

**SHOP DRAWING REVIEW**

REVIEWED AS REQUIRED BY THE CONSTRUCTION CONTRACT DOCUMENTS AND APPROVED, BUT ONLY FOR CONFORMANCE TO THE DESIGN CONCEPT OF THE WORK, AND SUBJECT TO FURTHER LIMITATIONS AND REQUIREMENTS CONTAINED IN THE CONSTRUCTION CONTRACT DOCUMENTS.

REJECTED  REVISE AND RESUBMIT  FURNISH AS CORRECTED

CORRECTIONS OR COMMENTS MADE ON THE SHOP DRAWINGS DURING THIS REVIEW DO NOT RELIEVE CONTRACTOR FROM COMPLIANCE WITH REQUIREMENTS OF THE DRAWINGS AND SPECIFICATIONS. THIS CHECK IS ONLY FOR REVIEW OF GENERAL CONFORMANCE WITH THE DESIGN CONCEPT OF THE PROJECT AND GENERAL COMPLIANCE WITH THE INFORMATION GIVEN IN THE CONTRACT DOCUMENTS. THE CONTRACTOR IS RESPONSIBLE FOR CONFIRMING AND CORRELATING ALL QUANTITIES AND DIMENSIONS, SELECTING FABRICATION PROCESSES AND TECHNIQUES OF CONSTRUCTION, COORDINATING HIS WORK WITH THAT OF ALL OTHER TRADES, AND PERFORMING HIS WORK IN A SAFE AND SATISFACTORY MANNER.


**Vanasse Hangen Brustlin, Inc.**  
 7056 US Route 7  
 North Ferrisburgh, VT 05473  
 802-425-7799

Job Number: 57528.00  
 Reviewed By: E.A. FIALA  
 Date: 04/28/2014

4-24-14 REVISE REINFORCING


APPROVAL STAMP:	<b>J.P. CARRARA &amp; SONS INC.</b> Precast & Prestress Manufacturer 2444 OASE ST., MIDDLEBURY, VERMONT 05753 Phone: (802)388-6361 Fax: (802)388-9010	<b>RENAUD BRO., INC.</b> CONTRACTOR VERNON, VERMONT
	<b>STATE OF VERMONT AGENCY OF TRANSPORTATION</b> COUNTY OF WINDHAM	DATE: MAR. 24, 2014 SCALE: NOTED
	TOWN OF BRATTLEBORO TH 12, CLASS III (LOCAL ROAD) OVER HALLADAY BROOK BRIDGE NO.: 7 PROJECT NO.: BR1442(35)	CHKD: M.D. DFTM: B.L. JOB NO: 23424-014
<b>MATERIALS LIST</b>		DWG. NO: <b>M1</b>

HORIZONTAL LOCATION OF  
ABUTMENT NO. 2/WW3 (TYP)

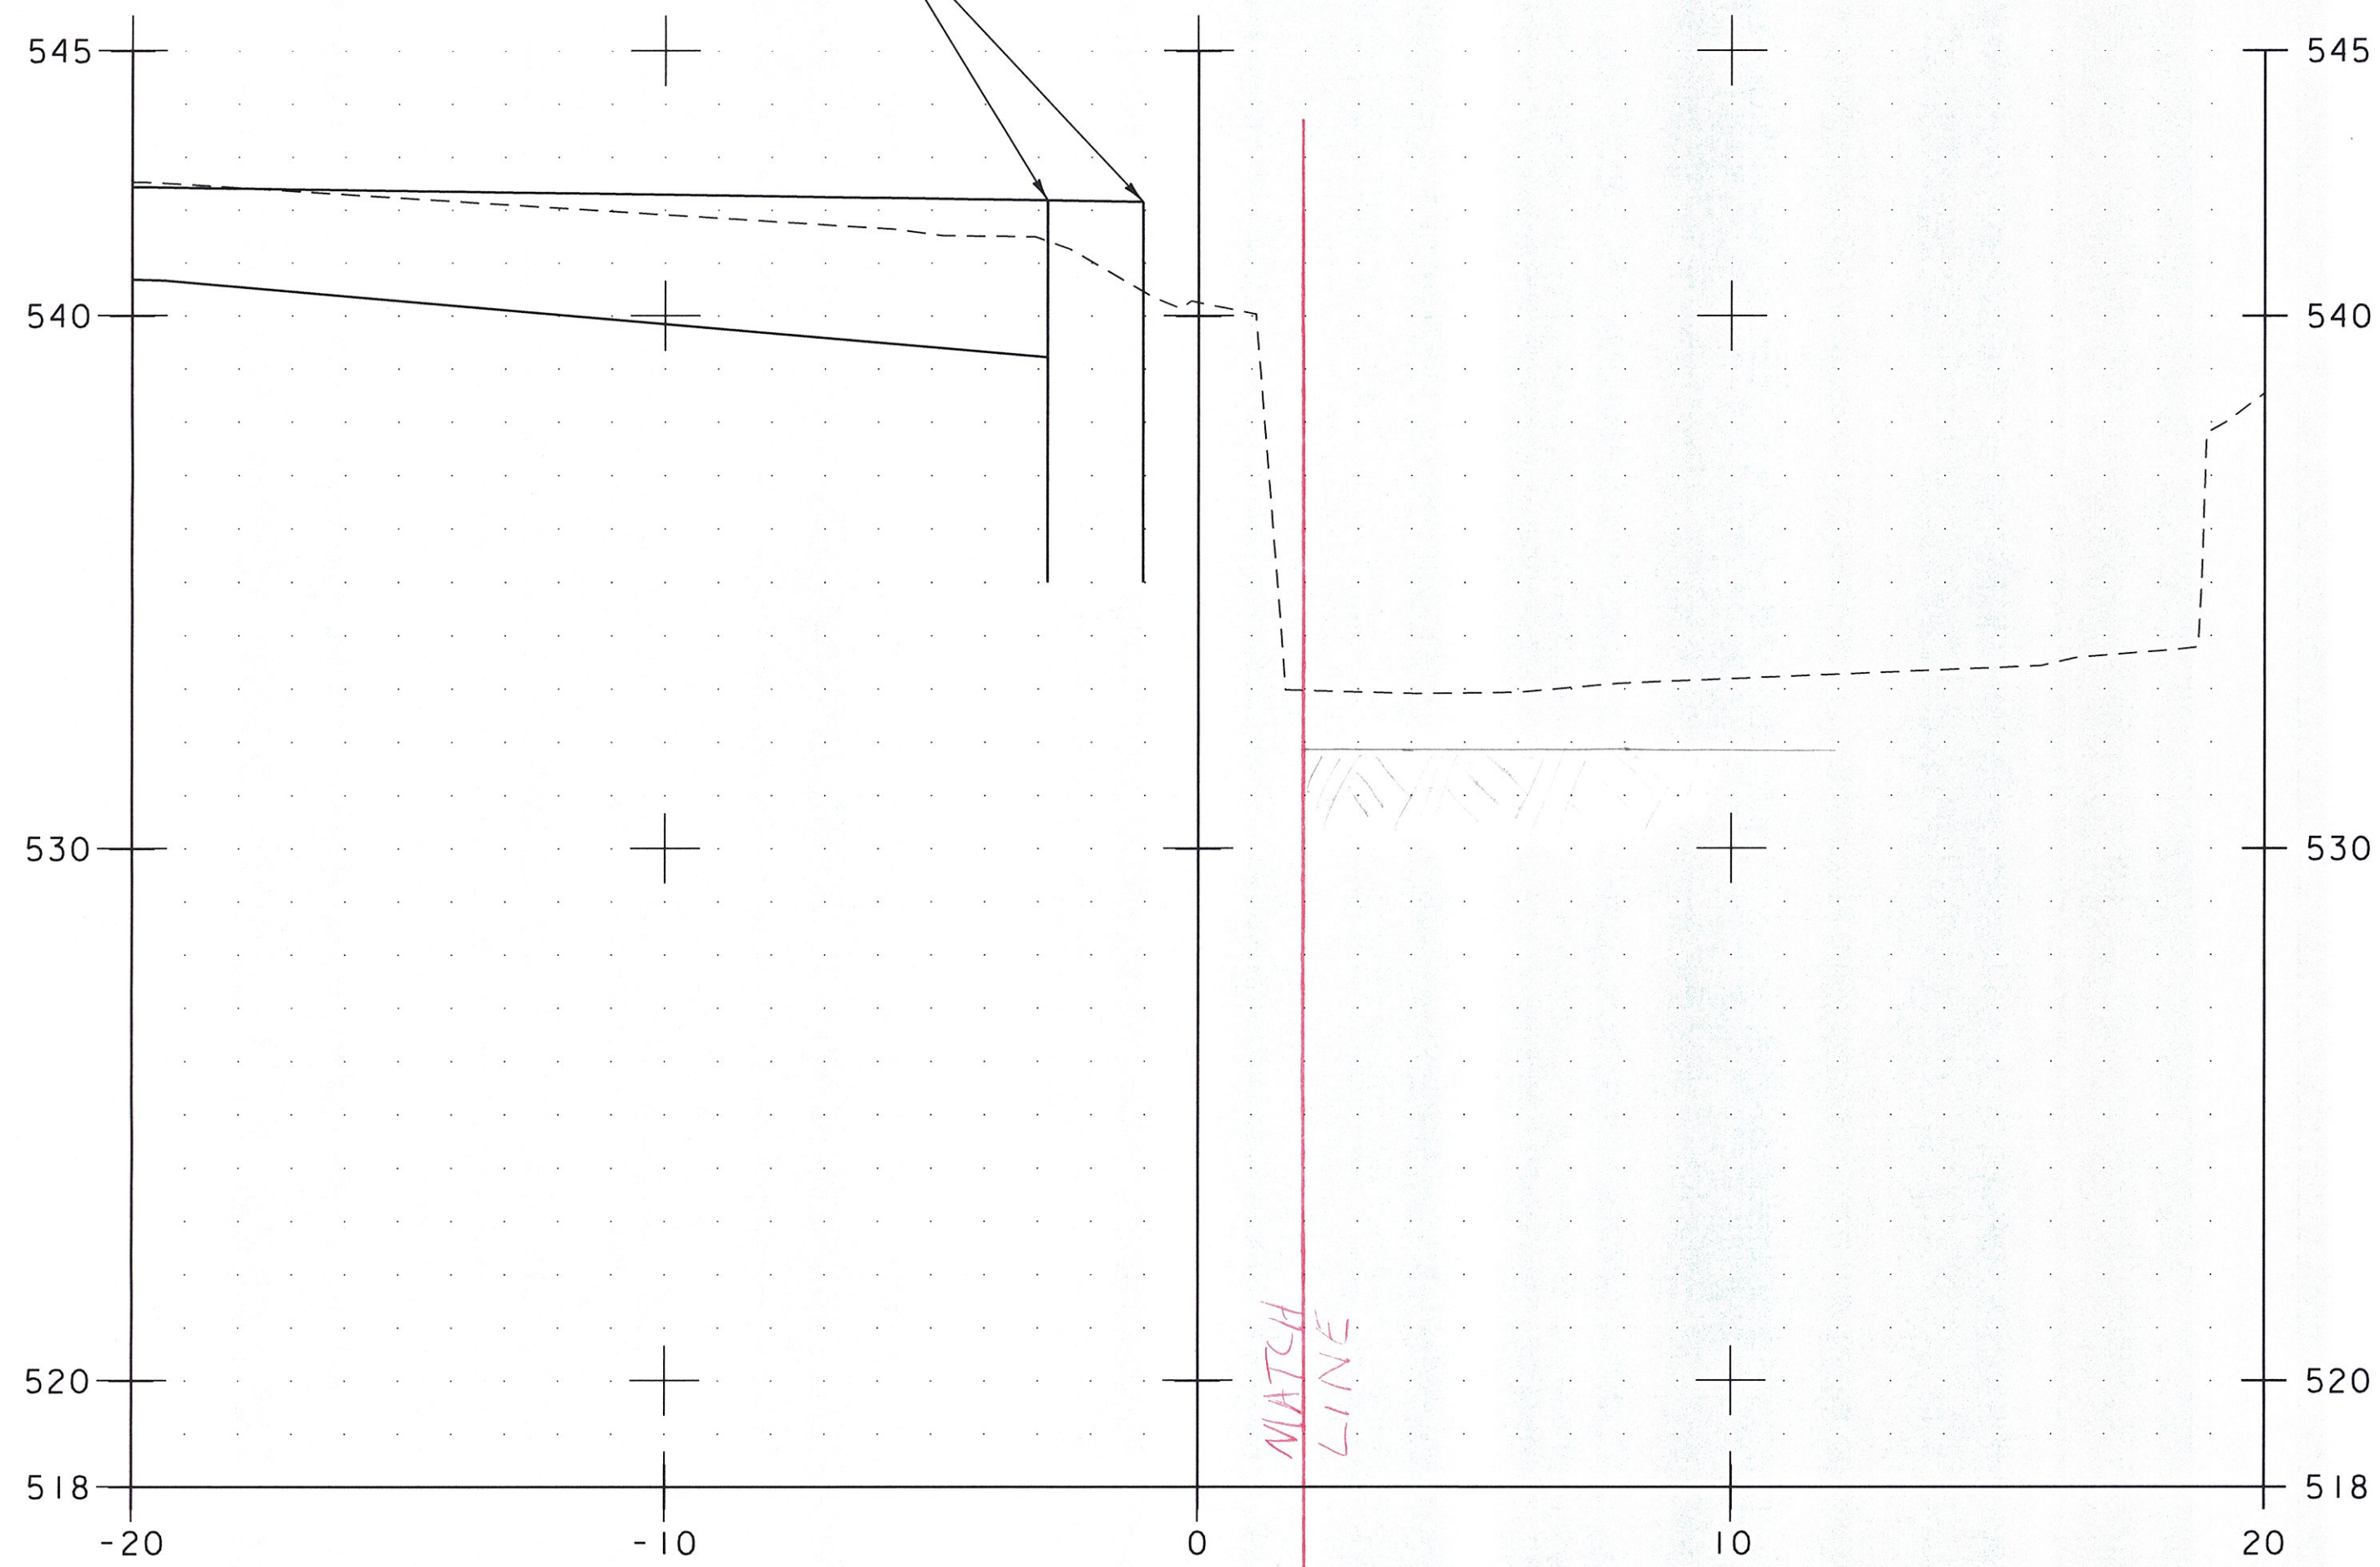

19+80.50

Unclassified Channel Excavation = Zero  
 Stone Fill, type # = Zero  
 Geo. Under Stone Fill = Zero  
 Unclassified Channel = Zero

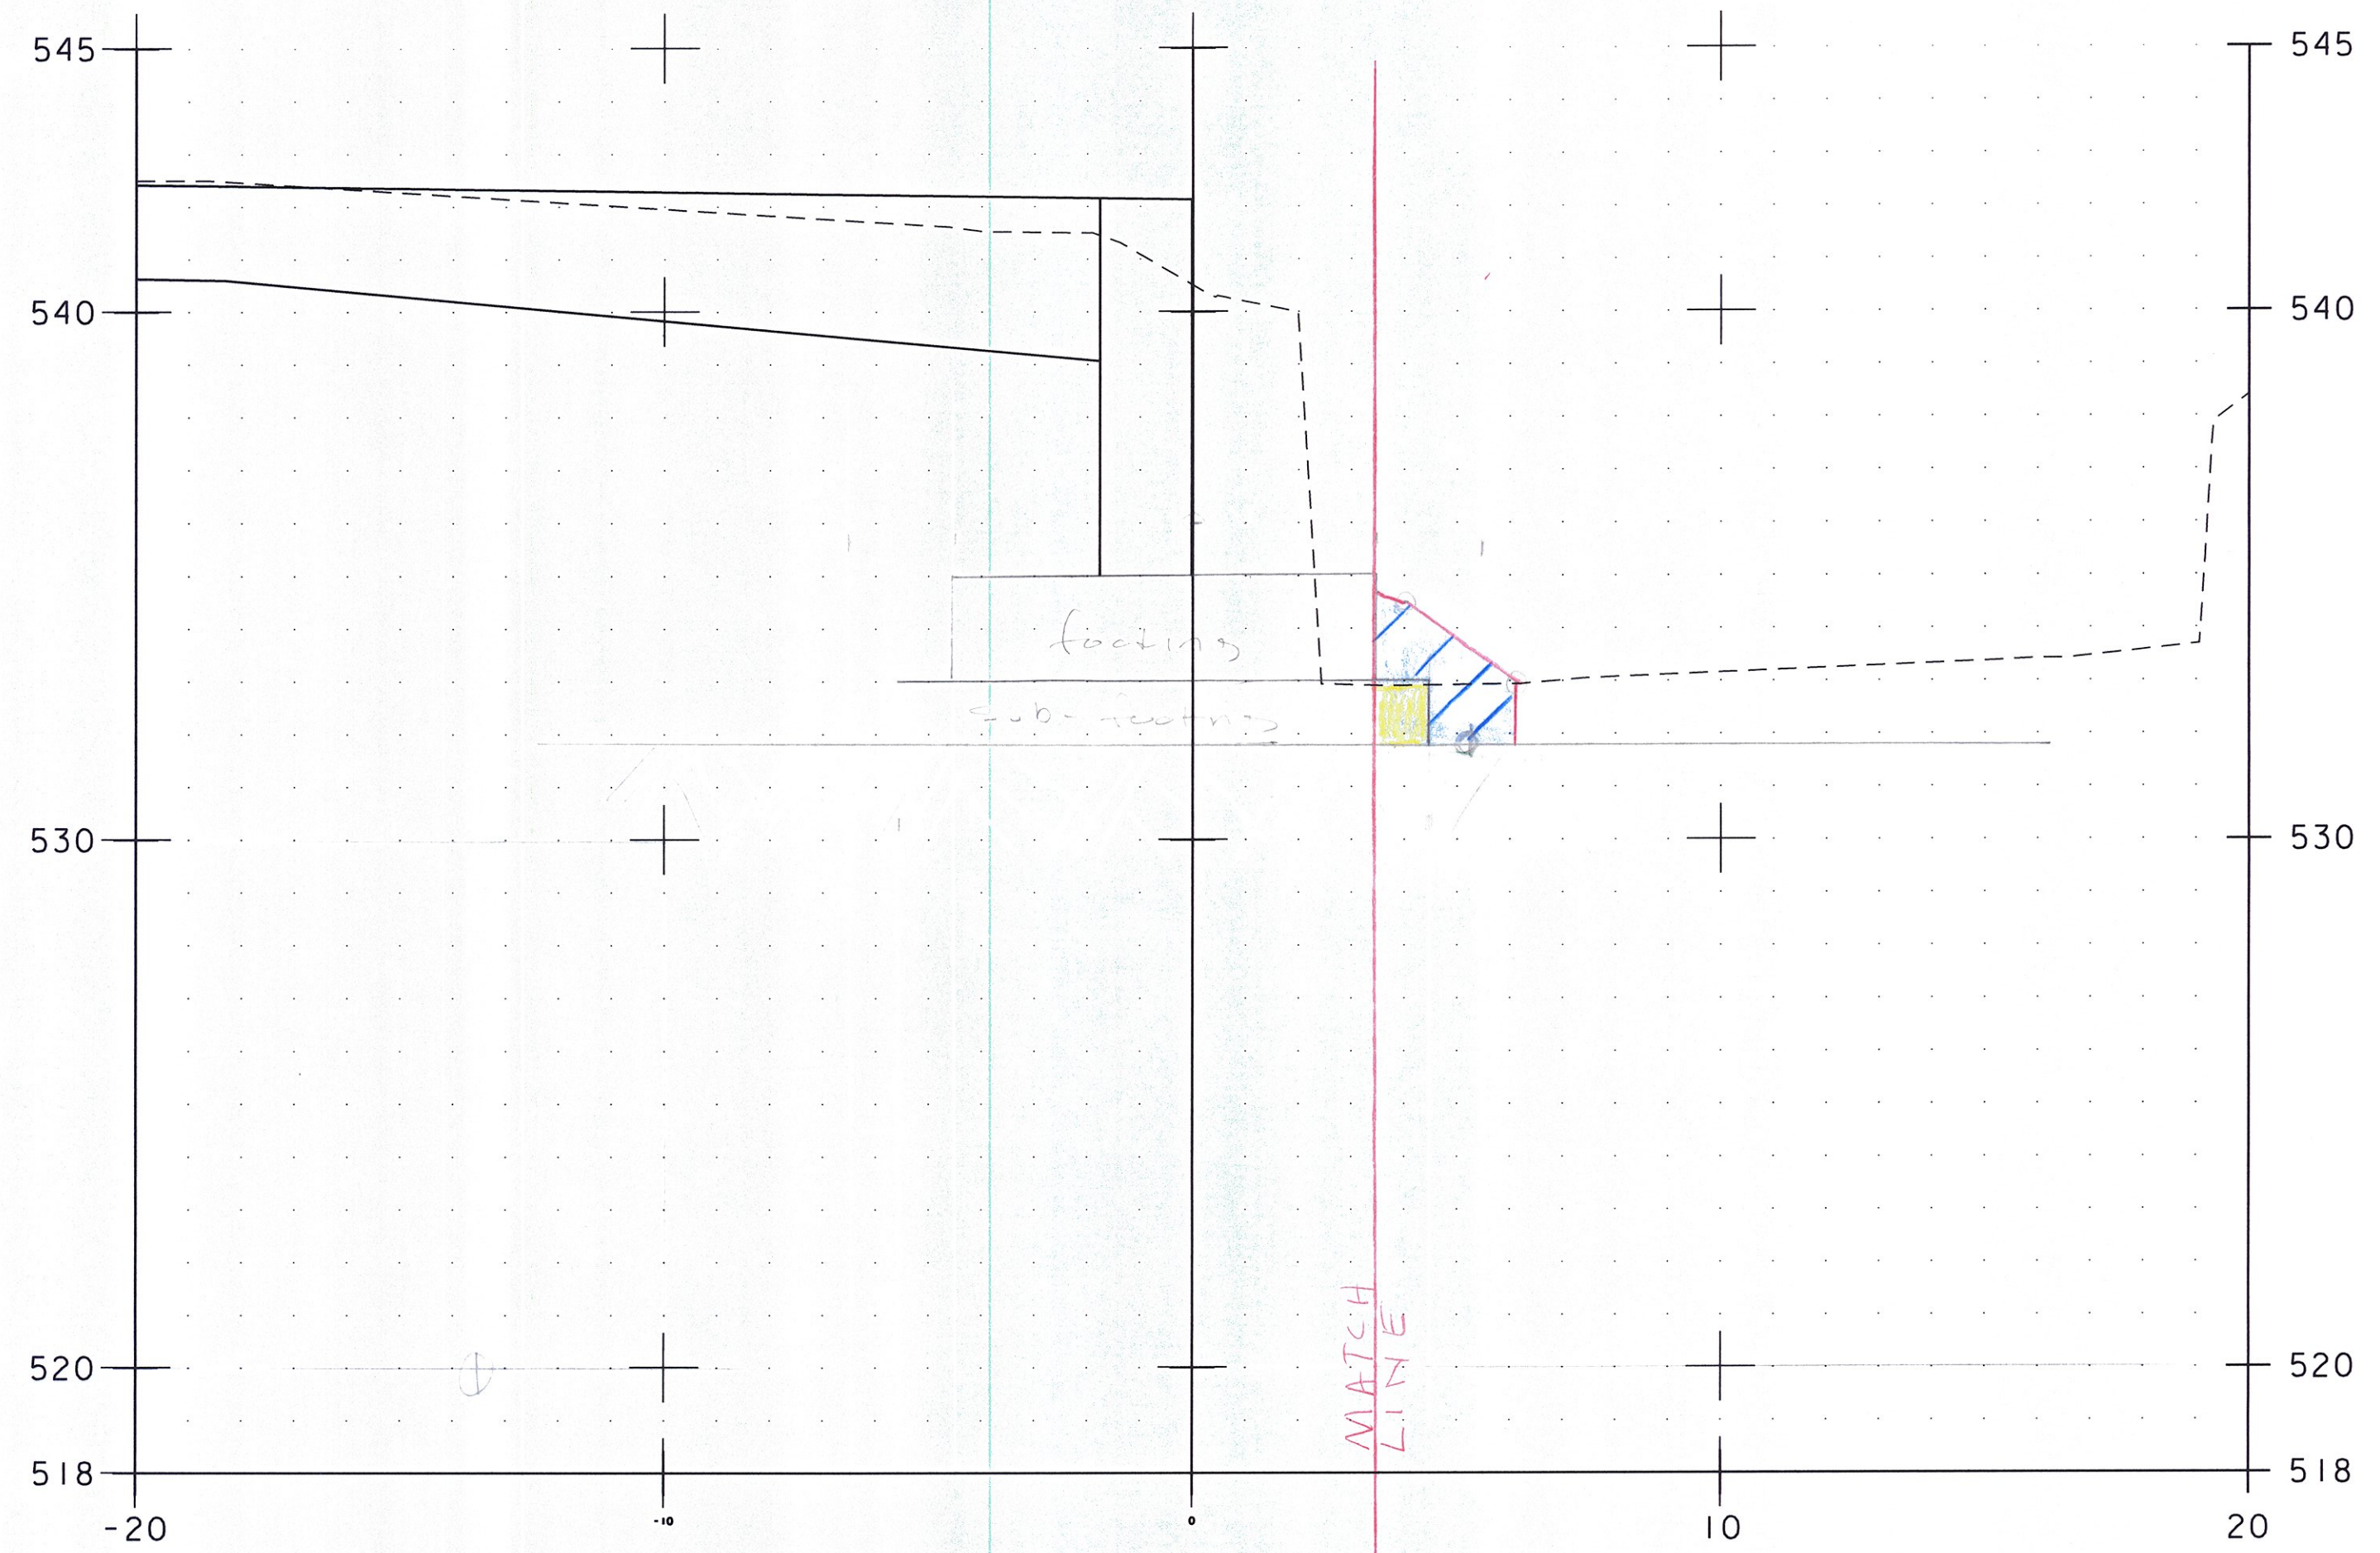

19+81.60

Cofferdam Excavation = Zero  
 Granular Backfill for Settlement = Zero  
 Unclassified Channel Excavation = 55 ft²  
 Stone Fill, type # = 4.5 ft²  
 Unclassified Channel = 5 ft²  
 M.W.H. 6/25/15  
 JDE 7/1/15

NOTE: LOCATION OF SUBBASE IS APPROXIMATE,  
PROPOSED GRADE IS NOT SHOWN.


PROJECT NAME: BRATTLEBORO  
 PROJECT NUMBER: BRO 1442(35)

FILE NAME: z10j062_customEL.dgn  
 PROJECT LEADER: S.E. BURBANK  
 DESIGNED BY: E.F. LAWES  
 ABUTMENT NO. 2 CROSS SECTIONS (1 OF 9)


PLOT DATE: 3/2/2015  
 DRAWN BY: E.F. LAWES  
 CHECKED BY: S.E. BURBANK  
 SHEET 1 OF 28



SCALE 1" = 3'-0"

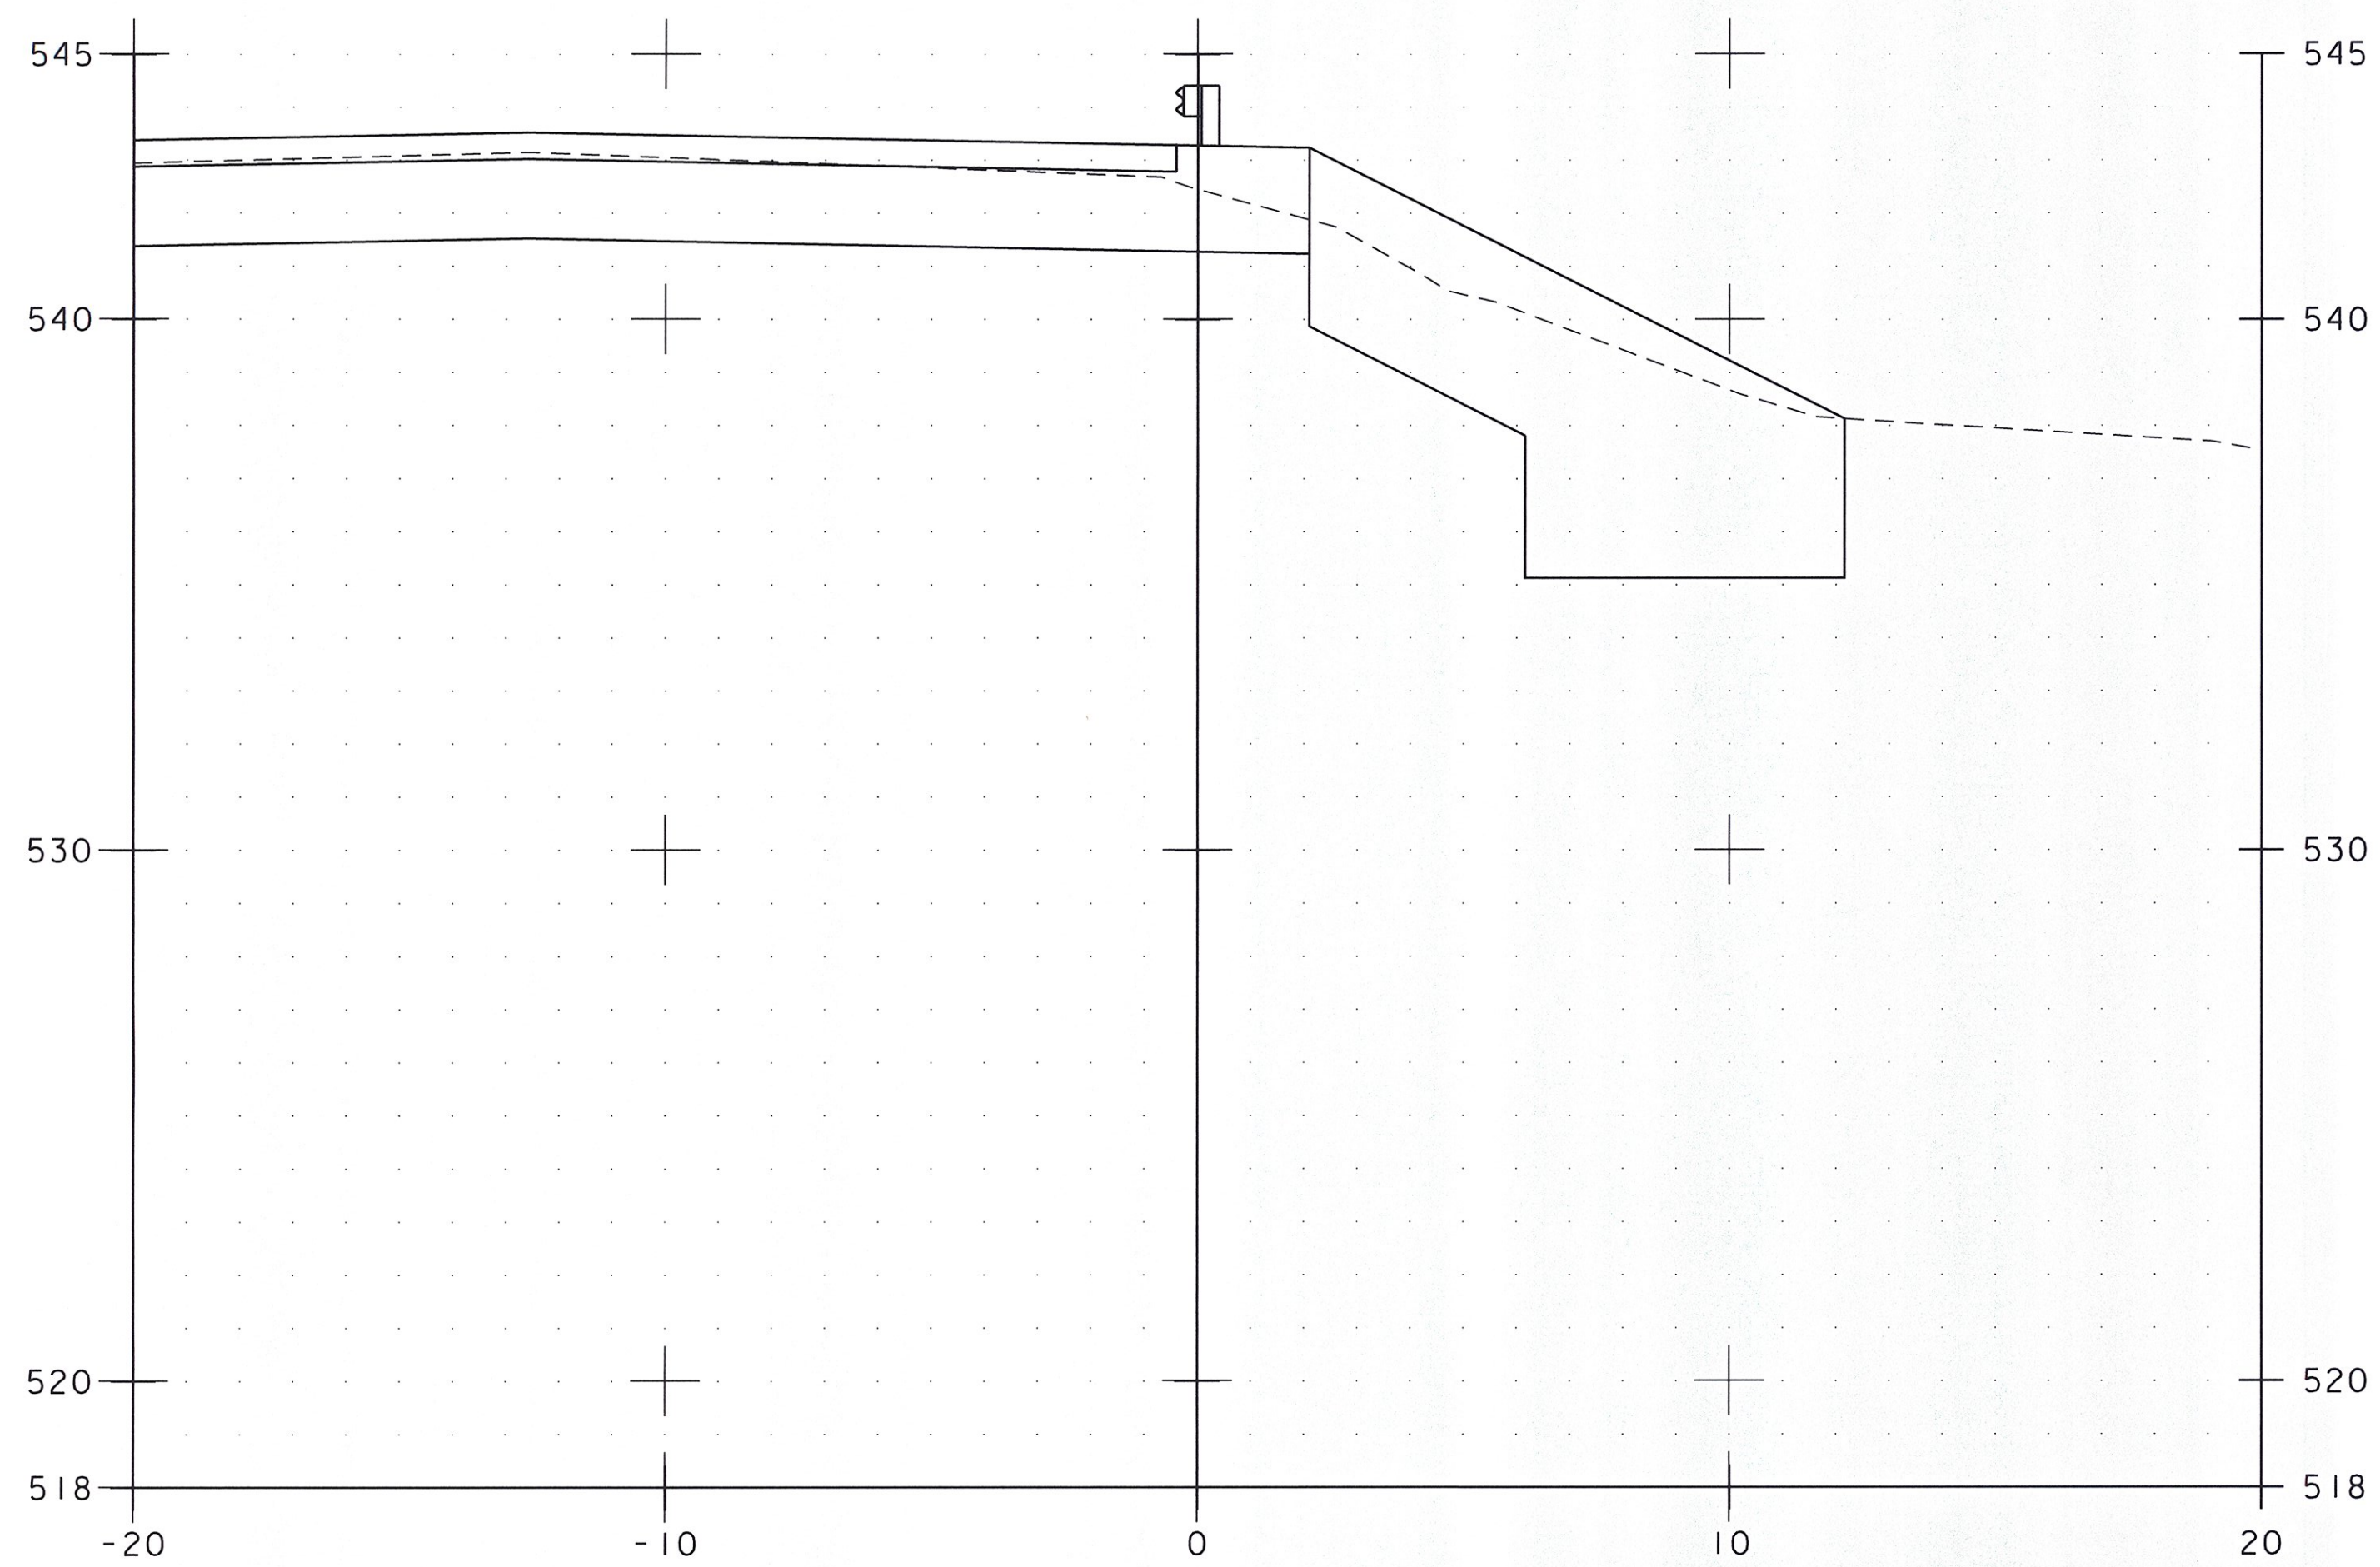

29+40.00

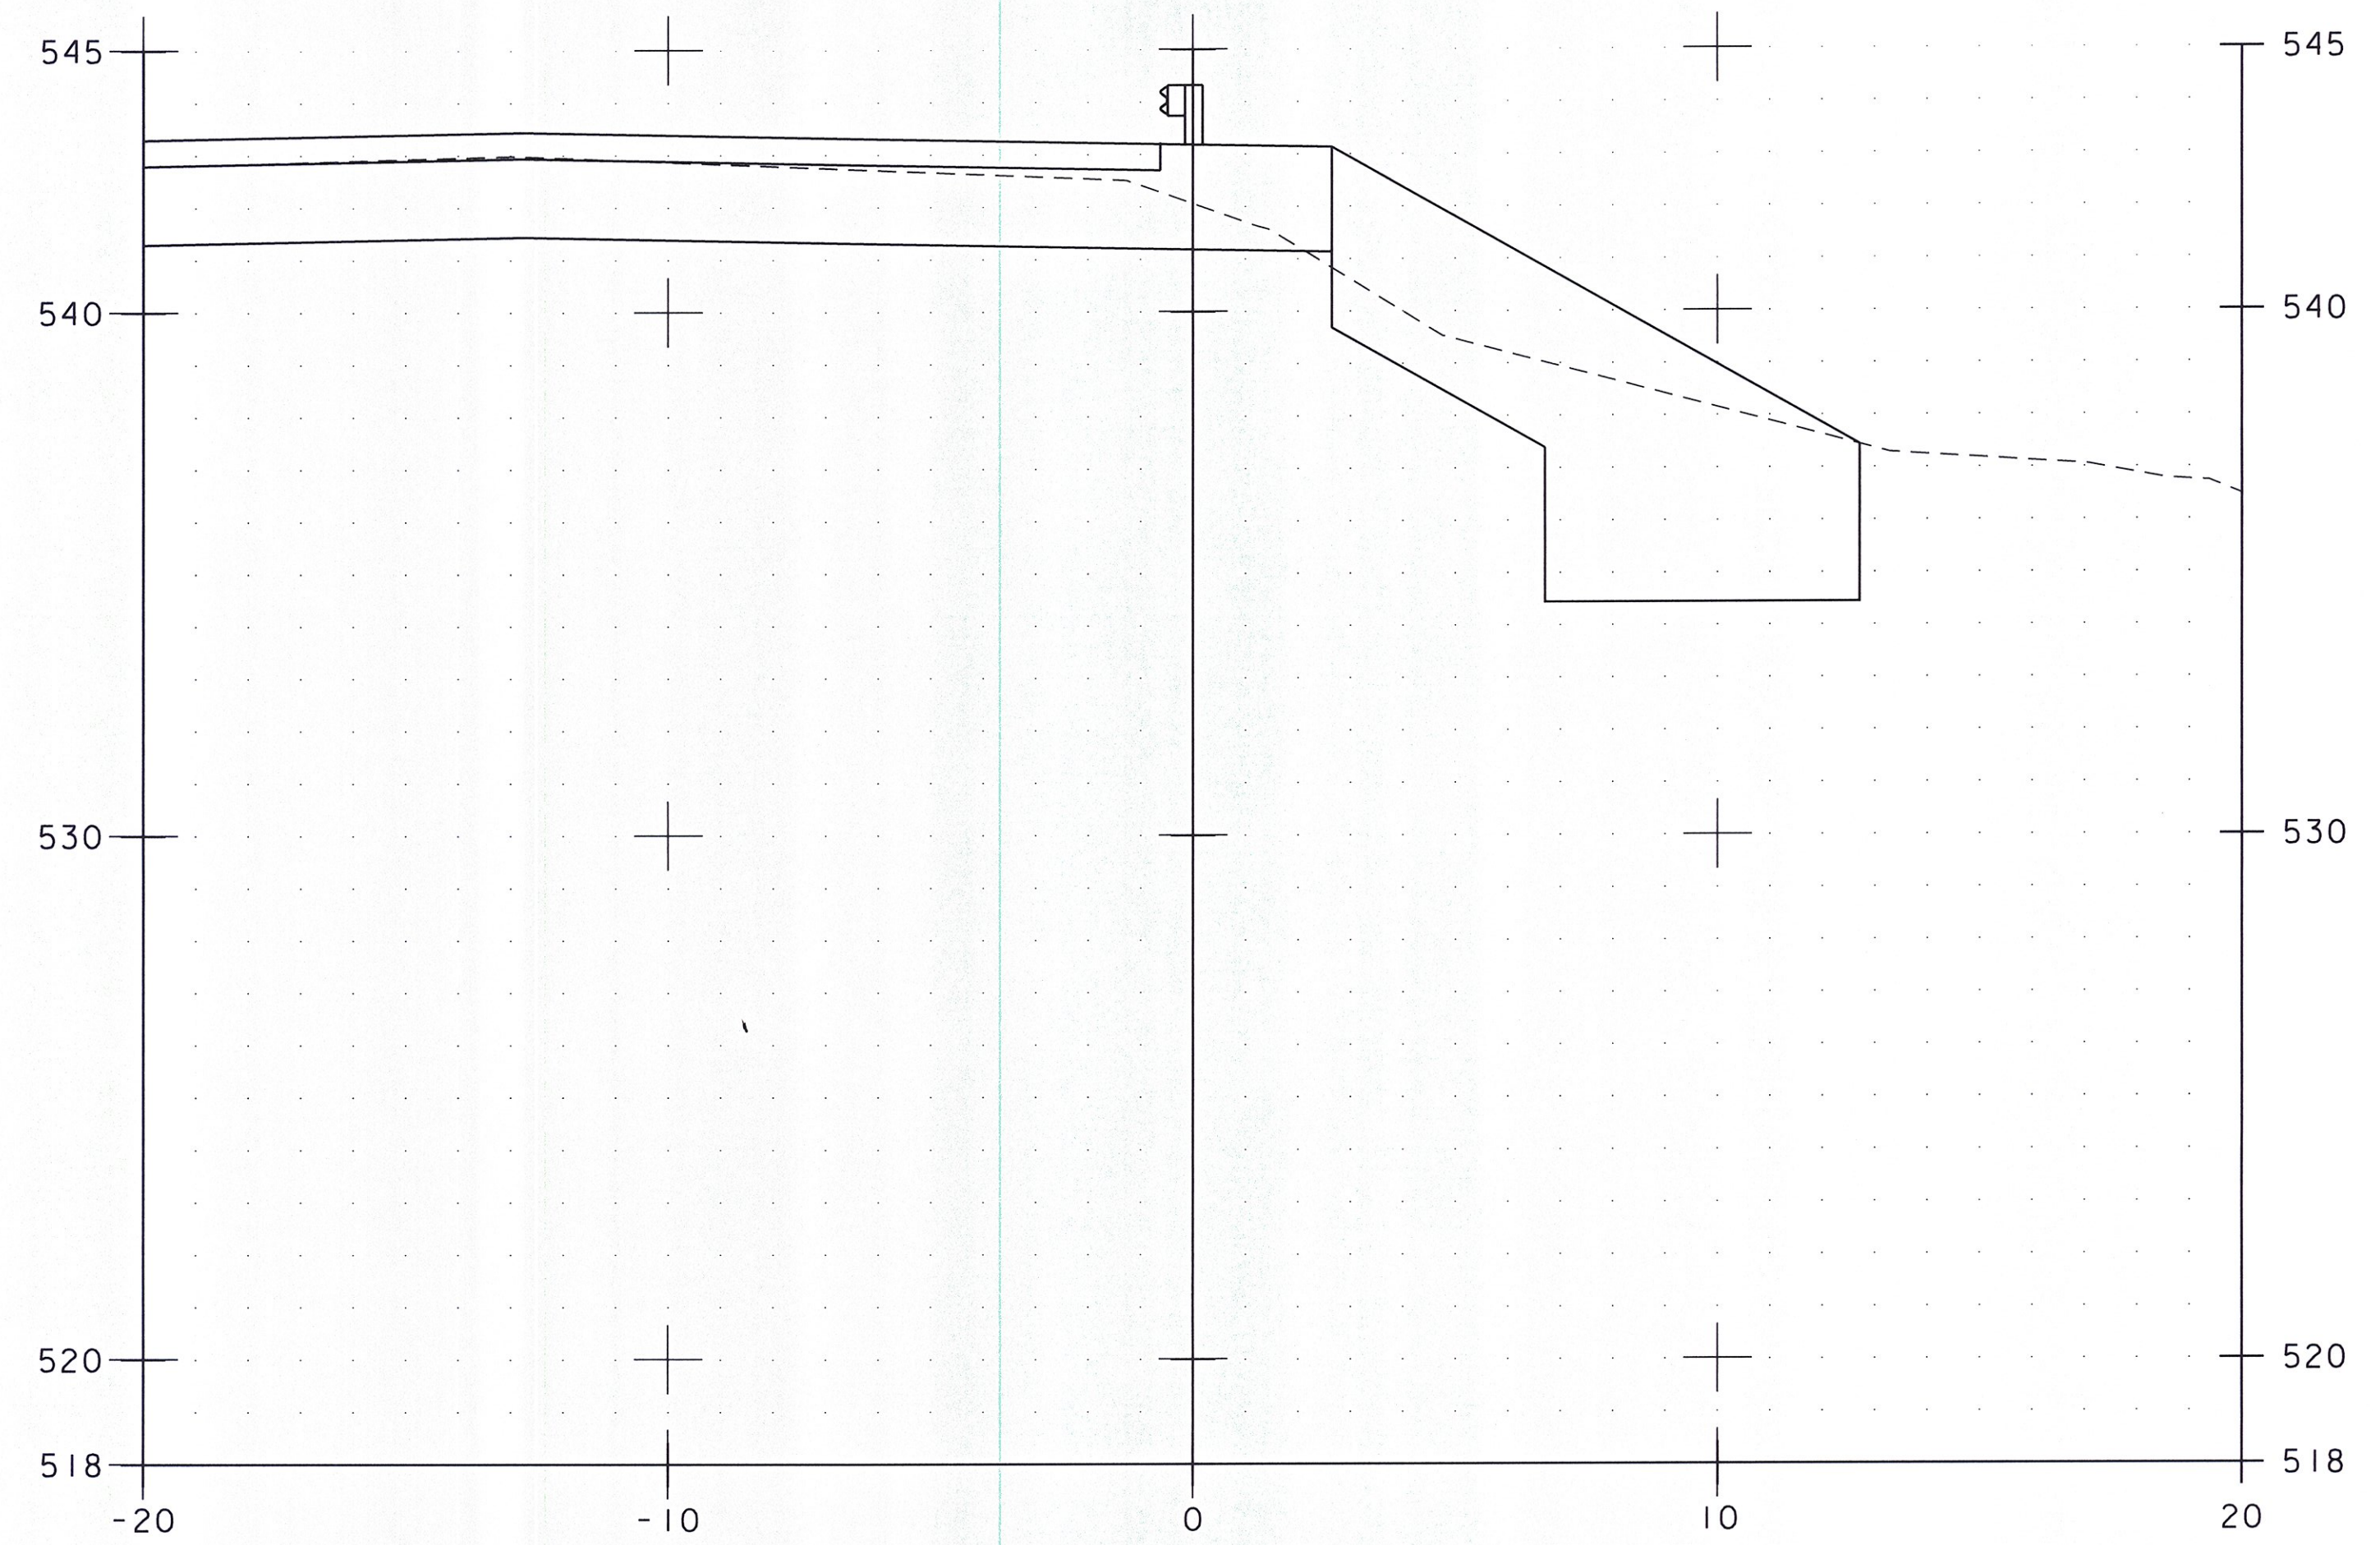

29+50.00

NOTE: PROPOSED GRADE IS NOT SHOWN.


PROJECT NAME:	BRATTLEBORO
PROJECT NUMBER:	BRO 1442(35)
FILE NAME:	z10j062_customEL.dgn
PROJECT LEADER:	S.E. BURBANK
DESIGNED BY:	E.F. LAWES
WINGWALL NO. 3 CROSS SECTIONS (1 OF 7)	
PLOT DATE:	3/2/2015
DRAWN BY:	E.F. LAWES
CHECKED BY:	S.E. BURBANK
SHEET	10 OF 28



SCALE 1" = 3'-0"

148.00' = 27.2 FT  
 270 SF = 37.1 FT²  
 10800' = 149.7 FT²  
 7260' = 99.9 FT²

148.00' = 27.2 FT  
 270 SF = 37.1 FT²  
 10800' = 149.7 FT²  
 7260' = 99.9 FT²

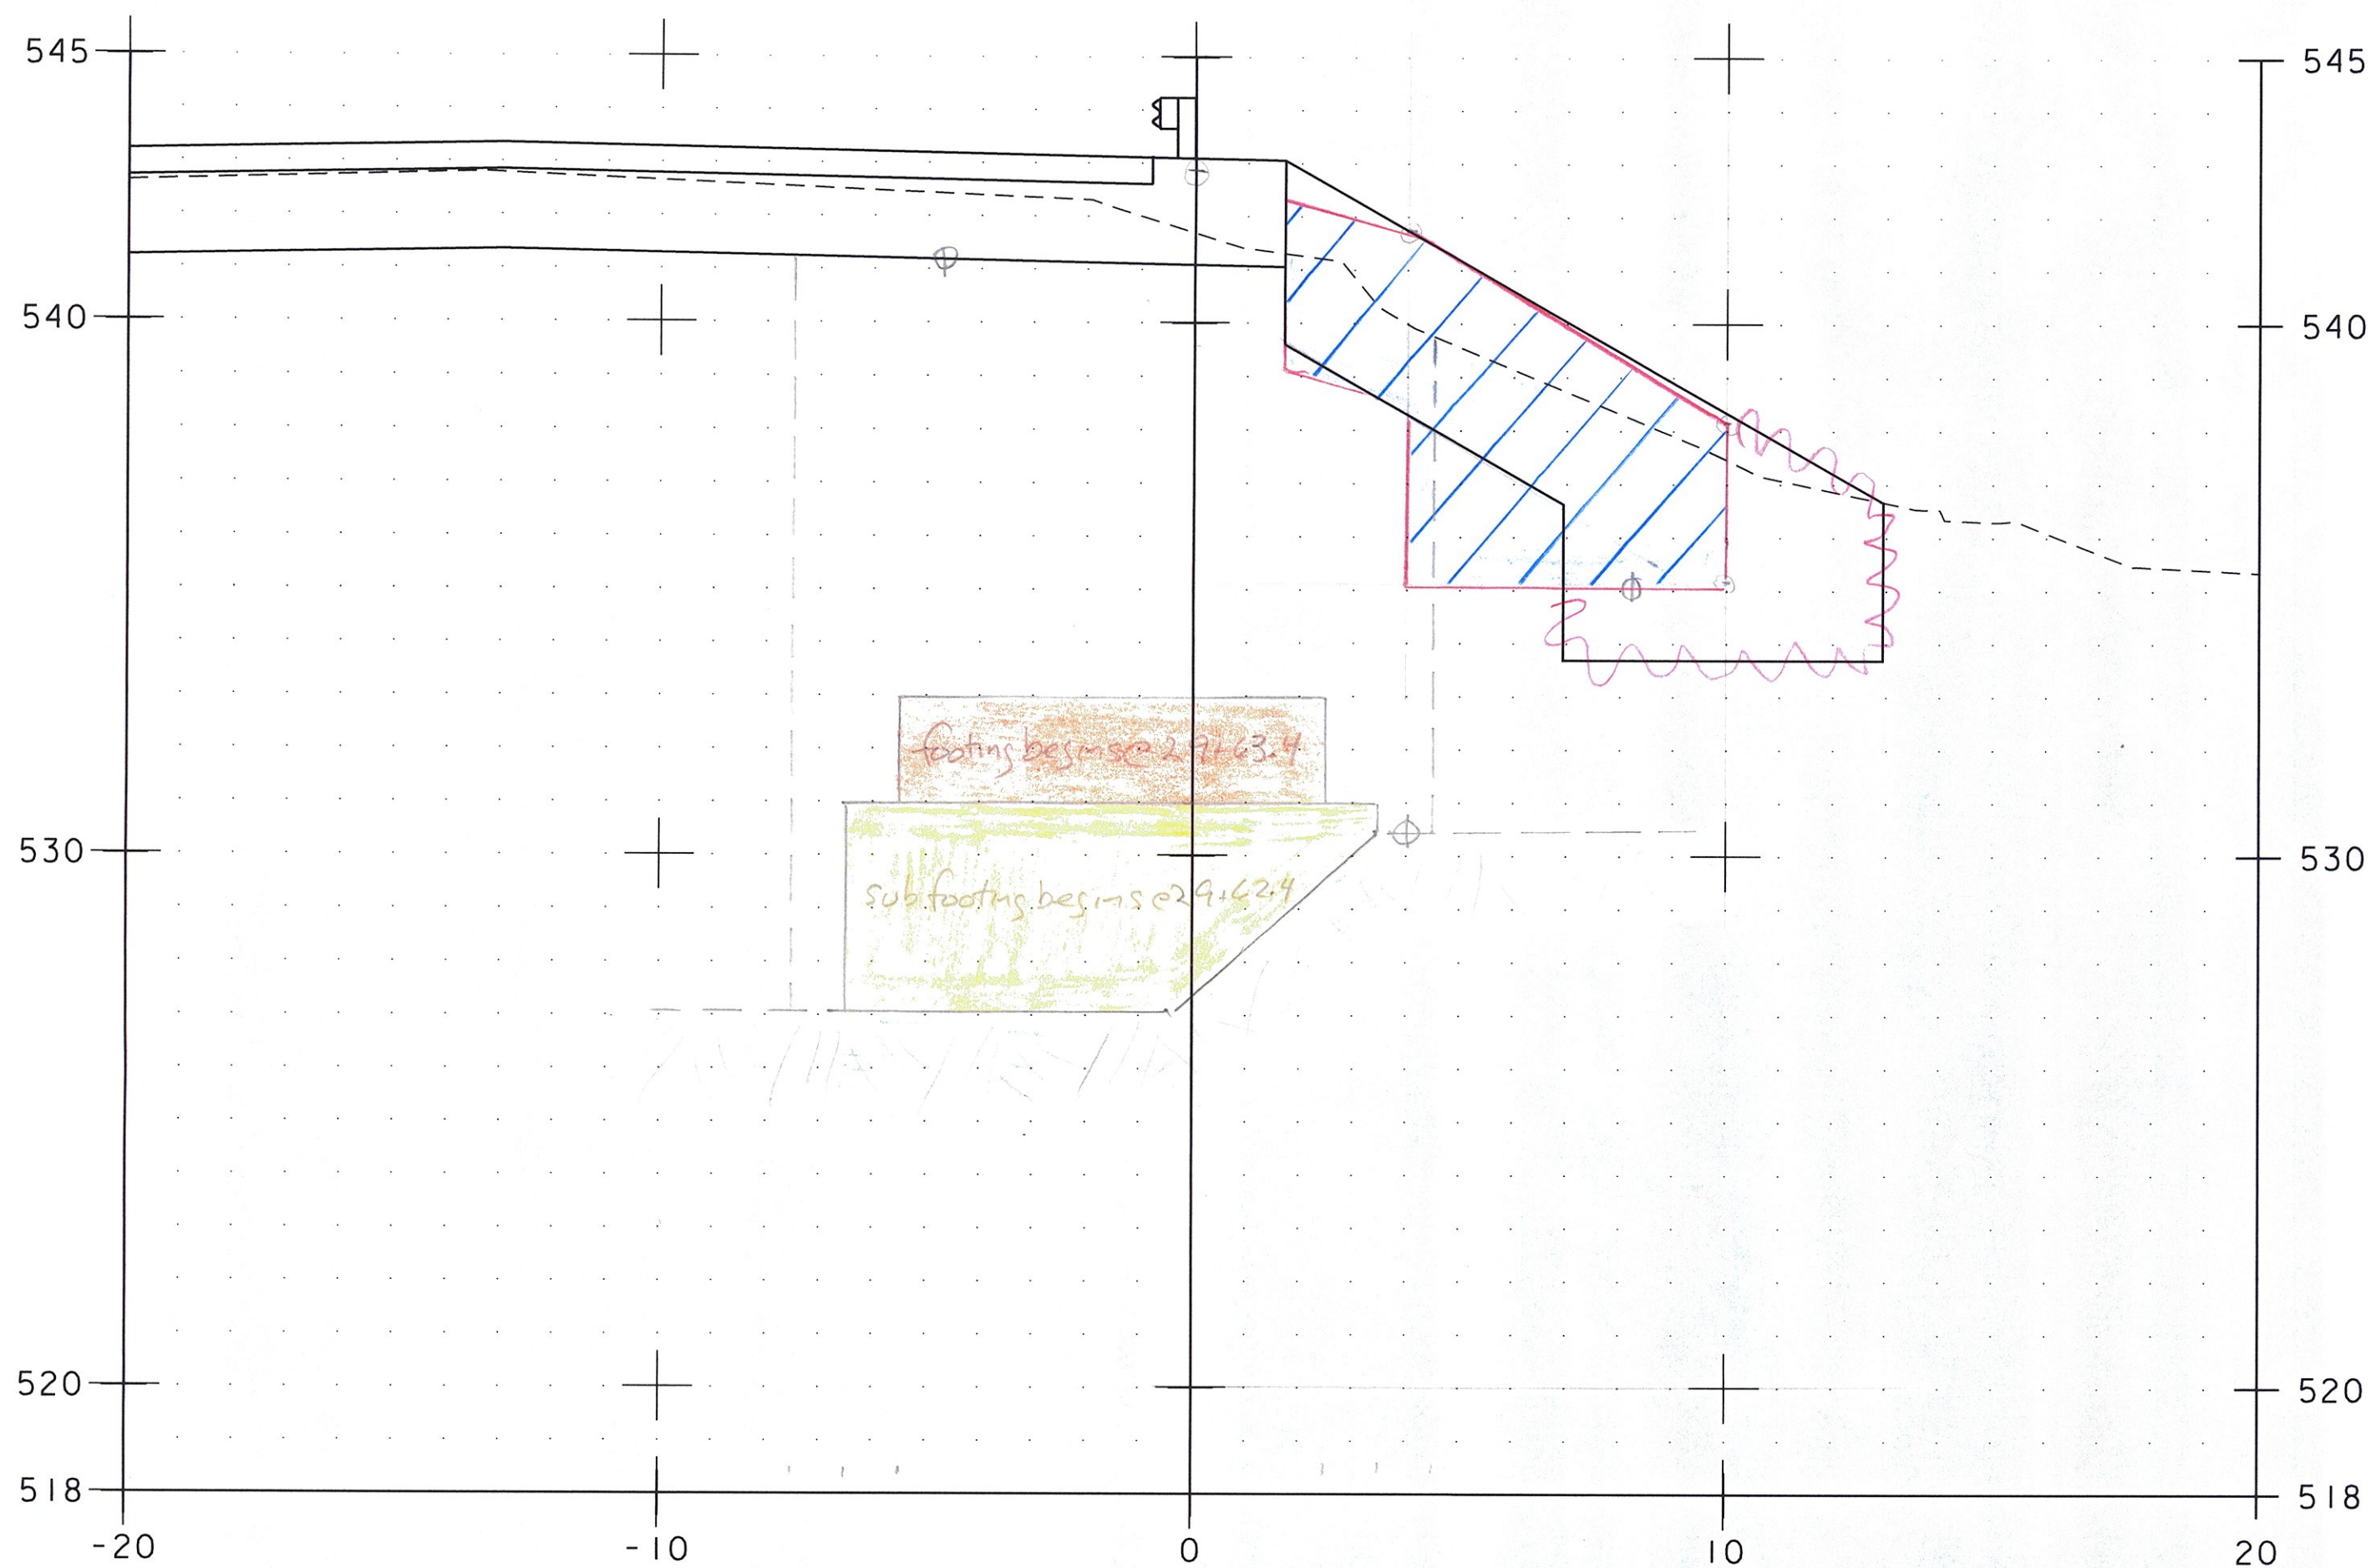

Collar Dam Earth  
 (cut)  $29+61.4 \text{ to } 29+62.4$  (cut) = 149.7 FT² ✓  
 $29+62.4$  (cut) = 149.7 FT² ✓  
 use final X-section = 29+62

Geo. Order Stone Fill Structures  
 (cut)  $29+61.4 \text{ to } 29+62.4$  (cut) = 149.7 FT² ✓  
 $29+62.4$  (cut) = 118.1 FT² ✓

Unclassified Channel Excavation  
 (cut)  $29+55 \text{ to } 29+61.4$  = 27.2 FT² ✓


Stone Fill, Type III  
 (cut)  $29+55 \text{ to } 29+61.4$  = 37.1 FT² ✓

Geo. Order Stone Fill  
 (cut)  $29+55 \text{ to } 29+61.4$  = 17.5' ✓  
 fm 5/5/15

29+61.40

use final X-section = 29+62

HORIZONTAL LOCATION  
 OF WINGWALL 3 (TYP)

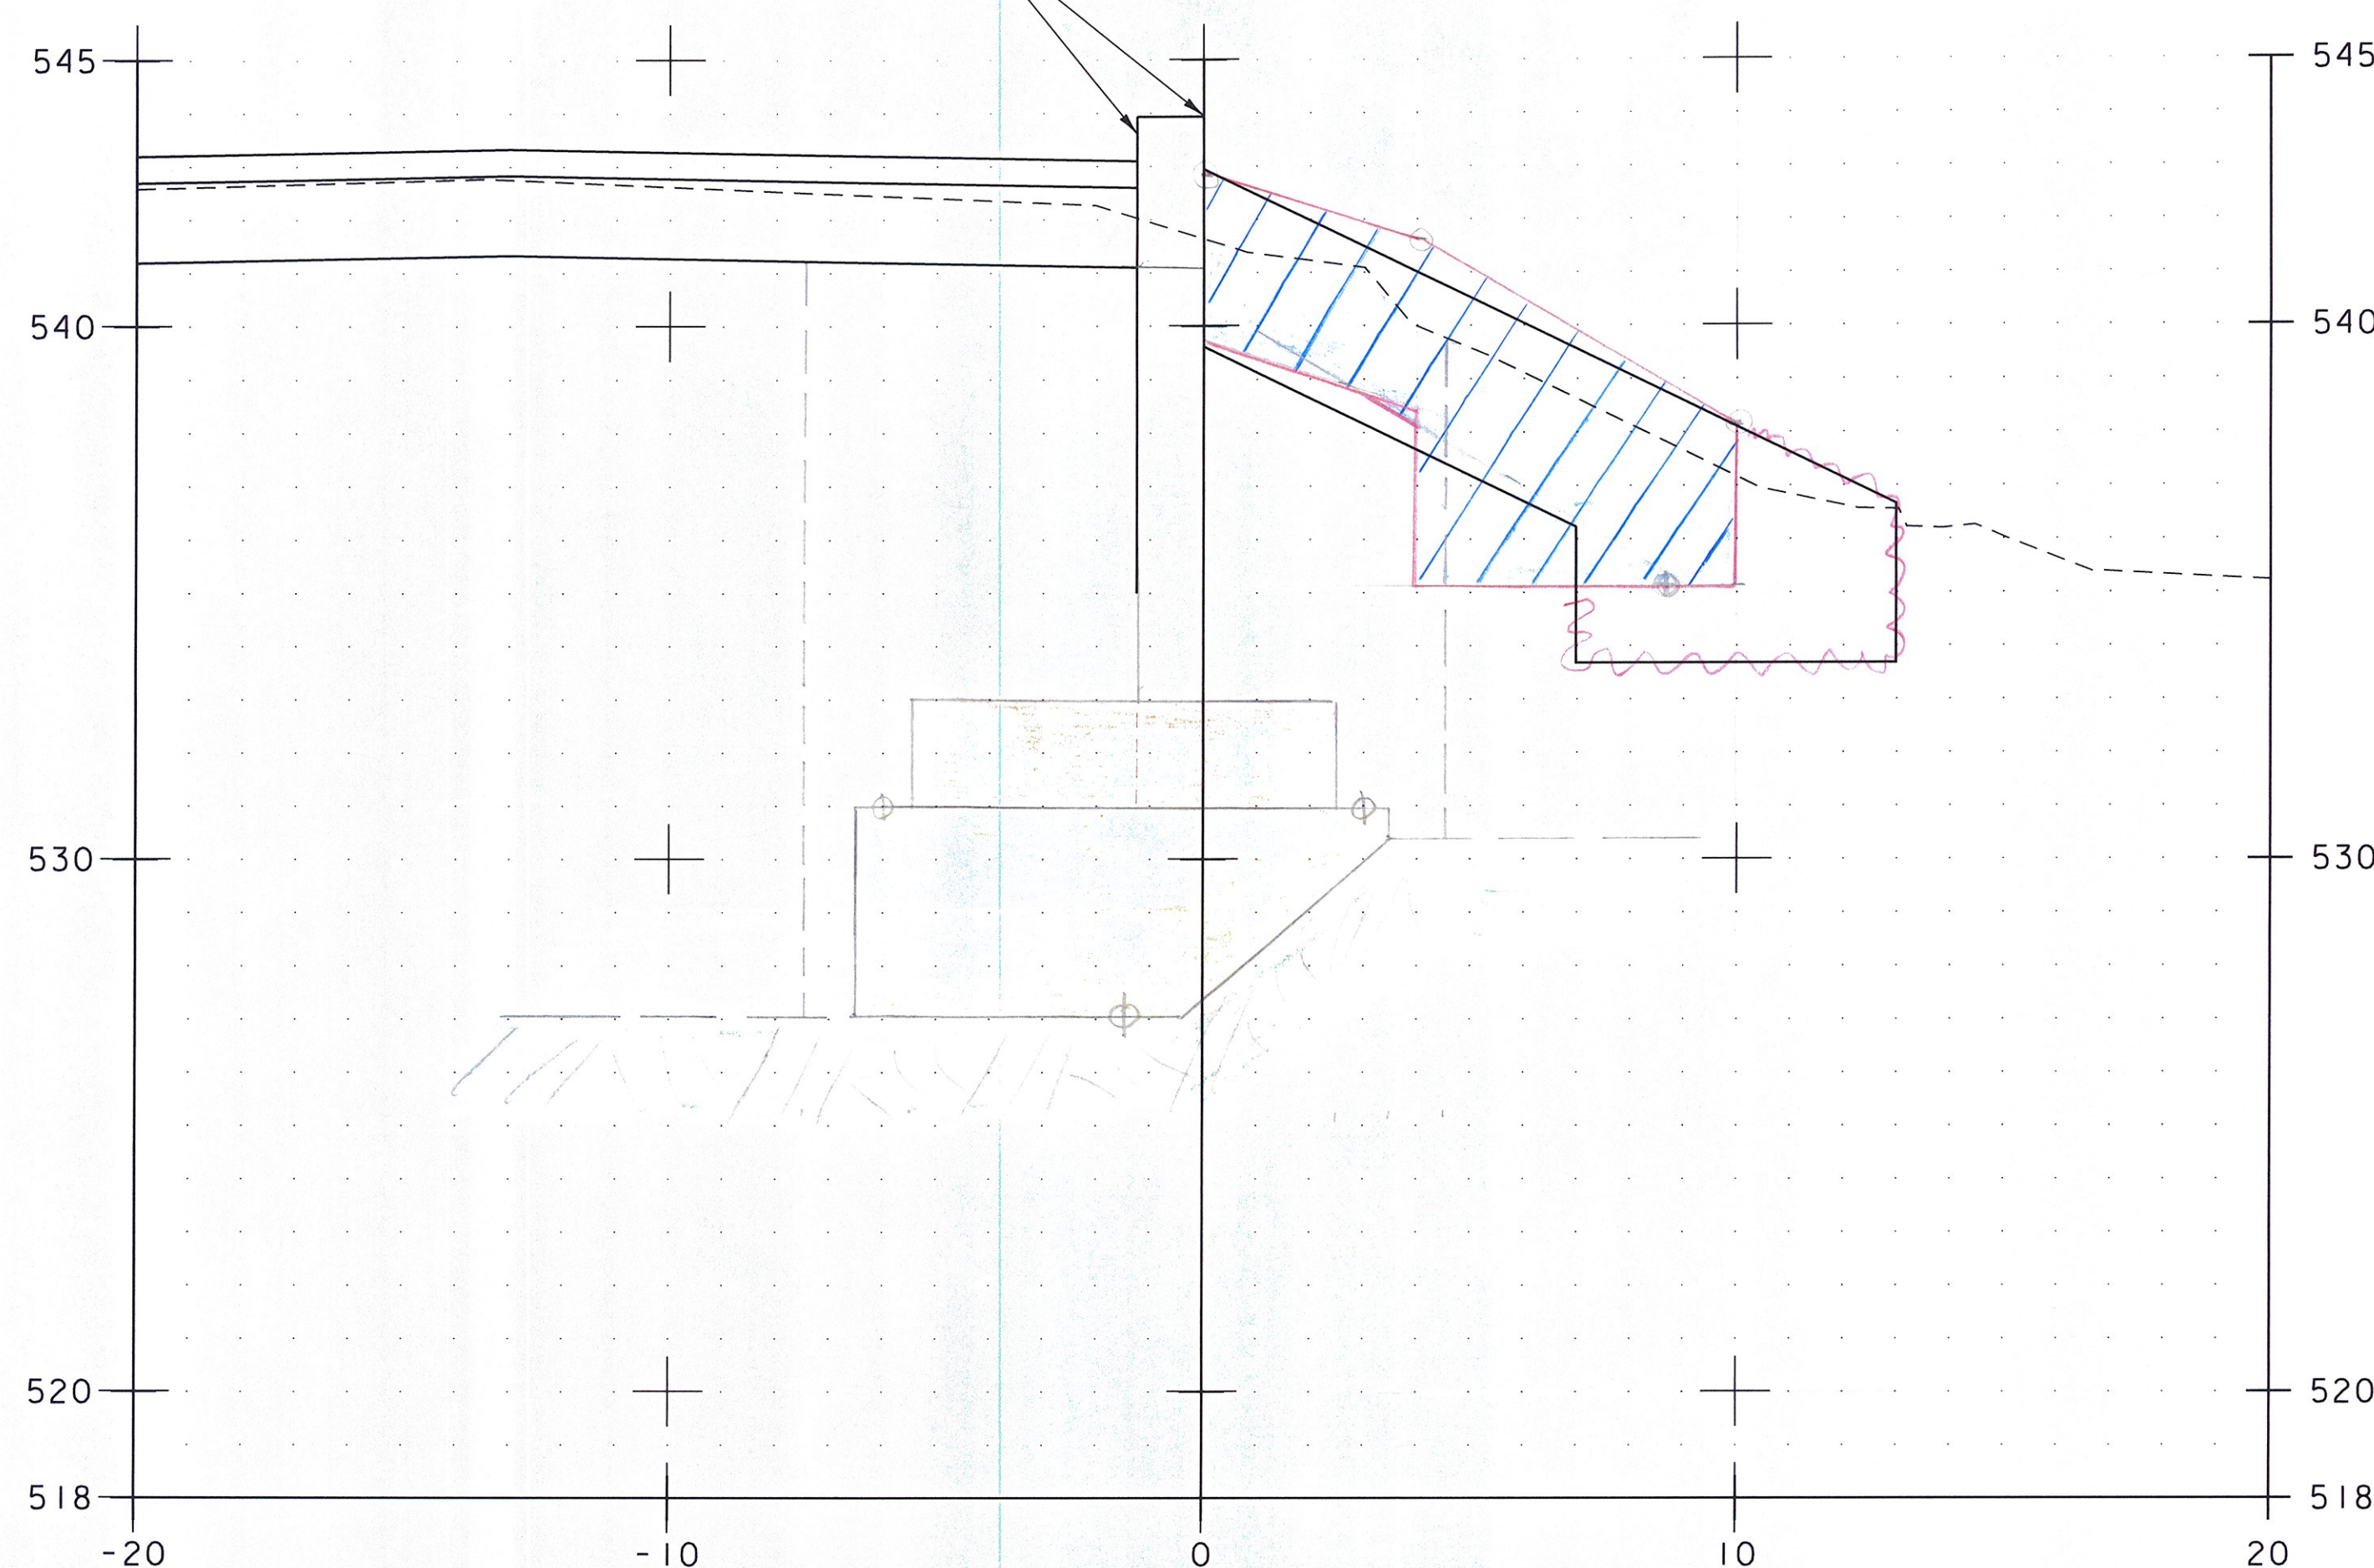

Collar Dam Earth  
 29+63.4 (cut) ✓  
 29+63.4 (cut) ✓  
 Geo. Order Stone Fill Structures  
 29+63.4 (cut) ✓  
 29+63.4 (cut) ✓  
 Stone Fill, Type III  
 29+63.4 ✓  
 Geo. Order Stone Fill  
 29+63.4 = 19.5' ✓

29+63.40

use final X-section = 29+62

NOTE: PROPOSED GRADE IS NOT SHOWN.


PROJECT NAME: BRATTLEBORO	PLOT DATE: 3/2/2015
PROJECT NUMBER: BRO 1442(35)	DRAWN BY: E.F. LAWES
FILE NAME: z10j062_customEL.dgn	CHECKED BY: S.E. BURBANK
PROJECT LEADER: S.E. BURBANK	DESIGNED BY: E.F. LAWES
WINGWALL NO. 3 CROSS SECTIONS (2 OF 7)	SHEET II OF 28

SCALE 1" = 3'-0"




$335 \text{ CE} = 121.5 \text{ FT}^2$   
 $10-372 = 67.5 \text{ FT}^2 \text{ (sh)}$   
 $74.3 \text{ FT}^2 \text{ (bk)}$   
 $173.304 = 24.5 \text{ FT}^2$   
 $28.951 = 39.8 \text{ FT}^2$

$114 \text{ CE} = 23.7 \text{ FT}^2$   
 $46.1 \text{ FT}^2 \text{ (sh)}$   
 $60.2 = 2.3 + 11.2 + 4.7 = 18.2 \text{ FT}^2$   
 $2.8 \text{ CE} = 0.3 \text{ FT}^2$   
 $2.1 \text{ CE} = 0.2 \text{ FT}^2$   
 $60.3 \text{ FT}^2 \text{ (sh)}$   
 $60.3 \text{ FT}^2 \text{ (bk)}$   
 $2.1 \text{ CE} = 0.2 \text{ FT}^2$

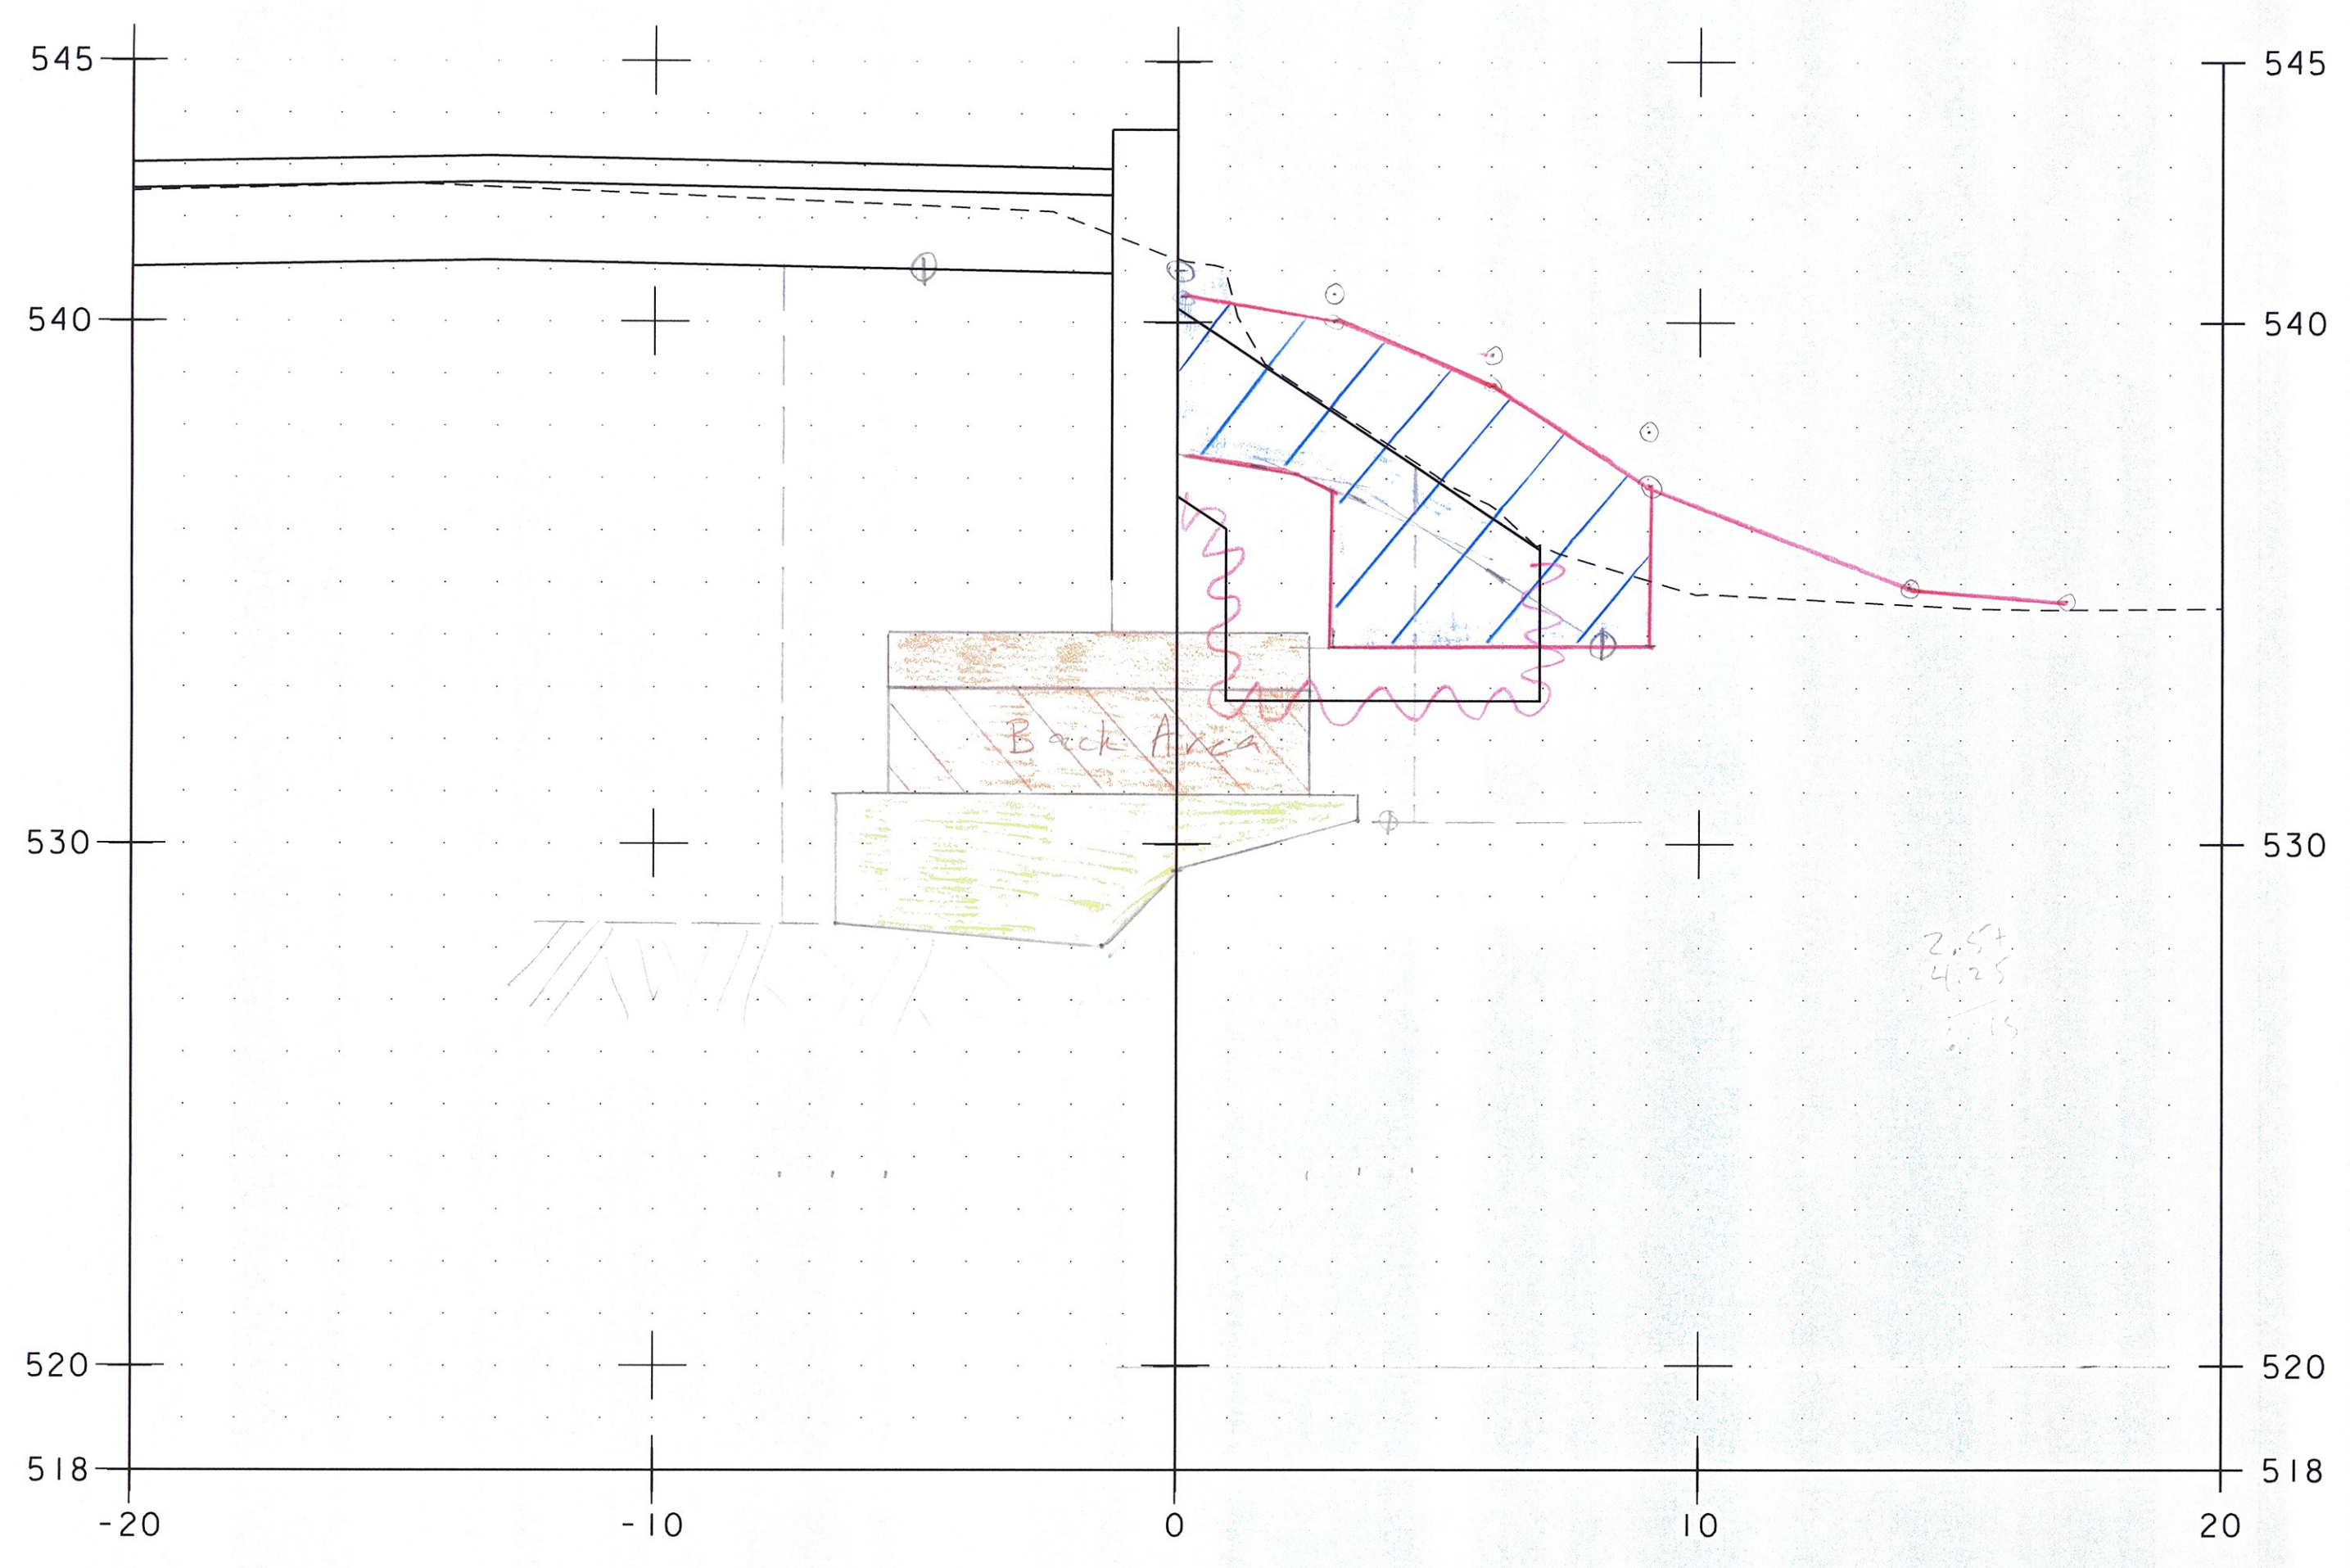

Cofferdam Earth  
 $29+79.0 = 121.5 \text{ FT}^2 \checkmark$   
 Granular Back fill for Structures  
 $29+79.0 \text{ (bk)} = 74.3 \text{ FT}^2 \checkmark$   
 $29+79.0 \text{ (sh)} = 67.5 \text{ FT}^2 \checkmark$   
 Unexcavated Channel Excavation  
 $29+79.0 = 24.5 \text{ FT}^2 \checkmark$   
 Stone Fill, type III  
 $29+79.0 = 39.8 \text{ FT}^2 \checkmark$   
 Geo. Under Stone Fill  
 $29+79.0 = 18' \checkmark$   
 PM 3/5/15

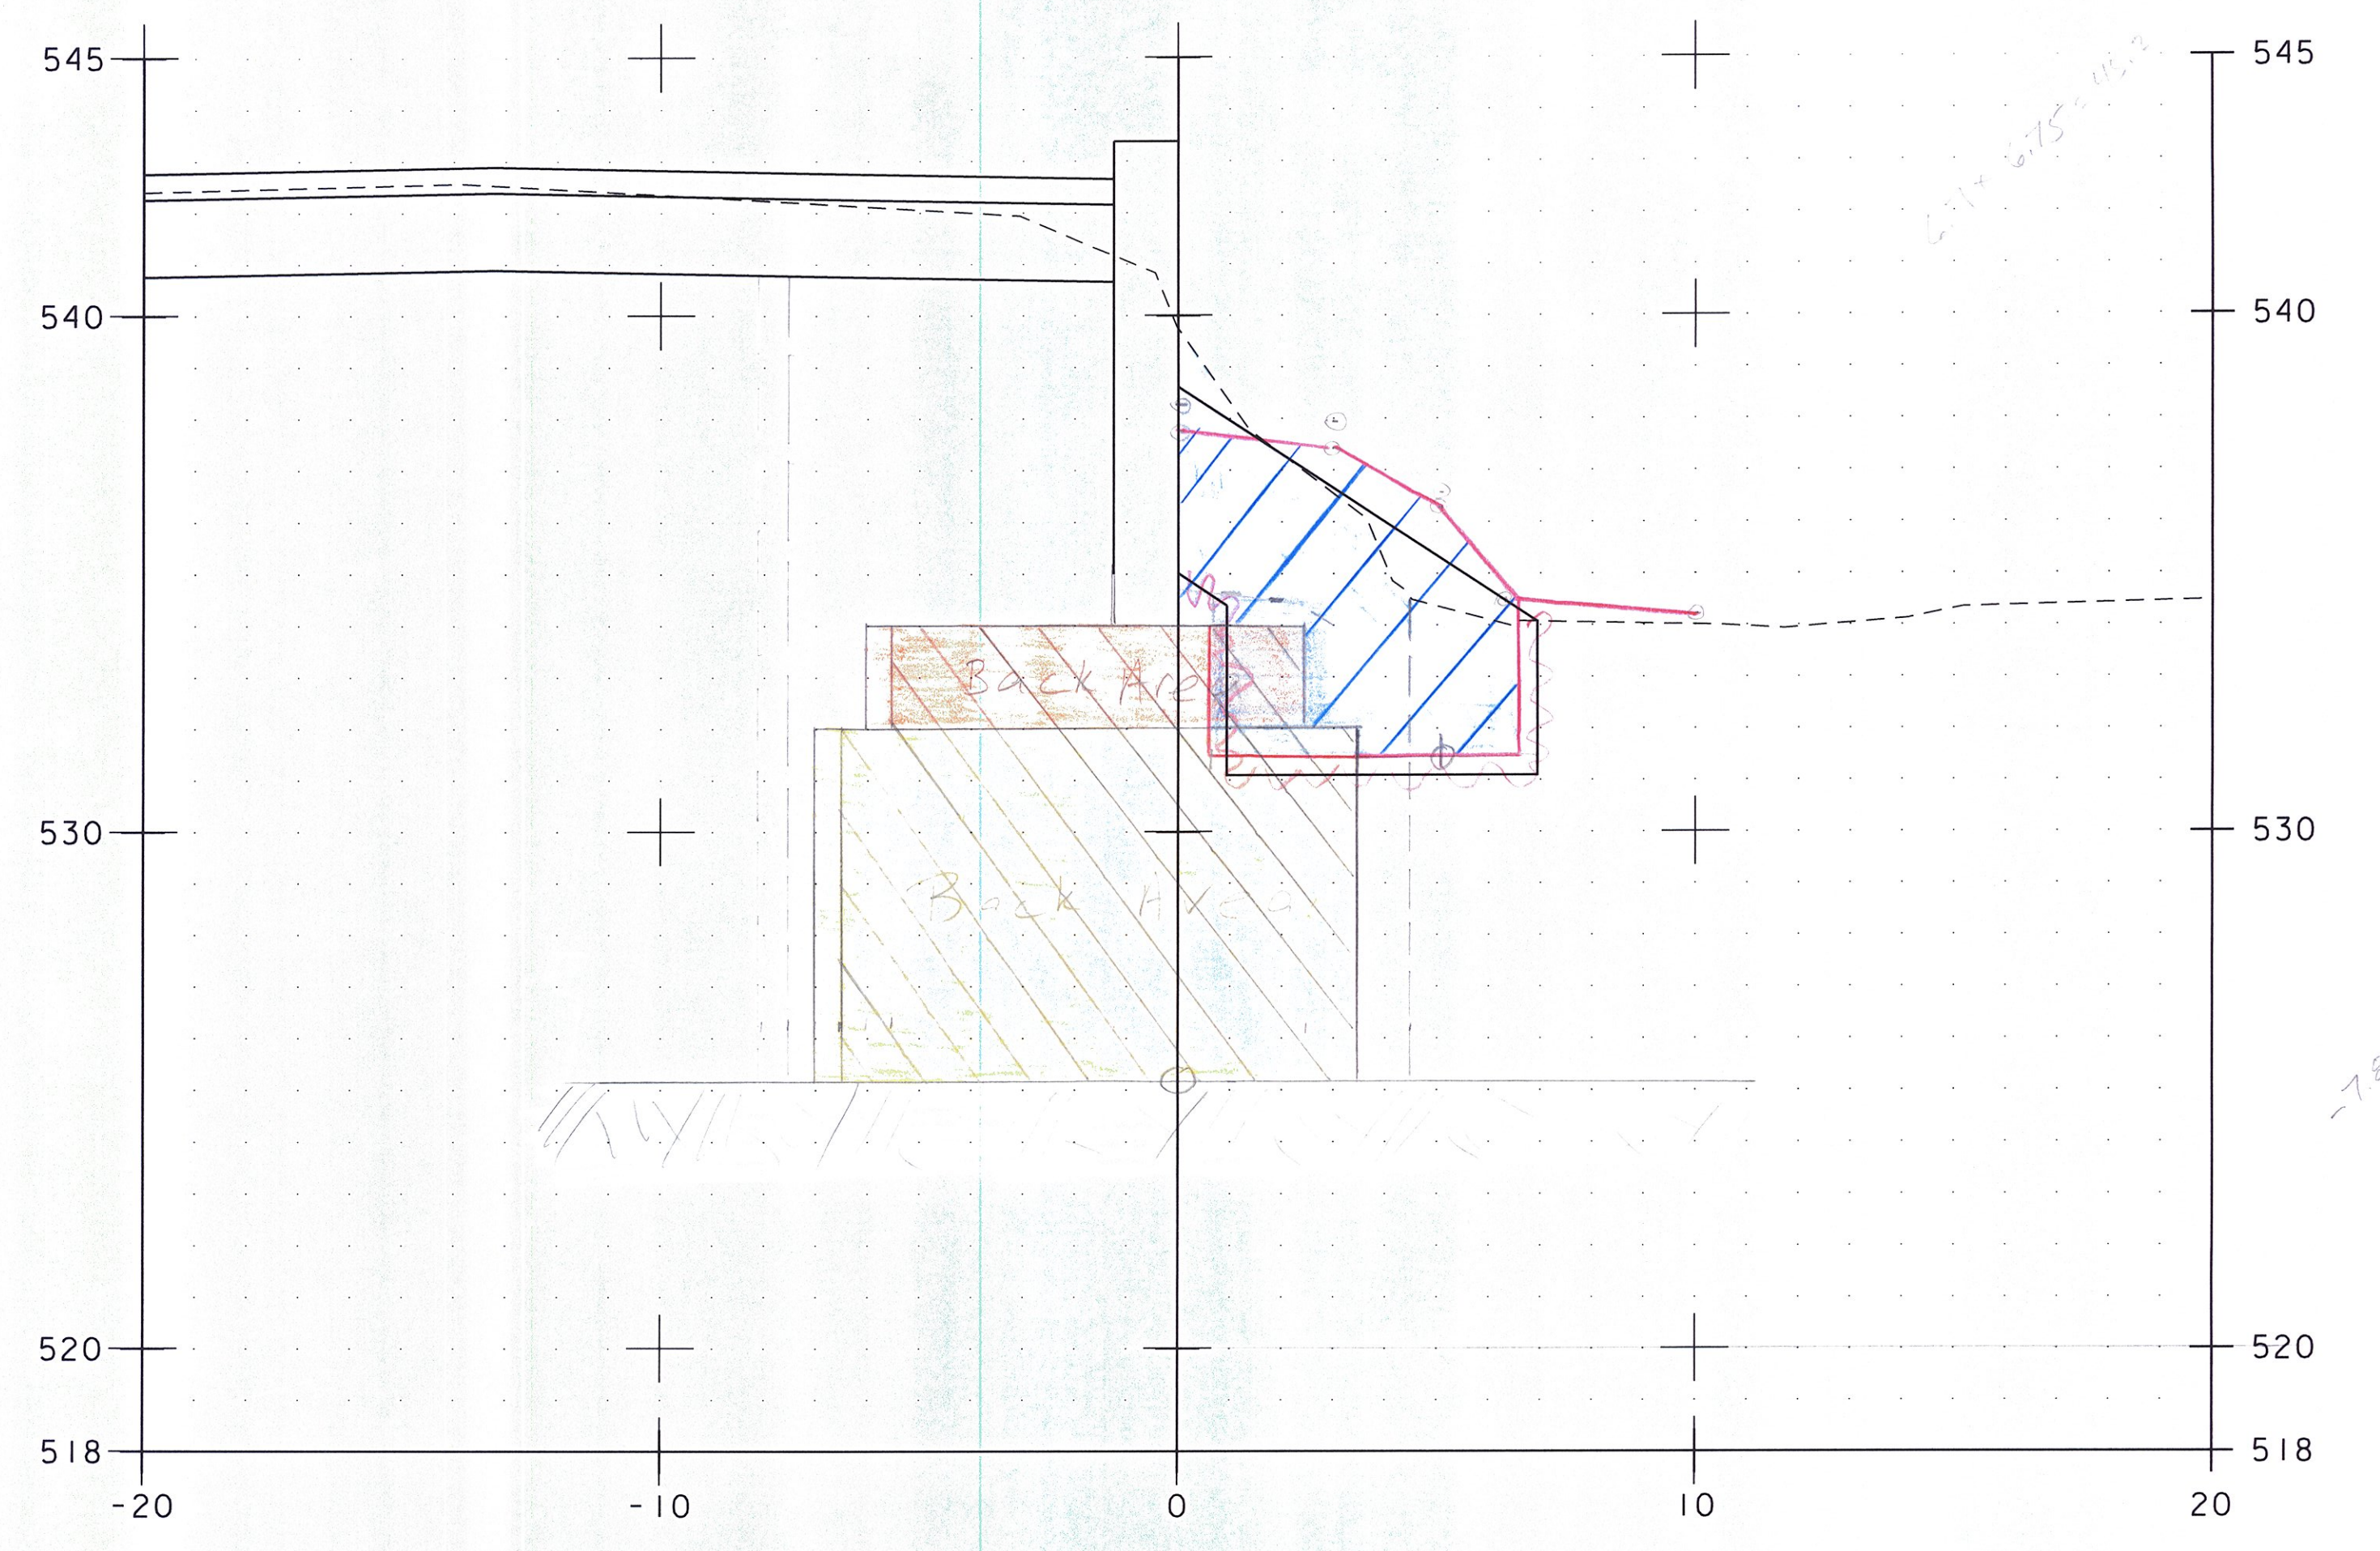

Cofferdam Earth  
 $30+00 \text{ (sh)} = 14.1 \text{ FT}^2 \checkmark$   
 $30+00 \text{ (bk)} = 33.0 \text{ FT}^2 \checkmark$   
 Granular Back fill for Structures  
 $30+00 \text{ (bk)} = 66.8 \text{ FT}^2 \checkmark$   
 $30+00 \text{ (sh)} = 62.3 \text{ FT}^2 \checkmark$   
 Unexcavated Channel Excavation  
 $30+00 = 30.0 \text{ FT}^2 \checkmark$   
 Stone Fill, type II  
 $30+00 = 23.5 \text{ FT}^2 \checkmark$   
 Geo. Under Stone Fill  
 $30+00 = 6' \checkmark$   
 PM 3/5/15

SCALE 1" = 3'-0"

NOTE: PROPOSED GRADE IS NOT SHOWN.



PROJECT NAME: BRATTLEBORO	
PROJECT NUMBER: BRO 1442(35)	
FILE NAME: z10j062_customEL.dgn	PLOT DATE: 3/2/2015
PROJECT LEADER: S.E. BURBANK	DRAWN BY: E.F. LAWES
DESIGNED BY: E.F. LAWES	CHECKED BY: S.E. BURBANK
WINGWALL NO. 3 CROSS SECTIONS (3 OF 7)	SHEET 12 OF 28



261 JCB = 23.5 FT²  
 162 STA = 23.1 FT²  
 170.5 FB = 23.5 FT²

253.66 = 18.6 FT²  
 25.1 FT²

APPROACH SLAB (TYP)

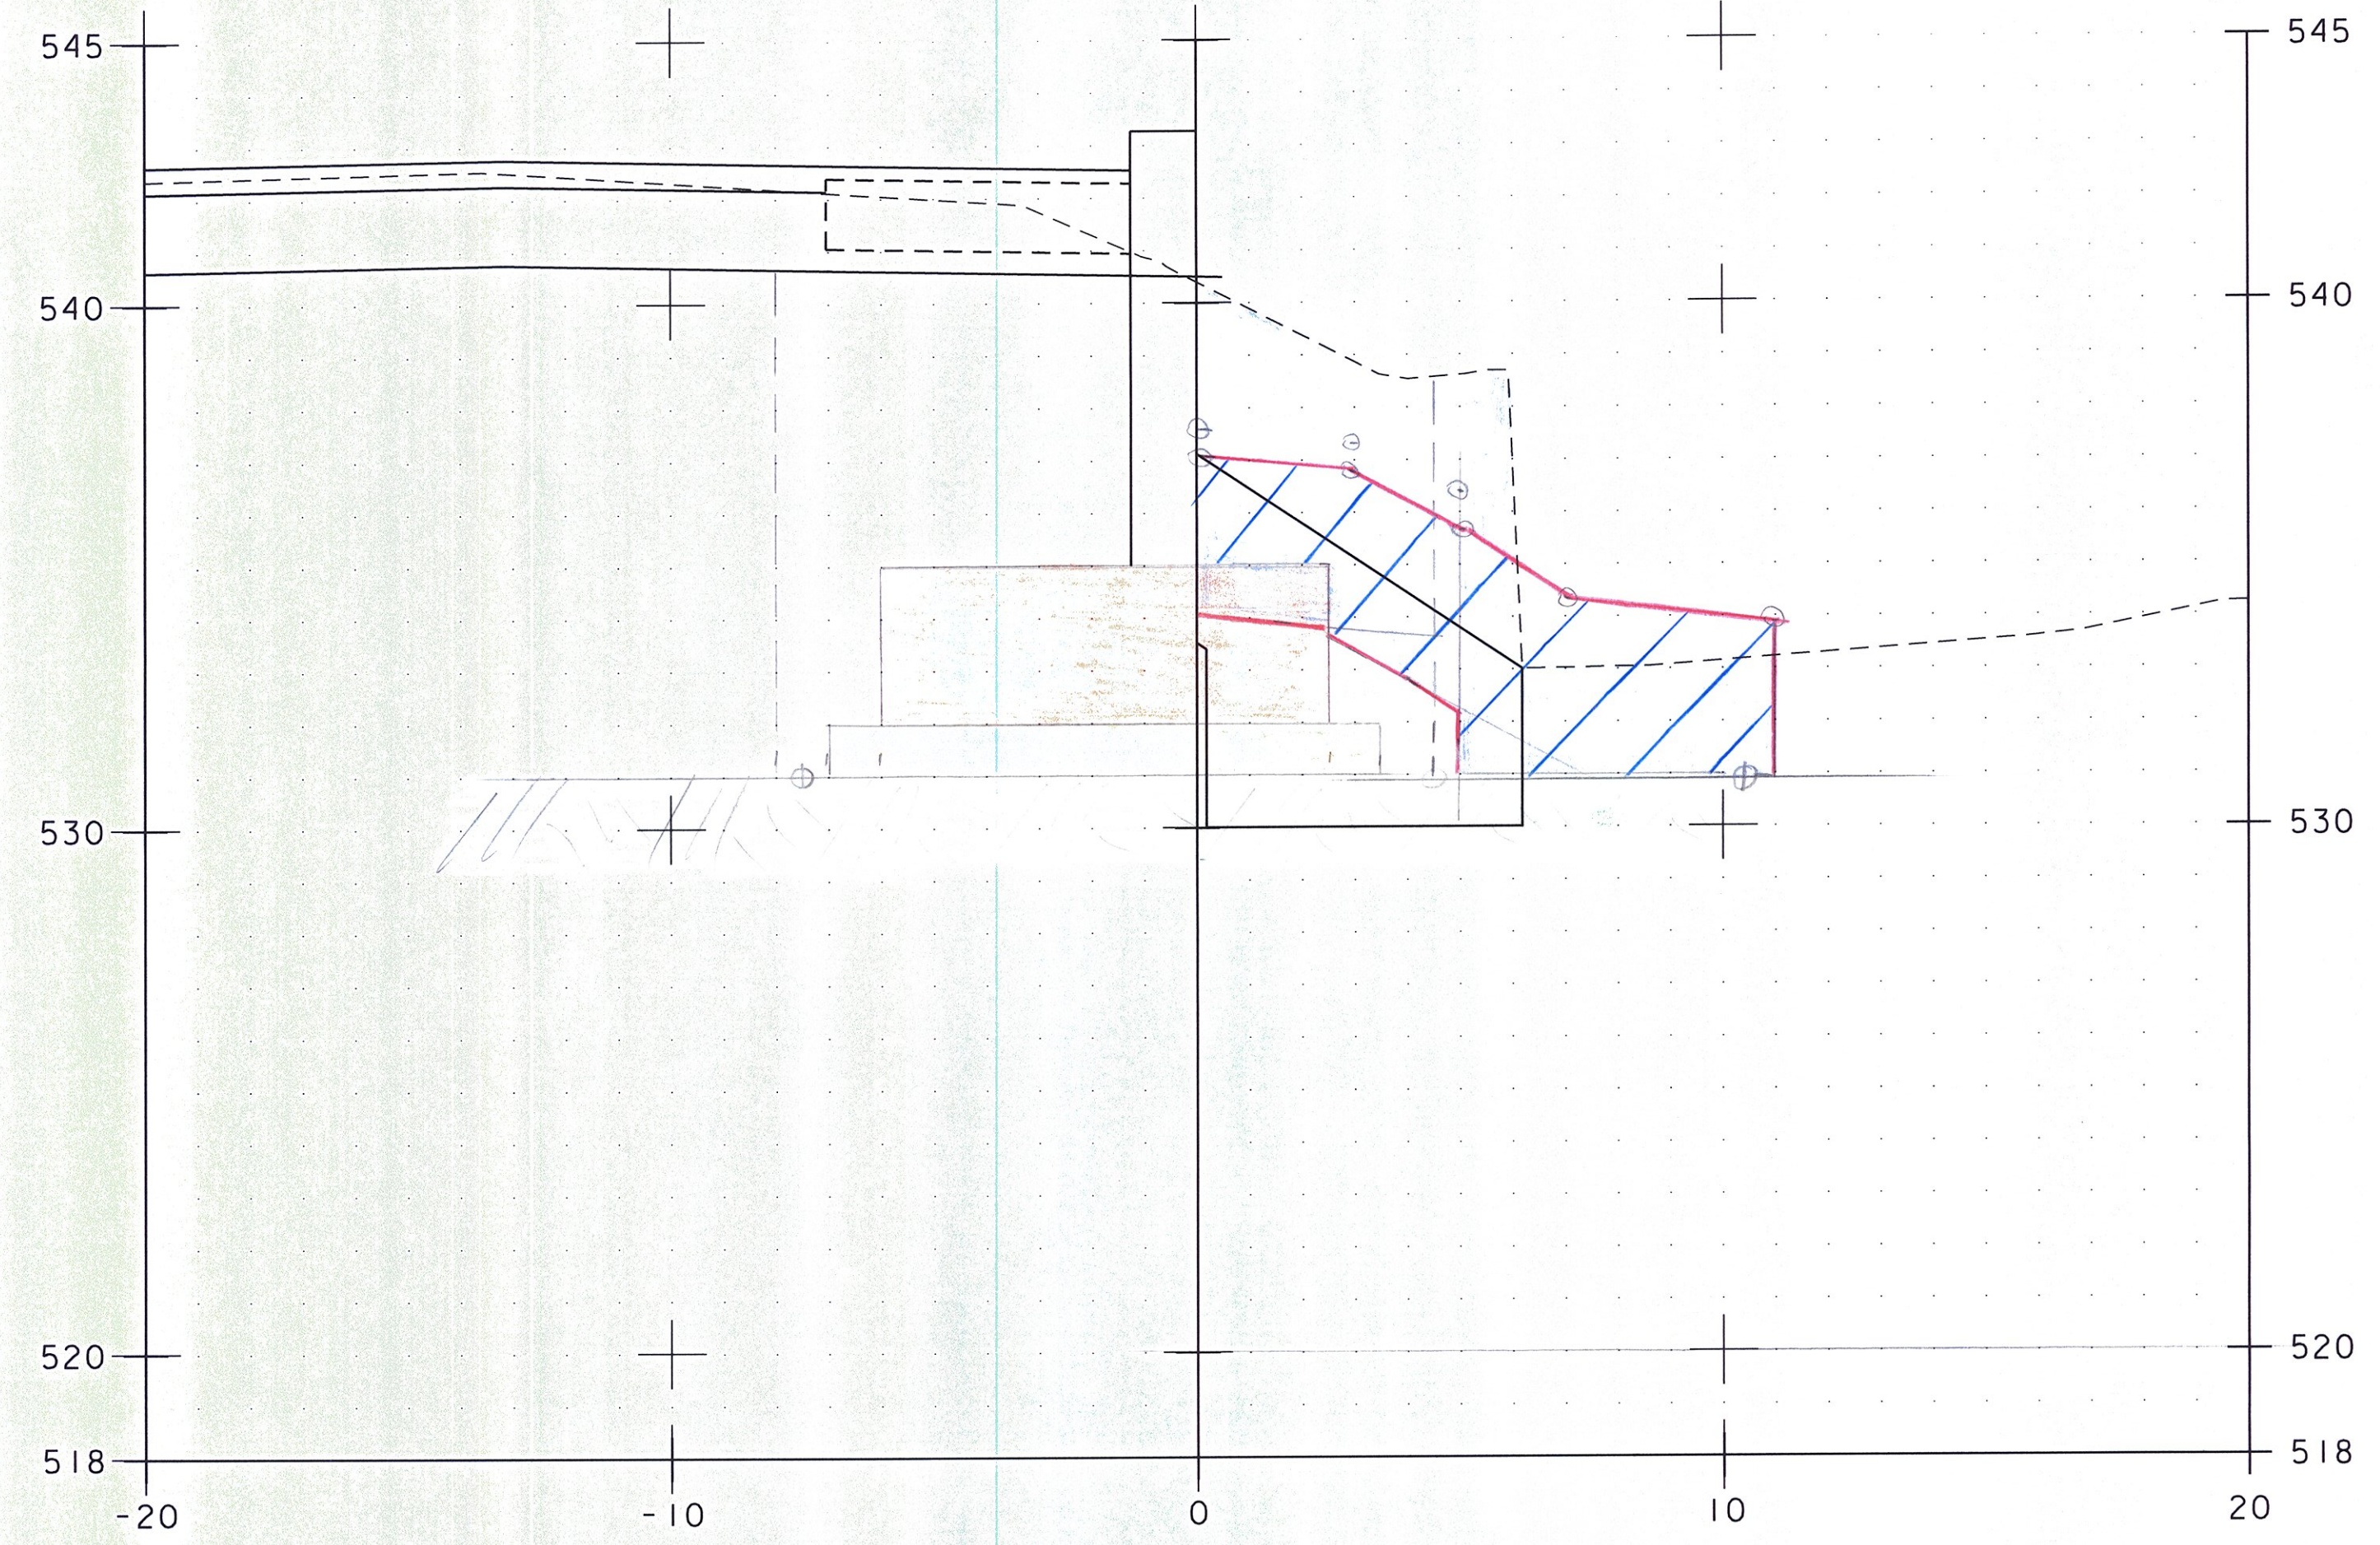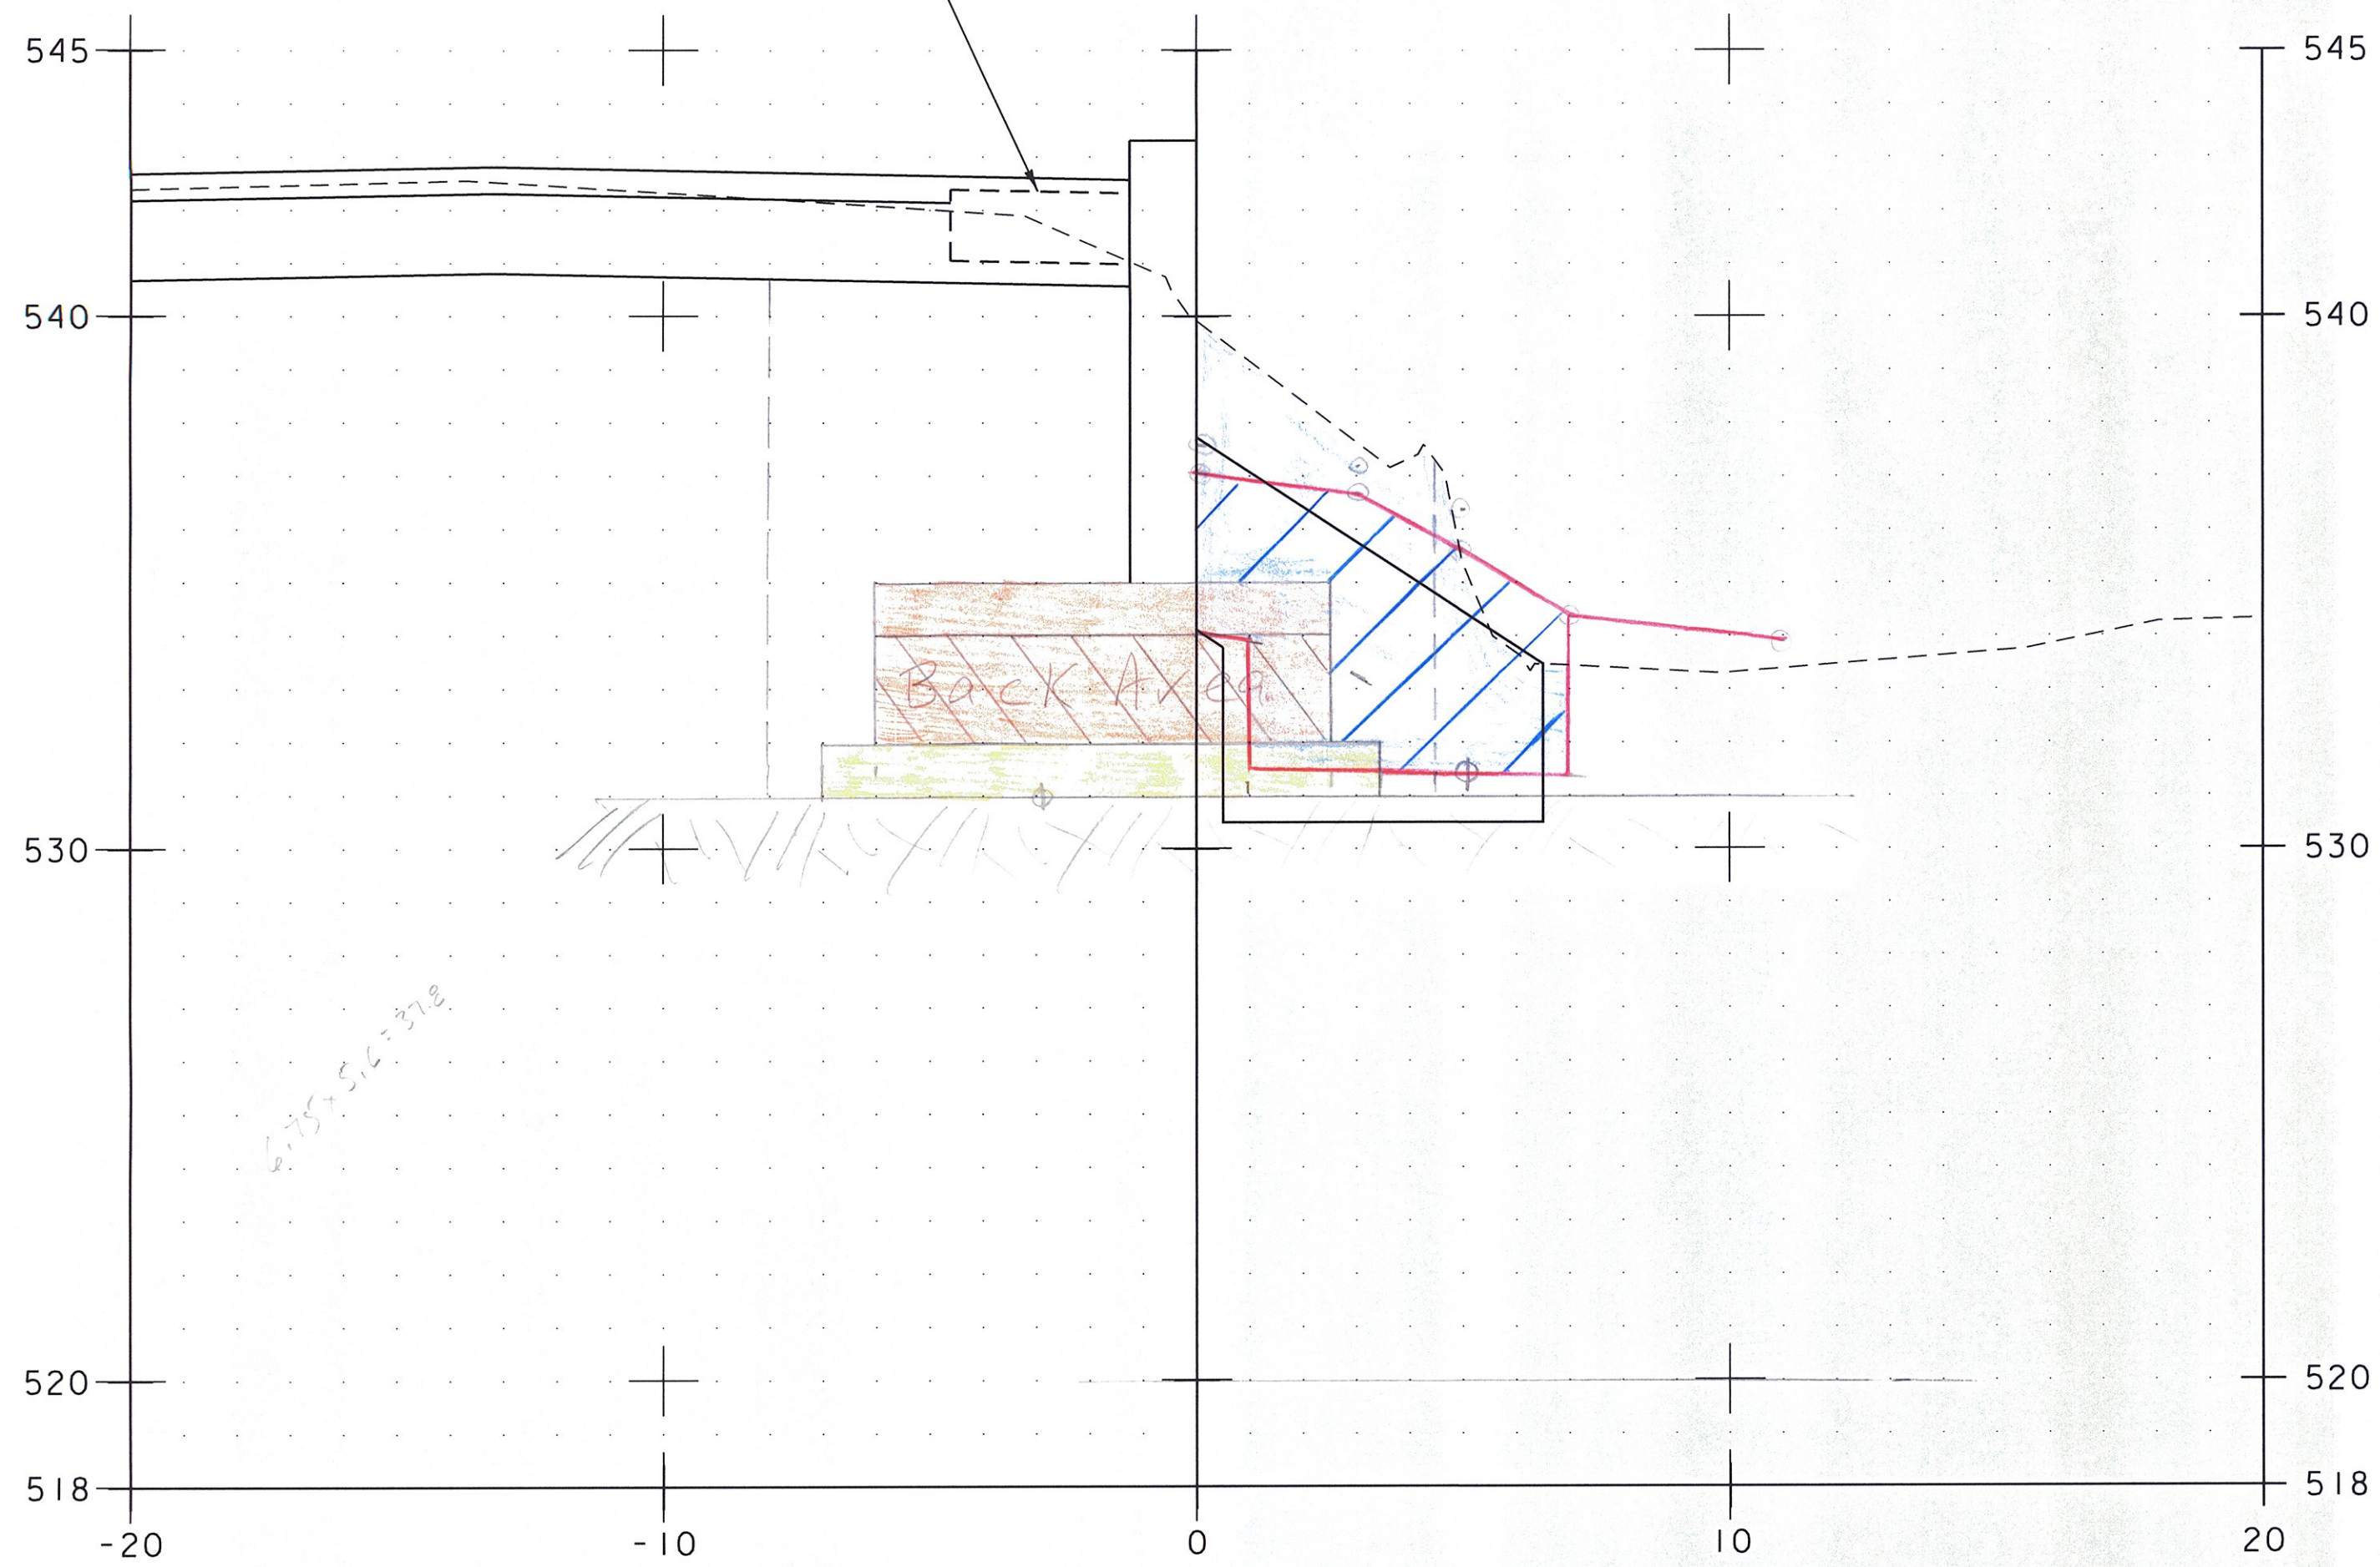

Cofferdam Earth

30+05 = 76.9 FT² ✓

Granular Backfill for Structure

30+05 (ok) = 49.6 FT² ✓

30+05 (ok) 44.8 FT² ✓

Unclass. fill Channel Excavation

30+05 = 25.9 FT² ✓

2 Stone Fill, type III

30+05 (ok) = 23.5 FT² ✓ *25.1 FT² / fu = 7.23 15*

(ok) = 23.1 FT² ✓

Area Under Stone Fill

30+05 = 16' ✓

*fu slips*

30+05.00 back & ahead

use final x-section 30+06

Cofferdam Earth

30+07.5 = 58.5 FT² ✓

Granular Backfill for Structure

30+07.5 = 18.6 FT² ✓

Unclass. fill Channel Excavation

30+07.5 = 10.0 FT² ✓

Stone Fill, type I

30+07.5 = 10.0 FT² ✓

Geo. Under Stone Fill

30+07.5 = 19' ✓

30+07.50

use final x-section 30+06

NOTE: PROPOSED GRADE IS NOT SHOWN.

PROJECT NAME: BRATTLEBORO

PROJECT NUMBER: BRO 1442(35)

FILE NAME: z10j062_customEL.dgn

PROJECT LEADER: S.E. BURBANK

DESIGNED BY: E.F. LAWES

WINGWALL NO. 3 CROSS SECTIONS (4 OF 7)

PLOT DATE: 3/2/2015

DRAWN BY: E.F. LAWES

CHECKED BY: S.E. BURBANK



SHEET 13 OF 28

SCALE 1" = 3'-0"



245000 = 33.7 FT²  
17950 = 17.7 FT²

130000 = 13.4 FT²  
5000 = 7.3 FT²

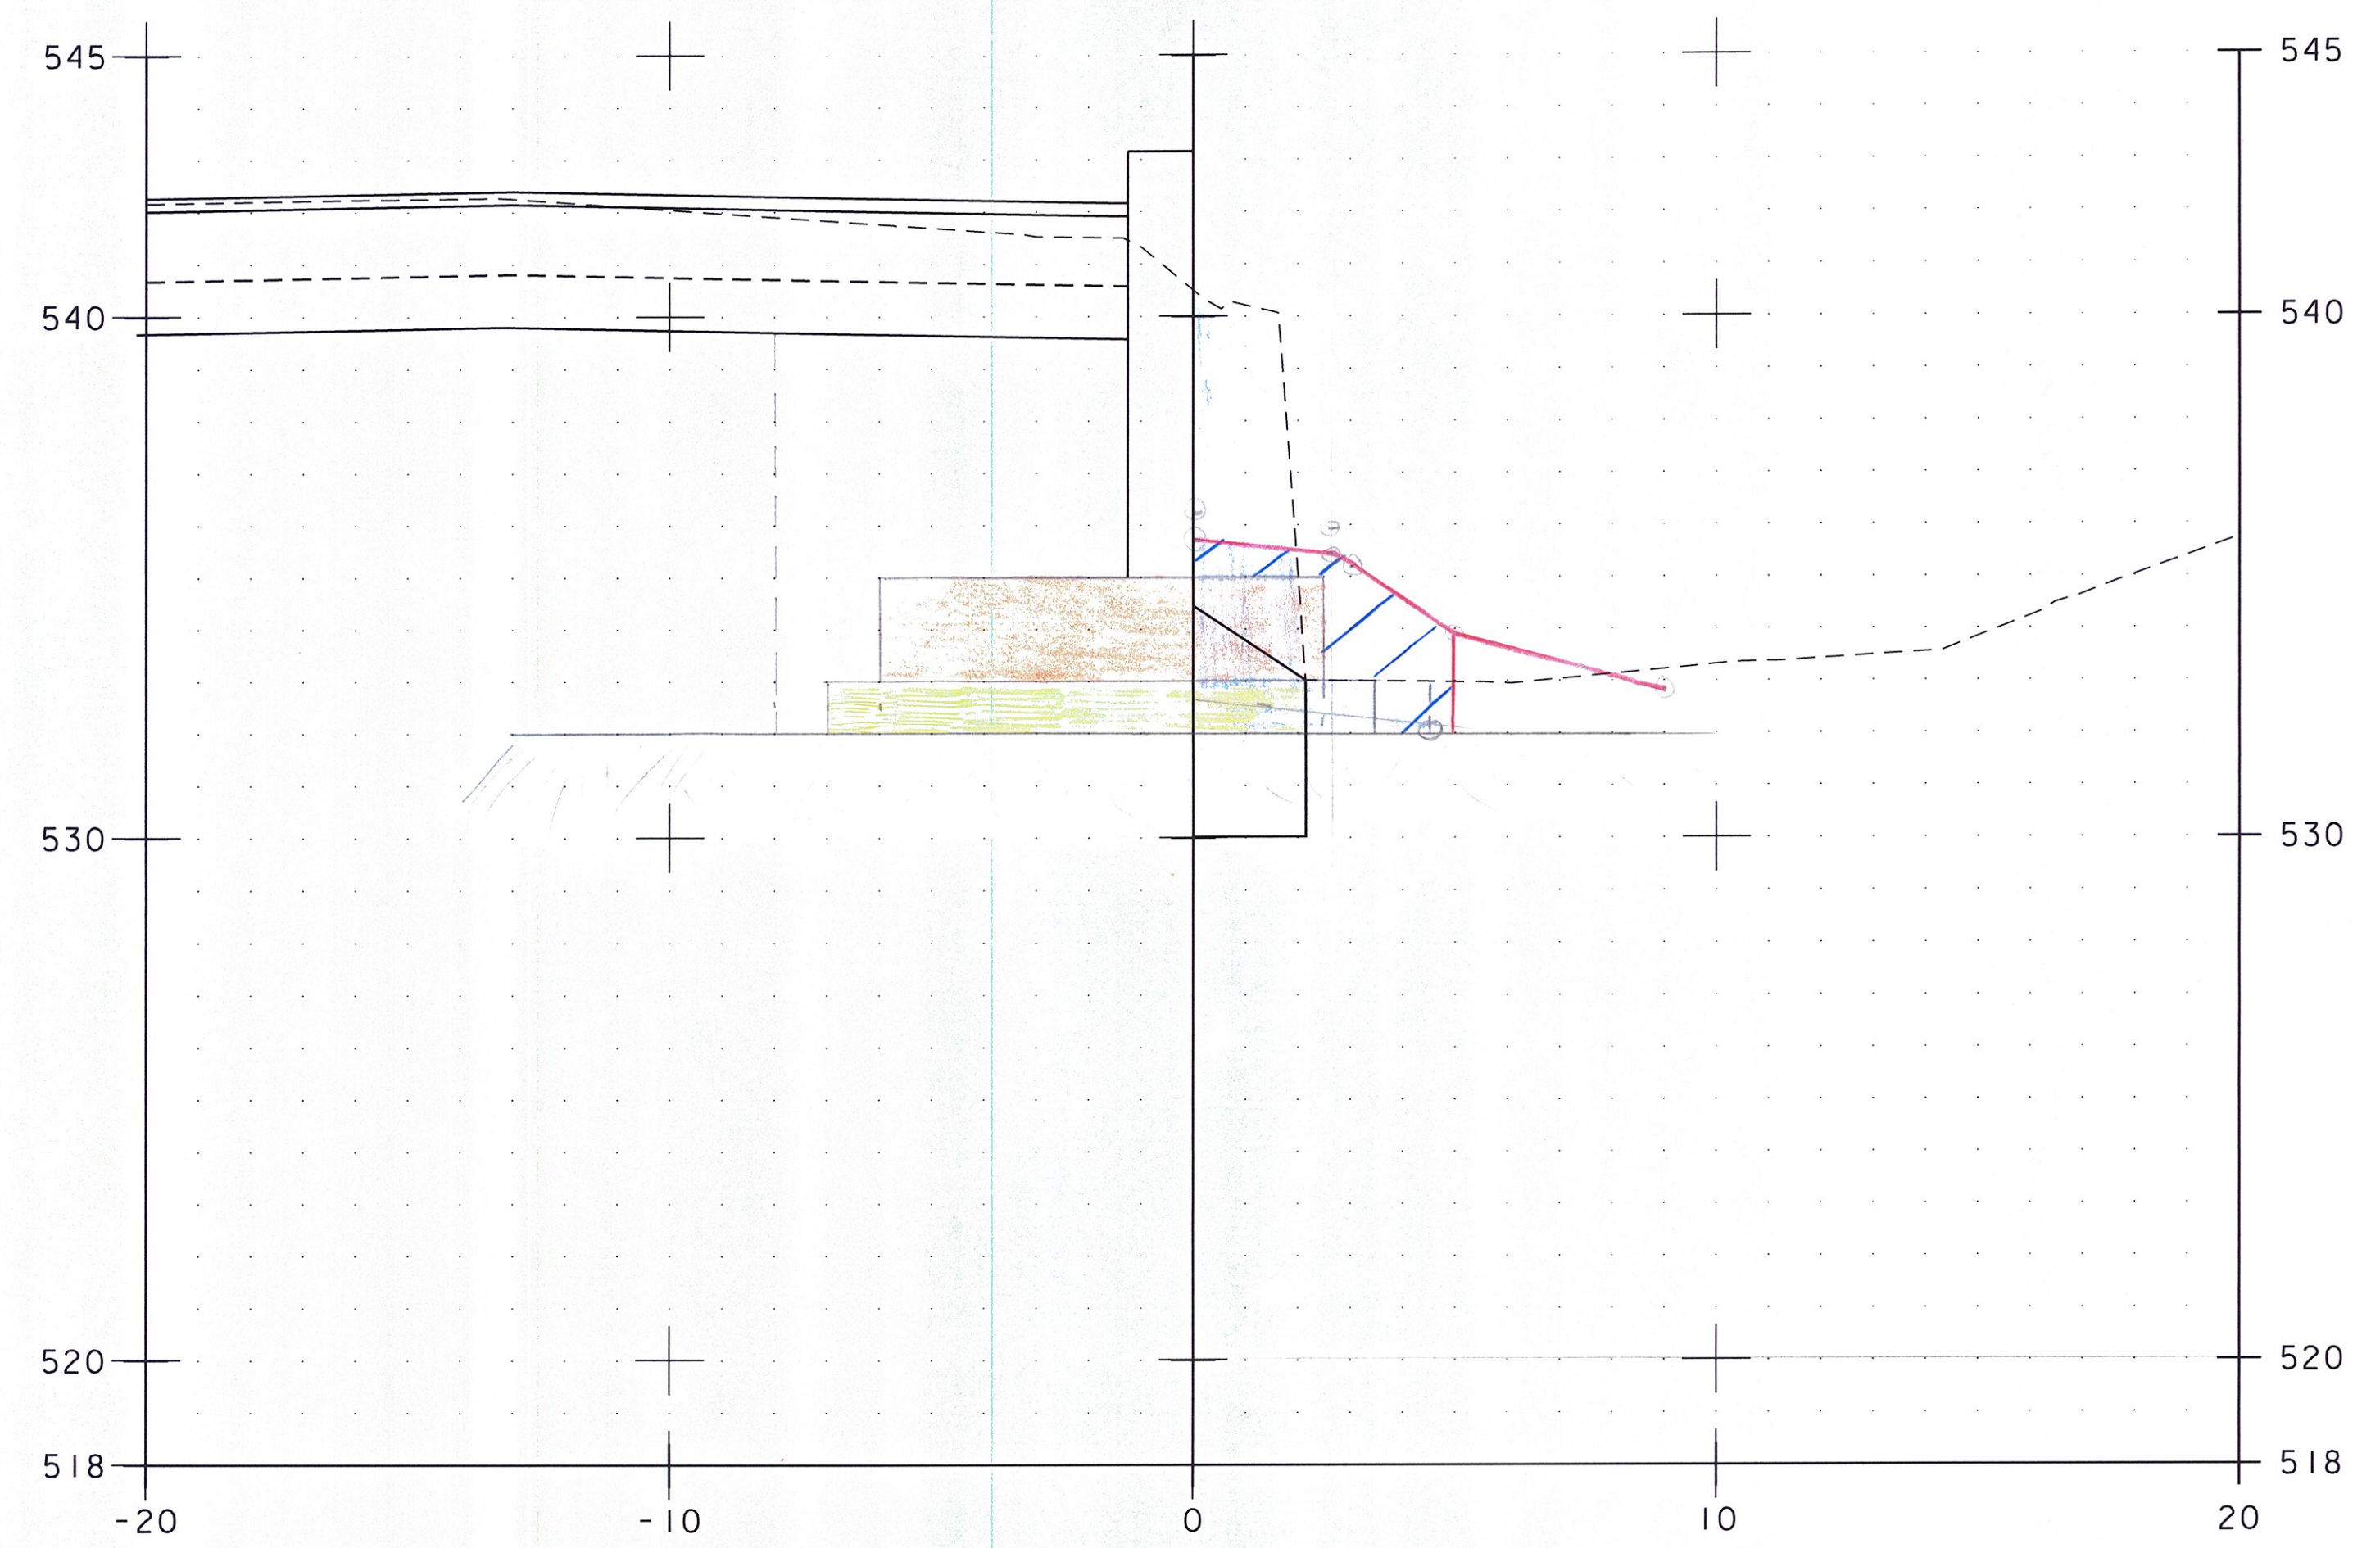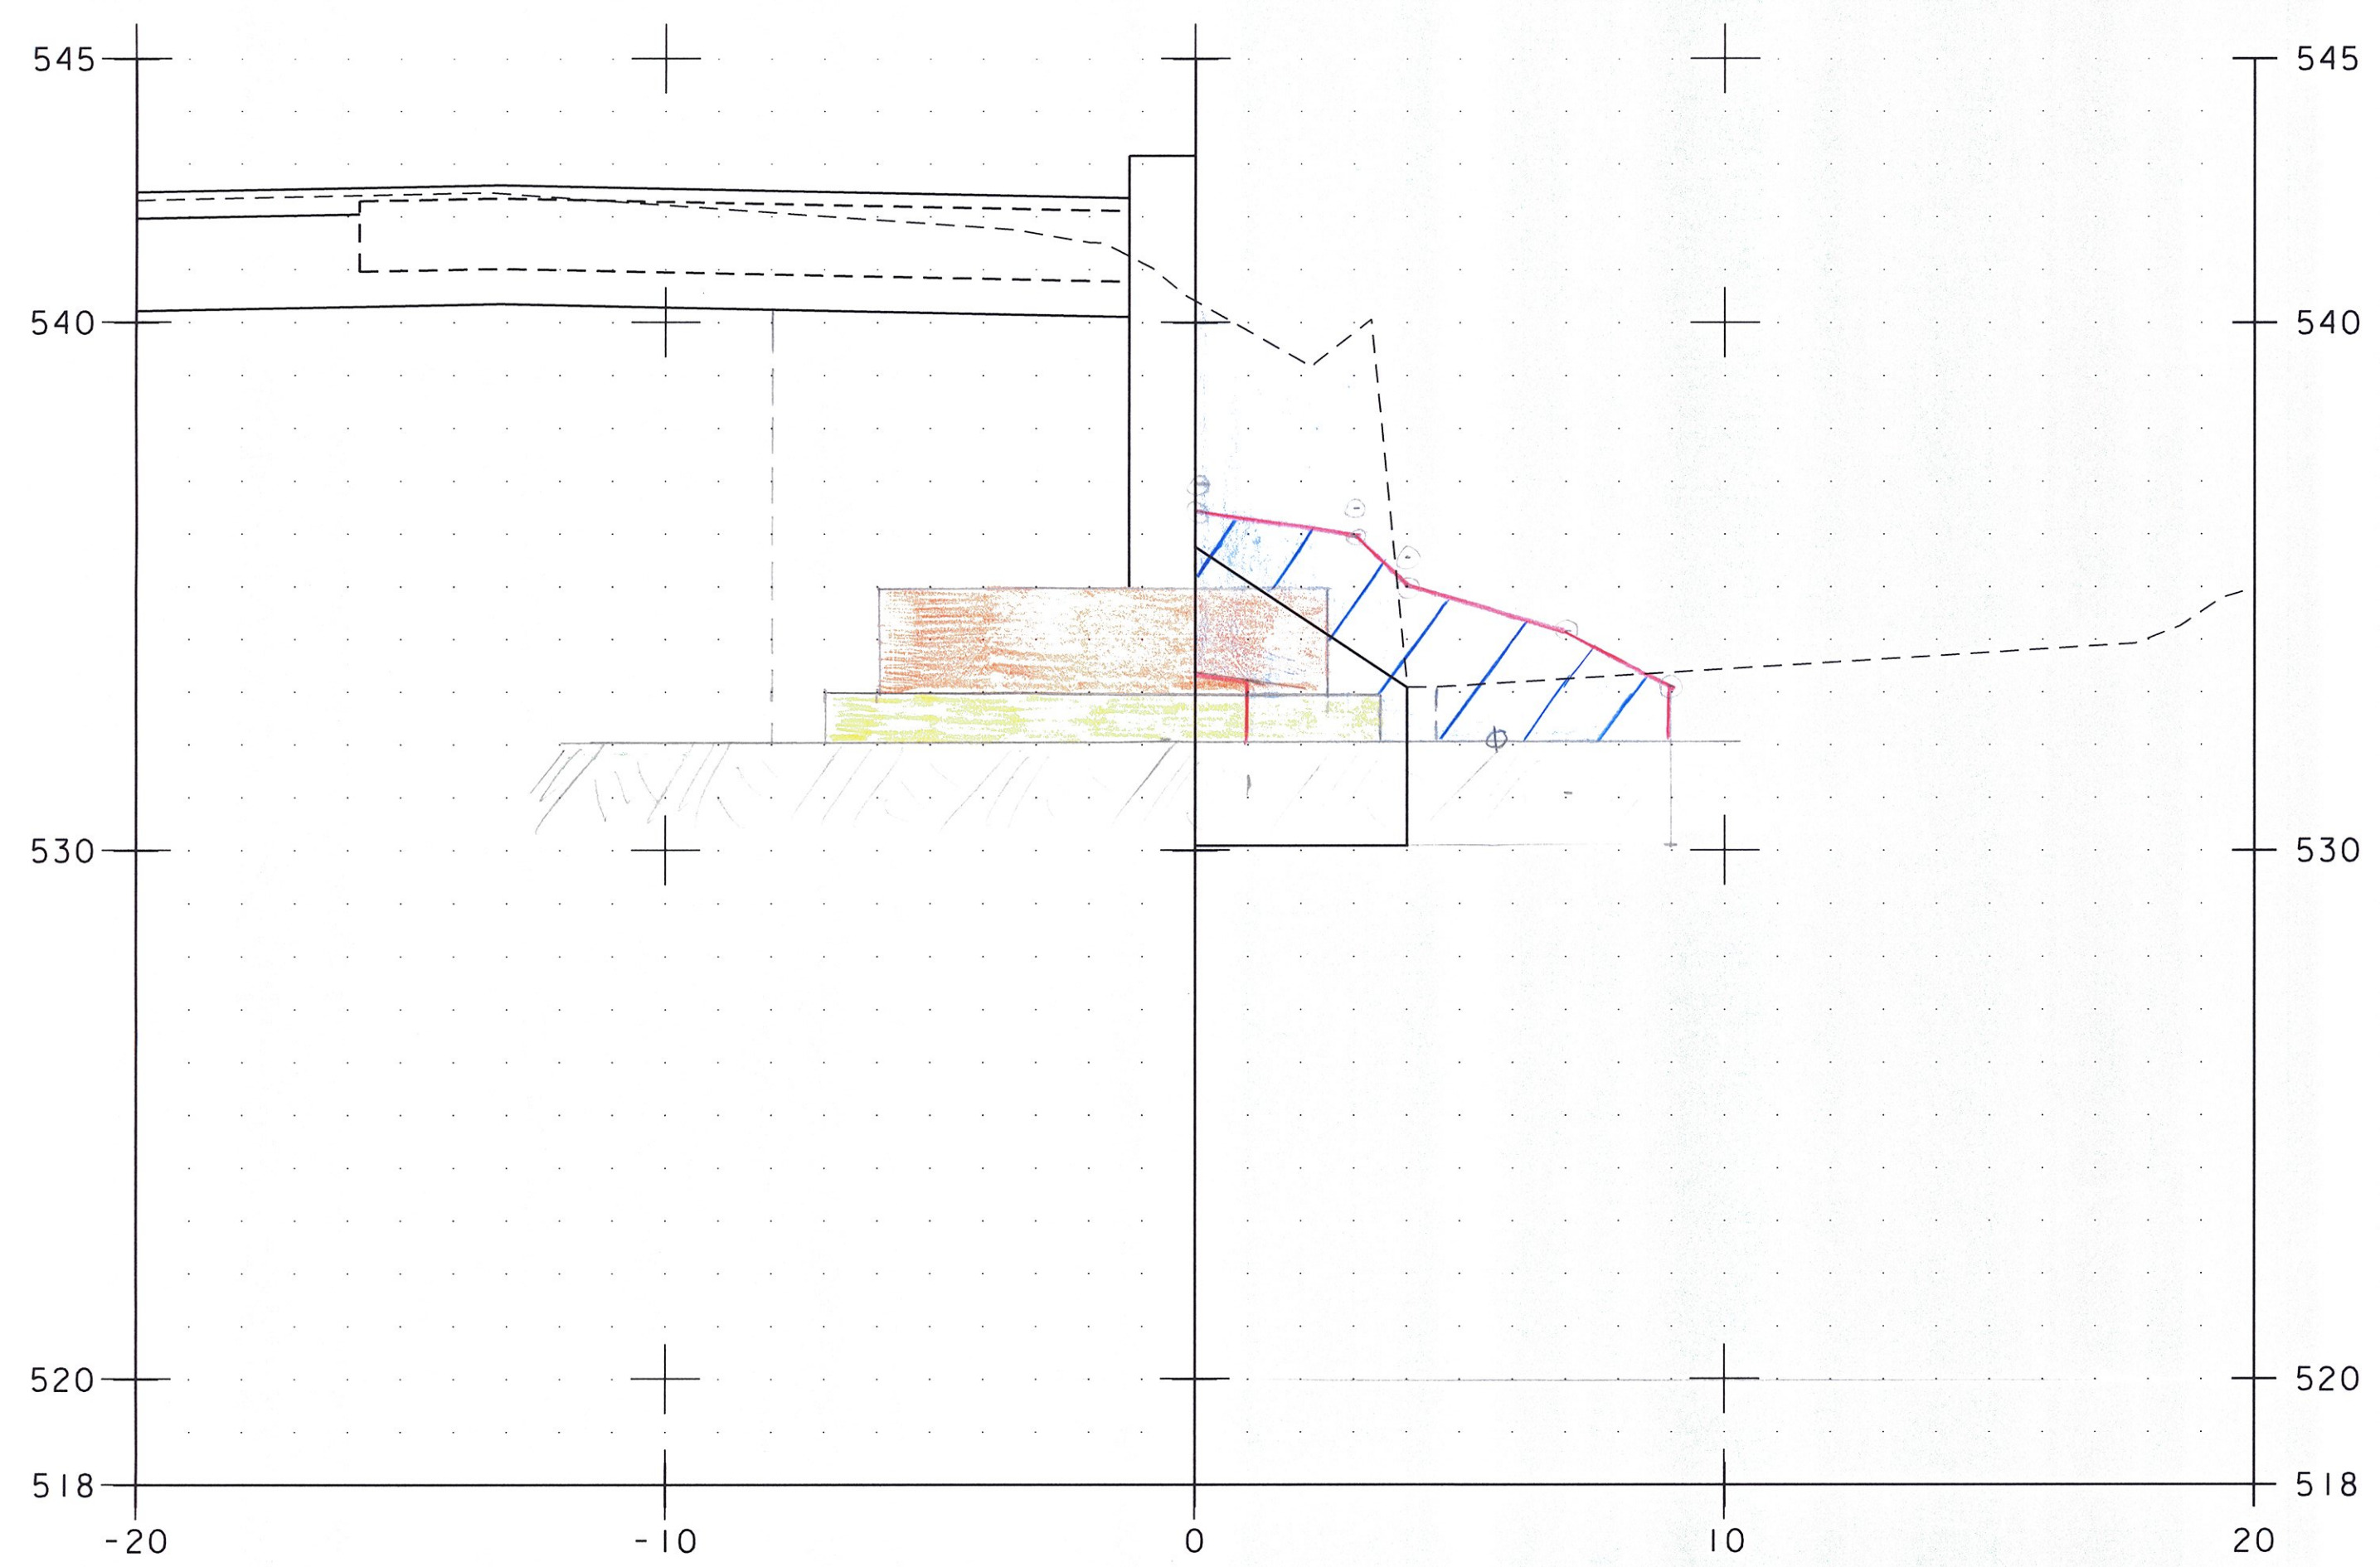

Collected Earth  
30+16.5 = 66.3 FT² ✓  
Granular Backfill for Structures  
30+16.5 = 40.1 FT² ✓  
Unclassified Channel Excavation  
30+16.5 = 33.7 FT² ✓  
Stone Fill, type II  
30+16.5 = 17.7 FT² ✓  
Geo. Under Stone Fill  
30+16.5 = 13.5 FT² ✓  
for 5/5/15

30+16.50

Collected Earth  
30+26 = 62.2 FT² ✓  
Granular Backfill for Structures  
30+26 = 36.7 FT² ✓  
Unclassified Channel Excavation  
30+26 = 13.4 FT² ✓  
Stone Fill, type II  
30+26 = 7.3 FT² ✓  
Geo. Under Stone Fill  
30+26 = 11 FT² ✓  
for 5/5/15

30+26.00

NOTE: PROPOSED GRADE IS NOT SHOWN.



PROJECT NAME: BRATTLEBORO	
PROJECT NUMBER: BRO 1442(35)	
FILE NAME: z10j062.customEL.dgn	PLOT DATE: 3/2/2015
PROJECT LEADER: S.E. BURBANK	DRAWN BY: E.F. LAWES
DESIGNED BY: E.F. LAWES	CHECKED BY: S.E. BURBANK
WINGWALL NO. 3 CROSS SECTIONS (5 OF 7)	SHEET 14 OF 28



SCALE 1" = 3'-0"

12,000 = 8.7 FT²  
62.58 = 2.5 FT²

155,000 = 11.8 FT²  
73.91 = 10.0 FT²

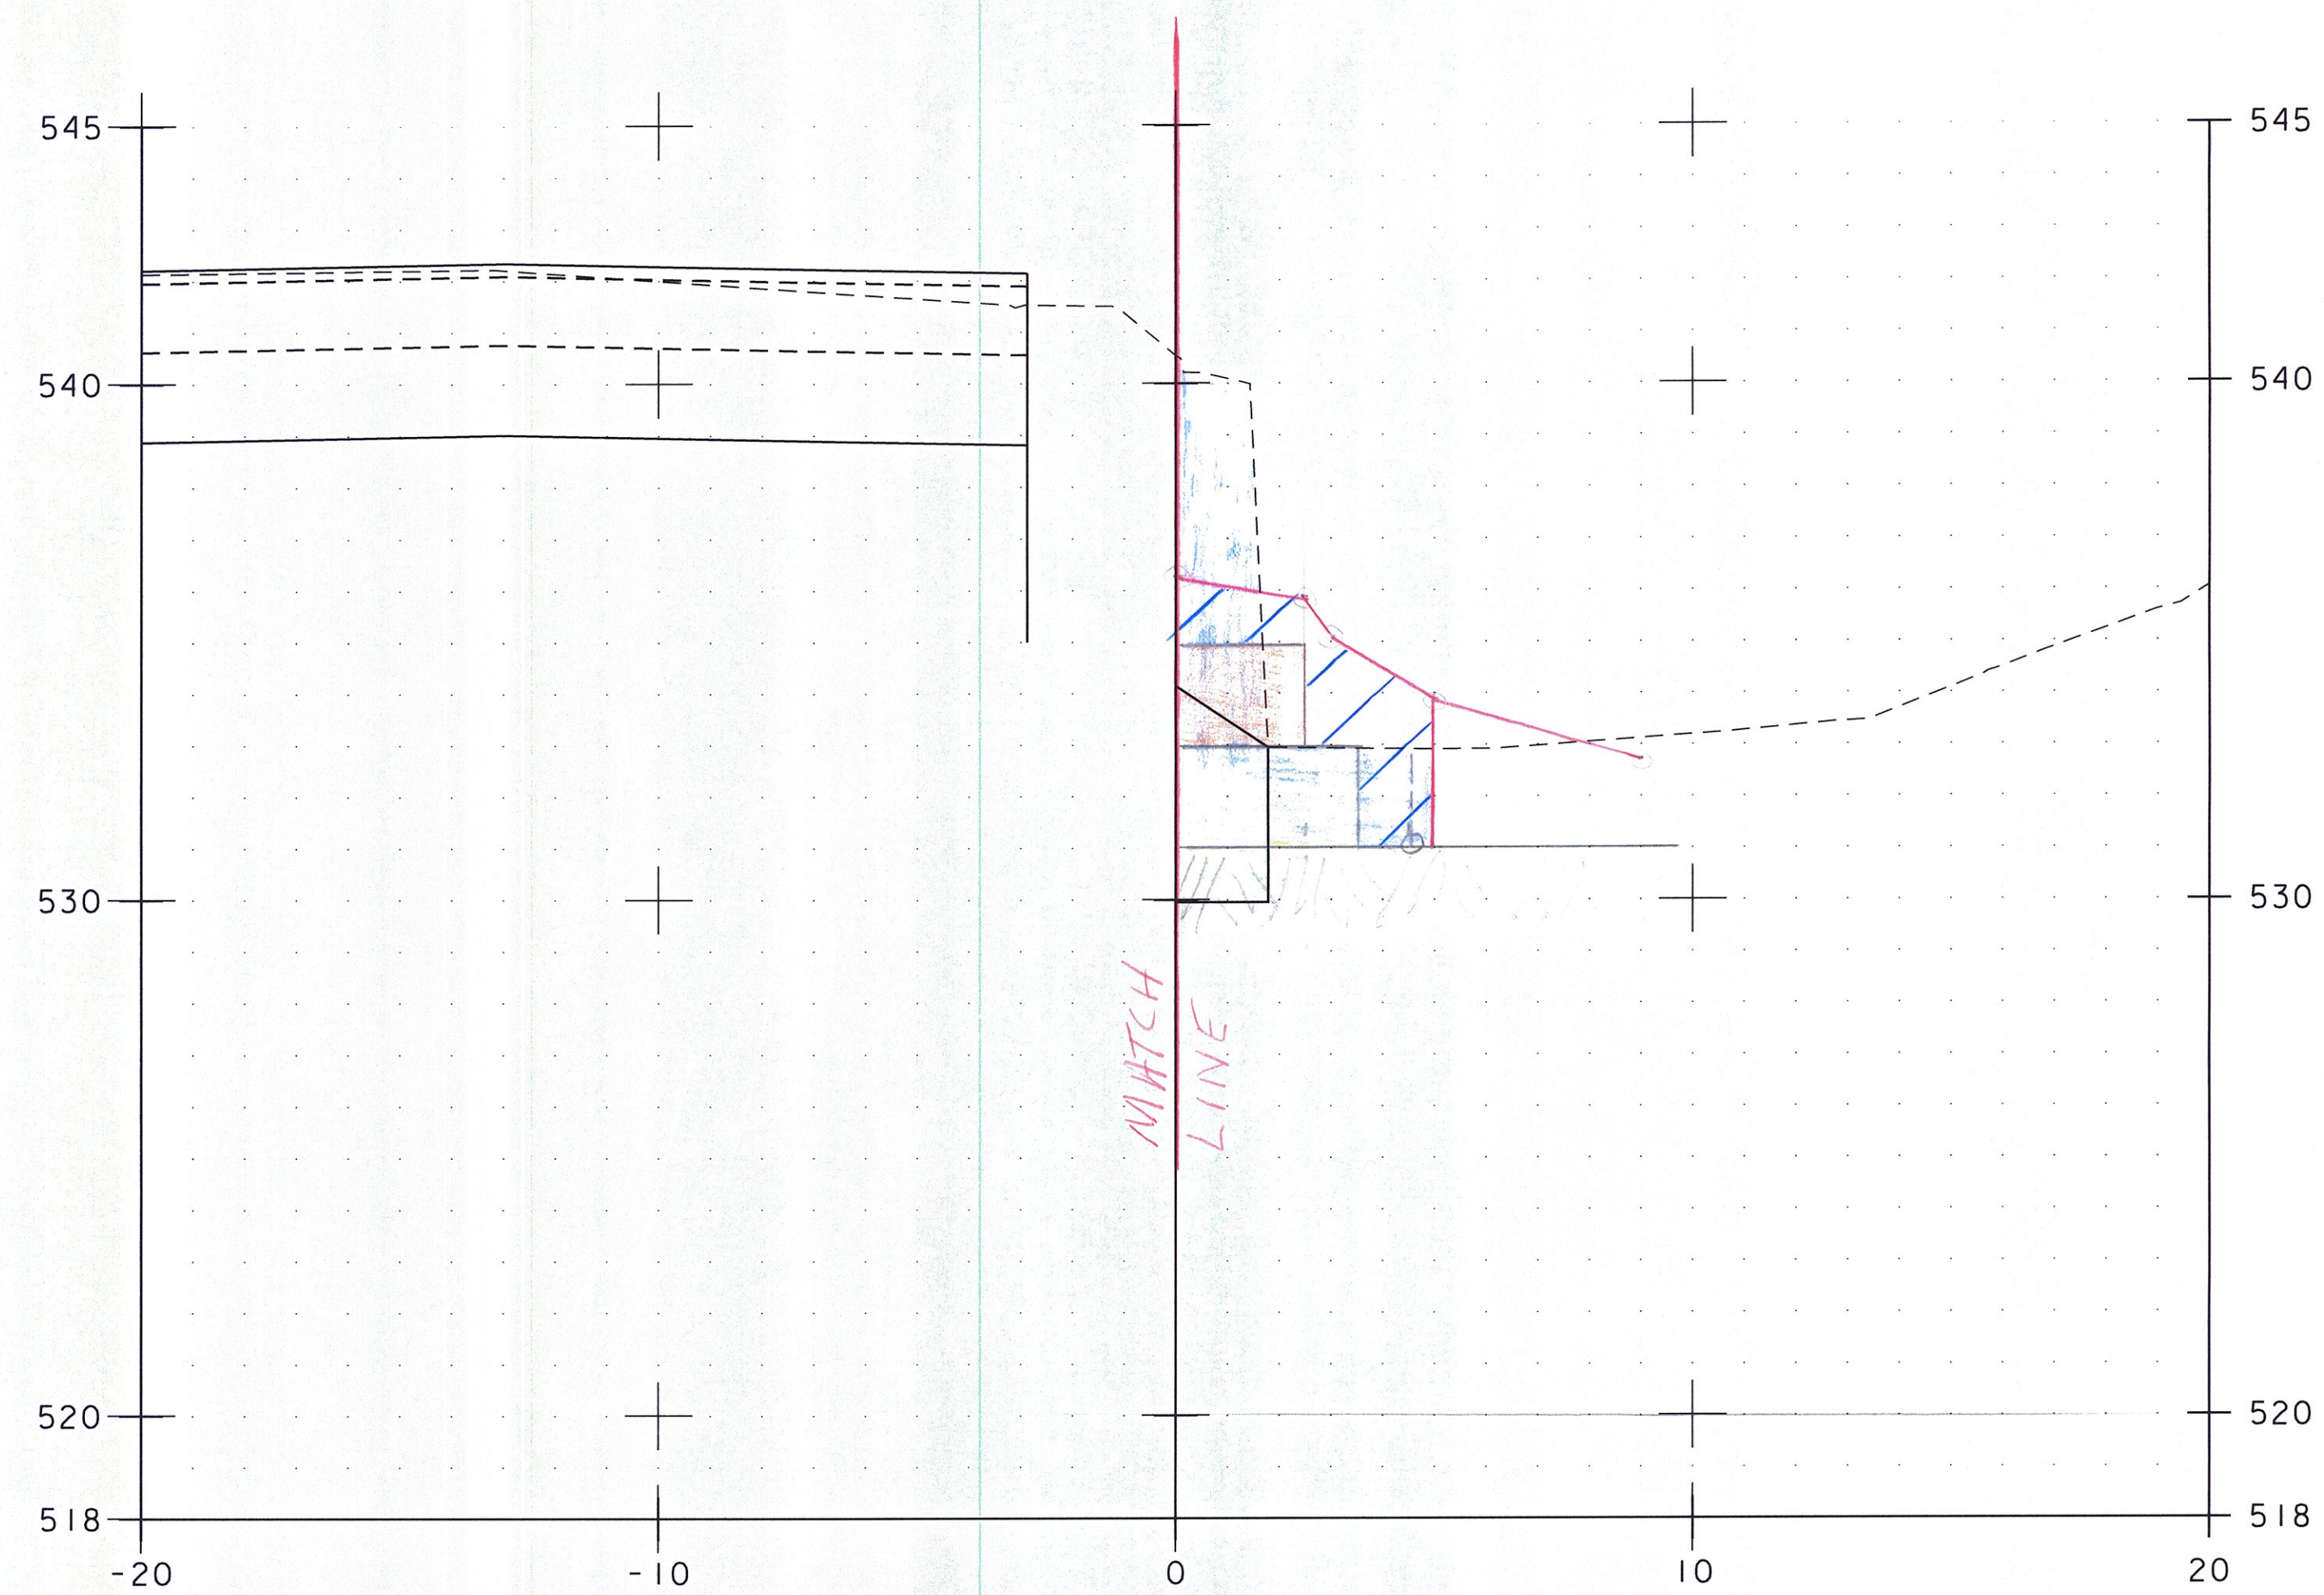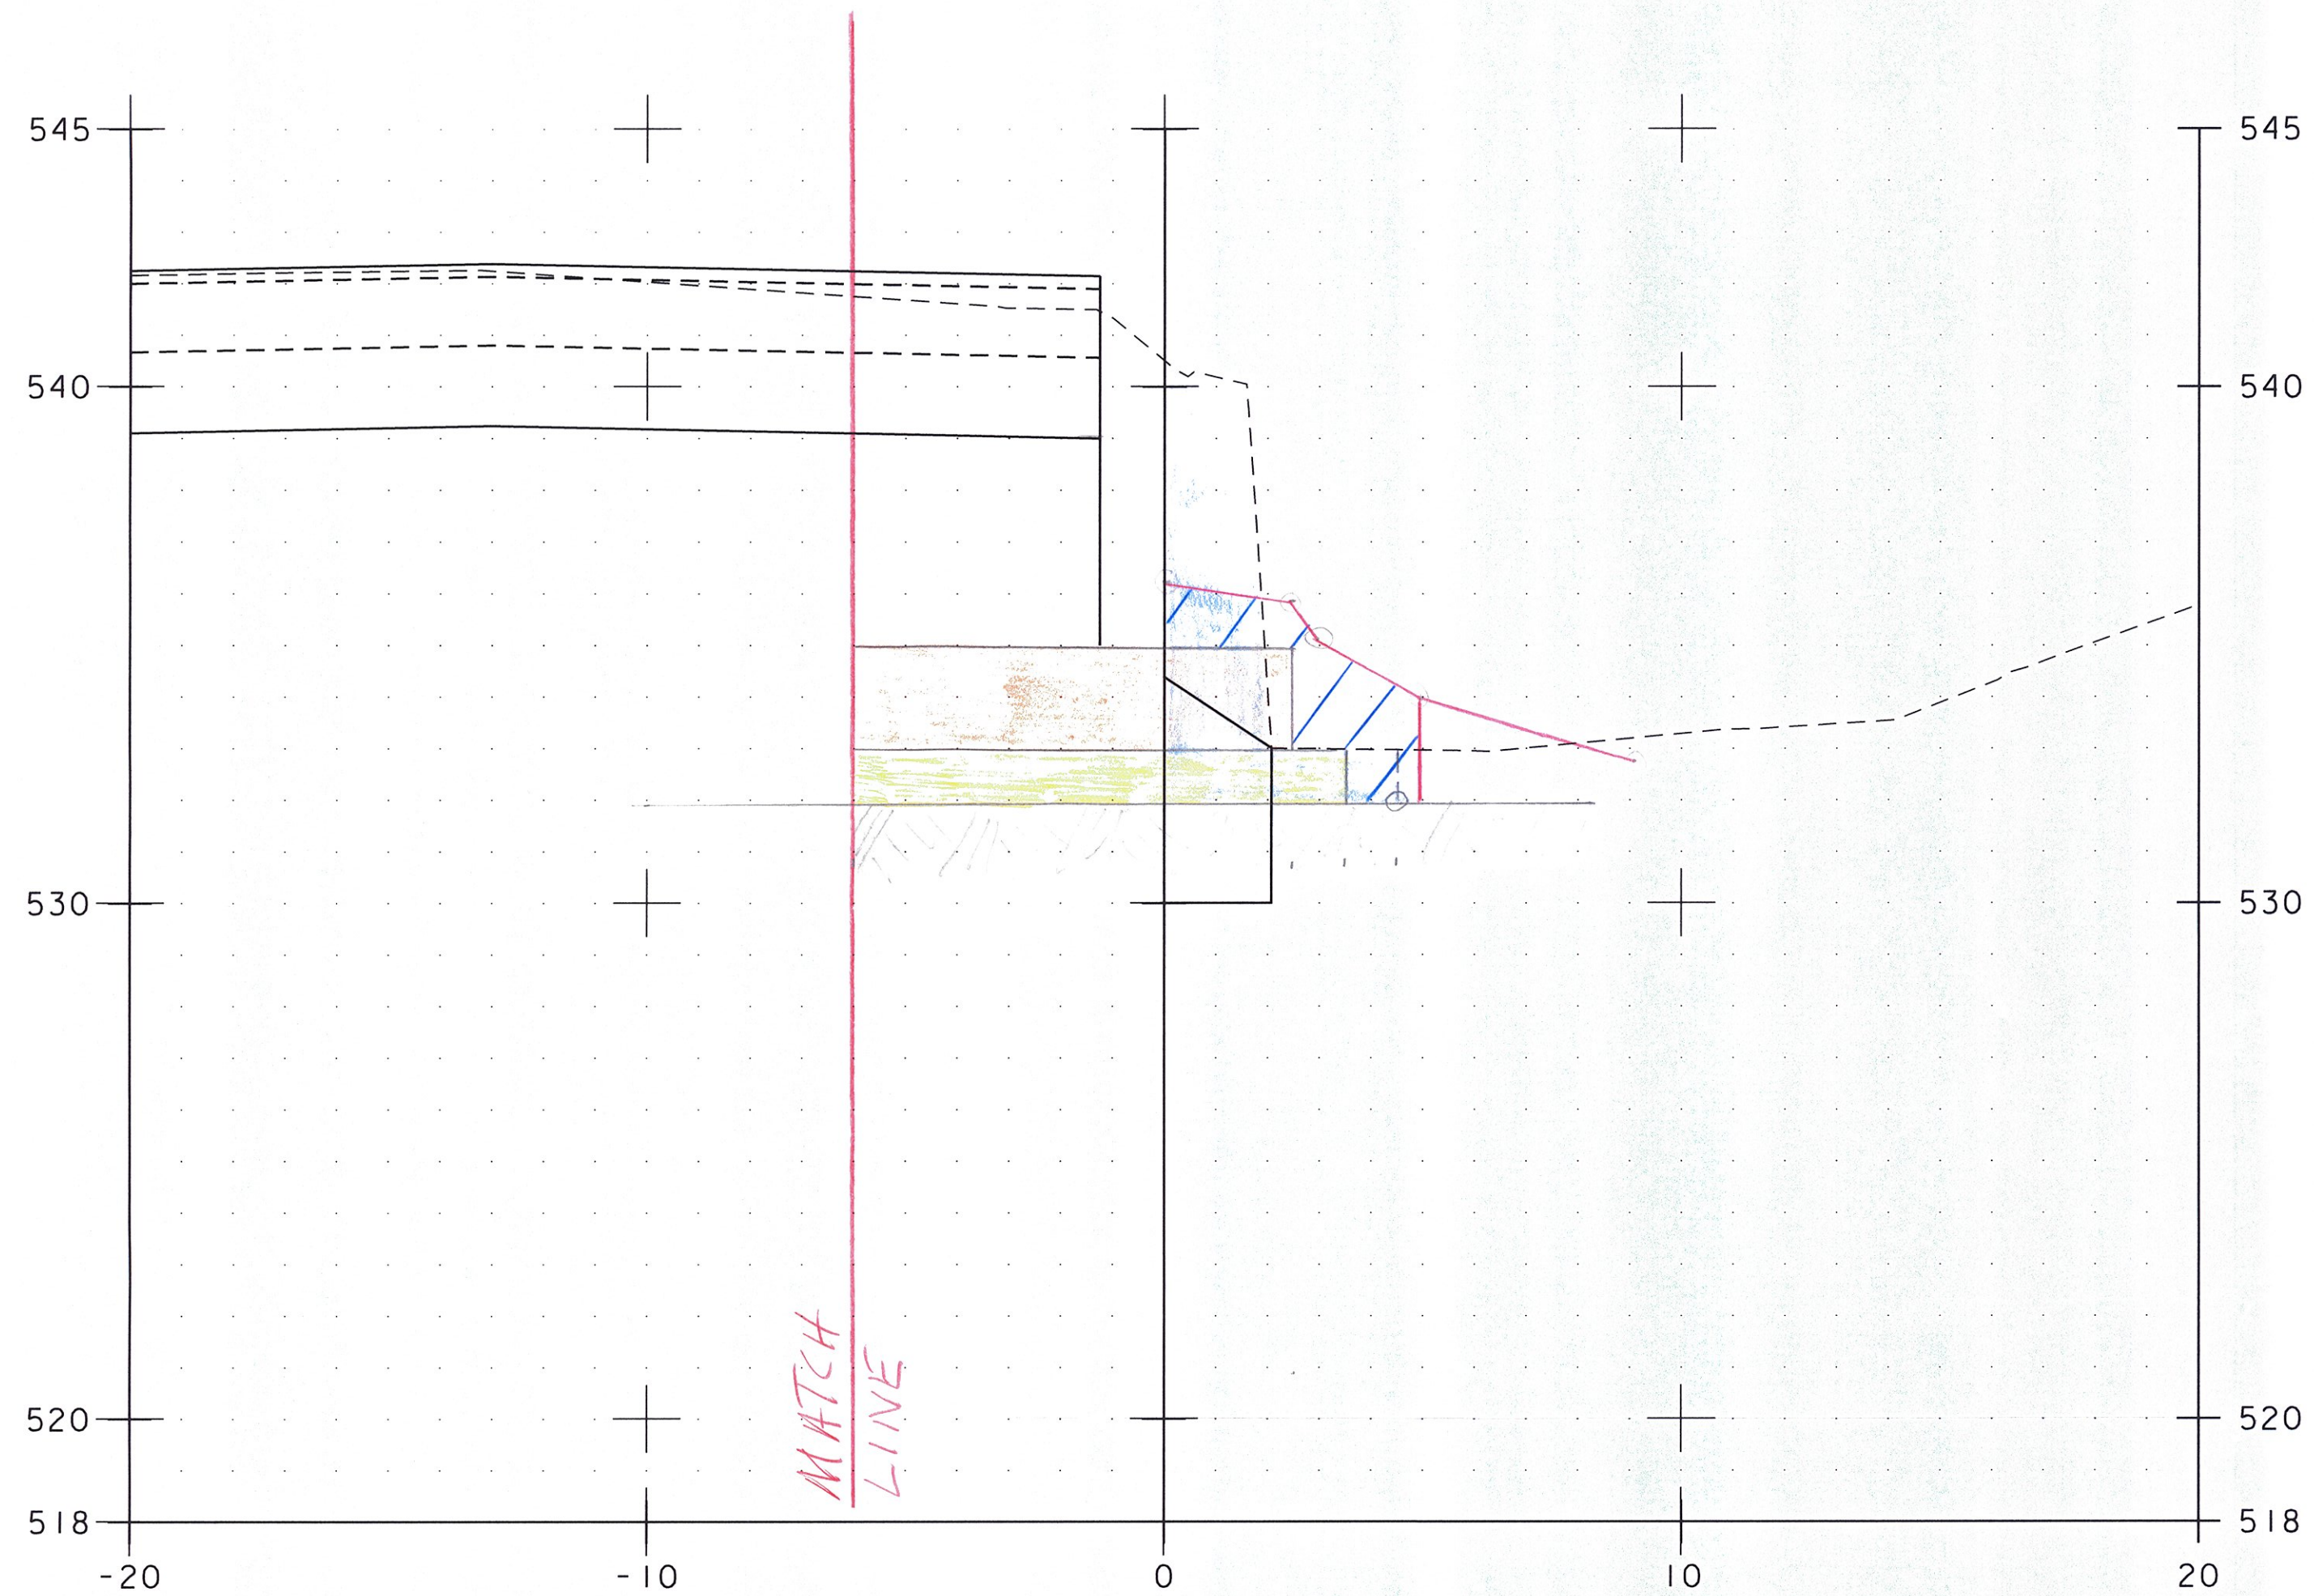

Cofferdam Earth  
30+26.5 = 45.7 FT² ✓  
Granular Backfill for Structure  
30+26.5 = 20.0 FT² ✓  
Unclassified Chemical Excavation  
30+26.5 = 18.7 FT² ✓  
Stone Fill, type II  
30+26.5 = 8.5 FT² ✓  
Green Under Stone Fill  
30+26.5 = 10.0 FT² for 7' 2.5" 15'  
for 2.5' 15'

30+26.50  
Use final X-section 30+27

Cofferdam Earth  
30+28.5 = 20.0 ✓  
Granular Backfill for Structure  
30+28.5 = 10.0 ✓  
Unclassified Chemical Excavation  
30+28.5 = 21.3 FT² ✓  
Stone Fill, type II  
30+28.5 = 10.0 FT² ✓  
Green Under Stone Fill  
30+28.5 = 13.5 ✓  
for 2.5' 15'



30+28.50  
Use final X-section 30+27

NOTE: PROPOSED GRADE IS NOT SHOWN.

PROJECT NAME: BRATTLEBORO	
PROJECT NUMBER: BRO 1442(35)	
FILE NAME: z10j062_customEL.dgn	PLOT DATE: 3/2/2015
PROJECT LEADER: S.E. BURBANK	DRAWN BY: E.F. LAWES
DESIGNED BY: E.F. LAWES	CHECKED BY: S.E. BURBANK
WINGWALL NO. 3 CROSS SECTIONS (6 OF 7)	SHEET 15 OF 28



SCALE 1" = 3'-0"

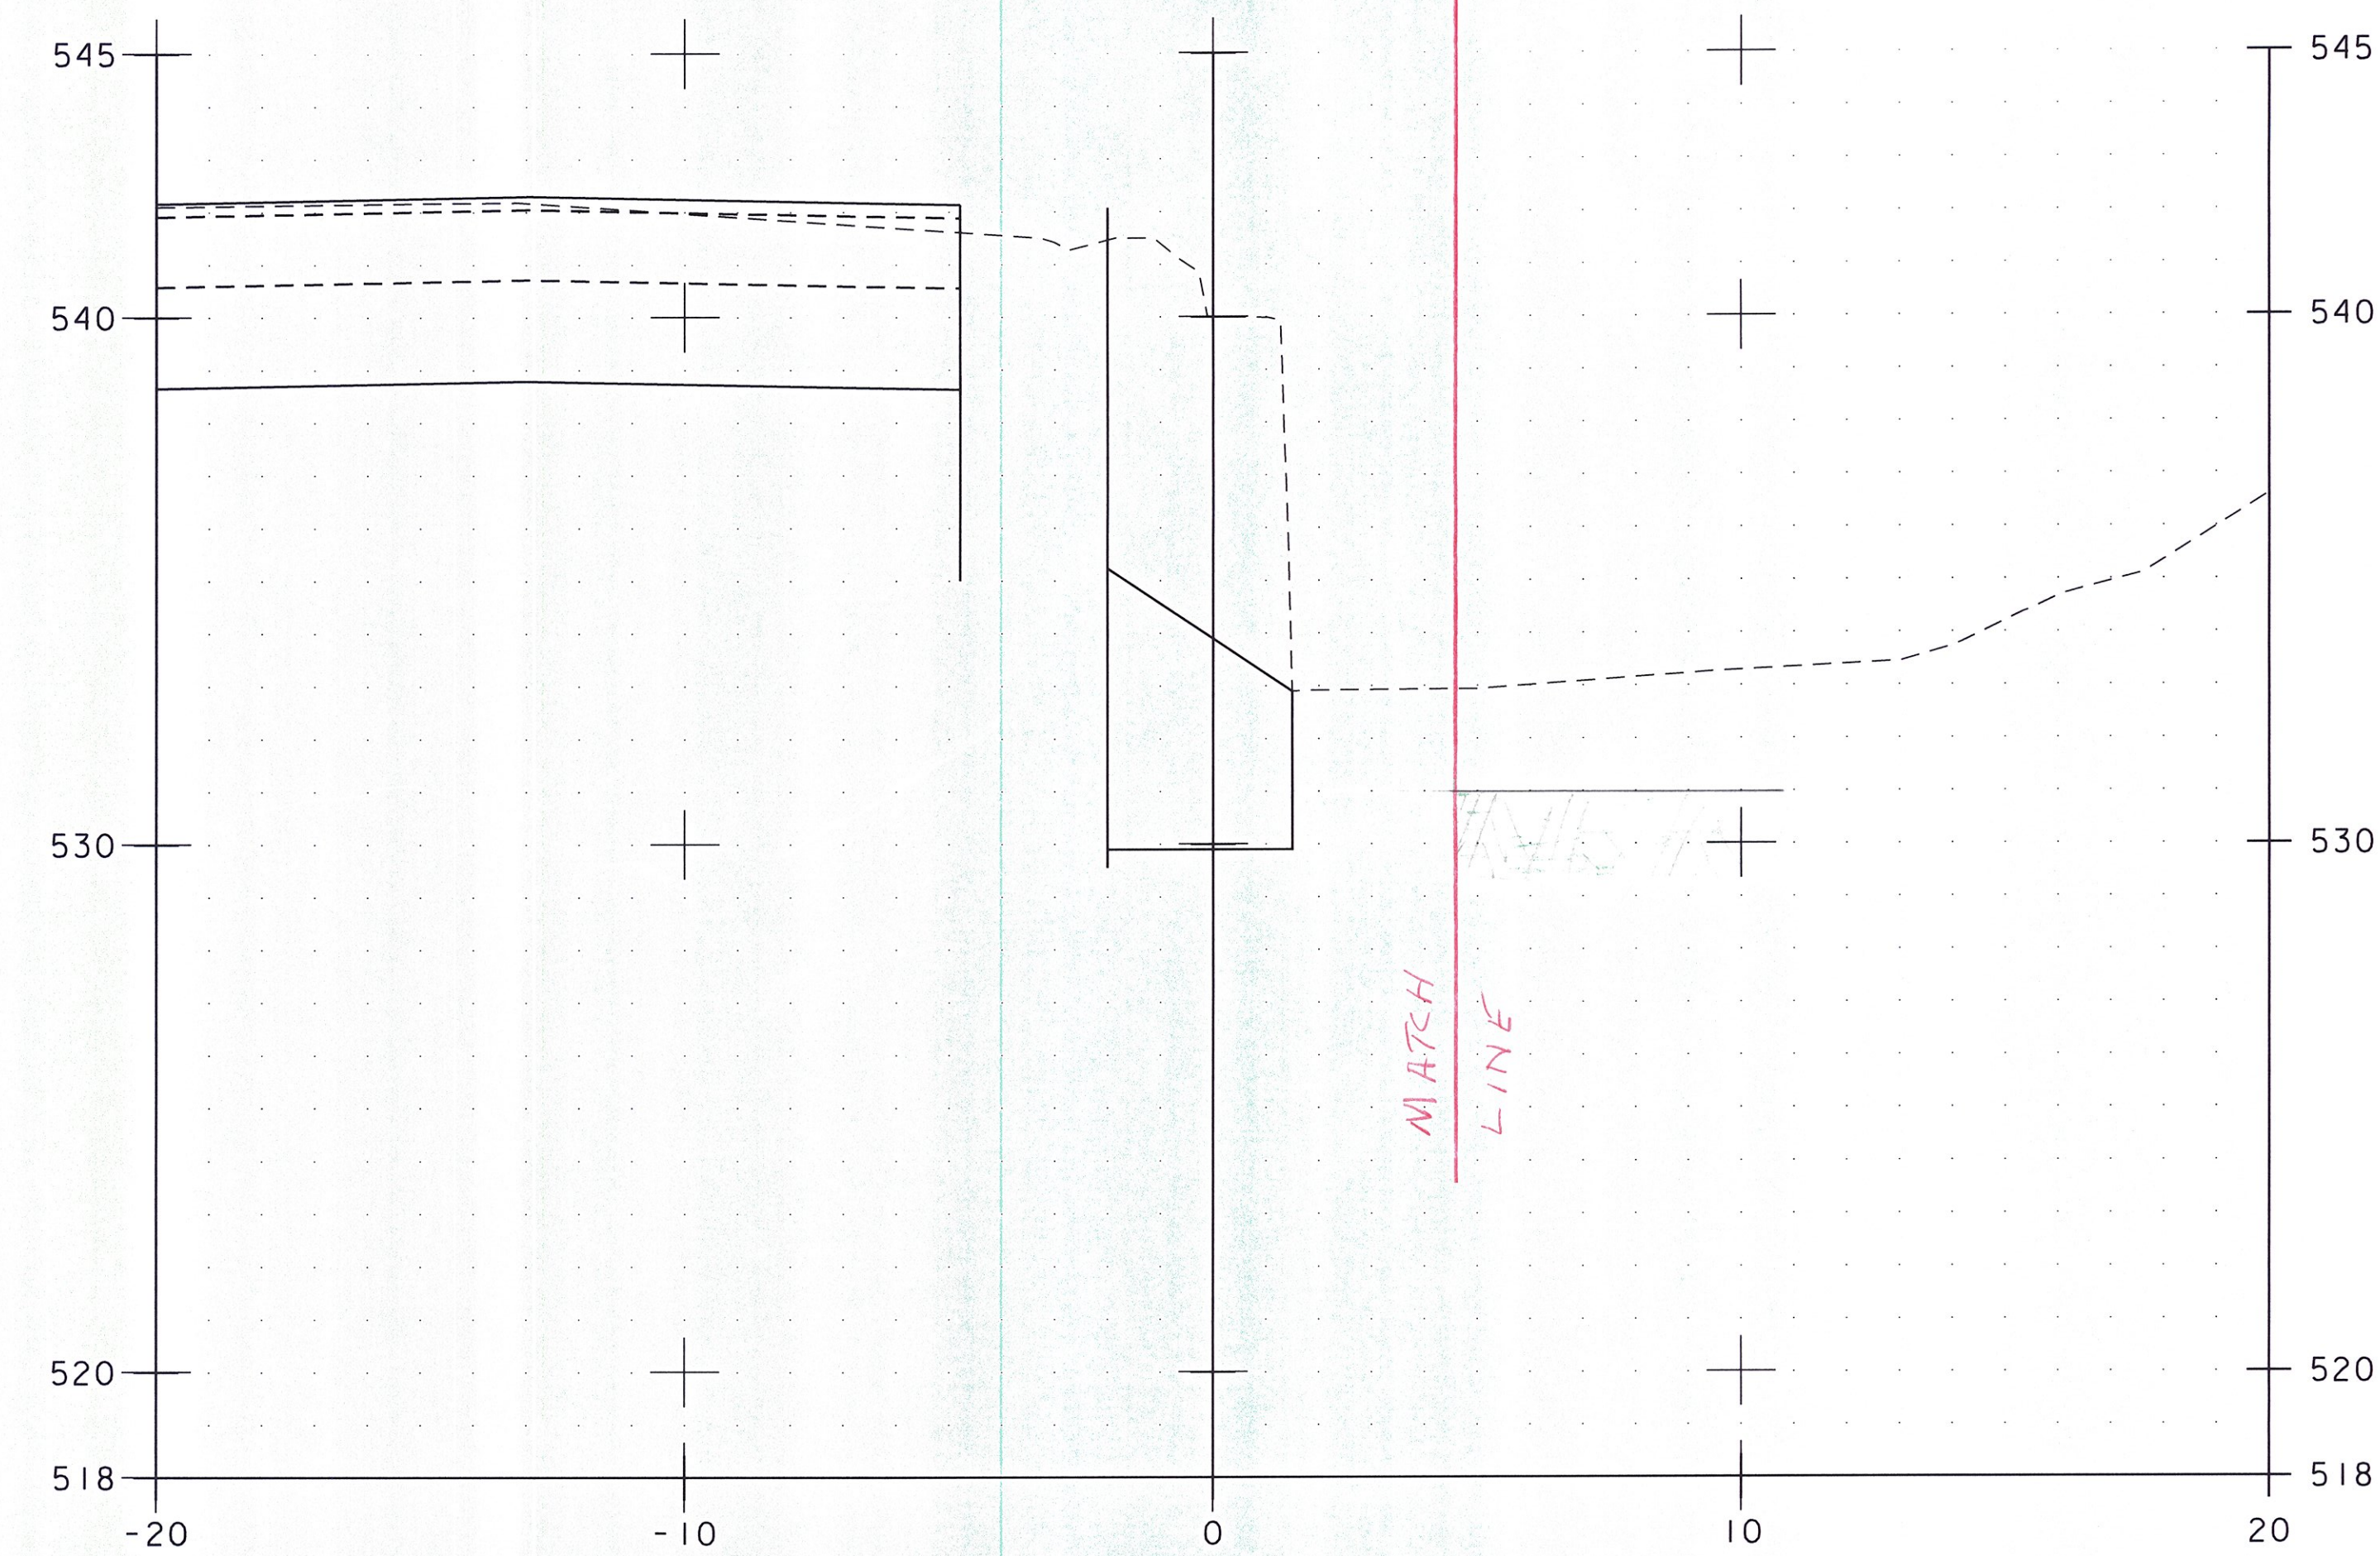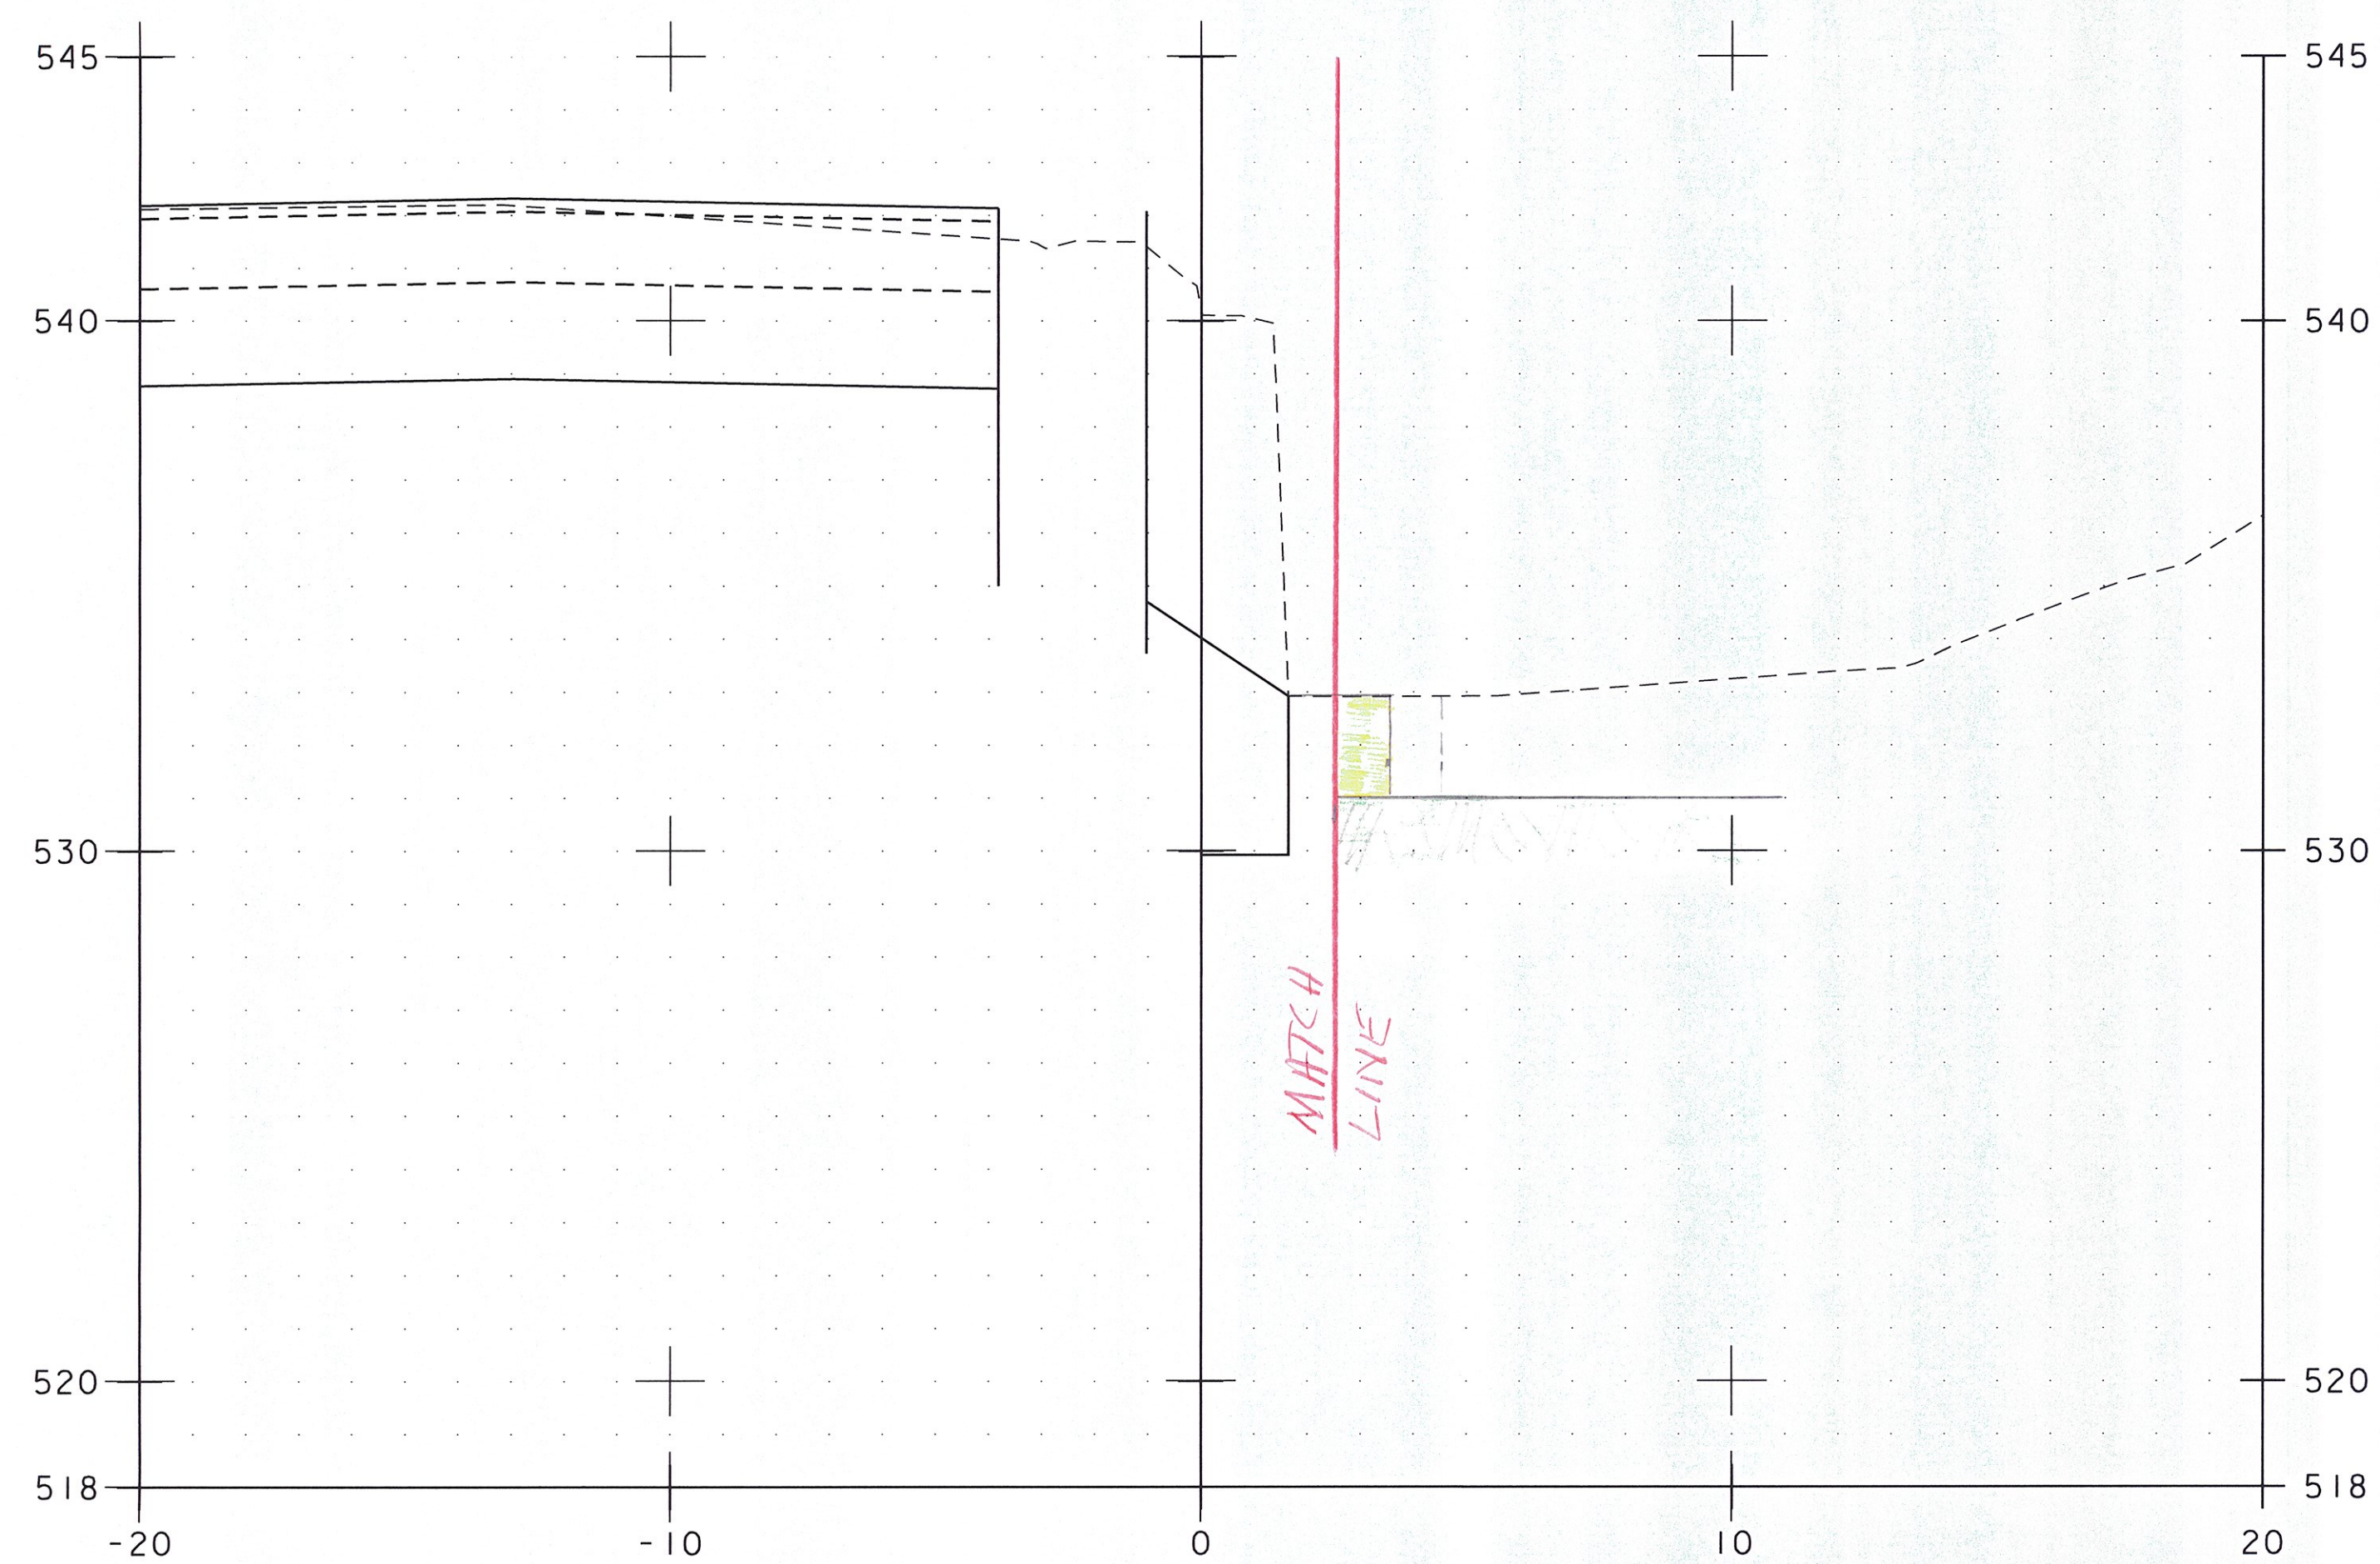

(batt) Coffered Earth 4.0' ✓ 30+29.50

(batt) Granular Bedding for Concrete 2.0' ✓

Unclassified Channel Excavation = zero 3.0' ✓

Stone Fill, type II = zero 3.0' ✓

Excav. Under Stone Fills zero 3.0' ✓

JPB  
2.0.0  
- for -

30+30.50


SCALE 1" = 3'-0"

NOTE: PROPOSED GRADE IS NOT SHOWN.

PROJECT NAME: BRATTLEBORO  
PROJECT NUMBER: BRO 1442(35)




FILE NAME: z10j062.customEL.dgn PLOT DATE: 3/2/2015  
PROJECT LEADER: S.E. BURBANK DRAWN BY: E.F. LAWES  
DESIGNED BY: E.F. LAWES CHECKED BY: S.E. BURBANK  
WINGWALL NO. 3 CROSS SECTIONS (7 OF 7) SHEET 16 OF 28

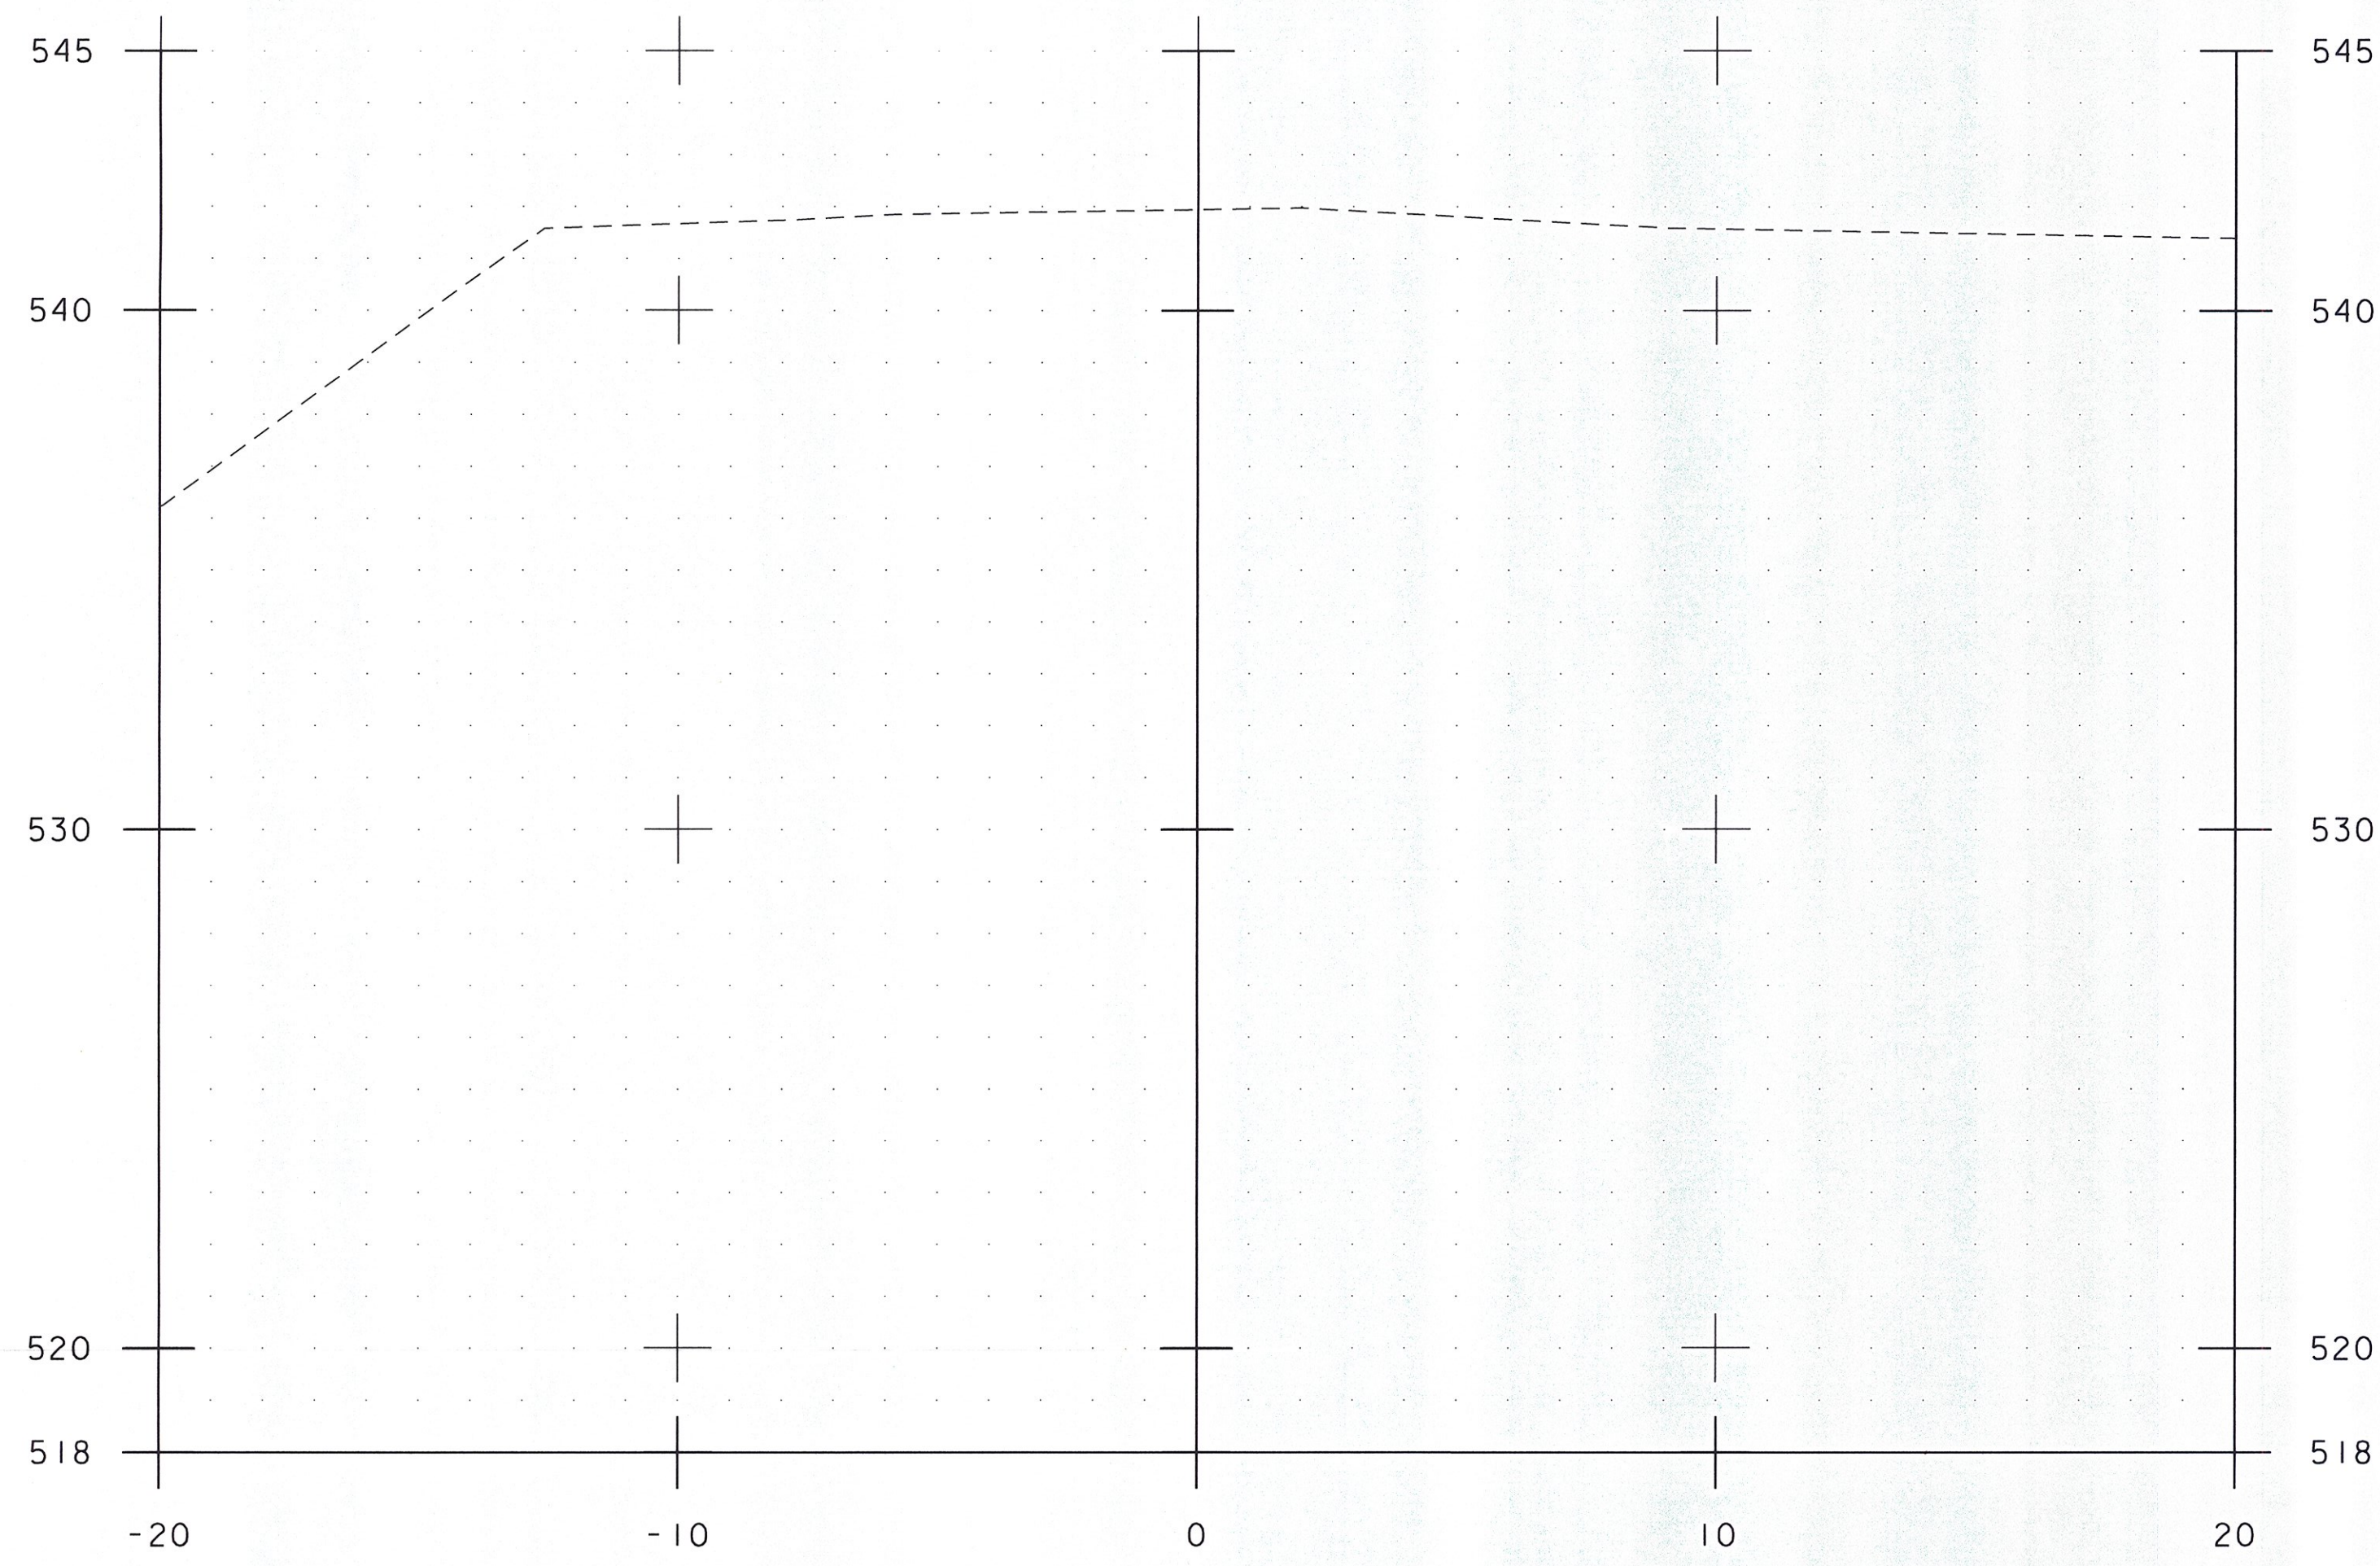

39+30

Common Excavation = Zero ✓

30  
1:4

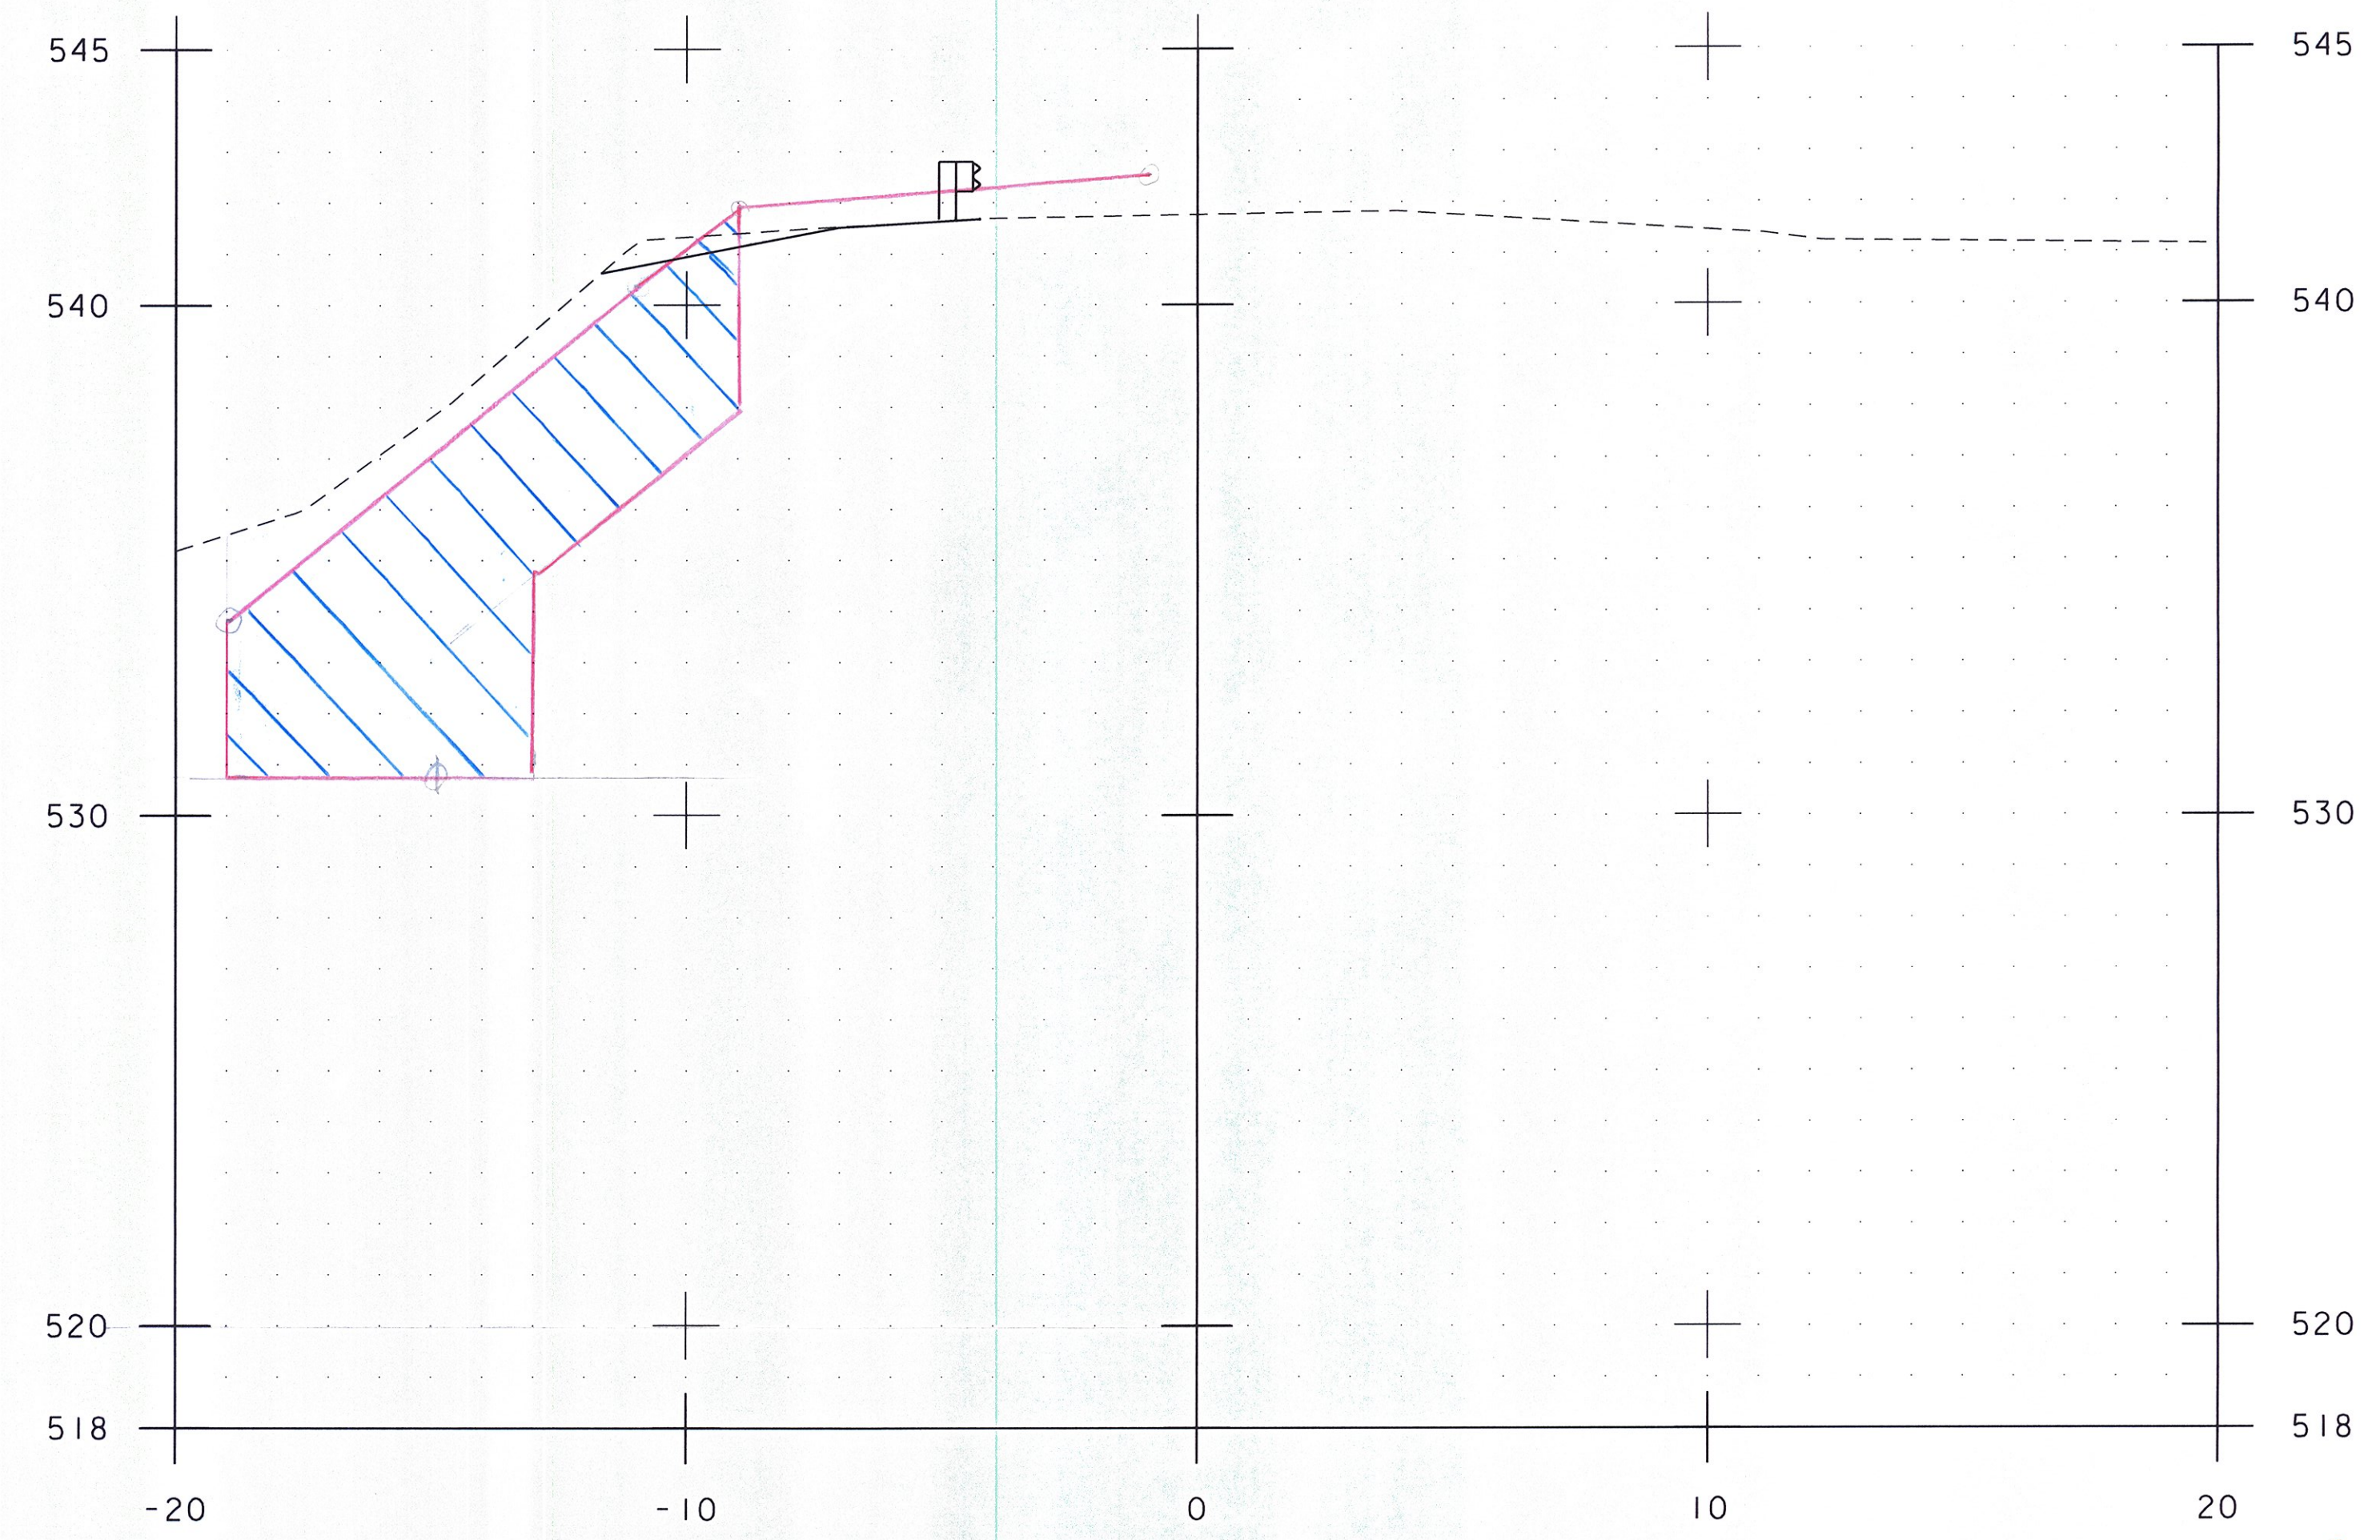

39+35

Upset  
 B.A. = 50.7 ft ✓  
 Stone Fill Type II  
 B.A. = 47.0 ft ✓  
 Clear road Surface  
 B.A. = 25.1' (+3.1') ✓  
 Common Excavation = 11.1' ✓



SCALE 1" = 3'-0"



PROJECT NAME: BRATTLEBORO	
PROJECT NUMBER: BRO 1442(35)	
FILE NAME: z10j062_customEL.dgn	PLOT DATE: 5/5/2015
PROJECT LEADER: S.E. BURBANK	DRAWN BY: E.F. LAWES
DESIGNED BY: E.F. LAWES	CHECKED BY: S.E. BURBANK
ABUTMENT NO. 1 CROSS SECTIONS (1 OF 2)	SHEET 1 OF 2

17A (No 17)

VHB 57428

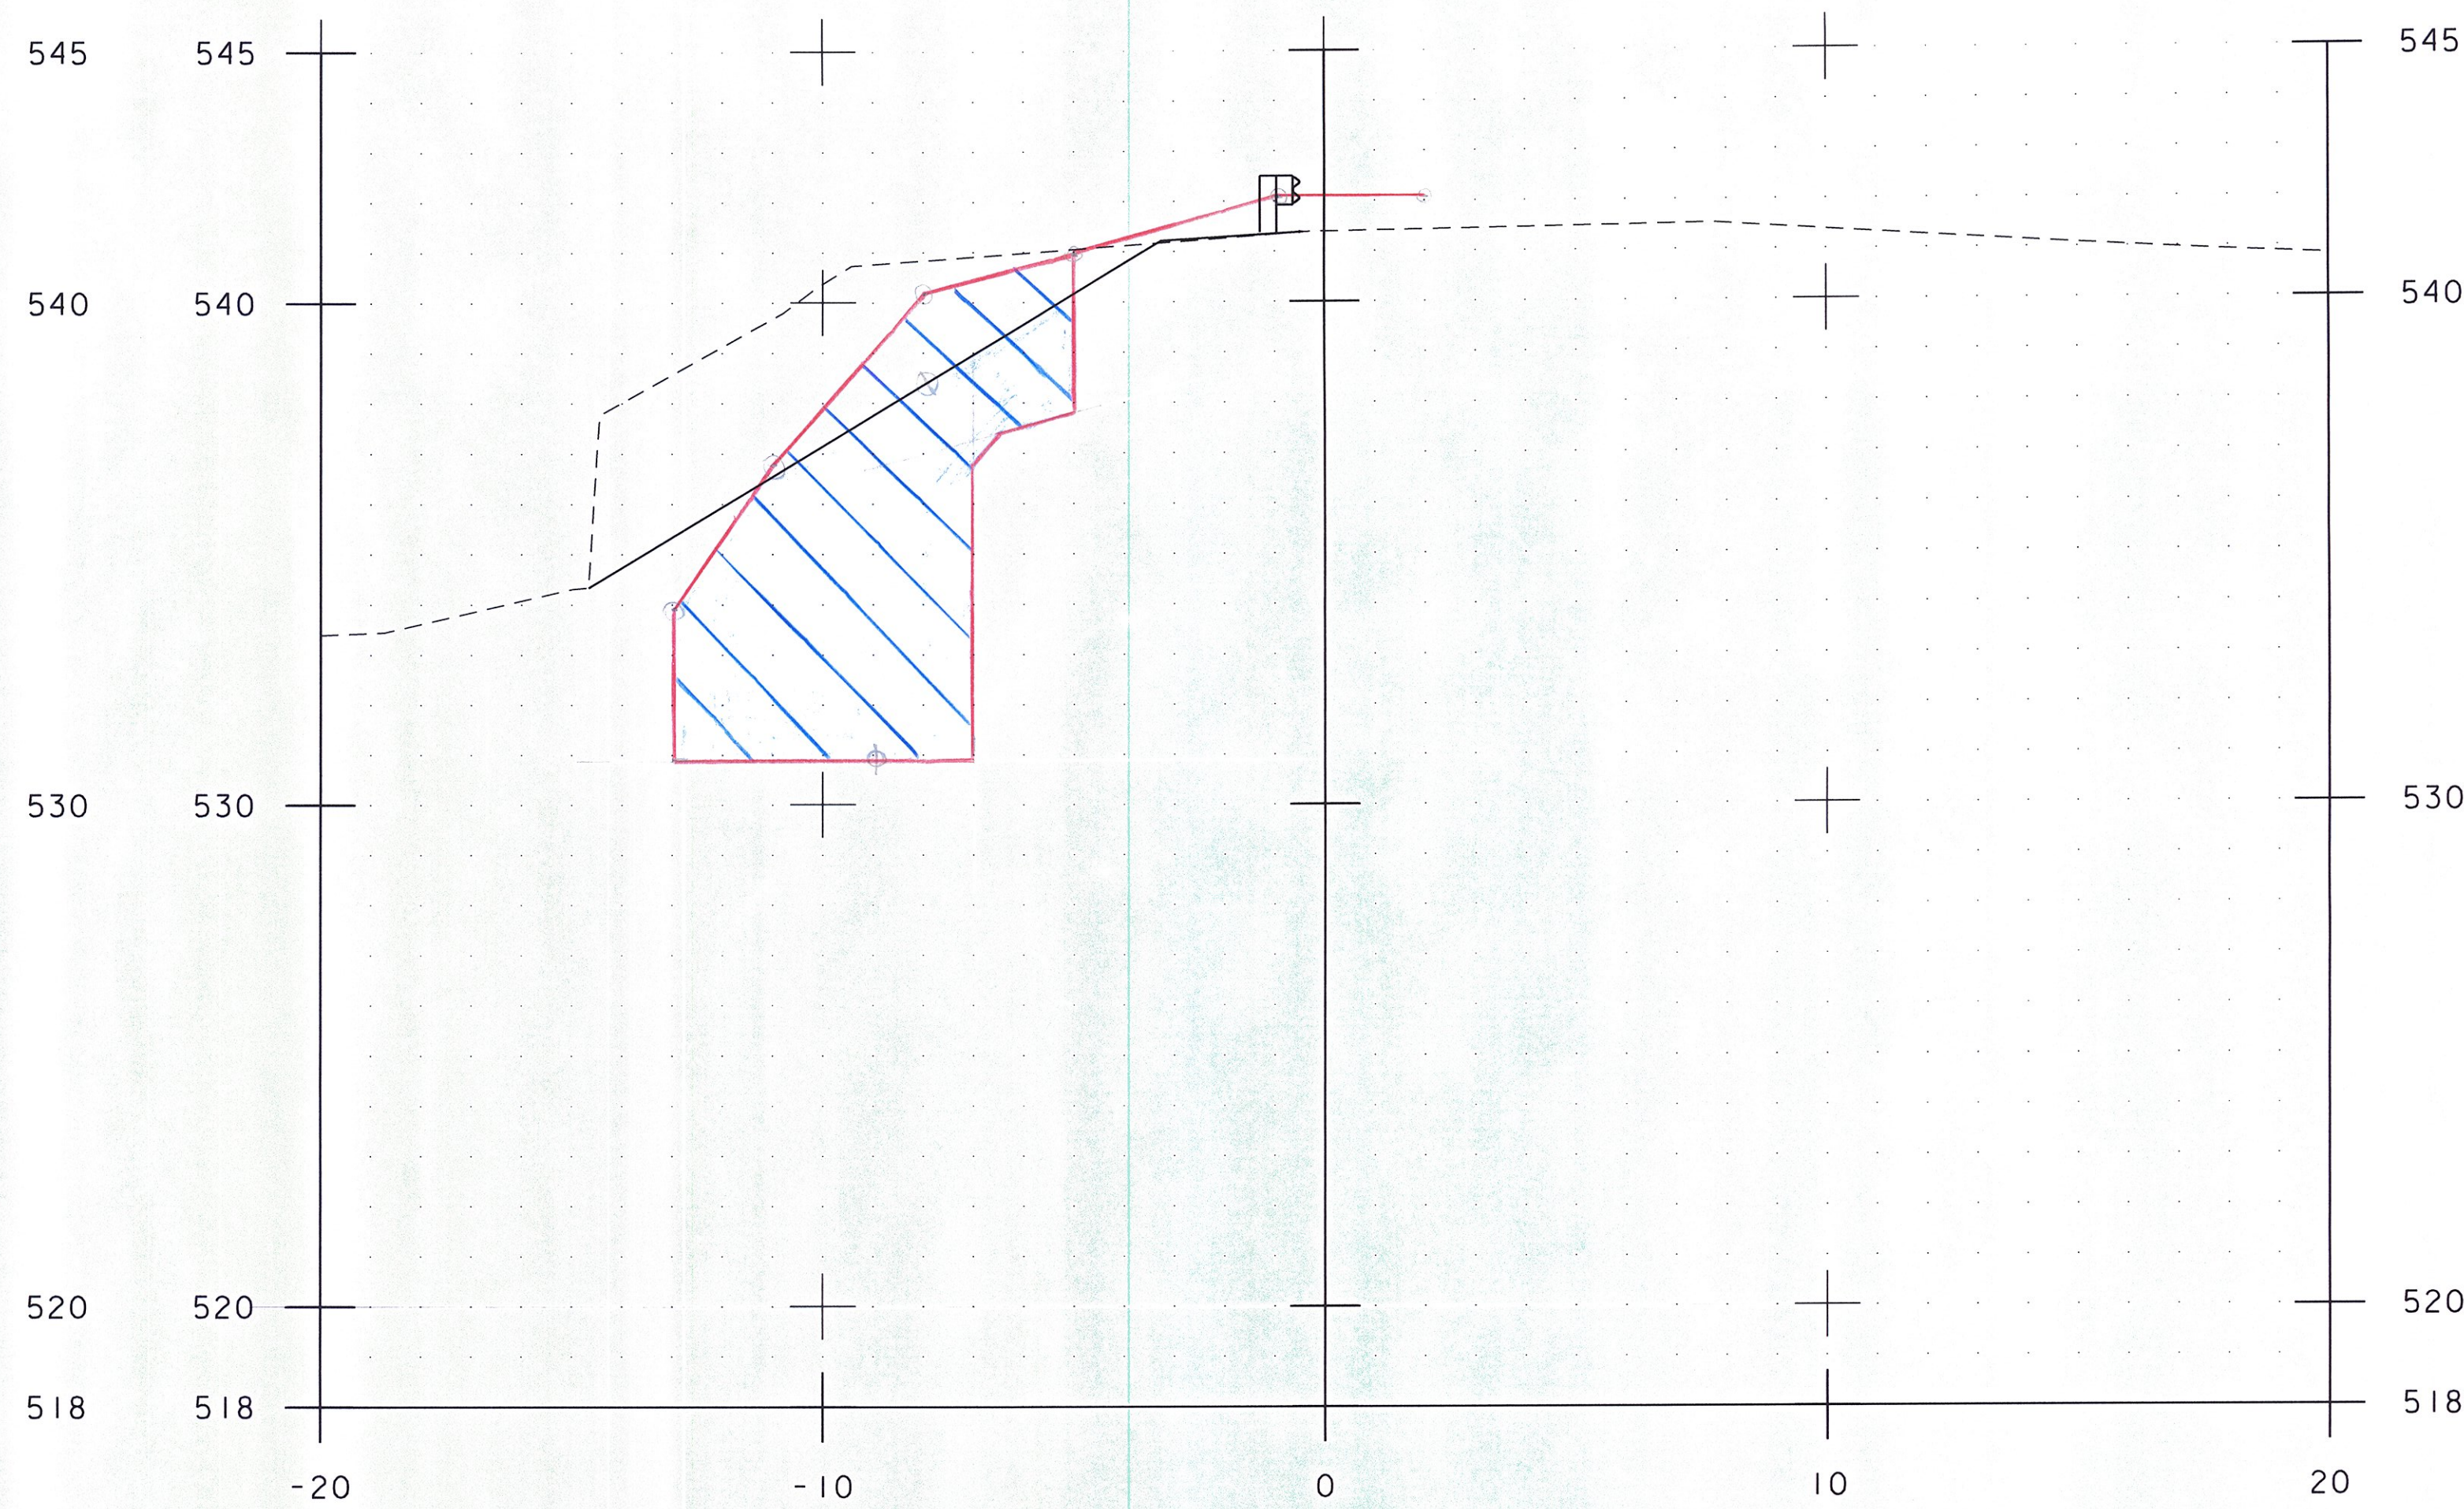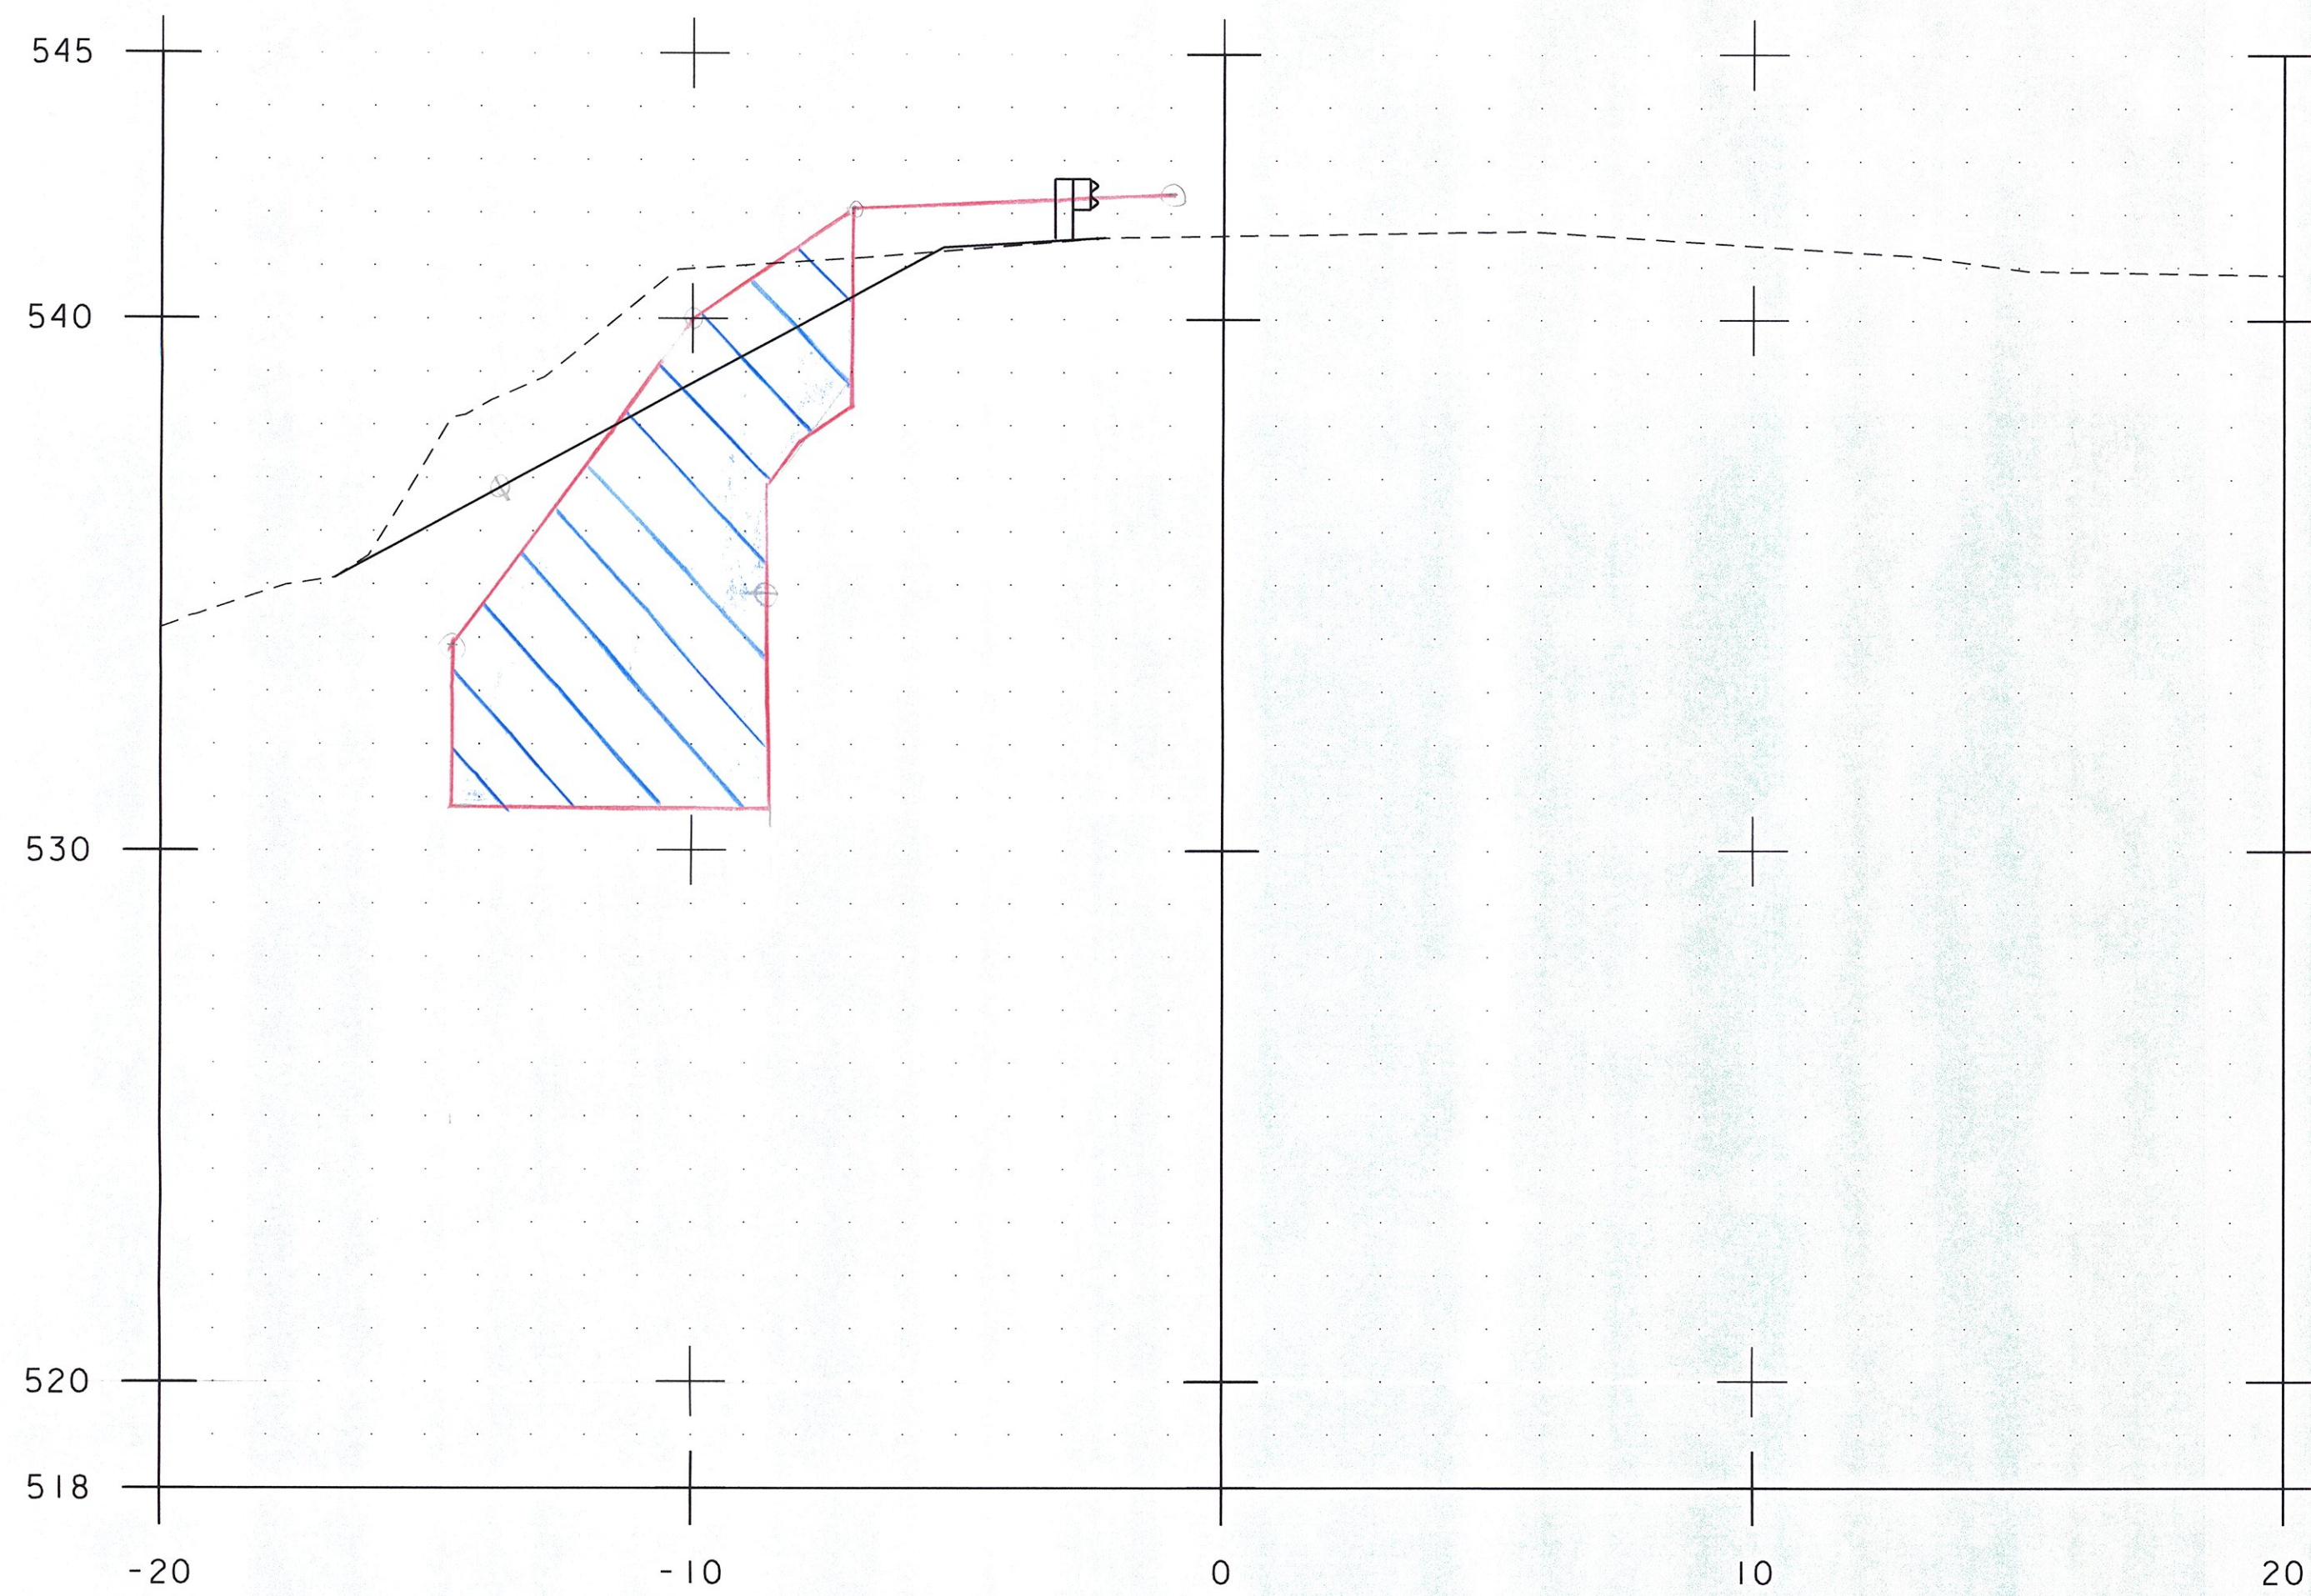

Unclassified Channel Excavation = 42.2 FT² ✓  
 Stone Fill, type III = 47.3 FT² ✓  
 Gen. Drain Stone Fill = 26.0' ✓  
 Common Excavation = 14.4 FT² ✓

✓  
 1.5  
 ✓  
 7.10.15


Unclassified Channel Excavation = ~~42.2~~ 41.4 FT² ✓  
 Stone Fill, type III = ~~47.3~~ 46.8 FT² ✓  
 Gen. Drain Stone Fill = 21.4' ✓  
 Common Excavation = ~~14.4~~ 14.4 FT² ✓

SCALE 1" = 3'-0"




PROJECT NAME:	BRATTLEBORO
PROJECT NUMBER:	BRO 1442(35)
FILE NAME:	z10j062_customEL.dgn
PROJECT LEADER:	S.E. BURBANK
DESIGNED BY:	E.F. LAWES
ABUTMENT NO./CROSS SECTIONS (2 OF 2)	SHEET 2 OF 2
PLOT DATE:	5/5/2015
DRAWN BY:	E.F. LAWES
CHECKED BY:	S.E. BURBANK

17B

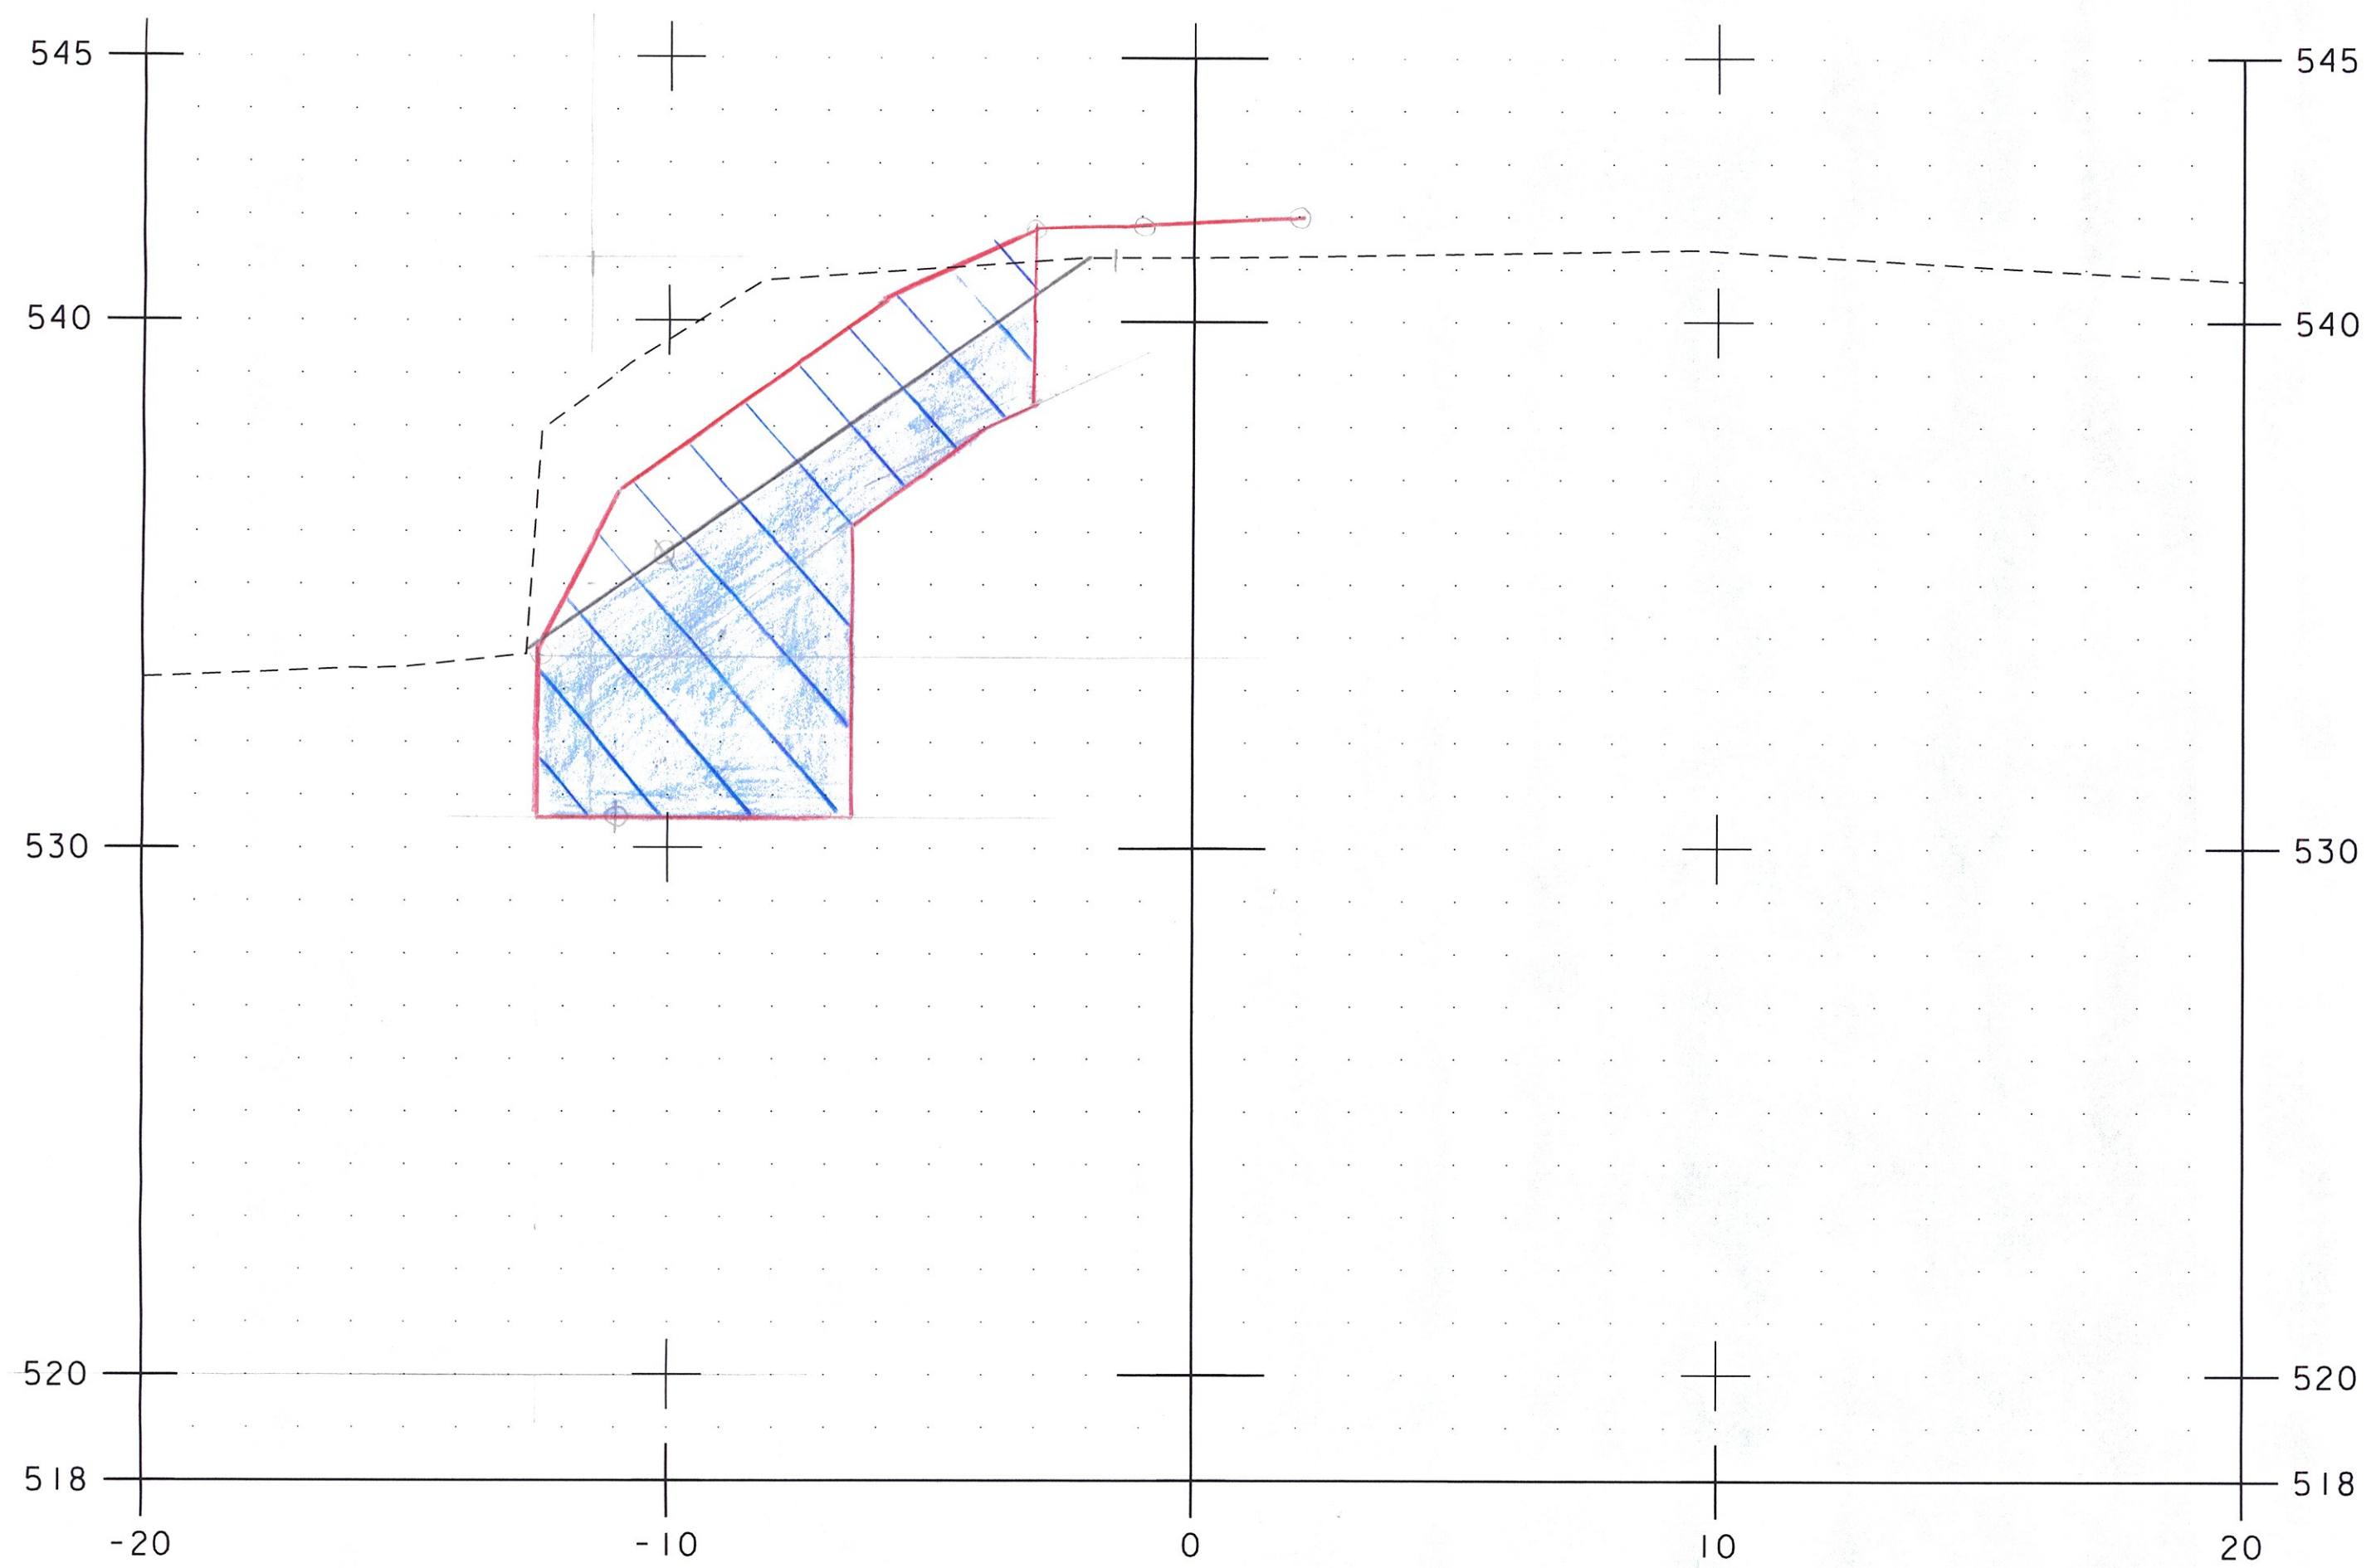

Unclassified Channel Excavation = 35.277' ✓ 39+50.00  
 Stone Fill, type III = 54.517' ✓  
 Geo. Under Stone Fill = 22.0' ✓  
 Common Excavation = 23.977' ✓  
 for 5/1/15

JPL  
 7-2-15

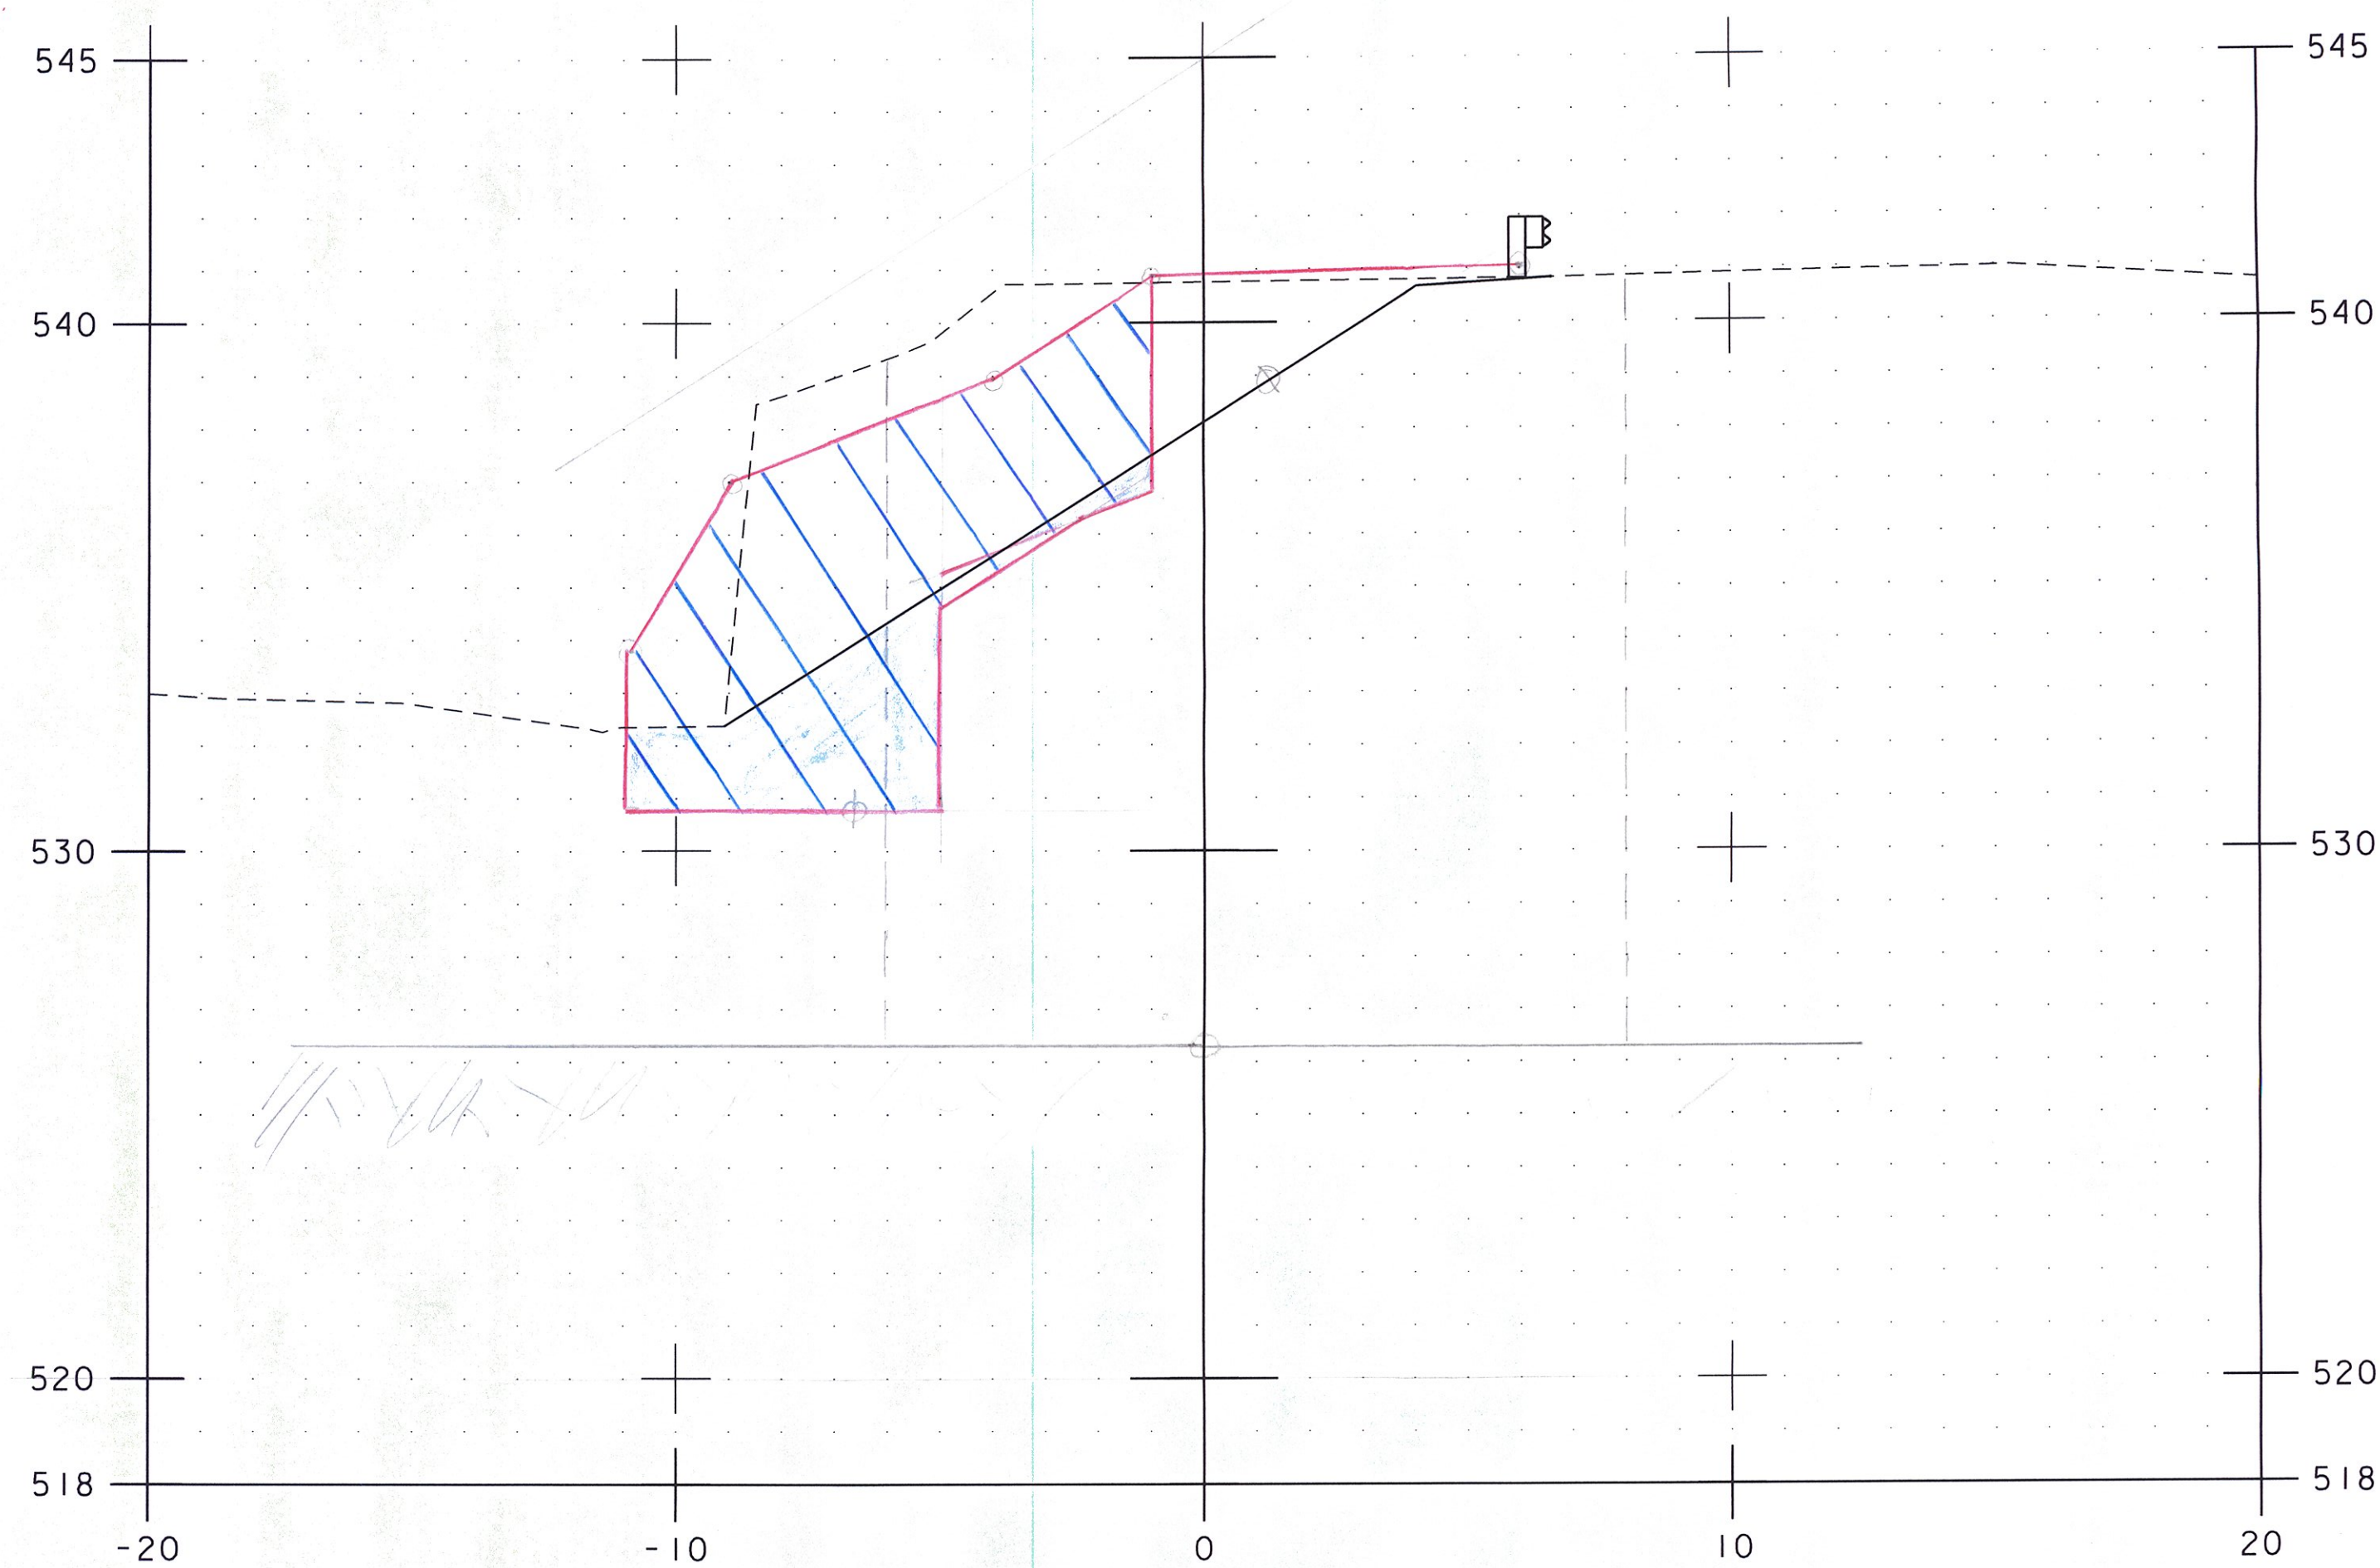

Unclassified Channel Excavation = 39+65.40 begin Collapsed Excavation (Geo) fill to 54  
 (bk) = 15.317' ✓ (Geo) 54.517' ✓  
 Stone Fill, type III = 51.277' ✓  
 Geo. Under Stone Fill = 26.5' ✓  
 Common Excavation = 23.977' ✓  
 Collapsed Excavation = 13.277' ✓  
 Geo. Under Collapsed Excavation = 13.277' ✓



SCALE 1" = 3'-0"

NOTE: LOCATION OF SUBBASE IS APPROXIMATE.

PROJECT NAME:	BRATTLEBORO
PROJECT NUMBER:	BRO 1442(35)
FILE NAME:	z10j062_customEL.dgn
PROJECT LEADER:	S.E. BURBANK
DESIGNED BY:	E.F. LAWES
ABUTMENT NO./CROSS SECTIONS (1 OF 7)	SHEET 17 OF 28
PLOT DATE:	3/2/2015
DRAWN BY:	E.F. LAWES
CHECKED BY:	S.E. BURBANK



17C (No 17D) VHB 57428

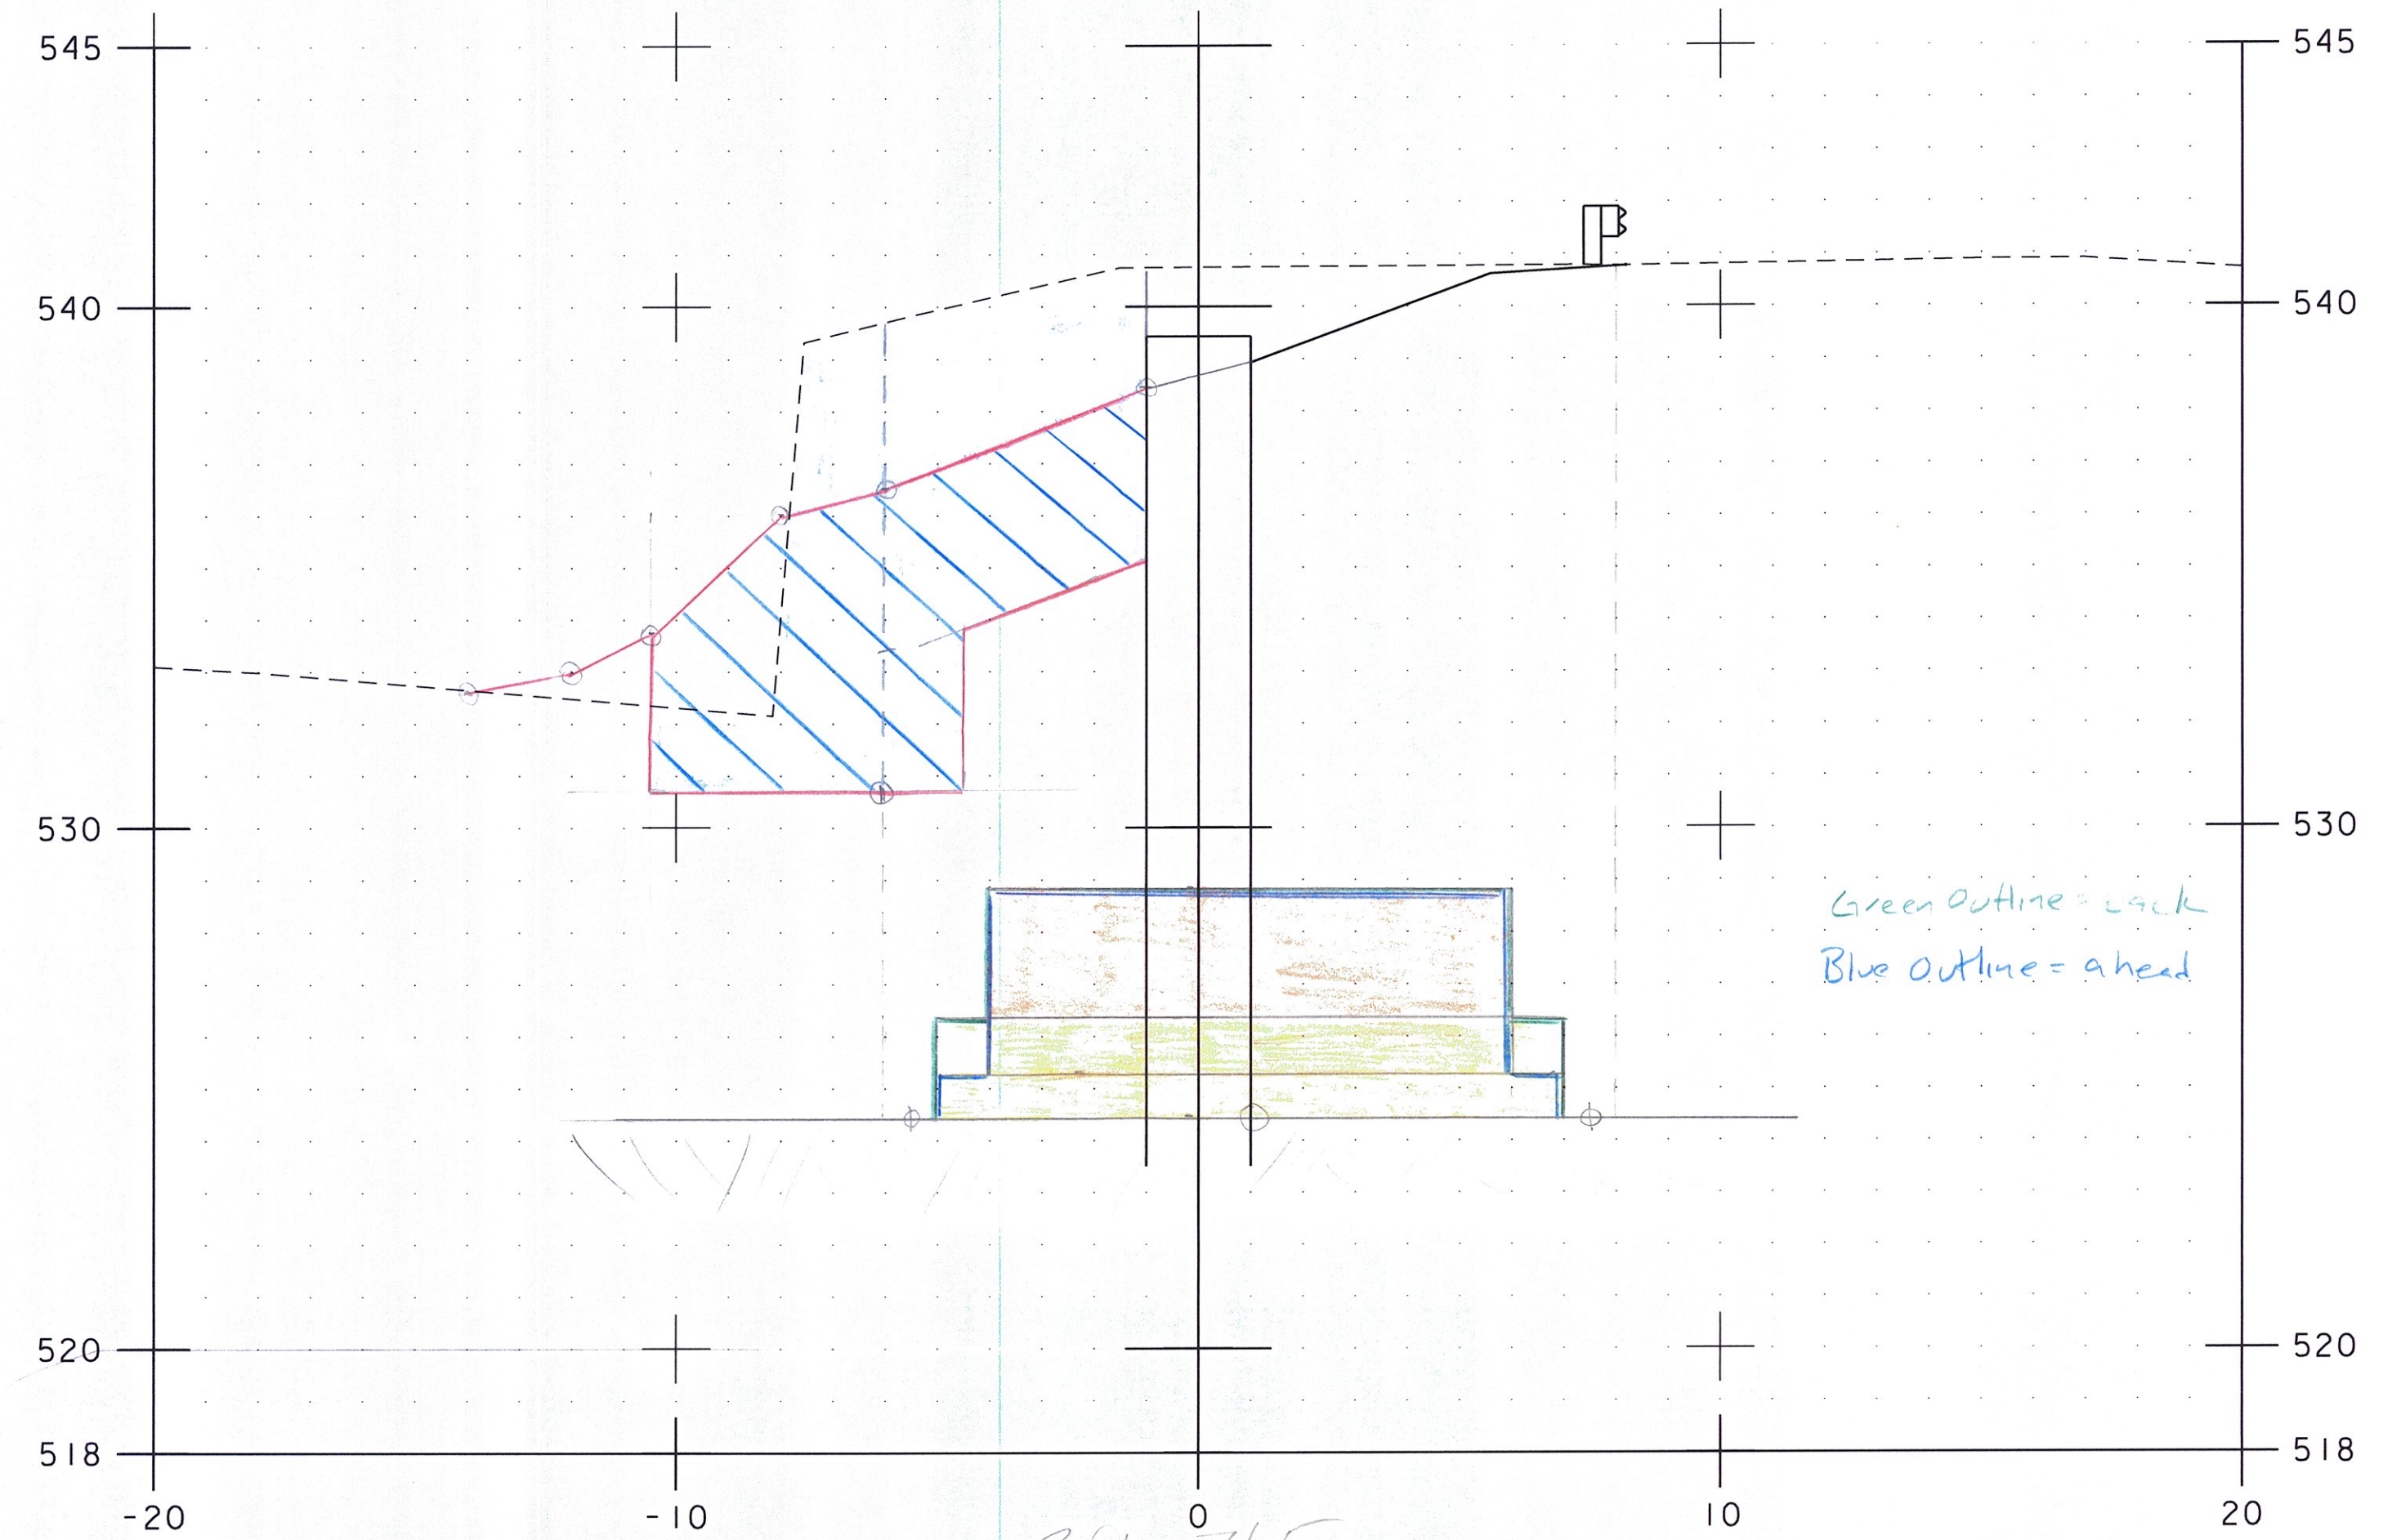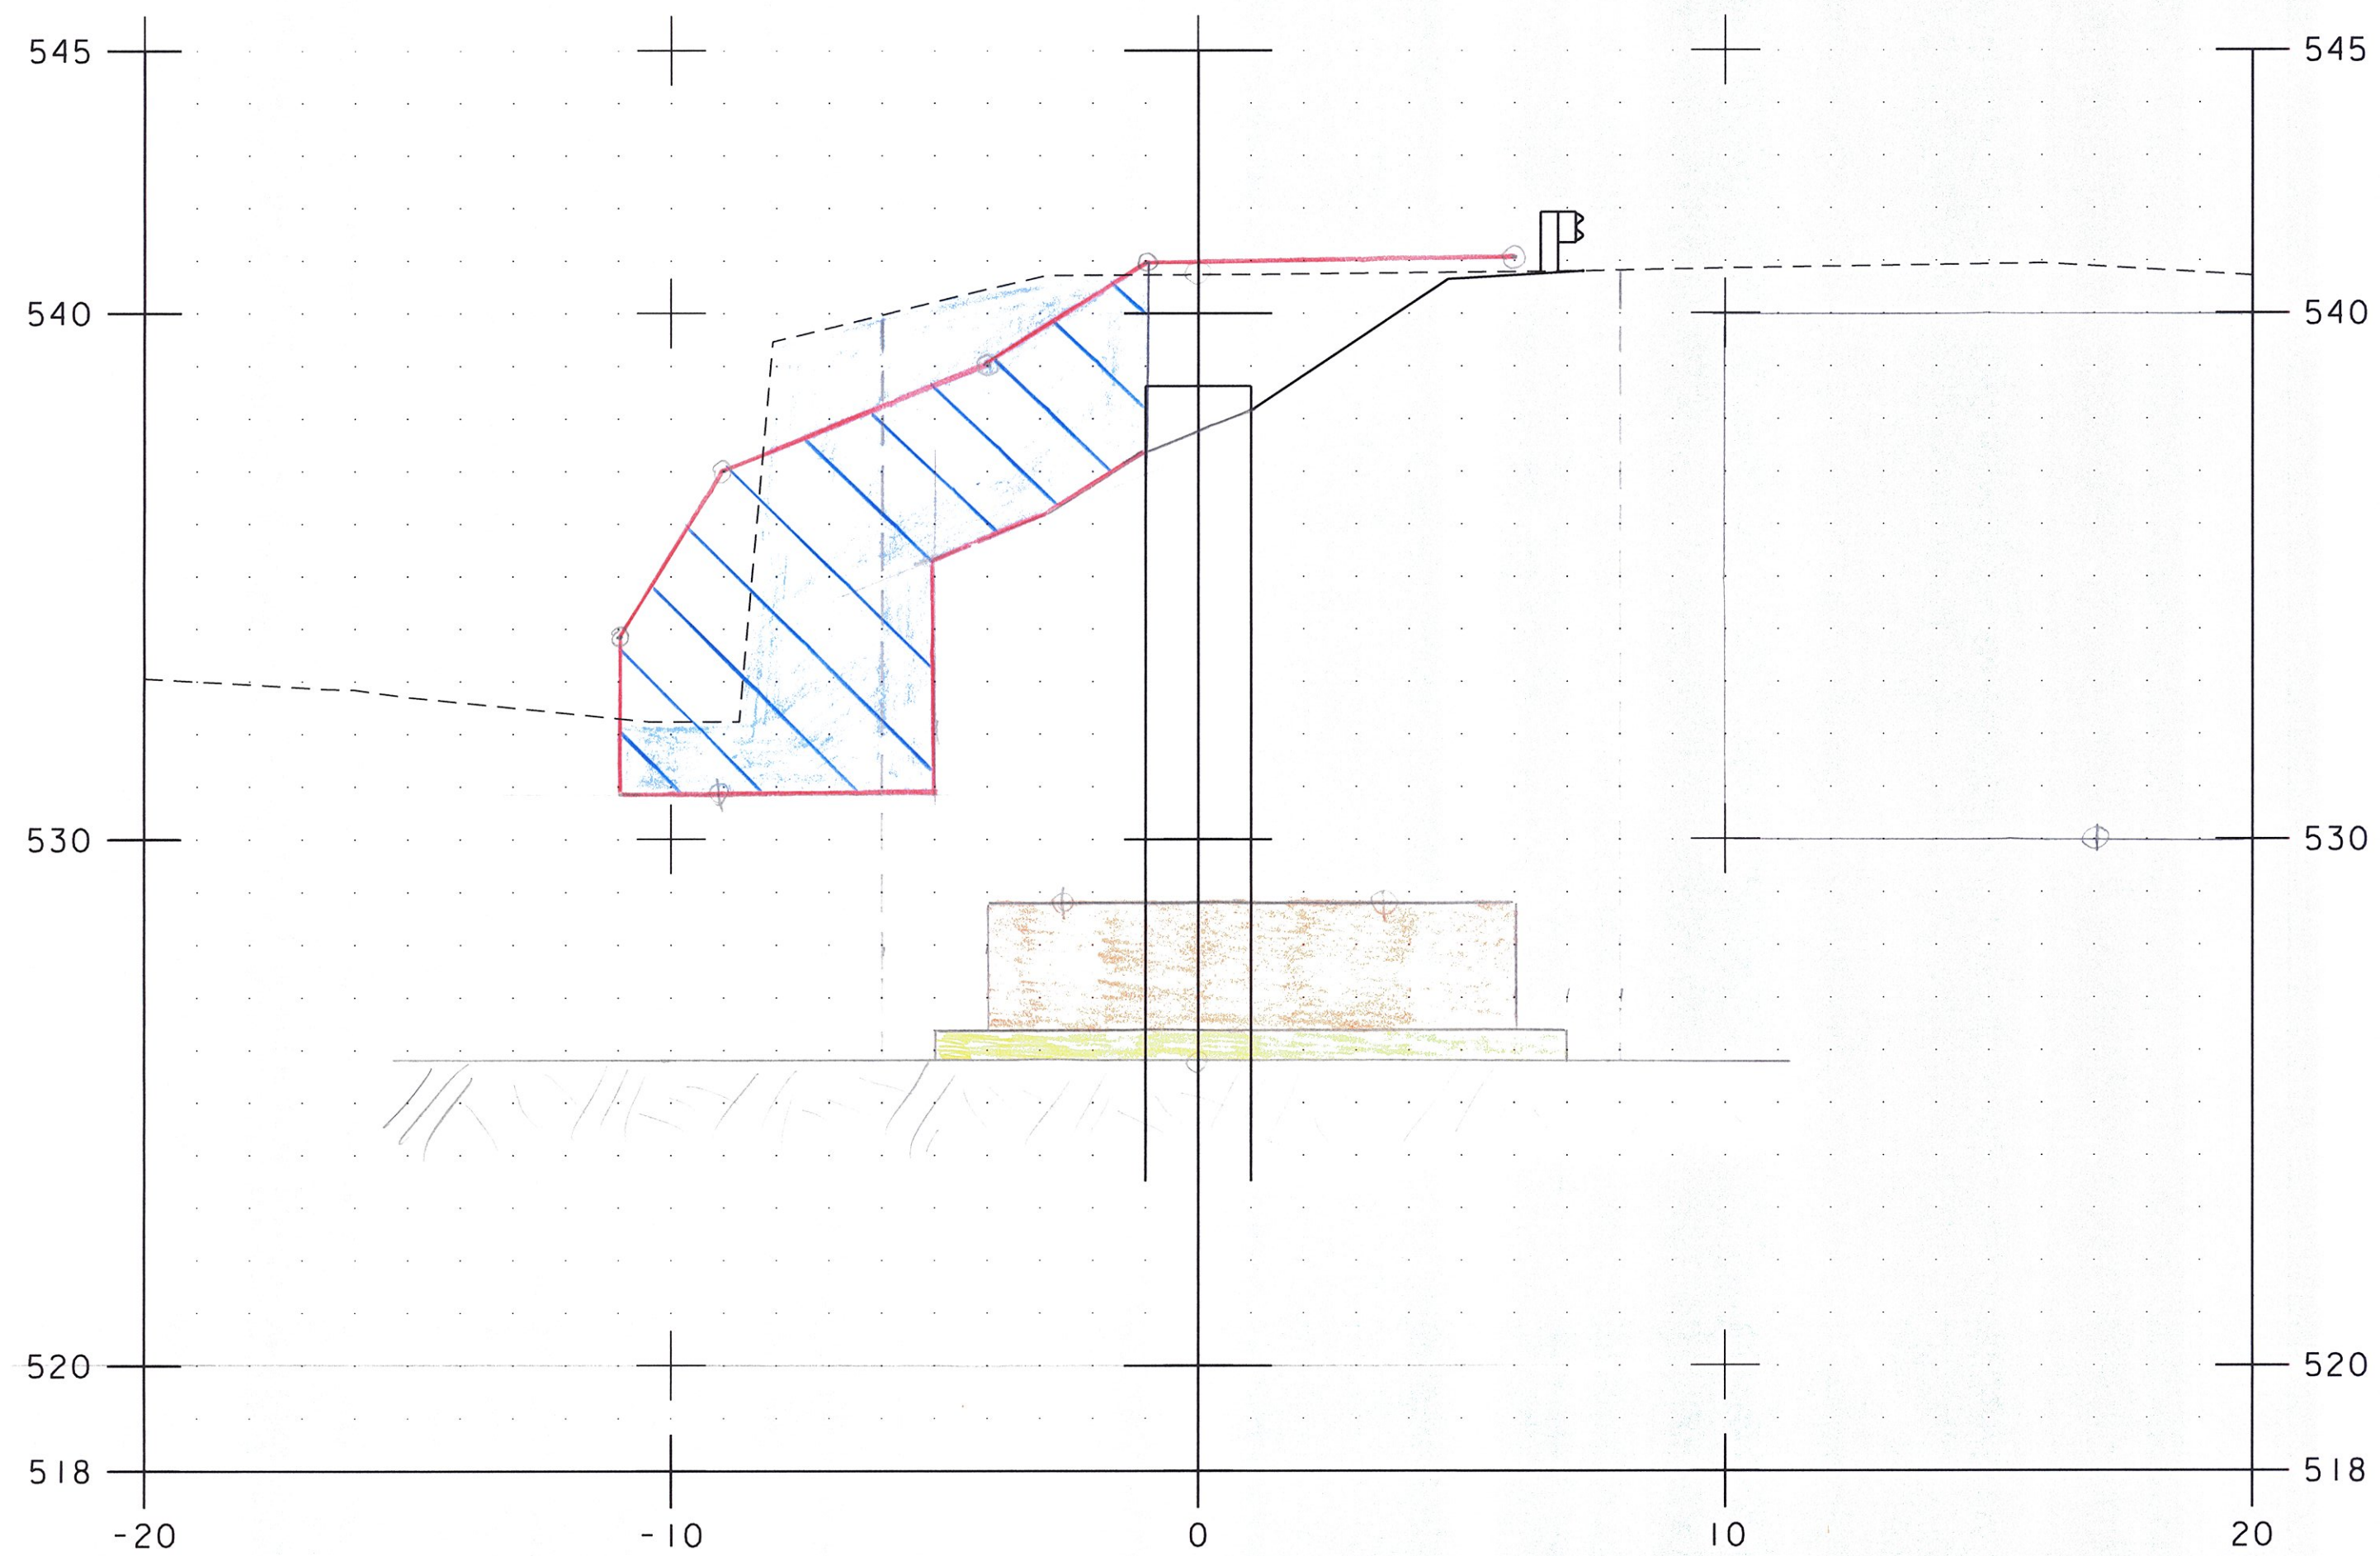

2' = 41.4 SF  
 14' = 54.2 JCE  
 1' = 121.0 SF  
 43' = 113.8 & 111.8

Cofferdam Earth = 168.6 FT² ✓  
 Granular Backfill for Sill = 144.6 FT² ✓  
 39+67.4 (a) = 138.1 FT² ✓  
 39+67.4 (b) = 120.1 FT² ✓  
 (a) = 120.2 FT² ✓  
 Unclassified Channel Exc = 54.2 FT² ✓  
 Stone Fill, Type III = 50.7 FT² ✓  
 Area Under Stone Fill = 21.0' ✓  
 Cofferdam Earth = 168.6 FT² ✓

39+67.40 Beginning  
 (39+66.4 begin Substation)

Cofferdam Earth = 181.0 FT² ✓  
 Granular Backfill for Sill = 113.8 FT² (ahead) ✓ & 111.8 FT² (back) ✓  
 Unclassified Channel Exc = 54.2 FT² ✓  
 Stone Fill, Type III = 41.4 FT² ✓  
 Area Under Stone Fill = 18.5' ✓

39+70.00  
 39+71.5  
 39+72.0 section

NOTE: LOCATION OF SUBBASE IS APPROXIMATE.

PROJECT NAME: BRATTLEBORO  
 PROJECT NUMBER: BRO 1442(35)


FILE NAME: z10j062_customEL.dgn  
 PROJECT LEADER: S.E. BURBANK  
 DESIGNED BY: E.F. LAWES  
 ABUTMENT NO. 1 CROSS SECTIONS (2 OF 7)

PLOT DATE: 3/2/2015  
 DRAWN BY: E.F. LAWES  
 CHECKED BY: S.E. BURBANK  
 SHEET 18 OF 28




SCALE 1" = 3'-0"

598  
27

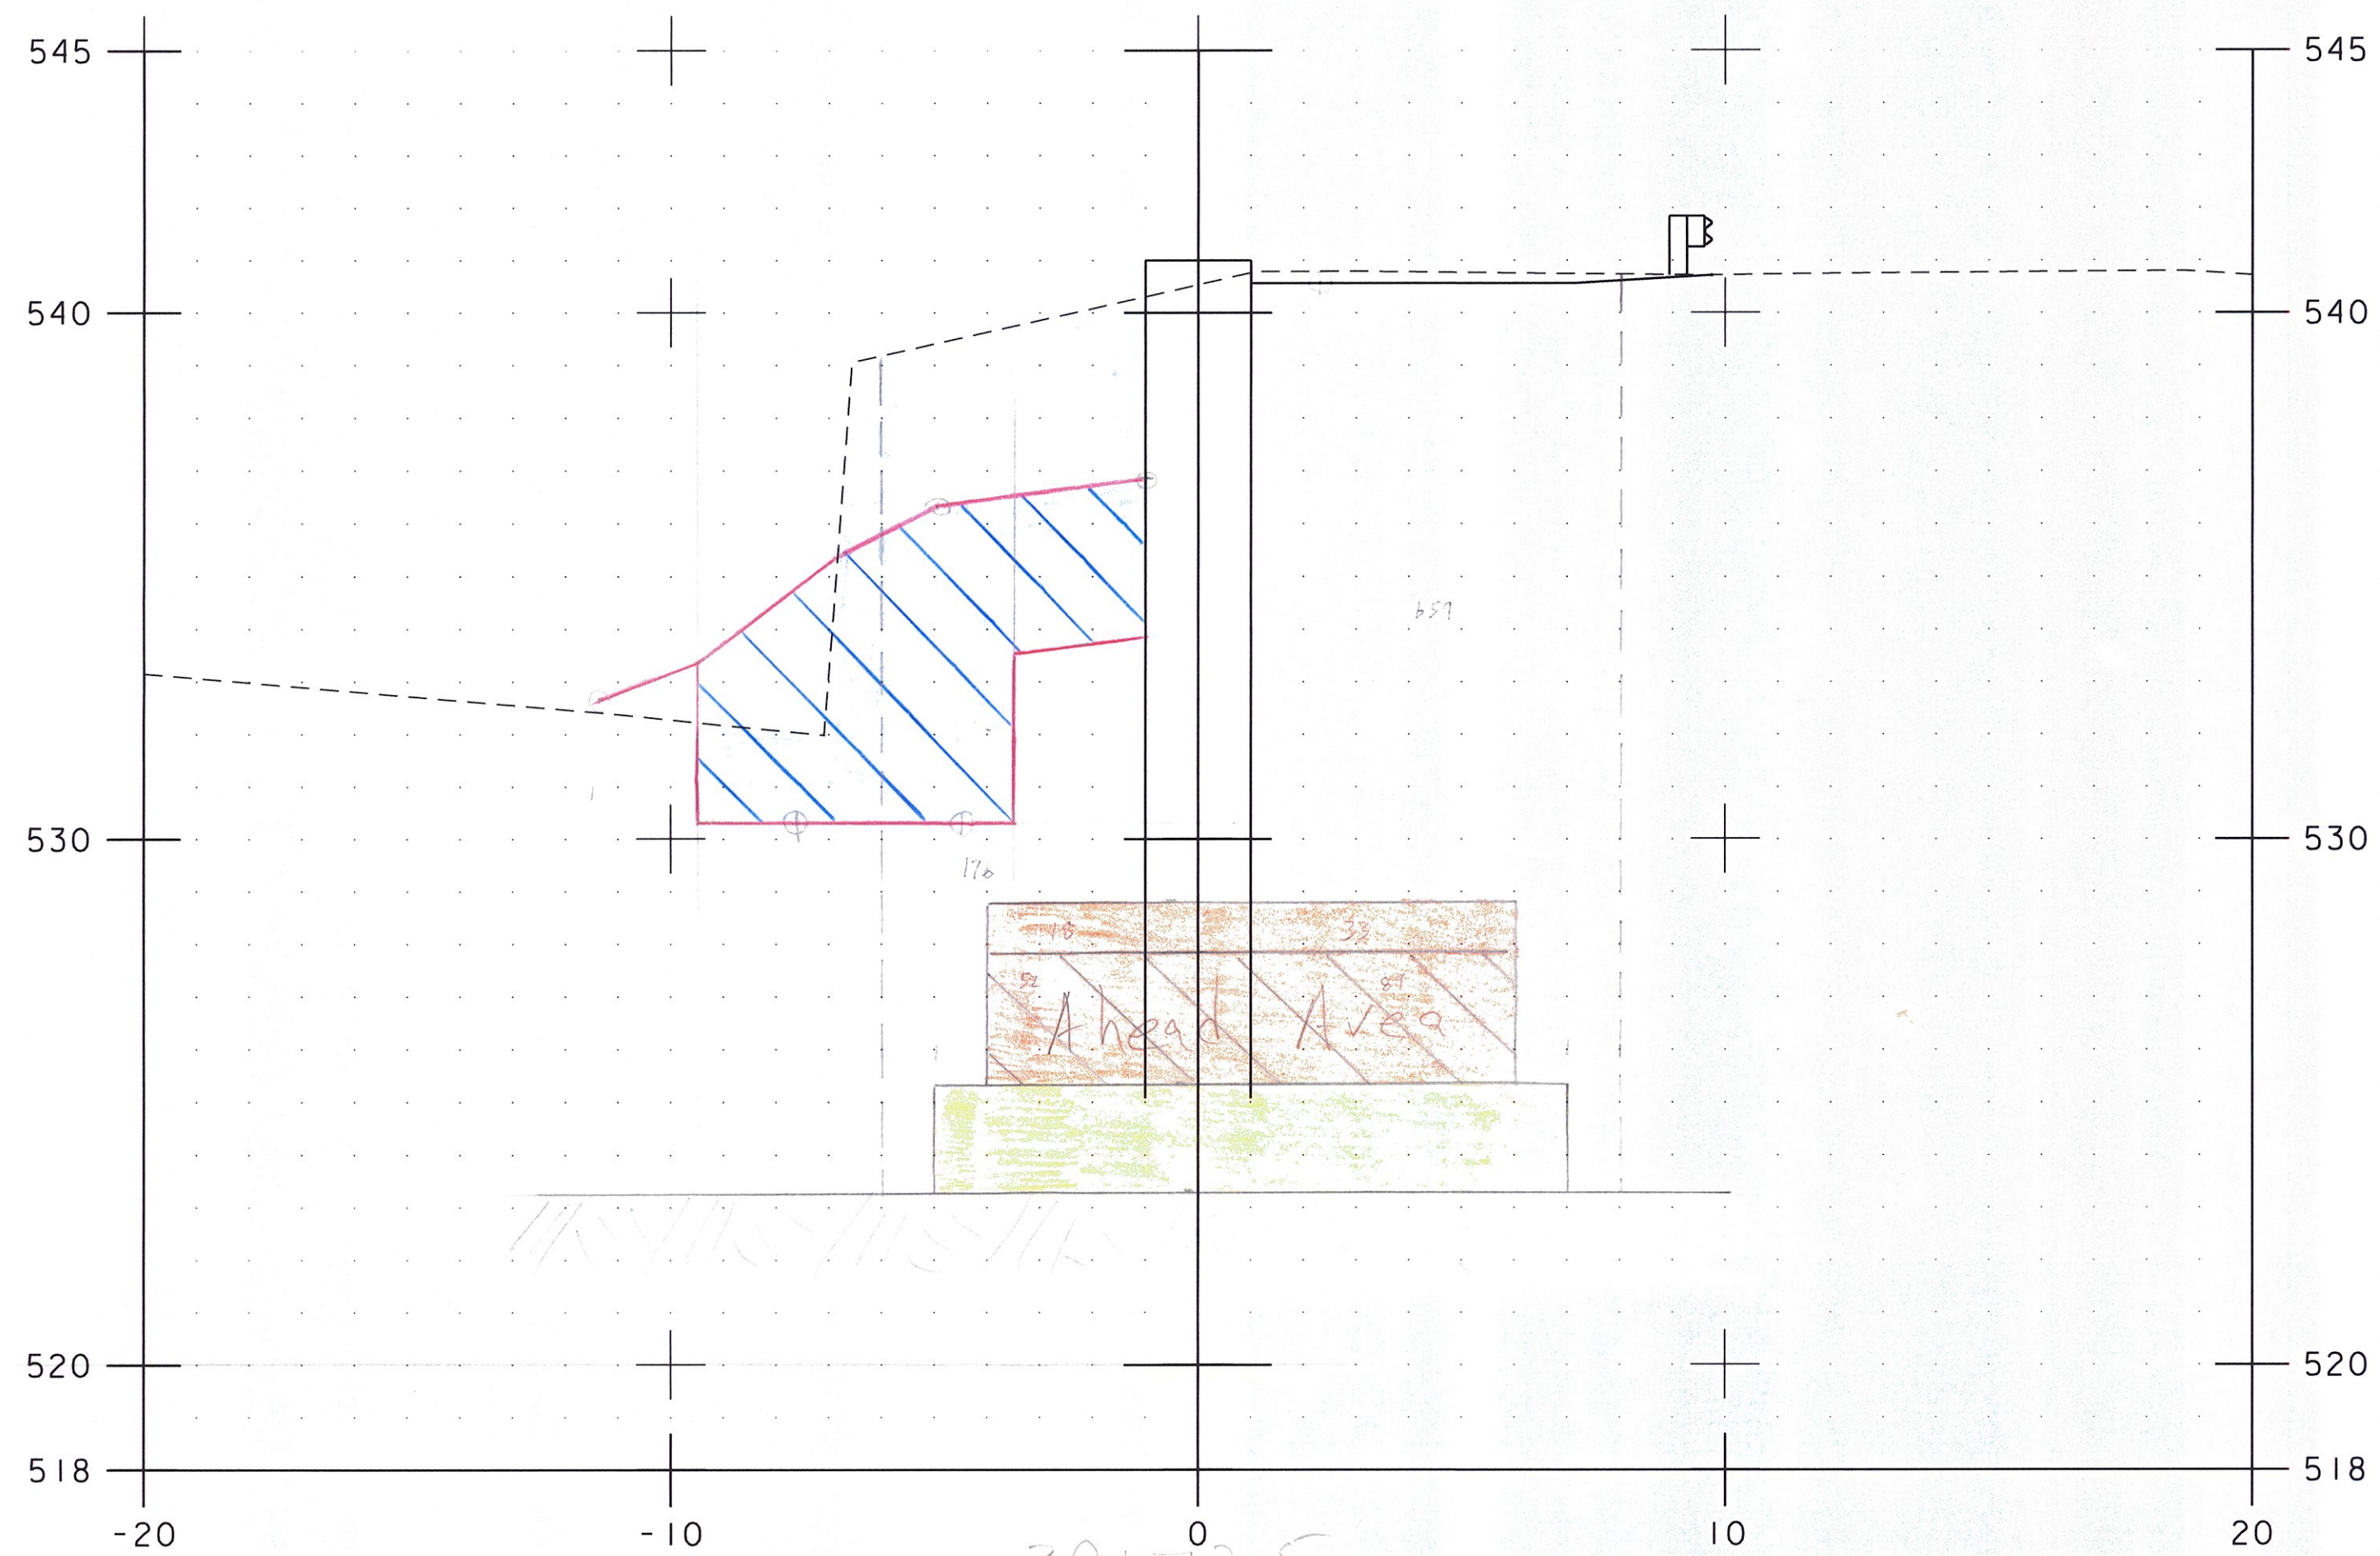

39+73.5  
use section  
39+75.00

Collar on Canal = 193.1 FT ✓  
 116.3 FT ✓  
 144.2 FT ✓  
 Unrelieved Canal Excavation = 5.0 FT ✓  
 Stone Fill, Type II = 2.4 FT ✓  
 Green Stone Spill Fill = 1.8 FT ✓  
 Concrete Excavation = 1.6 FT ✓  
 (1/4" S/12" S)

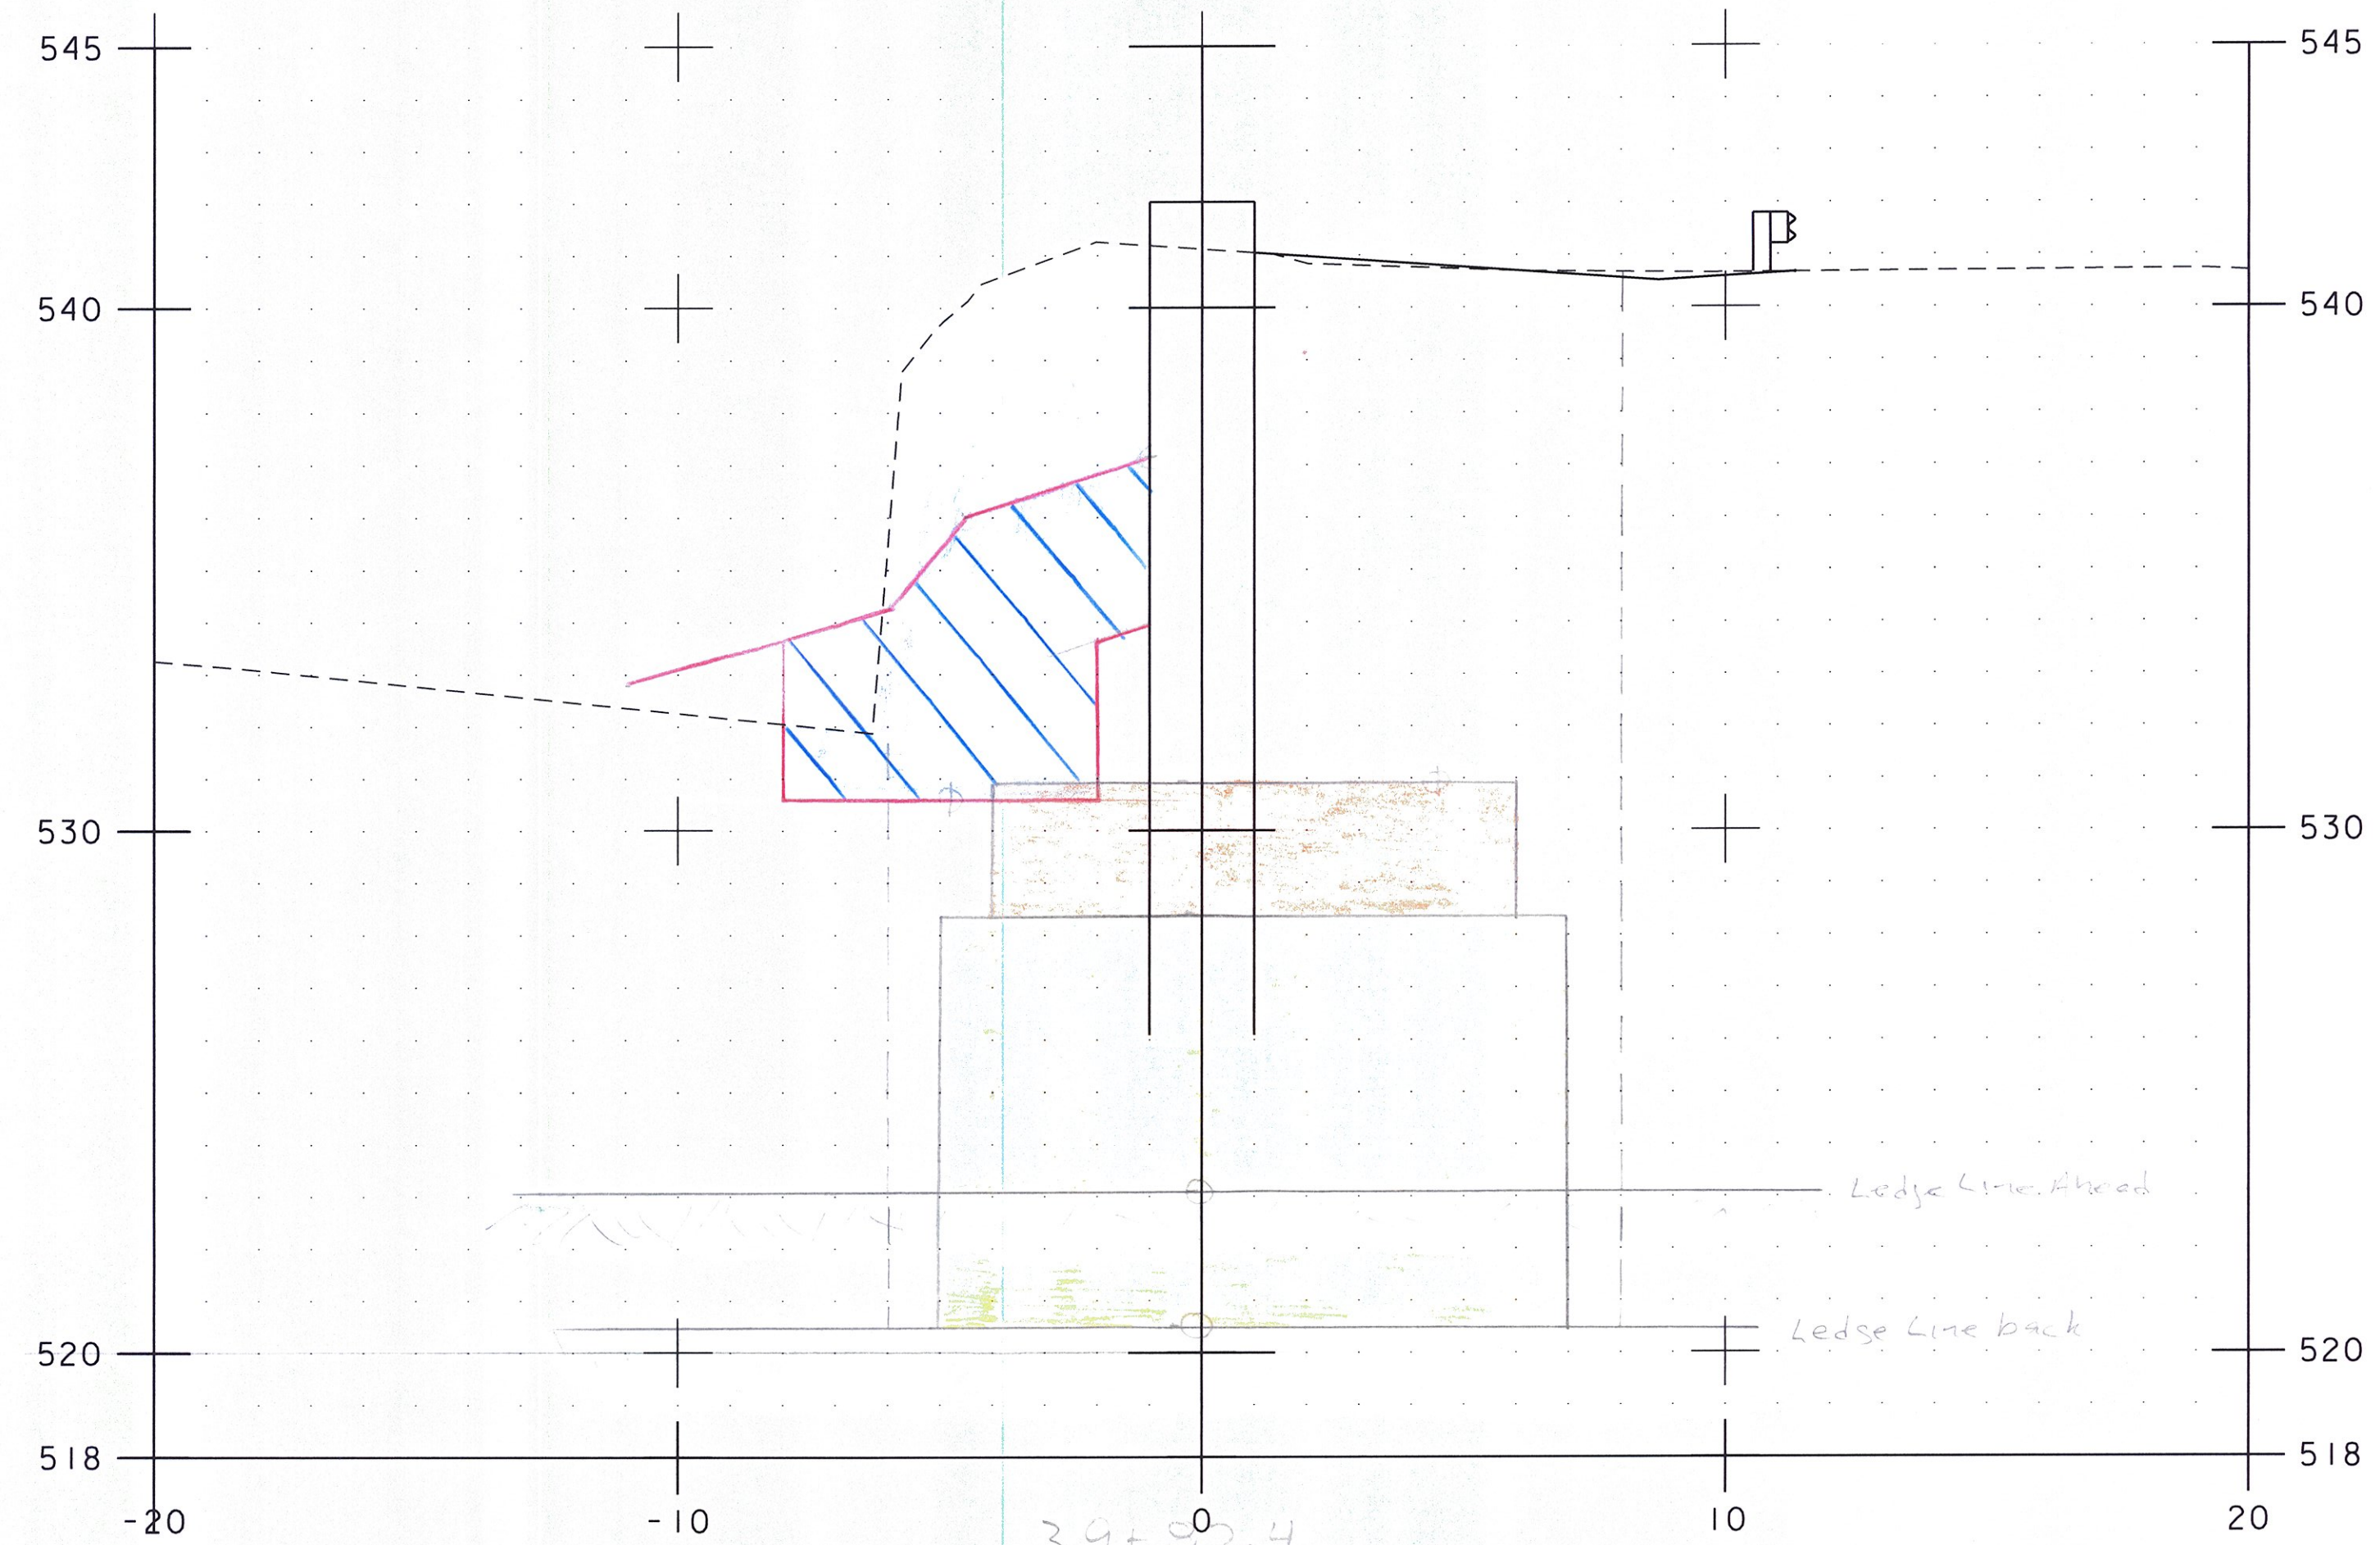

39+82.4  
use section  
39+80.00


Collar on Canal  
 (BA) = 201.5 FT ✓  
 (CA) = 116.3 FT ✓  
 Unrelieved Canal Excavation  
 (CA) = 5.0 FT ✓  
 (CB) = 2.4 FT ✓  
 (CA) = 100.1 FT ✓  
 (CB) = 92.9 FT ✓  
 Stone Fill, Type II = 2.4 FT ✓  
 Green Stone Spill Fill = 1.8 FT ✓  
 Concrete Excavation = 1.6 FT ✓  
 (1/4" S/12" S)

NOTE: LOCATION OF SUBBASE IS APPROXIMATE.

PROJECT NAME: BRATTLEBORO	
PROJECT NUMBER: BRO 1442(35)	
FILE NAME: z10j062_customEL.dgn	PLOT DATE: 3/2/2015
PROJECT LEADER: S.E. BURBANK	DRAWN BY: E.F. LAWES
DESIGNED BY: E.F. LAWES	CHECKED BY: S.E. BURBANK
ABUTMENT NO. 1 CROSS SECTIONS (3 OF 7)	SHEET 19 OF 28




SCALE 1" = 3'-0"

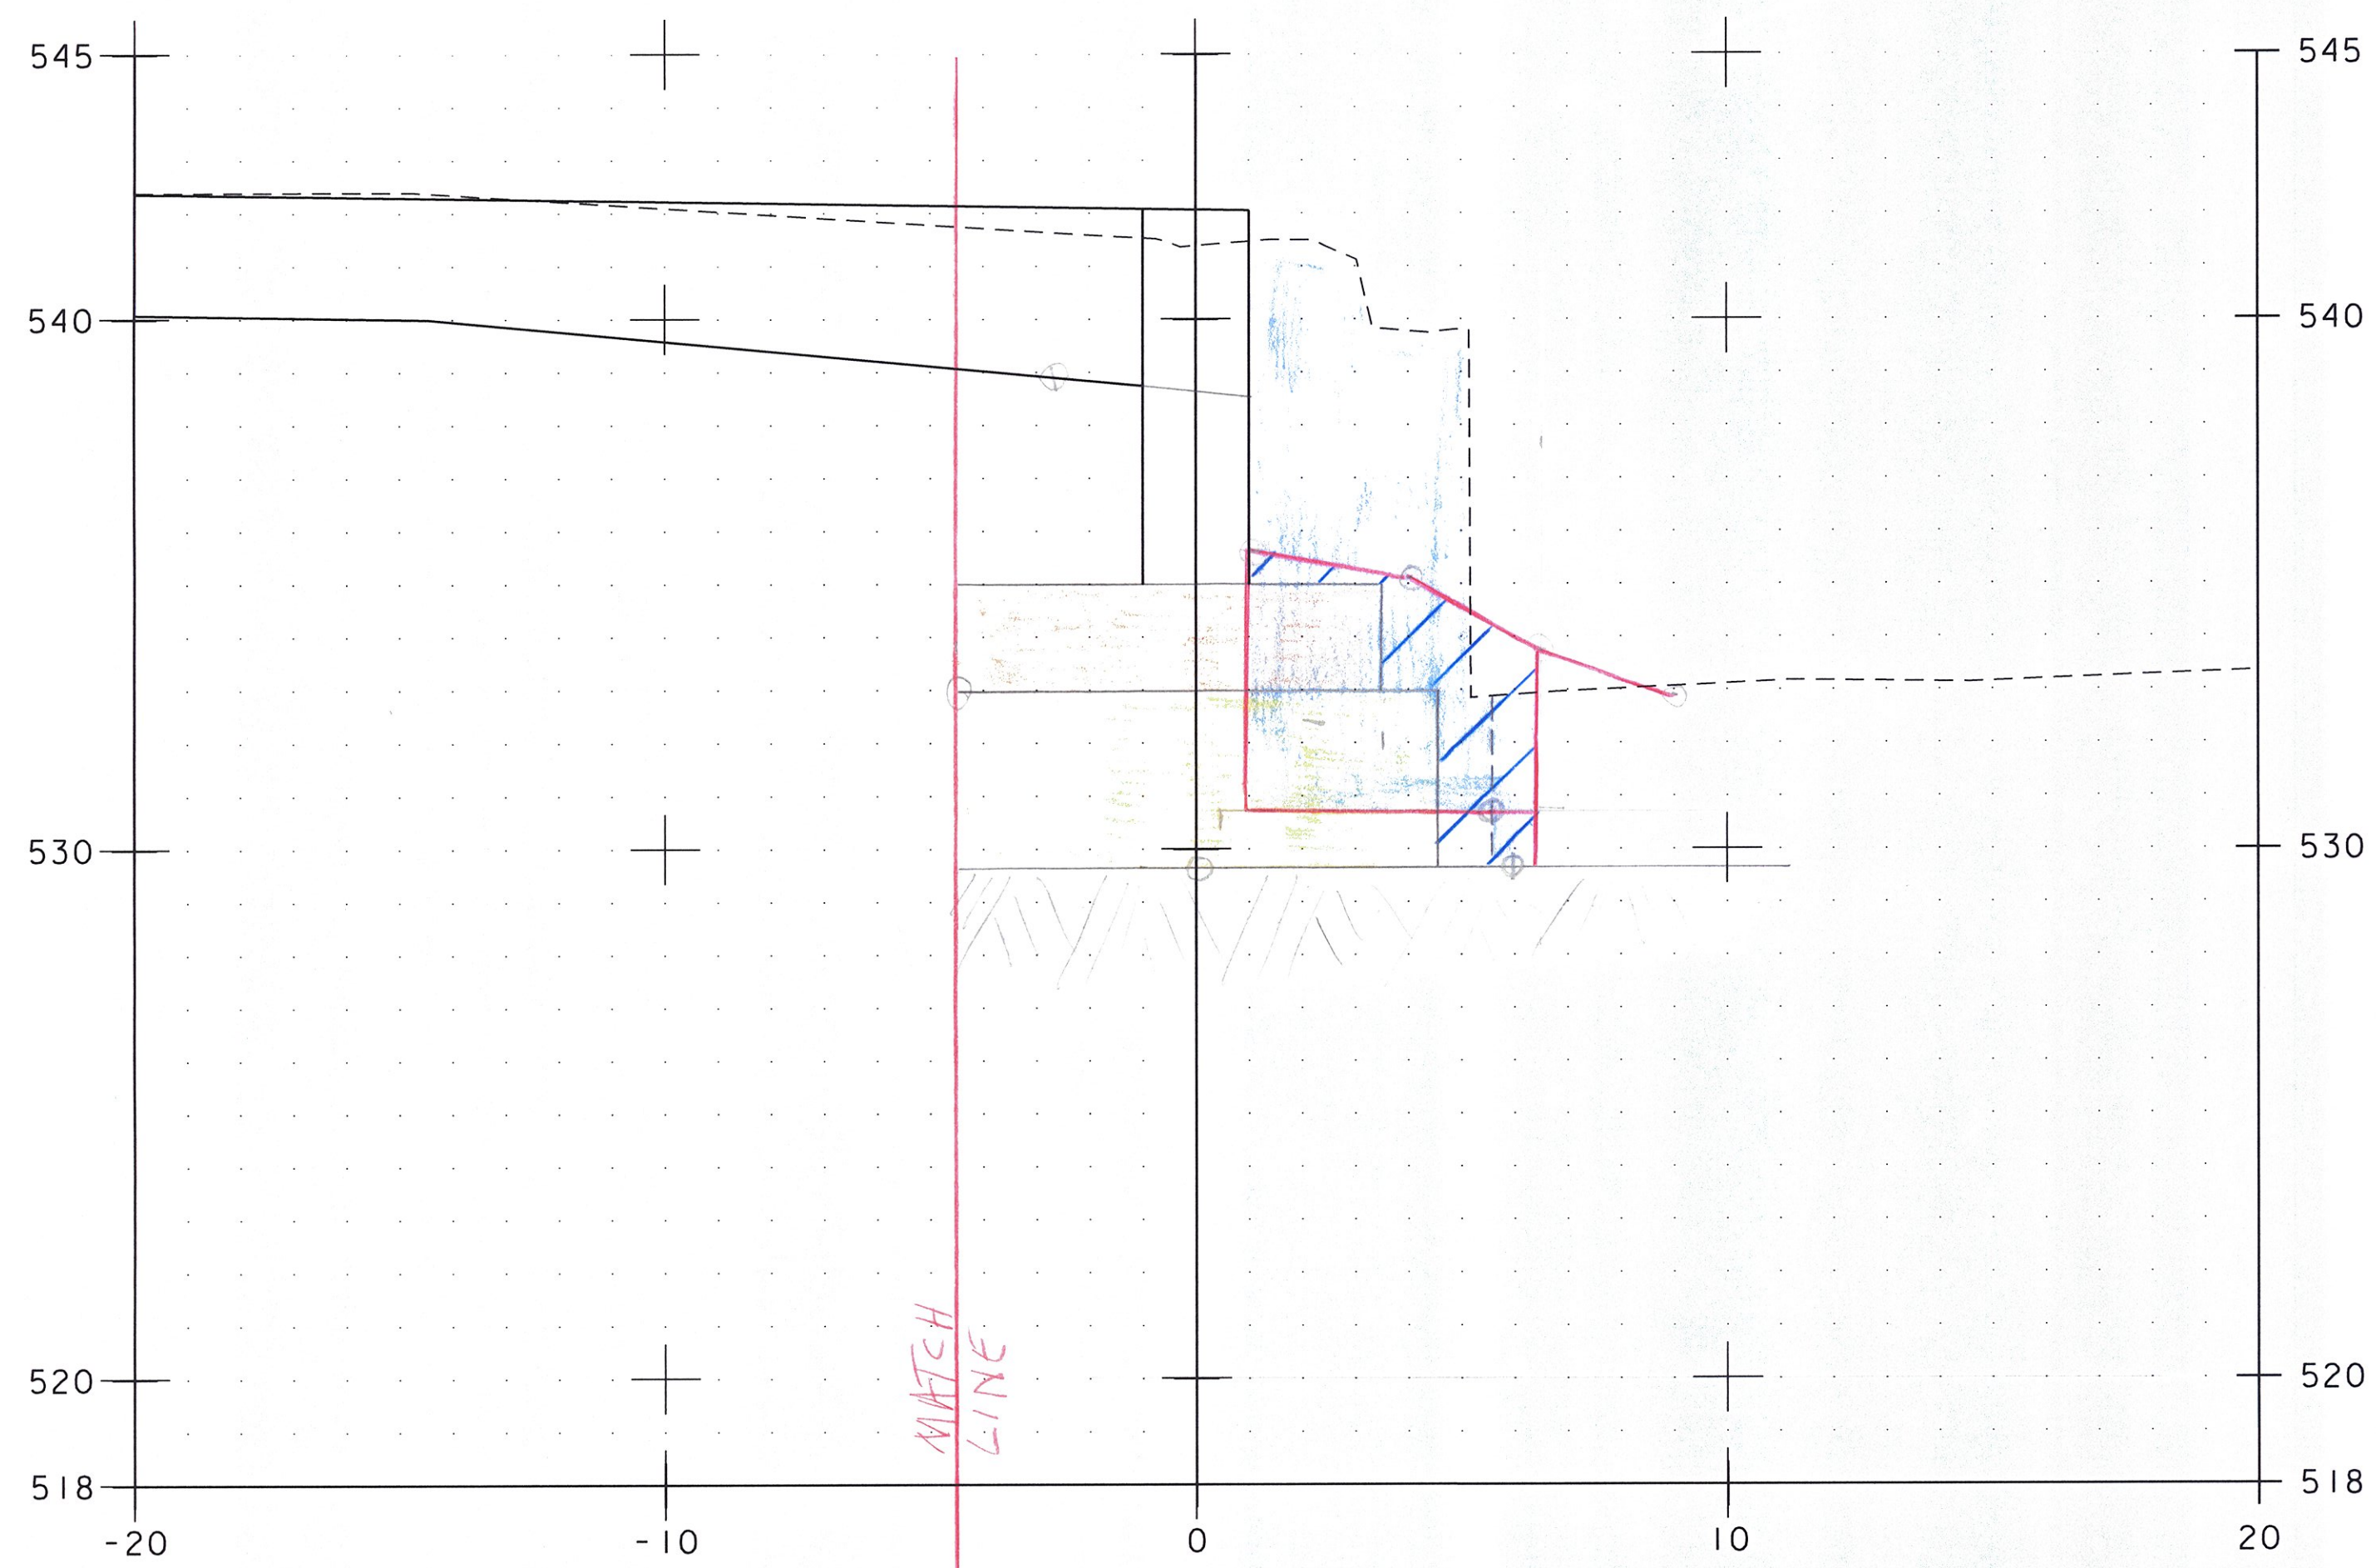

Cofferdam Earth = 539 FT² ✓  
 Greater Backfill for Spillway = 19.57 ✓  
 Unexcavated Channel Exc = 404 FT² ✓  
 Stone Fill, Type III = 114 FT² ✓  
 Clean Under Stone Fill = 15" M.W.H. 6/26/15  
 Jmc 5/15/15

19+85.50

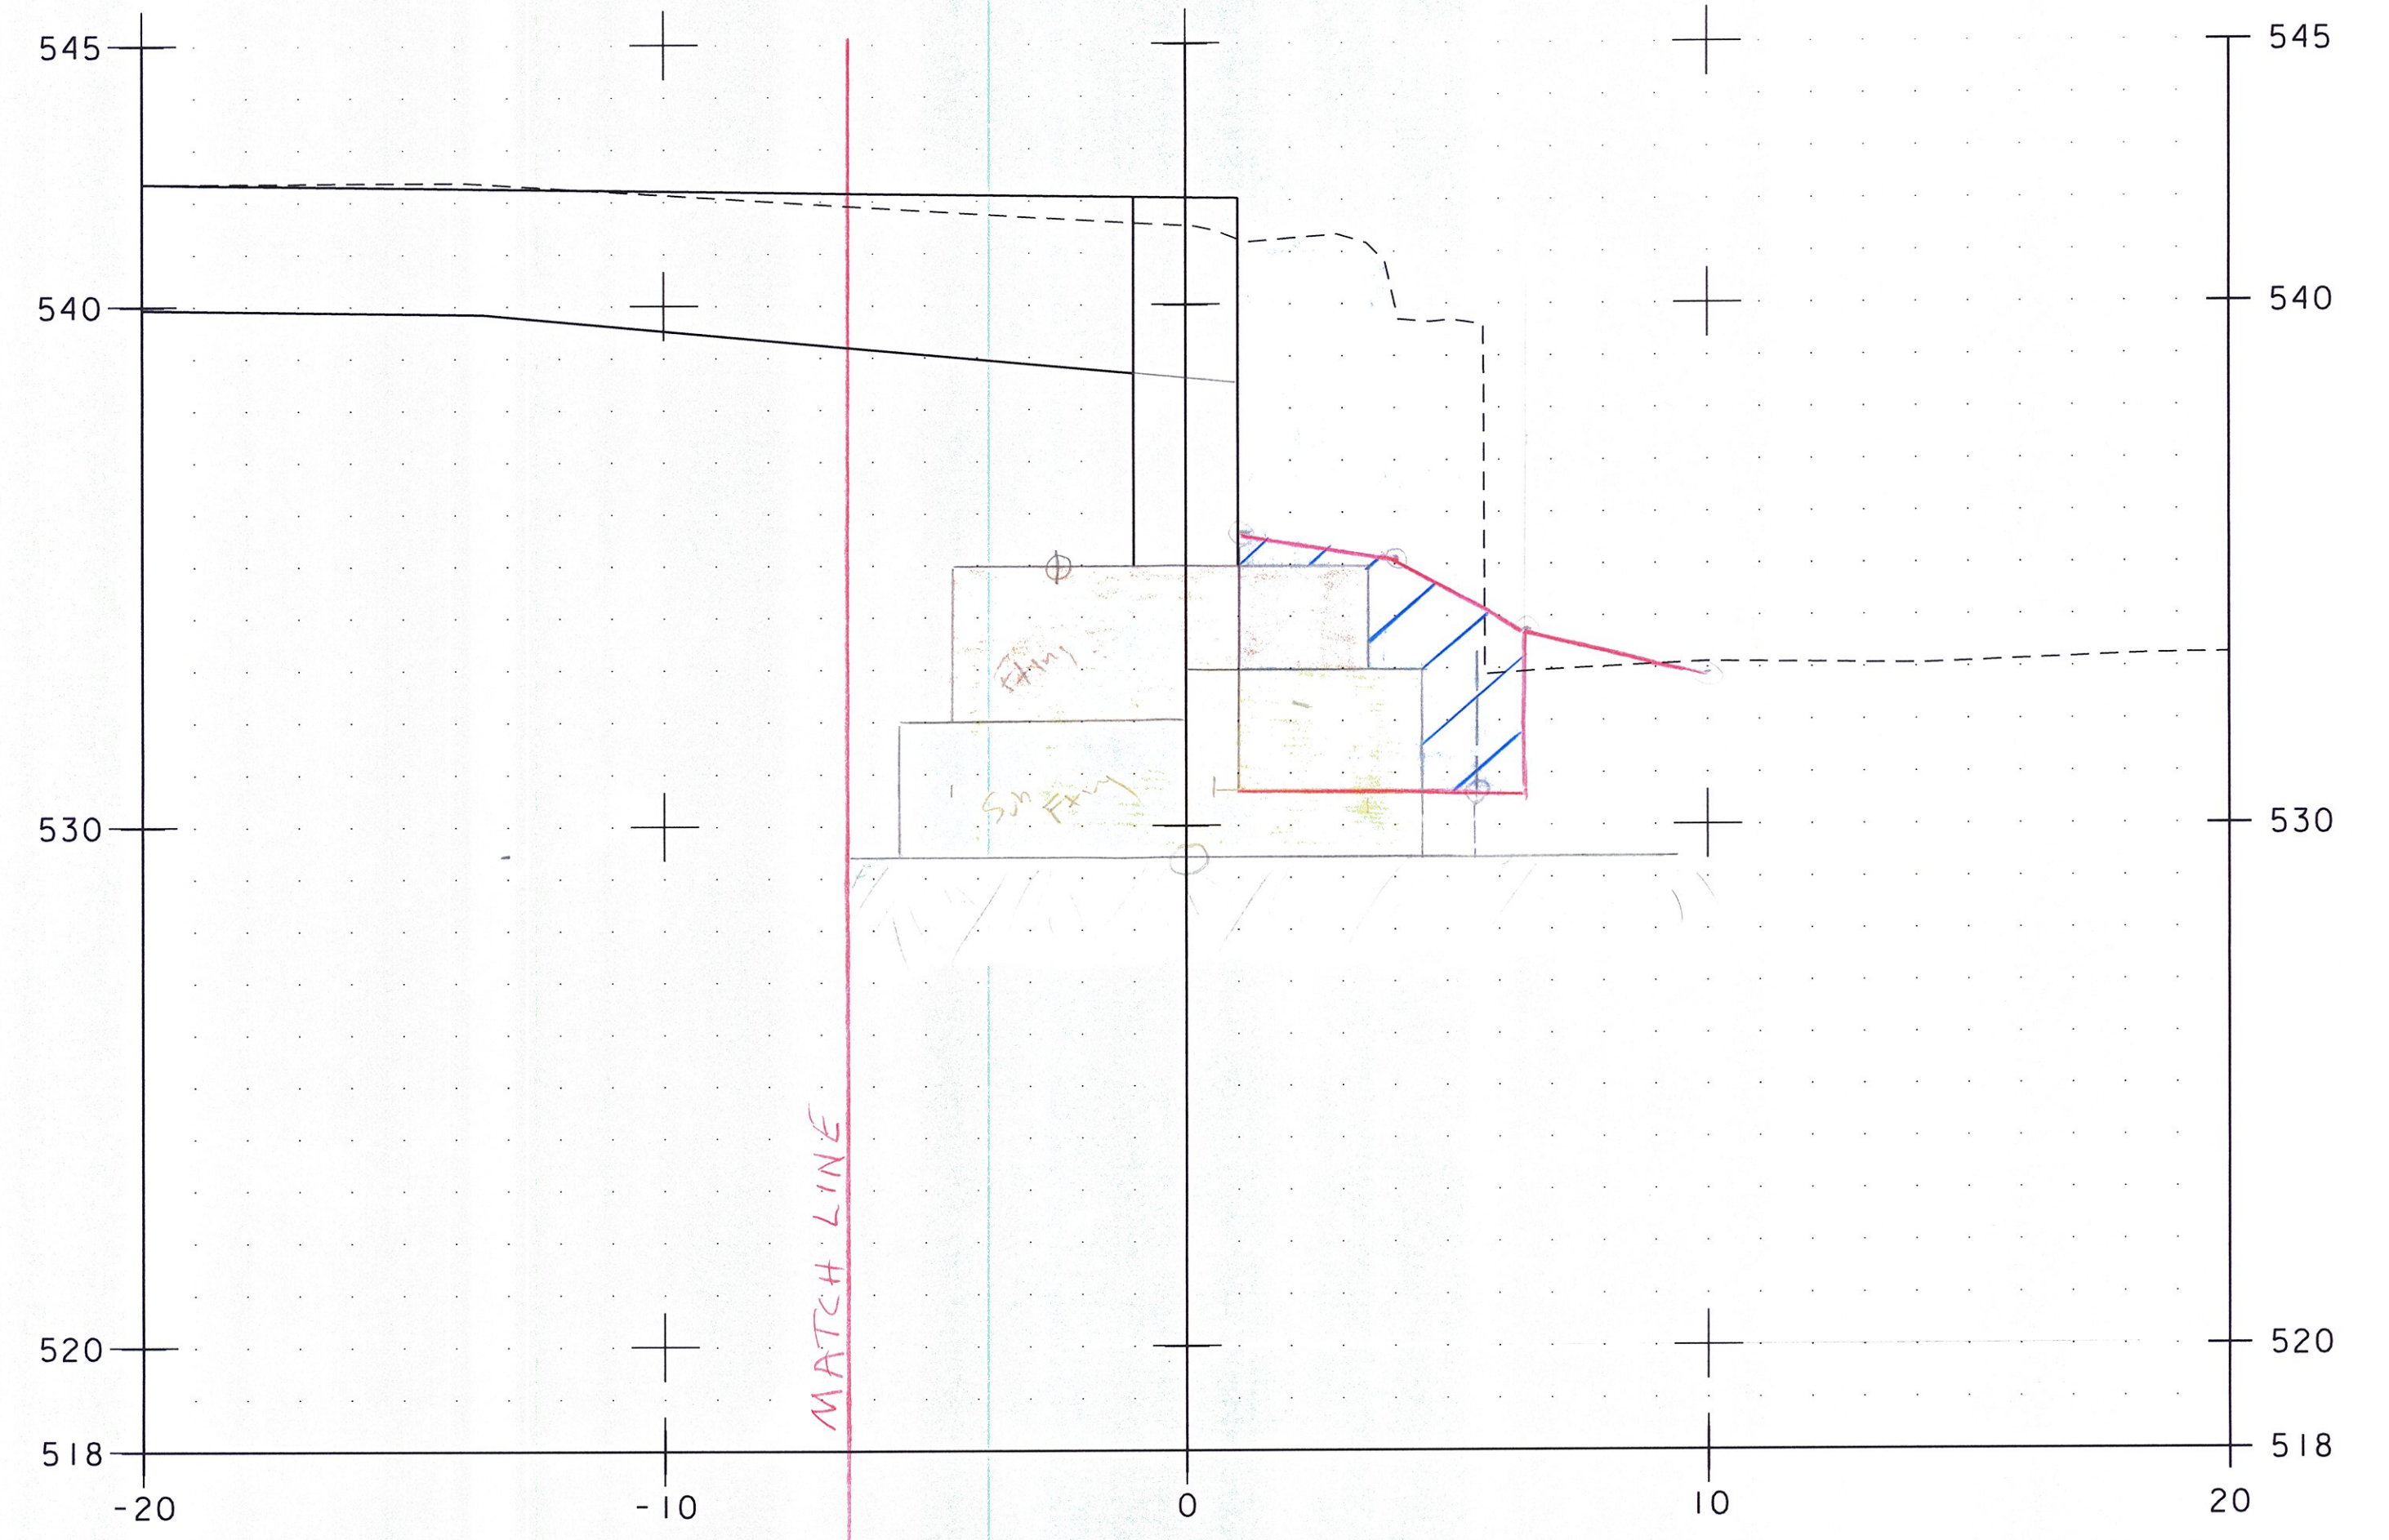

Cofferdam Earth = 763 FT² ✓  
 Greater Backfill for Spillway = 29.3 FT² ✓  
 M/U Unexcavated Channel Exc = 404 FT² ✓  
 Stone Fill, Type III = 101 FT² ✓  
 Clean Under Stone Fill = 13.5" M.W.H. 6/26/15  
 Jmc 5/15/15


19+86.50

NOTE: LOCATION OF SUBBASE IS APPROXIMATE, PROPOSED GRADE IS NOT SHOWN.


PROJECT NAME:	BRATTLEBORO
PROJECT NUMBER:	BRO 1442(35)
FILE NAME:	z10j062_customEL.dgn
PROJECT LEADER:	S.E. BURBANK
DESIGNED BY:	E.F. LAWES
ABUTMENT NO. 2 CROSS SECTIONS (2 OF 9)	SHEET 2 OF 28
PLOT DATE:	3/2/2015
DRAWN BY:	E.F. LAWES
CHECKED BY:	S.E. BURBANK

SCALE 1" = 3'-0"



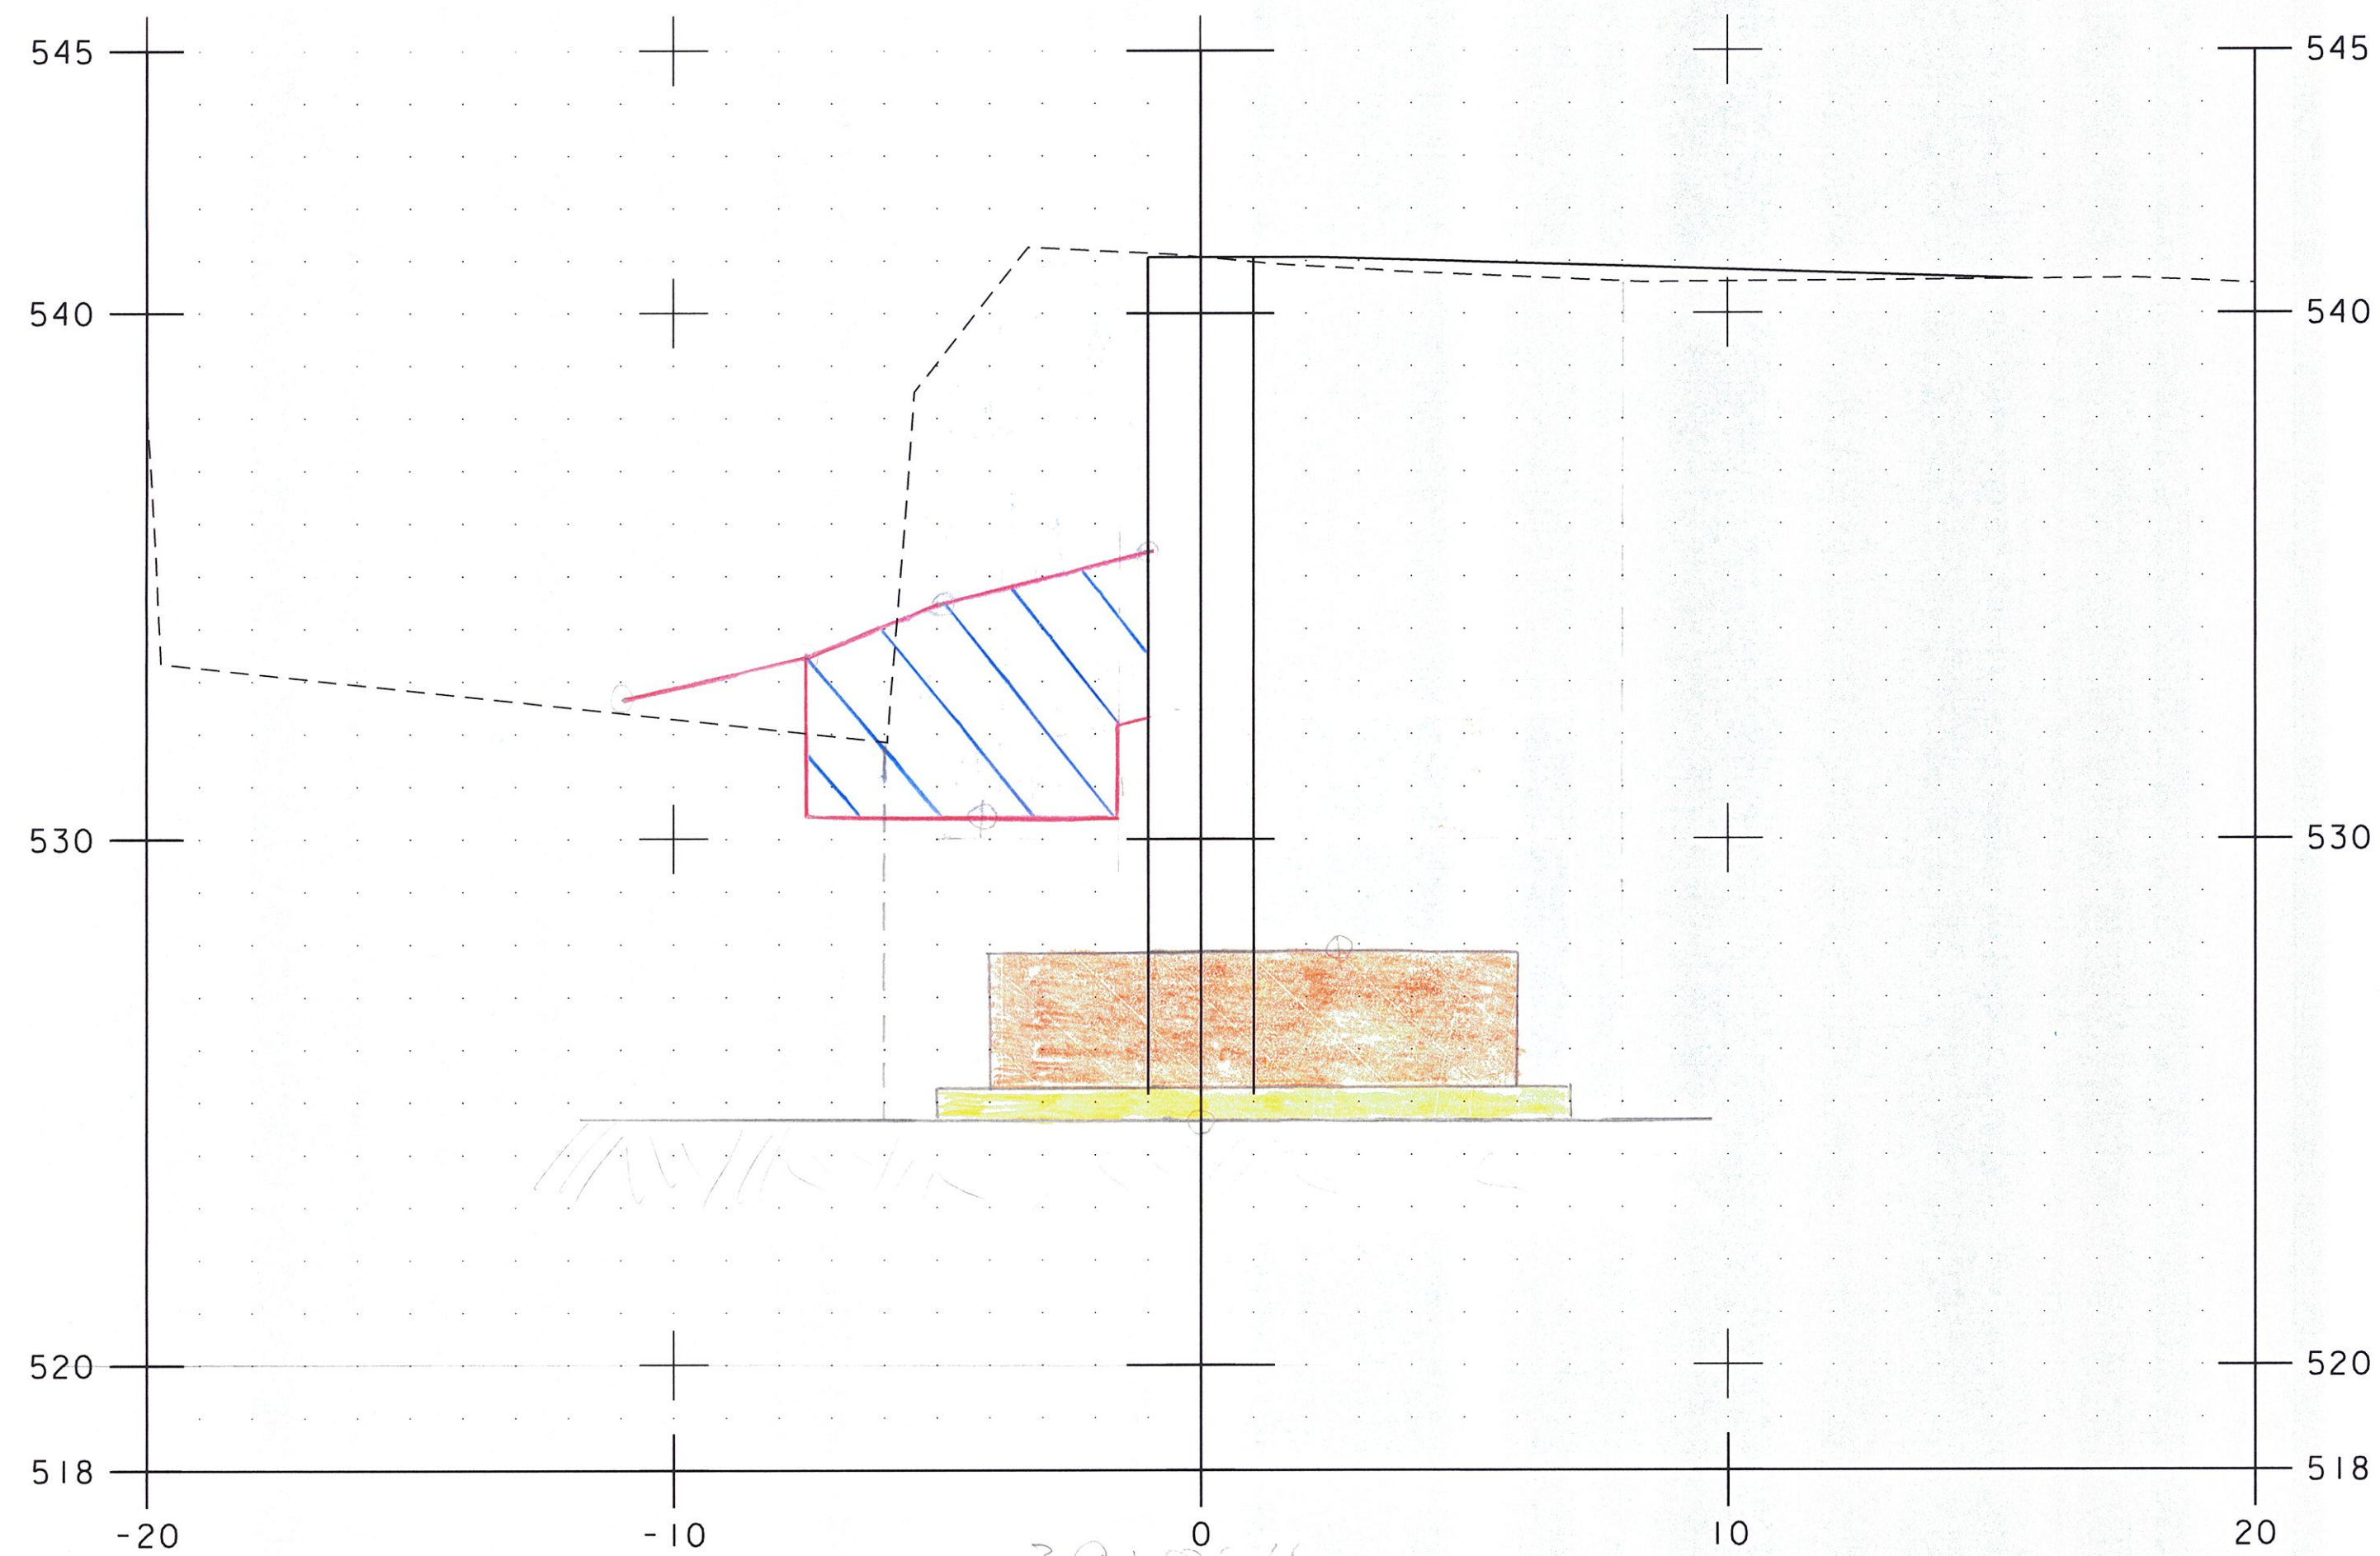

39+86.4  
 use Section  
**39+85.00**  
 Cofferdam Earth = 173.5 FT ✓  
 Granddike Subbase = 12.2 FT ✓  
 Granddike Subbase = 45.4 FT ✓  
 Subbase = 25.9 FT ✓  
 Granddike Subbase = 14.5 FT ✓  
 finished

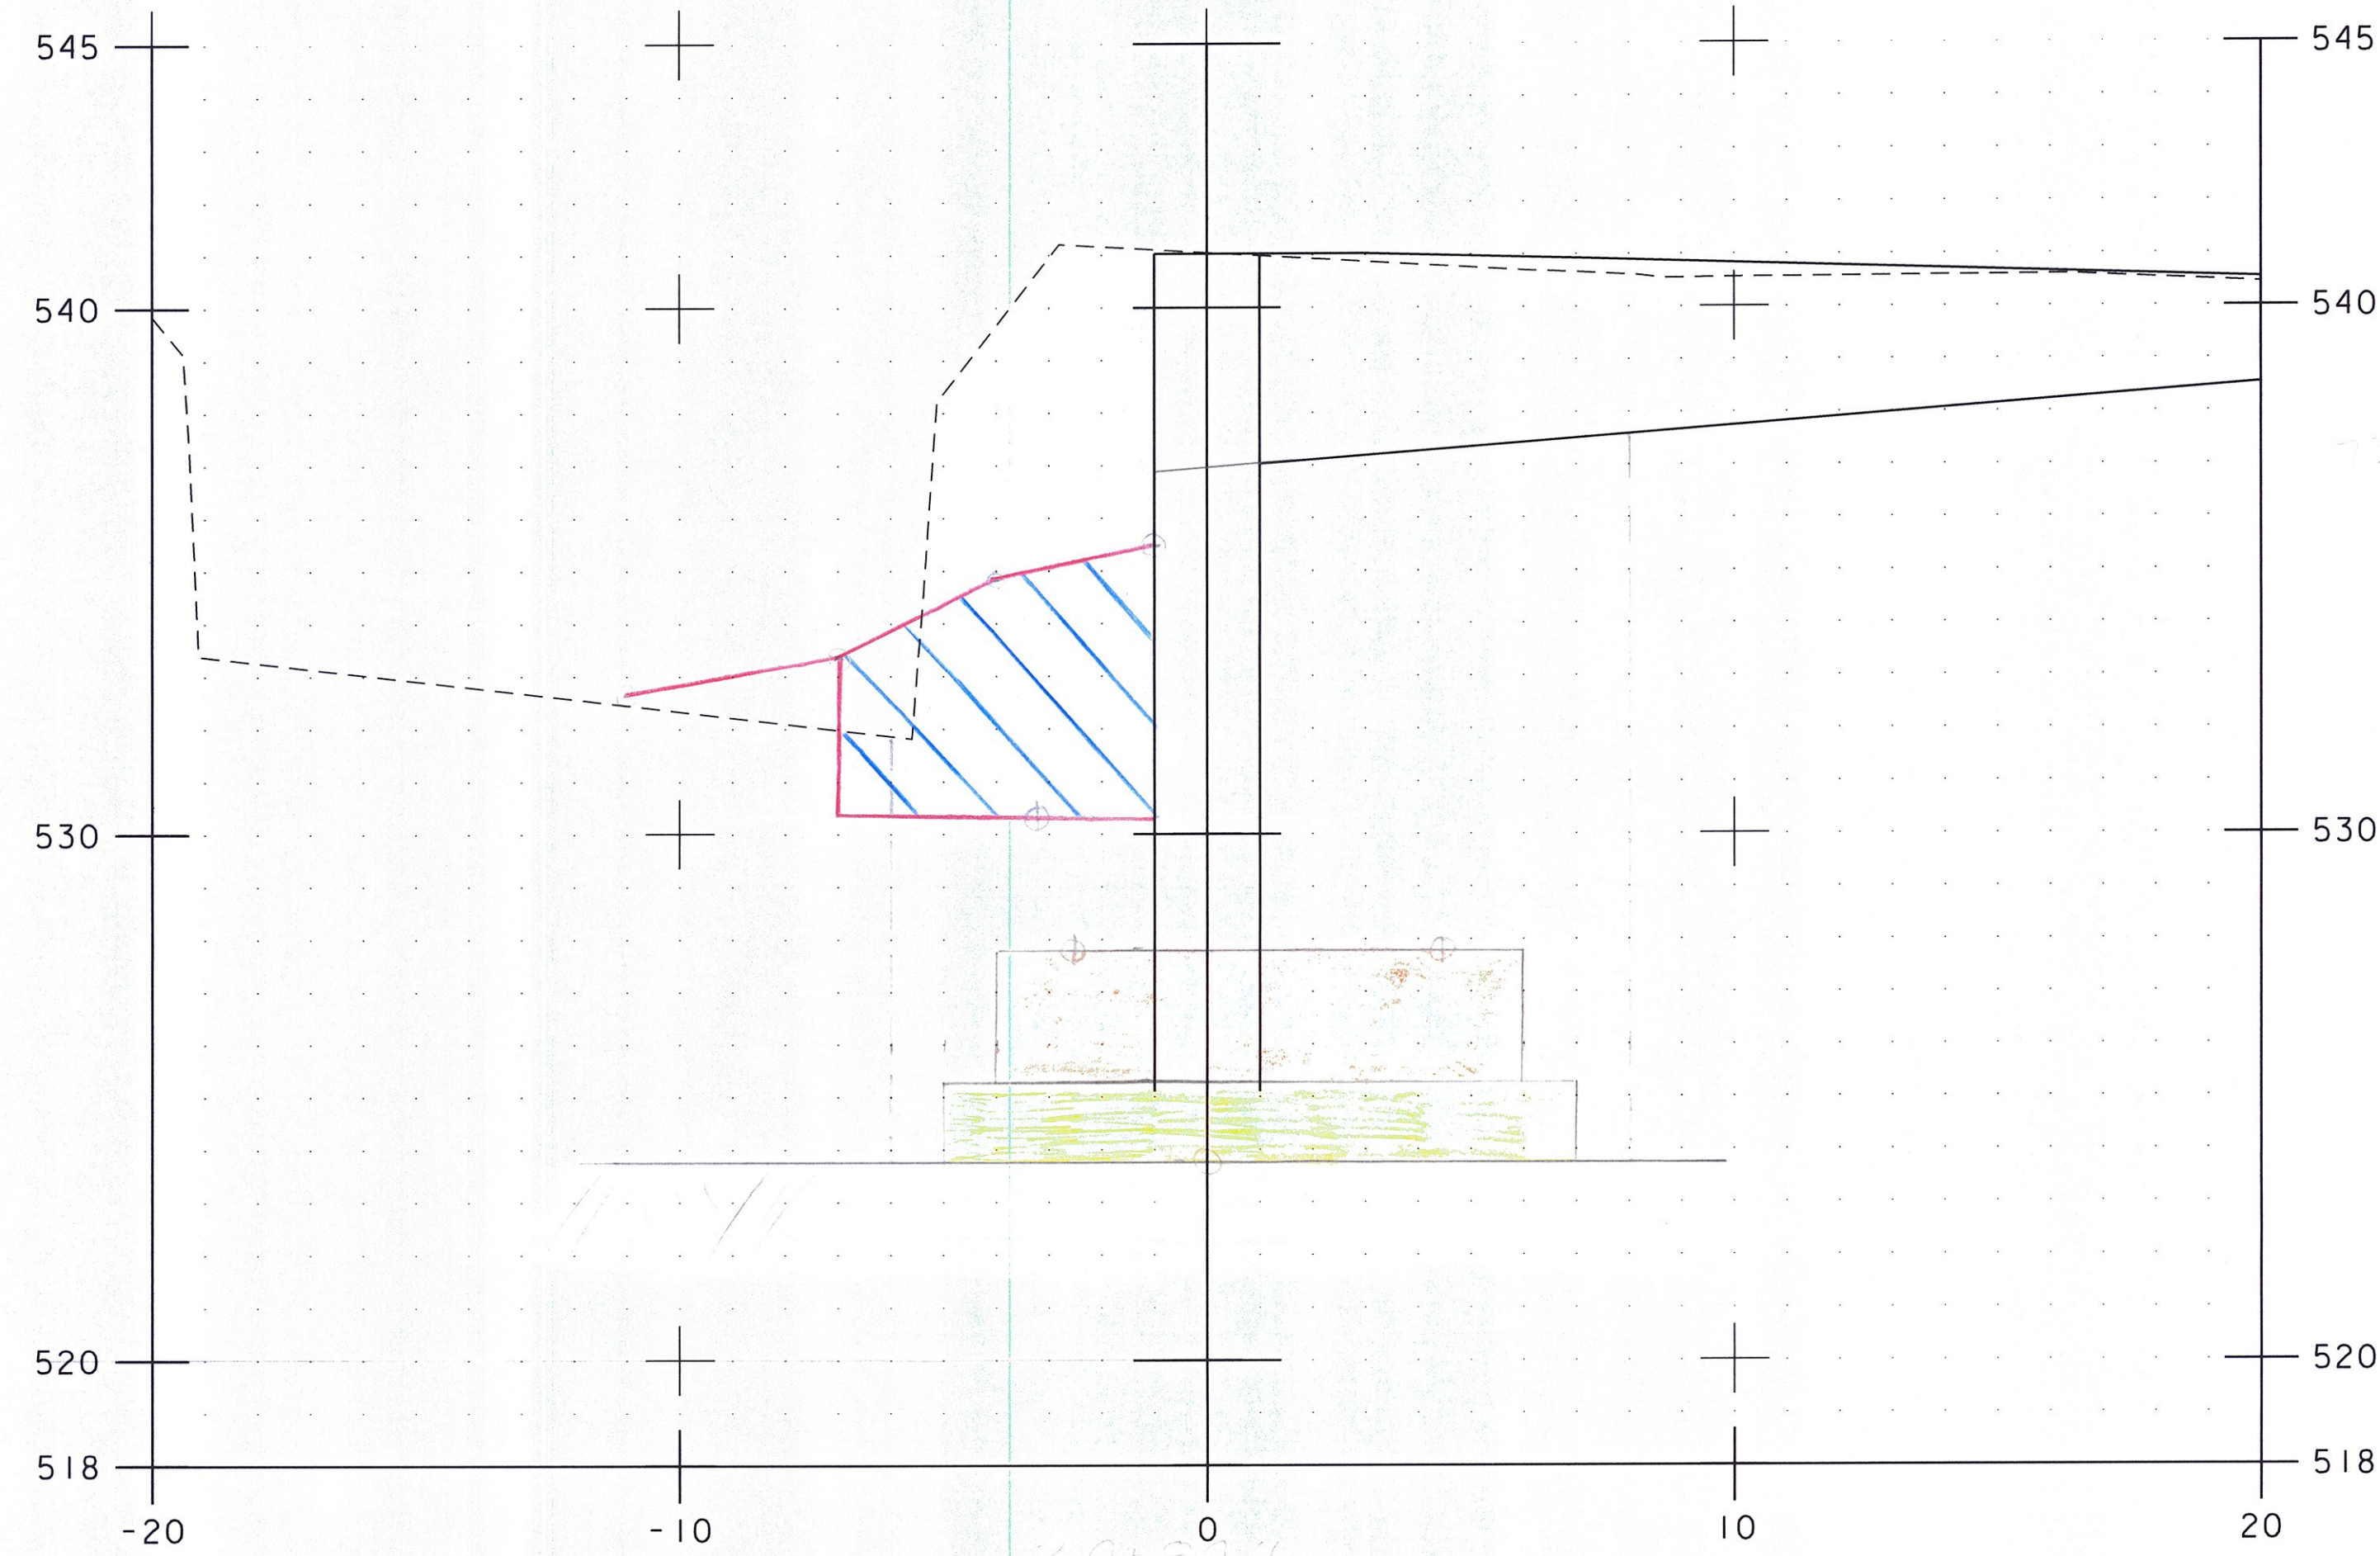

39+90.4  
 use Section  
**39+90.00**  
 Cofferdam Earth = 15.2 FT ✓  
 Granddike Subbase = 12.2 FT ✓  
 Granddike Subbase = 45.4 FT ✓  
 Subbase = 25.9 FT ✓  
 Granddike Subbase = 14.5 FT ✓  
 finished


SCALE 1" = 3'-0"

NOTE: LOCATION OF SUBBASE IS APPROXIMATE.

PROJECT NAME: BRATTLEBORO	
PROJECT NUMBER: BRO 1442(35)	
FILE NAME: z10j062_customEL.dgn	PLOT DATE: 3/2/2015
PROJECT LEADER: S.E. BURBANK	DRAWN BY: E.F. LAWES
DESIGNED BY: E.F. LAWES	CHECKED BY: S.E. BURBANK
ABUTMENT NO. 1 CROSS SECTIONS (4 OF 7)	SHEET 20 OF 28




715

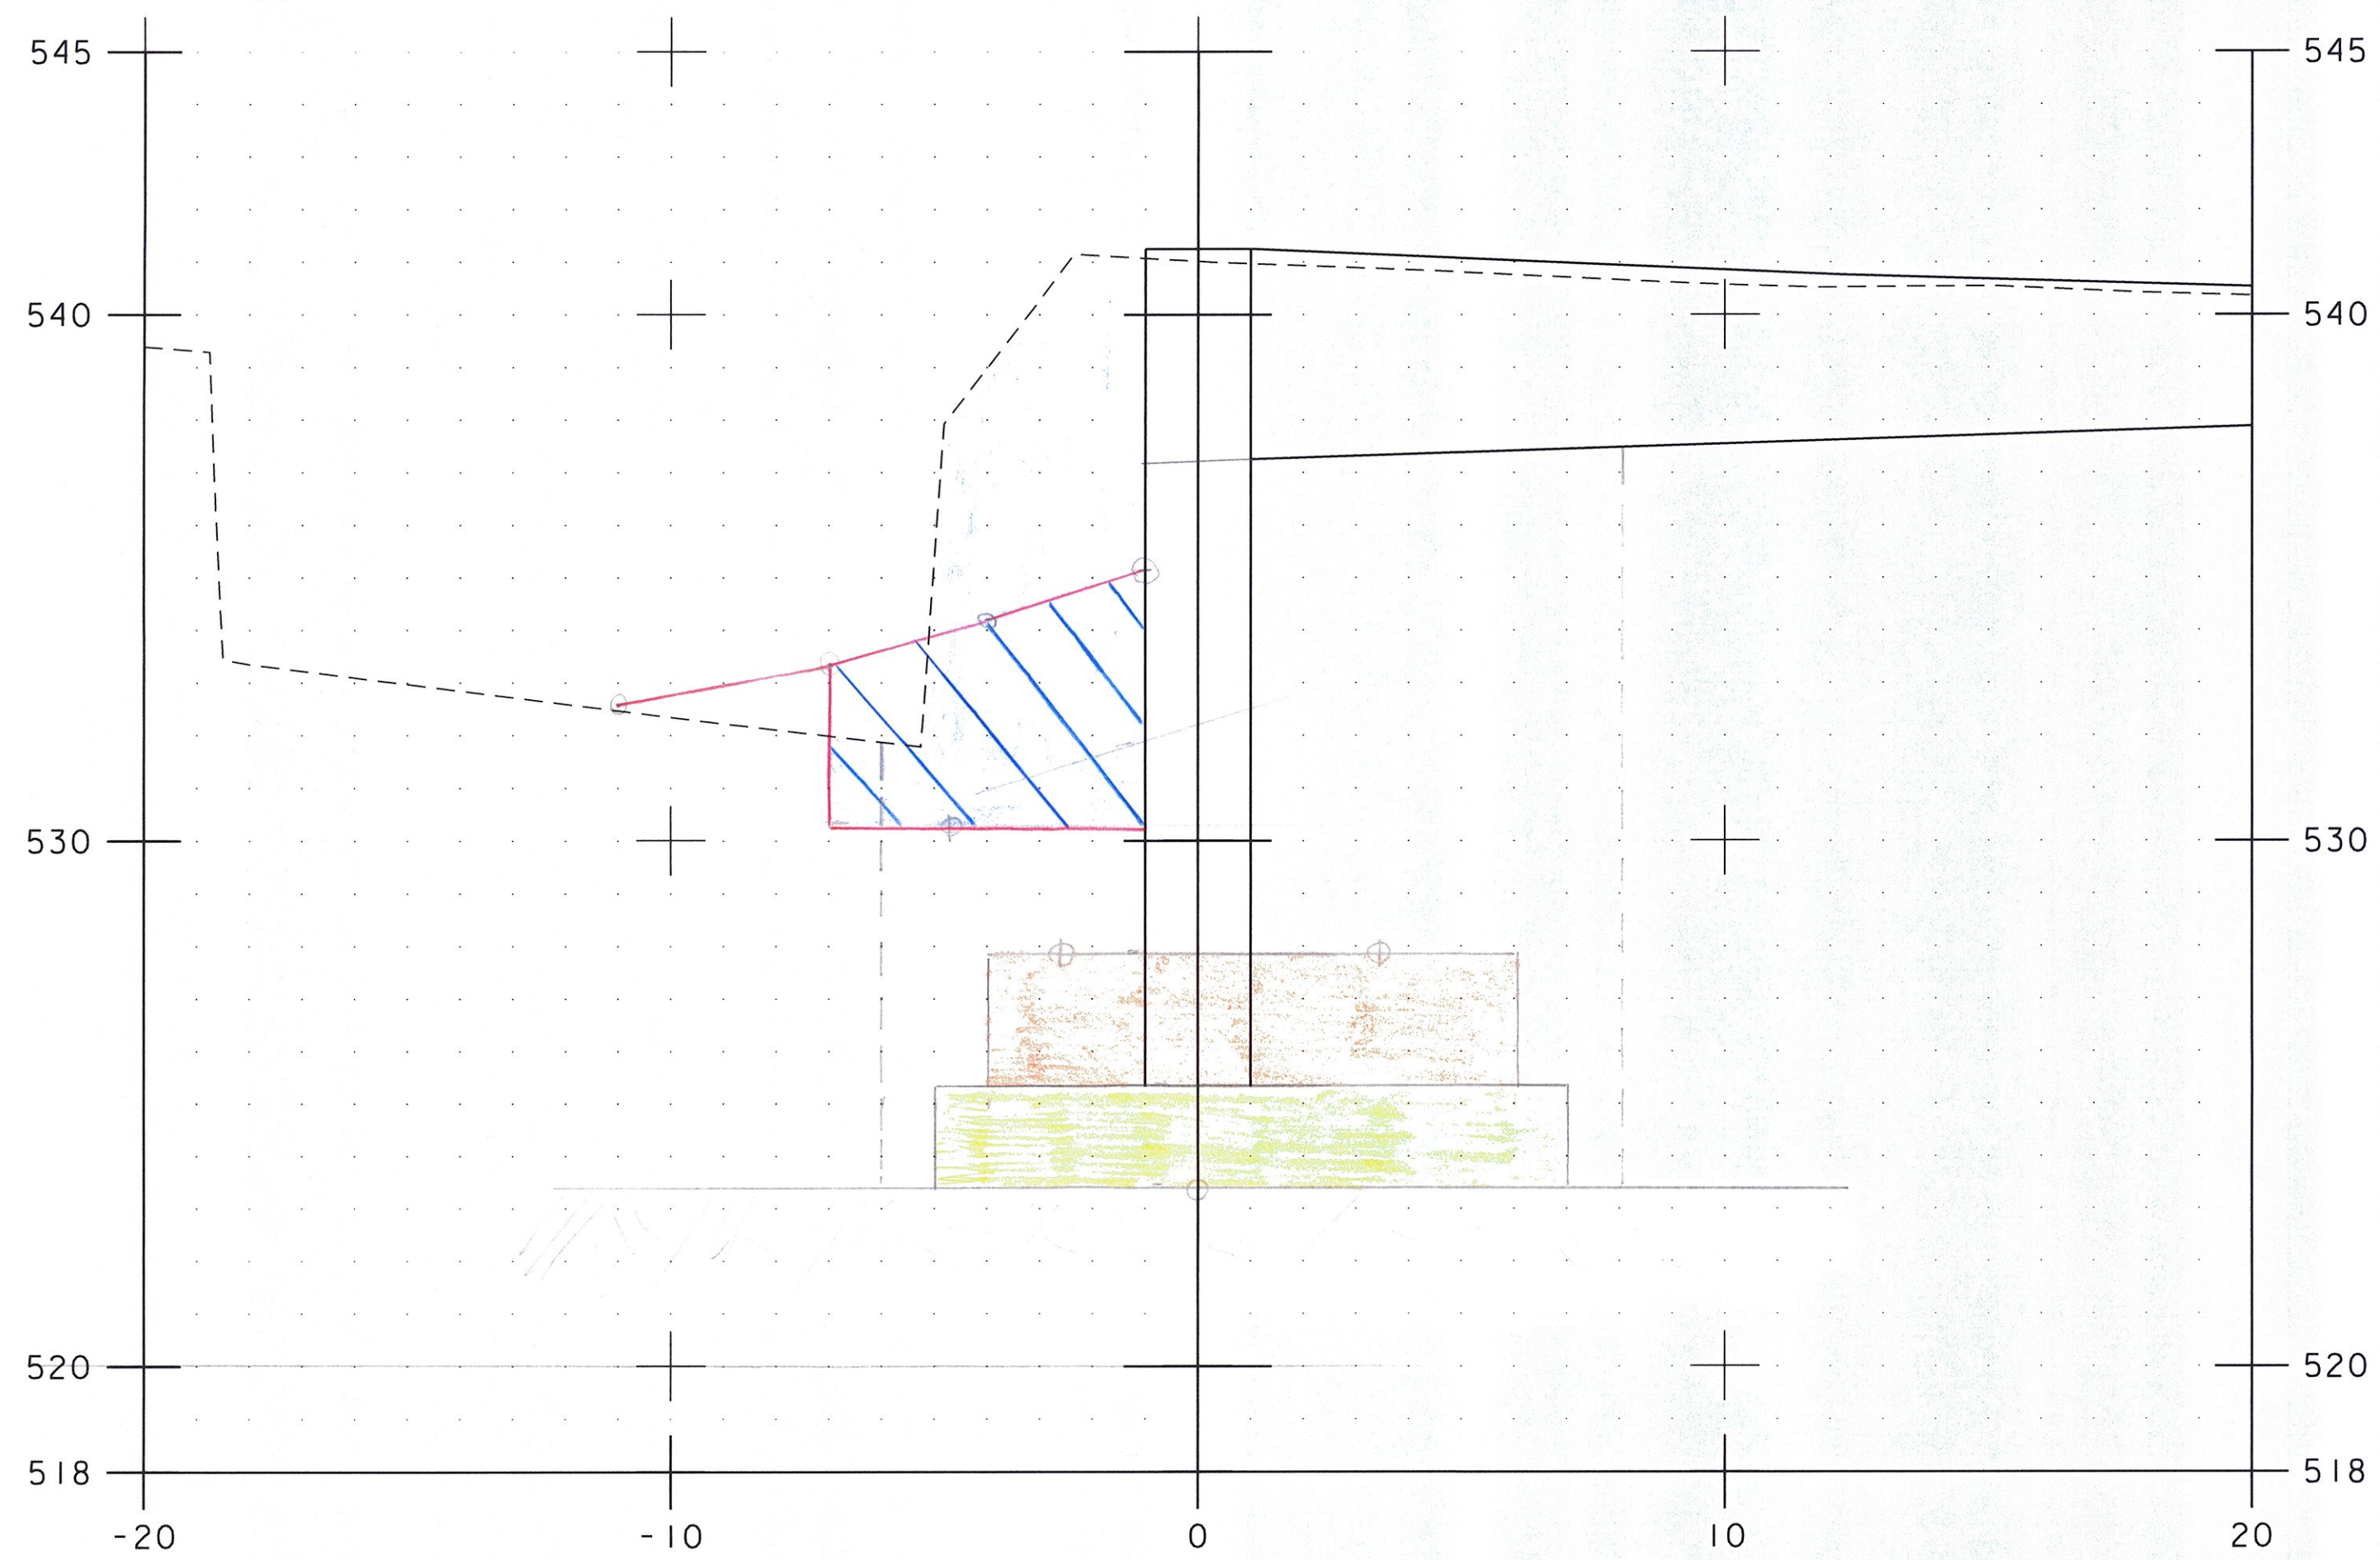

Confined Earth = 158.5 FT ✓  
 Granular Base for Structure = 9.0 FT ✓  
 Unconfined Subgrade = 4.3 FT ✓  
 Stone Fill, Type II = 0.0 FT ✓  
 Granular Stone Fill = 14' ✓  
 for 5/3/15

39+95.00

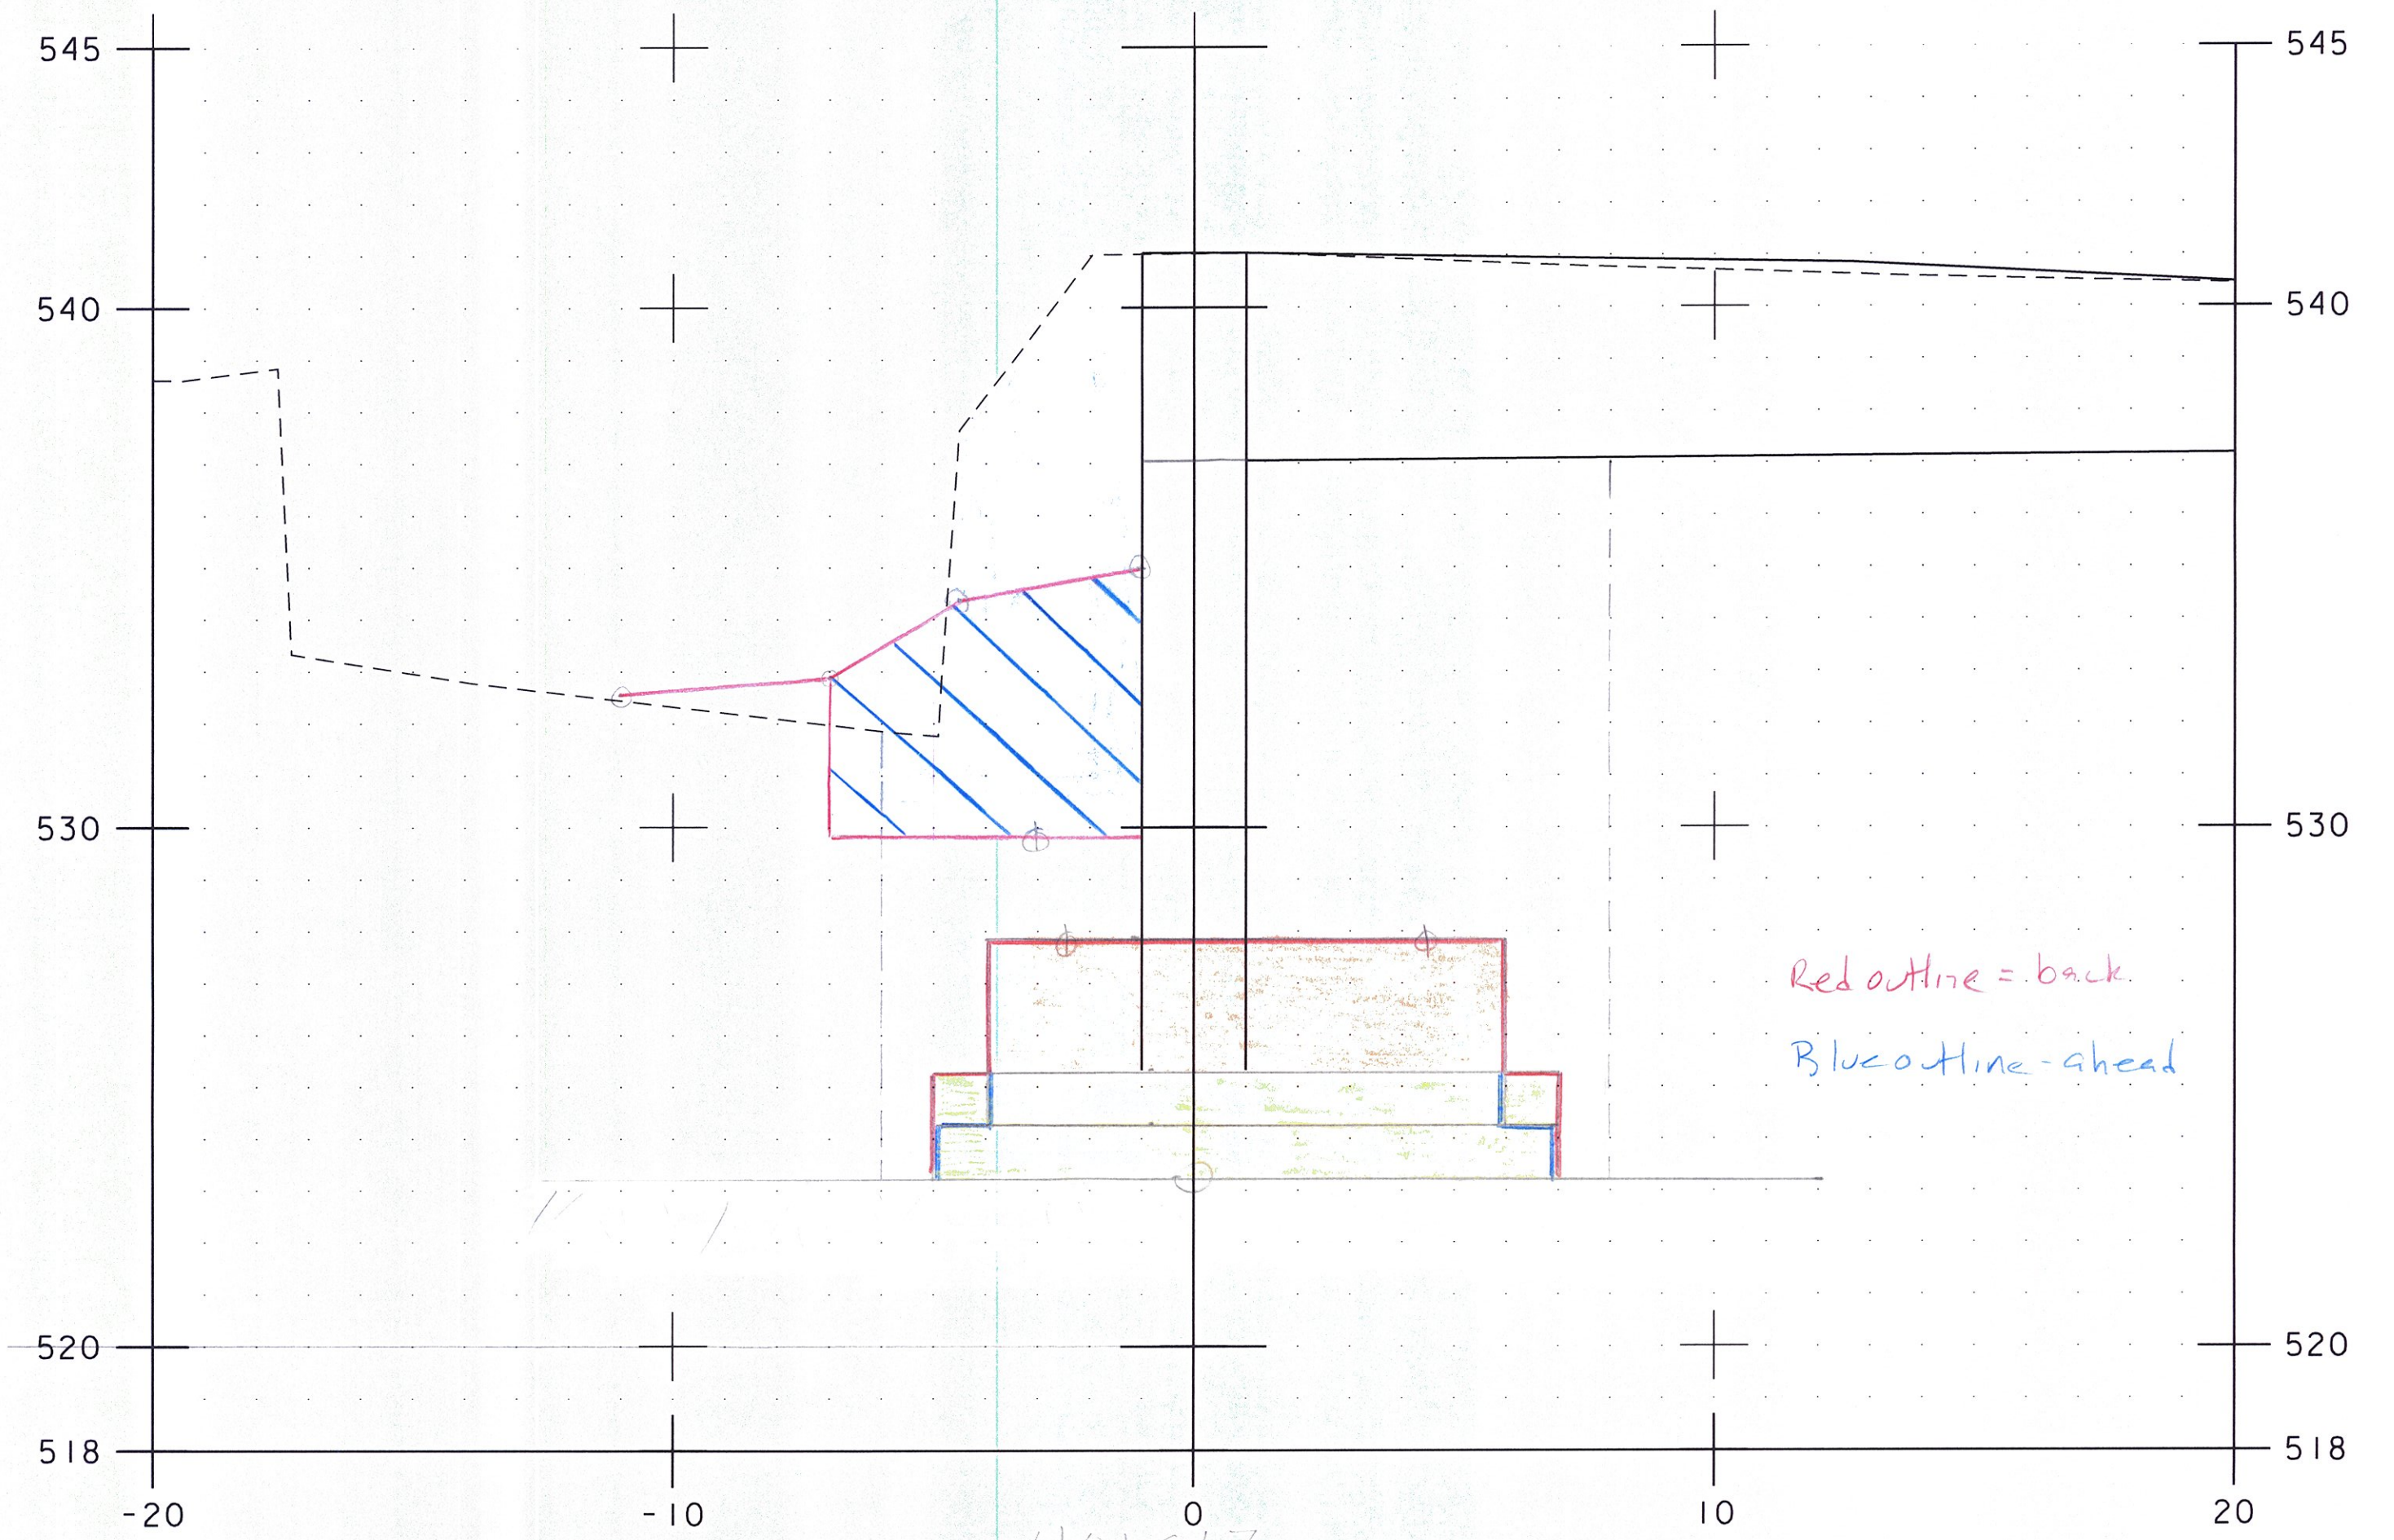

Confined Earth = 155.4 FT ✓  
 Granular Base for Structure  
 (B) = 5.0 FT ✓  
 (A) = 3.0 FT ✓  
 Unconfined Subgrade = 4.3 FT ✓  
 Stone Fill = 0.0 FT ✓  
 Granular Stone Fill = 14' ✓  
 for 5/3/15

40+00.00

Red outline = back  
 Blue outline = ahead


NOTE: LOCATION OF SUBBASE IS APPROXIMATE.

PROJECT NAME: BRATTLEBORO	
PROJECT NUMBER: BRO 1442(35)	
FILE NAME: z10j062_customEL.dgn	PLOT DATE: 3/2/2015
PROJECT LEADER: S.E. BURBANK	DRAWN BY: E.F. LAWES
DESIGNED BY: E.F. LAWES	CHECKED BY: S.E. BURBANK
ABUTMENT NO. 1 CROSS SECTIONS (5 OF 7)	SHEET 21 OF 28




SCALE 1" = 3'-0"



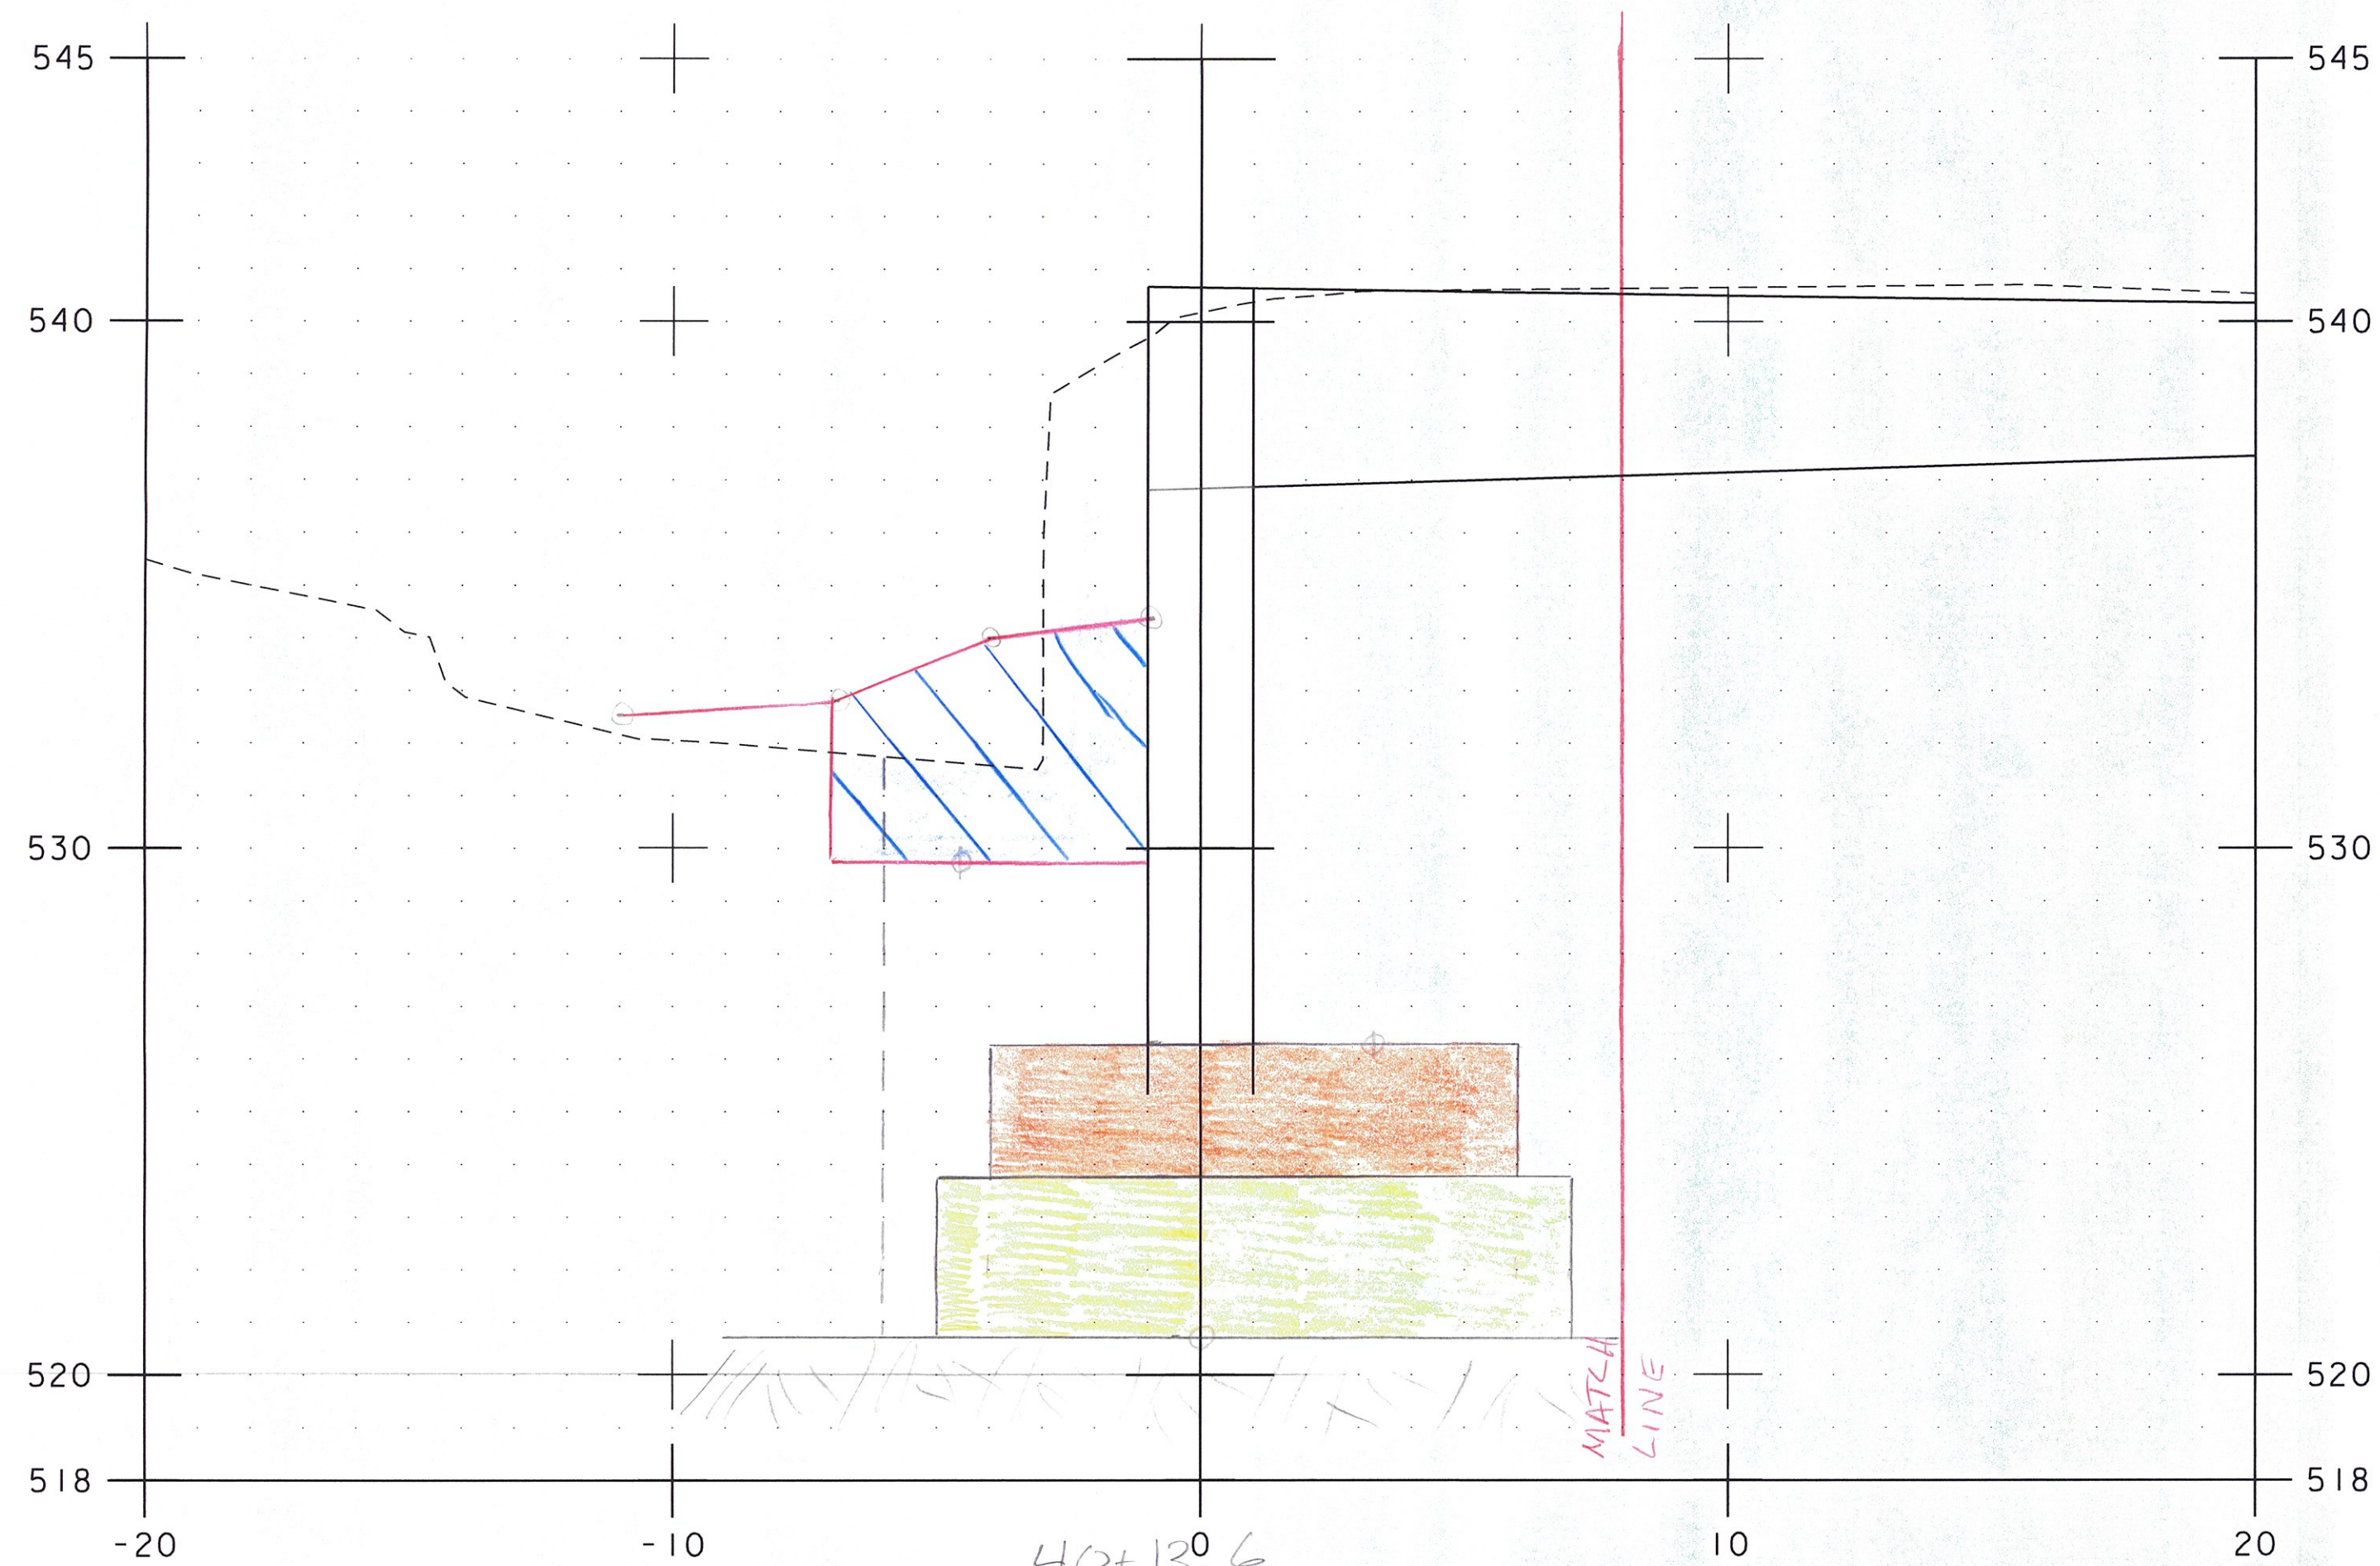

Cofferdam Earth = 185.7 FT² ✓  
 Granular Backfill for Structure = 105.7 FT² ✓  
 Unclassified Channel Exc = 25.9 FT² ✓  
 Stone Fill, type III = 23.9 FT² ✓  
 Geo. Under Stone Fill = 13.5' ✓  
 520.7  
 520.5  
 40+13.6  
 Use section  
 40+14.40

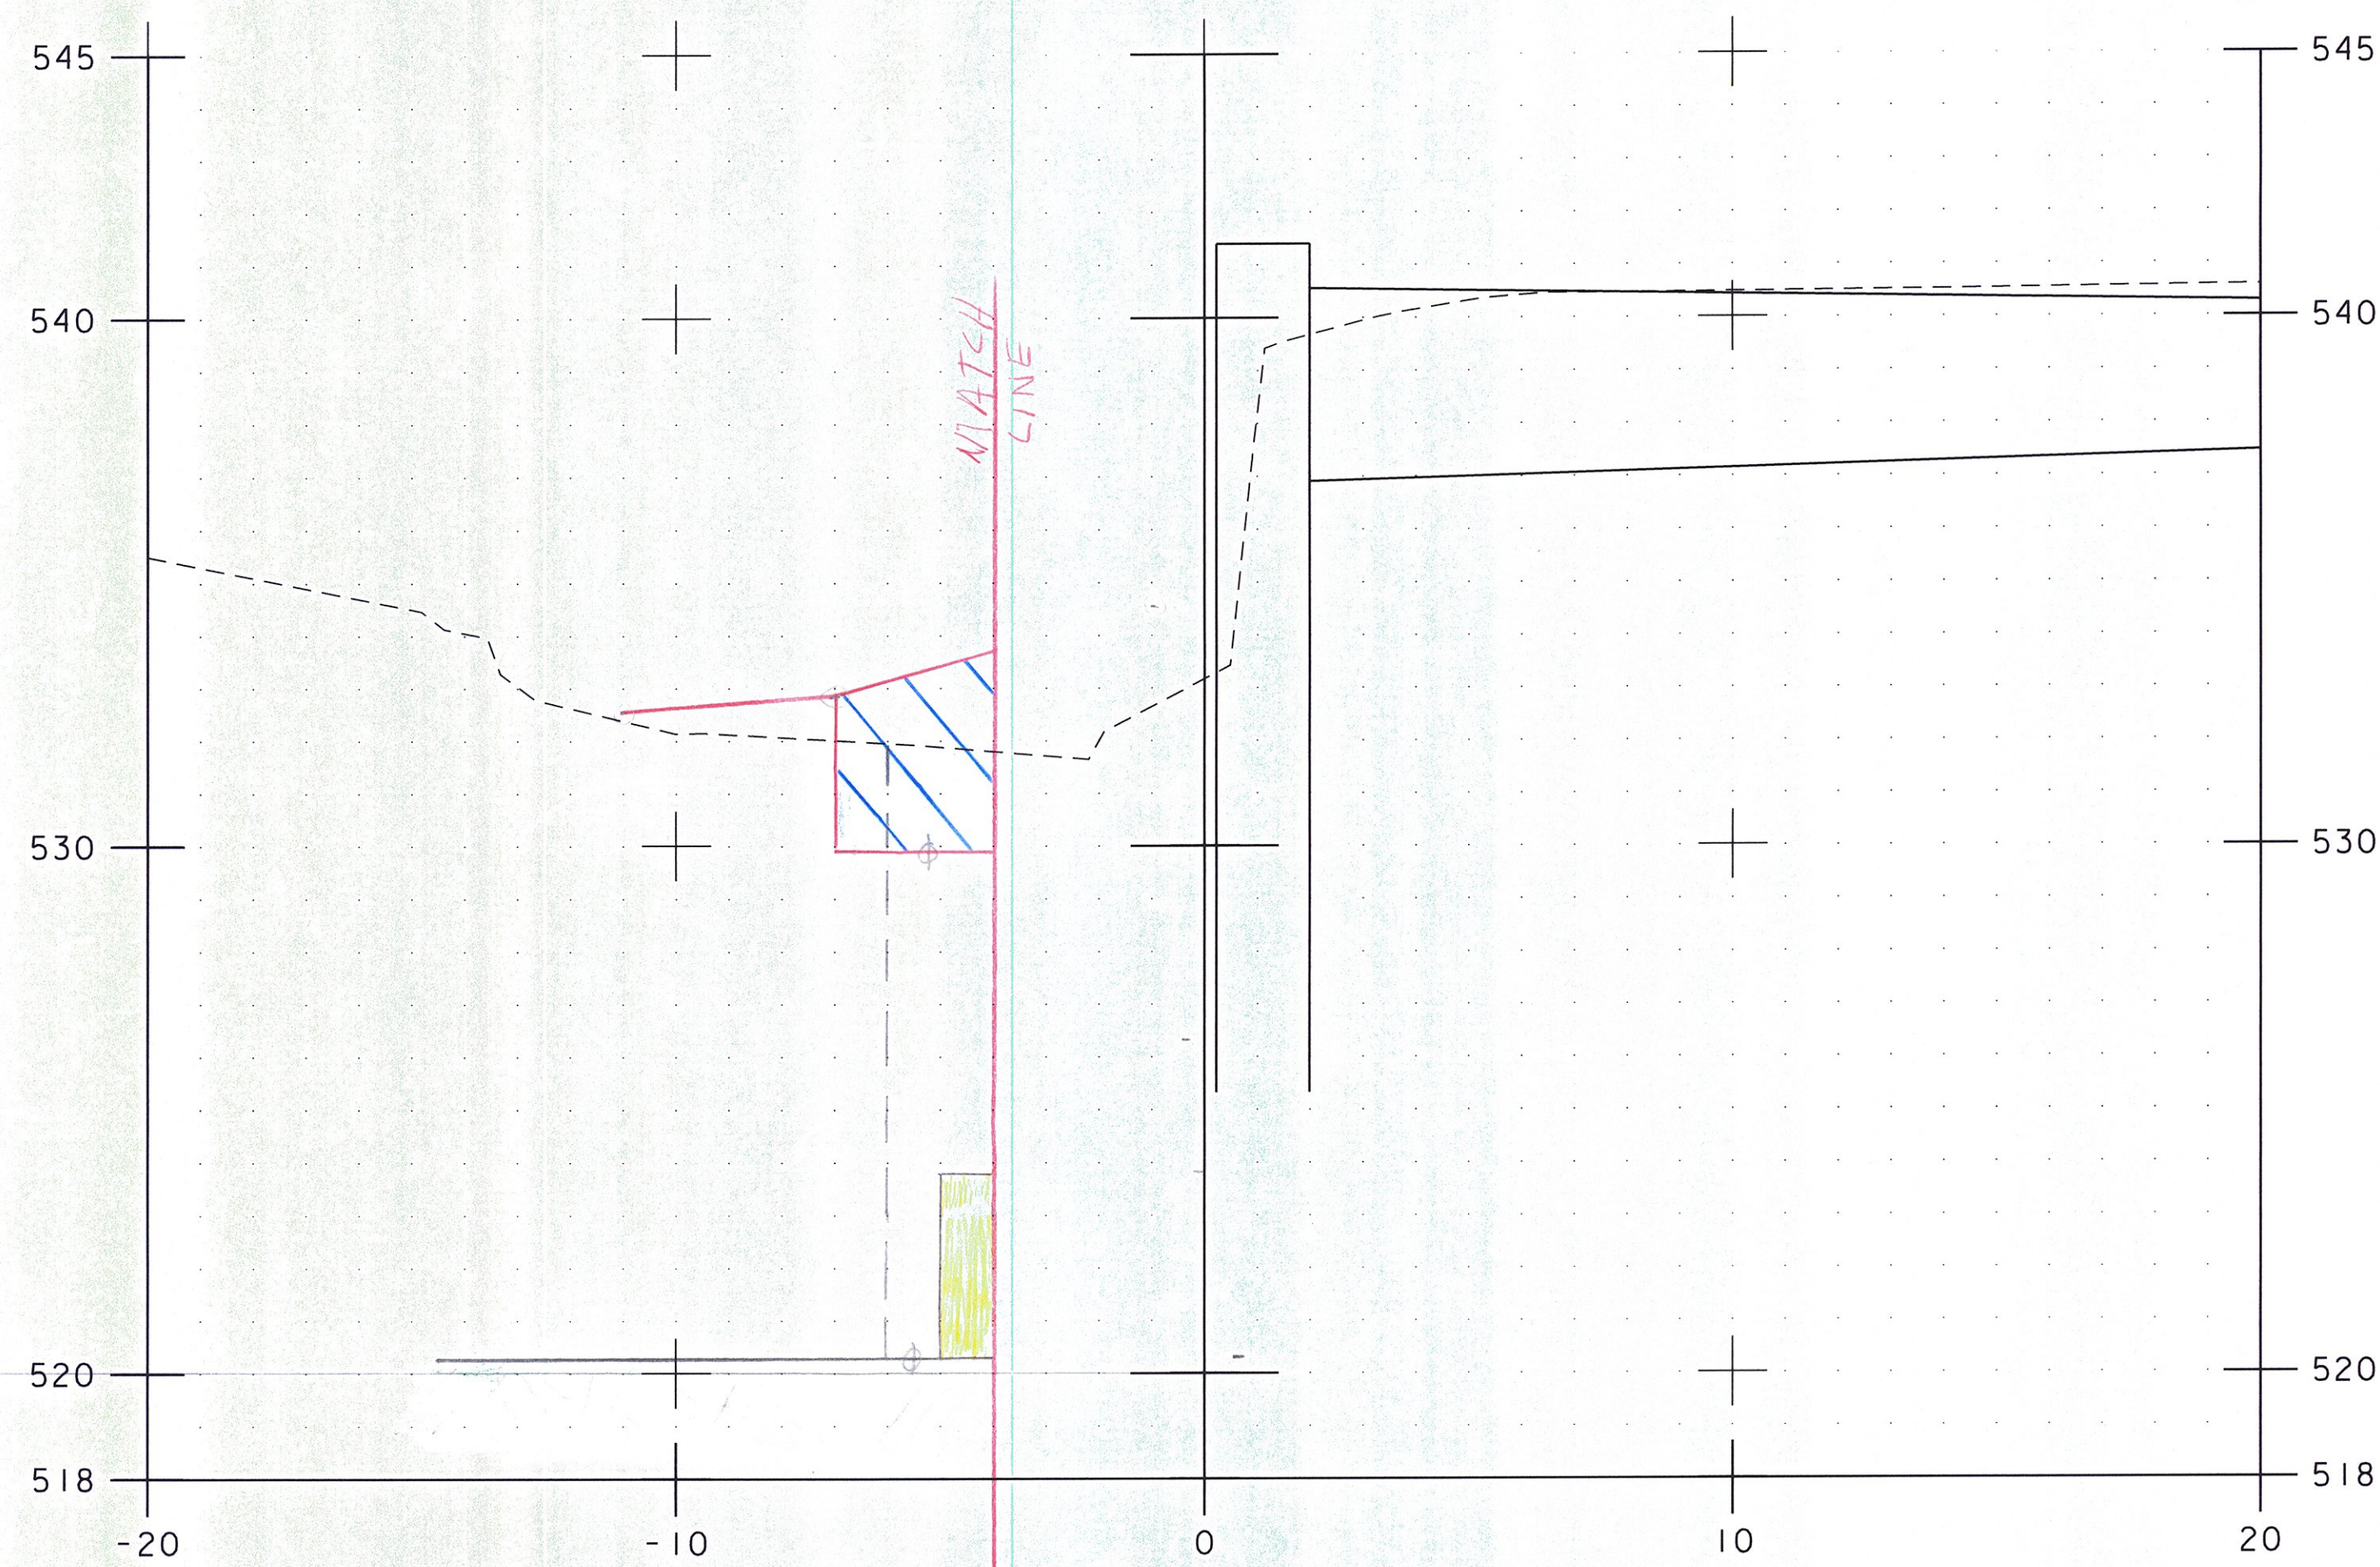

Cofferdam Earth = 19.0 FT² ✓  
 Granular Backfill for Structure = 15.4 FT² ✓  
 Unclassified Channel Exc = 5.0 FT² ✓  
 Stone Fill, type III = 10.2 FT² ✓  
 Geo. Under Stone Fill = 6' ✓  
 520.3  
 520.3  
 40+18.60

40+19.4 = Zero Cofferdam Exc + G.B.F. ✓  
 40+20 = Zero D.C. Exc + S.F. + G.D.S.F. ✓

NOTE: LOCATION OF SUBBASE IS APPROXIMATE.


PROJECT NAME:	BRATTLEBORO
PROJECT NUMBER:	BRO 1442(35)
FILE NAME:	z10j062_customEL.dgn
PROJECT LEADER:	S.E. BURBANK
DESIGNED BY:	E.F. LAWES
ABUTMENT NO./CROSS SECTIONS (7 OF 7)	SHEET 23 OF 28
PLOT DATE:	3/2/2015
DRAWN BY:	E.F. LAWES
CHECKED BY:	S.E. BURBANK

SCALE 1" = 3'-0"




197  
162

450  
139

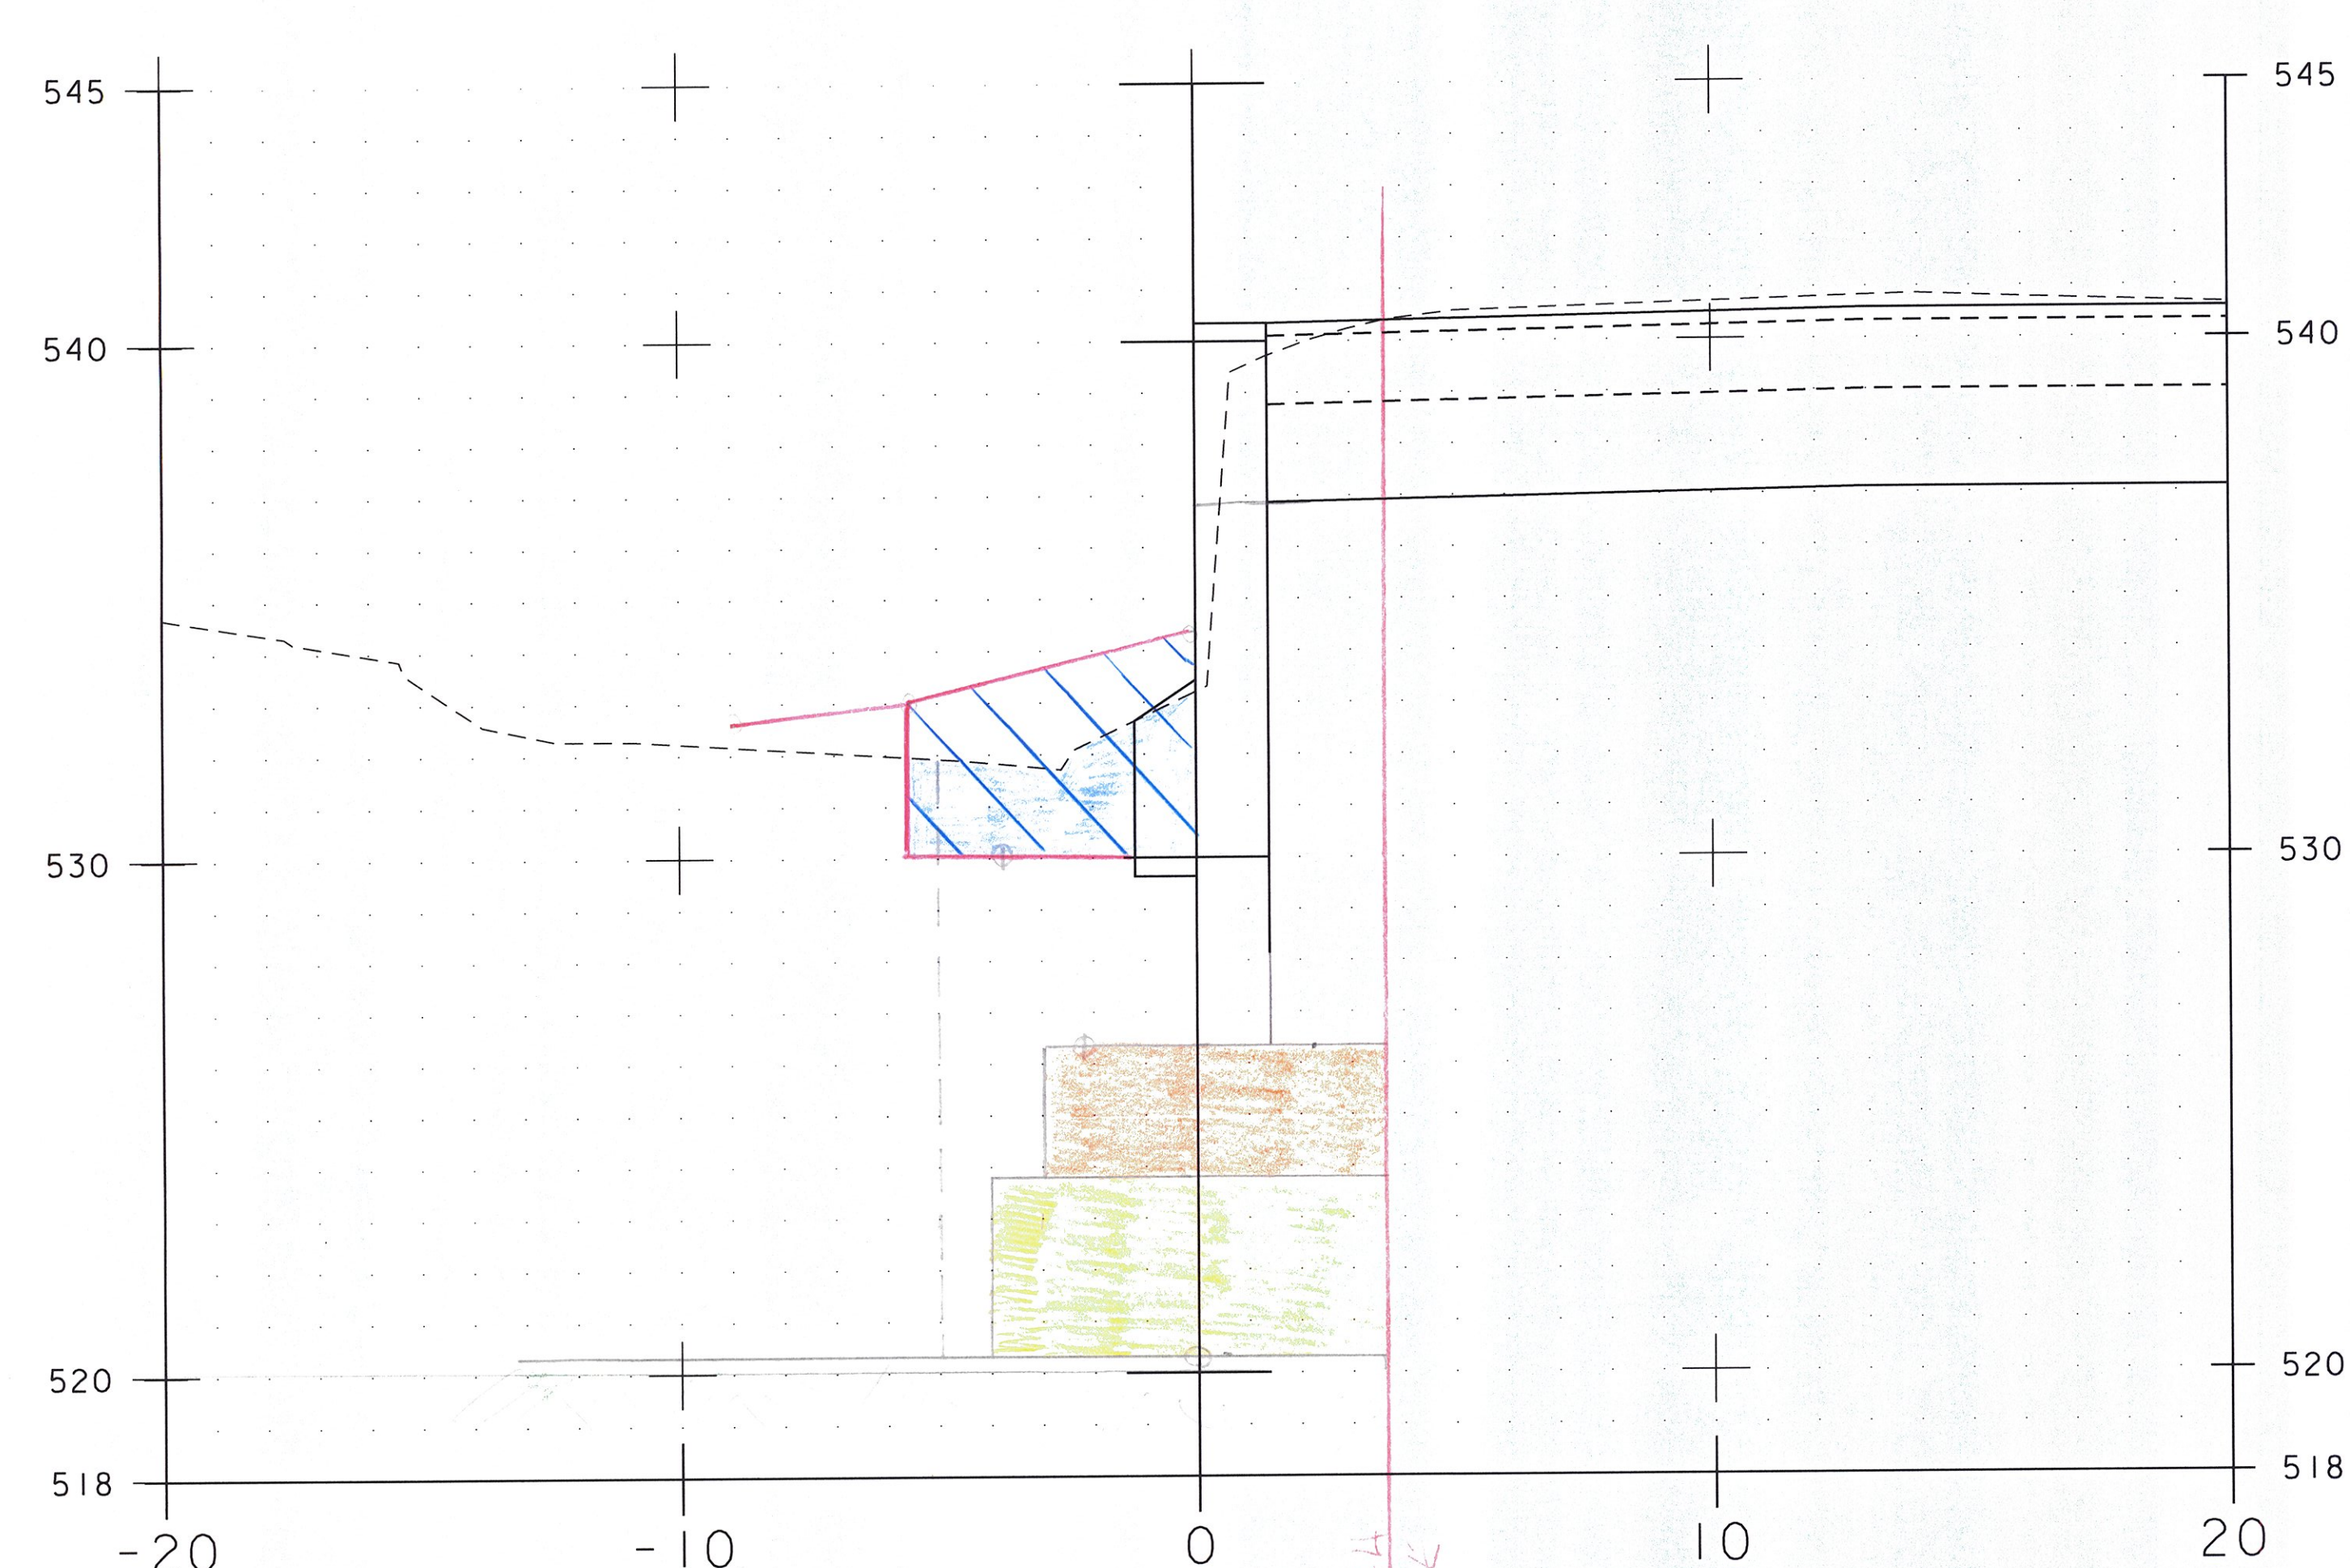

Collarless Earth = 10650' ✓  
 Granular Backfill = 1240' ✓  
 Unclassified Channel = 1300' ✓  
 Stone Fills = 1300' ✓  
 Granular Stone Fills = 1300' ✓  
 JDD 7-22-15  
 51.2 ✓  
 50+00.00  
 MATCH LINE

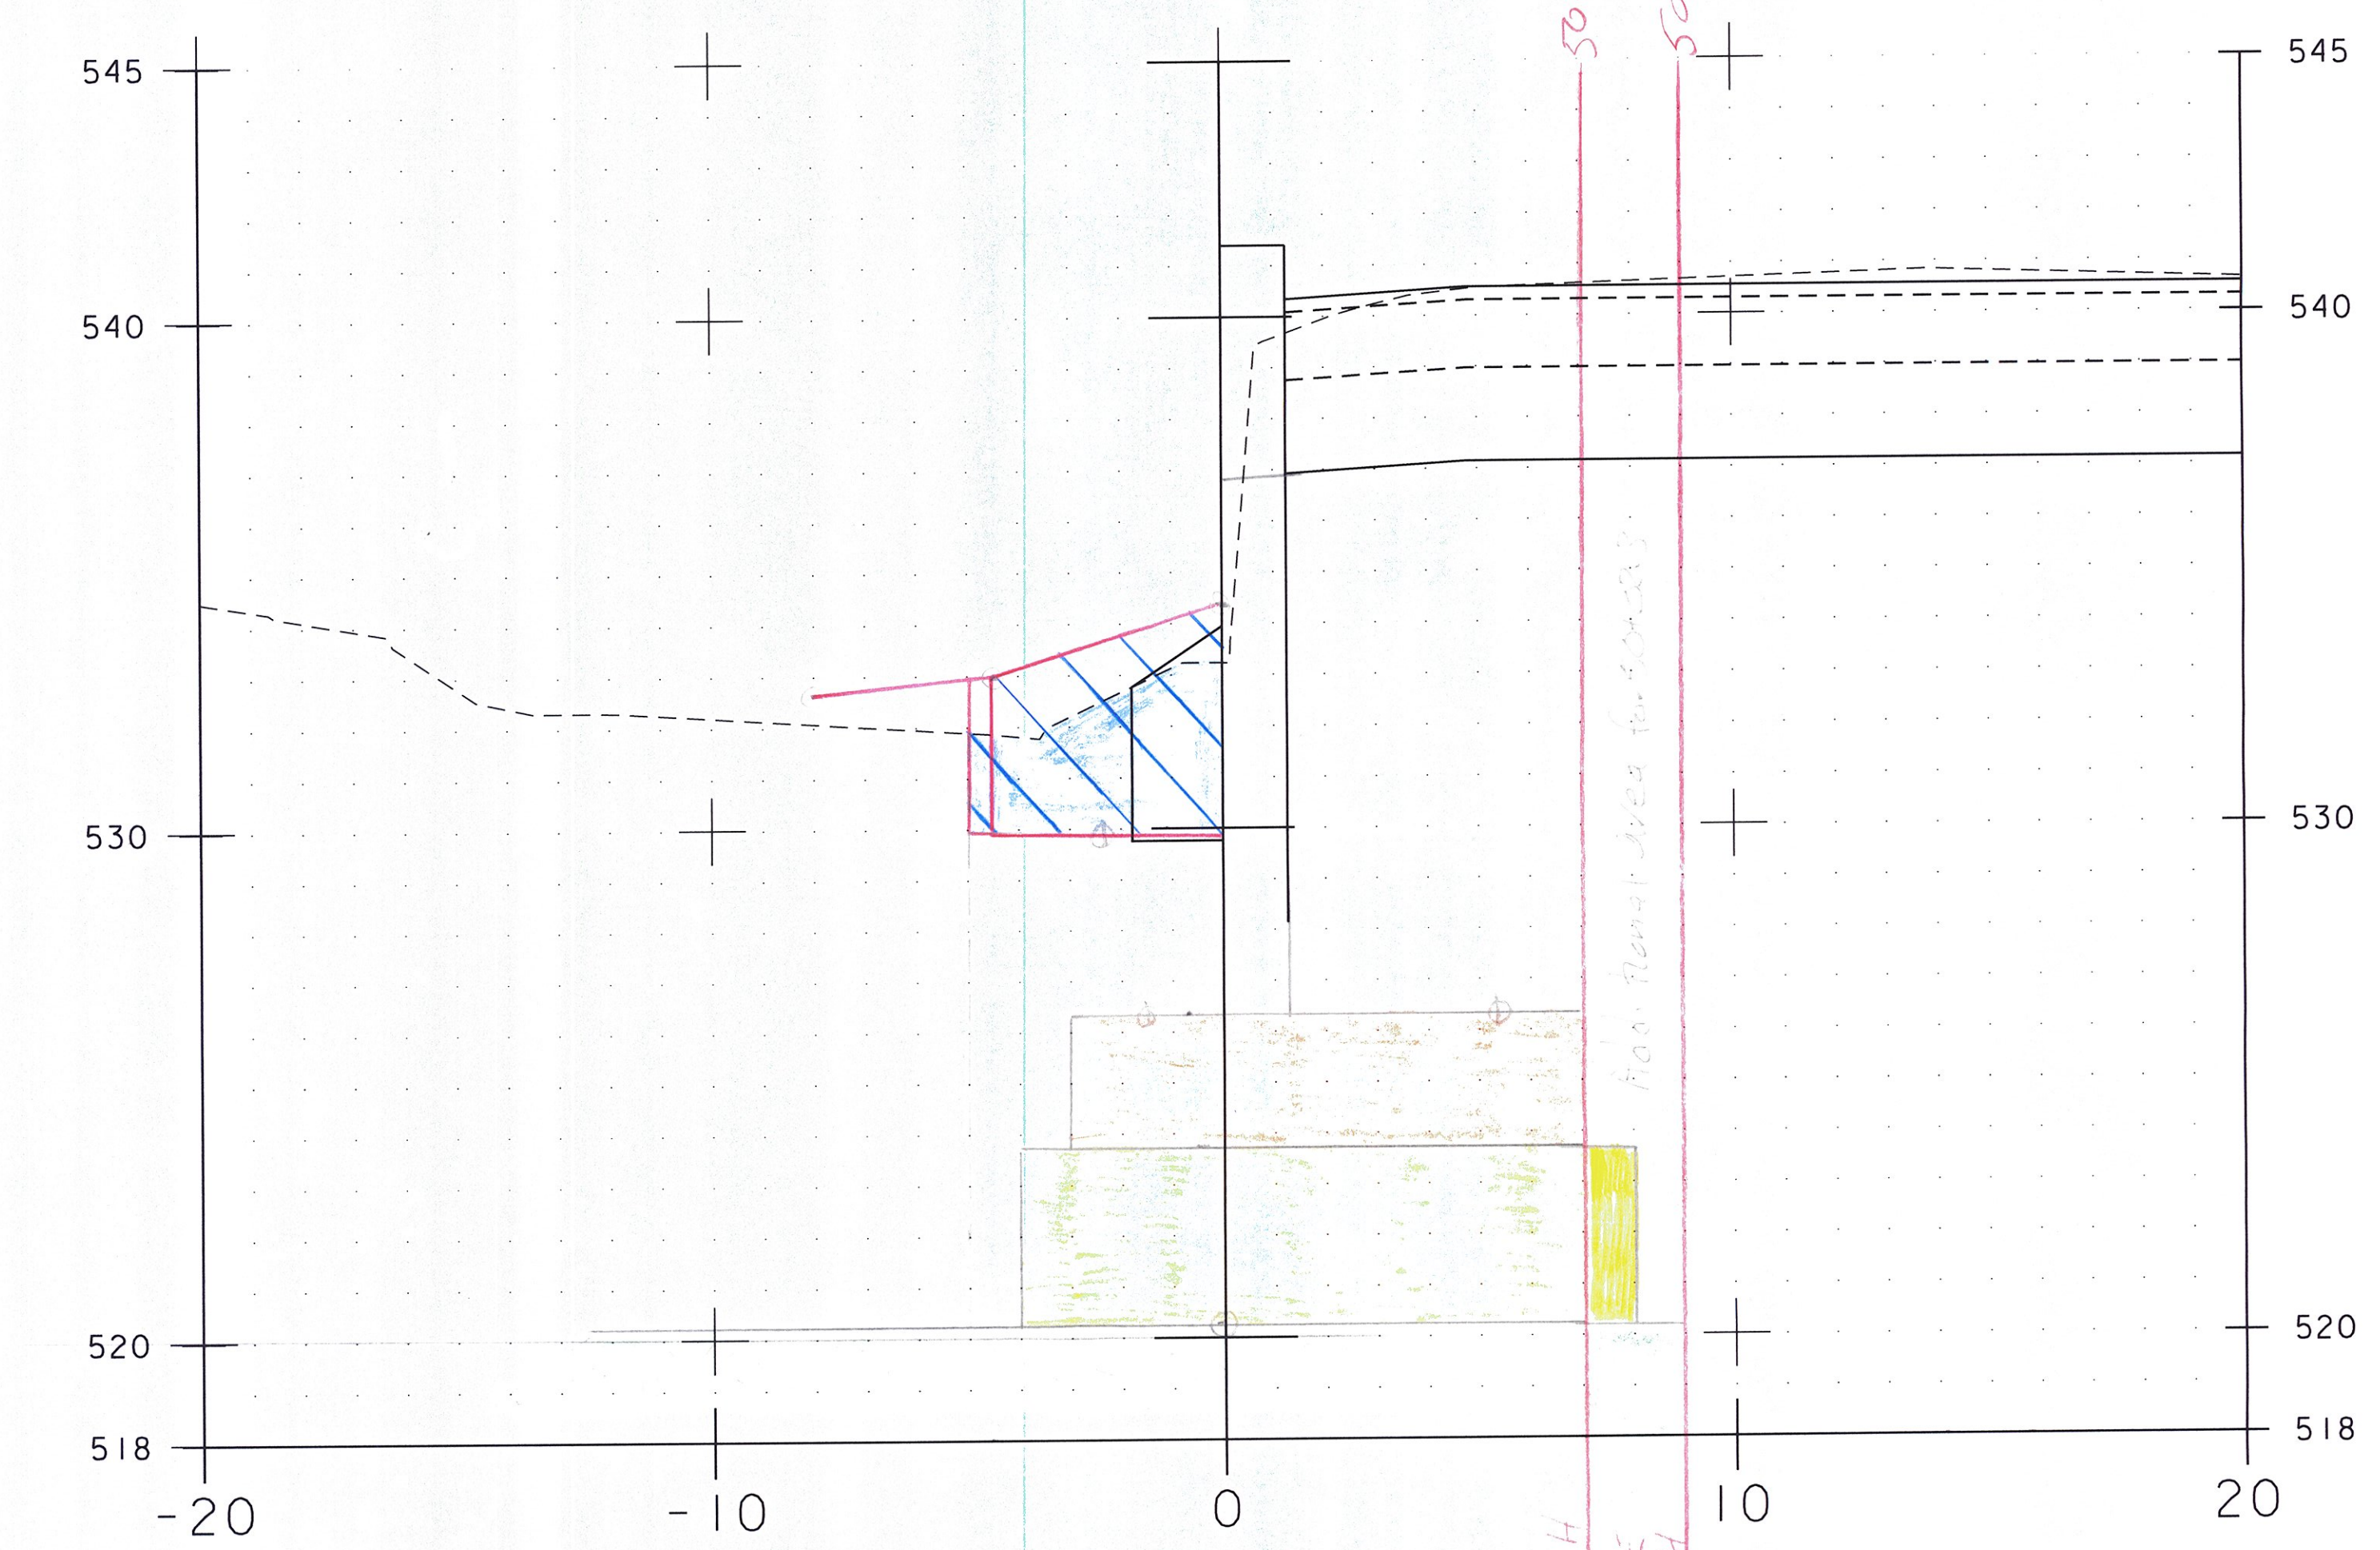


Collarless Earth = 1200' ✓  
 Granular Backfill = 1240' ✓  
 Unclassified Channel = 1300' ✓  
 Stone Fills = 1300' ✓  
 Granular Stone Fills = 1300' ✓  
 JDD 7-22-15  
 50+01.50  
 MATCH LINE

SCALE 1" = 3'-0"



PROJECT NAME: BRATTLEBORO	PLOT DATE: 3/2/2015
PROJECT NUMBER: BRO 1442(35)	DRAWN BY: E.F. LAWES
FILE NAME: z10j062.customEL.dgn	CHECKED BY: S.E. BURBANK
PROJECT LEADER: S.E. BURBANK	DESIGNED BY: E.F. LAWES
WINGWALL NO. 2 CROSS SECTIONS (1 OF 4)	SHEET 24 OF 28

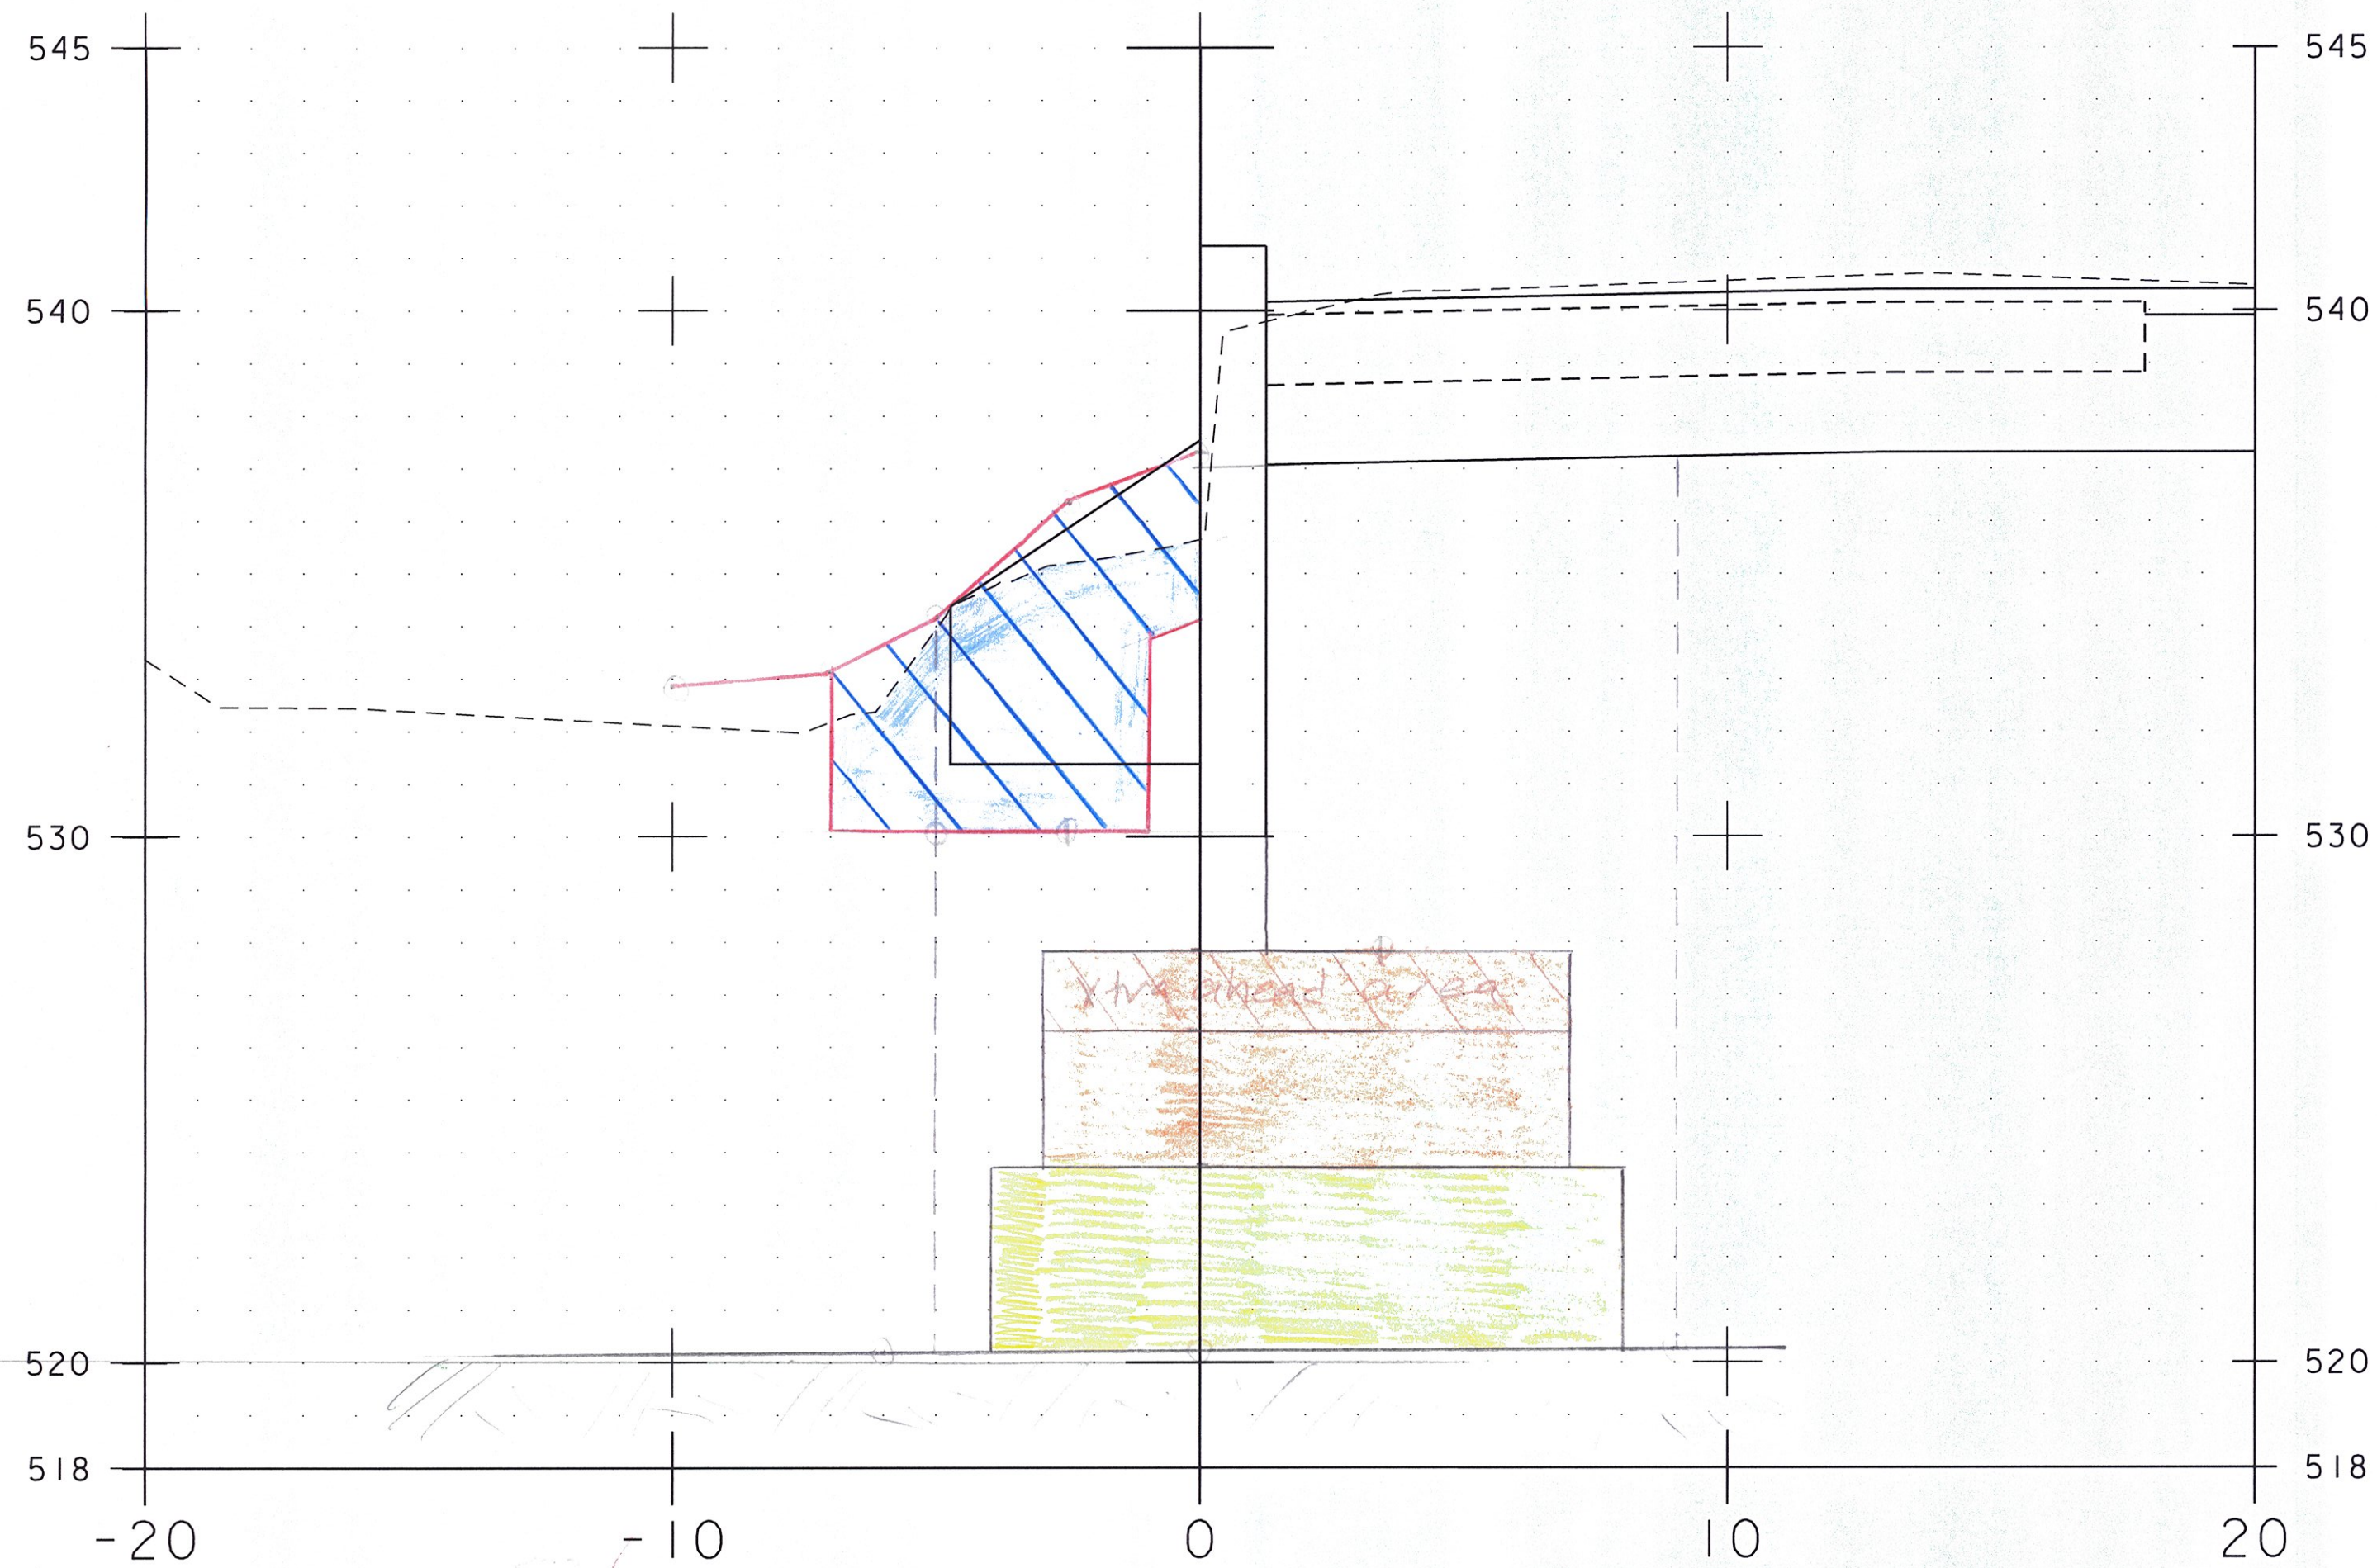


50+08.50 back of area

Collection Basin 2000' ✓  
 Concrete Substructure ✓  
 (60) = 1350' ✓  
 (40) = 1600' ✓  
 Unscreened Inlet ✓  
 Stone Filter Bed 1200' ✓  
 Gen. Drainage Pipe 14" ✓  
 SDD 2115  
 for 11/15

527.9  
527.4  
527.9

520.0  
519.5

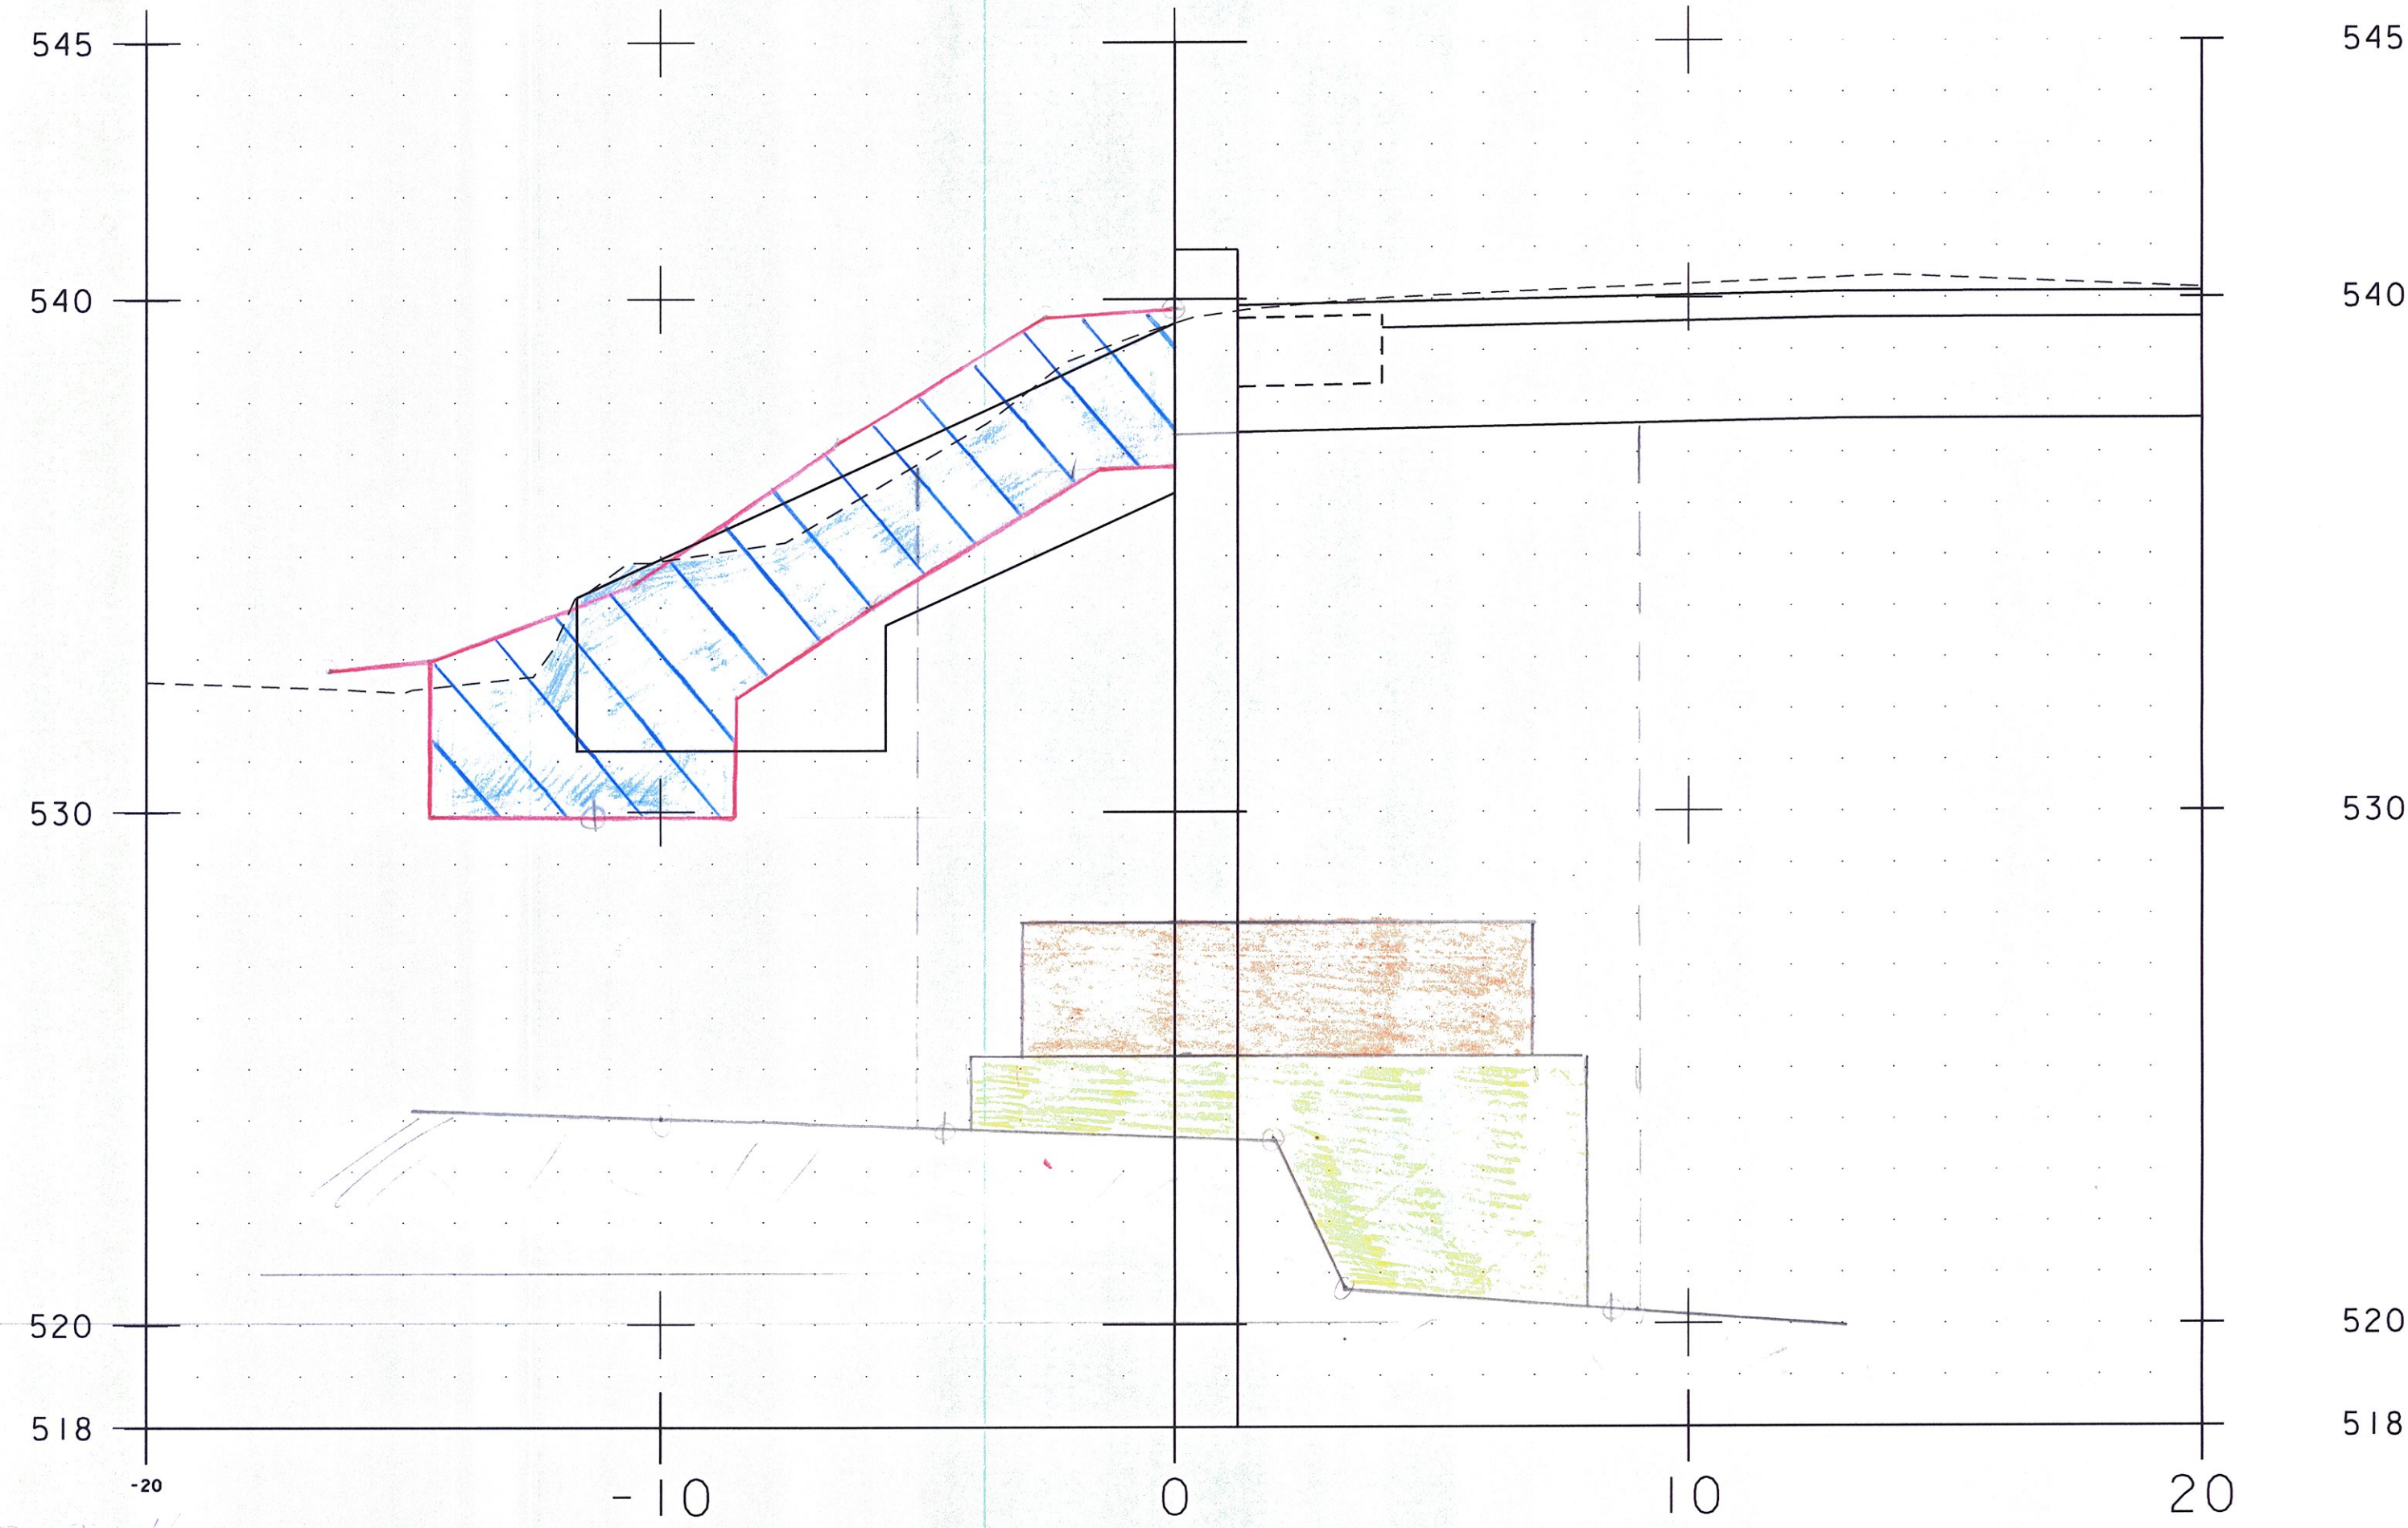

50+22.40 butt section for loading

50+22.4  
 Collection Basin 2000' ✓  
 Concrete Substructure ✓  
 (60) = 1350' ✓  
 (40) = 1600' ✓  
 Unscreened Inlet ✓  
 Stone Filter Bed 1200' ✓  
 Gen. Drainage Pipe 14" ✓


527.8  
525.3

50+23.4  
 Collection Basin 2000' ✓  
 Concrete Substructure ✓  
 (60) = 1350' ✓  
 (40) = 1600' ✓  
 Unscreened Inlet ✓  
 Stone Filter Bed 1200' ✓  
 Gen. Drainage Pipe 14" ✓

SCALE 1" = 3'-0"




PROJECT NAME: BRATTLEBORO	
PROJECT NUMBER: BRO 1442(35)	
FILE NAME: z10j062_customEL.dgn	PLOT DATE: 3/2/2015
PROJECT LEADER: S.E. BURBANK	DRAWN BY: E.F. LAWES
DESIGNED BY: E.F. LAWES	CHECKED BY: S.E. BURBANK
WINGWALL NO. 2 CROSS SECTIONS (2 OF 4)	SHEET 25 OF 28

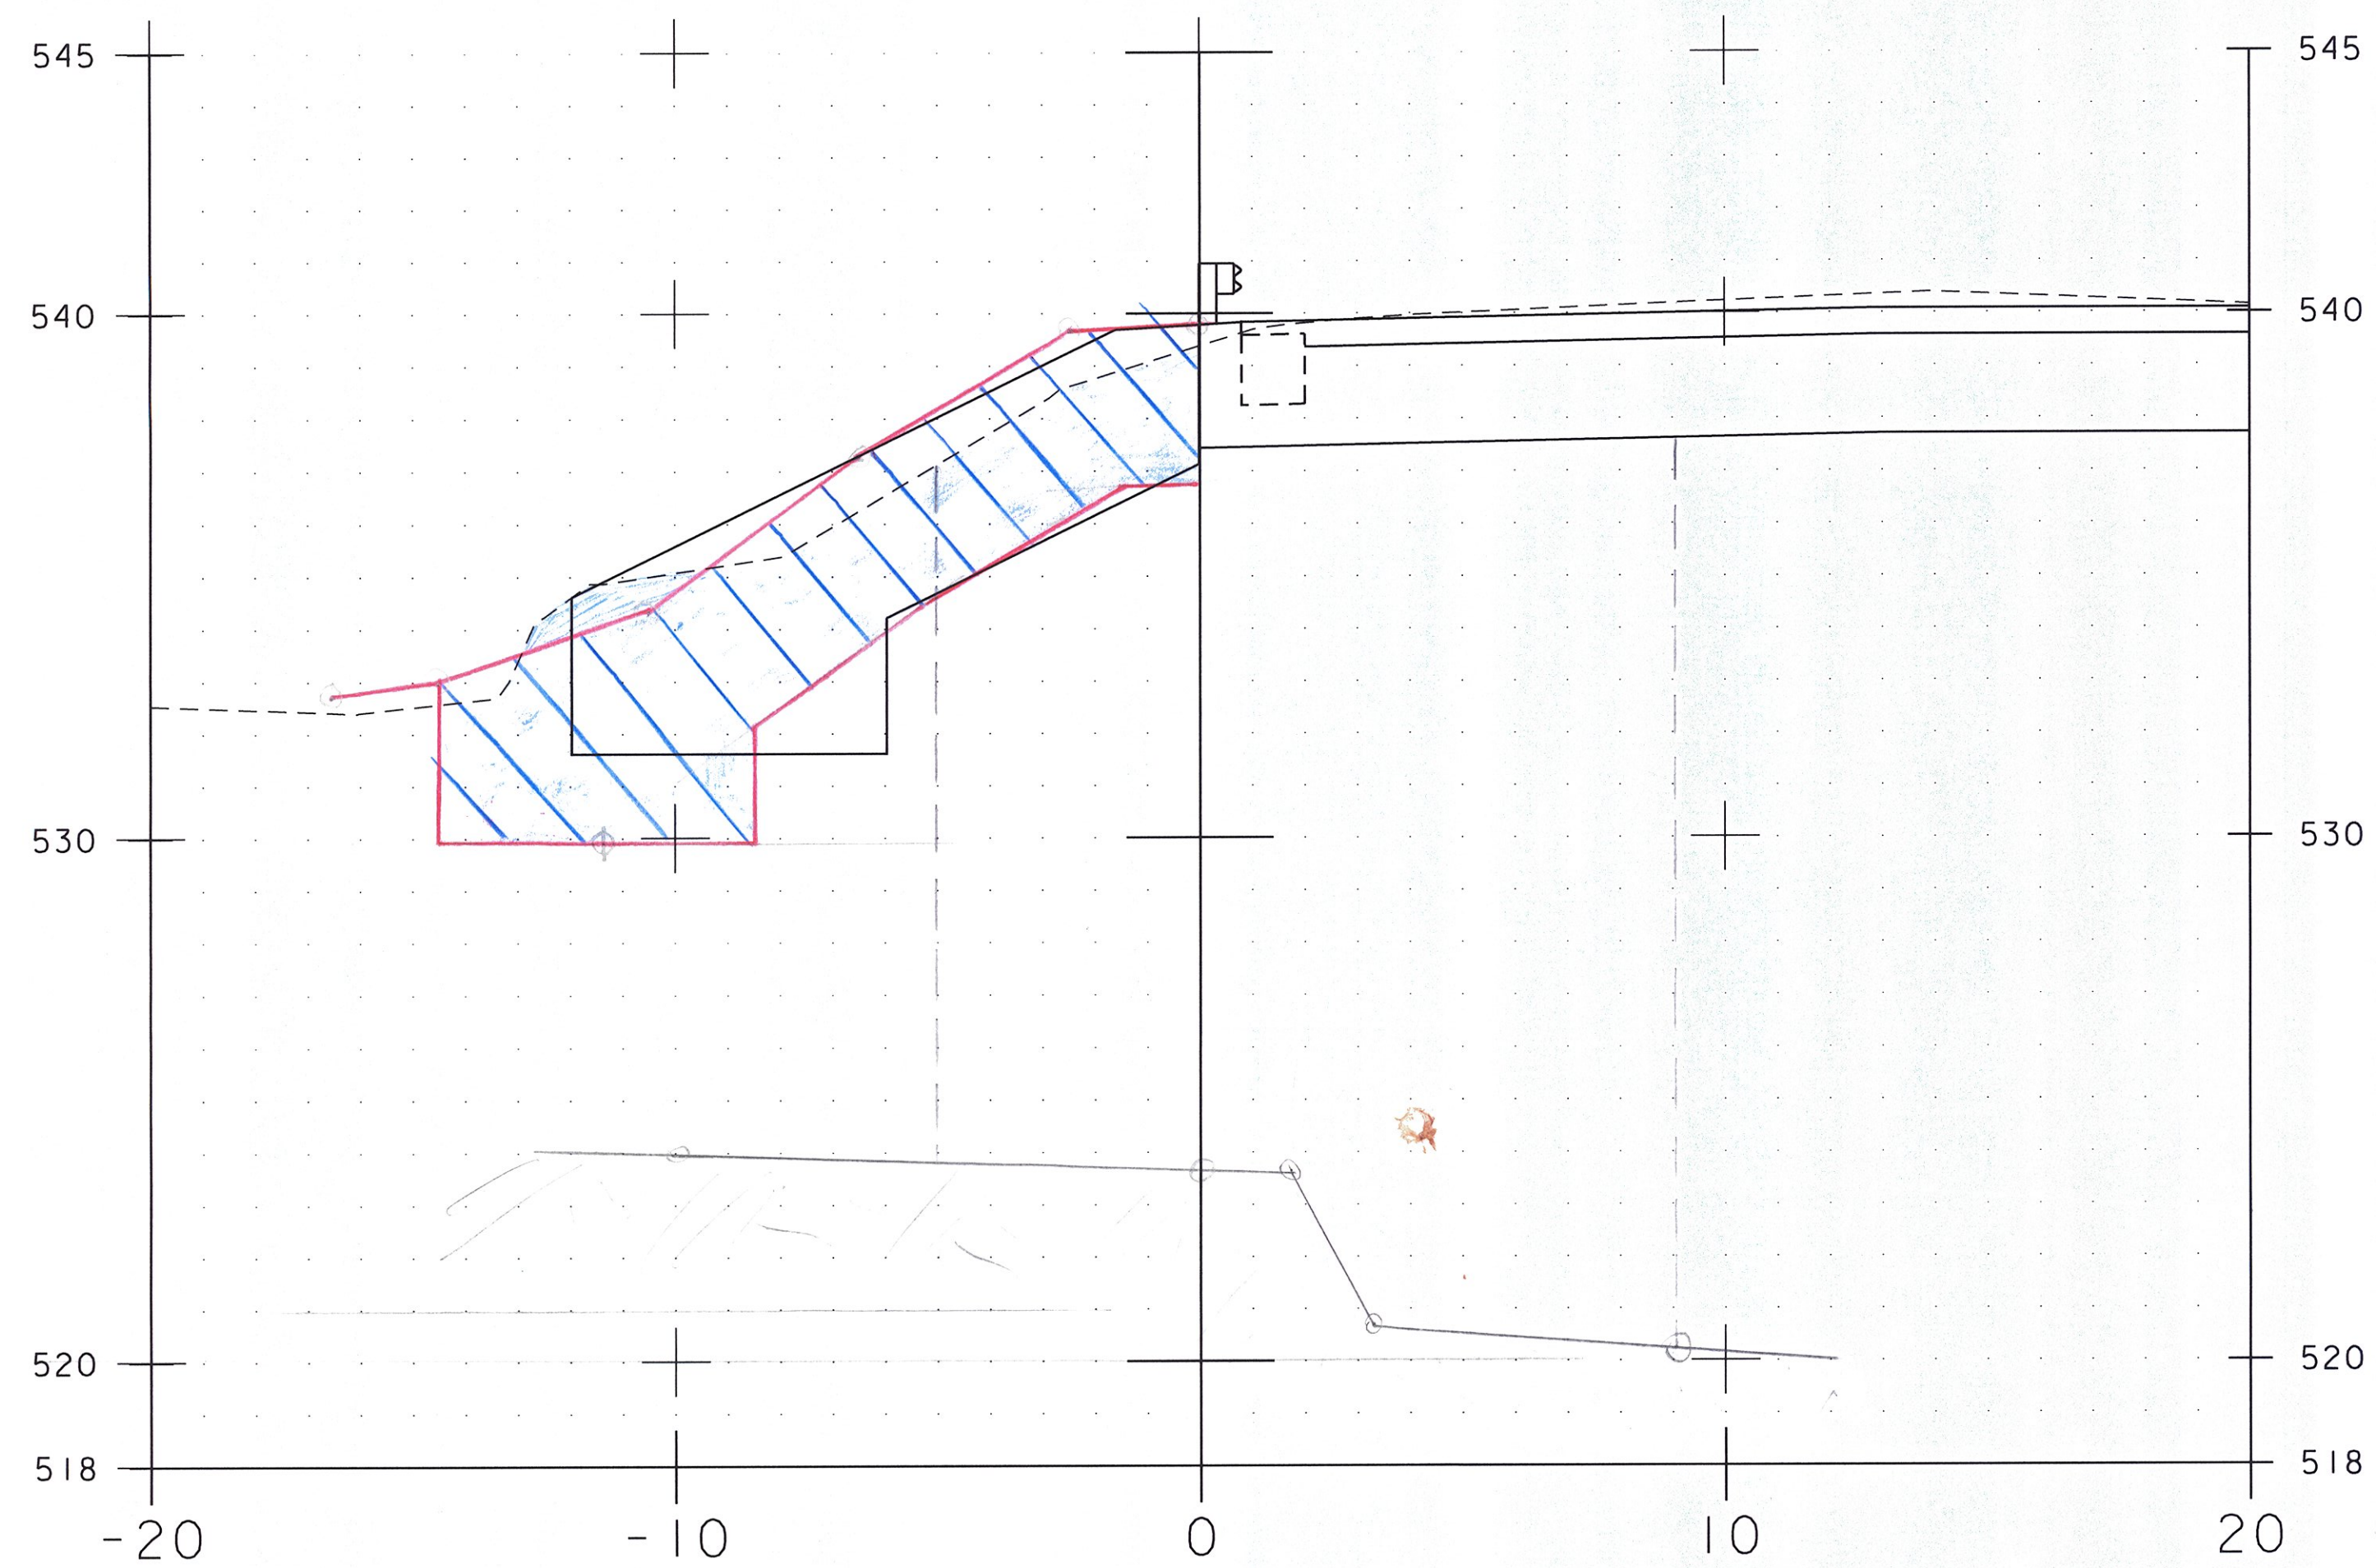

50+24.40 ✓  
 Elev. 518.00 ✓  
 Elev. 520.00 ✓  
 Elev. 524.00 ✓  
 Elev. 528.00 ✓  
 Elev. 532.00 ✓  
 Elev. 536.00 ✓  
 Elev. 540.00 ✓  
 Elev. 544.00 ✓

50+24.40

butt section for  
Colerden Exc.

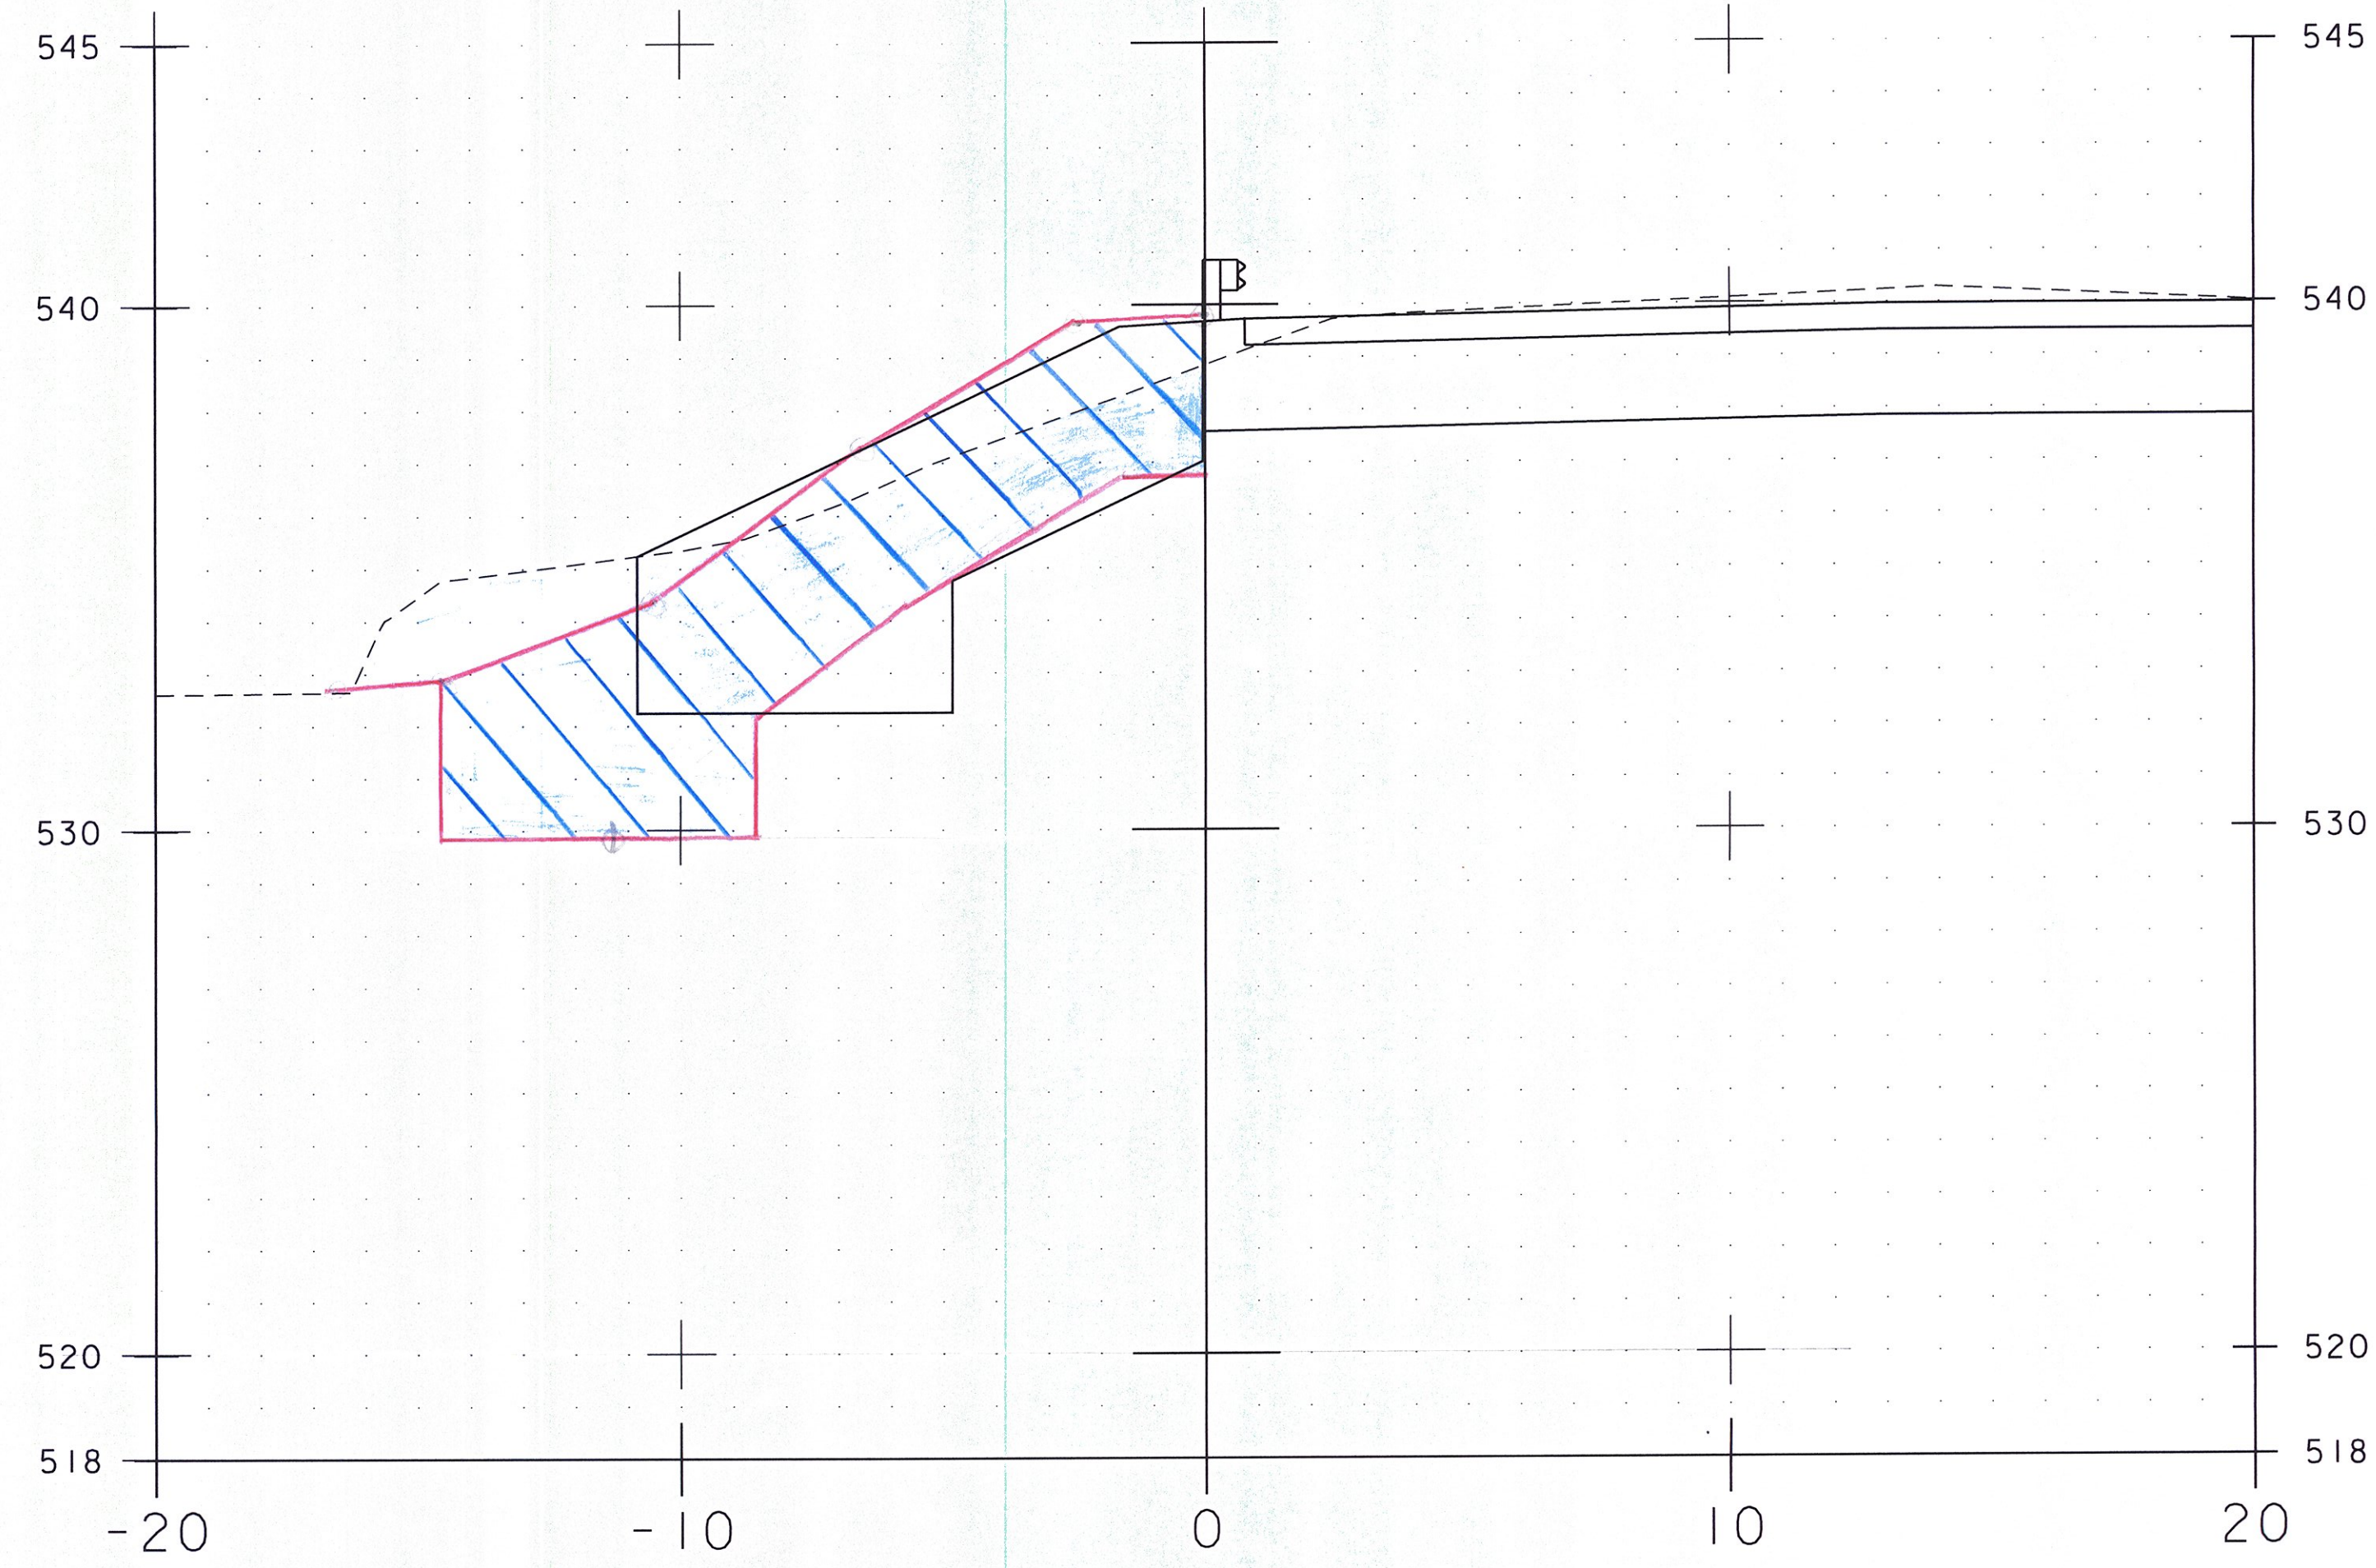

50+30.00 ✓  
 Elev. 518.00 ✓  
 Elev. 520.00 ✓  
 Elev. 524.00 ✓  
 Elev. 528.00 ✓  
 Elev. 532.00 ✓  
 Elev. 536.00 ✓  
 Elev. 540.00 ✓  
 Elev. 544.00 ✓


50+30.00

butt section for  
cut  
btt. Elev. under S.f.

SCALE 1" = 3'-0"



PROJECT NAME: BRATTLEBORO	PLOT DATE: 3/2/2015
PROJECT NUMBER: BRO 1442(35)	DRAWN BY: E.F. LAWES
FILE NAME: z10j062_customEL.dgn	CHECKED BY: S.E. BURBANK
DESIGNED BY: E.F. LAWES	WINGWALL NO. 2 CROSS SECTIONS (3 OF 4)
	SHEET 26 OF 28


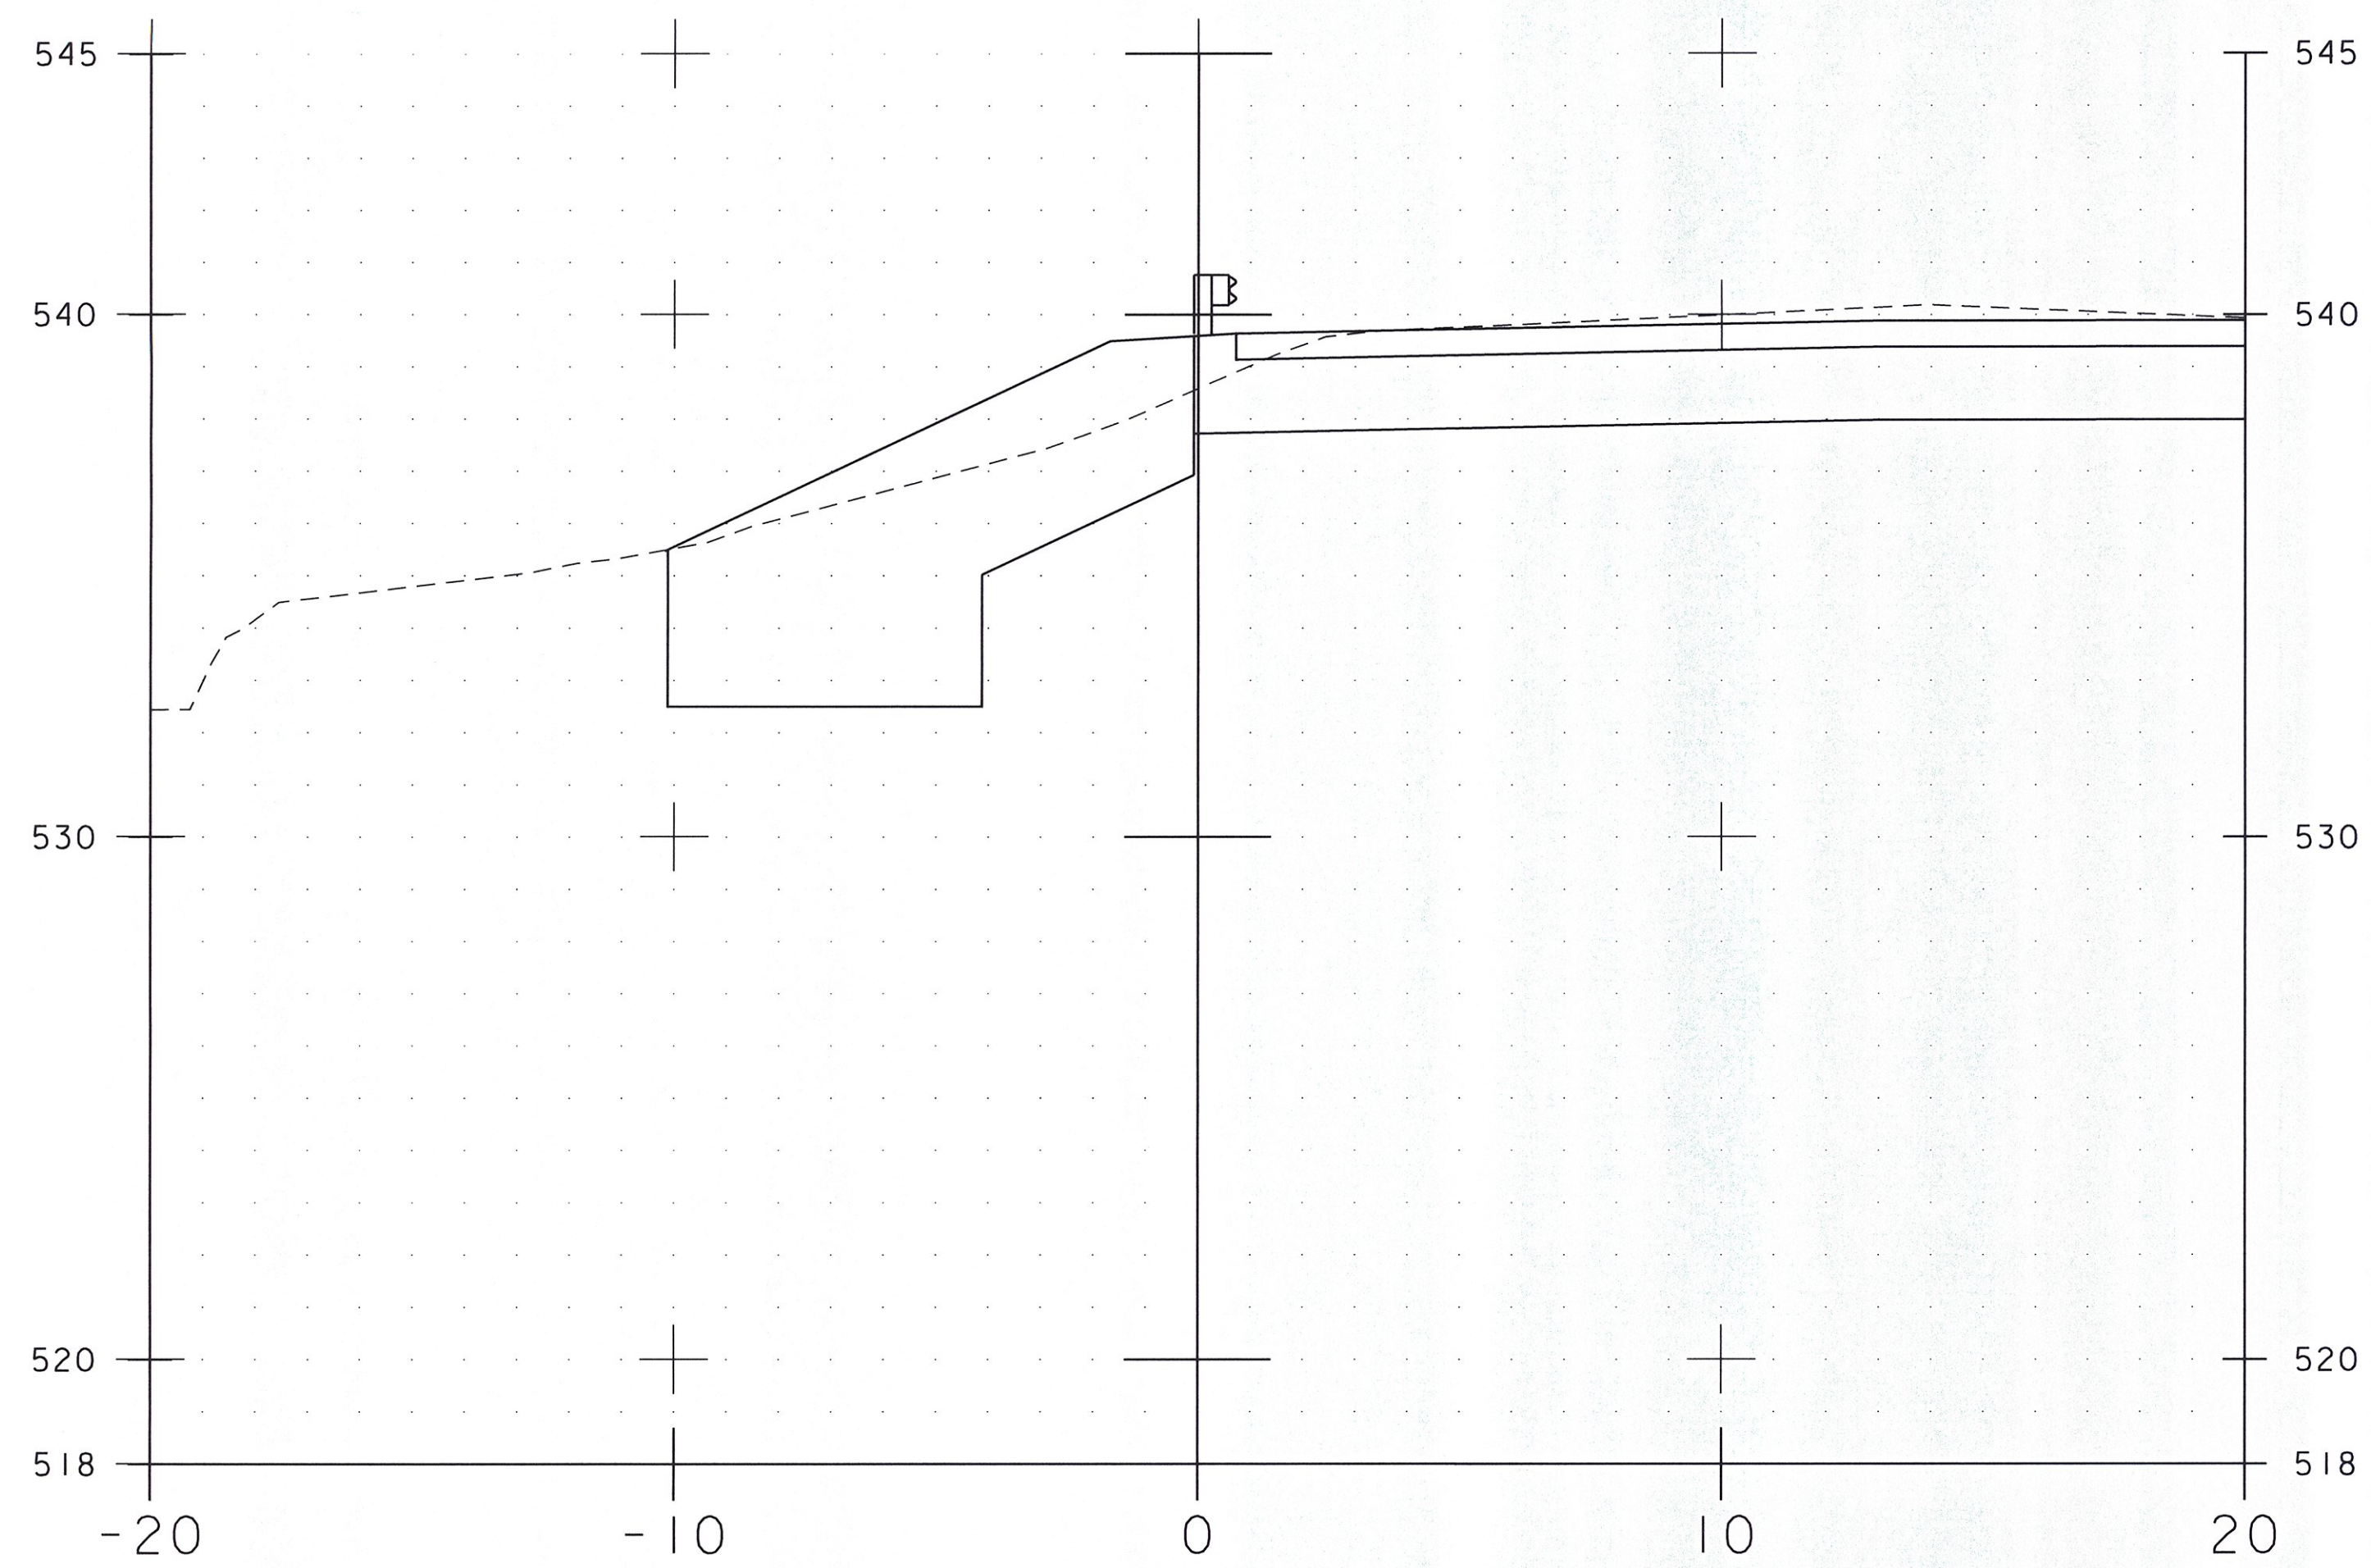


50+35.00

SCALE 1" = 3'-0"



PROJECT NAME: BRATTLEBORO	
PROJECT NUMBER: BRO 1442(35)	
FILE NAME: z10j062_customEL.dgn	PLOT DATE: 3/2/2015
PROJECT LEADER: S.E. BURBANK	DRAWN BY: E.F. LAWES
DESIGNED BY: E.F. LAWES	CHECKED BY: S.E. BURBANK
WINGWALL NO. 2 CROSS SECTIONS (4 OF 4)	SHEET 27 OF 28

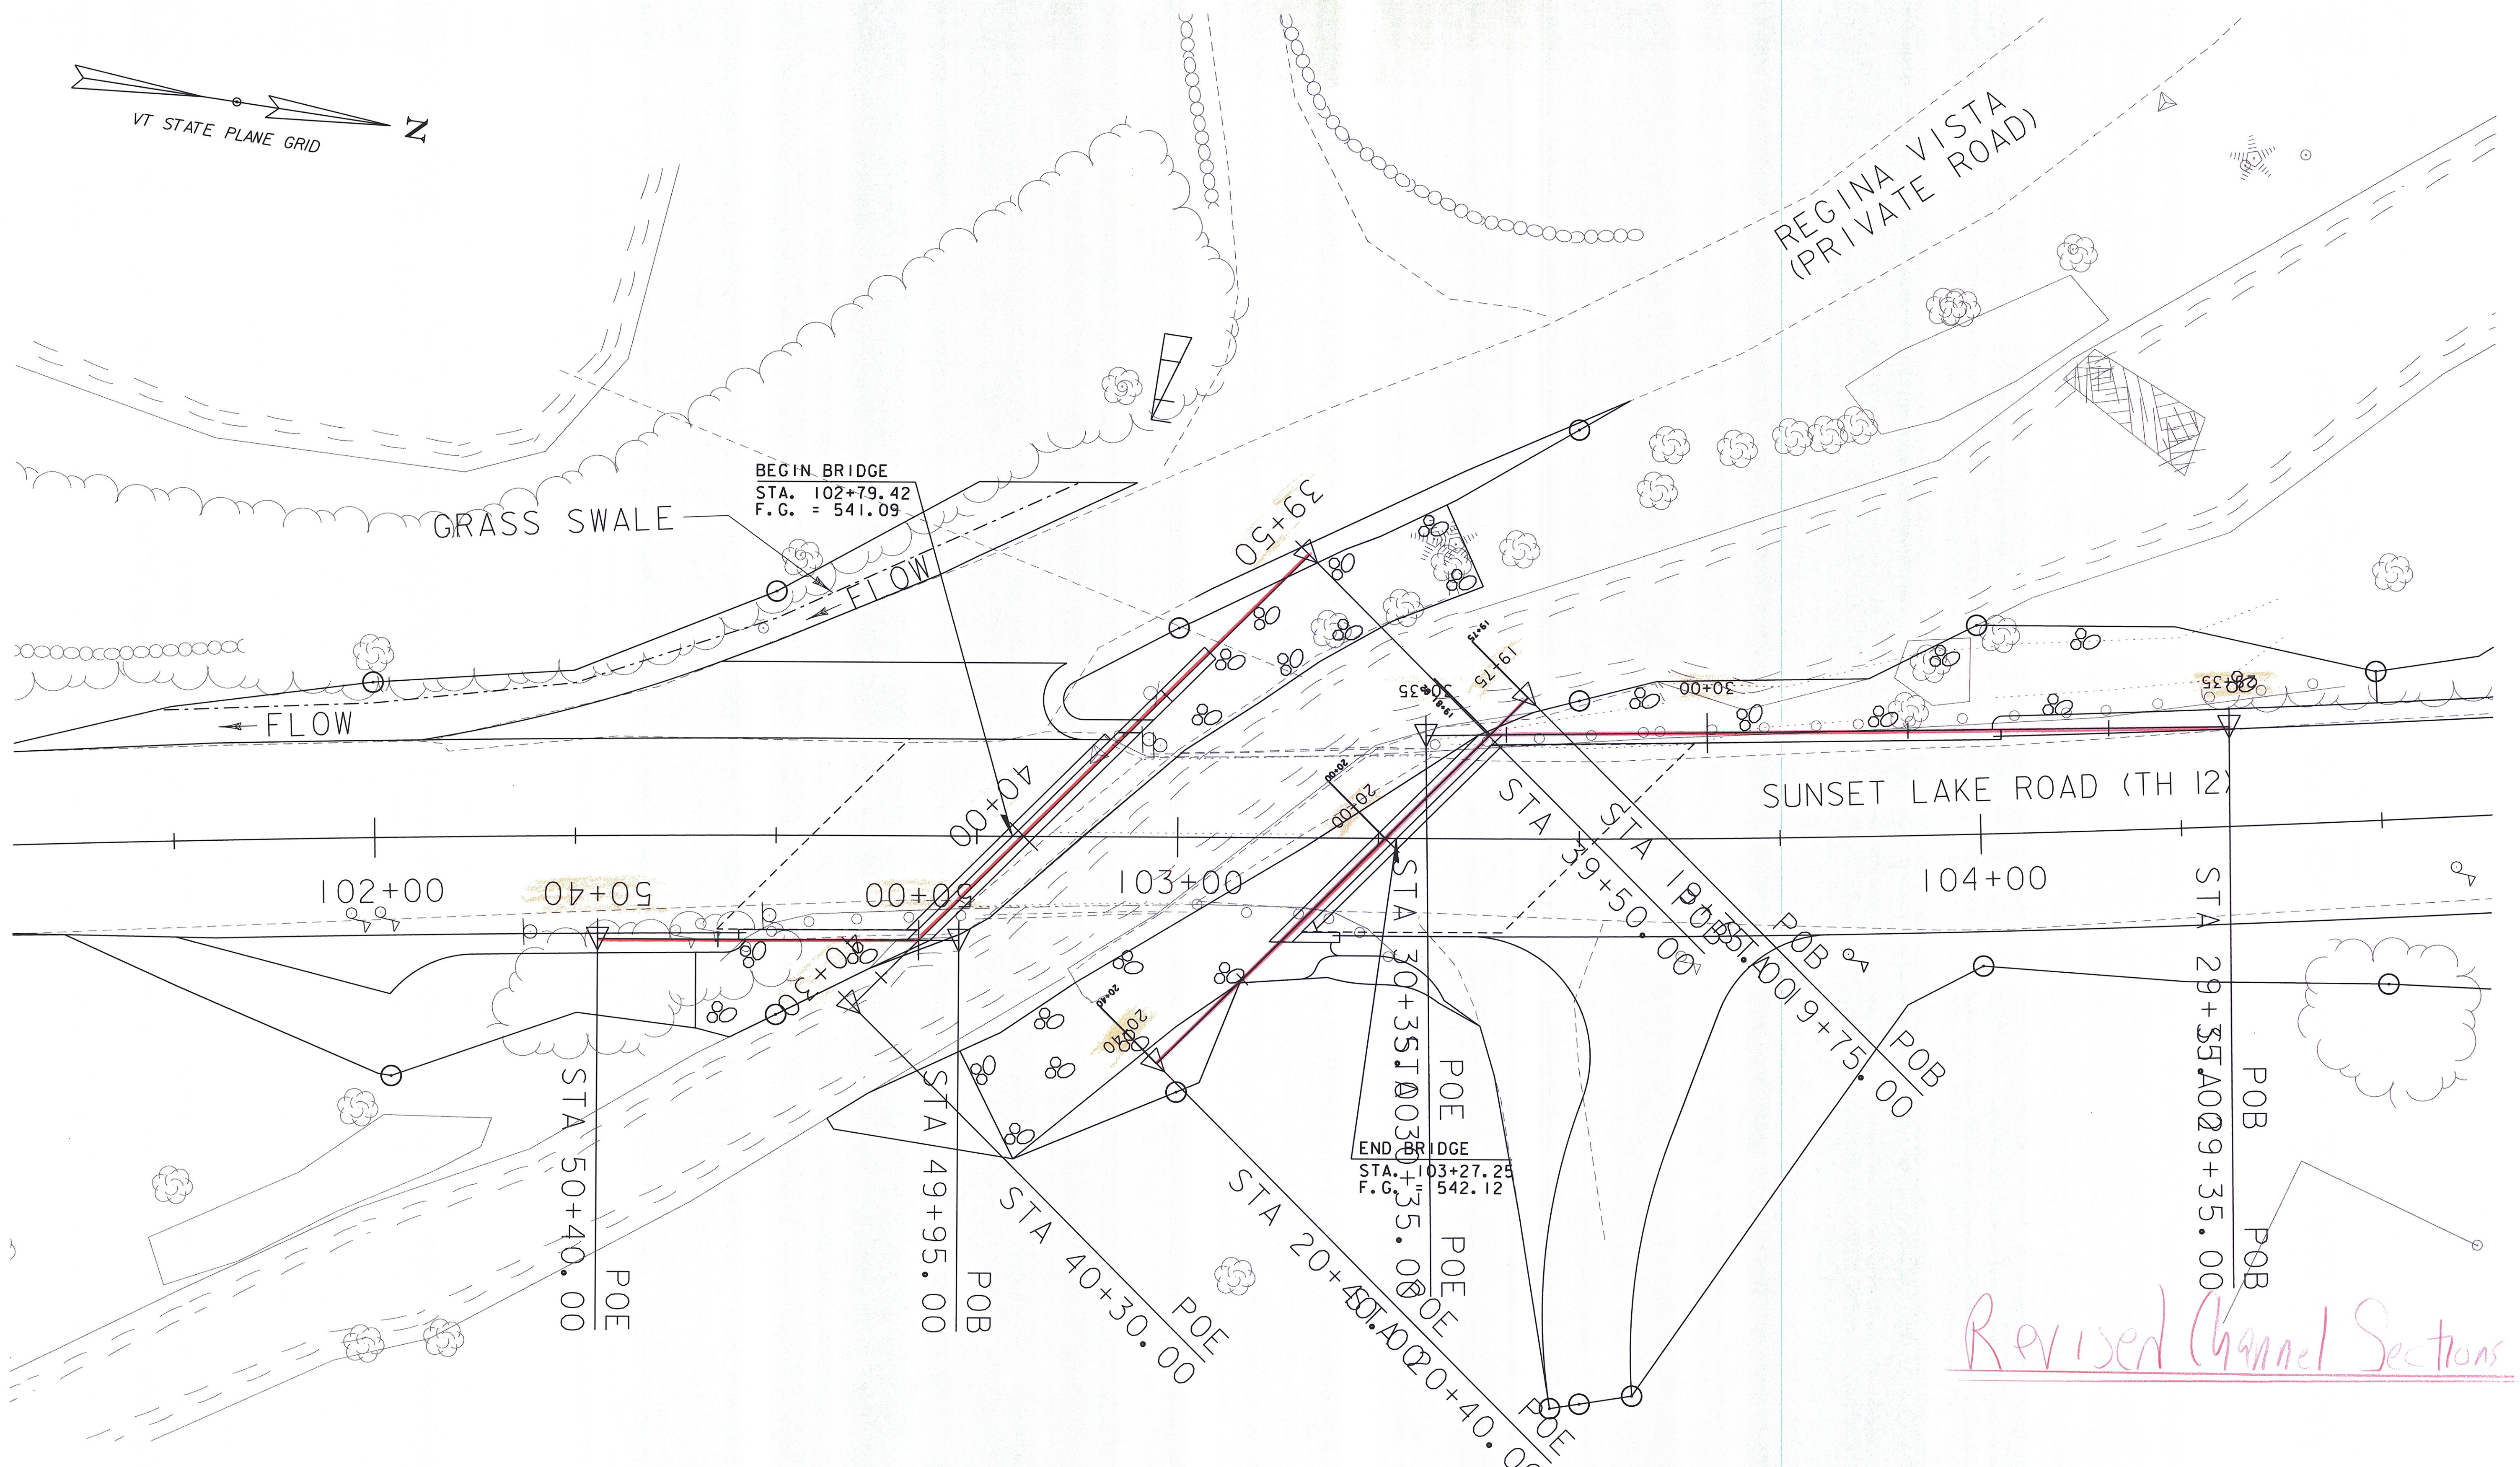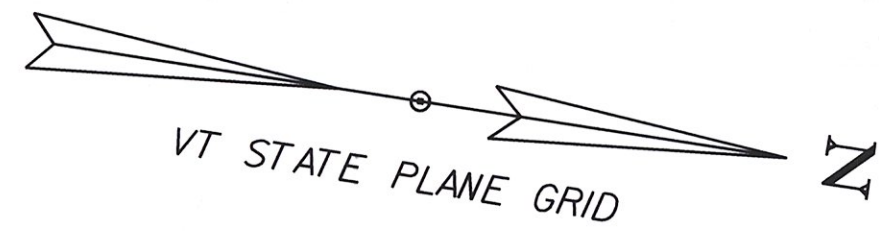


*Revised Channel Sections*

SCALE 1" = 10'-0"




PROJECT NAME:	BRATTLEBORO	FILE NAME: \$files\$	PLOT DATE: 3/2/2015
PROJECT NUMBER:	BRO 1442(35)	PROJECT LEADER: S.E. BURBANK	DRAWN BY: E.F. LAWES
		DESIGNED BY: E.F. LAWES	CHECKED BY: S.E. BURBANK
		LAYOUT SHEET	SHEET 28 OF 28

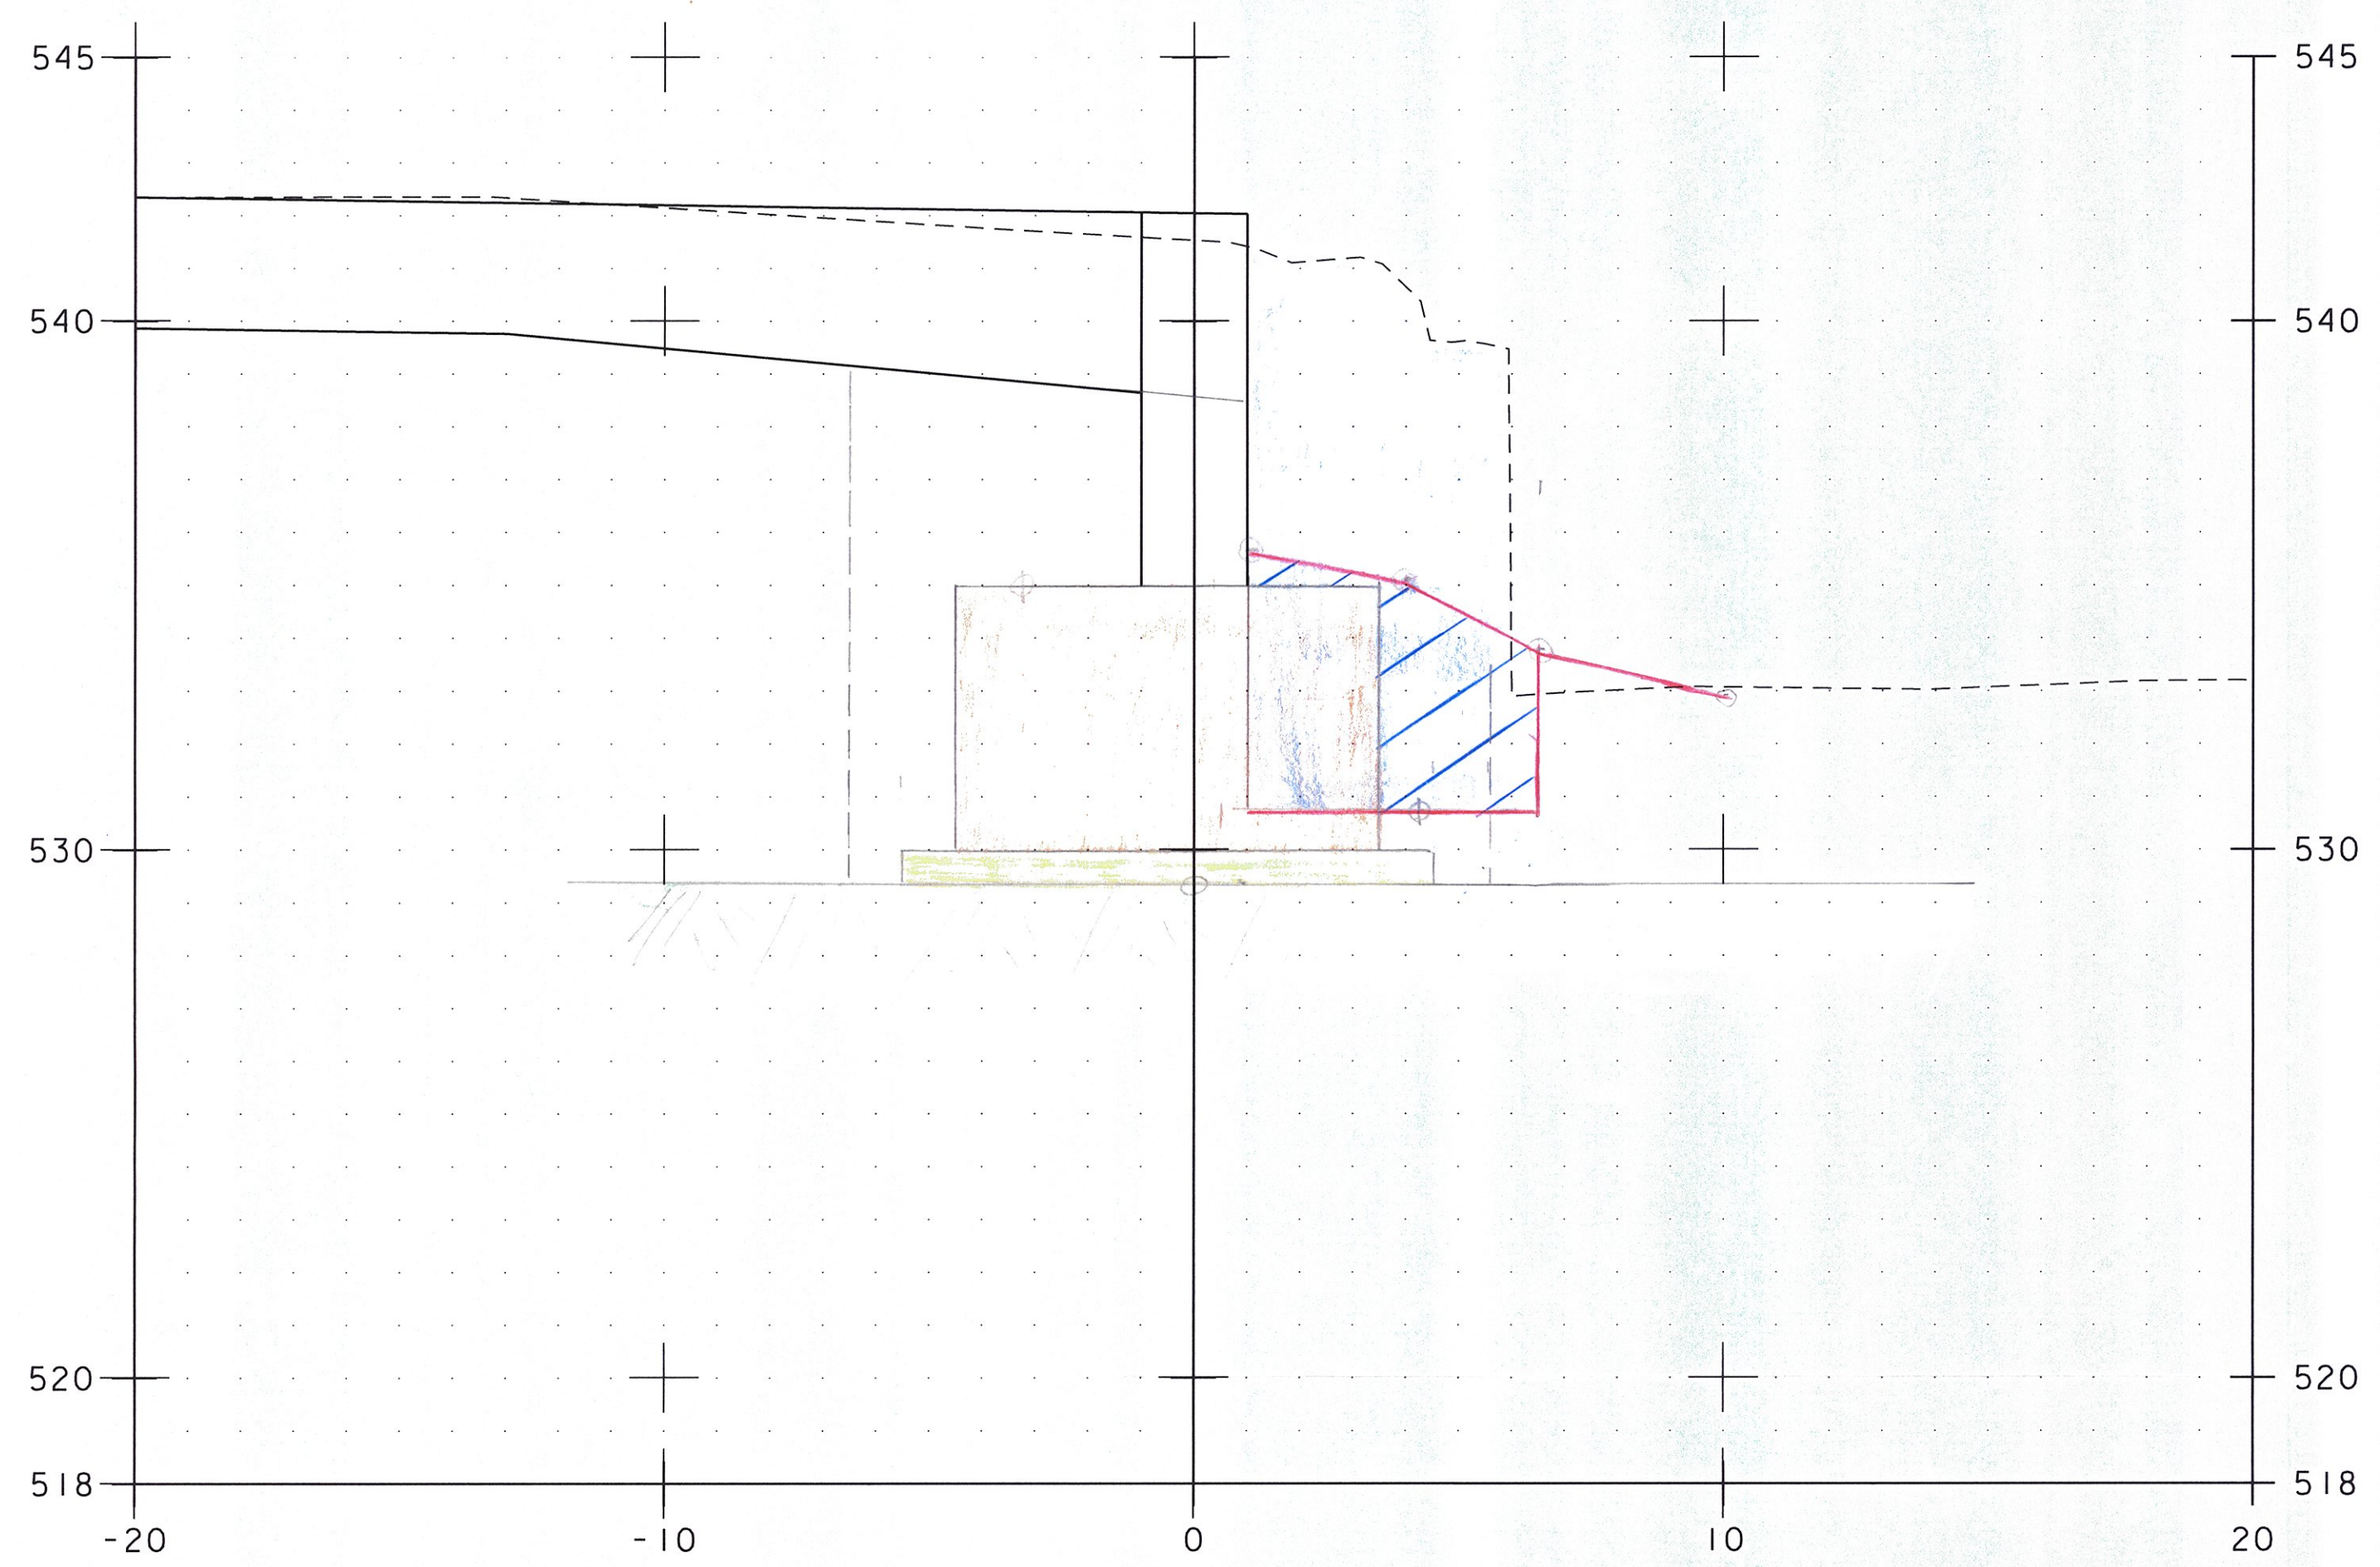

Cofferdam Earth = 77.0' ✓  
 Granular Base Fill for Structures = 77.7' ✓  
 Discrete Sand Channel Excavation = 81.0' ✓  
 Stone Fill, Type III = 12.4' ✓  
 Geotextile Stone Fill = 16' ✓  
 13.5' ✓ for 7/22/15  
 m.w.h. 6/26/15  
 JDD 7-1-15

19+87.00

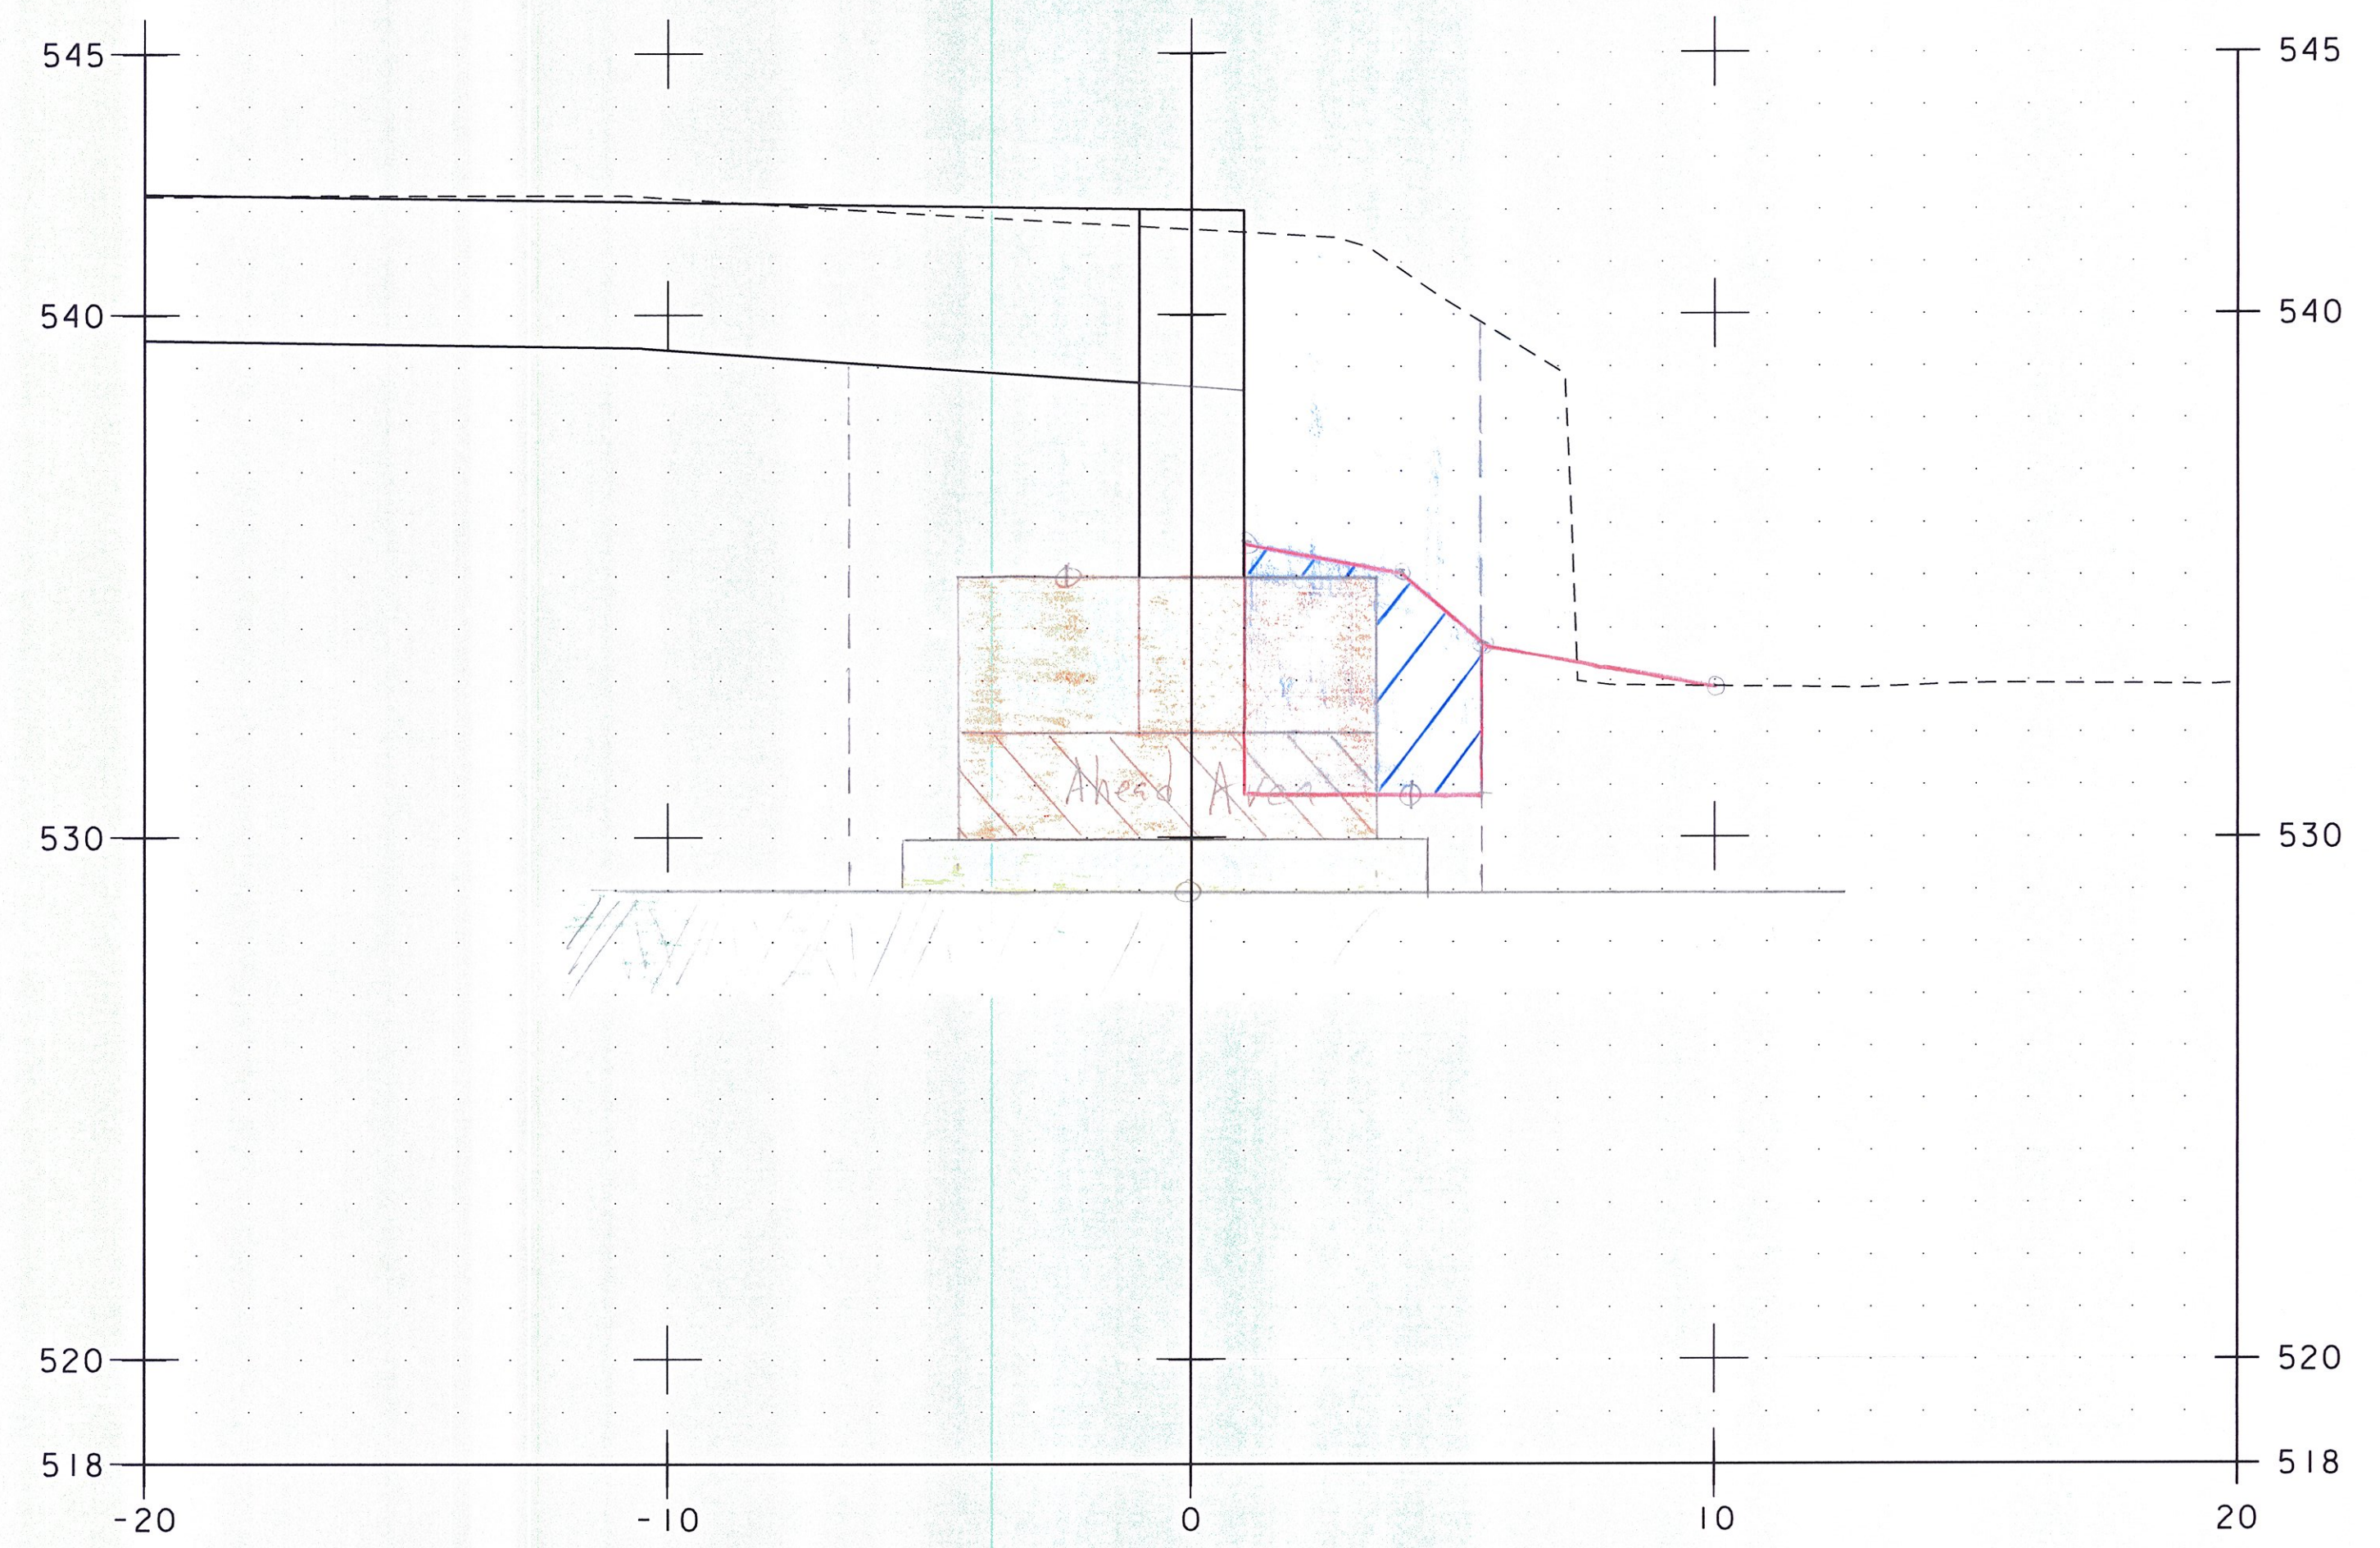

Cofferdam Earth = 82.1' ✓  
 Granular Base Fill for Structures  
 (bk) = 82.0' ✓  
 Geotextile Stone Fill = 49.7' ✓  
 Discrete Sand Channel Excavation = 52.1' ✓  
 Stone Fill, Type III  
 Geotextile Stone Fill = 14.9' ✓  
 Geotextile Stone Fill = 12.5' ✓ m.w.h. 6/26/15


19+89.50 back of canal

NOTE: LOCATION OF SUBBASE IS APPROXIMATE, PROPOSED GRADE IS NOT SHOWN.

PROJECT NAME: BRATTLEBORO	
PROJECT NUMBER: BRO 1442(35)	
FILE NAME: z10j062_customEL.dgn	PLOT DATE: 3/2/2015
PROJECT LEADER: S.E. BURBANK	DRAWN BY: E.F. LAWES
DESIGNED BY: E.F. LAWES	CHECKED BY: S.E. BURBANK
ABUTMENT NO. 2 CROSS SECTIONS (3 OF 9)	SHEET 3 OF 28




SCALE 1" = 3'-0"

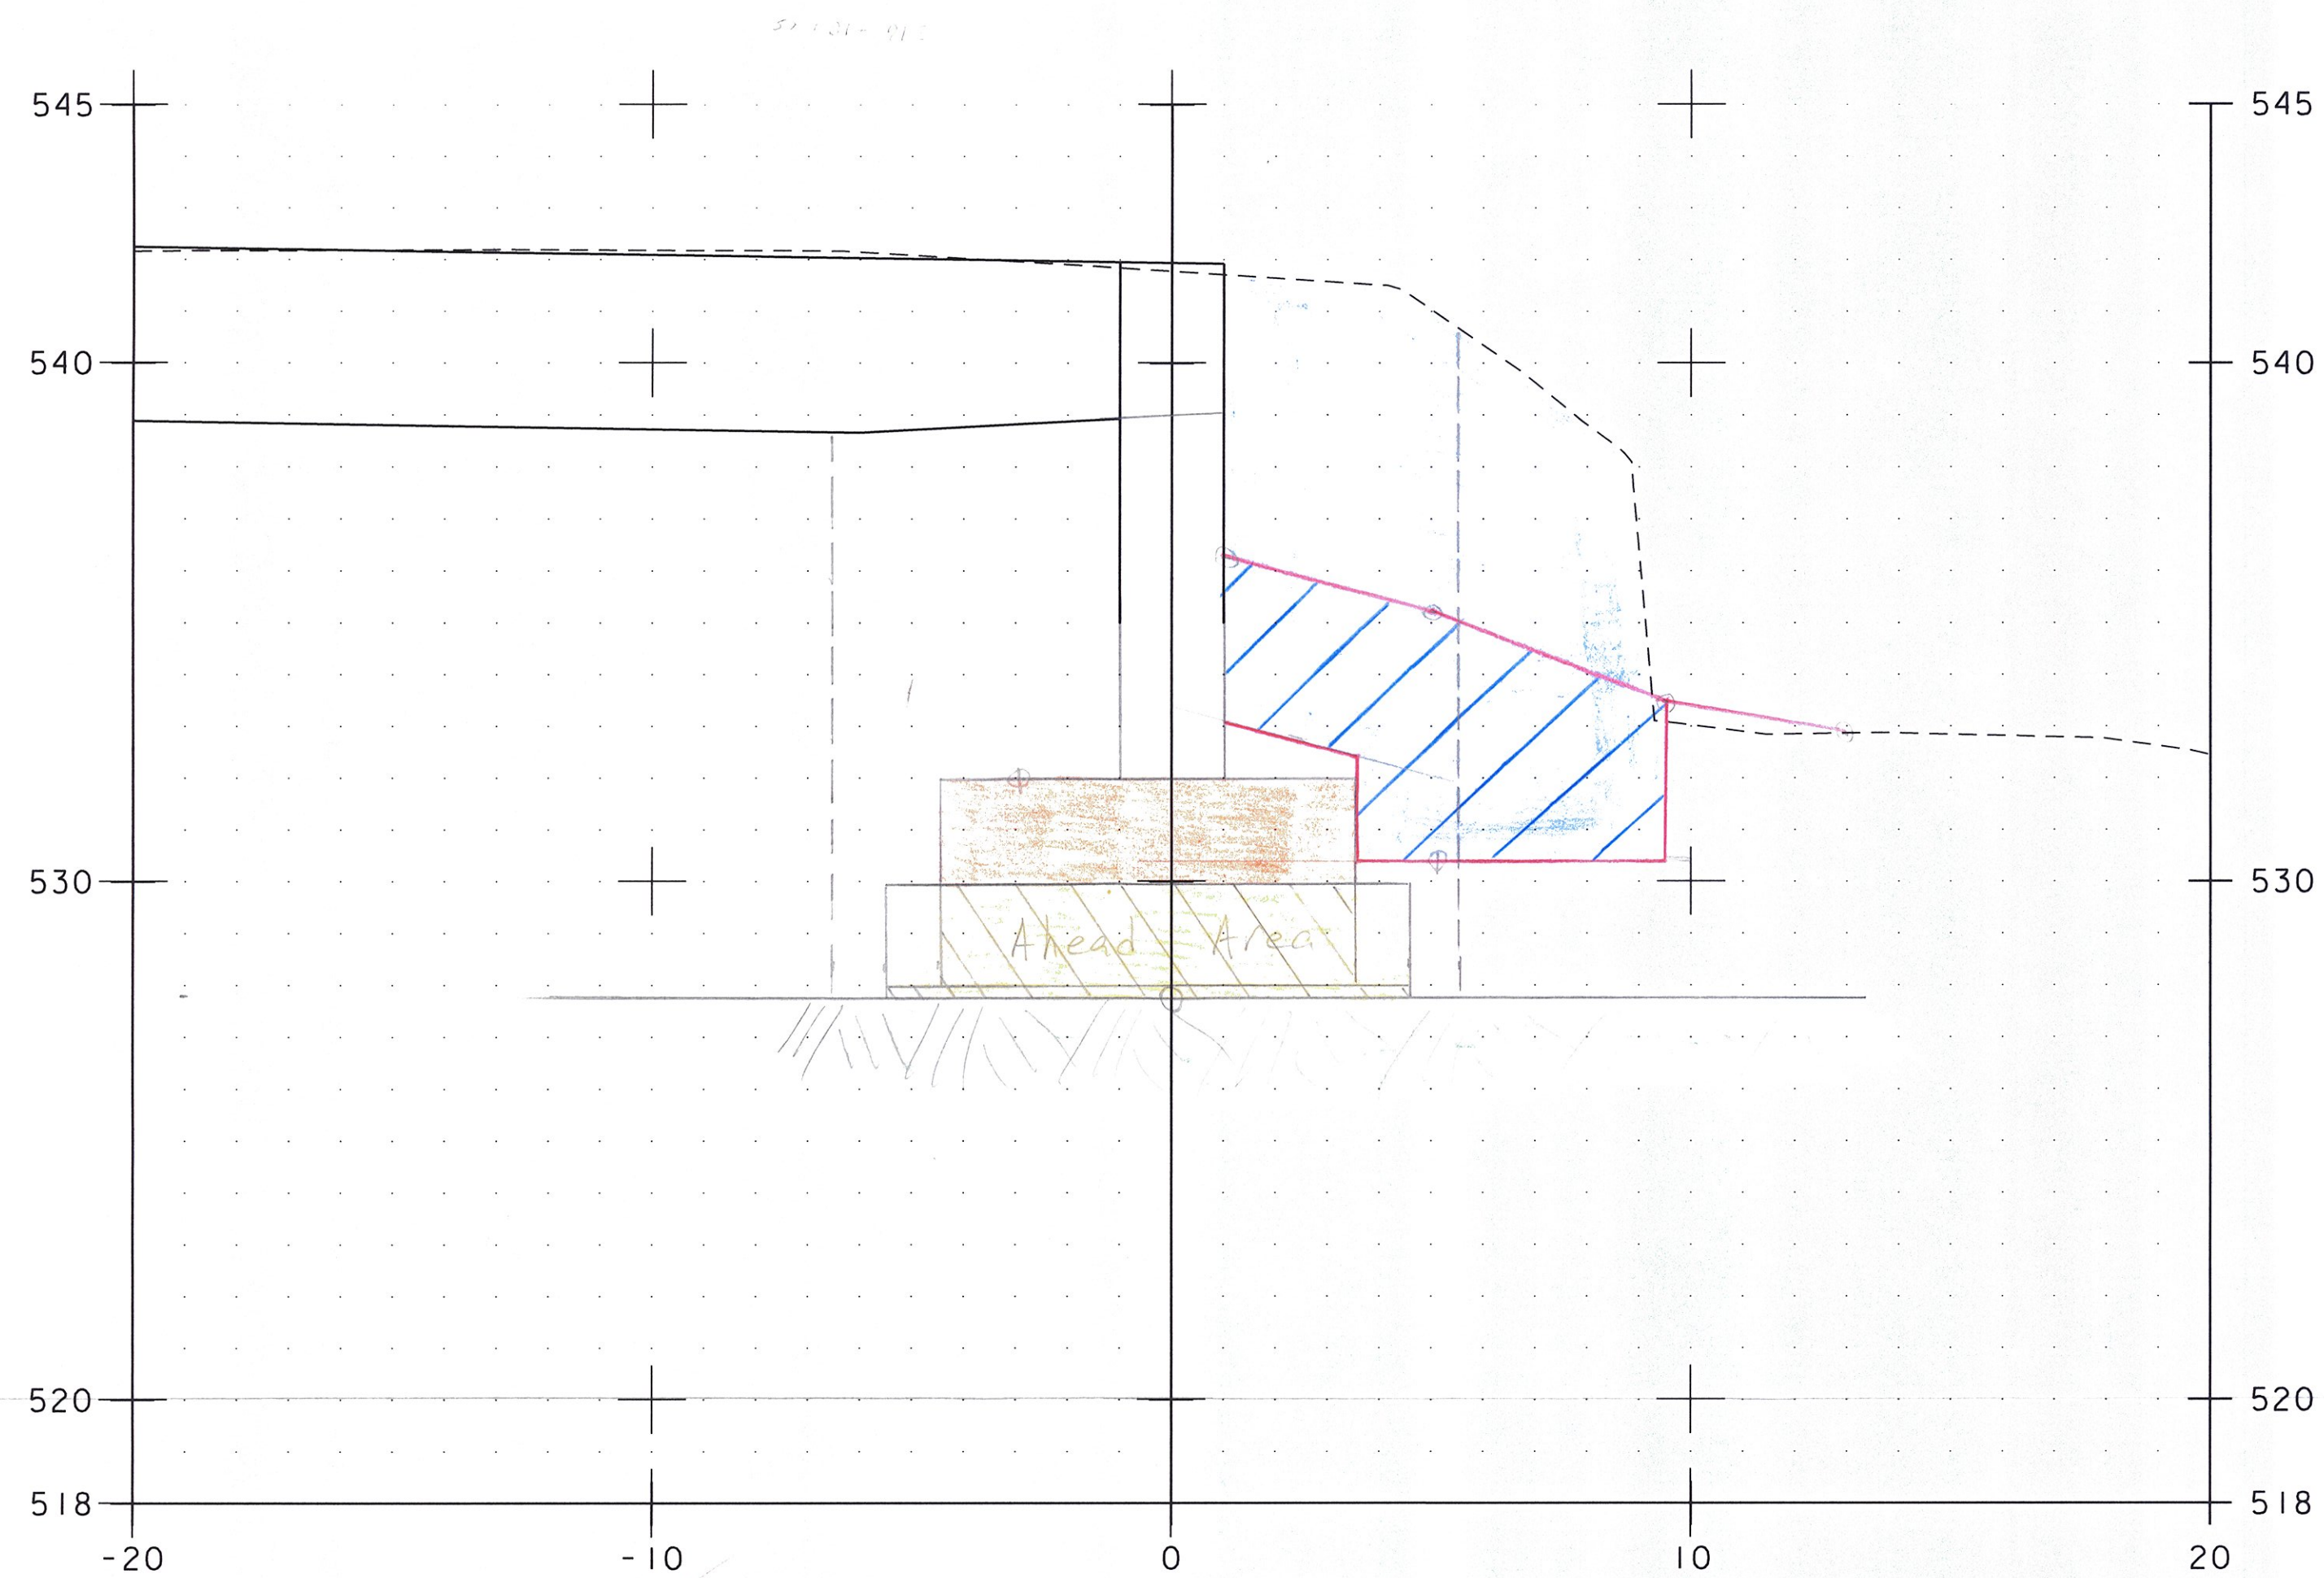

Confirmed Earth = 1010.90 ✓  
 Granular Backfill Structure  
 (L) = 48.2 FT ✓  
 (R) = 63.2 FT ✓  
 Unclassified Channel Exc = 76.0 FT ✓  
 Stone Fill, Type II = 32.9 FT ✓  
 Conc. Under Stone Fill = 16.5 FT ✓  
 M.W.H. 6/26/15 ✓  
 JDD 7-1-15 ✓

19+94.00 back ahead

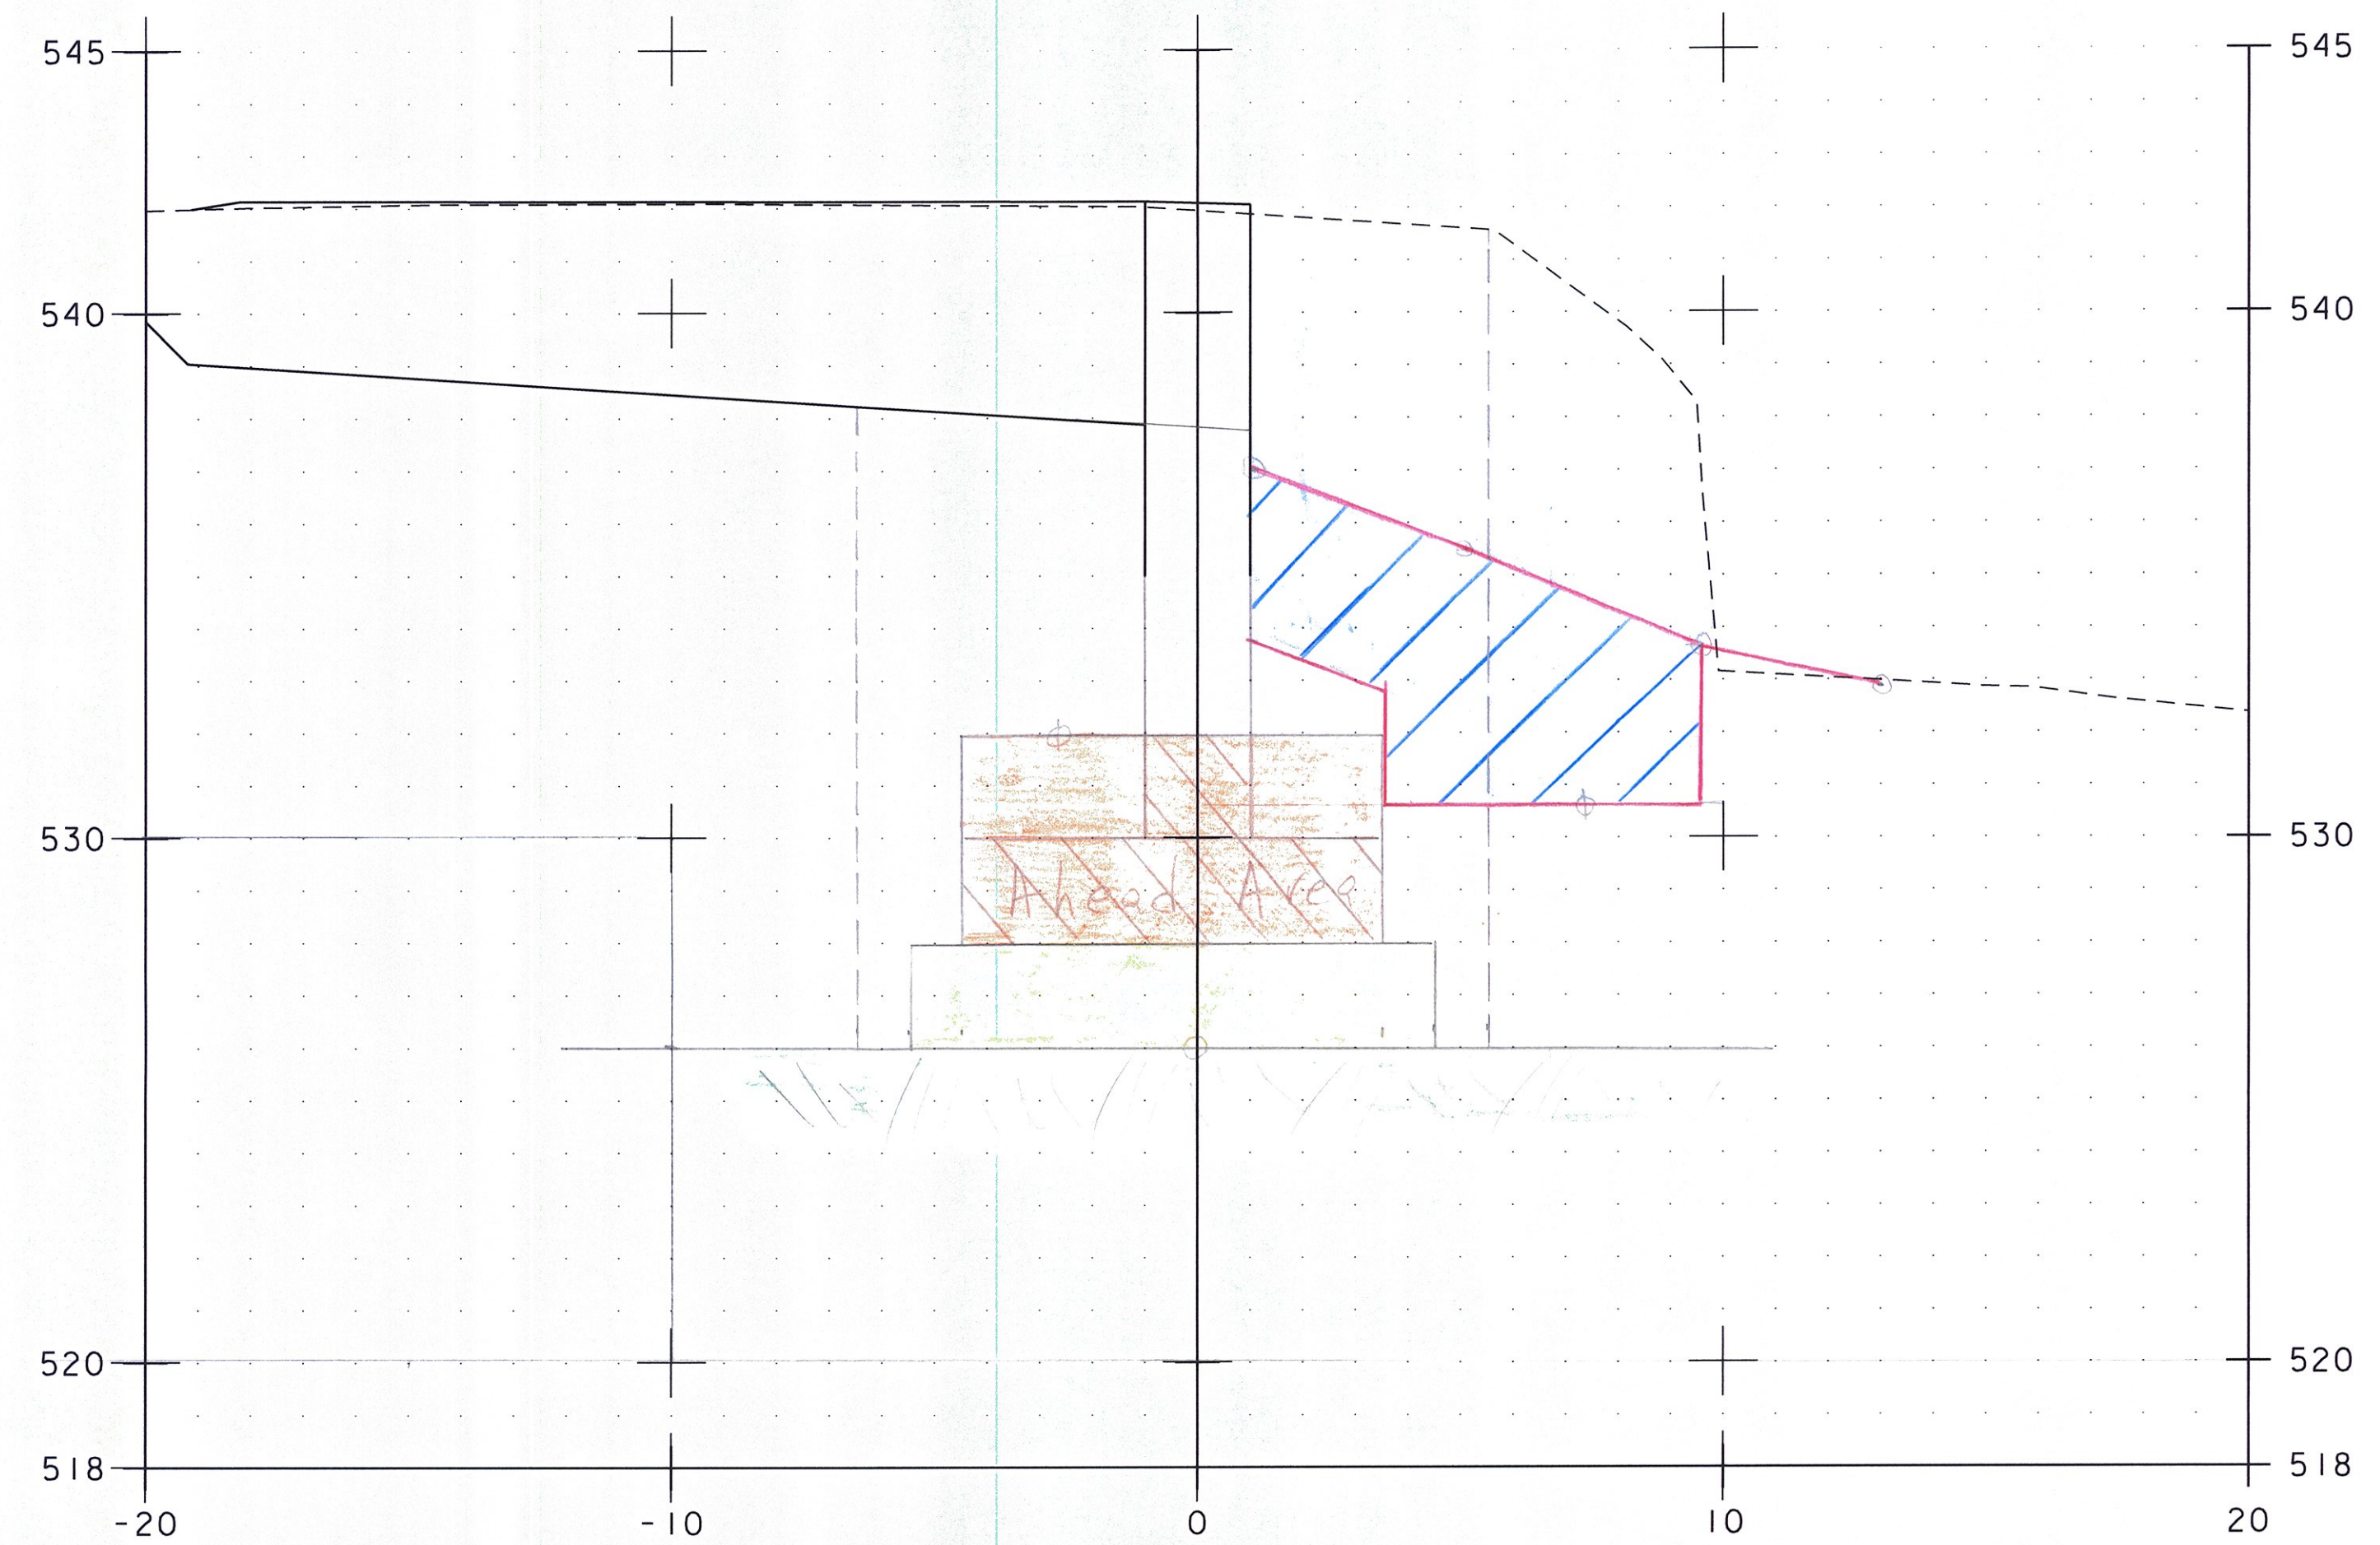

Confirmed Earth = 116.1 FT ✓  
 Granular Backfill Structure  
 (L) = 53.5 FT ✓  
 (R) = 65.3 FT ✓  
 Unclassified Channel Exc = 51.0 FT ✓  
 Stone Fill, Type II = 37.3 FT ✓  
 Conc. Under Stone Fill = 18.7 FT ✓  
 M.W.H. 6/26/15 ✓  
 JDD 7-1-15 ✓


19+99.00 back ahead

NOTE: LOCATION OF SUBBASE IS APPROXIMATE, PROPOSED GRADE IS NOT SHOWN.

PROJECT NAME: BRATTLEBORO	
PROJECT NUMBER: BRO 1442(35)	
FILE NAME: z10j062_customEL.dgn	PLOT DATE: 3/2/2015
PROJECT LEADER: S.E. BURBANK	DRAWN BY: E.F. LAWES
DESIGNED BY: E.F. LAWES	CHECKED BY: S.E. BURBANK
ABUTMENT NO. 2 CROSS SECTIONS (4 OF 9)	SHEET 4 OF 28




SCALE 1" = 3'-0"

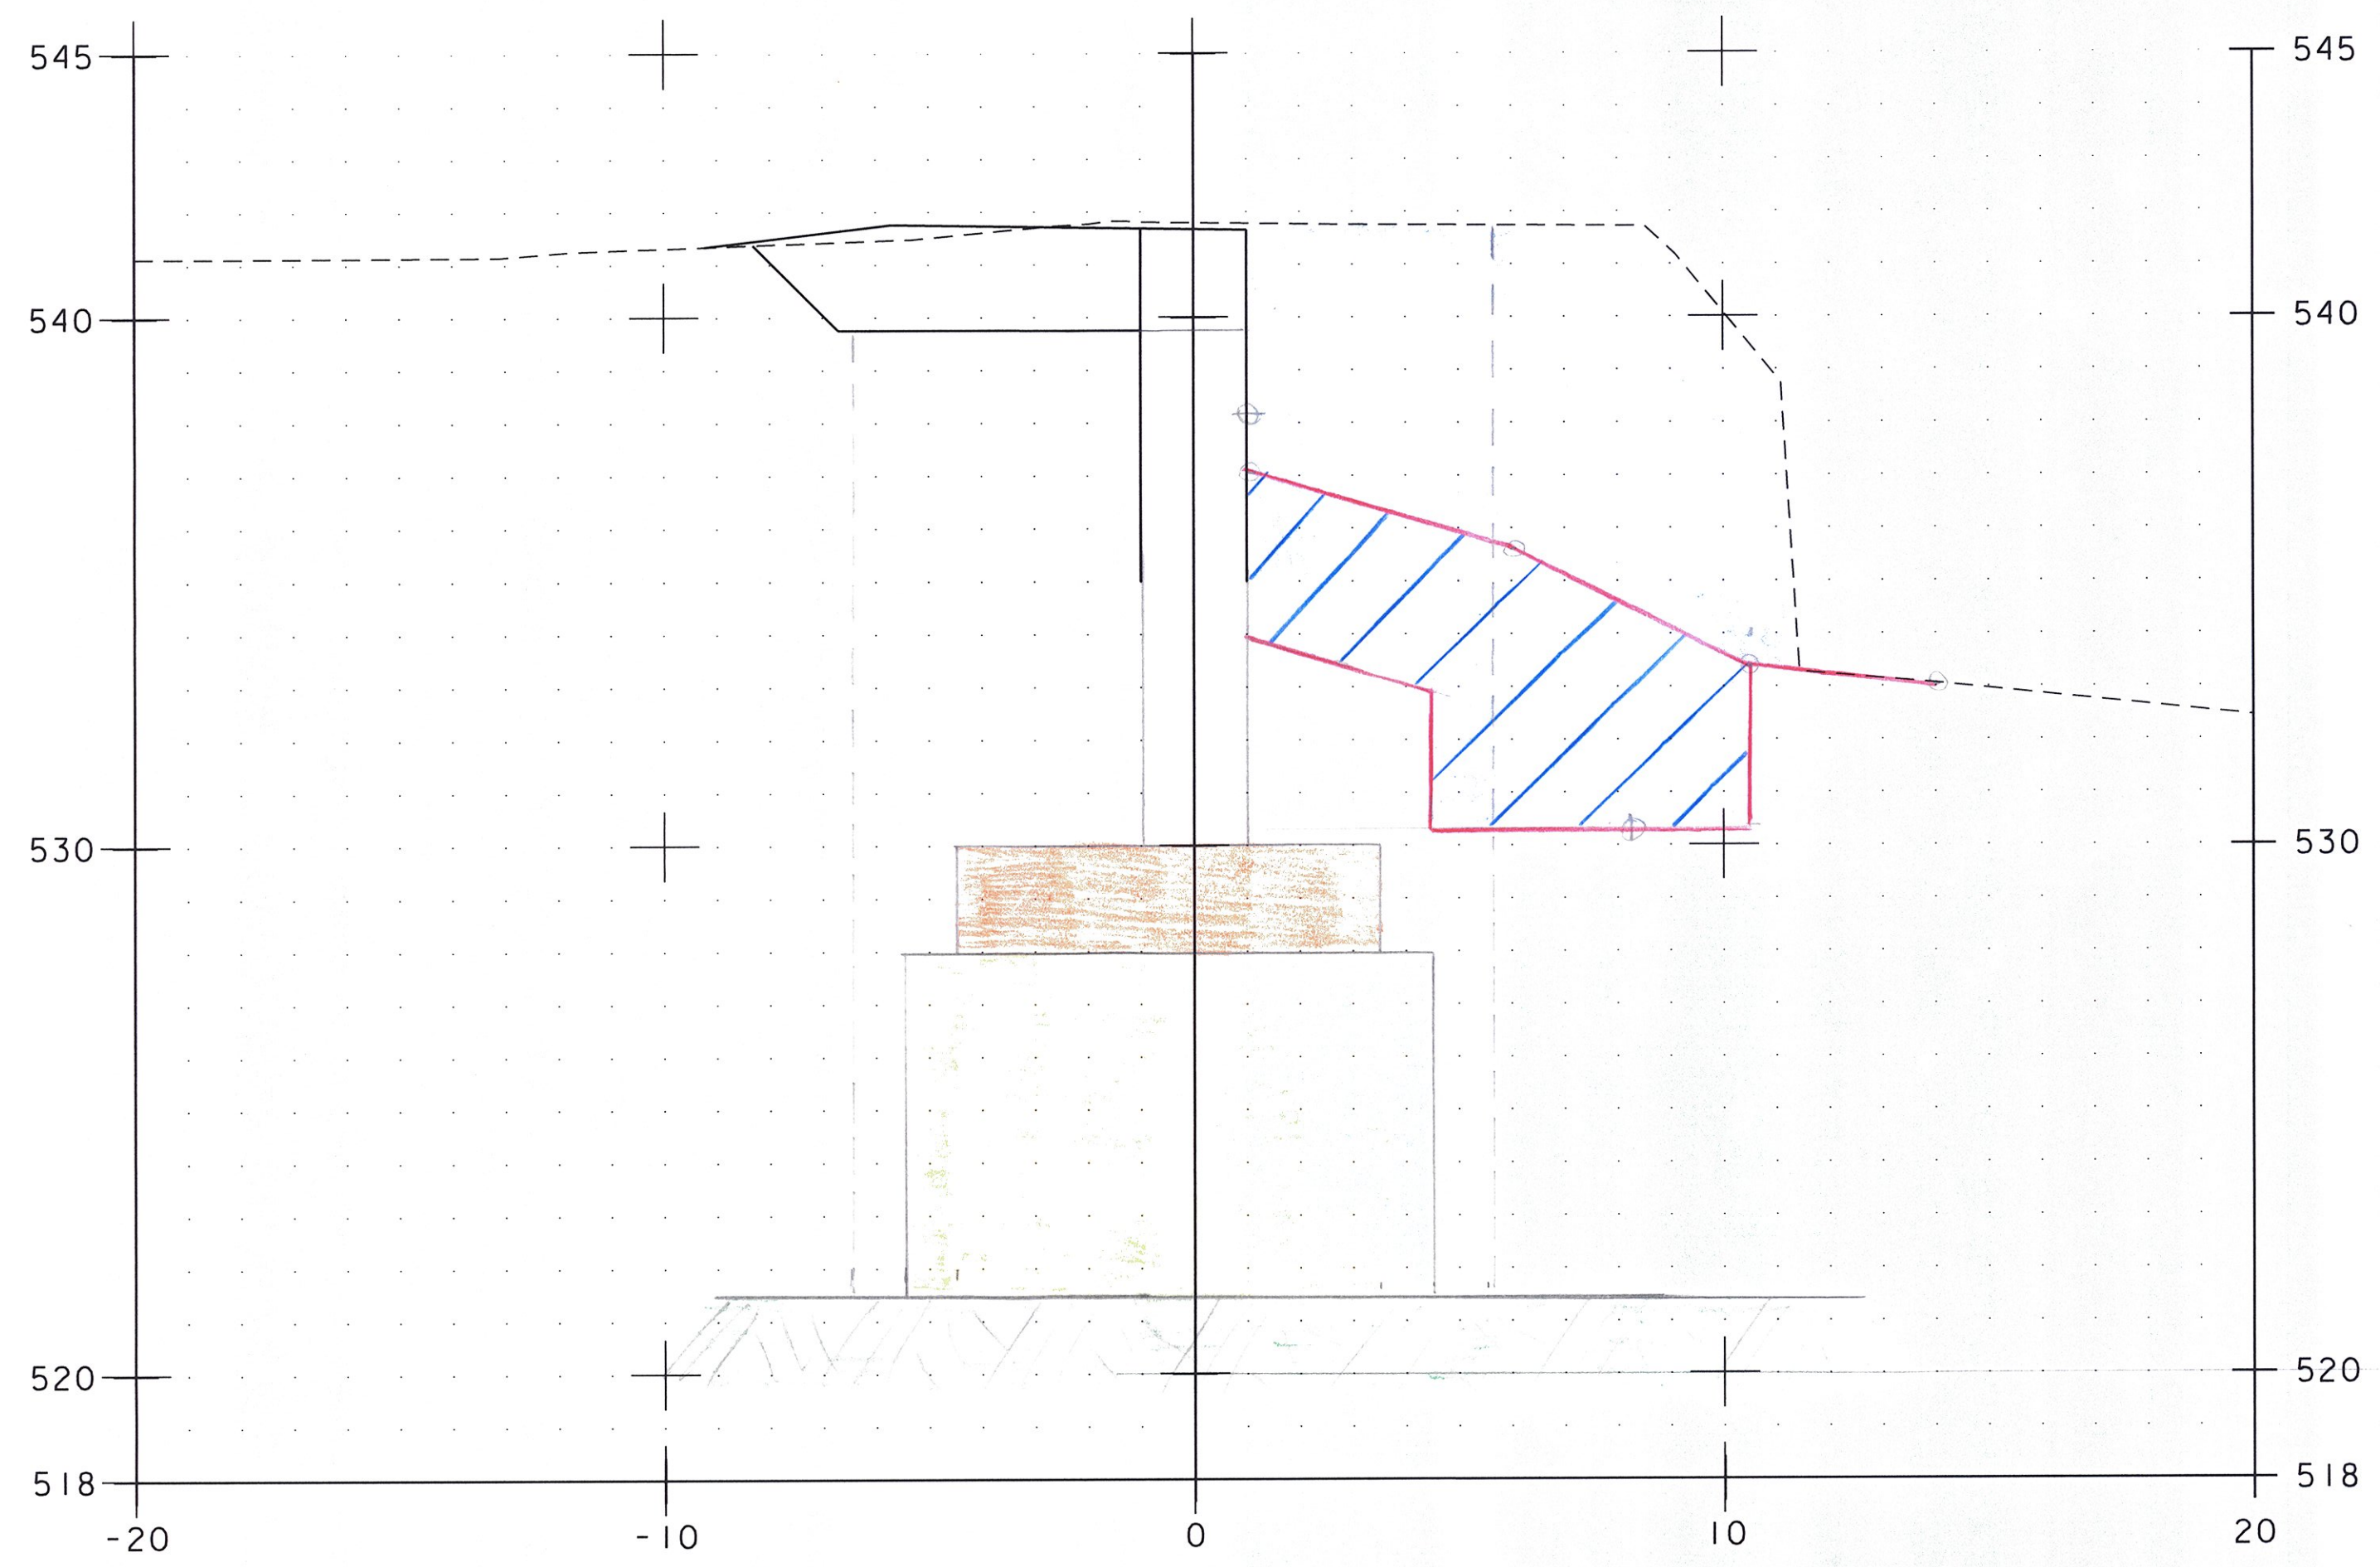

Cofferdam Earth = 185.7 FT³ ✓  
 Granular Base/Fill for Str = 86.4 FT³ ✓  
 Unclassified Channel Exc = 98.8 FT³ ✓  
 Stone Fill, Type II = 38.4 FT³ ✓  
 Geo. Under Stone Fill = 18.5' M.W.H. 6/26/15  
 5/11/15  
 JDD 7/1/15

20+11.50

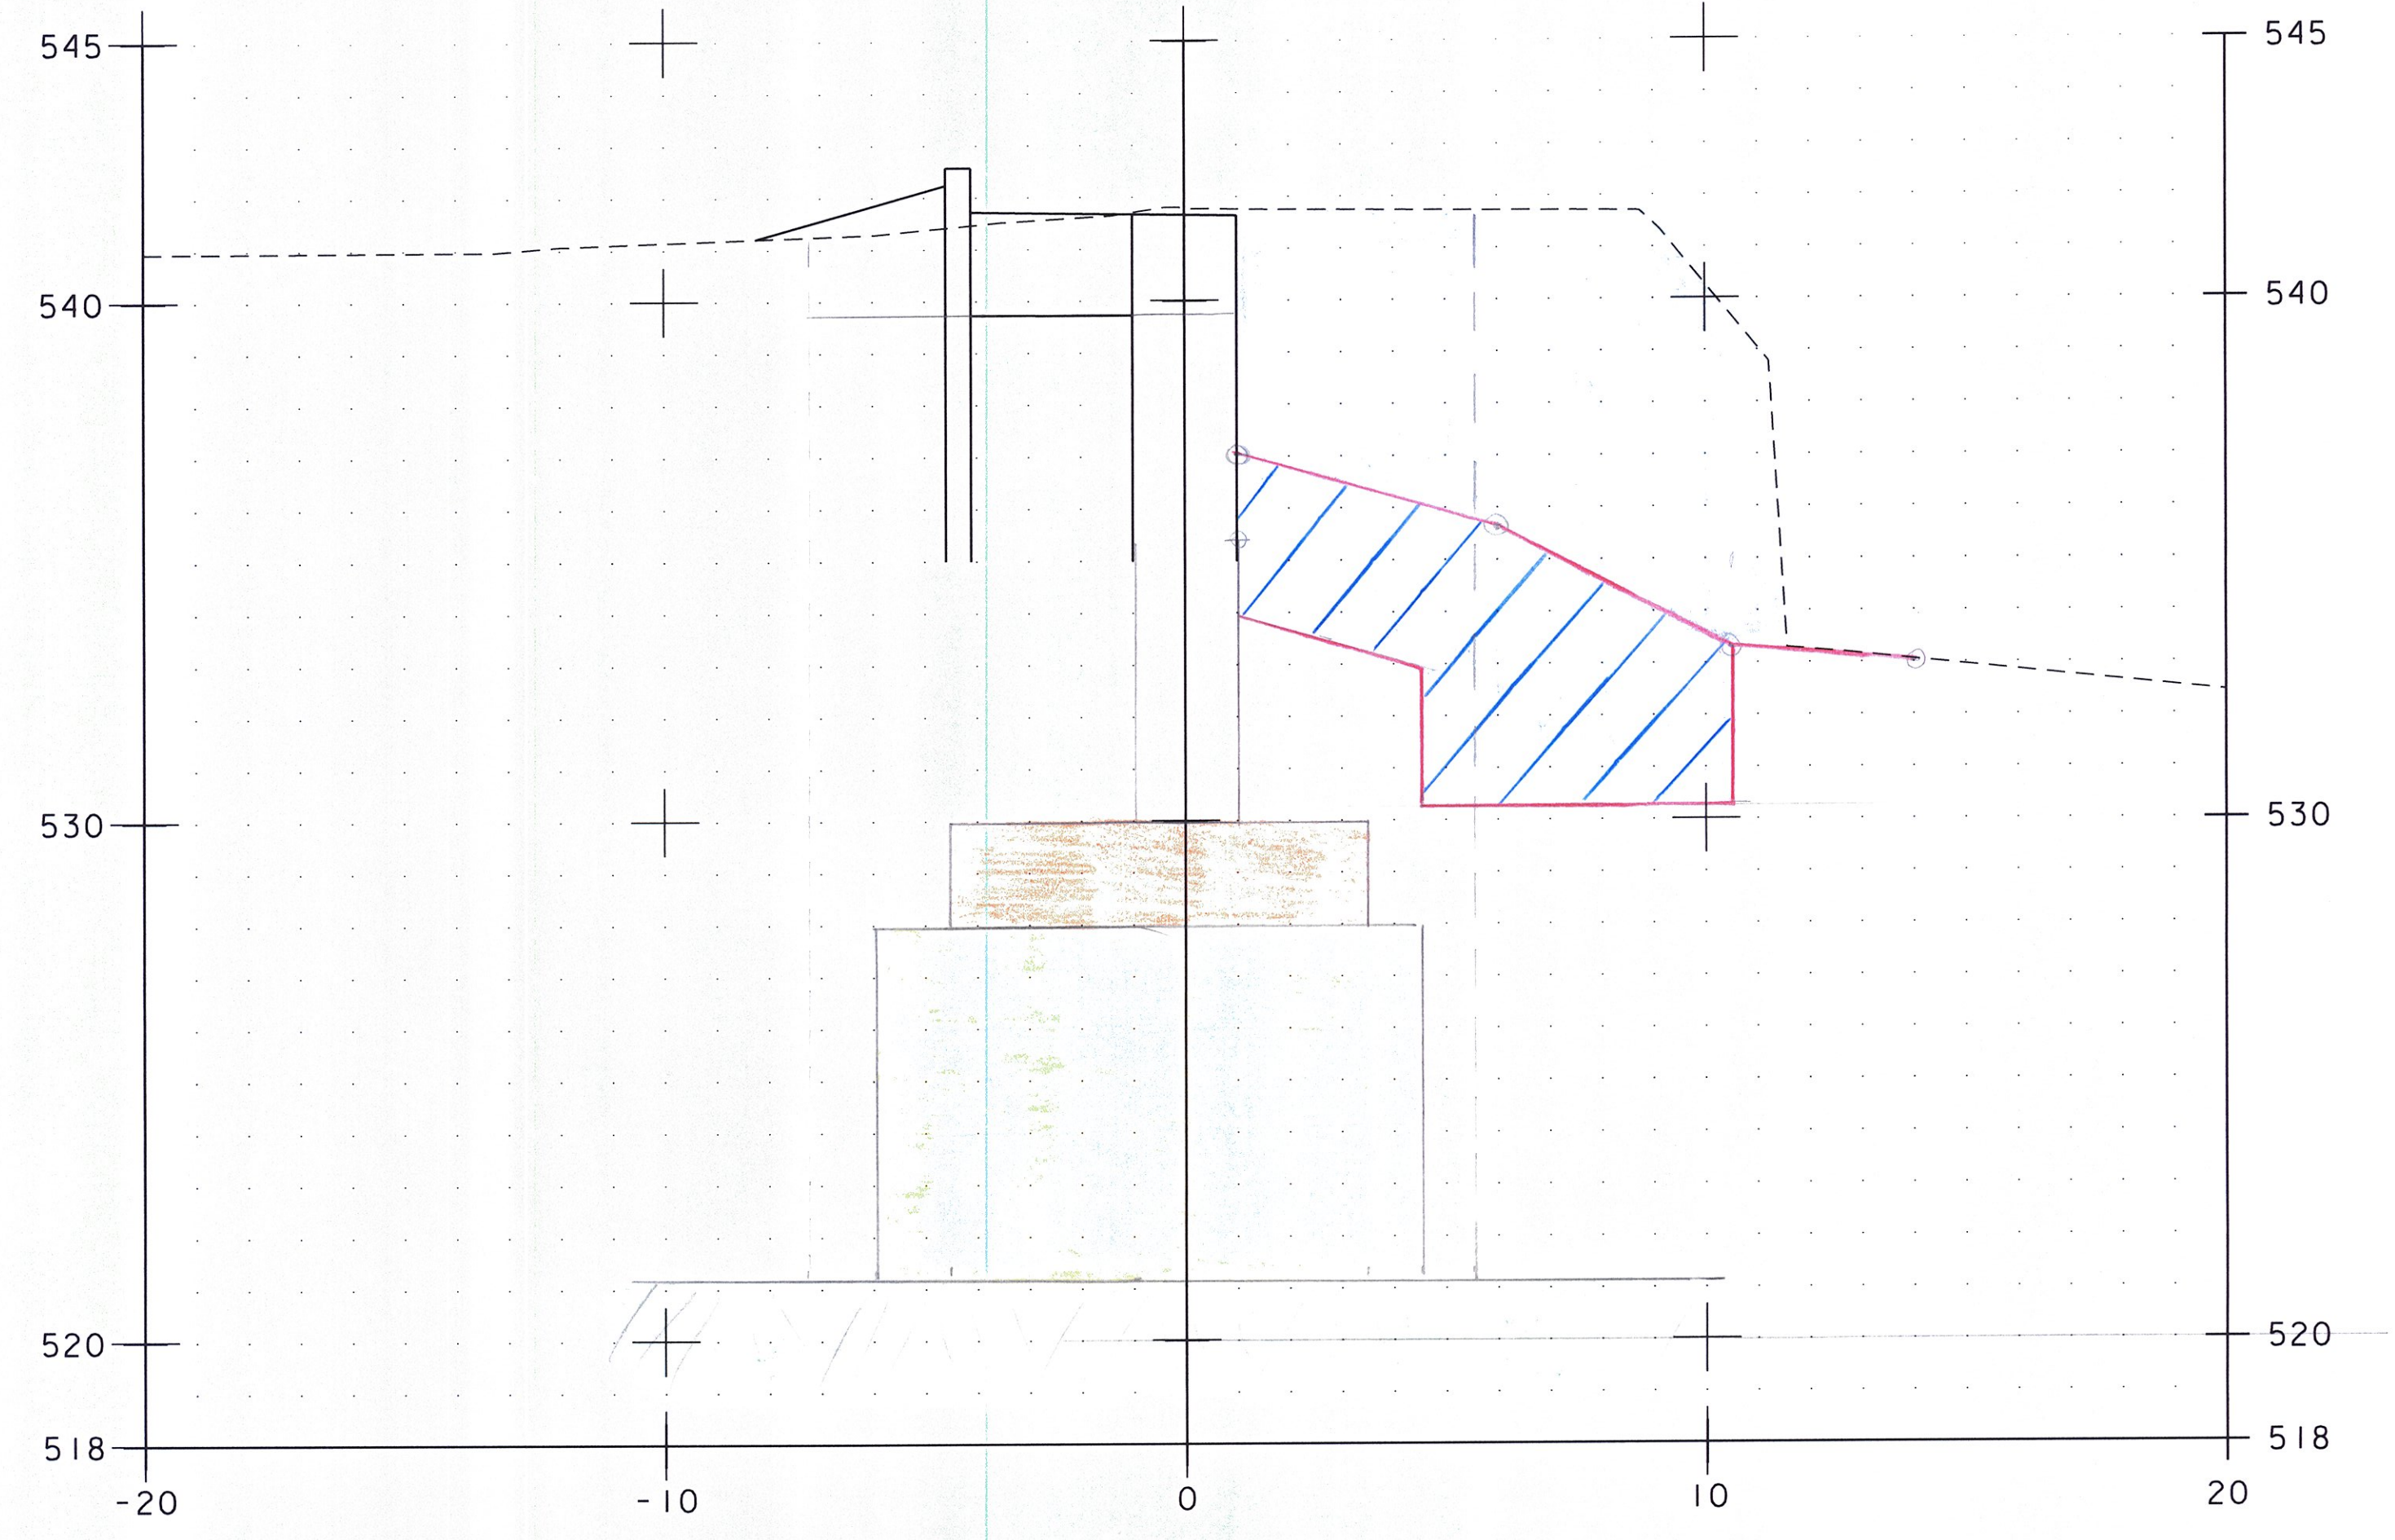

Cofferdam Earth = 204.8 FT³ ✓  
 Granular Base/Fill for Str = 27.5 FT³ ✓  
 Unclassified Channel Exc = 100.1 FT³ ✓  
 Stone Fill, Type II = 158.4 FT³ ✓  
 Geo. Under Stone Fill = 13.5' M.W.H. 6/26/15  
 5/11/15

20+12.50


NOTE: LOCATION OF SUBBASE IS APPROXIMATE, PROPOSED GRADE IS NOT SHOWN.

SCALE 1" = 3'-0"




PROJECT NAME:	BRATTLEBORO
PROJECT NUMBER:	BRO 1442(35)
FILE NAME:	z10j062_customEL.dgn
PROJECT LEADER:	S.E. BURBANK
DESIGNED BY:	E.F. LAWES
ABUTMENT NO. 2 CROSS SECTIONS (5 OF 9)	SHEET 5 OF 28
PLOT DATE:	3/2/2015
DRAWN BY:	E.F. LAWES
CHECKED BY:	S.E. BURBANK

2019

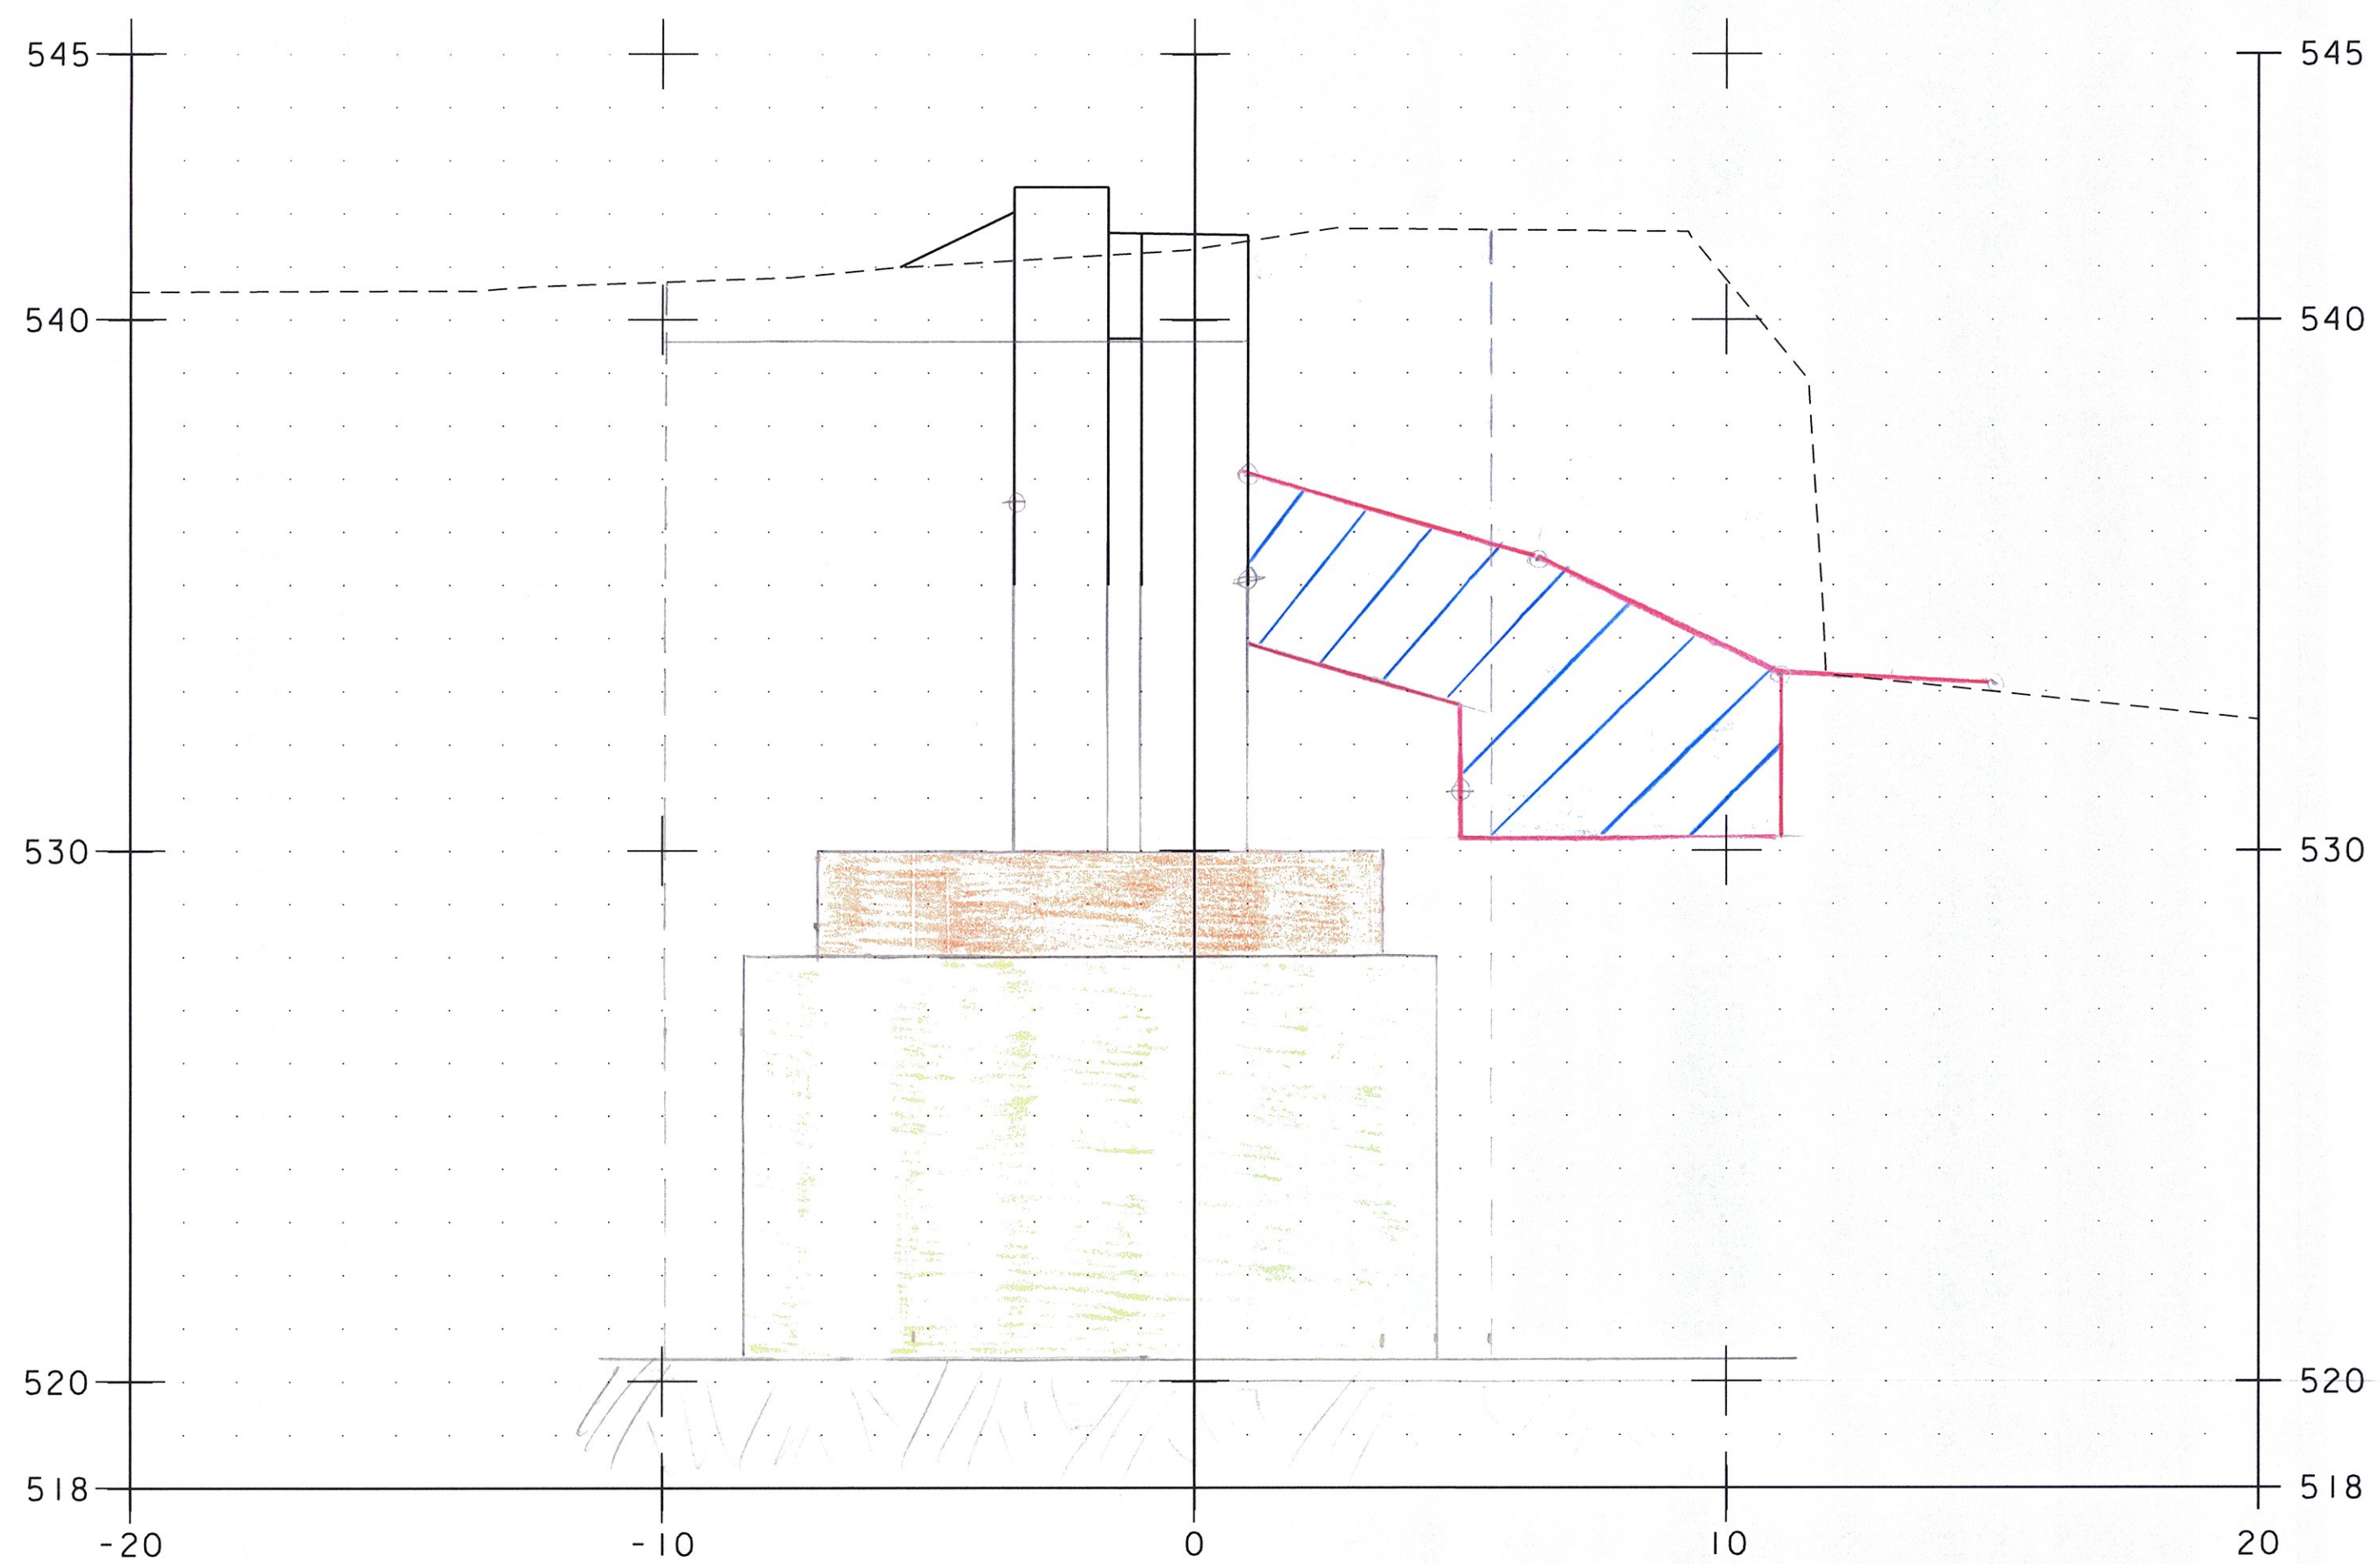

Cofferdam Earth = 2641 FT³ ✓  
 Granular backfill (ex. SW) = 103.7 FT³ ✓  
 Unclassified Channel Exc = 102.9 FT³ ✓  
 Stone Fill, type III = 40.0 FT³ ✓  
 Geo. Under Stone Fill = 19' M.W.H. 6/26/15  
 JFD 7-1-15

20+15.00

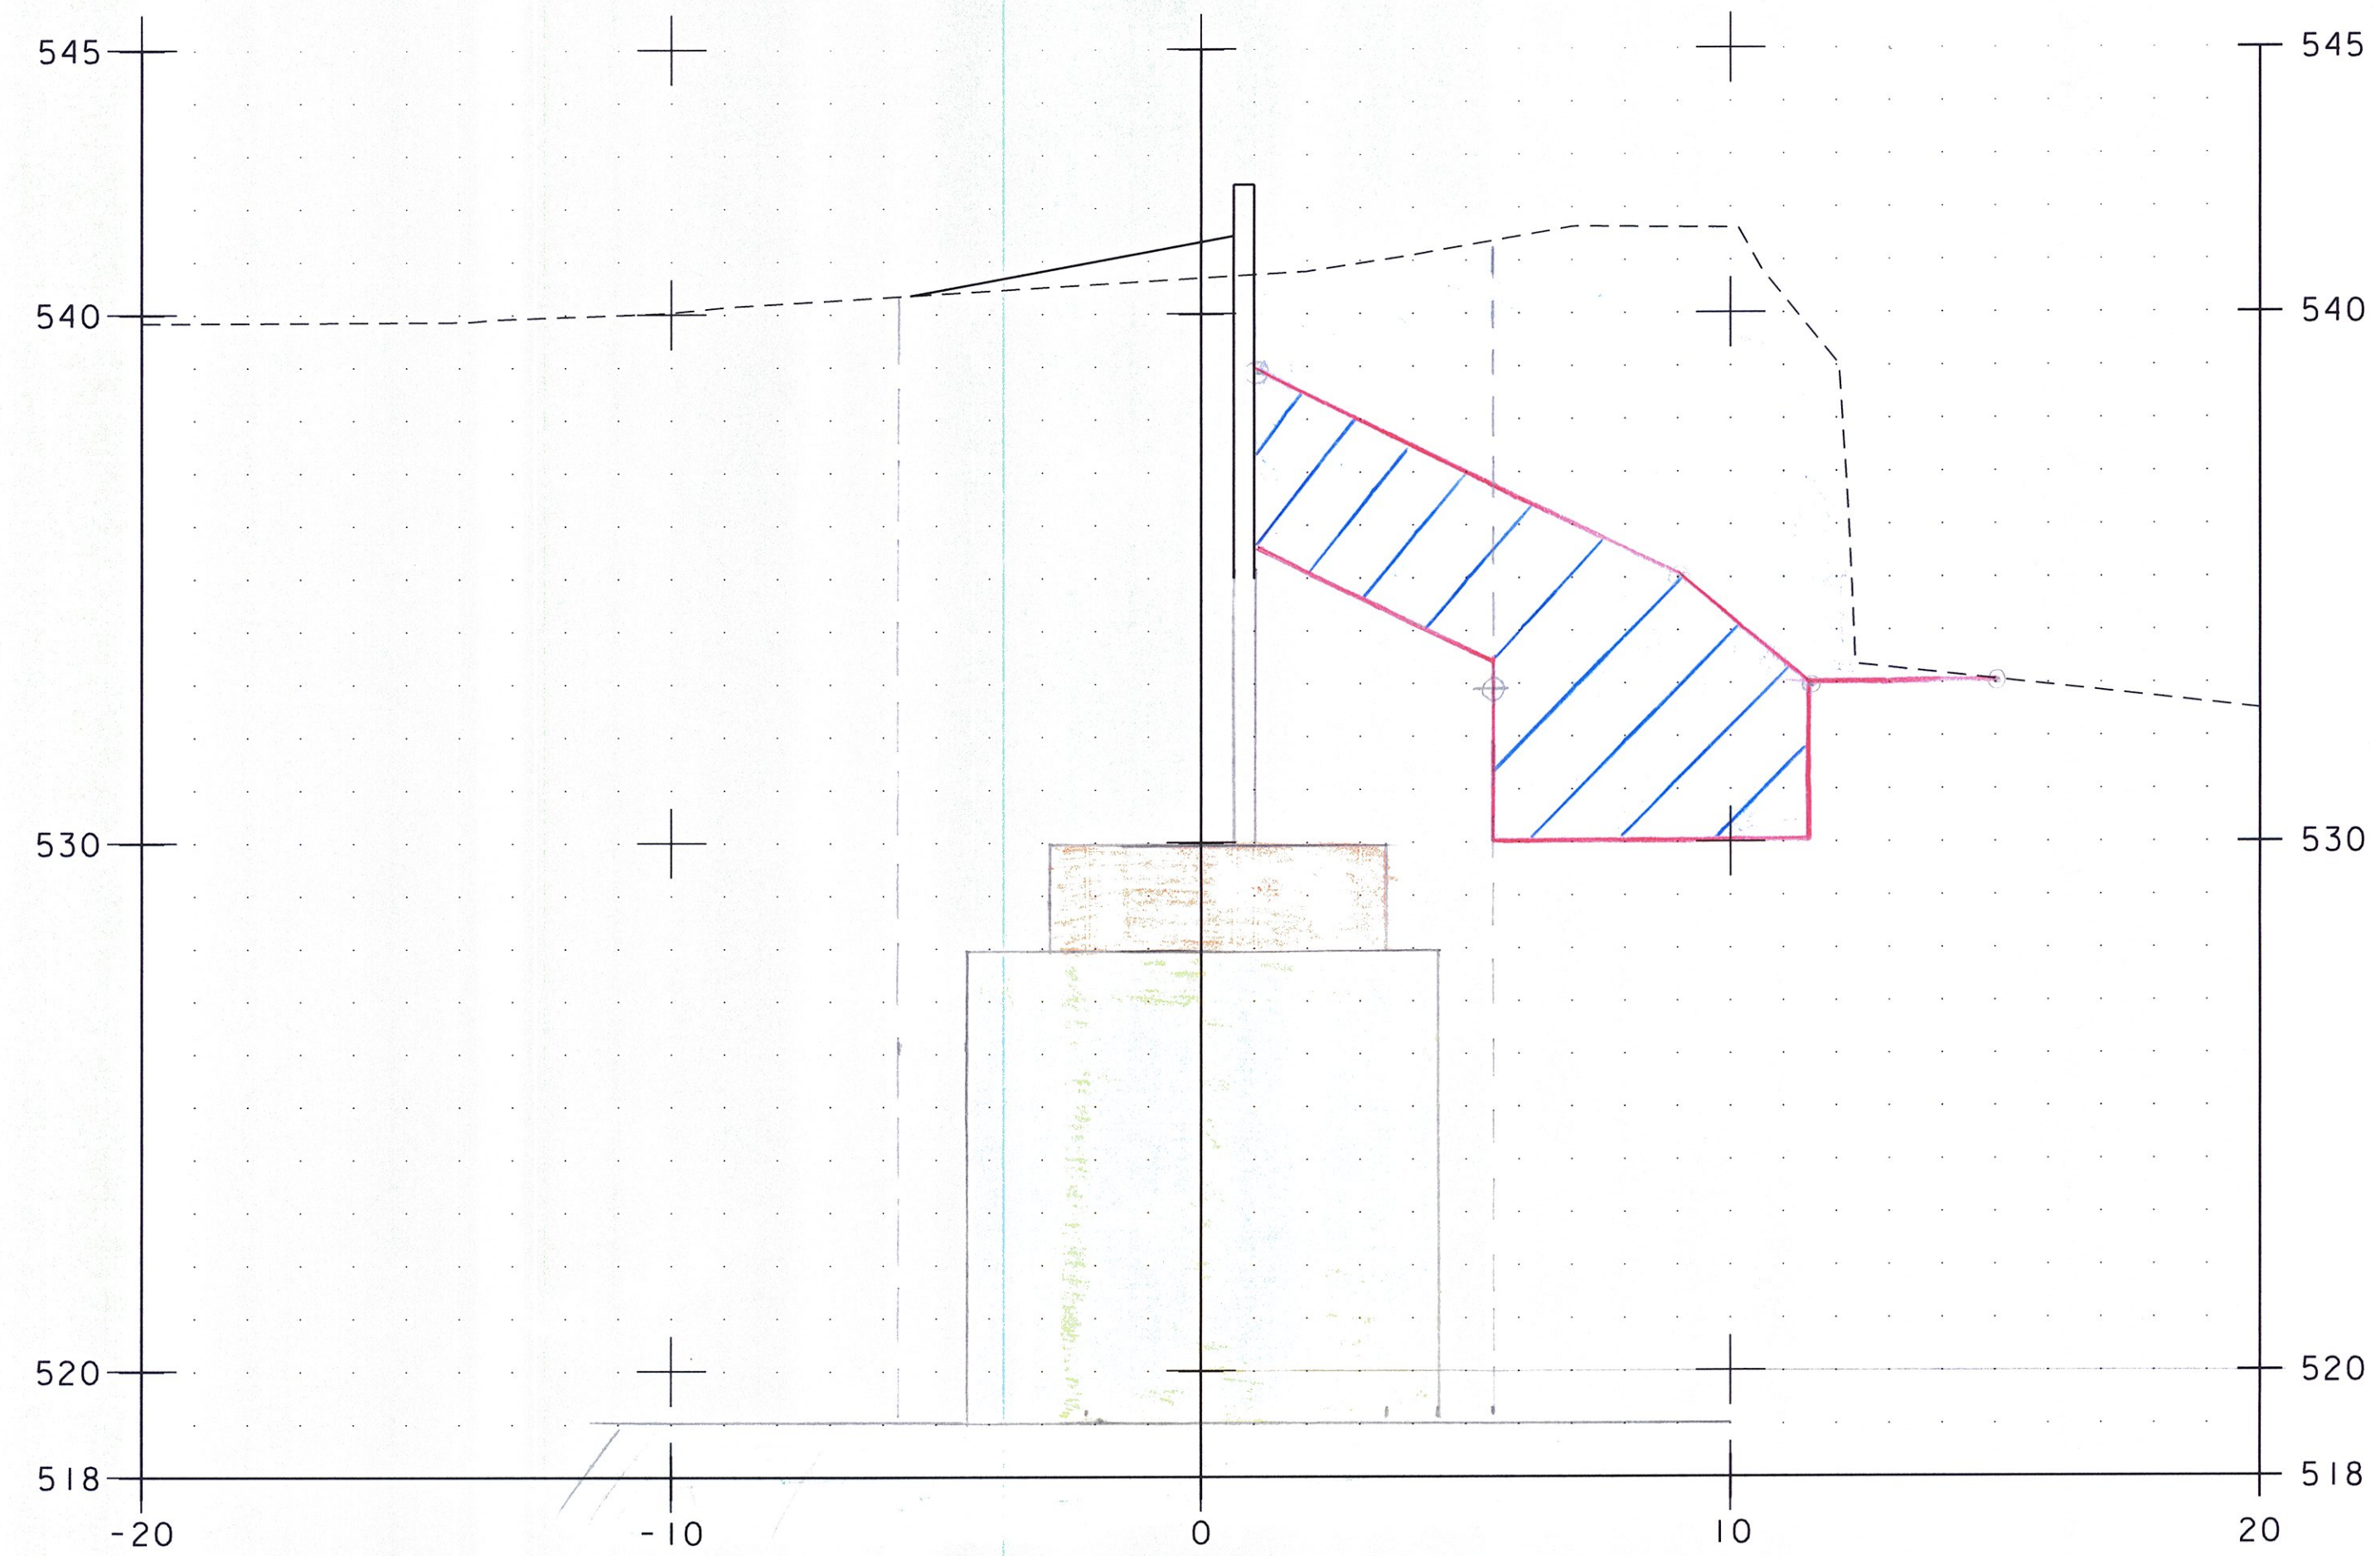

Cofferdam Earth = 213.5 FT³ ✓  
 Granular backfill (ex. SW) = 121.0 FT³ ✓  
 Unclassified Channel Exc = 50.0 FT³ ✓  
 Stone Fill, type III = 45.0 FT³ ✓  
 Geo. Under Stone Fill = 21' M.W.H. 6/26/15  
 JFD 7-1-15


20+19.00

NOTE: LOCATION OF SUBBASE IS APPROXIMATE, PROPOSED GRADE IS NOT SHOWN.


PROJECT NAME: BRATTLEBORO	
PROJECT NUMBER: BRO 1442(35)	
FILE NAME: z10j062_customEL.dgn	PLOT DATE: 3/2/2015
PROJECT LEADER: S.E. BURBANK	DRAWN BY: E.F. LAWES
DESIGNED BY: E.F. LAWES	CHECKED BY: S.E. BURBANK
ABUTMENT NO. 2 CROSS SECTIONS (6 OF 9)	SHEET 6 OF 28



SCALE 1" = 3'-0"

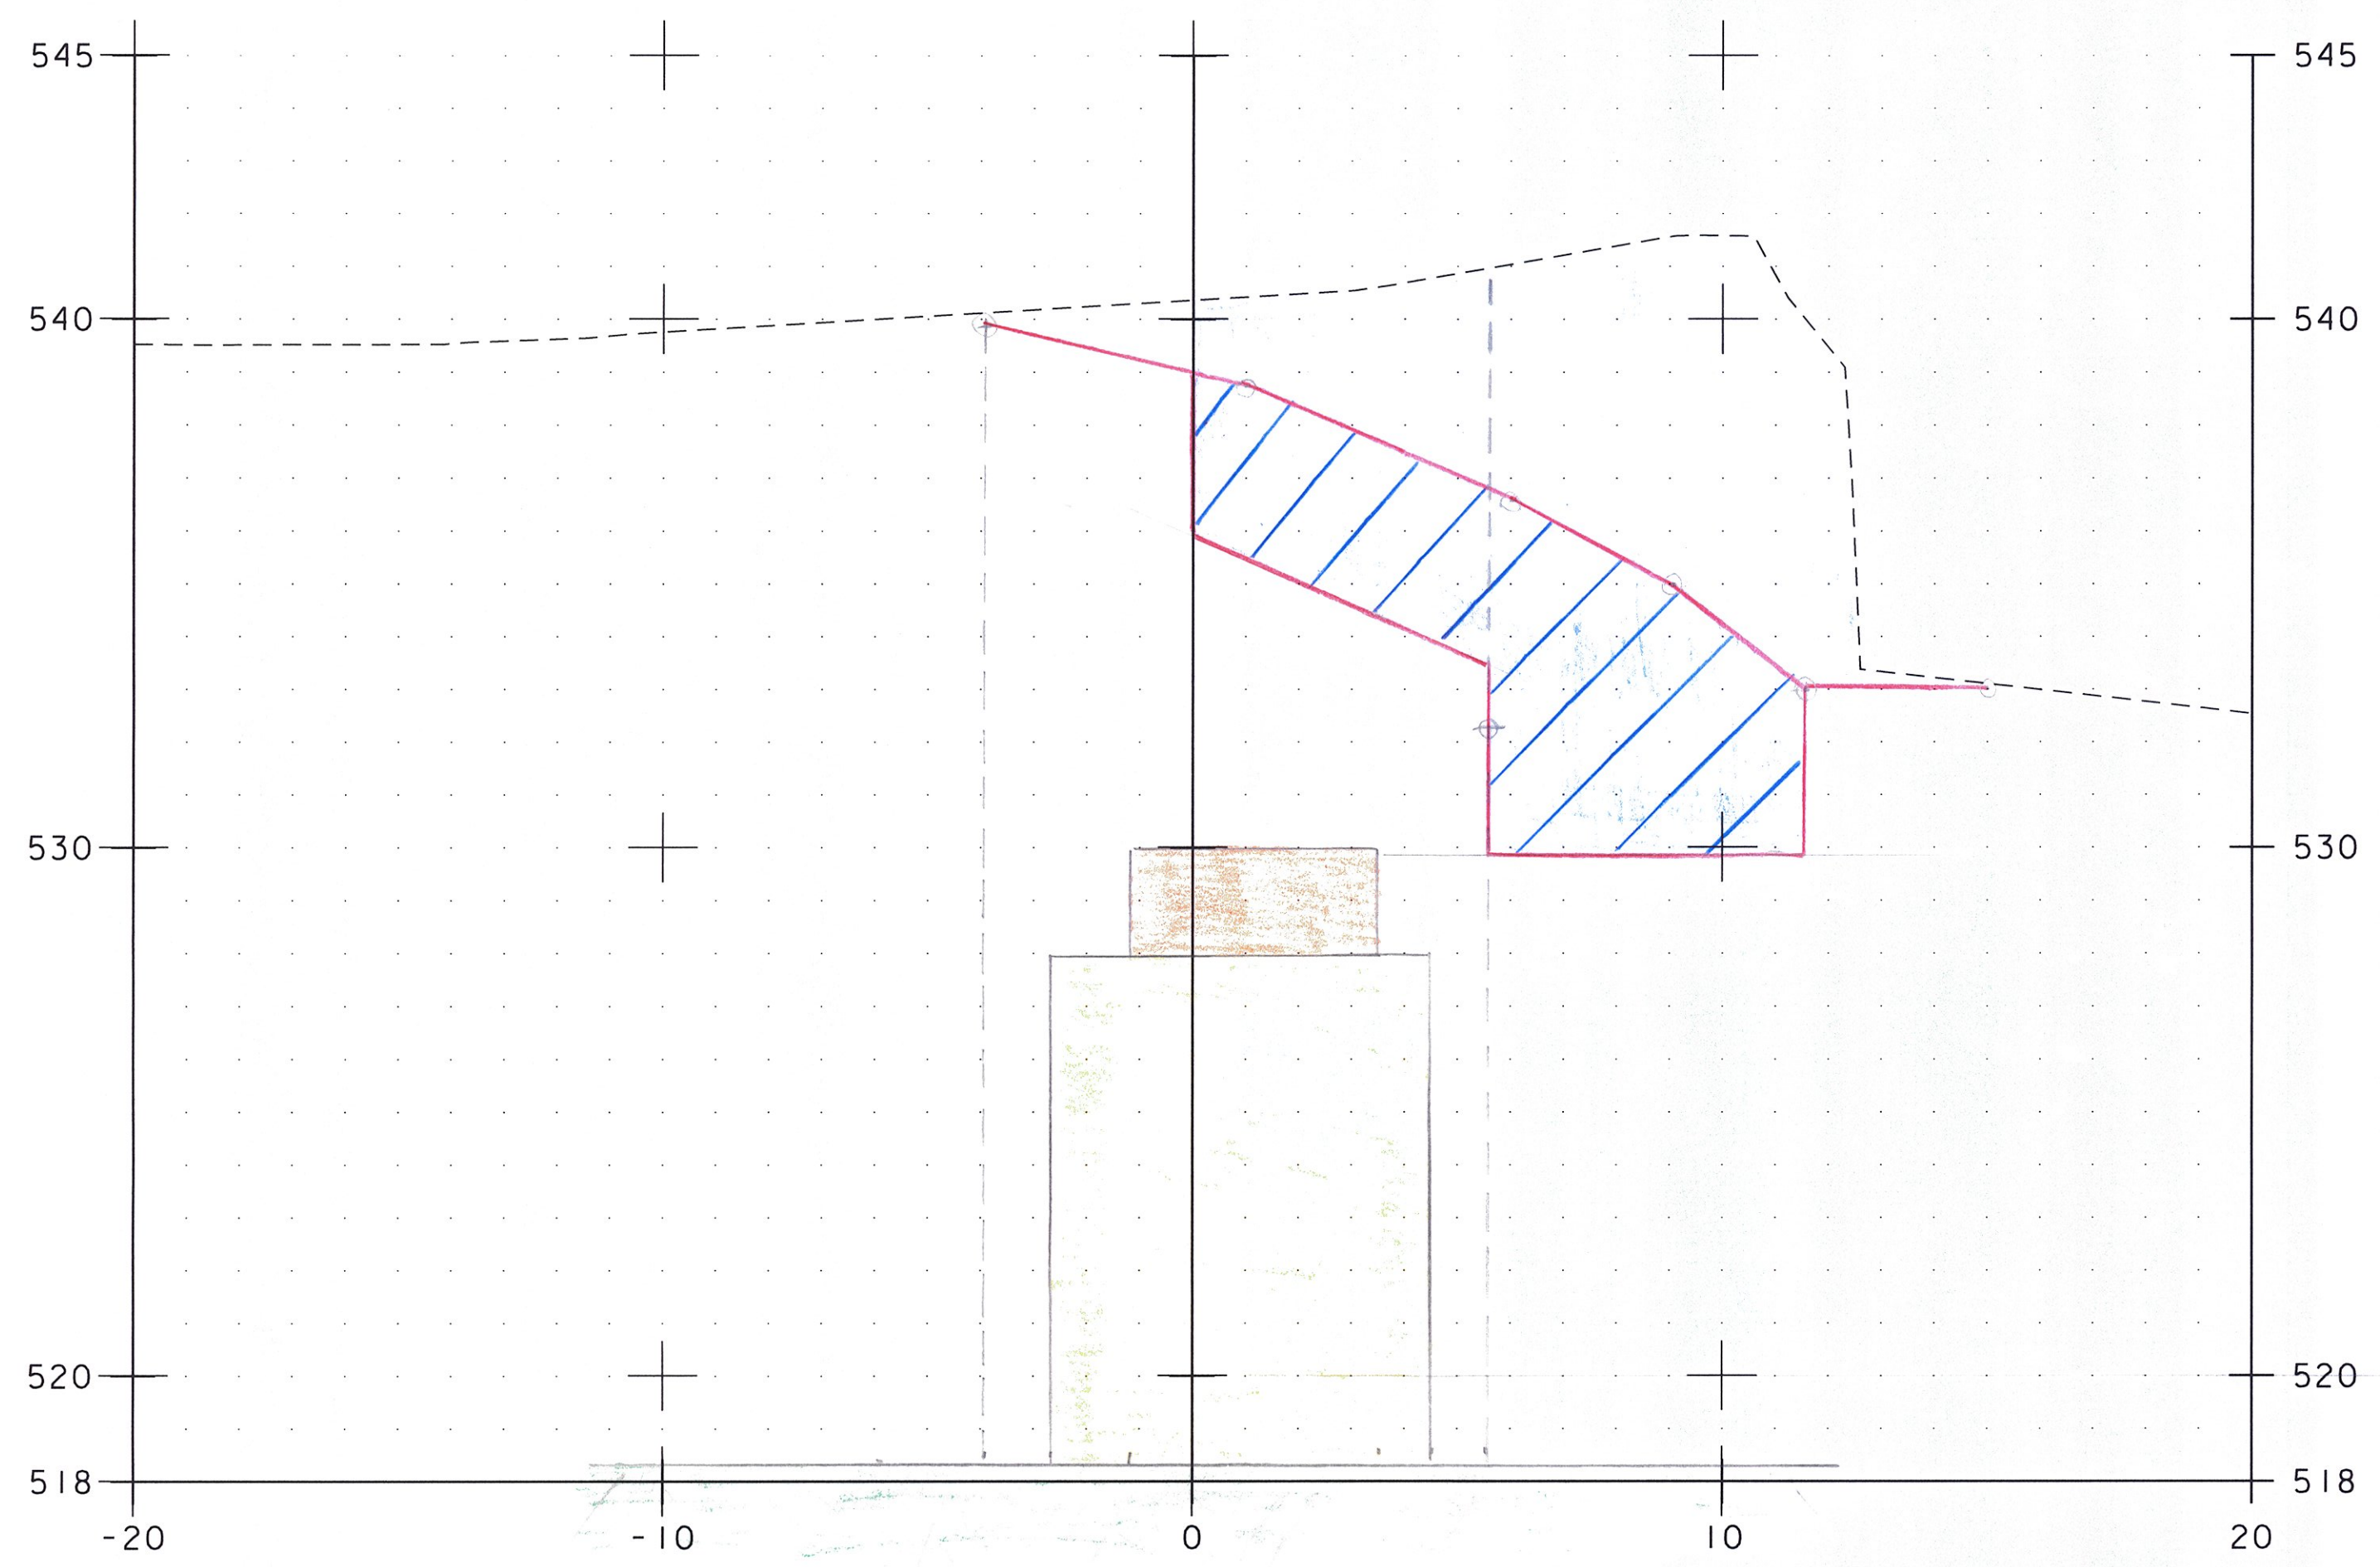

Col. Center to South = 176.5 FT ✓  
 Granular Backfill for Str = 102.0 FT ✓  
 Unclassified Channel Exc = 106.1 FT ✓  
 Stone Fill, type III = 49.9 FT ✓  
 Geo. Drain Stone Fill = 22.5' ✓ 6/26/15  
 JFB 7-1-15

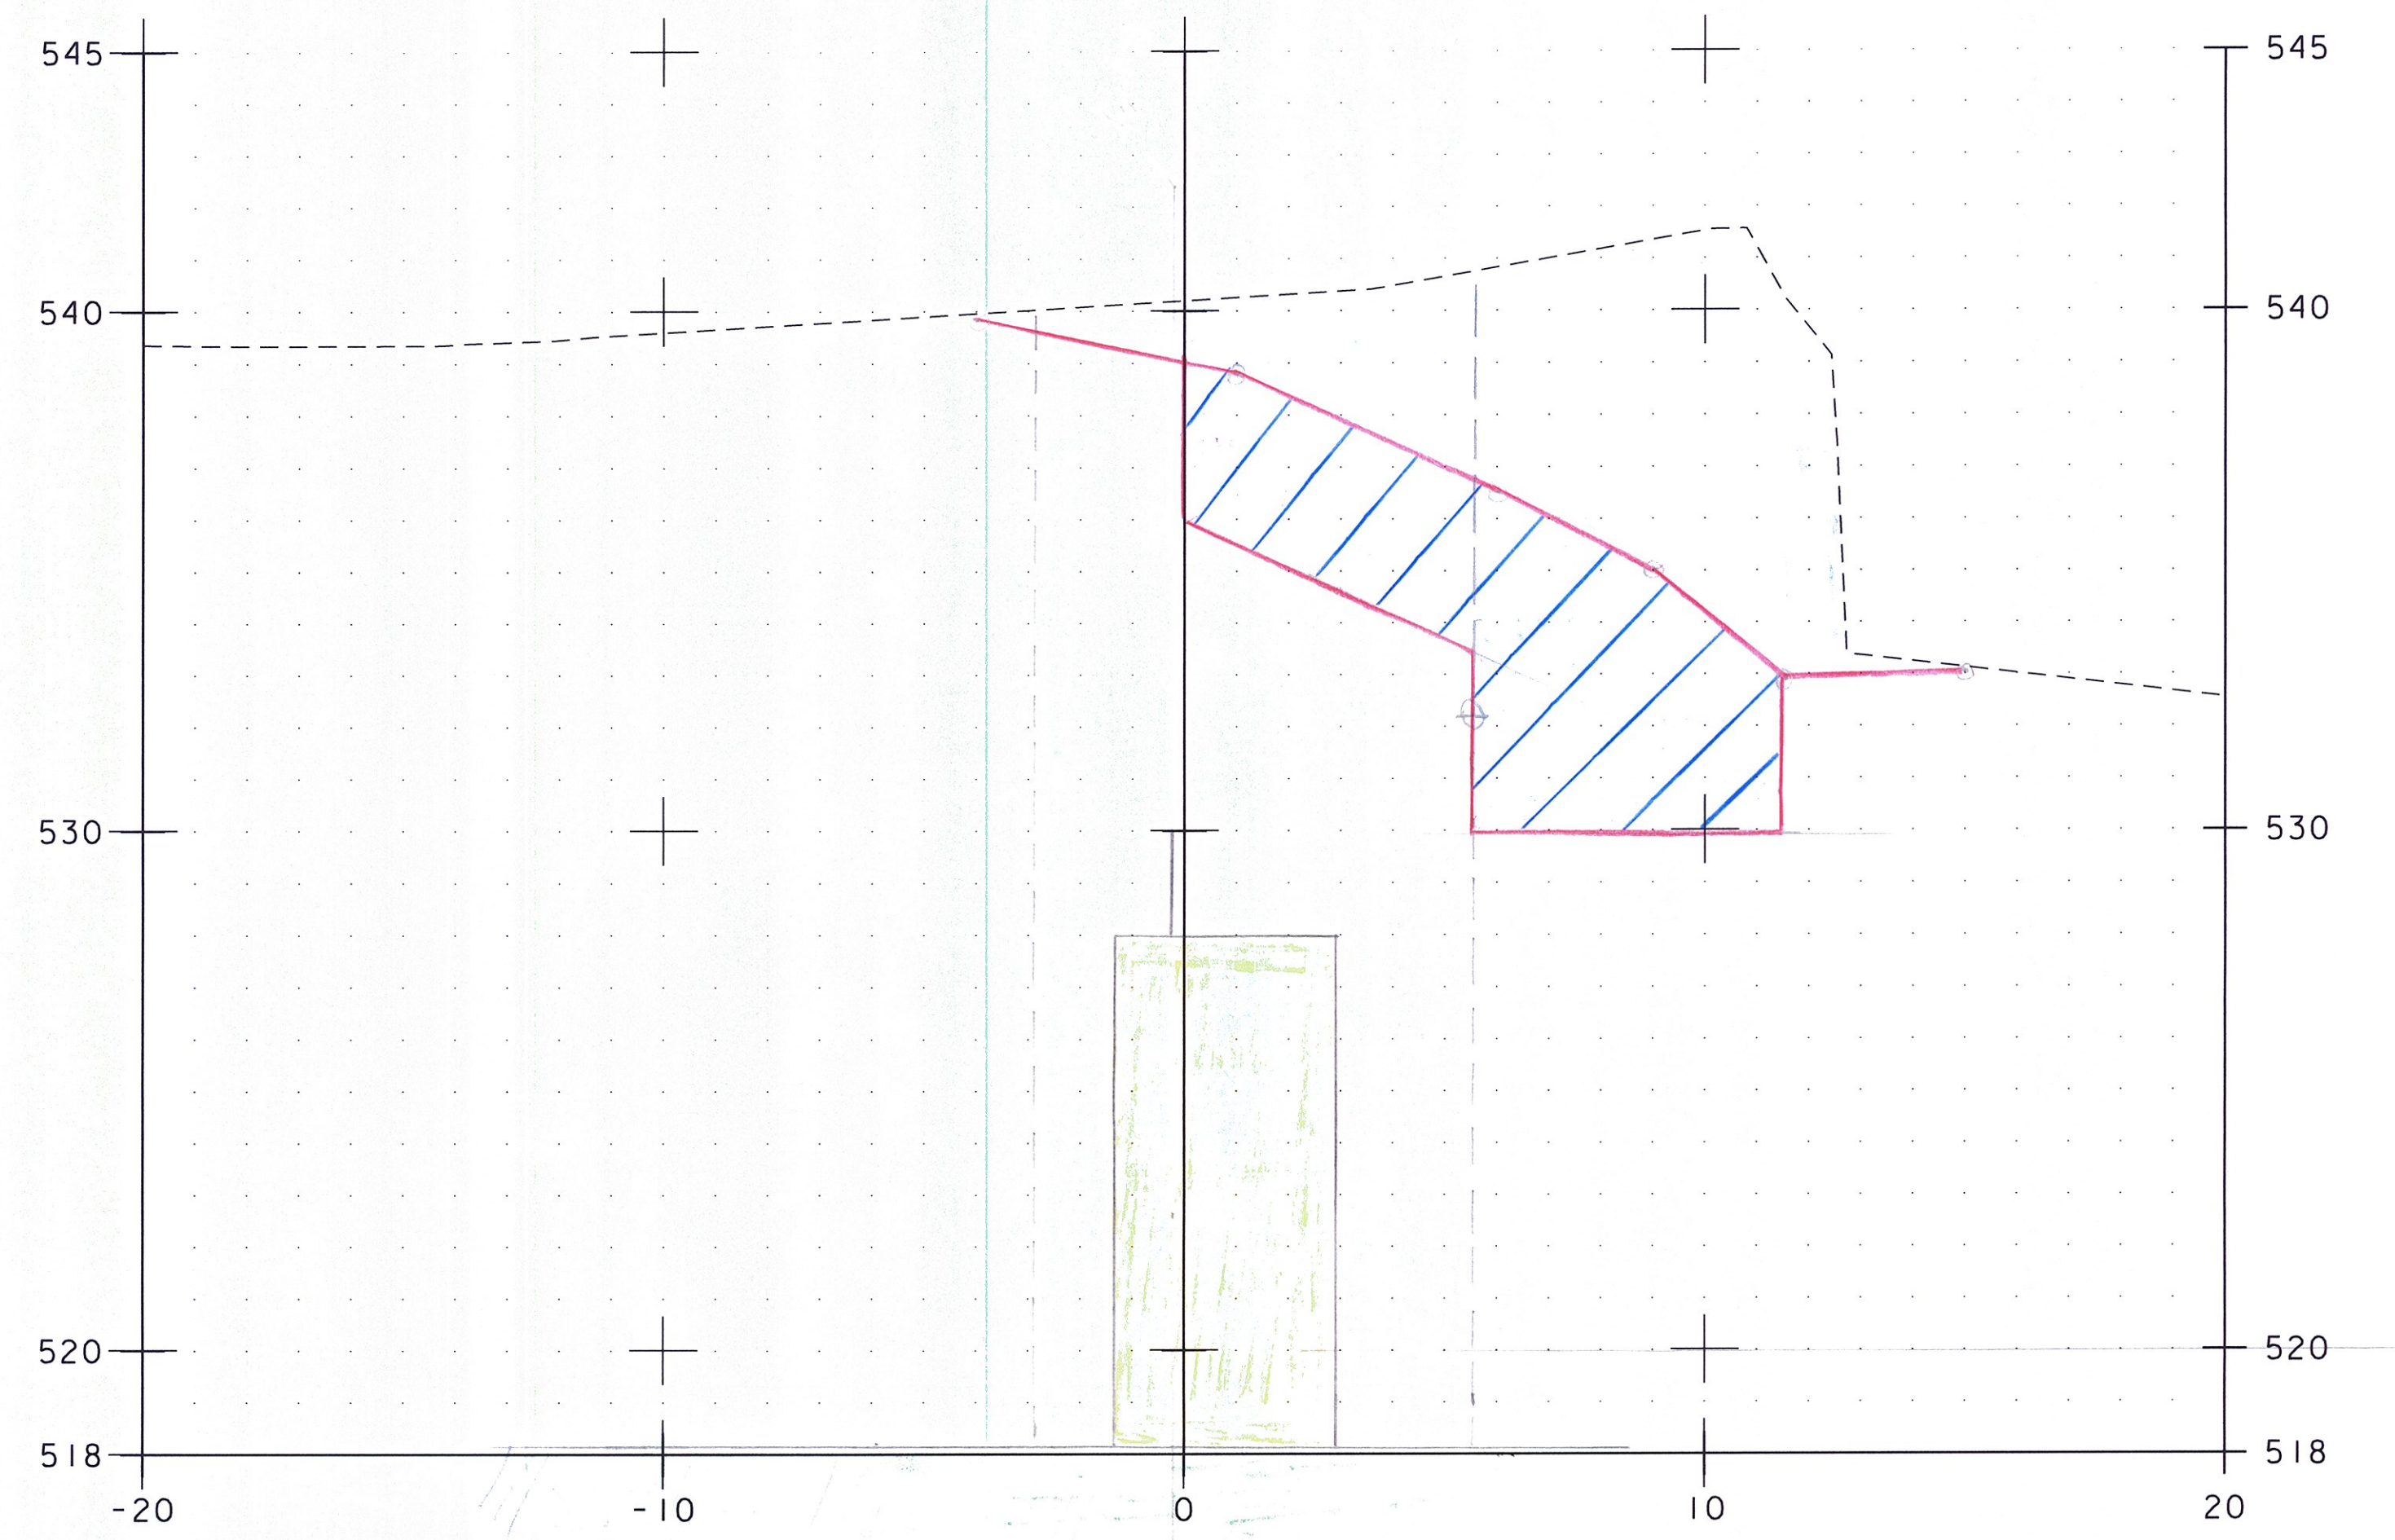


Col. Center to South = 154.3 FT ✓  
 Granular Backfill for Str = 112.7 FT ✓  
 Unclassified Channel Exc = 105.0 FT ✓  
 Stone Fill, type III = 42.2 FT ✓  
 Geo. Drain Stone Fill = 21.5' ✓ M.W.H. 6/26/15  
 JFB 7-1-15

NOTE: LOCATION OF SUBBASE IS APPROXIMATE, PROPOSED GRADE IS NOT SHOWN.


PROJECT NAME: BRATTLEBORO	
PROJECT NUMBER: BRO 1442(35)	
FILE NAME: z10j062_customEL.dgn	PLOT DATE: 3/2/2015
PROJECT LEADER: S.E. BURBANK	DRAWN BY: E.F. LAWES
DESIGNED BY: E.F. LAWES	CHECKED BY: S.E. BURBANK
ABUTMENT NO. 2 CROSS SECTIONS (7 OF 9)	SHEET 7 OF 28

SCALE 1" = 3'-0"



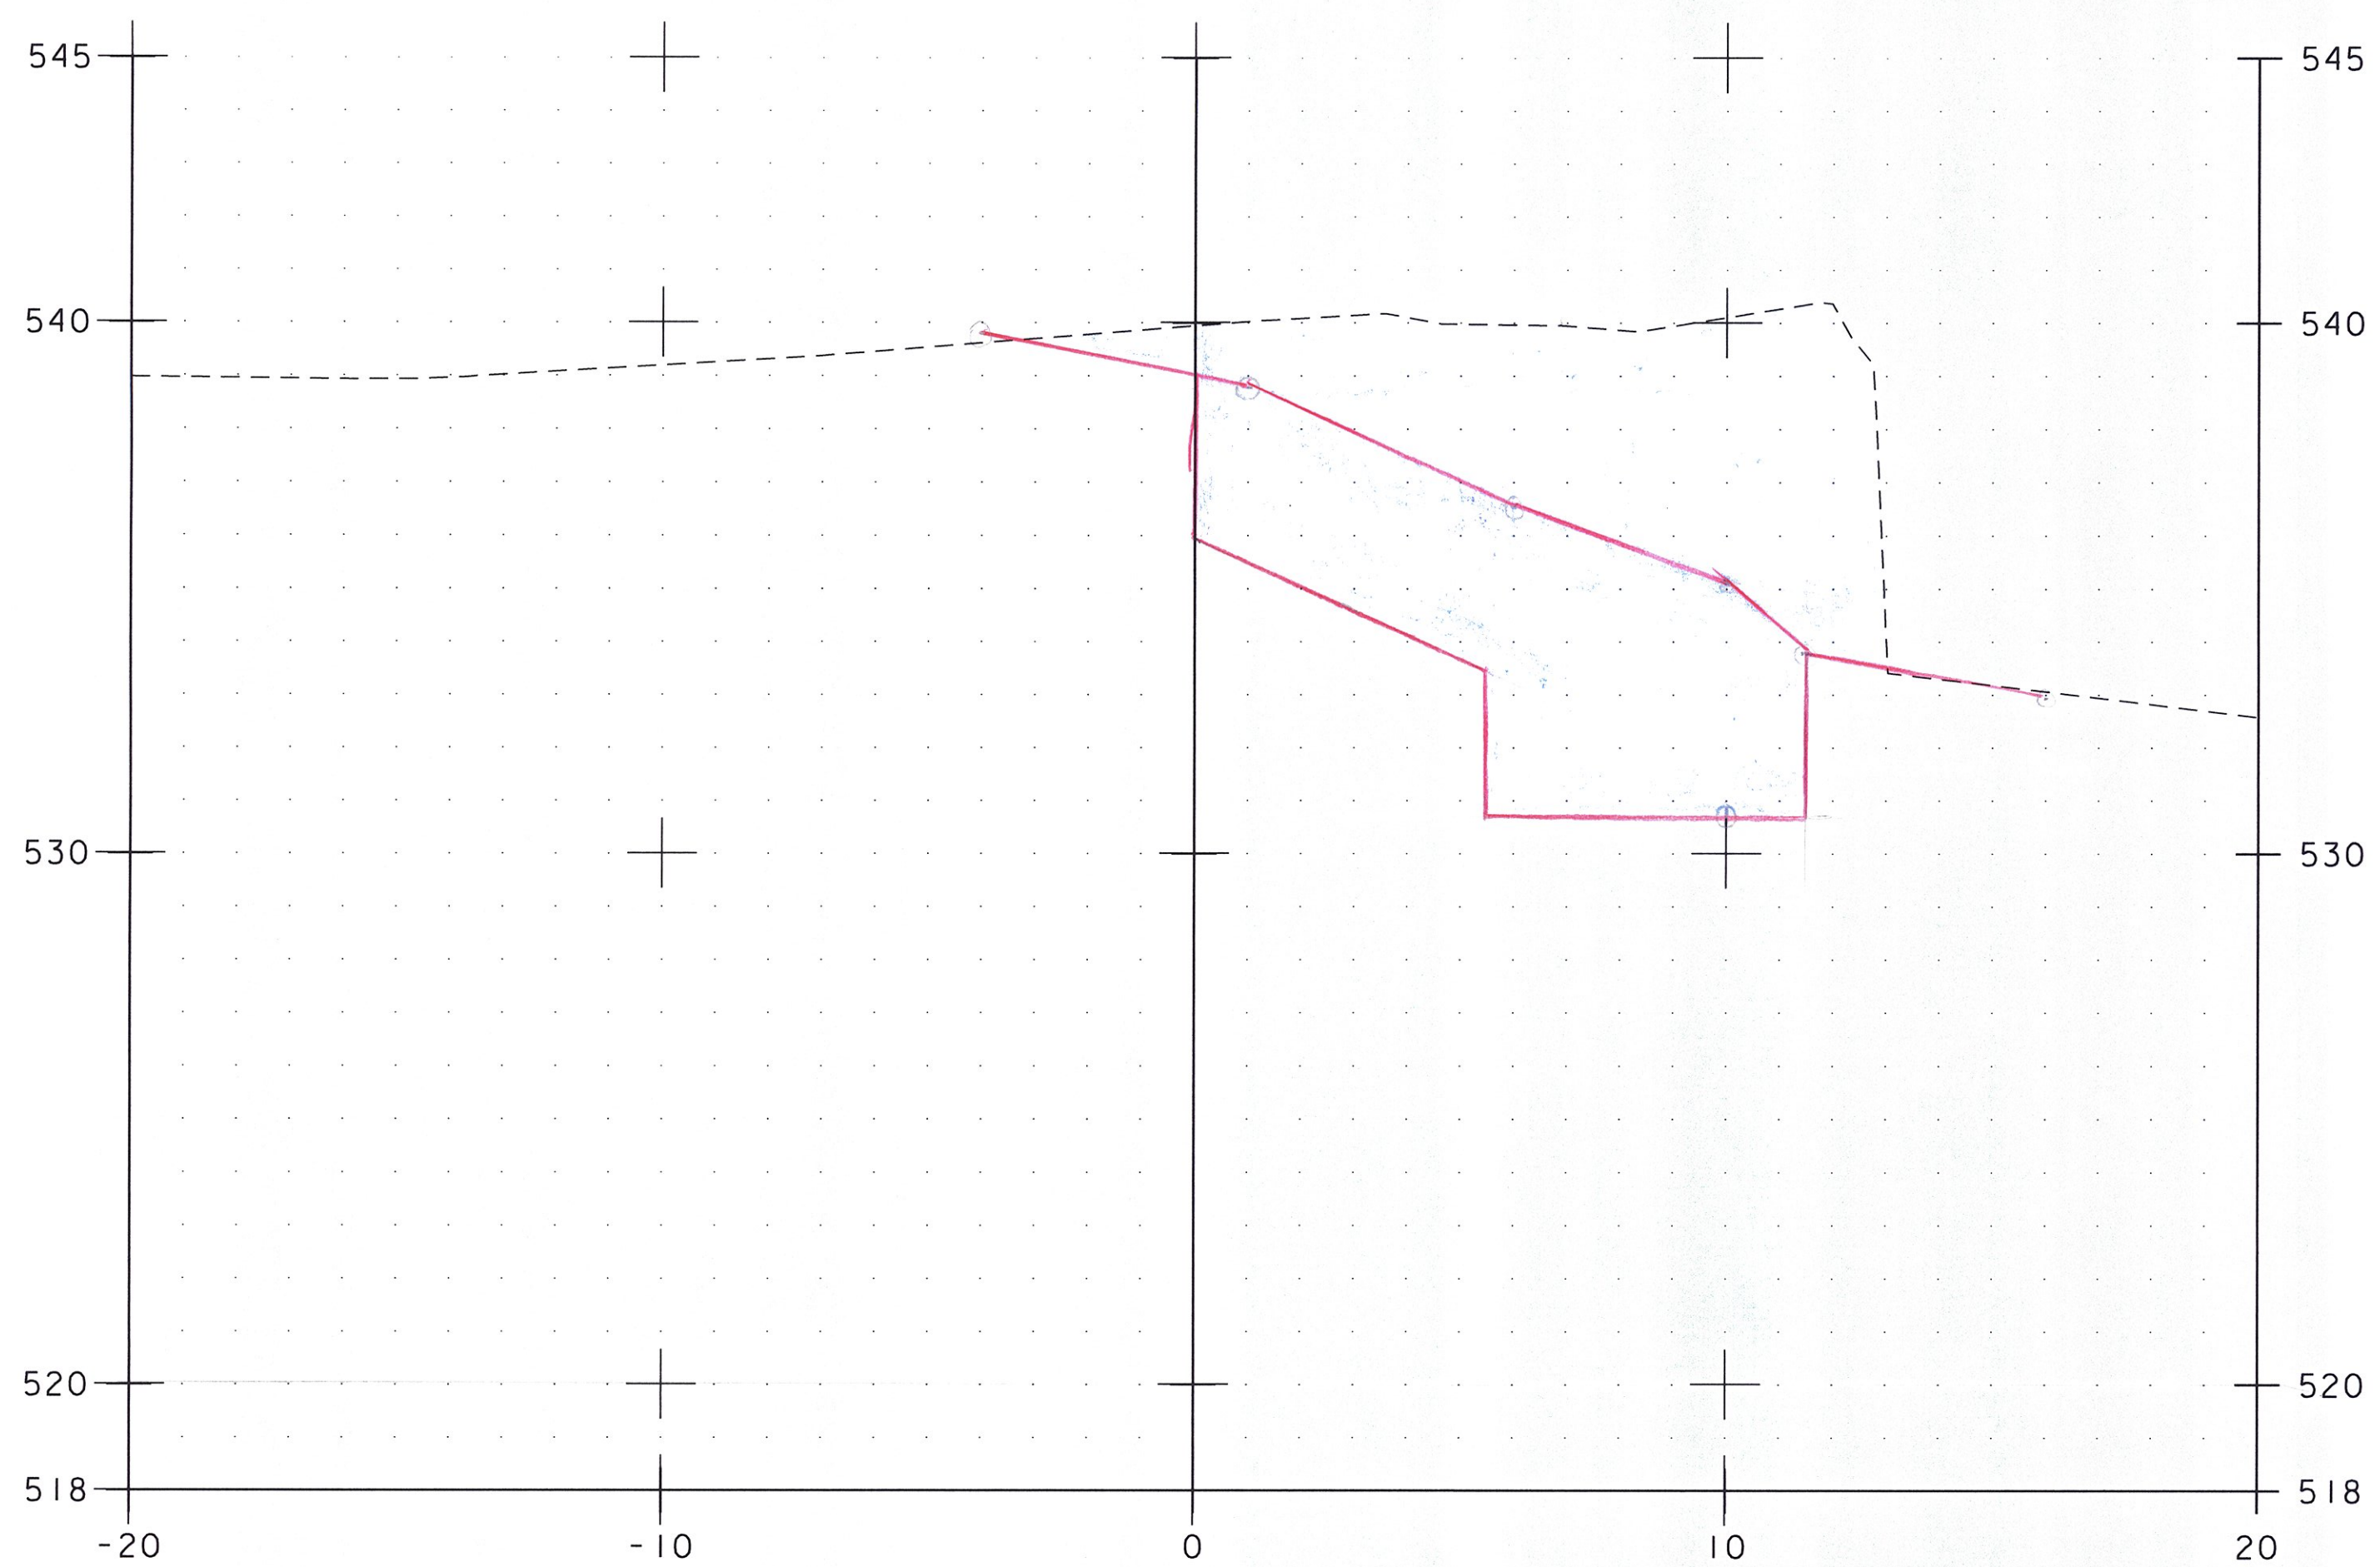

Unclassified Stone Fill = 94.1 FT² ✓  
 Stone Fill, type III = 48.0 FT² ✓  
 Geo. Under Stone Fill = 21' ✓  
 M.W.A. 6/26/15  
 20+24.50  
 42.9  
 Collision Equ. = 2.00  
 Groundwater Table = 2.00

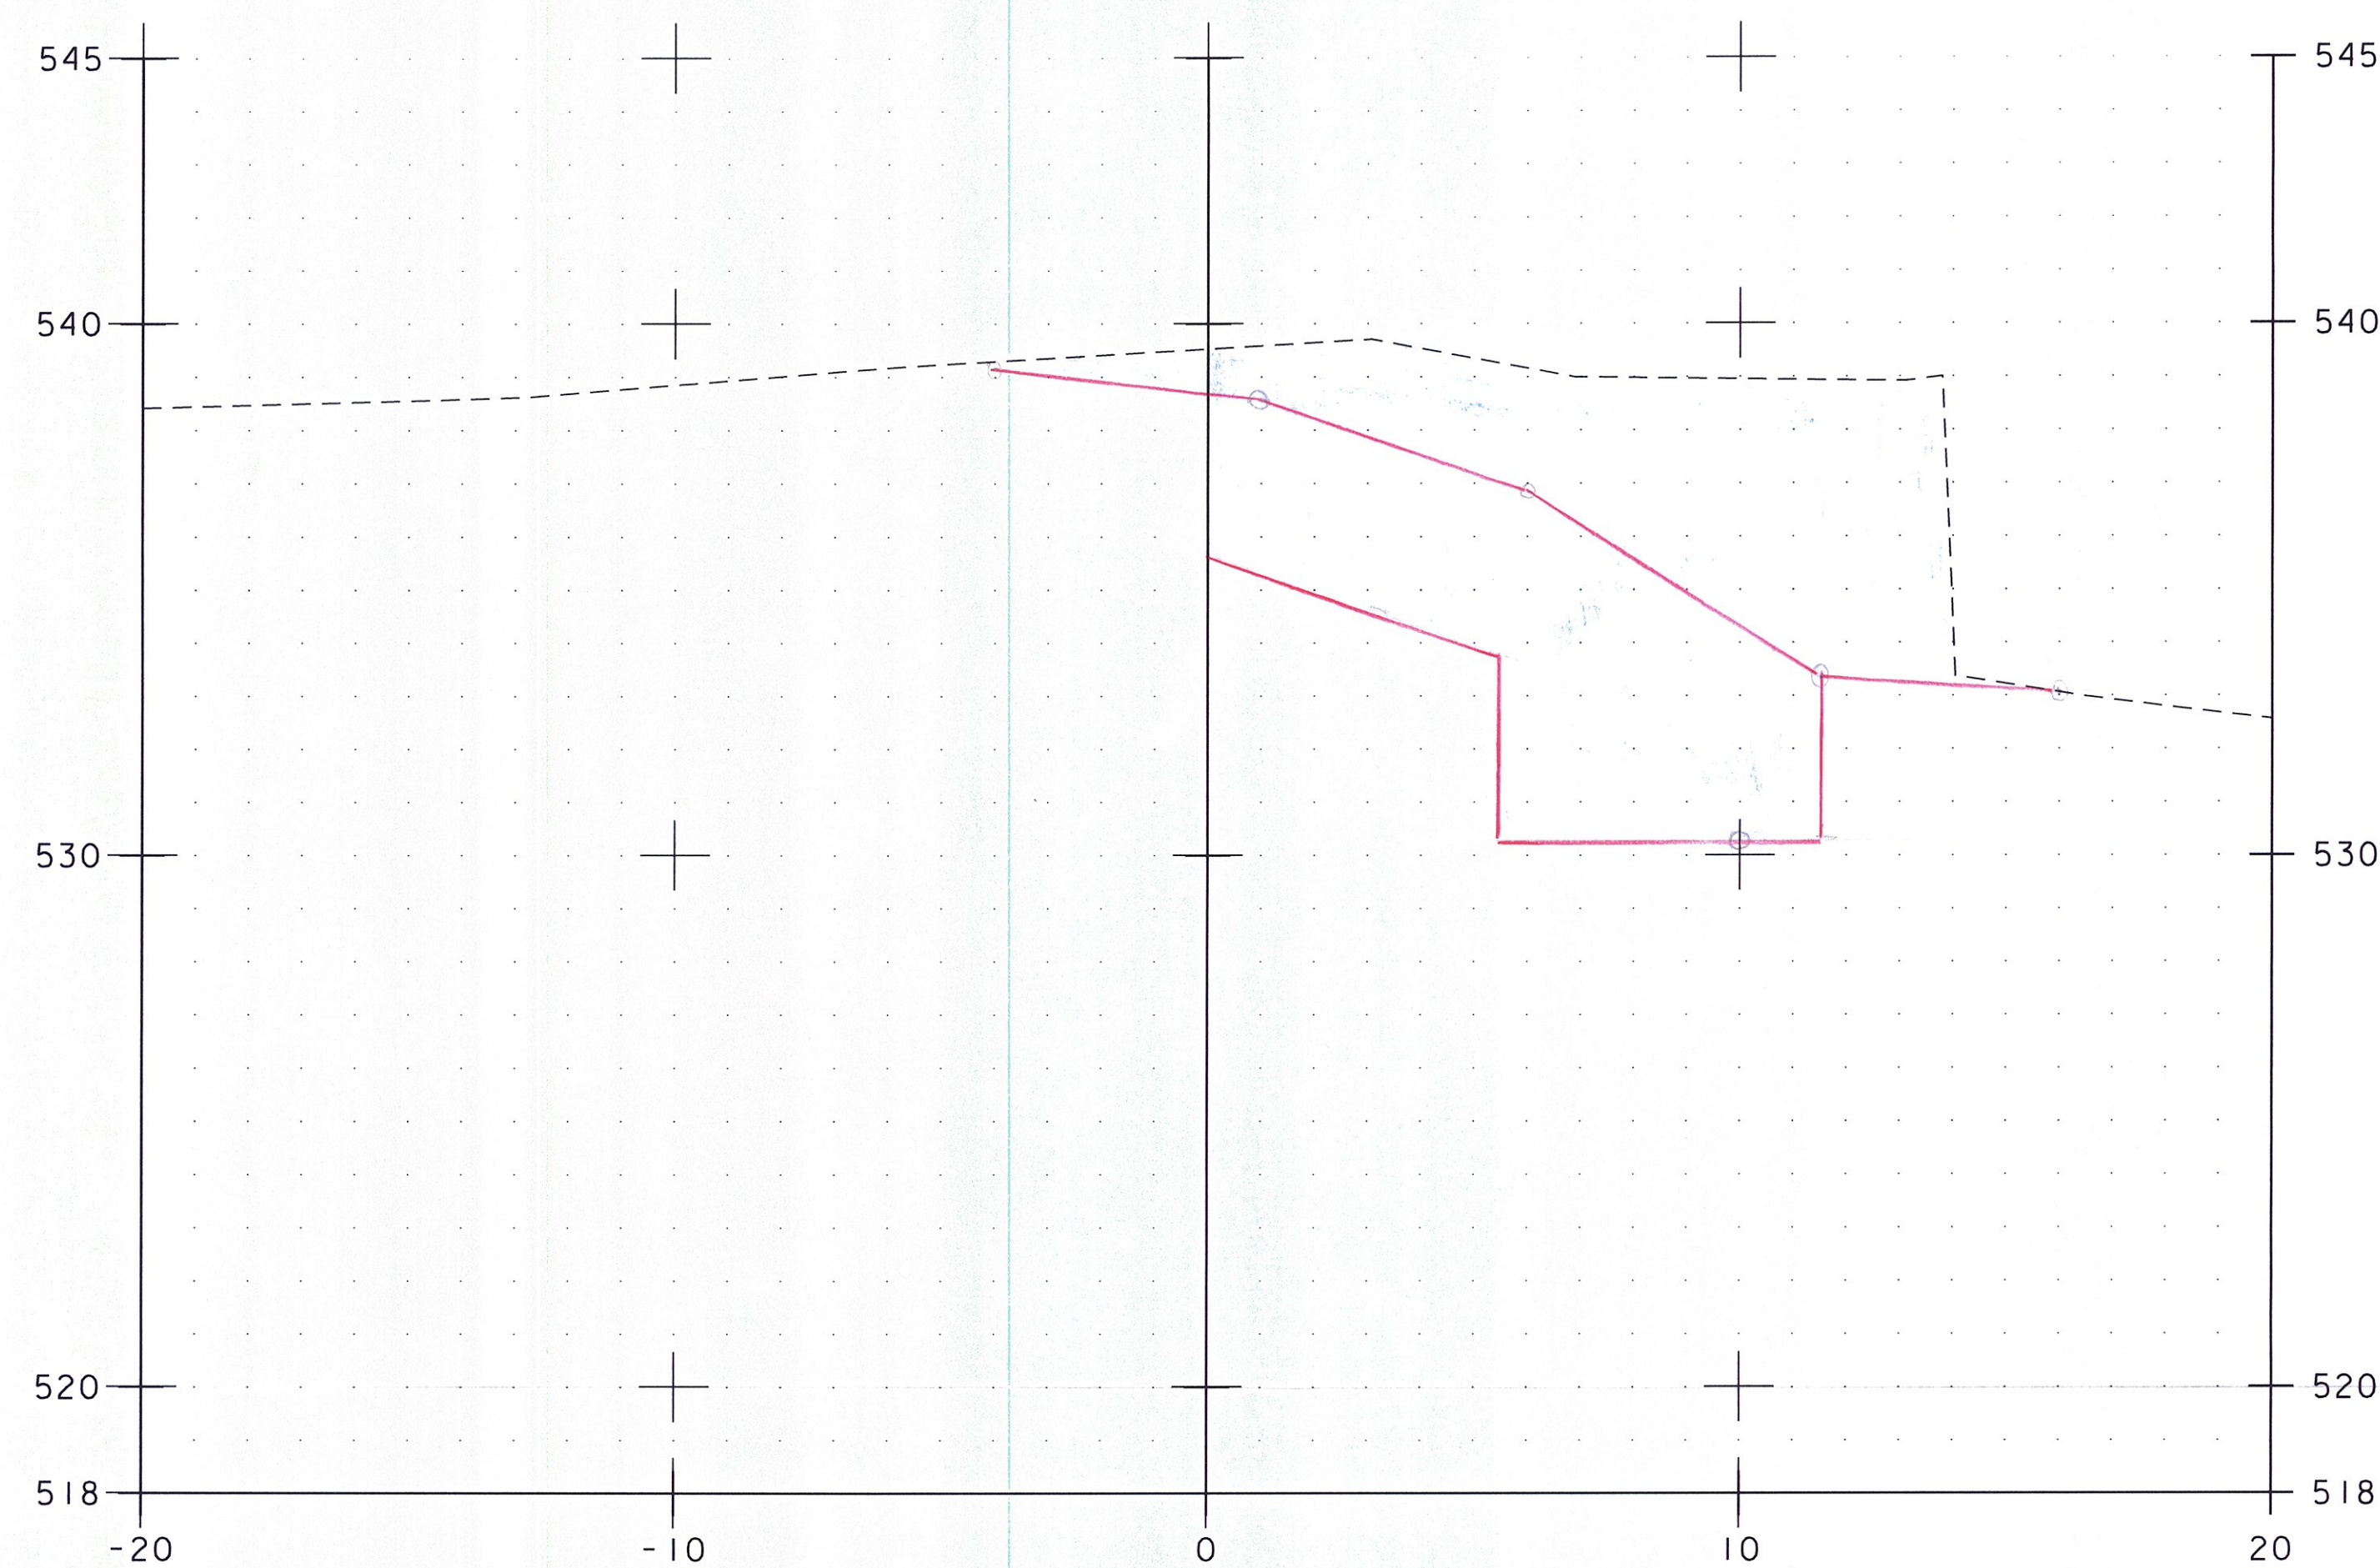


Unclassified Stone Fill = 94.5 FT² ✓  
 Stone Fill, type III = 49.2 FT² ✓  
 Geo. Under Stone Fill = 21.5' ✓  
 M.W.A. 6/26/15  
 20+30.00  
 43.0  
 SPD 7-1-15

SCALE 1" = 3'-0"

NOTE: LOCATION OF SUBBASE IS APPROXIMATE,  
PROPOSED GRADE IS NOT SHOWN.

PROJECT NAME: BRATTLEBORO	
PROJECT NUMBER: BRO 1442(35)	
FILE NAME: z10j062_customEL.dgn	PLOT DATE: 3/2/2015
PROJECT LEADER: S.E. BURBANK	DRAWN BY: E.F. LAWES
DESIGNED BY: E.F. LAWES	CHECKED BY: S.E. BURBANK
ABUTMENT NO. 2 CROSS SECTIONS (8 OF 9)	SHEET 8 OF 28



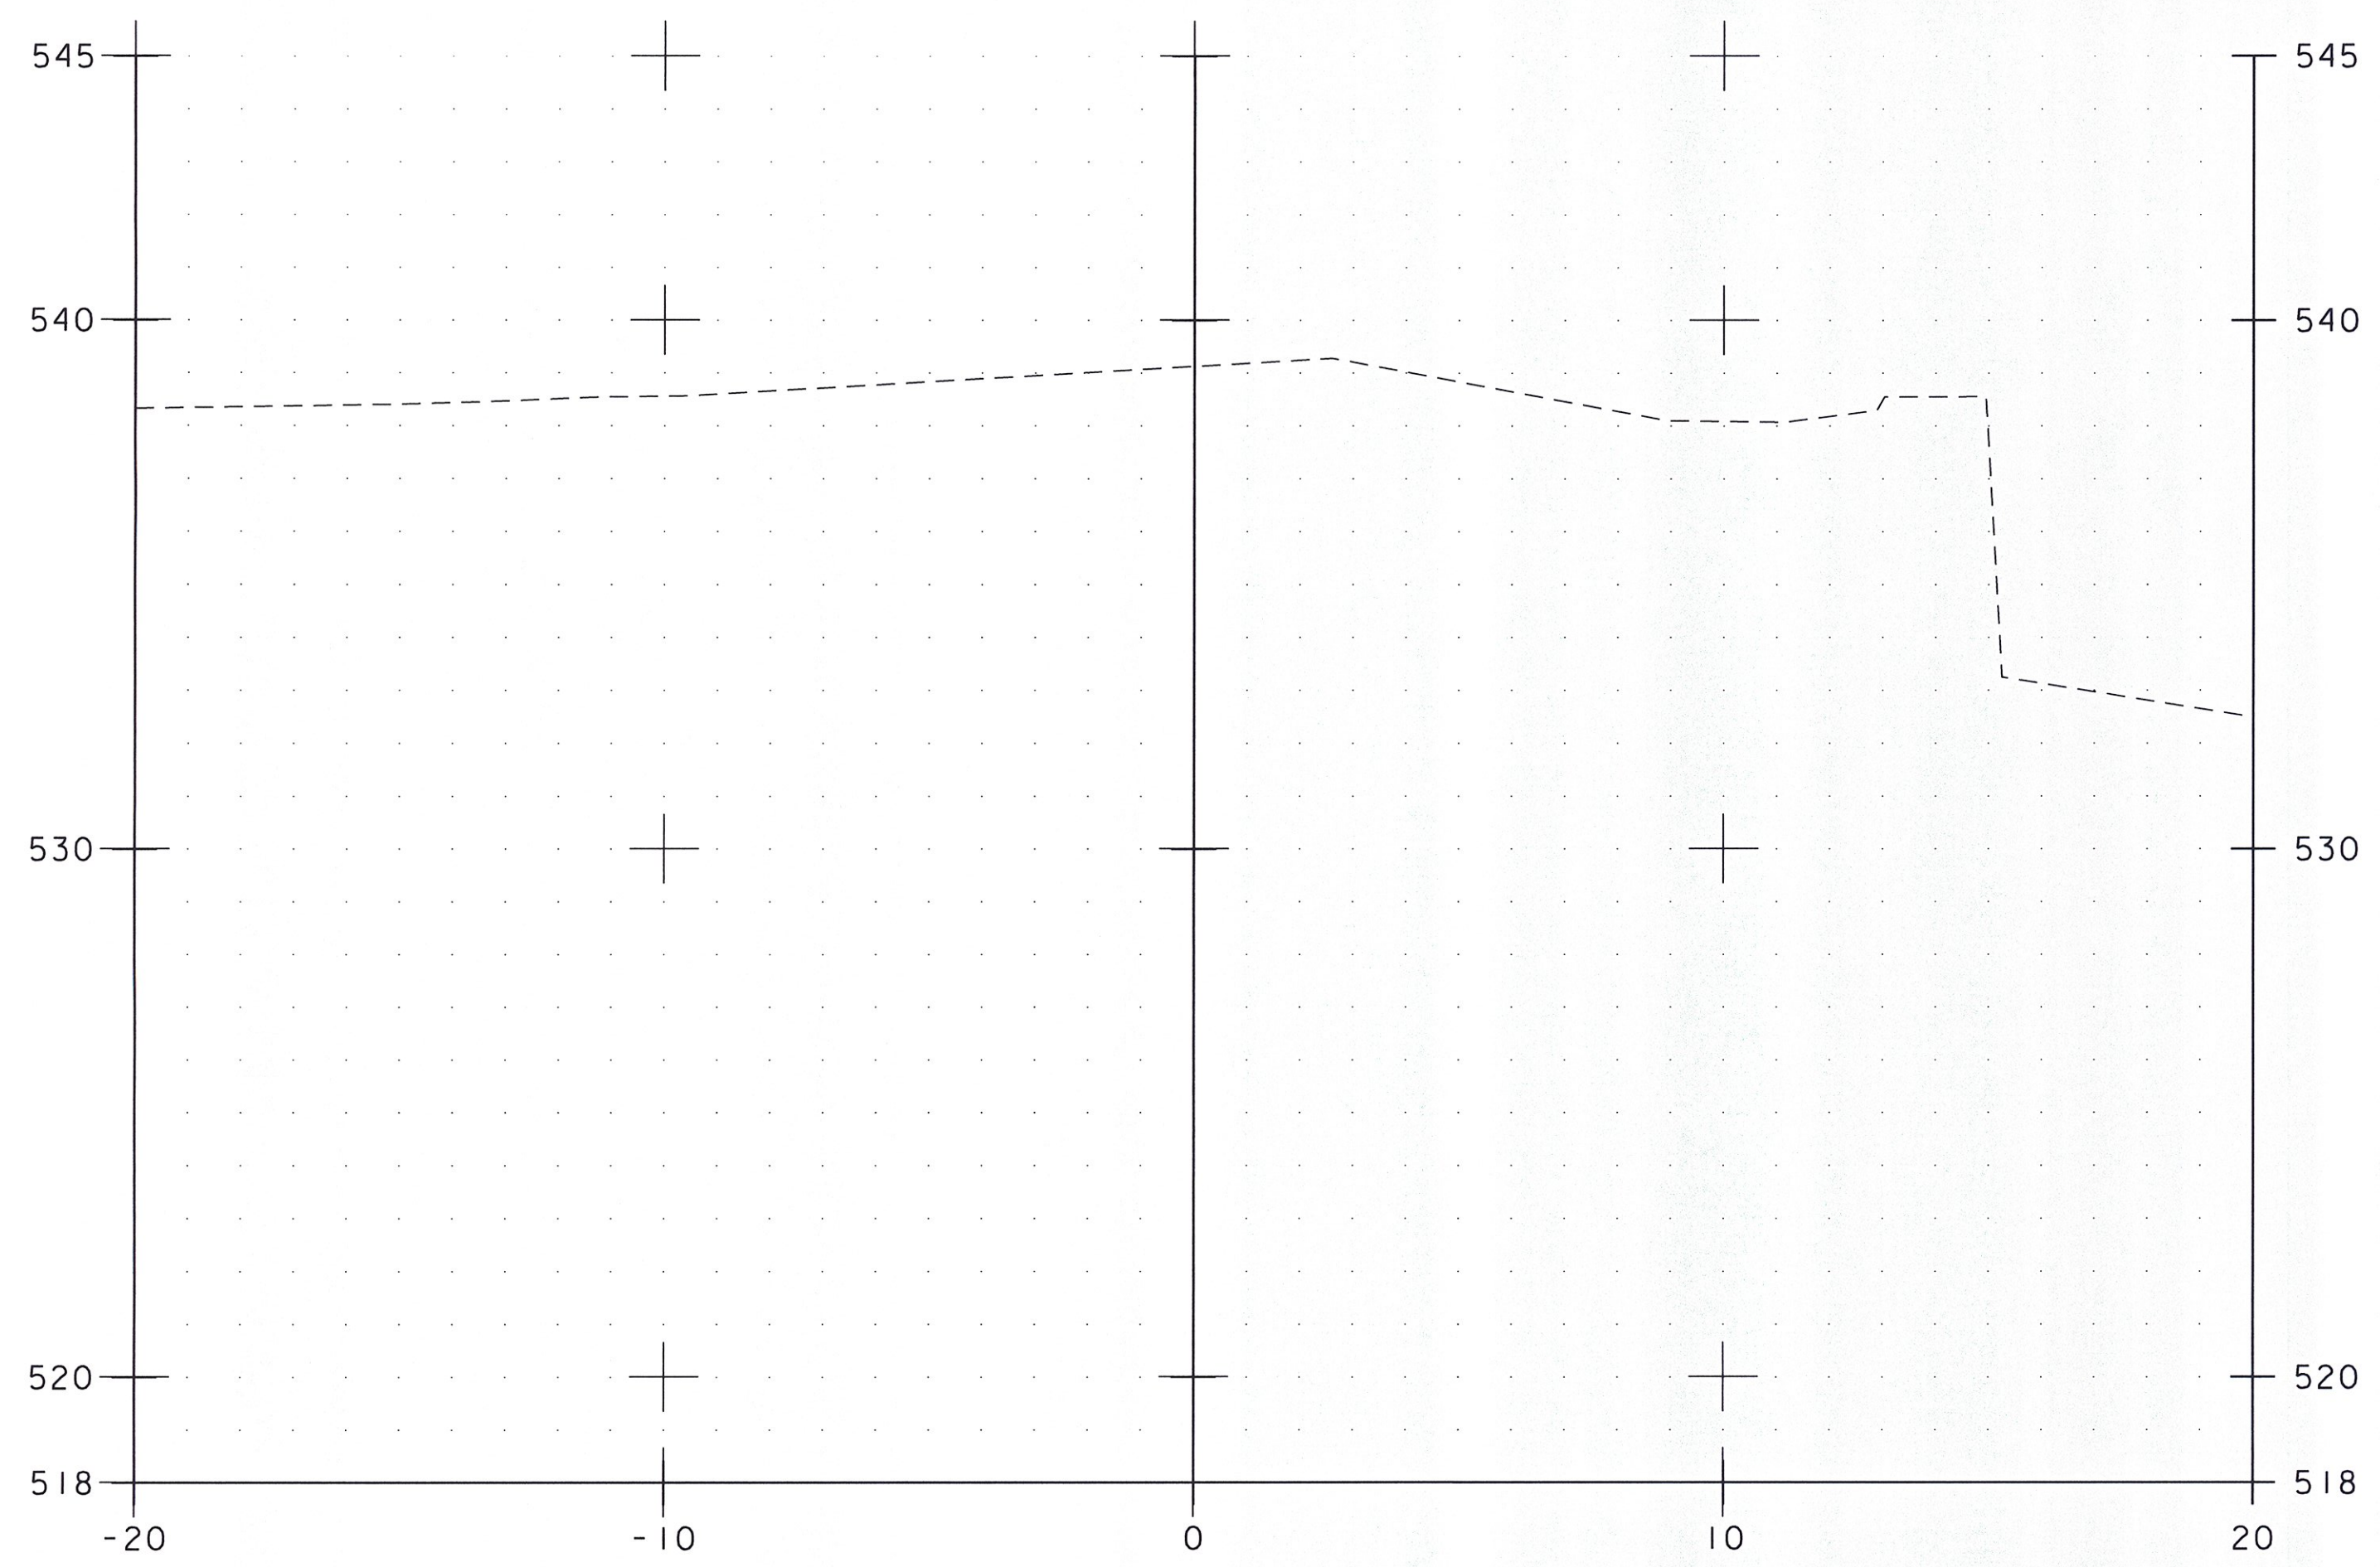

20+35.00

SCALE 1" = 3'-0"

NOTE: LOCATION OF SUBBASE IS APPROXIMATE,  
PROPOSED GRADE IS NOT SHOWN.

PROJECT NAME: BRATTLEBORO	
PROJECT NUMBER: BRO 1442(35)	
FILE NAME: z10j062_customEL.dgn	PLOT DATE: 3/2/2015
PROJECT LEADER: S.E. BURBANK	DRAWN BY: E.F. LAWES
DESIGNED BY: E.F. LAWES	CHECKED BY: S.E. BURBANK
ABUTMENT NO. 2 CROSS SECTIONS (9 OF 9)	SHEET 9 OF 28

