


MISCELLANEOUS MATERIALS				
ITEM	MARK	QTY.	DESCRIPTION	REMARKS
1				
2				
3				
4	EM-B1	36	E 3/4" x 5" x 5" W/ 1/8" HOLE (GALV.) (ASTM A-36)	FOR ERECTION, SEE DETAIL THIS SHEET
5	EM-B2	36	1" HEAVY HEX NUT DOMESTIC (A194-22) (GALV.) & DOMESTIC STRUCTURAL WASHER (F436 T1) (GALV.)	FOR ERECTION
6	EM-B3	6	1" x 6'-5 3/4" THREADED ROD (A-449) (H.D. GALV.)	FOR ERECTION
7	EM-B4	12	1" x 7'-5" THREADED ROD (A-449) (H.D. GALV.)	FOR ERECTION
8		18	COMPRESSIBLE SEALER SELF ADHESIVE	FOR ERECTION
9				
10				
11				
12				
13				
14				
15	PK-B1	24	DATTON C-24 TYPE 4-APR DECK FORM HANGER (GALV.)	
16		28	SET OF DOUBLE 1/2" x 270 KSI STRAND LIFTING LOOPS	
17				
18				
19				
20				

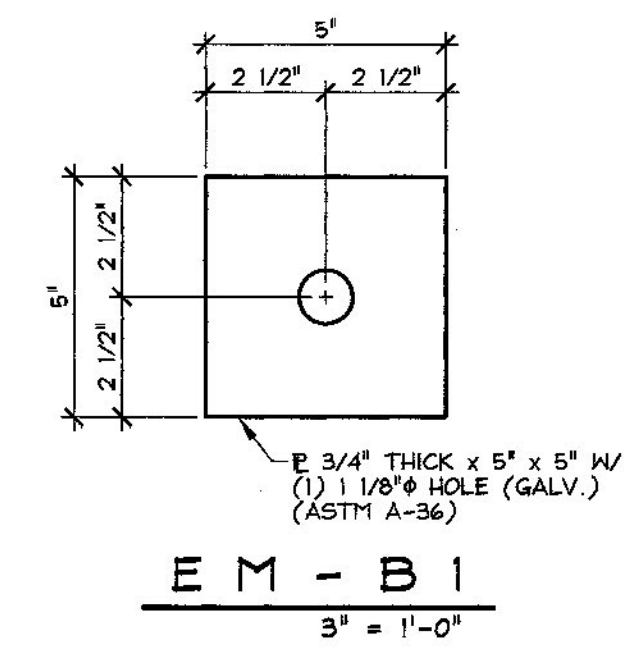

Vermont Agency of Transportation  
**RECEIVED**  
 CK'D BY MJC OK'D BY TAS  
 April 24, 2014  
 RESUBMIT No Approved AsNoted  
 BY M. J. Chenette DATE 04/29/2014

**SHOP DRAWING REVIEW**

REVIEWED AS REQUIRED BY THE CONSTRUCTION CONTRACT DOCUMENTS AND APPROVED, BUT ONLY FOR CONFORMANCE TO THE DESIGN CONCEPT OF THE WORK, AND SUBJECT TO FURTHER LIMITATIONS AND REQUIREMENTS CONTAINED IN THE CONSTRUCTION CONTRACT DOCUMENTS.

REJECTED  REVISE AND RESUBMIT  FURNISH AS CORRECTED

CORRECTIONS OR COMMENTS MADE ON THE SHOP DRAWINGS DURING THIS REVIEW DO NOT RELIEVE CONTRACTOR FROM COMPLIANCE WITH REQUIREMENTS OF THE DRAWINGS AND SPECIFICATIONS. THIS CHECK IS ONLY FOR REVIEW OF GENERAL CONFORMANCE WITH THE DESIGN CONCEPT OF THE PROJECT AND GENERAL COMPLIANCE WITH THE INFORMATION GIVEN IN THE CONTRACT DOCUMENTS. THE CONTRACTOR IS RESPONSIBLE FOR CONFIRMING AND CORRELATING ALL QUANTITIES AND DIMENSIONS, SELECTING FABRICATION PROCESSES AND TECHNIQUES OF CONSTRUCTION, COORDINATING HIS WORK WITH THAT OF ALL OTHER TRADES, AND PERFORMING HIS WORK IN A SAFE AND SATISFACTORY MANNER.

**Vanasse Hangen Brustlin, Inc.**  
 7056 US Route 7  
 North Ferrisburgh, VT 05473  
 802-425-7799

Job Number: 57528.00  
 Reviewed By: E.A. FIALA  
 Date: 04/28/2014

4-24-14 REVISE REINFORCING

APPROVAL STAMP:	<b>J.P. CARRARA &amp; SONS INC.</b> Precast & Prestress Manufacturer 2444 CASE ST., MIDDLEBURY, VERMONT 05753 Phone: (802)388-6361 Fax: (802)388-9010	<b>RENAUD BRO., INC.</b> CONTRACTOR VERNON, VERMONT
	<b>STATE OF VERMONT AGENCY OF TRANSPORTATION</b> COUNTY OF WINDHAM	DATE: MAR. 24, 2014 SCALE: NOTED
	<b>TOWN OF BRATTLEBORO</b> TH 12, CLASS III (LOCAL ROAD) OVER HALLADAY BROOK BRIDGE NO.: 7 PROJECT NO.: BR0 1442(35)	CHKD: M.D. DFTM: B.L. JOB NO: 23424-014
	<b>MATERIALS LIST</b>	DWG. NO: <b>M1</b>