



HORIZONTAL LOCATION OF
ABUTMENT NO. 2/WW3 (TYP)

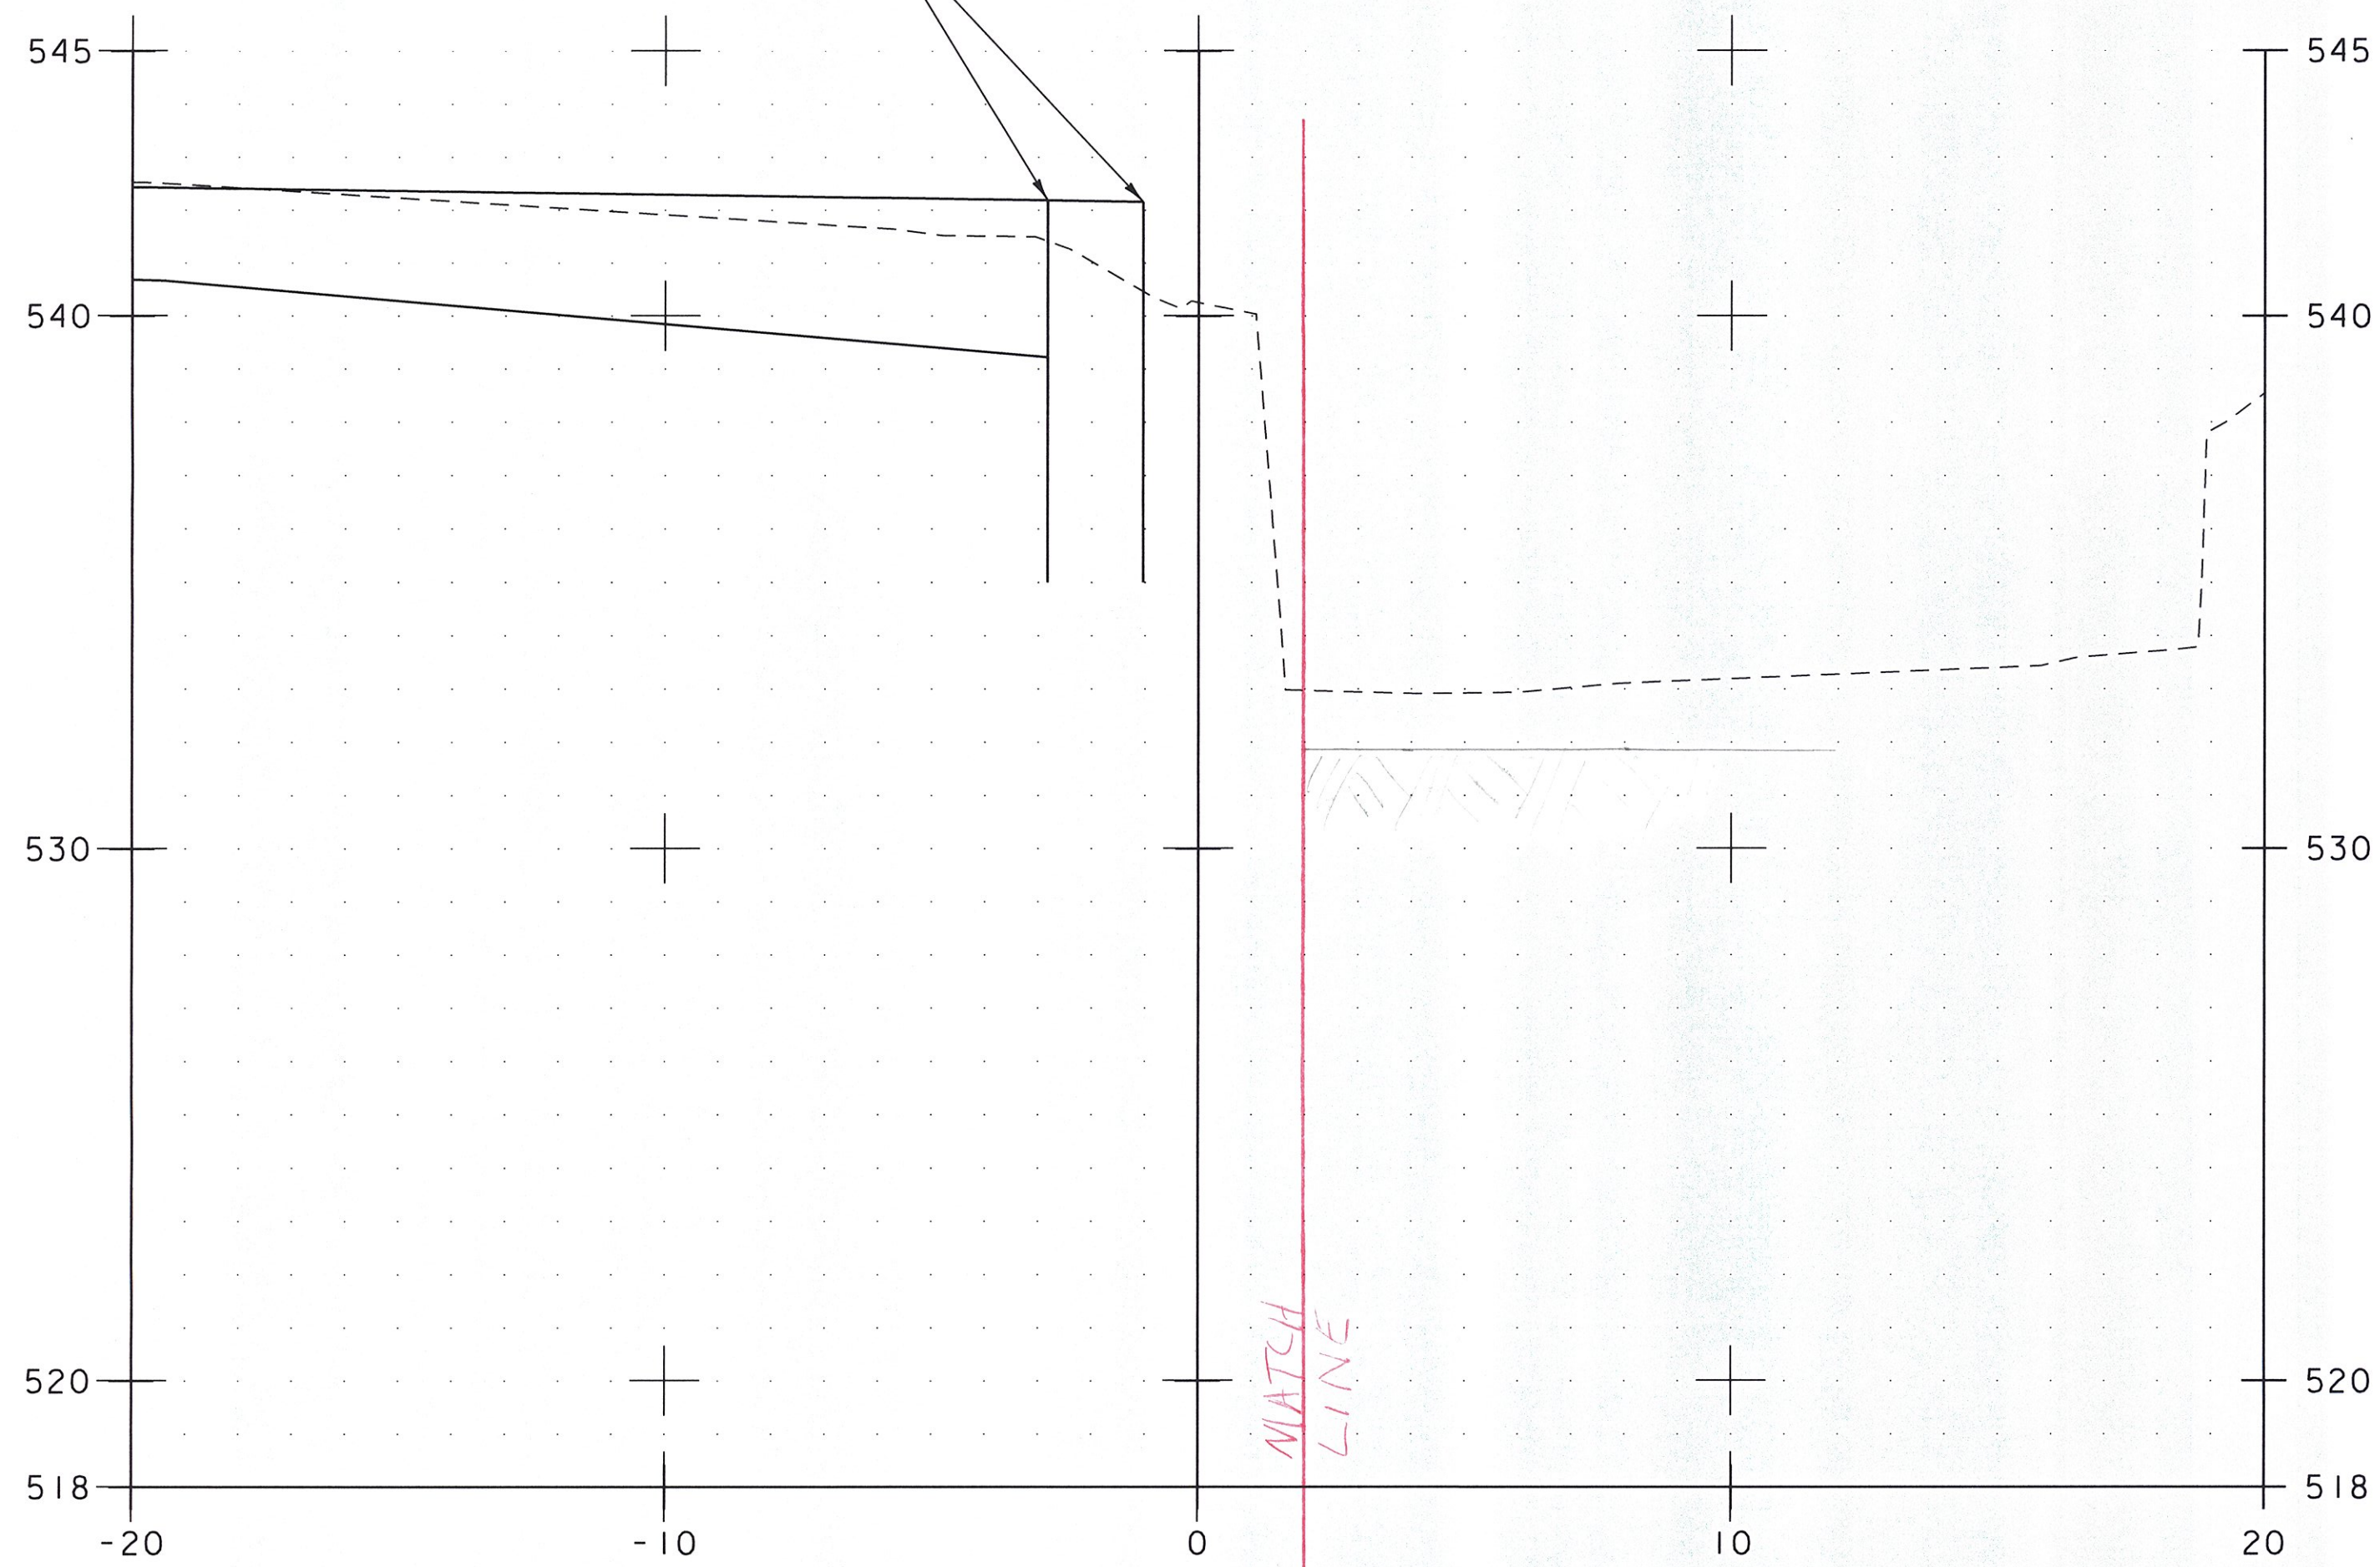

19+80.50

Unclassified Channel Excavation = Zero
 Stone Fill, type # = Zero
 Geo. Under Stone Fill = Zero
 Unclassified Channel = Zero

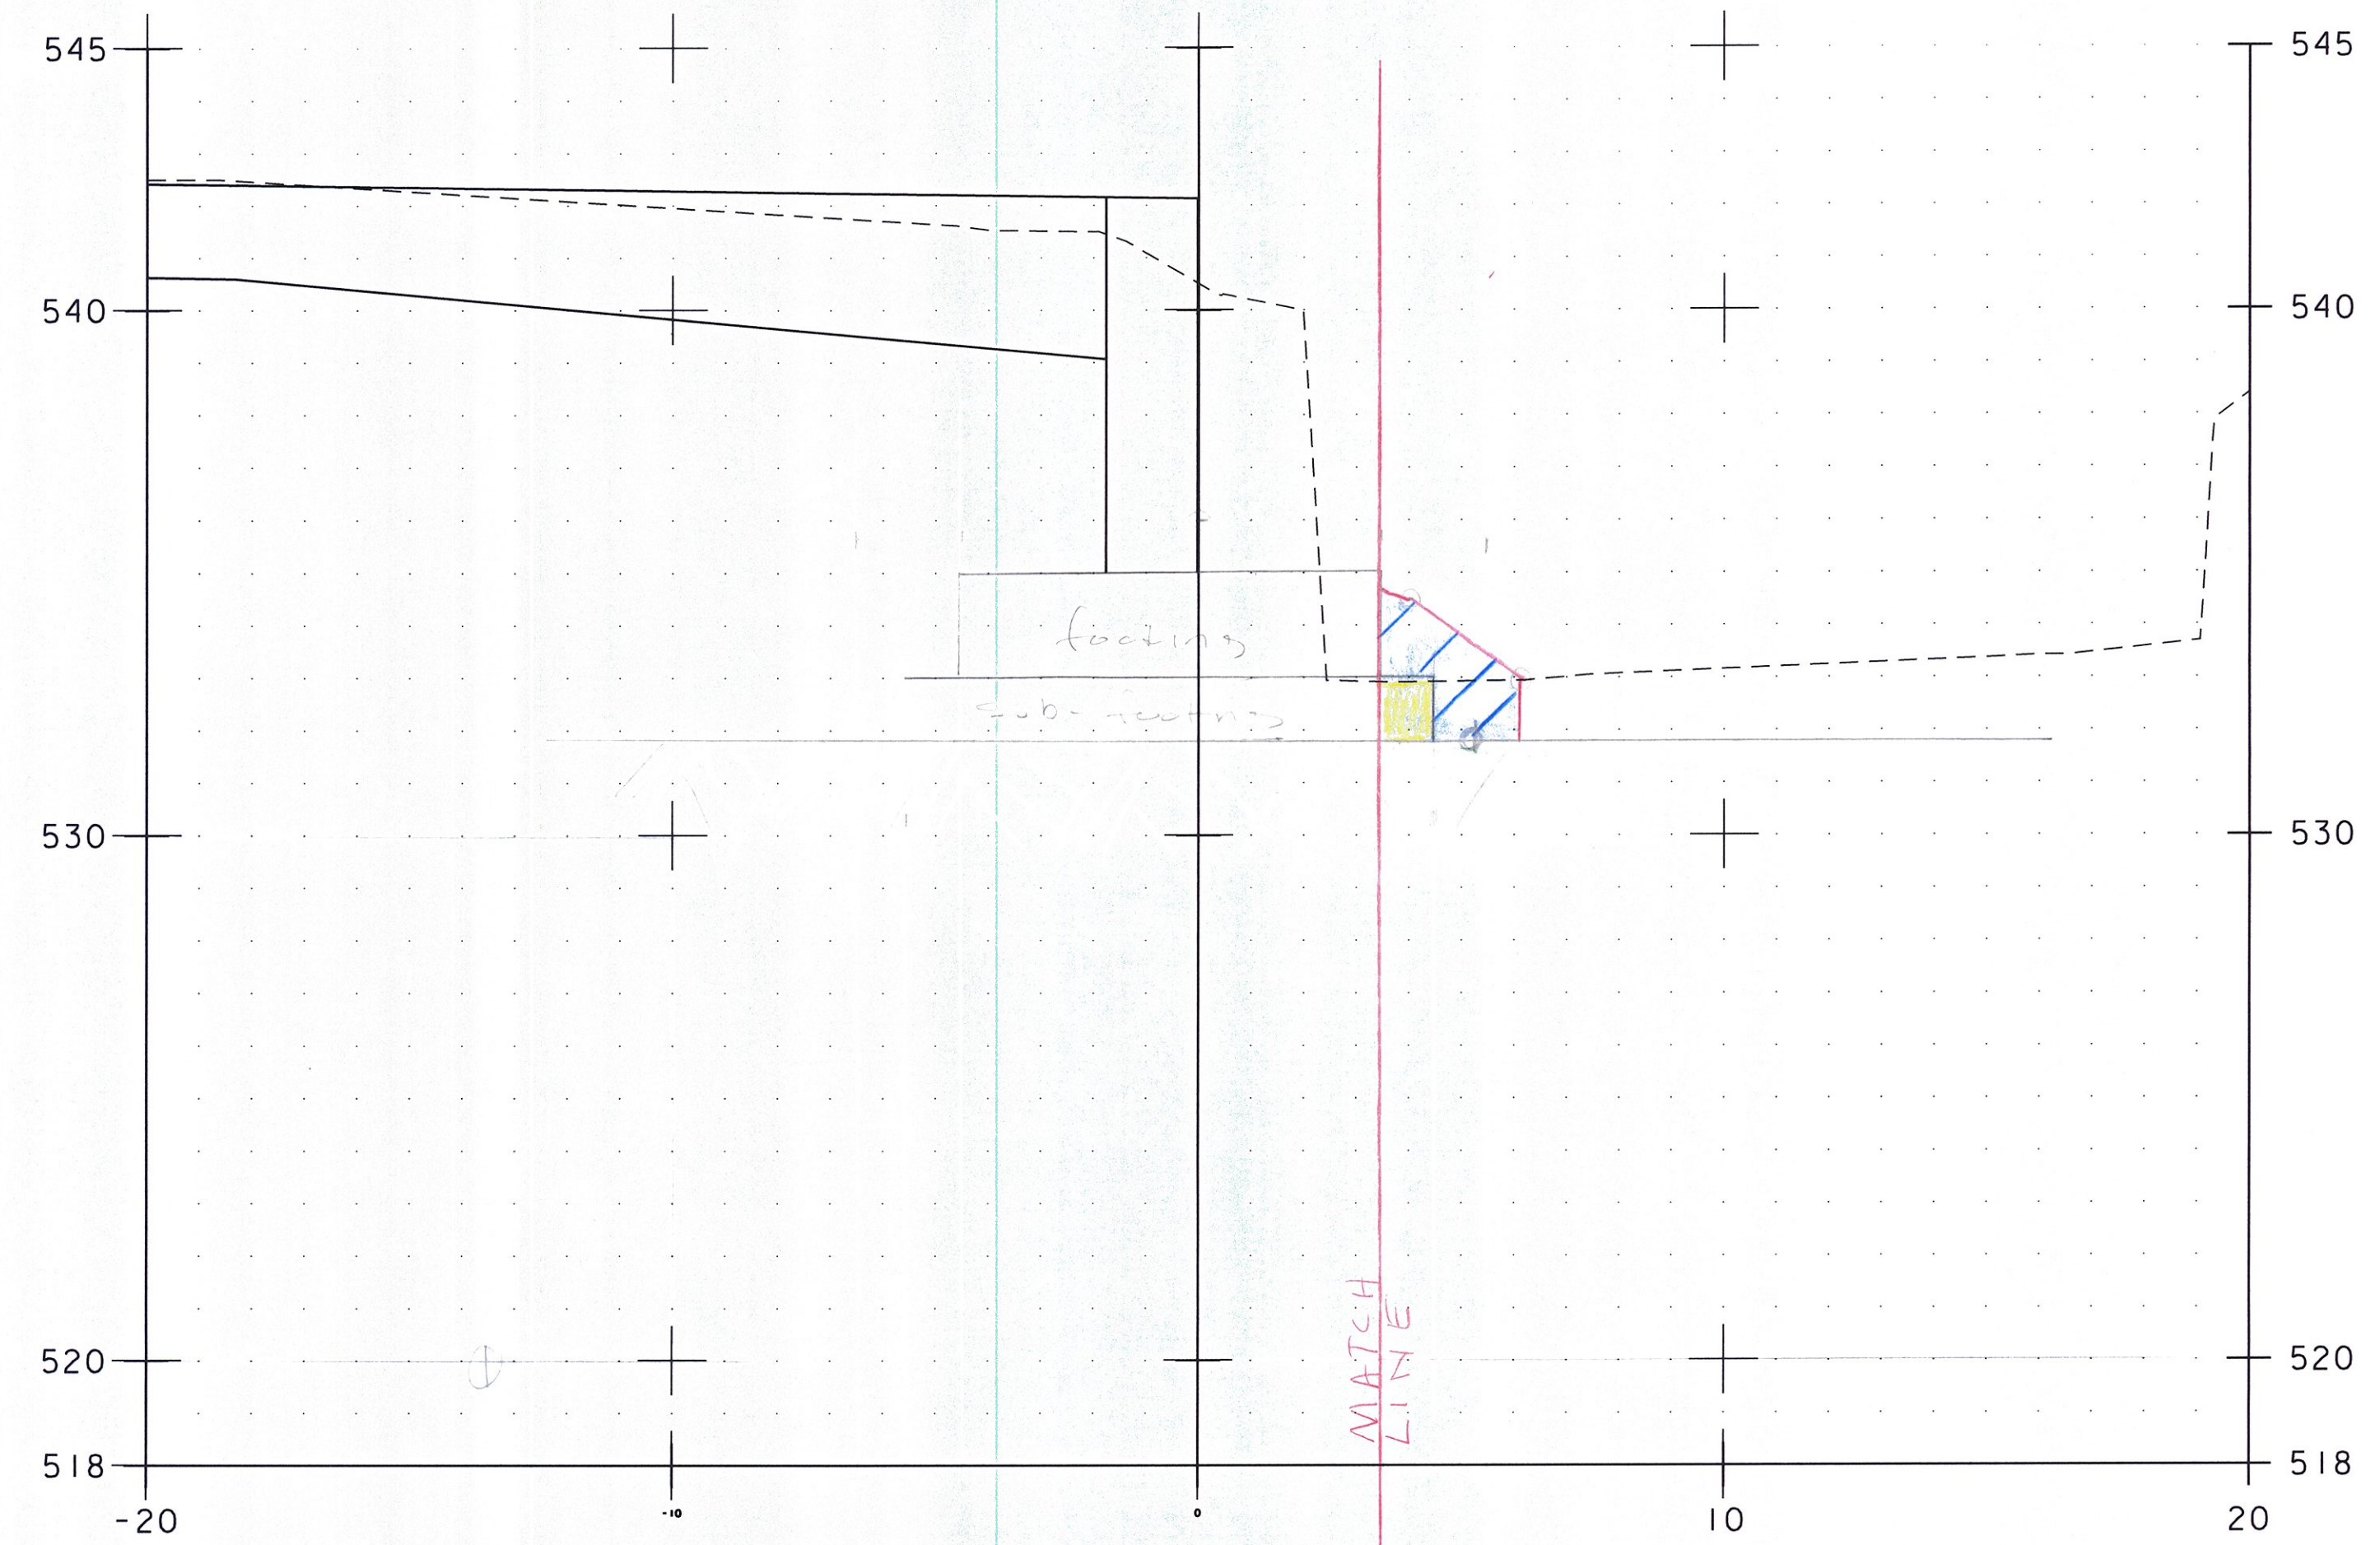

19+81.60

Cofferdam Excavation = Zero ✓
 Granular Backfill for Settlement = Zero ✓
 Unclassified Channel Excavation = 55 ft² ✓
 Stone Fill, type # = 4.5 ft² ✓
 Geo. Under Stone Fill = 5 ft ✓
 Unclassified Channel = 20 ft ✓
 M.W.H. 6/25/15
 JDE 7/1/15

NOTE: LOCATION OF SUBBASE IS APPROXIMATE,
PROPOSED GRADE IS NOT SHOWN.

PROJECT NAME: BRATTLEBORO
 PROJECT NUMBER: BRO 1442(35)

FILE NAME: z10j062_customEL.dgn
 PROJECT LEADER: S.E. BURBANK
 DESIGNED BY: E.F. LAWES
 ABUTMENT NO. 2 CROSS SECTIONS (1 OF 9)

PLOT DATE: 3/2/2015
 DRAWN BY: E.F. LAWES
 CHECKED BY: S.E. BURBANK
 SHEET 1 OF 28



SCALE 1" = 3'-0"