
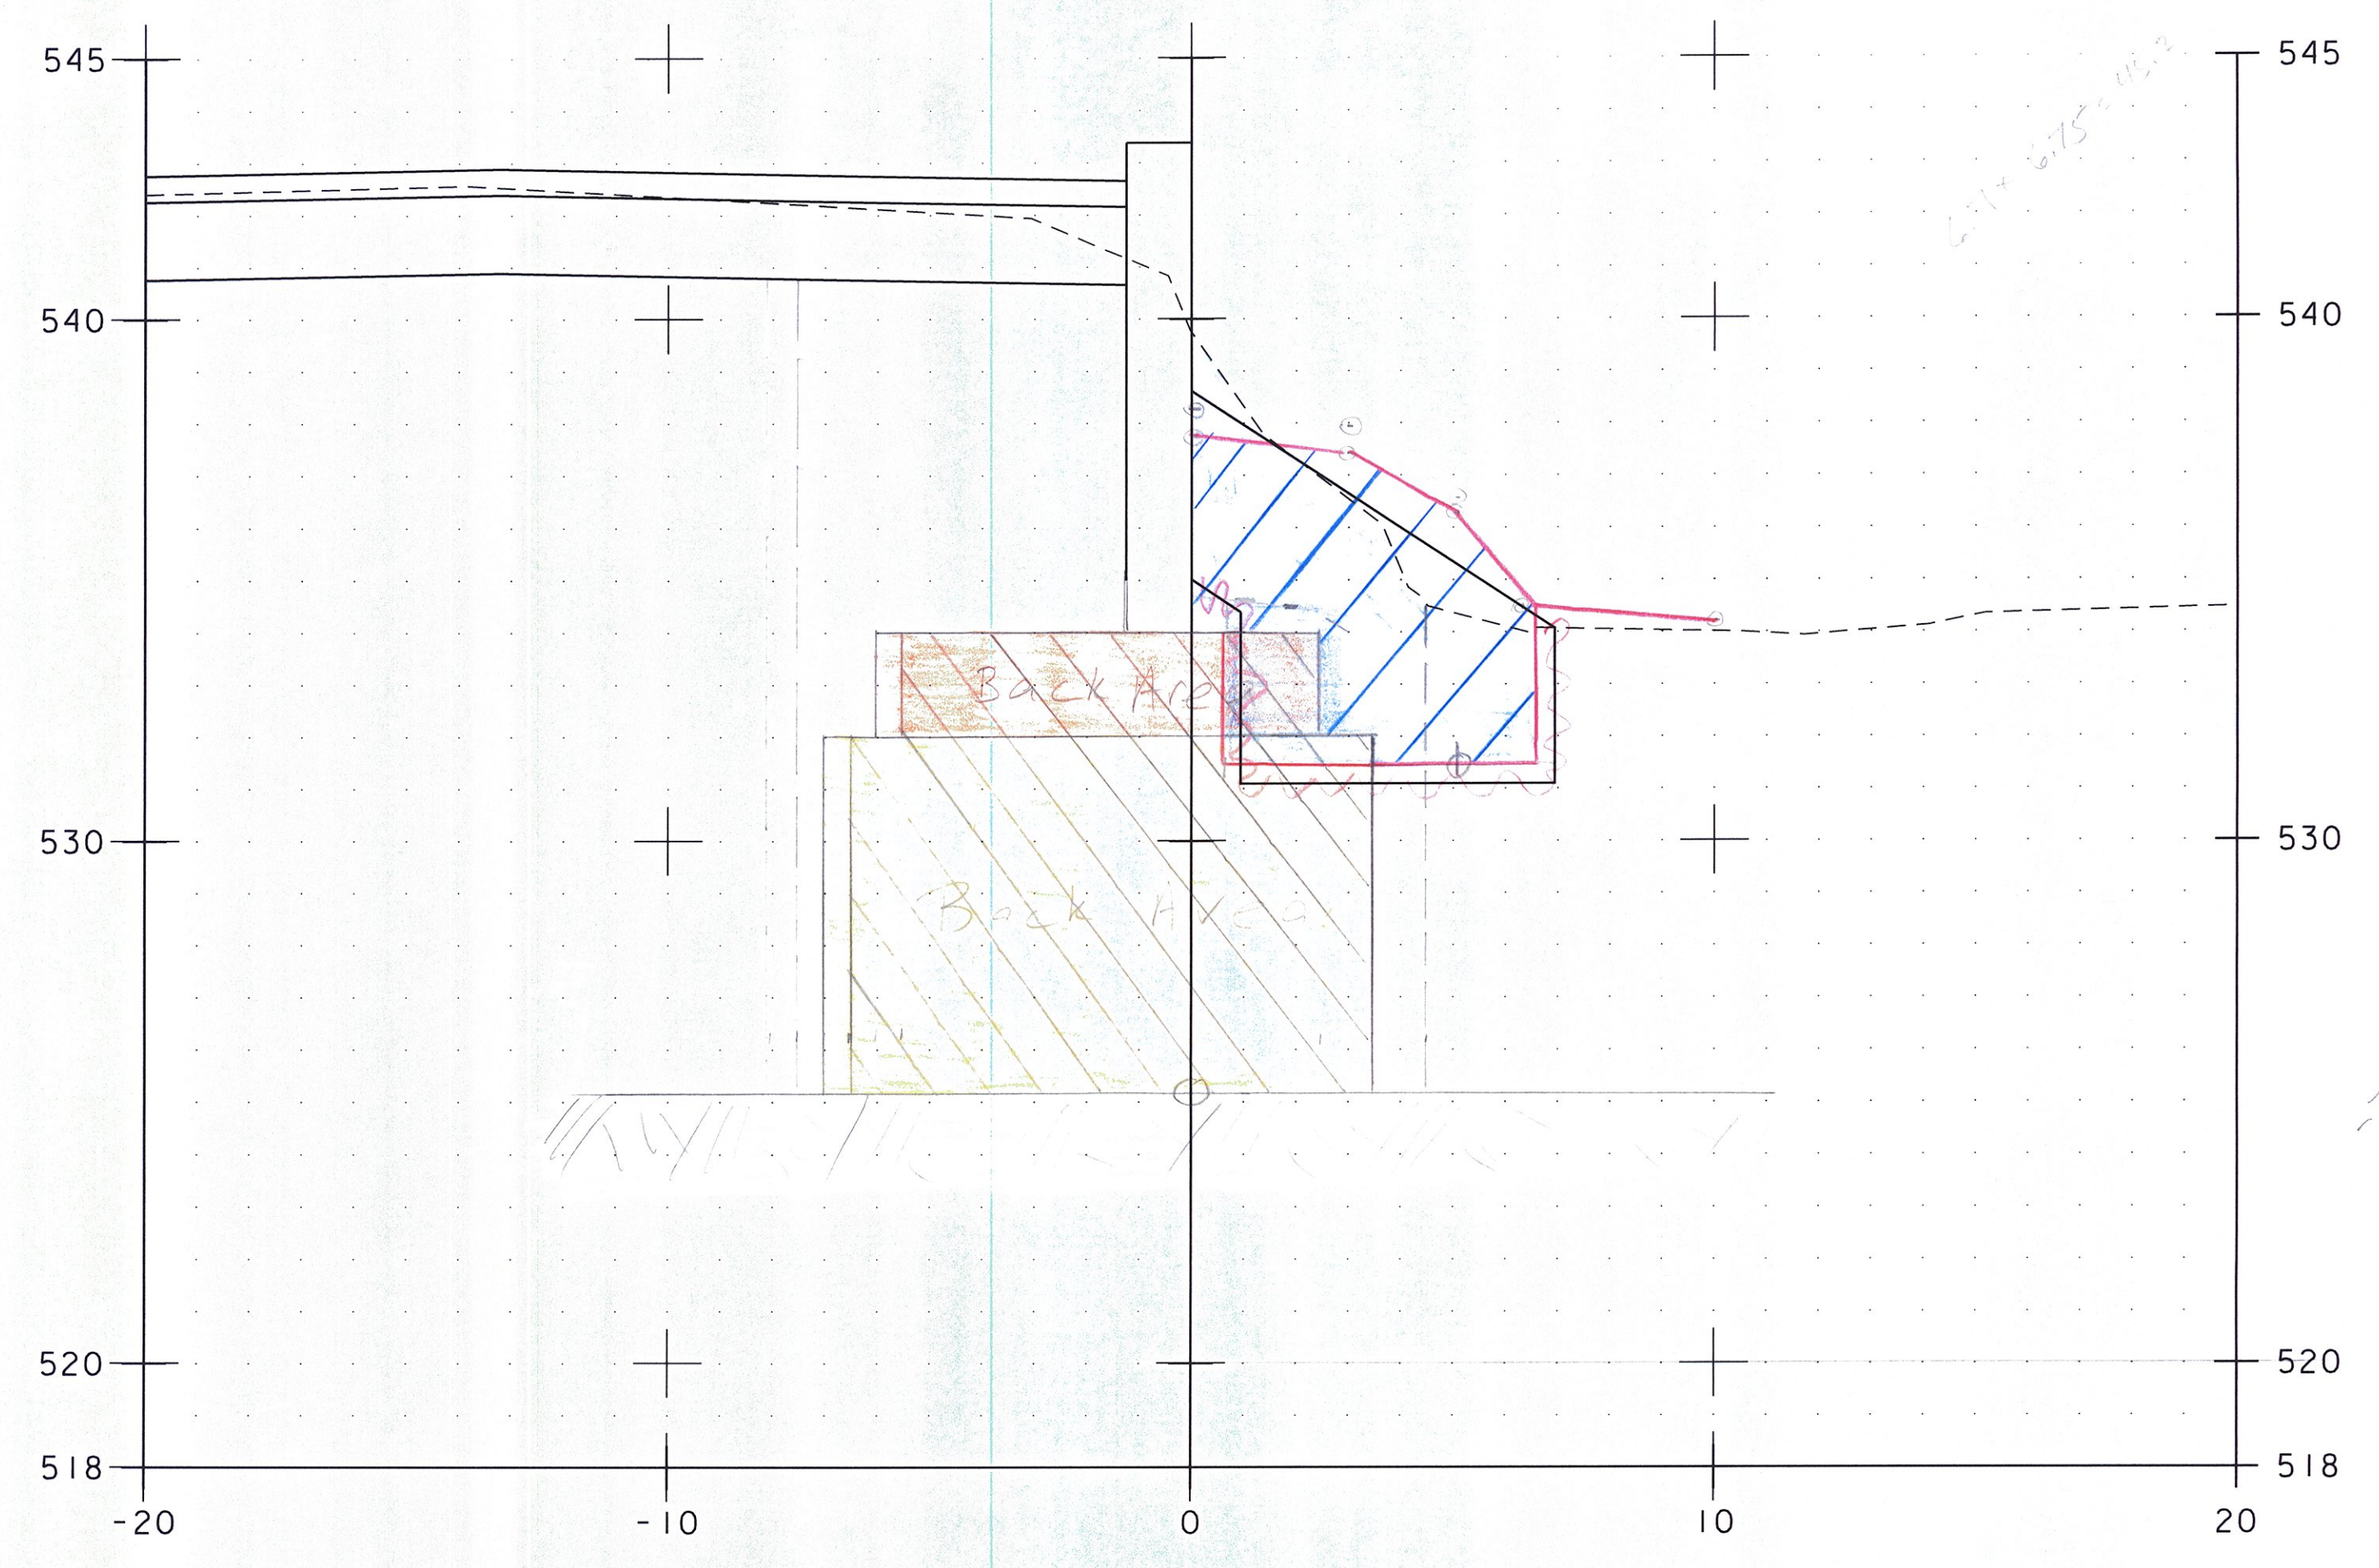


$335 \text{ CE} = 121.5 \text{ FT}^2$   
 $10 \times 372 = 67.5 \text{ FT}^2 \text{ (sh)}$   
 $74.3 \text{ FT}^2 \text{ (bk)}$   
 $173.3 \text{ CE} = 24.5 \text{ FT}^2$   
 $28.7 \text{ CE} = 39.8 \text{ FT}^2$

$114 \text{ CE} = 23.5 \text{ FT}^2$   
 $46.1 \text{ FT}^2 \text{ (sh)}$   
 $60.2 \text{ CE} = 23.5 \text{ FT}^2$   
 $2.8 \text{ CE} = 2.8 \text{ FT}^2$   
 $2.1 \text{ CE} = 2.1 \text{ FT}^2$   
 $60.3 \text{ CE} = 60.3 \text{ FT}^2$

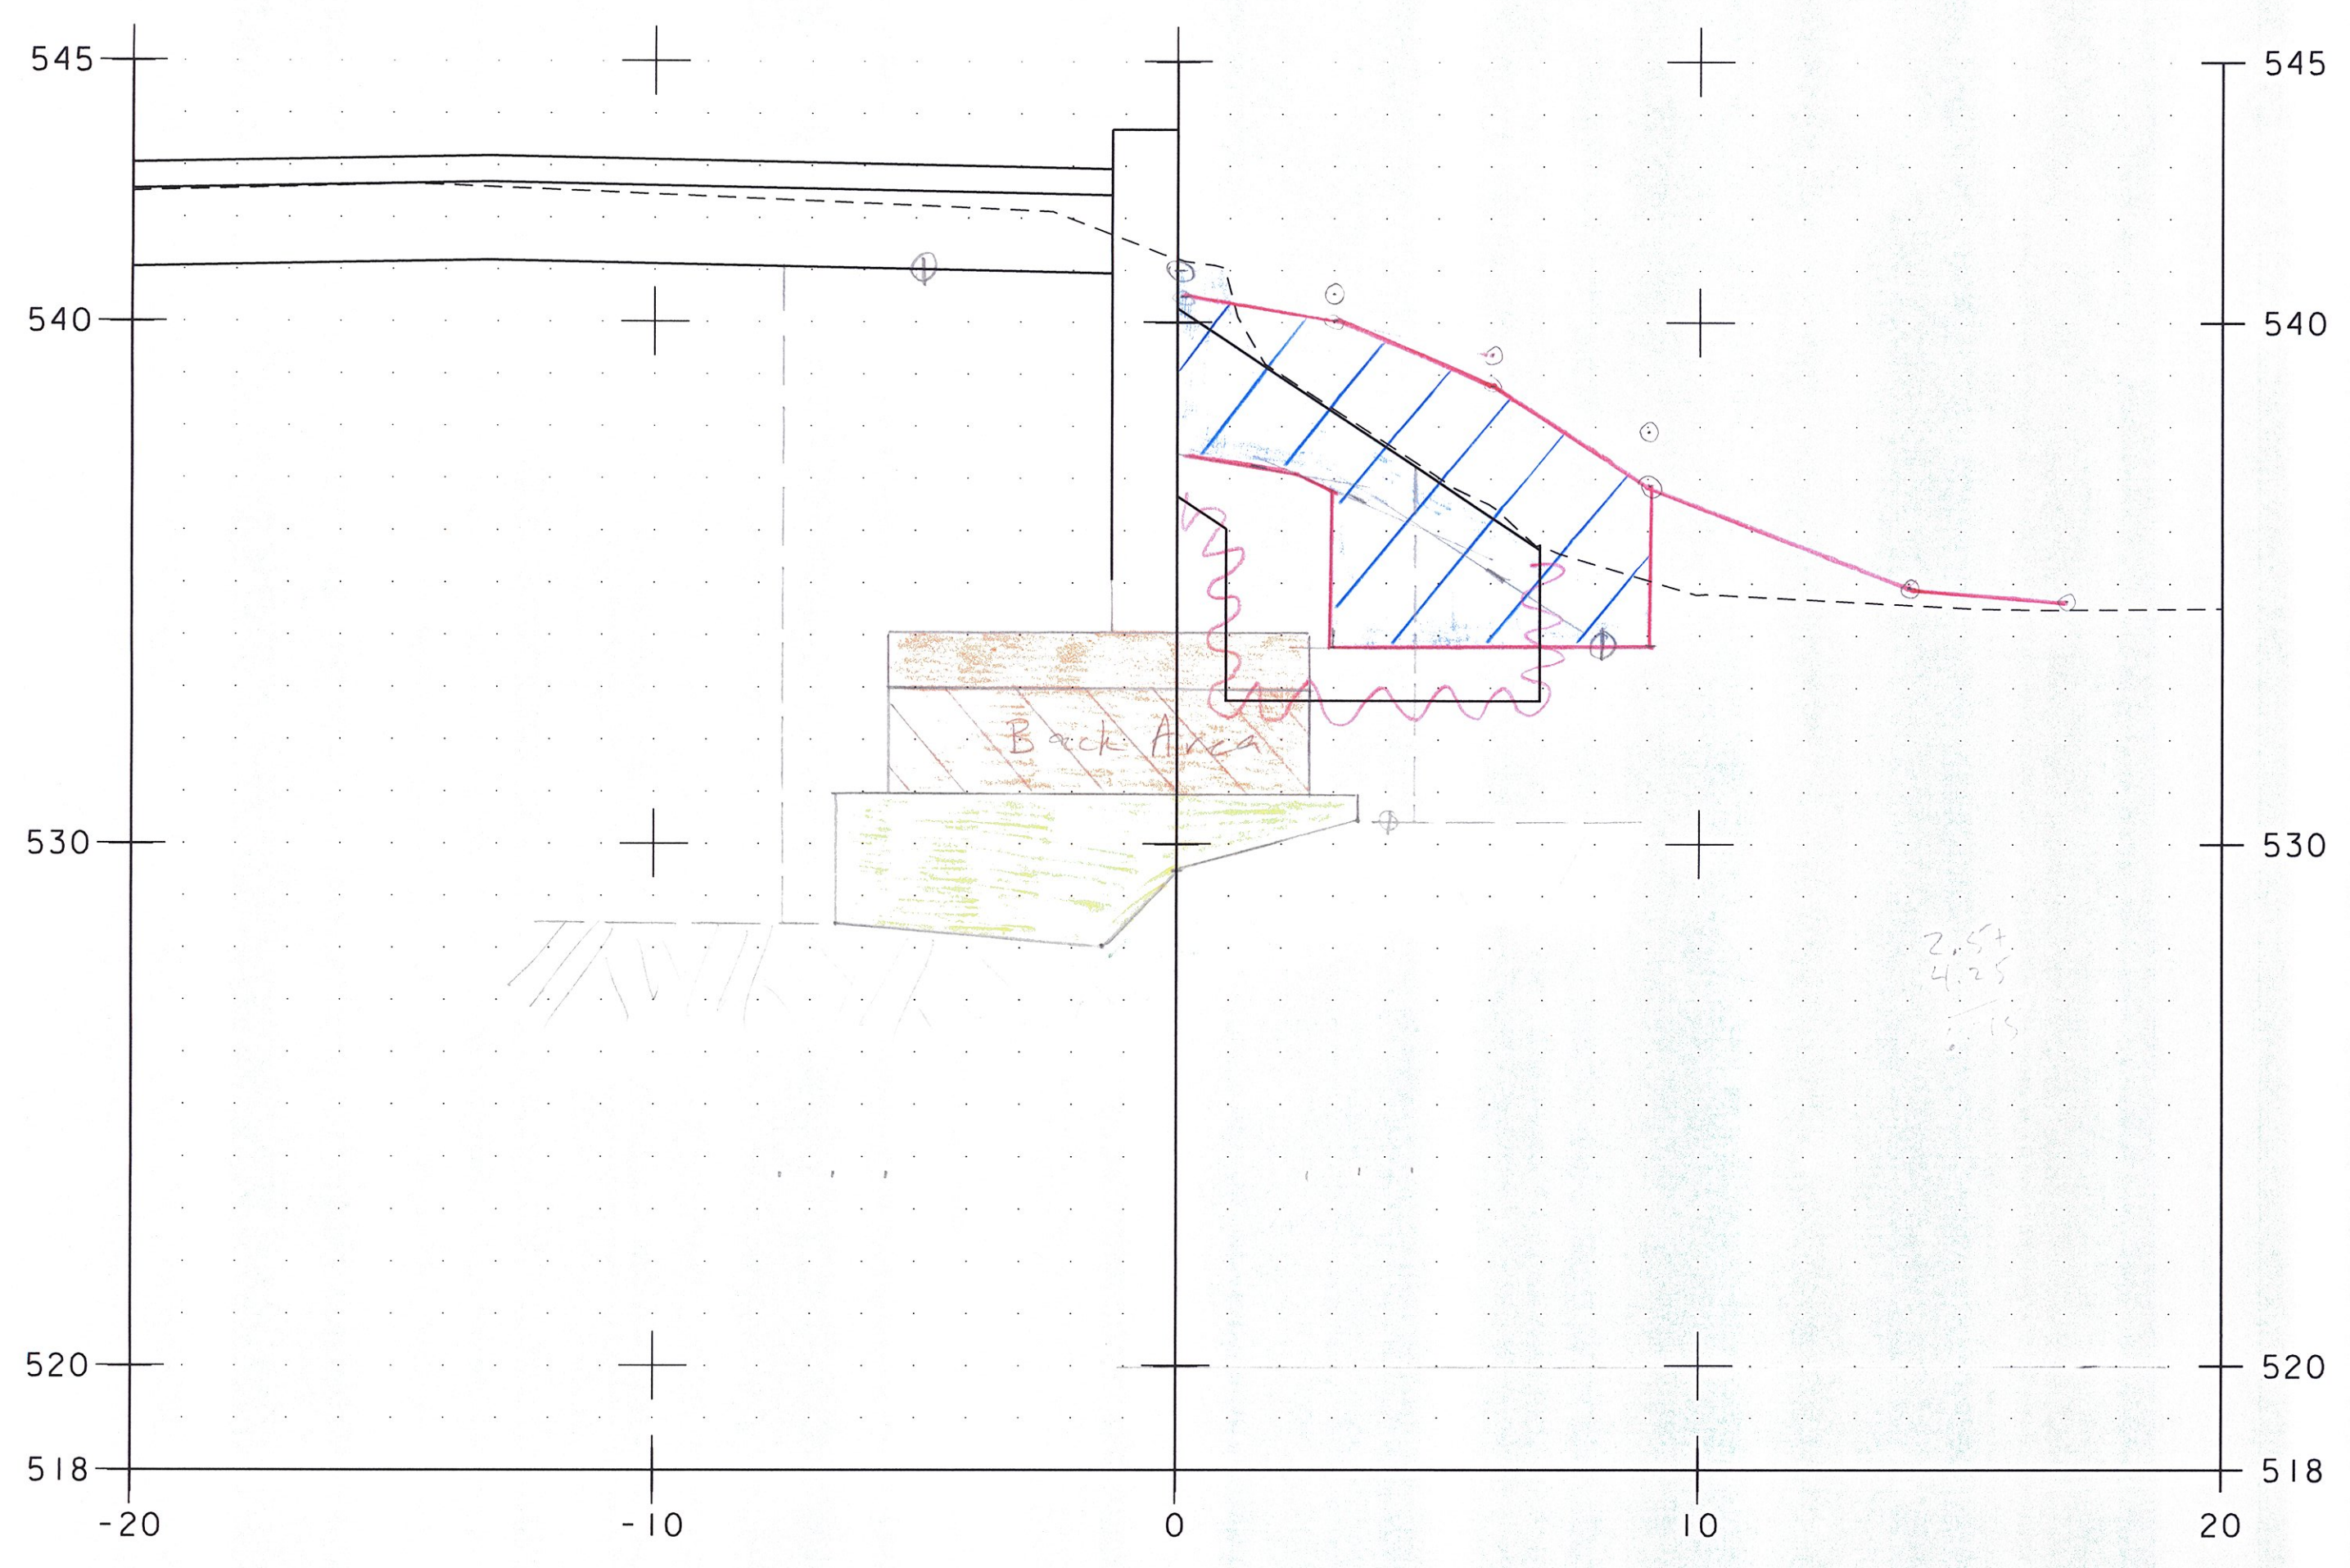

Cofferdam Earth  
 $29+79.0 = 121.5 \text{ FT}^2 \checkmark$   
 Granular Backfill for Structures  
 $29+79.0 \text{ (bk)} = 74.3 \text{ FT}^2 \checkmark$   
 $29+79.0 \text{ (sh)} = 67.5 \text{ FT}^2 \checkmark$   
 Unexcavated Channel Excavation  
 $29+79.0 = 24.5 \text{ FT}^2 \checkmark$   
 Stone Fill, type III  
 $29+79.0 = 39.8 \text{ FT}^2 \checkmark$   
 Geo. Under Stone Fill  
 $29+79.0 = 18' \checkmark$   
 PM 3/5/15

Cofferdam Earth  
 $30+00 \text{ (sh)} = 14.1 \text{ FT}^2 \checkmark$   
 $30+00 \text{ (bk)} = 33.0 \text{ FT}^2 \checkmark$   
 Granular Backfill for Structures  
 $30+00 \text{ (sh)} = 66.8 \text{ FT}^2 \checkmark$   
 $30+00 \text{ (bk)} = 62.3 \text{ FT}^2 \checkmark$   
 Unexcavated Channel Excavation  
 $30+00 = 30.0 \text{ FT}^2 \checkmark$   
 Stone Fill, type II  
 $30+00 = 23.5 \text{ FT}^2 \checkmark$   
 Geo. Under Stone Fill  
 $30+00 = 6' \checkmark$   
 PM 3/5/15

SCALE 1" = 3'-0"

NOTE: PROPOSED GRADE IS NOT SHOWN.

PROJECT NAME: BRATTLEBORO	
PROJECT NUMBER: BRO 1442(35)	
FILE NAME: z10j062_customEL.dgn	PLOT DATE: 3/2/2015
PROJECT LEADER: S.E. BURBANK	DRAWN BY: E.F. LAWES
DESIGNED BY: E.F. LAWES	CHECKED BY: S.E. BURBANK
WINGWALL NO. 3 CROSS SECTIONS (3 OF 7)	SHEET 12 OF 28

