
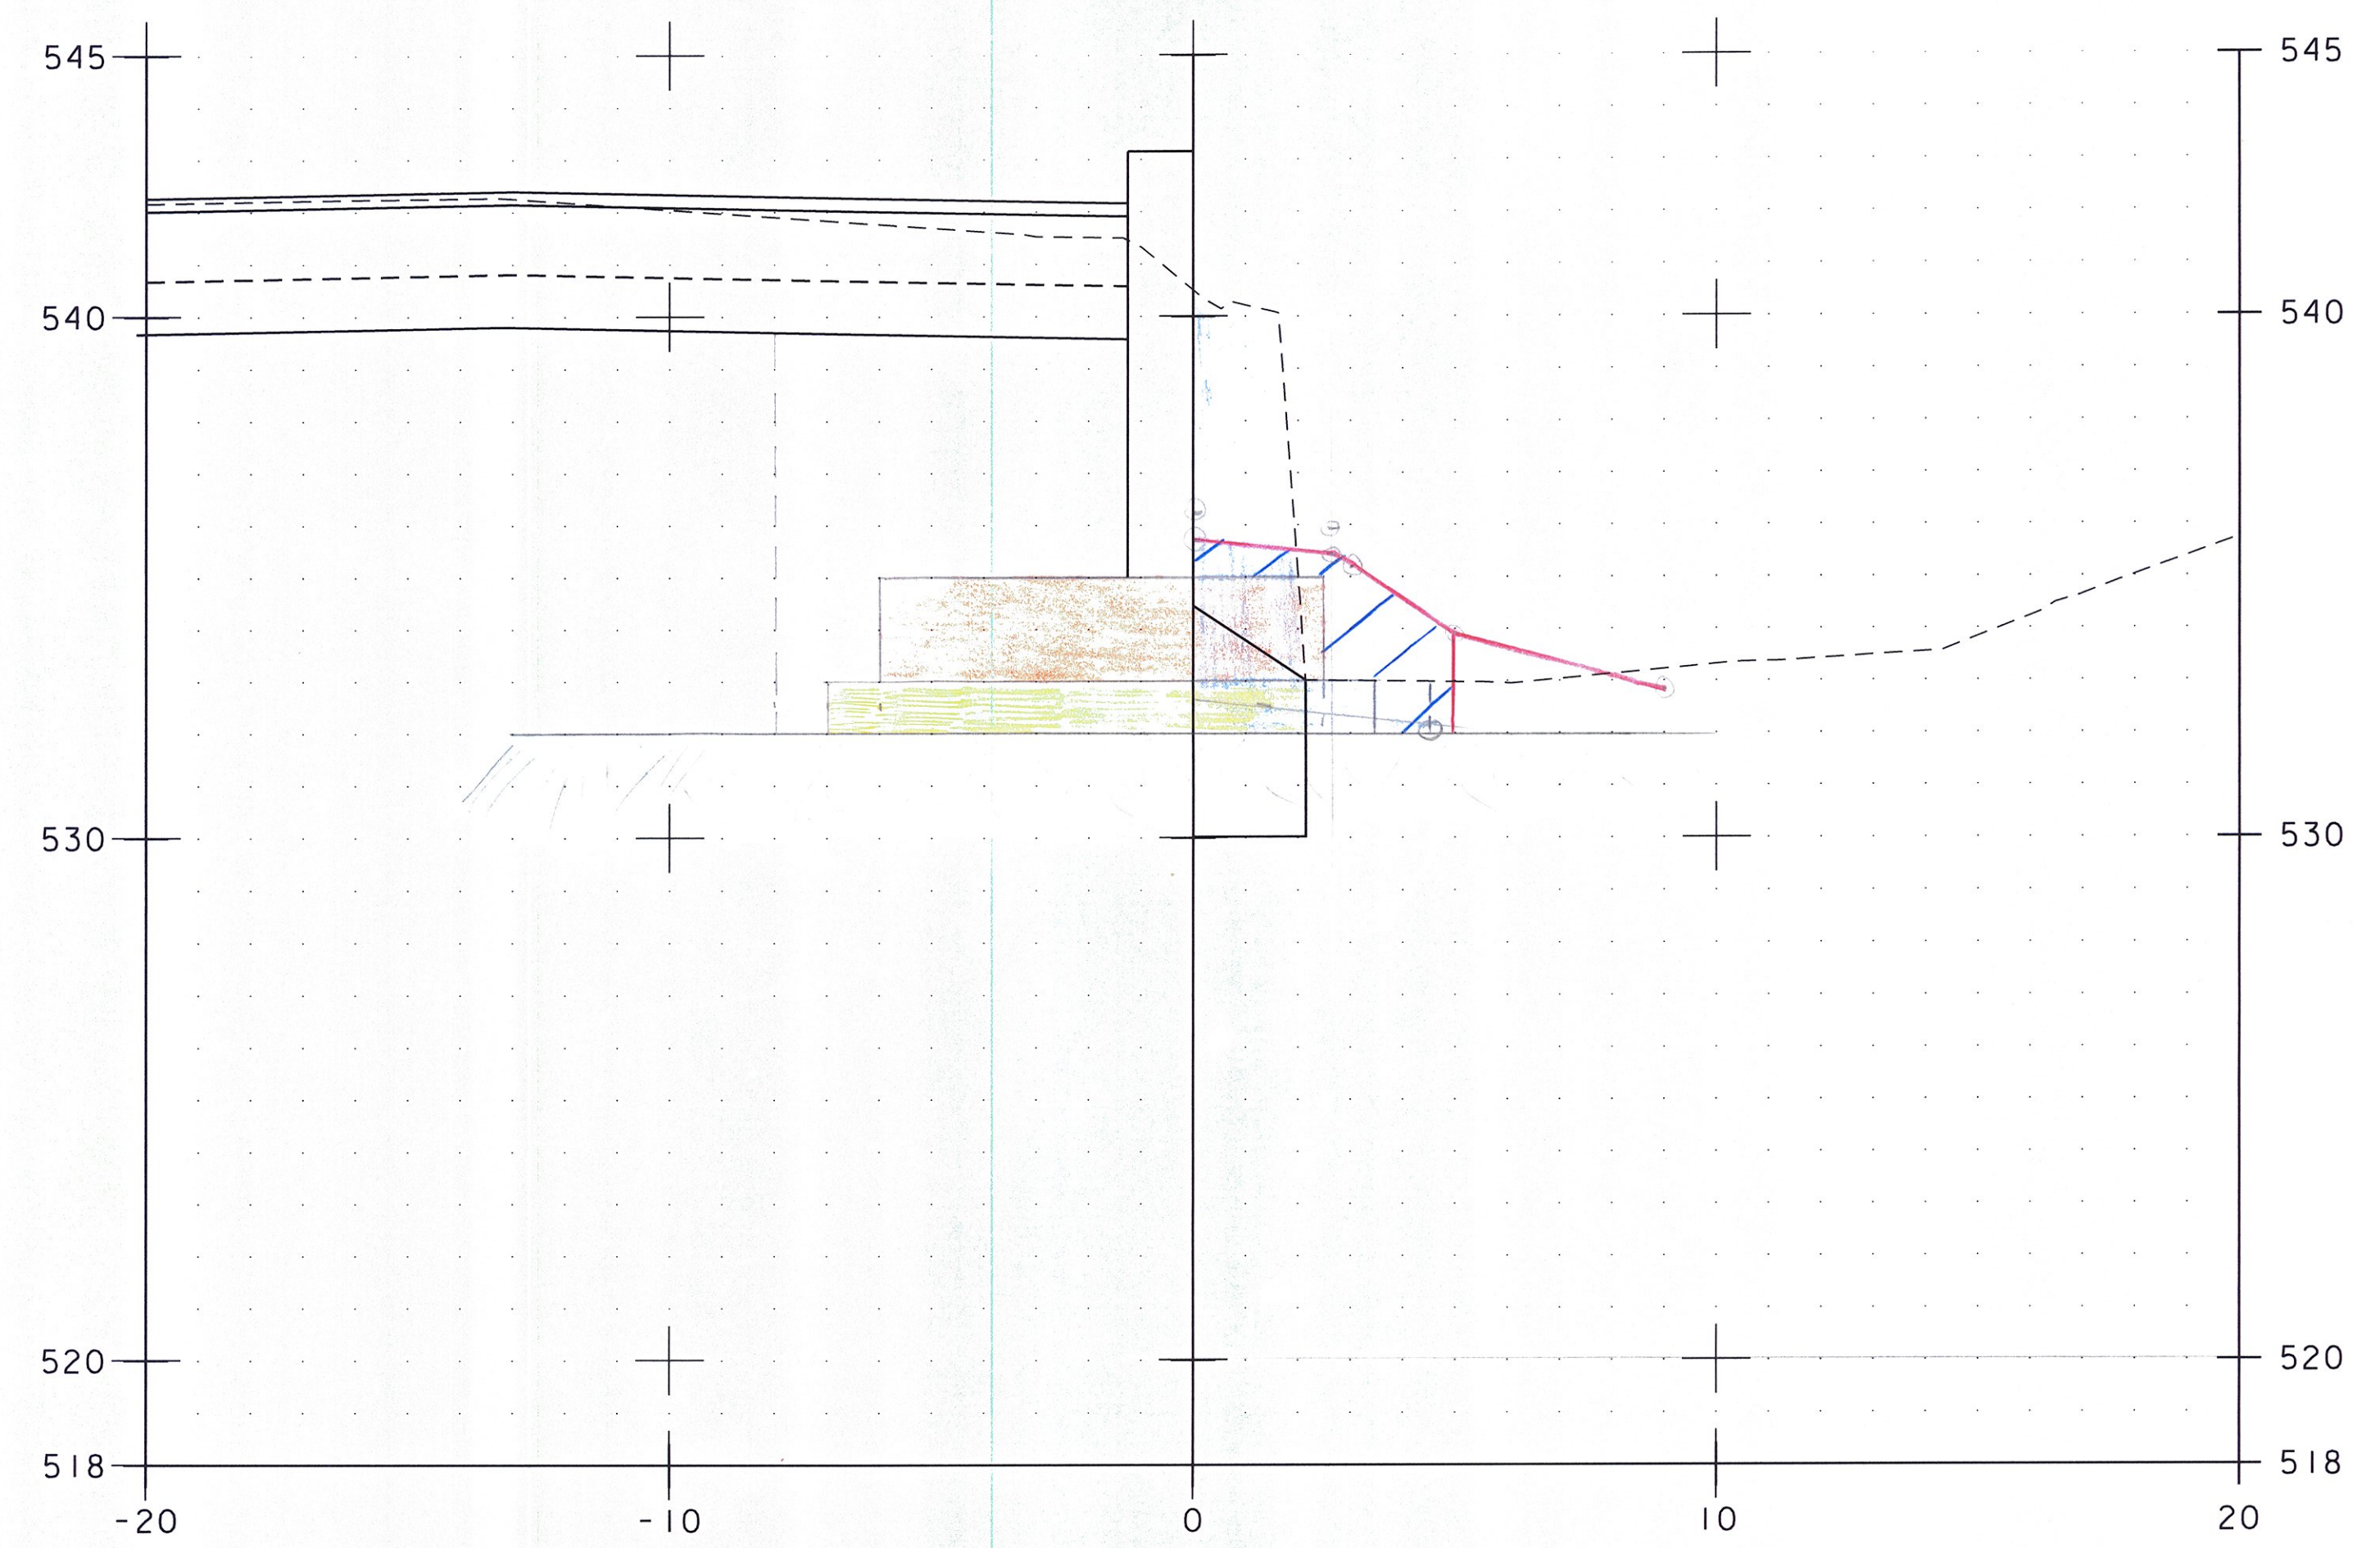


245000 = 33.7 FT²
17950 = 17.7 FT²

130000 = 13.4 FT²
5000 = 7.3 FT²

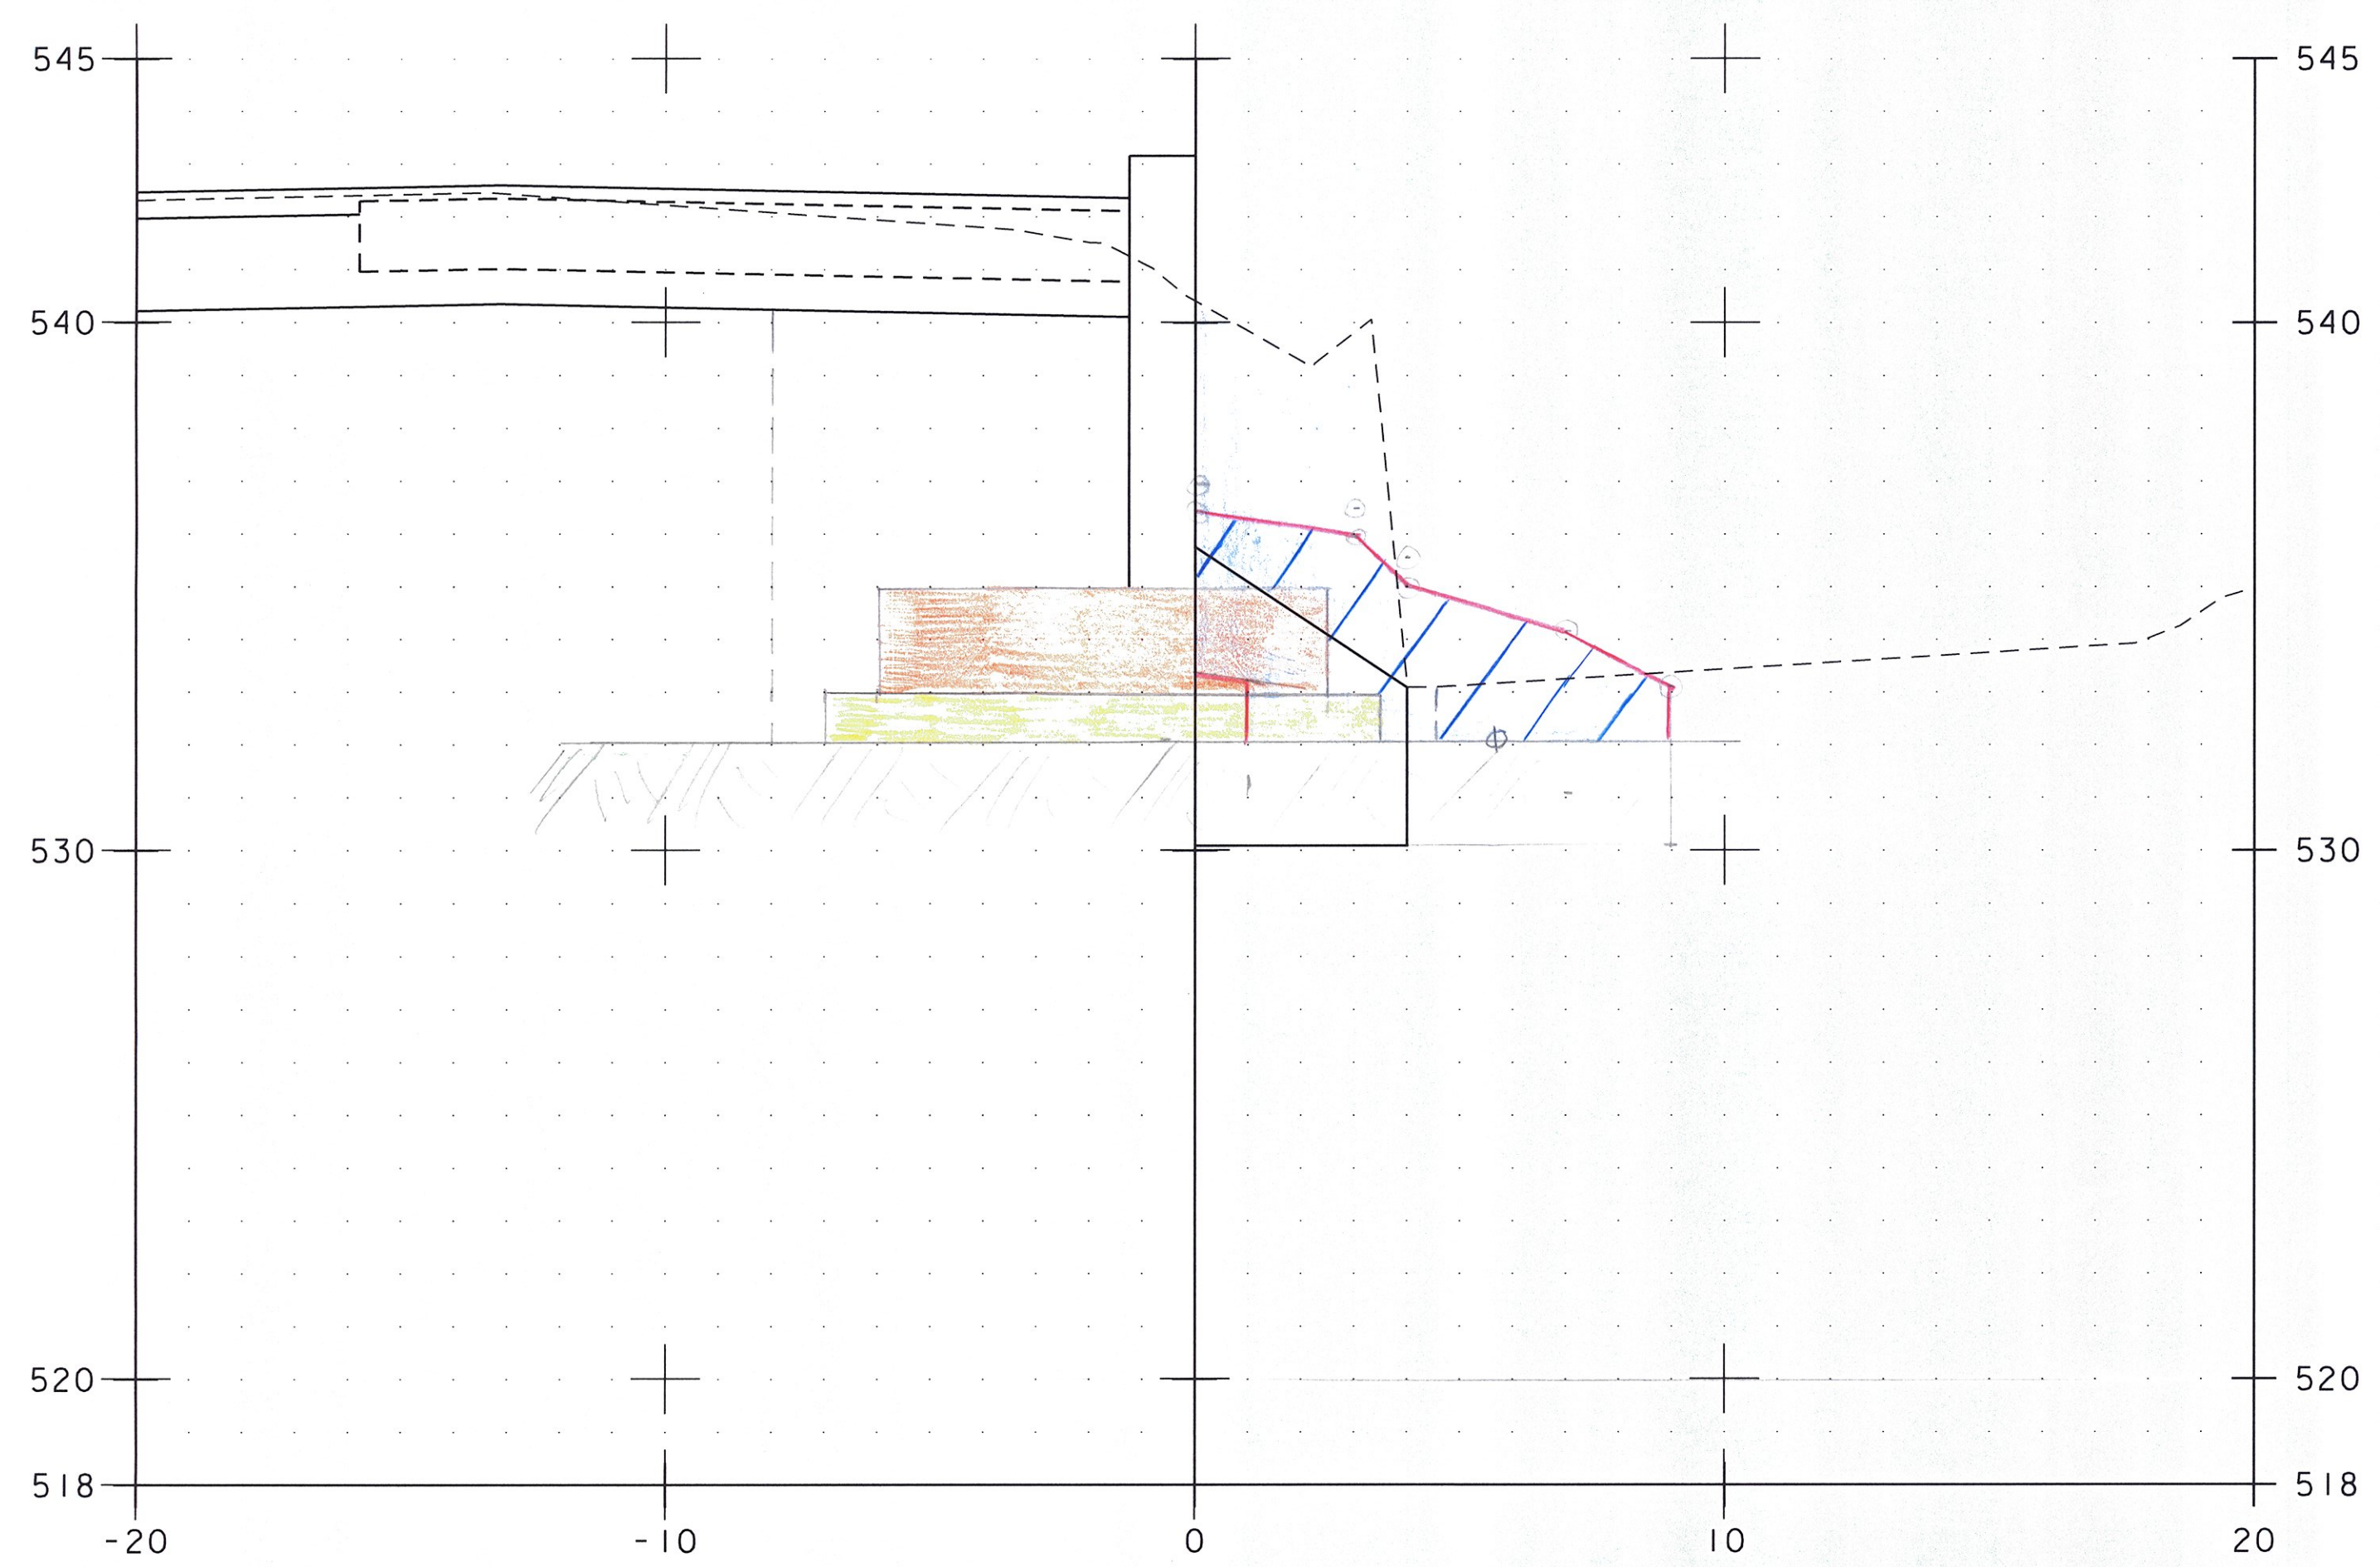

Collected Earth
30+16.5 = 66.3 FT² ✓
Granular Backfill for Structures
30+16.5 = 40.1 FT² ✓
Unclassified Channel Excavation
30+16.5 = 33.7 FT² ✓
Stone Fill, type II
30+16.5 = 17.7 FT² ✓
Geo. Under Stone Fill
30+16.5 = 13.5 FT² ✓
for 5/5/15

30+16.50

Collected Earth
30+26 = 62.2 FT² ✓
Granular Backfill for Structures
30+26 = 36.7 FT² ✓
Unclassified Channel Excavation
30+26 = 13.4 FT² ✓
Stone Fill, type II
30+26 = 7.3 FT² ✓
Geo. Under Stone Fill
30+26 = 11 FT² ✓
for 5/5/15

30+26.00

NOTE: PROPOSED GRADE IS NOT SHOWN.

PROJECT NAME:	BRATTLEBORO
PROJECT NUMBER:	BRO 1442(35)
FILE NAME:	z10j062_customEL.dgn
PROJECT LEADER:	S.E. BURBANK
DESIGNED BY:	E.F. LAWES
WINGWALL NO. 3 CROSS SECTIONS (5 OF 7)	
PLOT DATE:	3/2/2015
DRAWN BY:	E.F. LAWES
CHECKED BY:	S.E. BURBANK
SHEET	14 OF 28



SCALE 1" = 3'-0"