
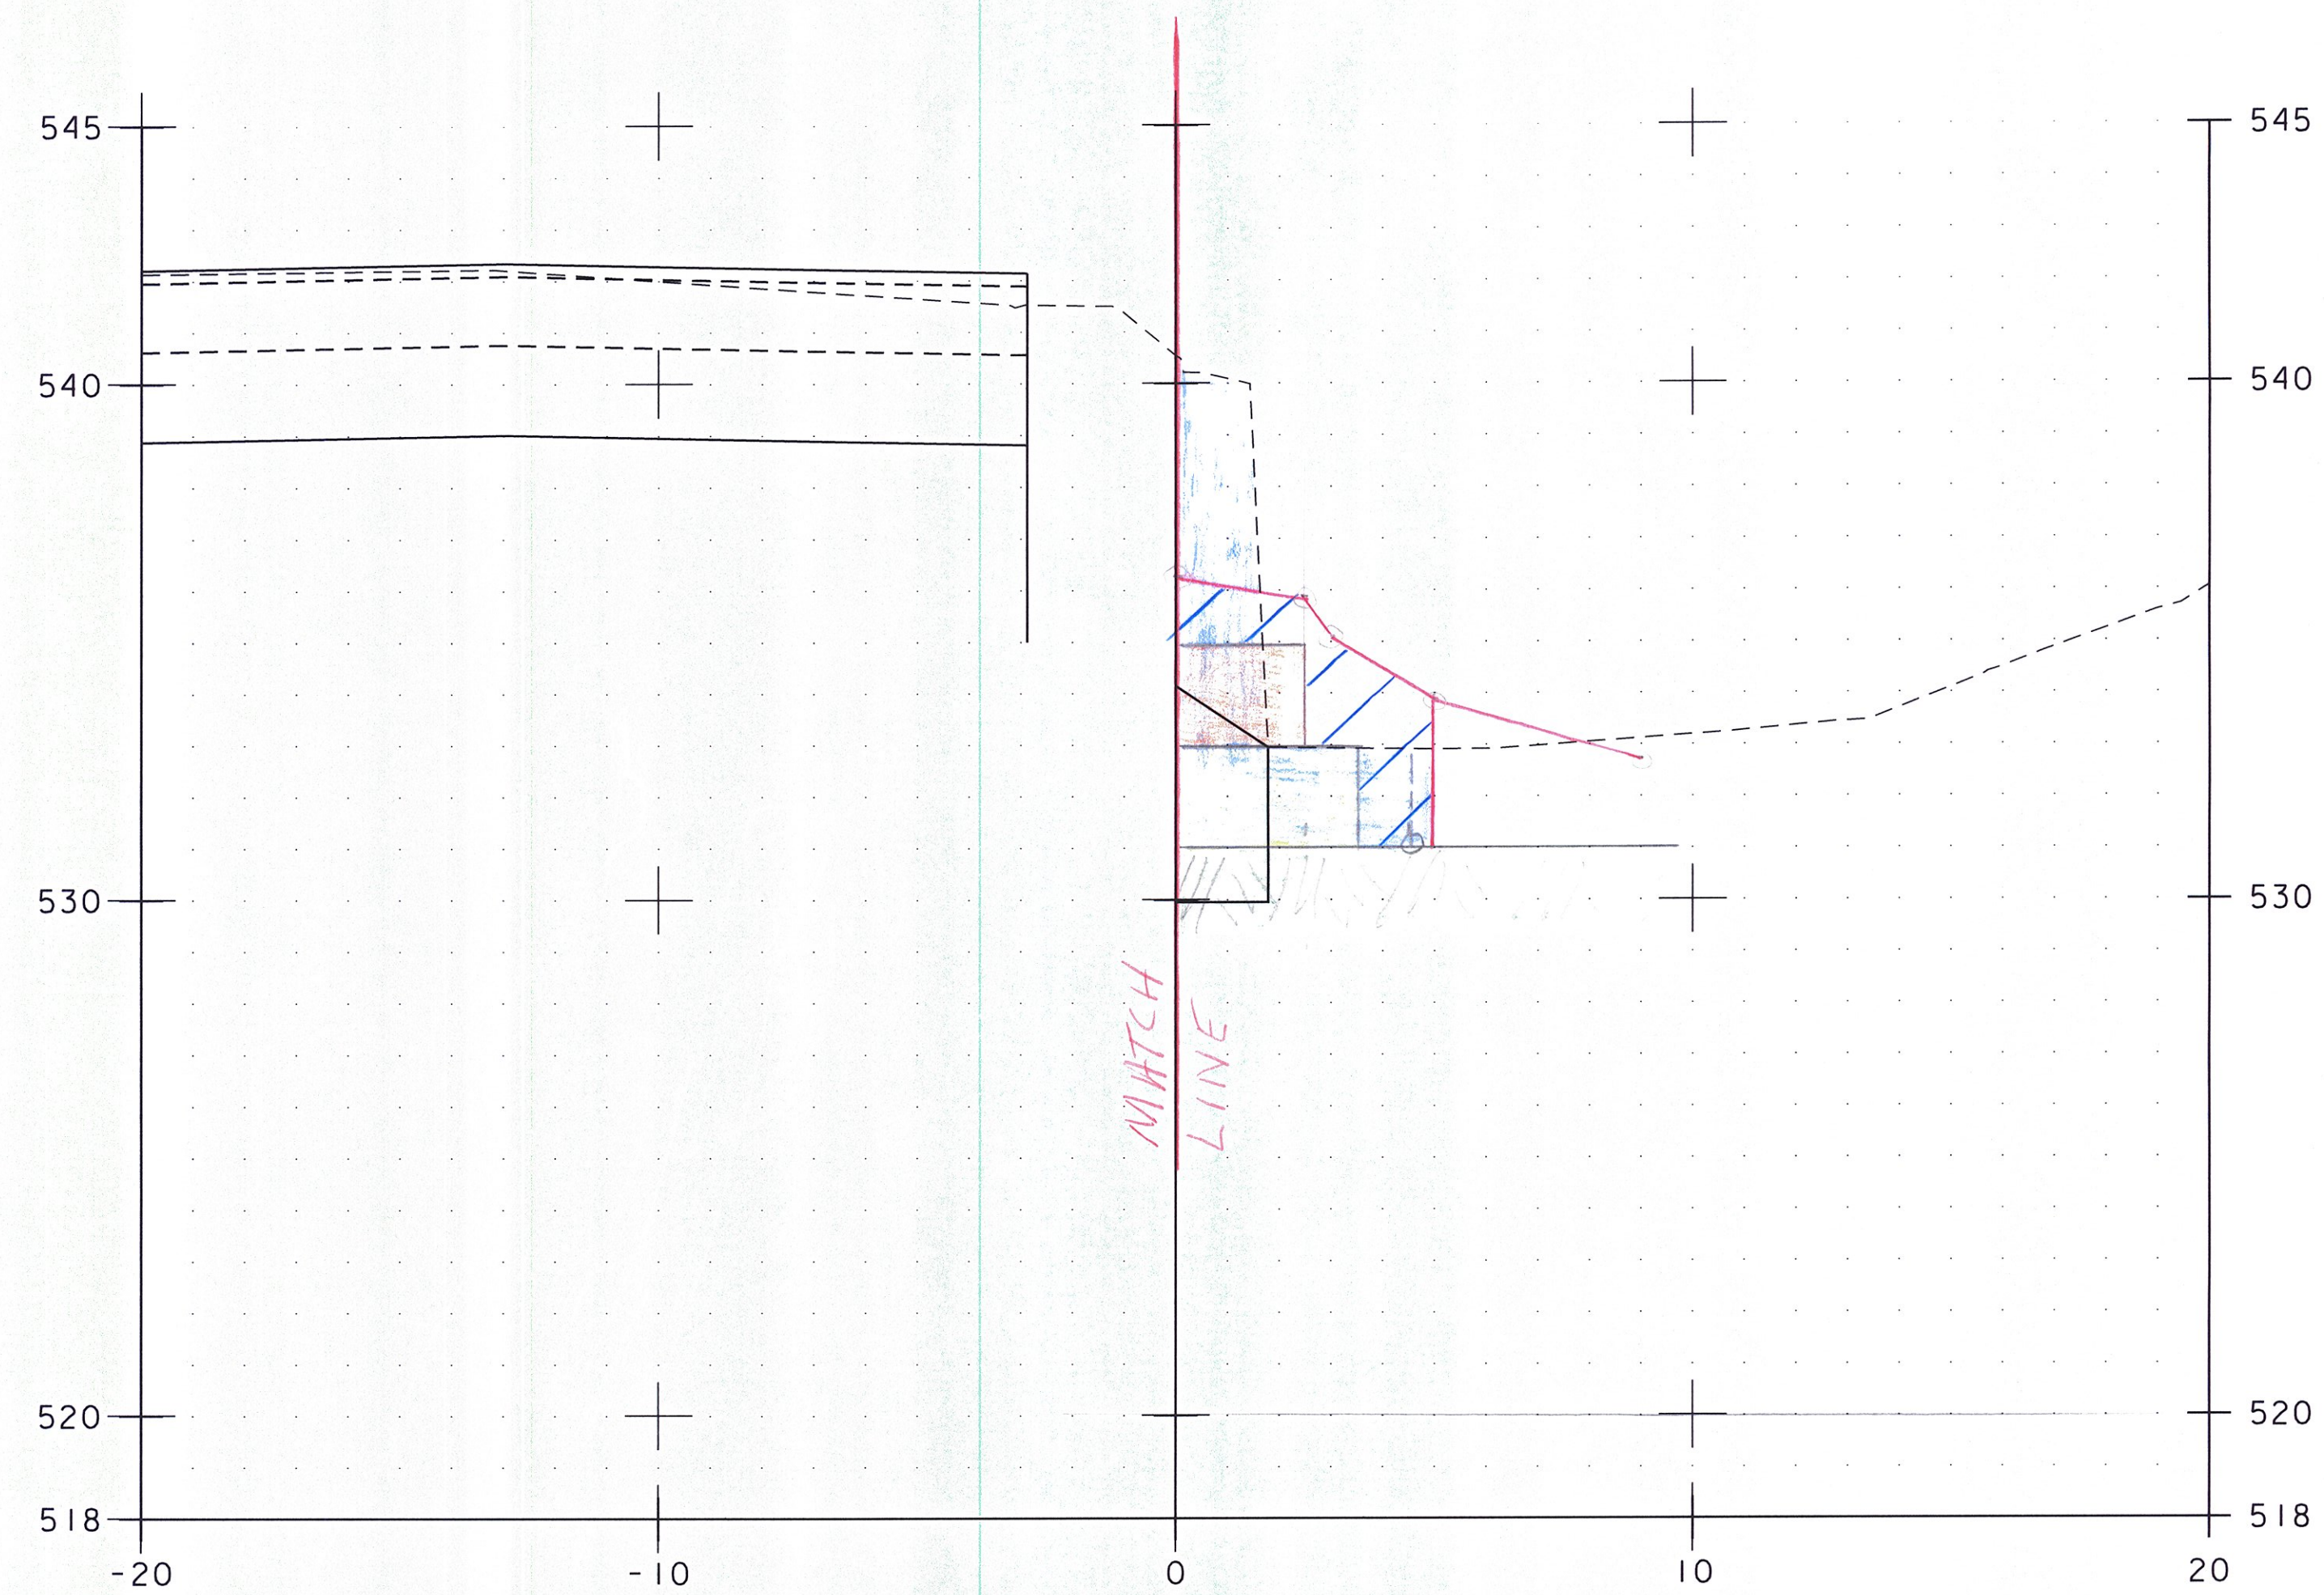


12,000 = 8.7 FT²
62.5 = 2.5 FT²

155,000 = 11.8 FT²
73.5 = 10.0 FT²

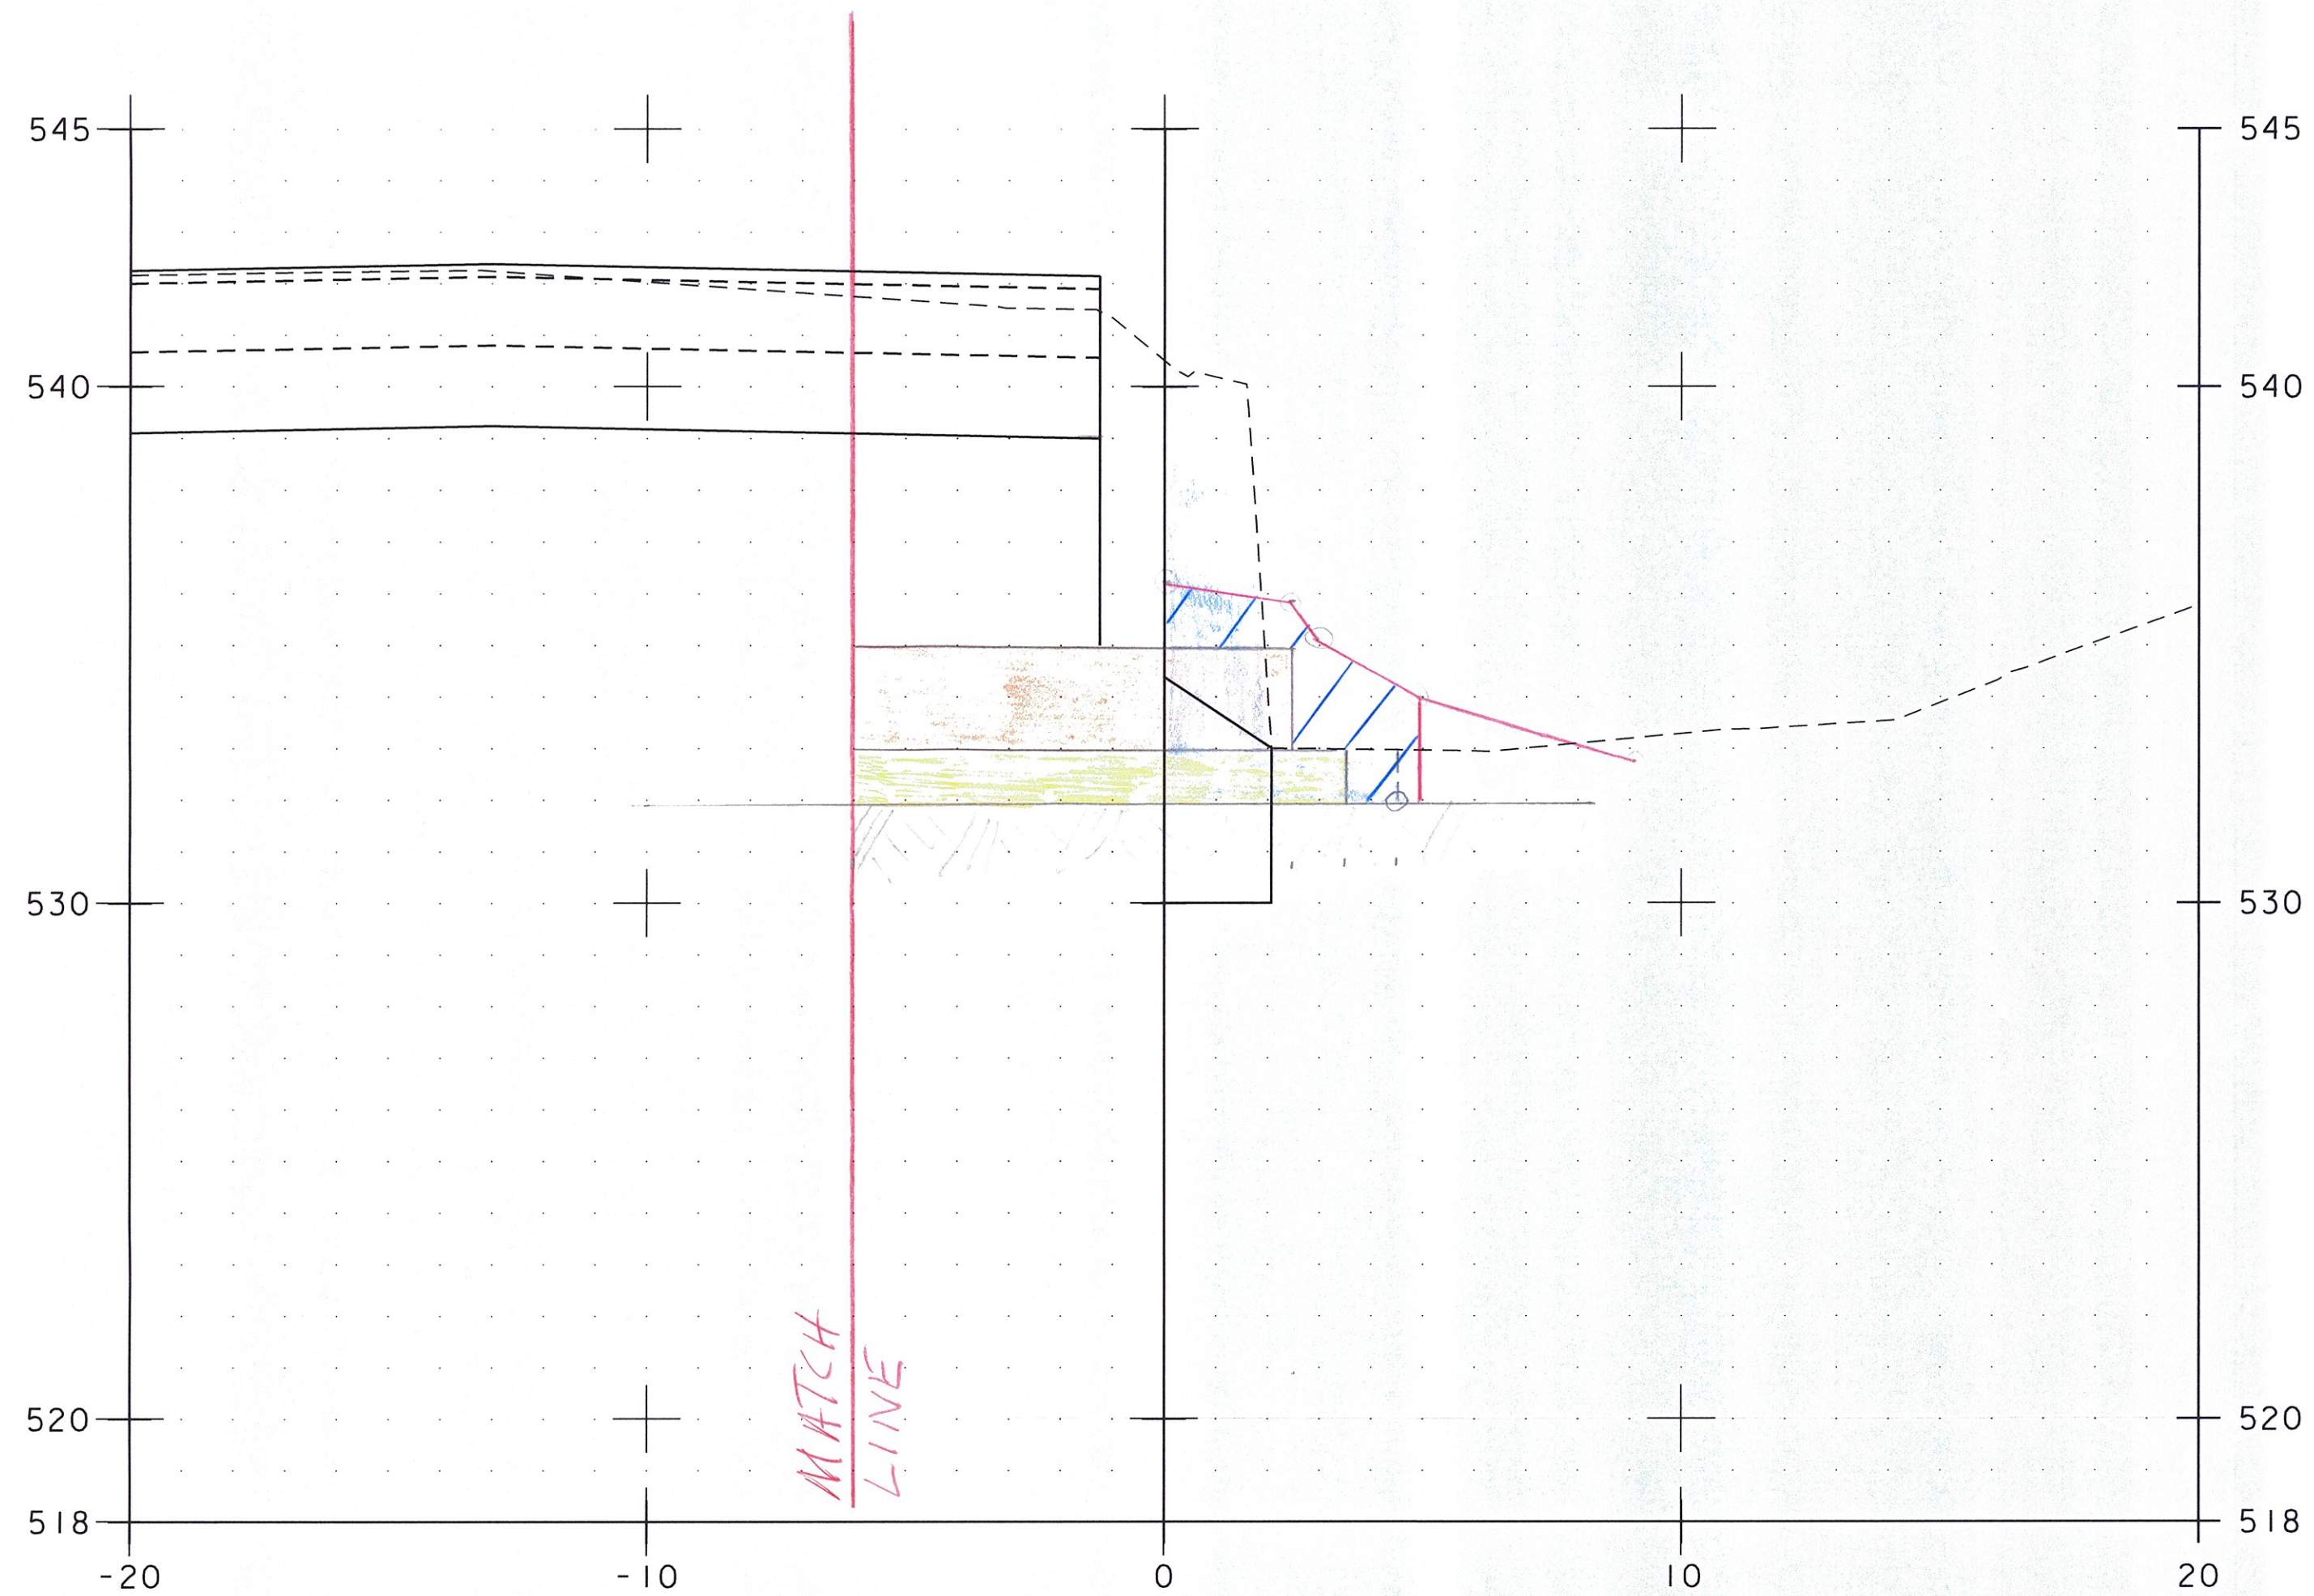

Cofferdam Earth
30+26.5 = 45.7 FT² ✓
Granular Backfill for Structure
30+26.5 = 20.0 FT² ✓
Unclassified Chemical Excavation
30+26.5 = 18.7 FT² ✓
Stone Fill, type II
30+26.5 = 8.5 FT² ✓
Green Under Stone Fill
30+26.5 = 10.0 FT² for 7' 2.5-1.5
for 2.5-1.5

30+26.50
Use final x-section 30+27

Cofferdam Earth
30+28.5 = 20.0 ✓
Granular Backfill for Structure
30+28.5 = 10.0 ✓
Unclassified Chemical Excavation
30+28.5 = 21.3 FT² ✓
Stone Fill, type II
30+28.5 = 10.0 FT² ✓
Green Under Stone Fill
30+28.5 = 13.5 ✓
for 2.5-1.5

30+28.50
Use final x-section 30+27

NOTE: PROPOSED GRADE IS NOT SHOWN.

PROJECT NAME: BRATTLEBORO	
PROJECT NUMBER: BRO 1442(35)	
FILE NAME: z10j062_customEL.dgn	PLOT DATE: 3/2/2015
PROJECT LEADER: S.E. BURBANK	DRAWN BY: E.F. LAWES
DESIGNED BY: E.F. LAWES	CHECKED BY: S.E. BURBANK
WINGWALL NO. 3 CROSS SECTIONS (6 OF 7)	SHEET 15 OF 28



SCALE 1" = 3'-0"