



598
27

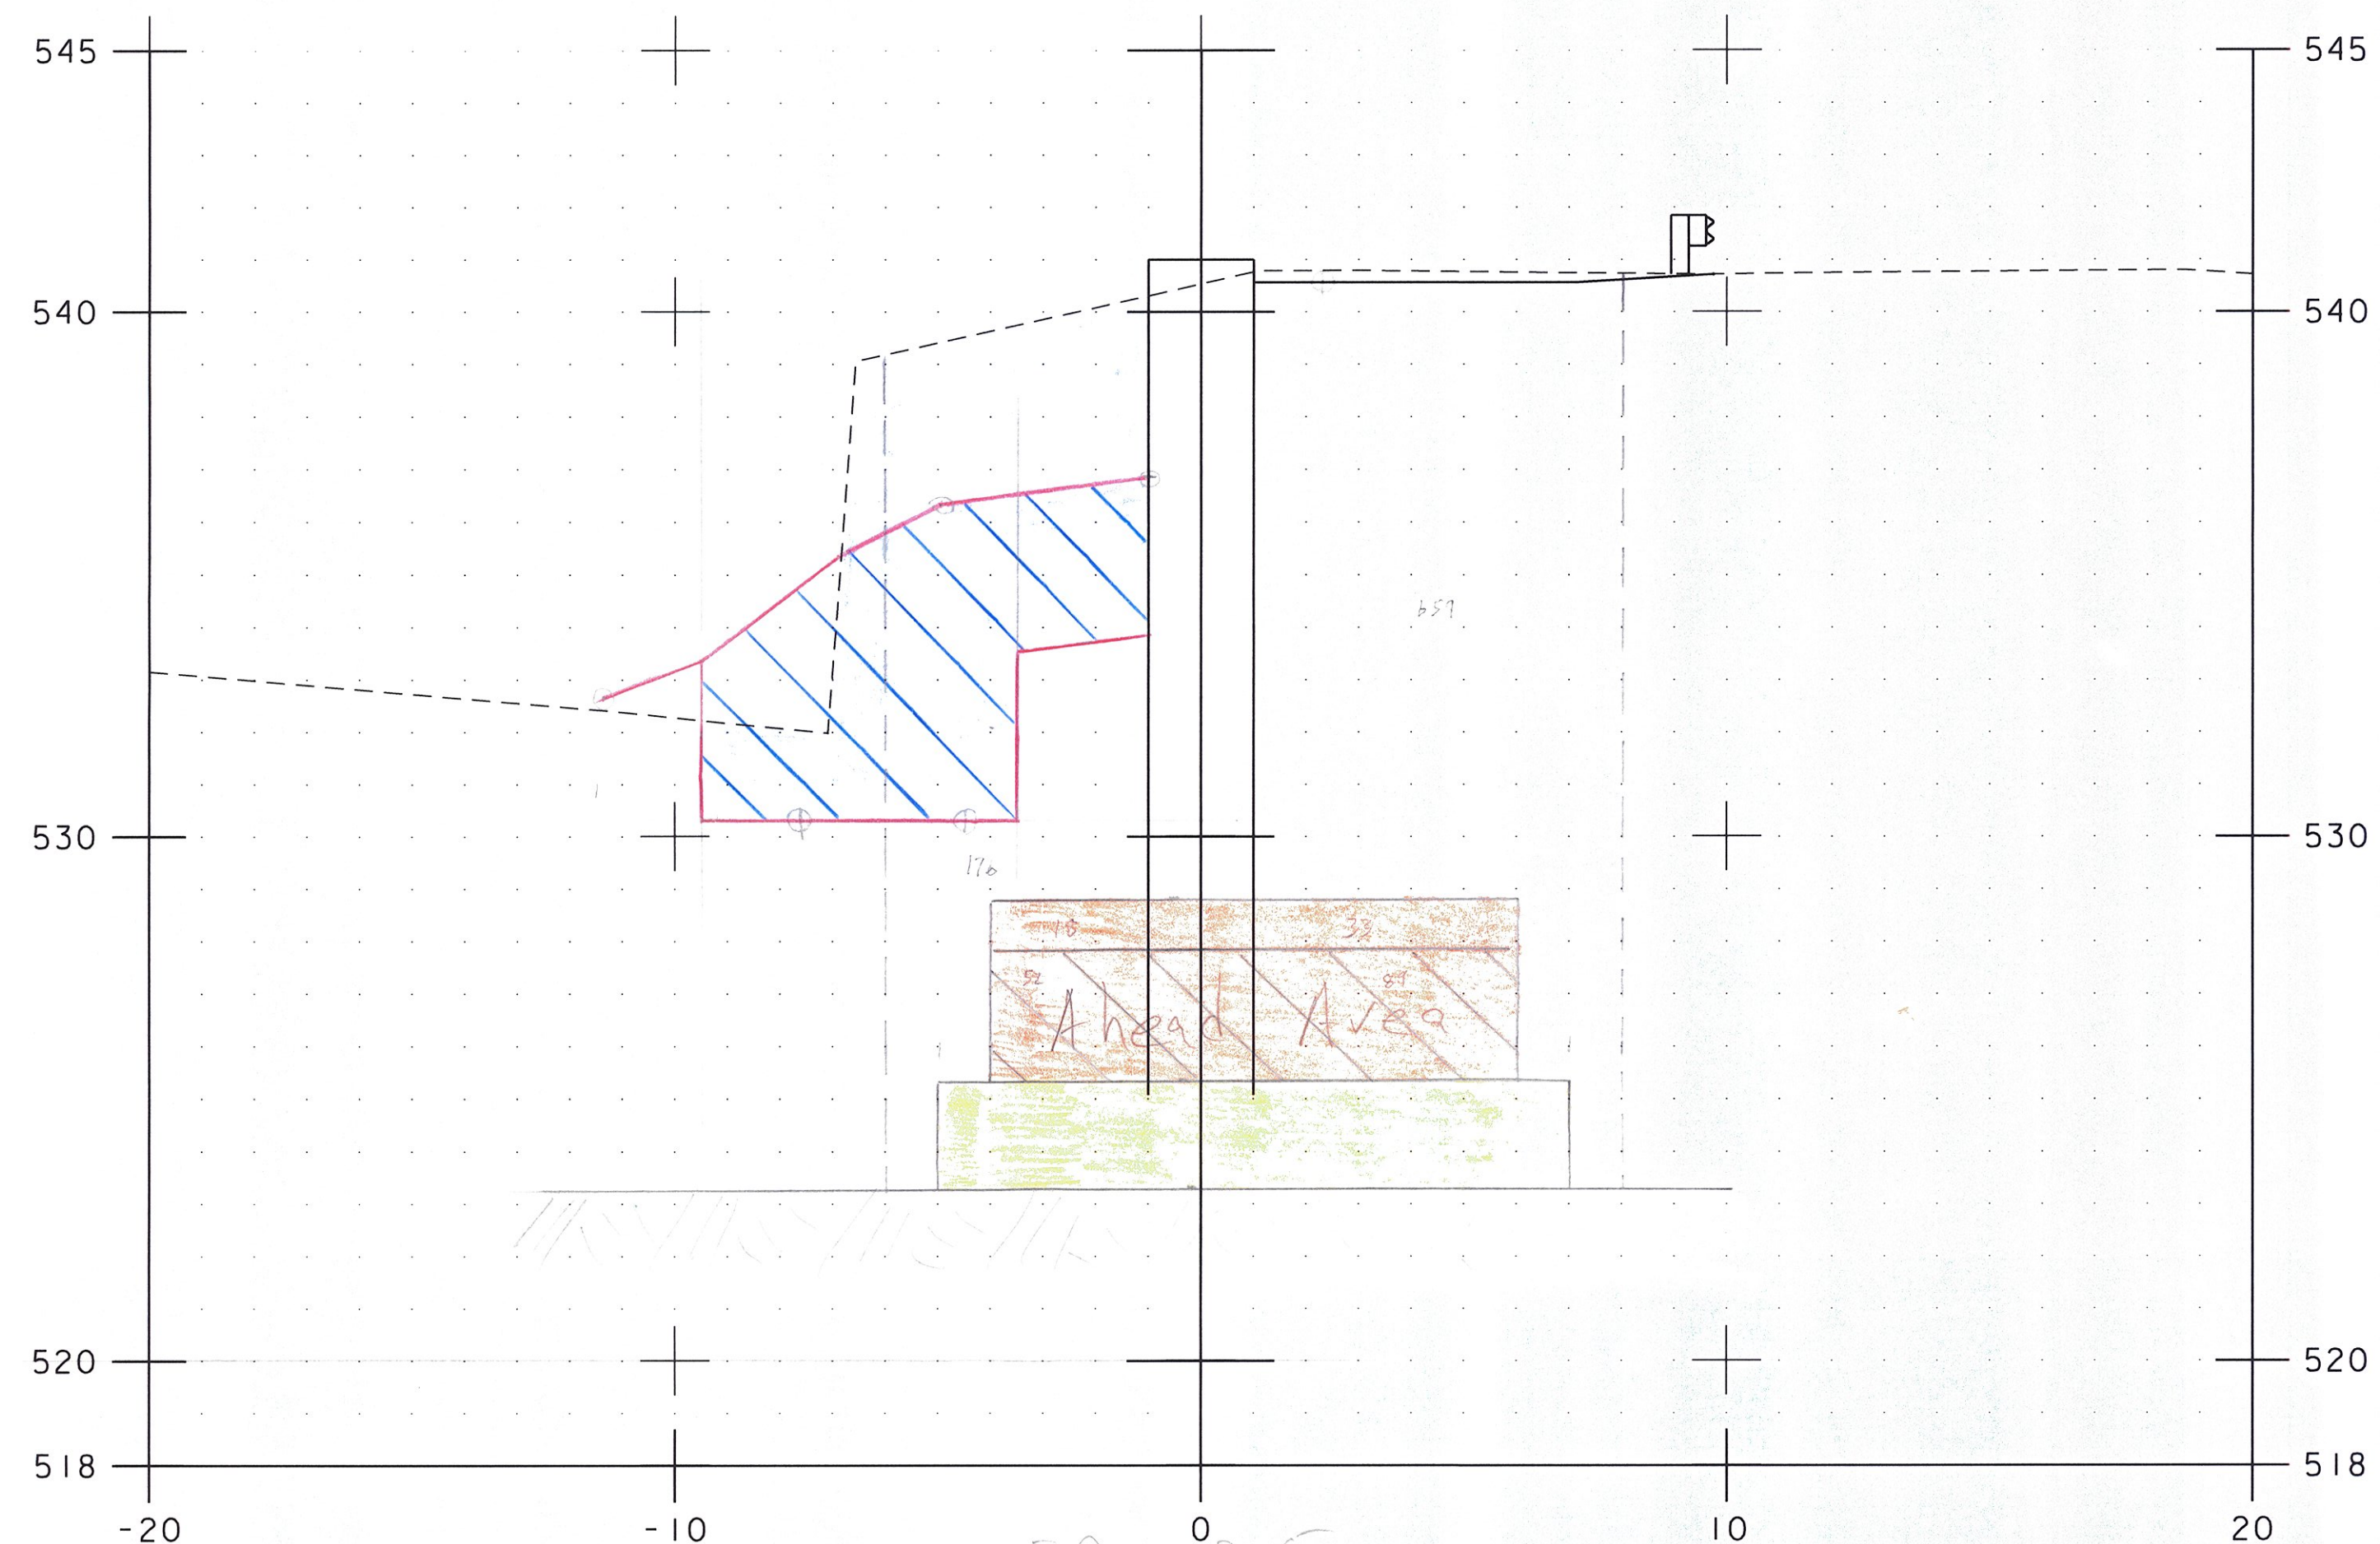

39+73.5
use section
39+75.00

Collar Road = 193.1 FT ✓
 116.3 FT ✓
 144.2 FT ✓
 123.4 FT ✓
 Stone Fill, Type II = 24.1 FT ✓
 Green Stone Spill Fill = 18 FT ✓
 Concrete Encasement = 1.6 FT ✓
 5/22/15

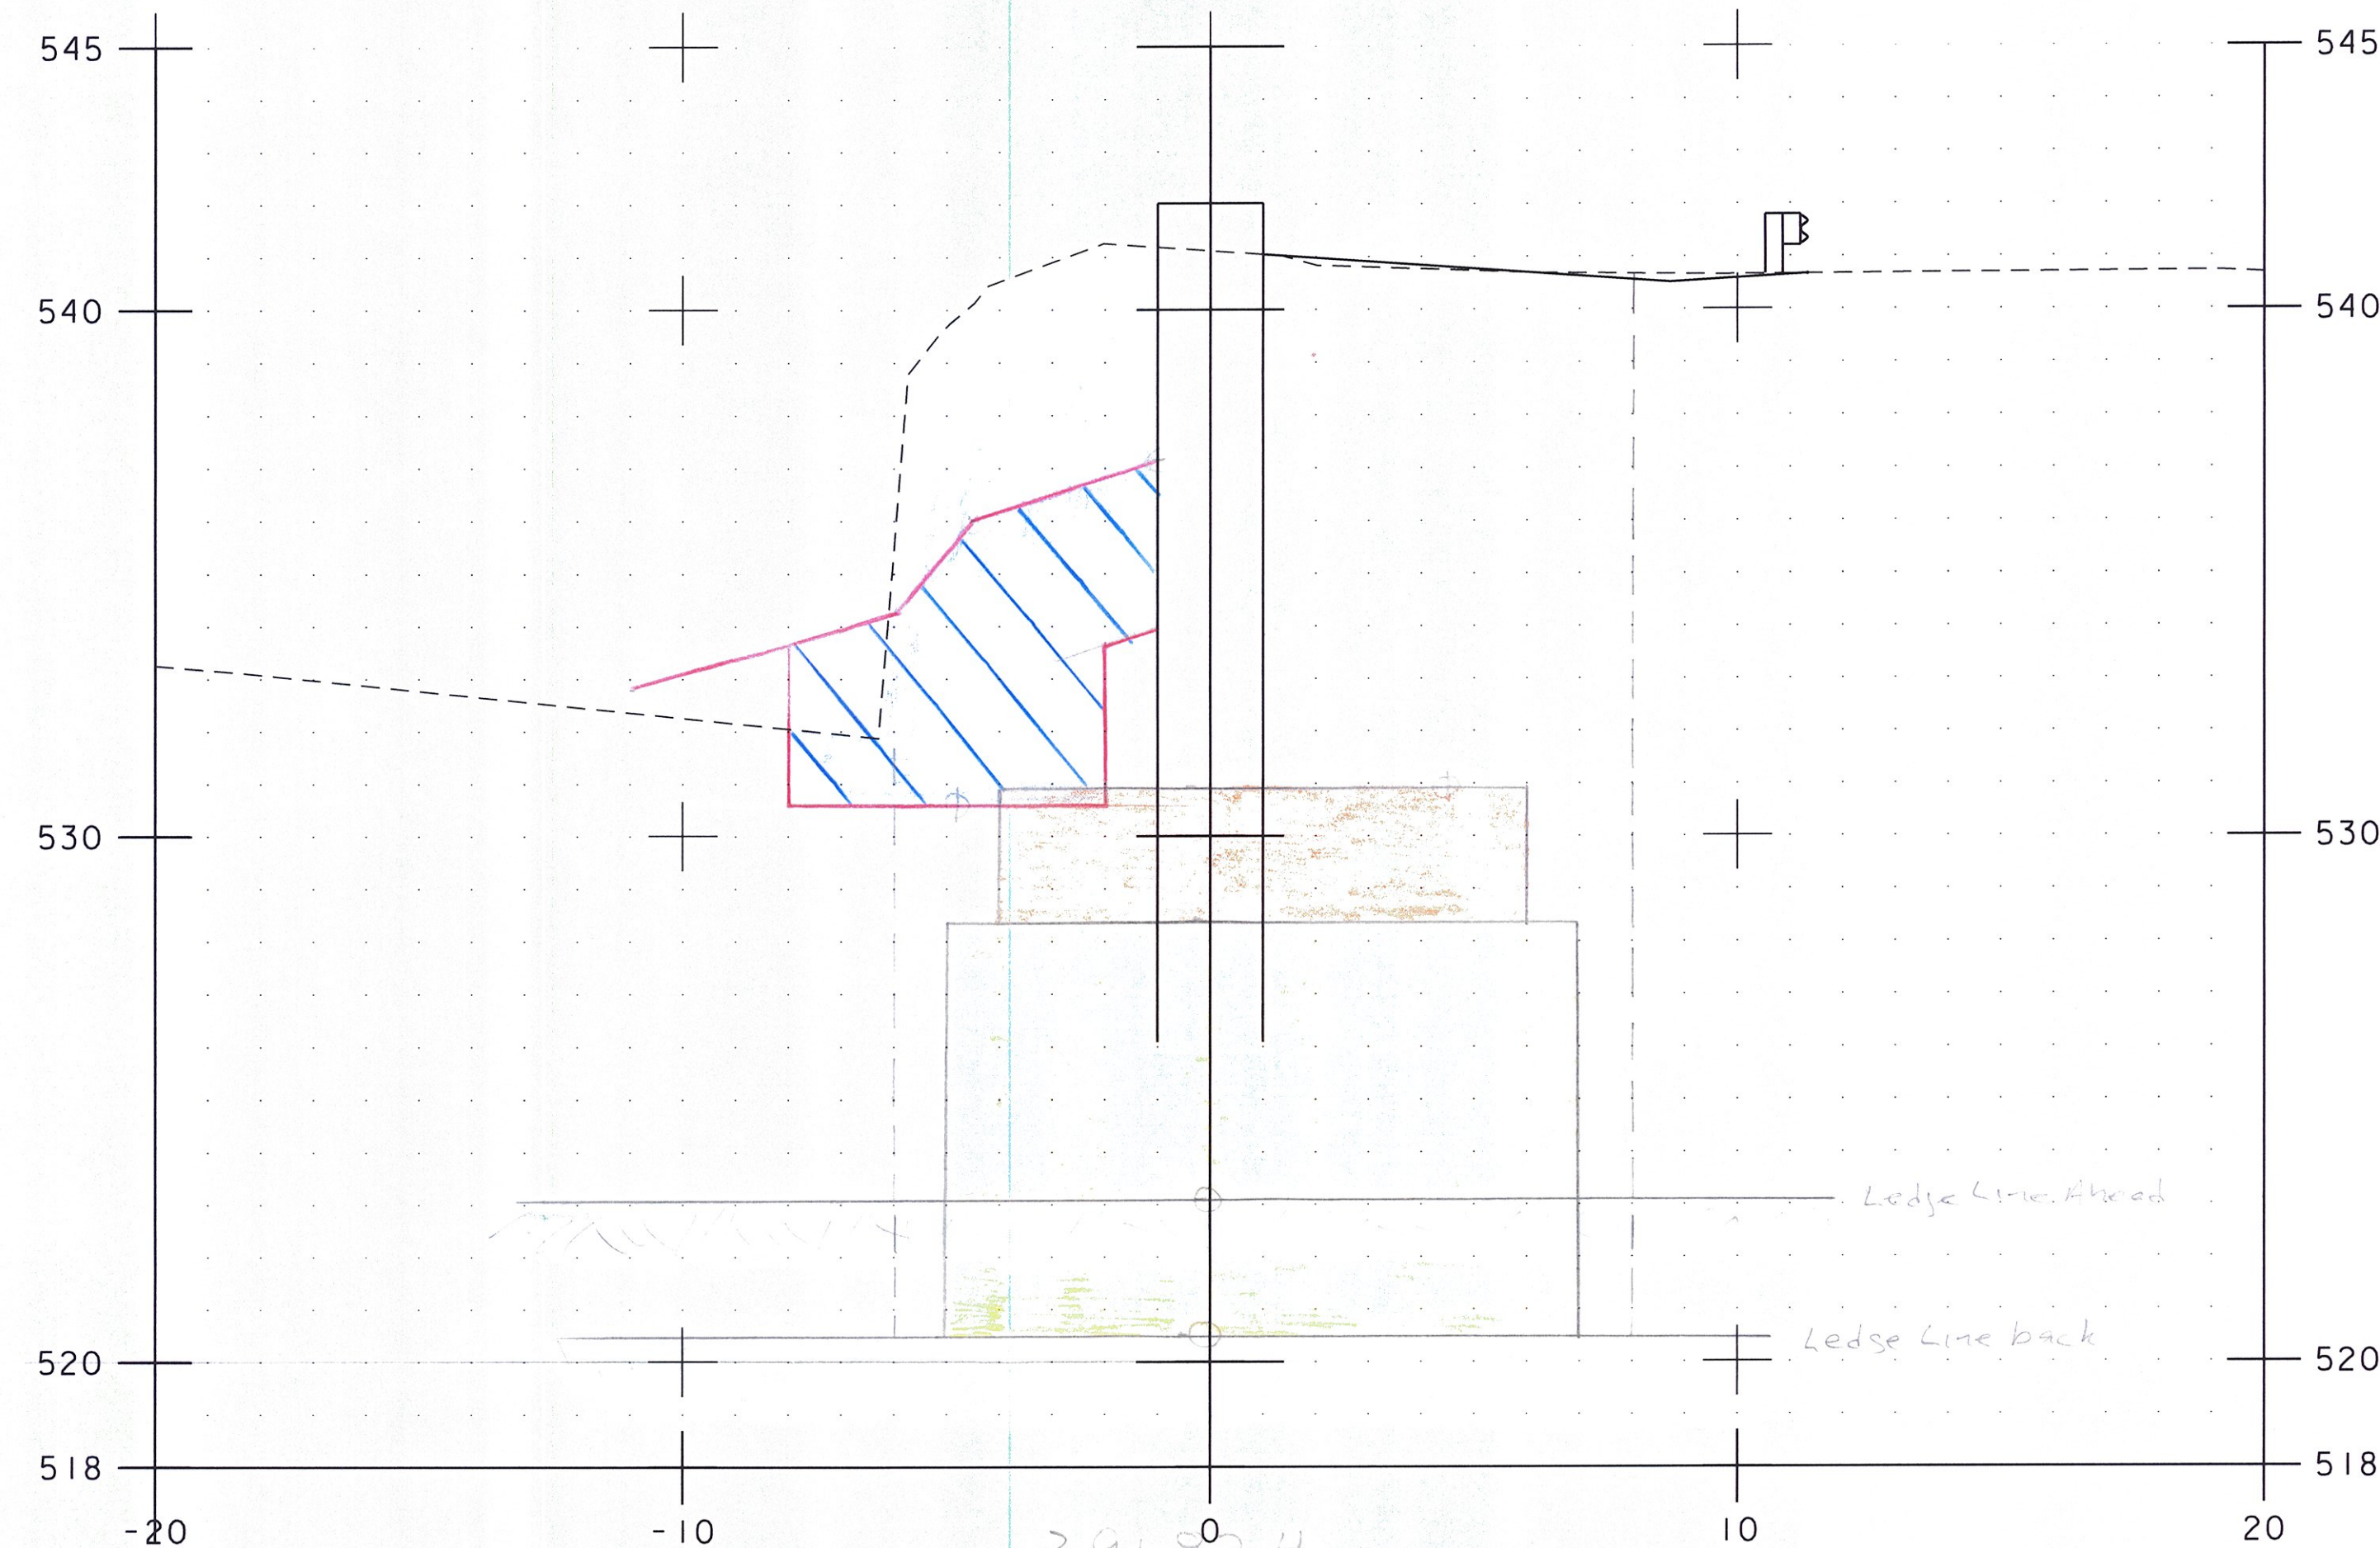

39+82.4
use section
39+80.00

Collar Road
 (BA) = 201.5 FT ✓
 (CA) = 100.1 FT ✓
 100.1 FT ✓
 92.9 FT ✓
 Stone Fill, Type II = 24.1 FT ✓
 Green Stone Spill Fill = 16.5 FT ✓
 Concrete Encasement = zero ✓

NOTE: LOCATION OF SUBBASE IS APPROXIMATE.

PROJECT NAME:	BRATTLEBORO
PROJECT NUMBER:	BRO 1442(35)
FILE NAME:	z10j062_customEL.dgn
PROJECT LEADER:	S.E. BURBANK
DESIGNED BY:	E.F. LAWES
ABUTMENT NO. / CROSS SECTIONS (3 OF 7)	SHEET 19 OF 28
PLOT DATE:	3/2/2015
DRAWN BY:	E.F. LAWES
CHECKED BY:	S.E. BURBANK



SCALE 1" = 3'-0"