


Cofferdam Earth = 539 FT² ✓
 Greater Backfill for Spillway = 19.57 ✓
 Unexcavated Channel Exc = 404 FT² ✓
 Stone Fill, Type III = 114 FT² ✓
 Clean Under Stone Fill = 15" M.W.H. 6/26/15
 Jmc 5/15/15

19+85.50

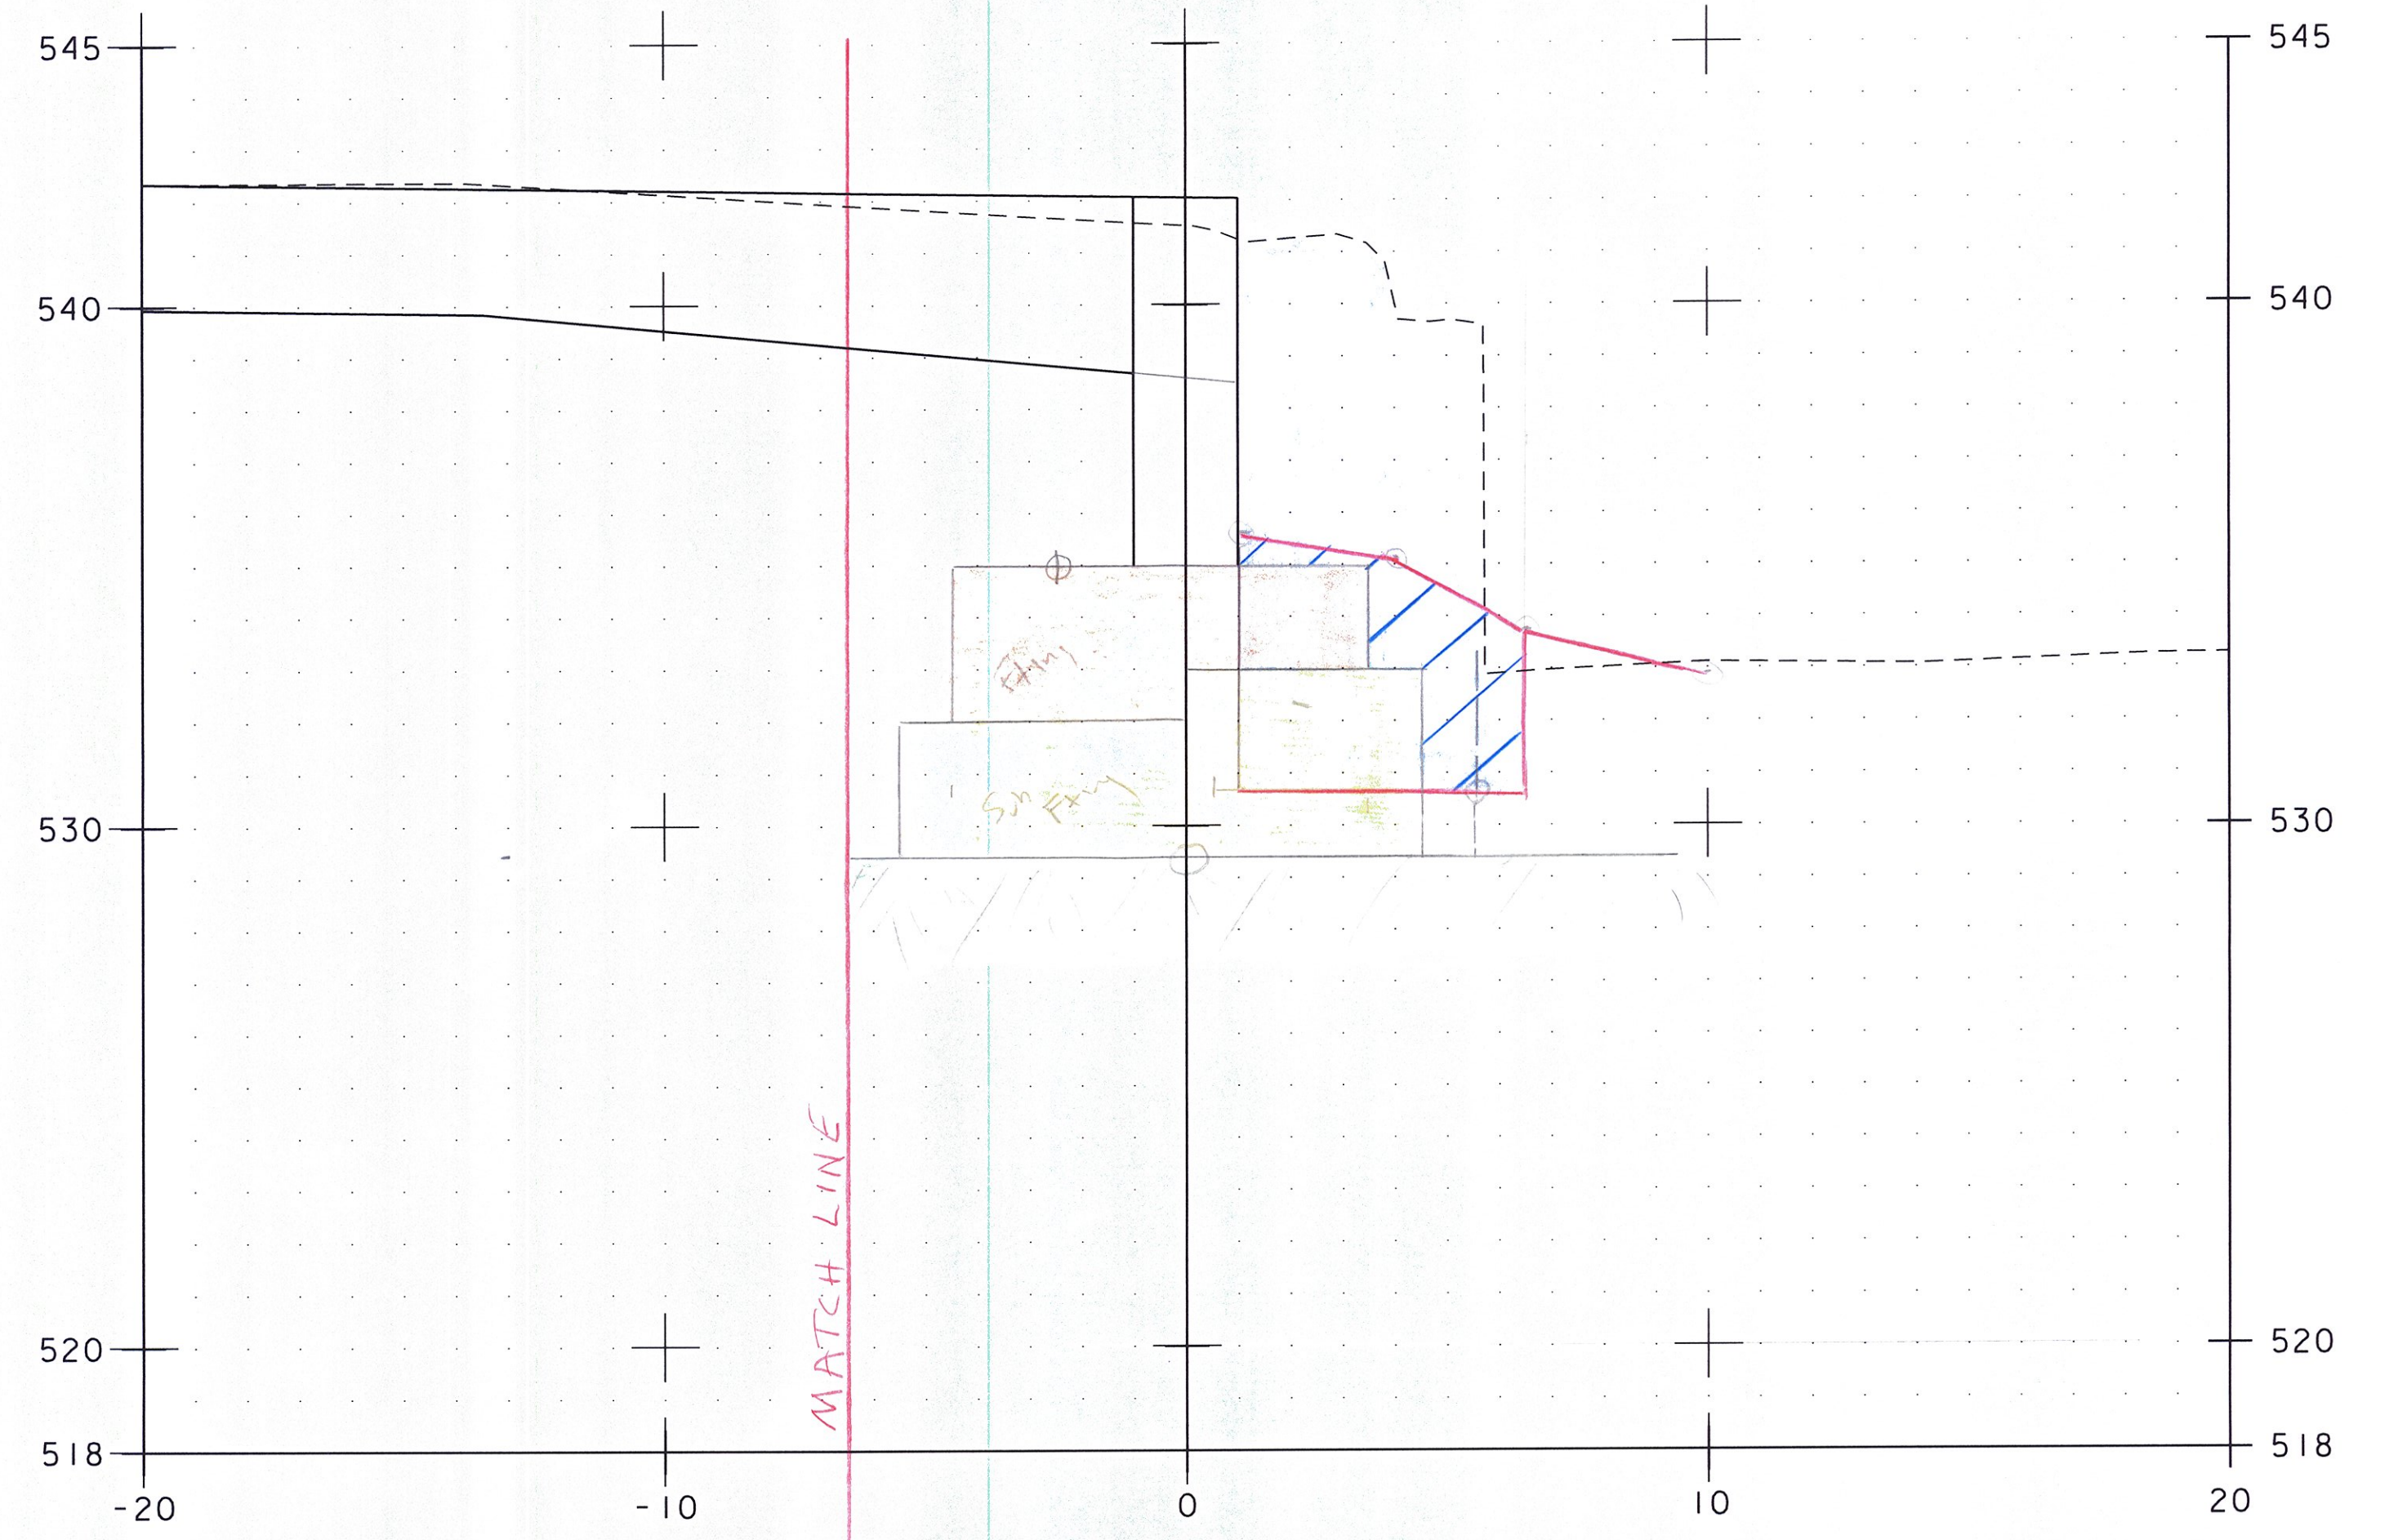

Cofferdam Earth = 763 FT² ✓
 Greater Backfill for Spillway = 29.3 FT² ✓
 M/U Unexcavated Channel Exc = 404 FT² ✓
 Stone Fill, Type III = 101 FT² ✓
 Clean Under Stone Fill = 13.5" M.W.H. 6/26/15
 Jmc 5/15/15

19+86.50

NOTE: LOCATION OF SUBBASE IS APPROXIMATE, PROPOSED GRADE IS NOT SHOWN.

PROJECT NAME:	BRATTLEBORO
PROJECT NUMBER:	BRO 1442(35)
FILE NAME:	z10j062_customEL.dgn
PROJECT LEADER:	S.E. BURBANK
DESIGNED BY:	E.F. LAWES
ABUTMENT NO. 2 CROSS SECTIONS (2 OF 9)	SHEET 2 OF 28
PLOT DATE:	3/2/2015
DRAWN BY:	E.F. LAWES
CHECKED BY:	S.E. BURBANK

SCALE 1" = 3'-0"

