


39+86.4  
 use Section  
**39+85.00**  
 Cofferdam Earth = 173.5 FT ✓  
 Granddike Subbase = 12.2 FT ✓  
 Granddike Subbase = 45.4 FT ✓  
 Subbase = 25.9 FT ✓  
 Granddike Subbase = 14.5 FT ✓  
 finished

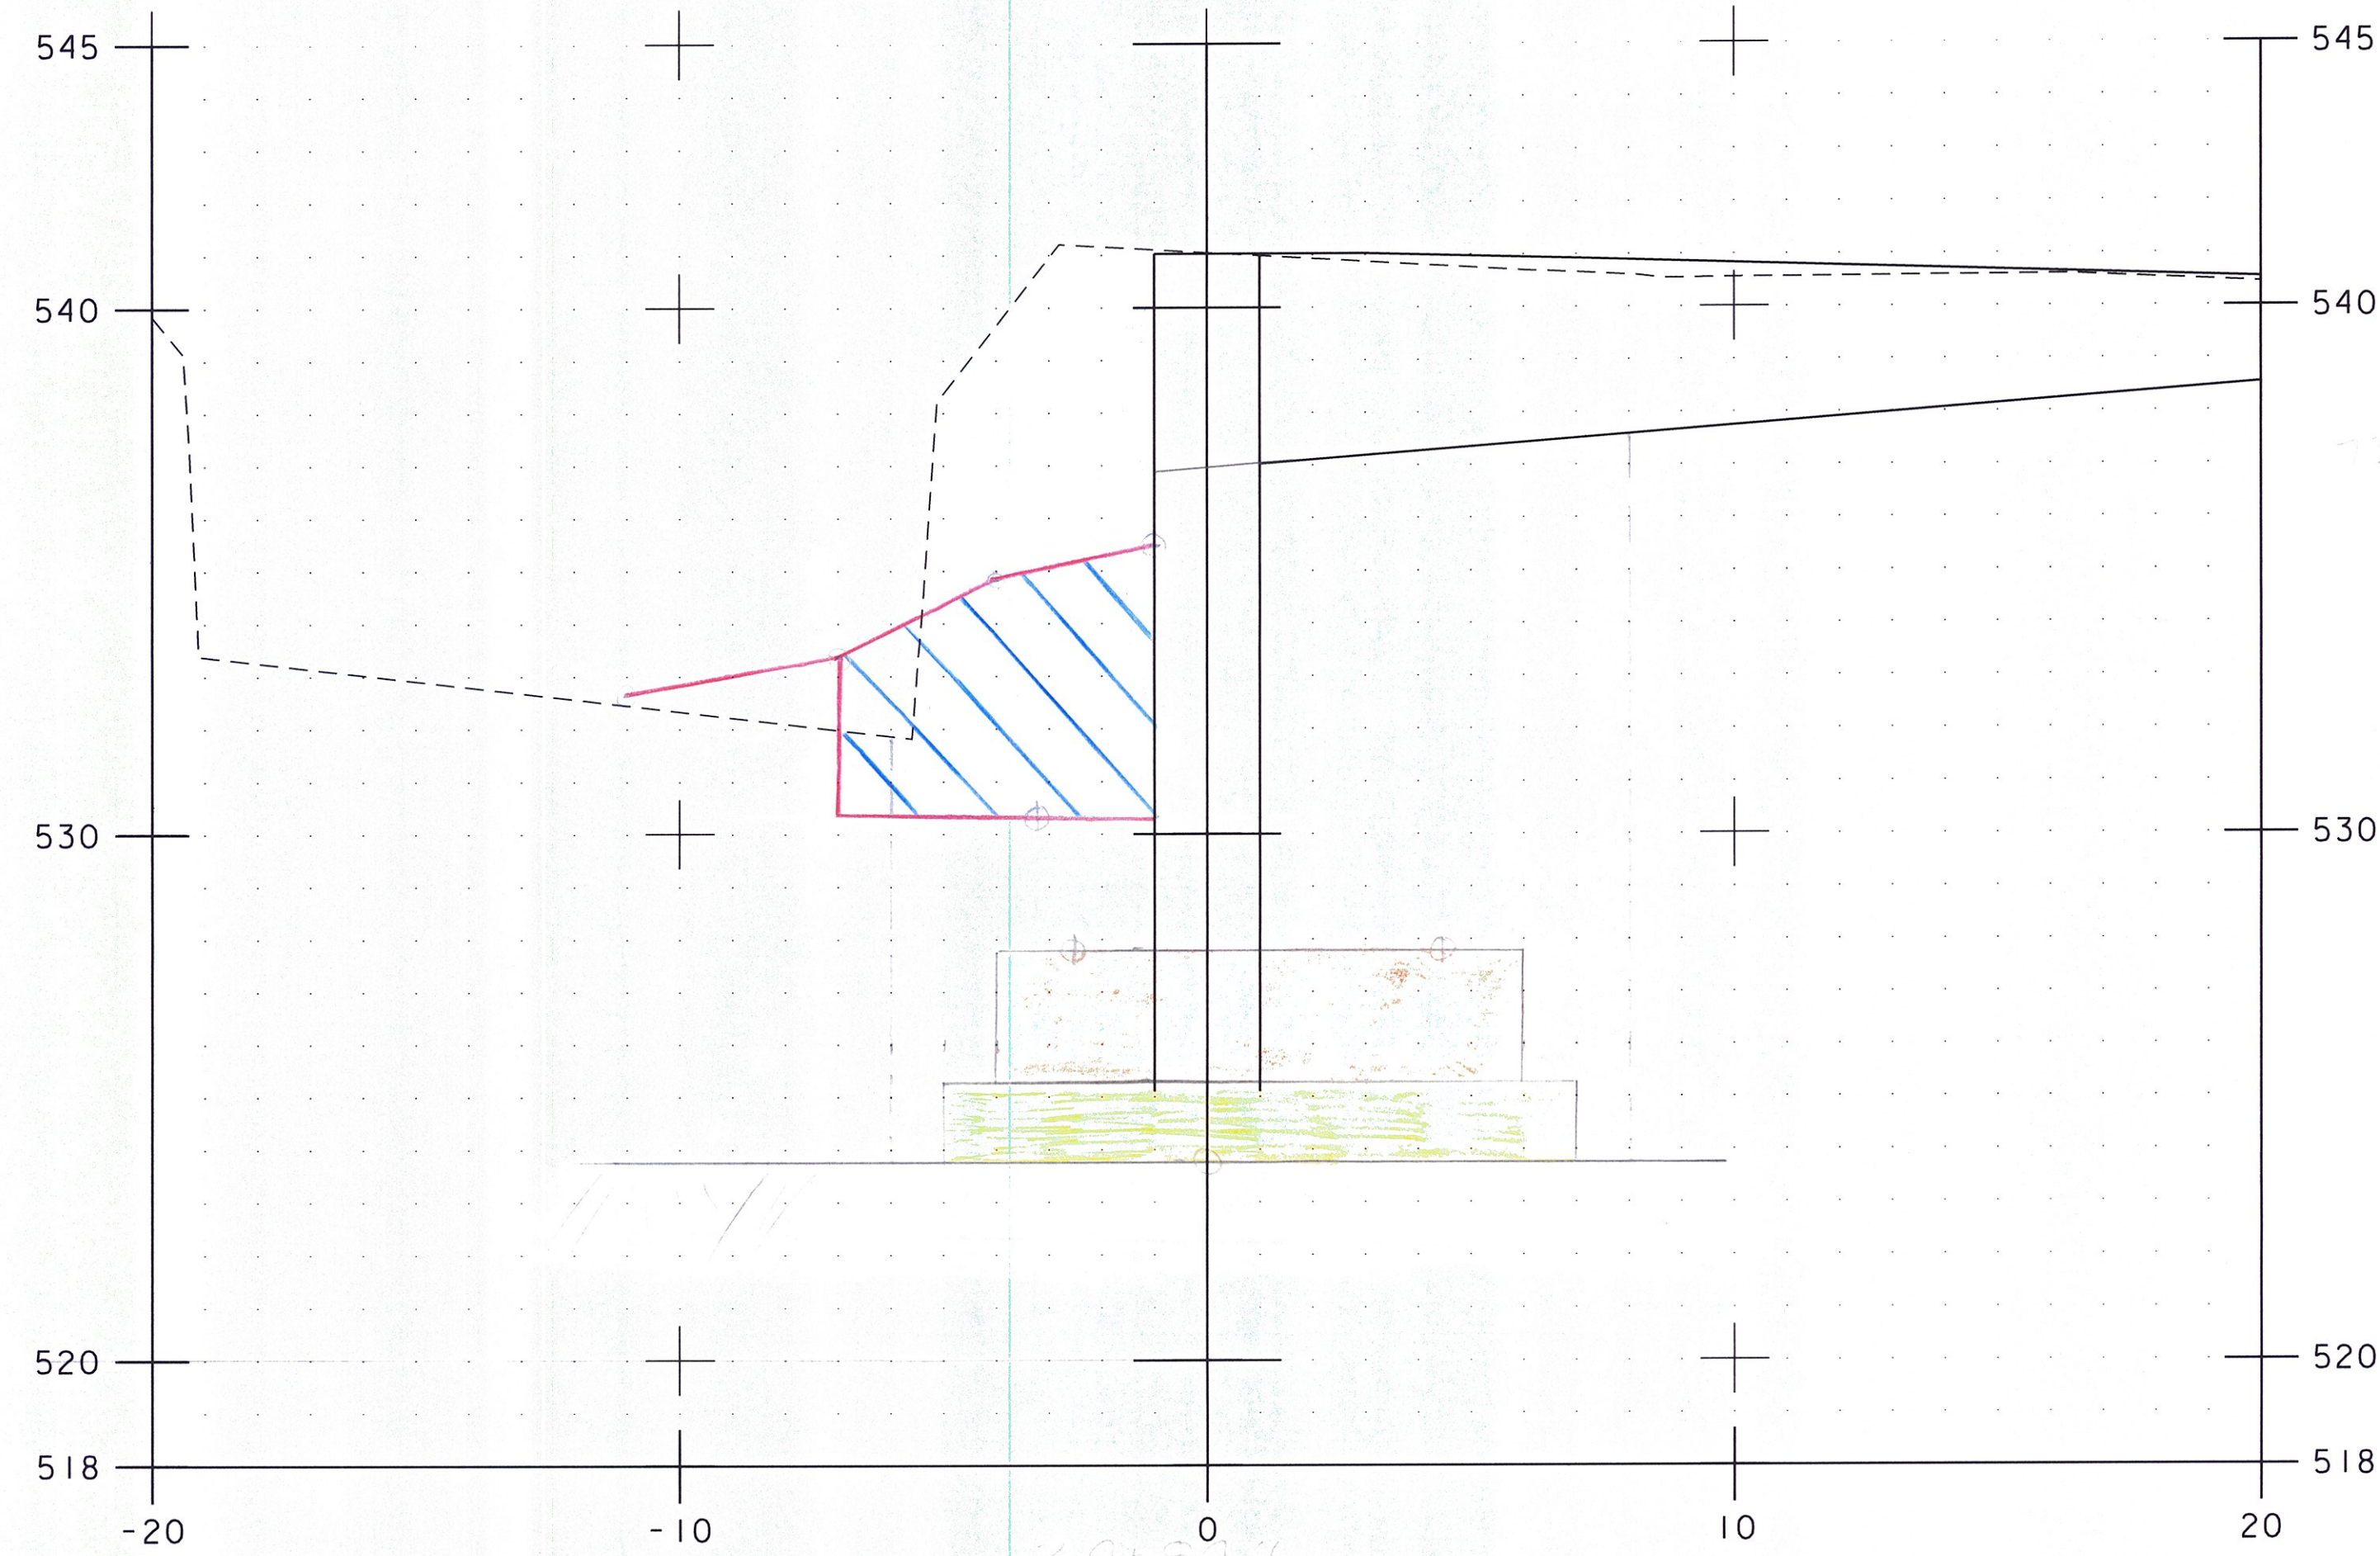

39+90.4  
 use Section  
**39+90.00**  
 Cofferdam Earth = 15.2 FT ✓  
 Granddike Subbase = 12.2 FT ✓  
 Granddike Subbase = 45.4 FT ✓  
 Subbase = 25.9 FT ✓  
 Granddike Subbase = 14.5 FT ✓  
 finished

SCALE 1" = 3'-0"

NOTE: LOCATION OF SUBBASE IS APPROXIMATE.



PROJECT NAME: BRATTLEBORO	PLOT DATE: 3/2/2015
PROJECT NUMBER: BRO 1442(35)	DRAWN BY: E.F. LAWES
FILE NAME: z10j062_customEL.dgn	CHECKED BY: S.E. BURBANK
PROJECT LEADER: S.E. BURBANK	SHEET 20 OF 28
DESIGNED BY: E.F. LAWES	
ABUTMENT NO. 1 CROSS SECTIONS (4 OF 7)	