



715

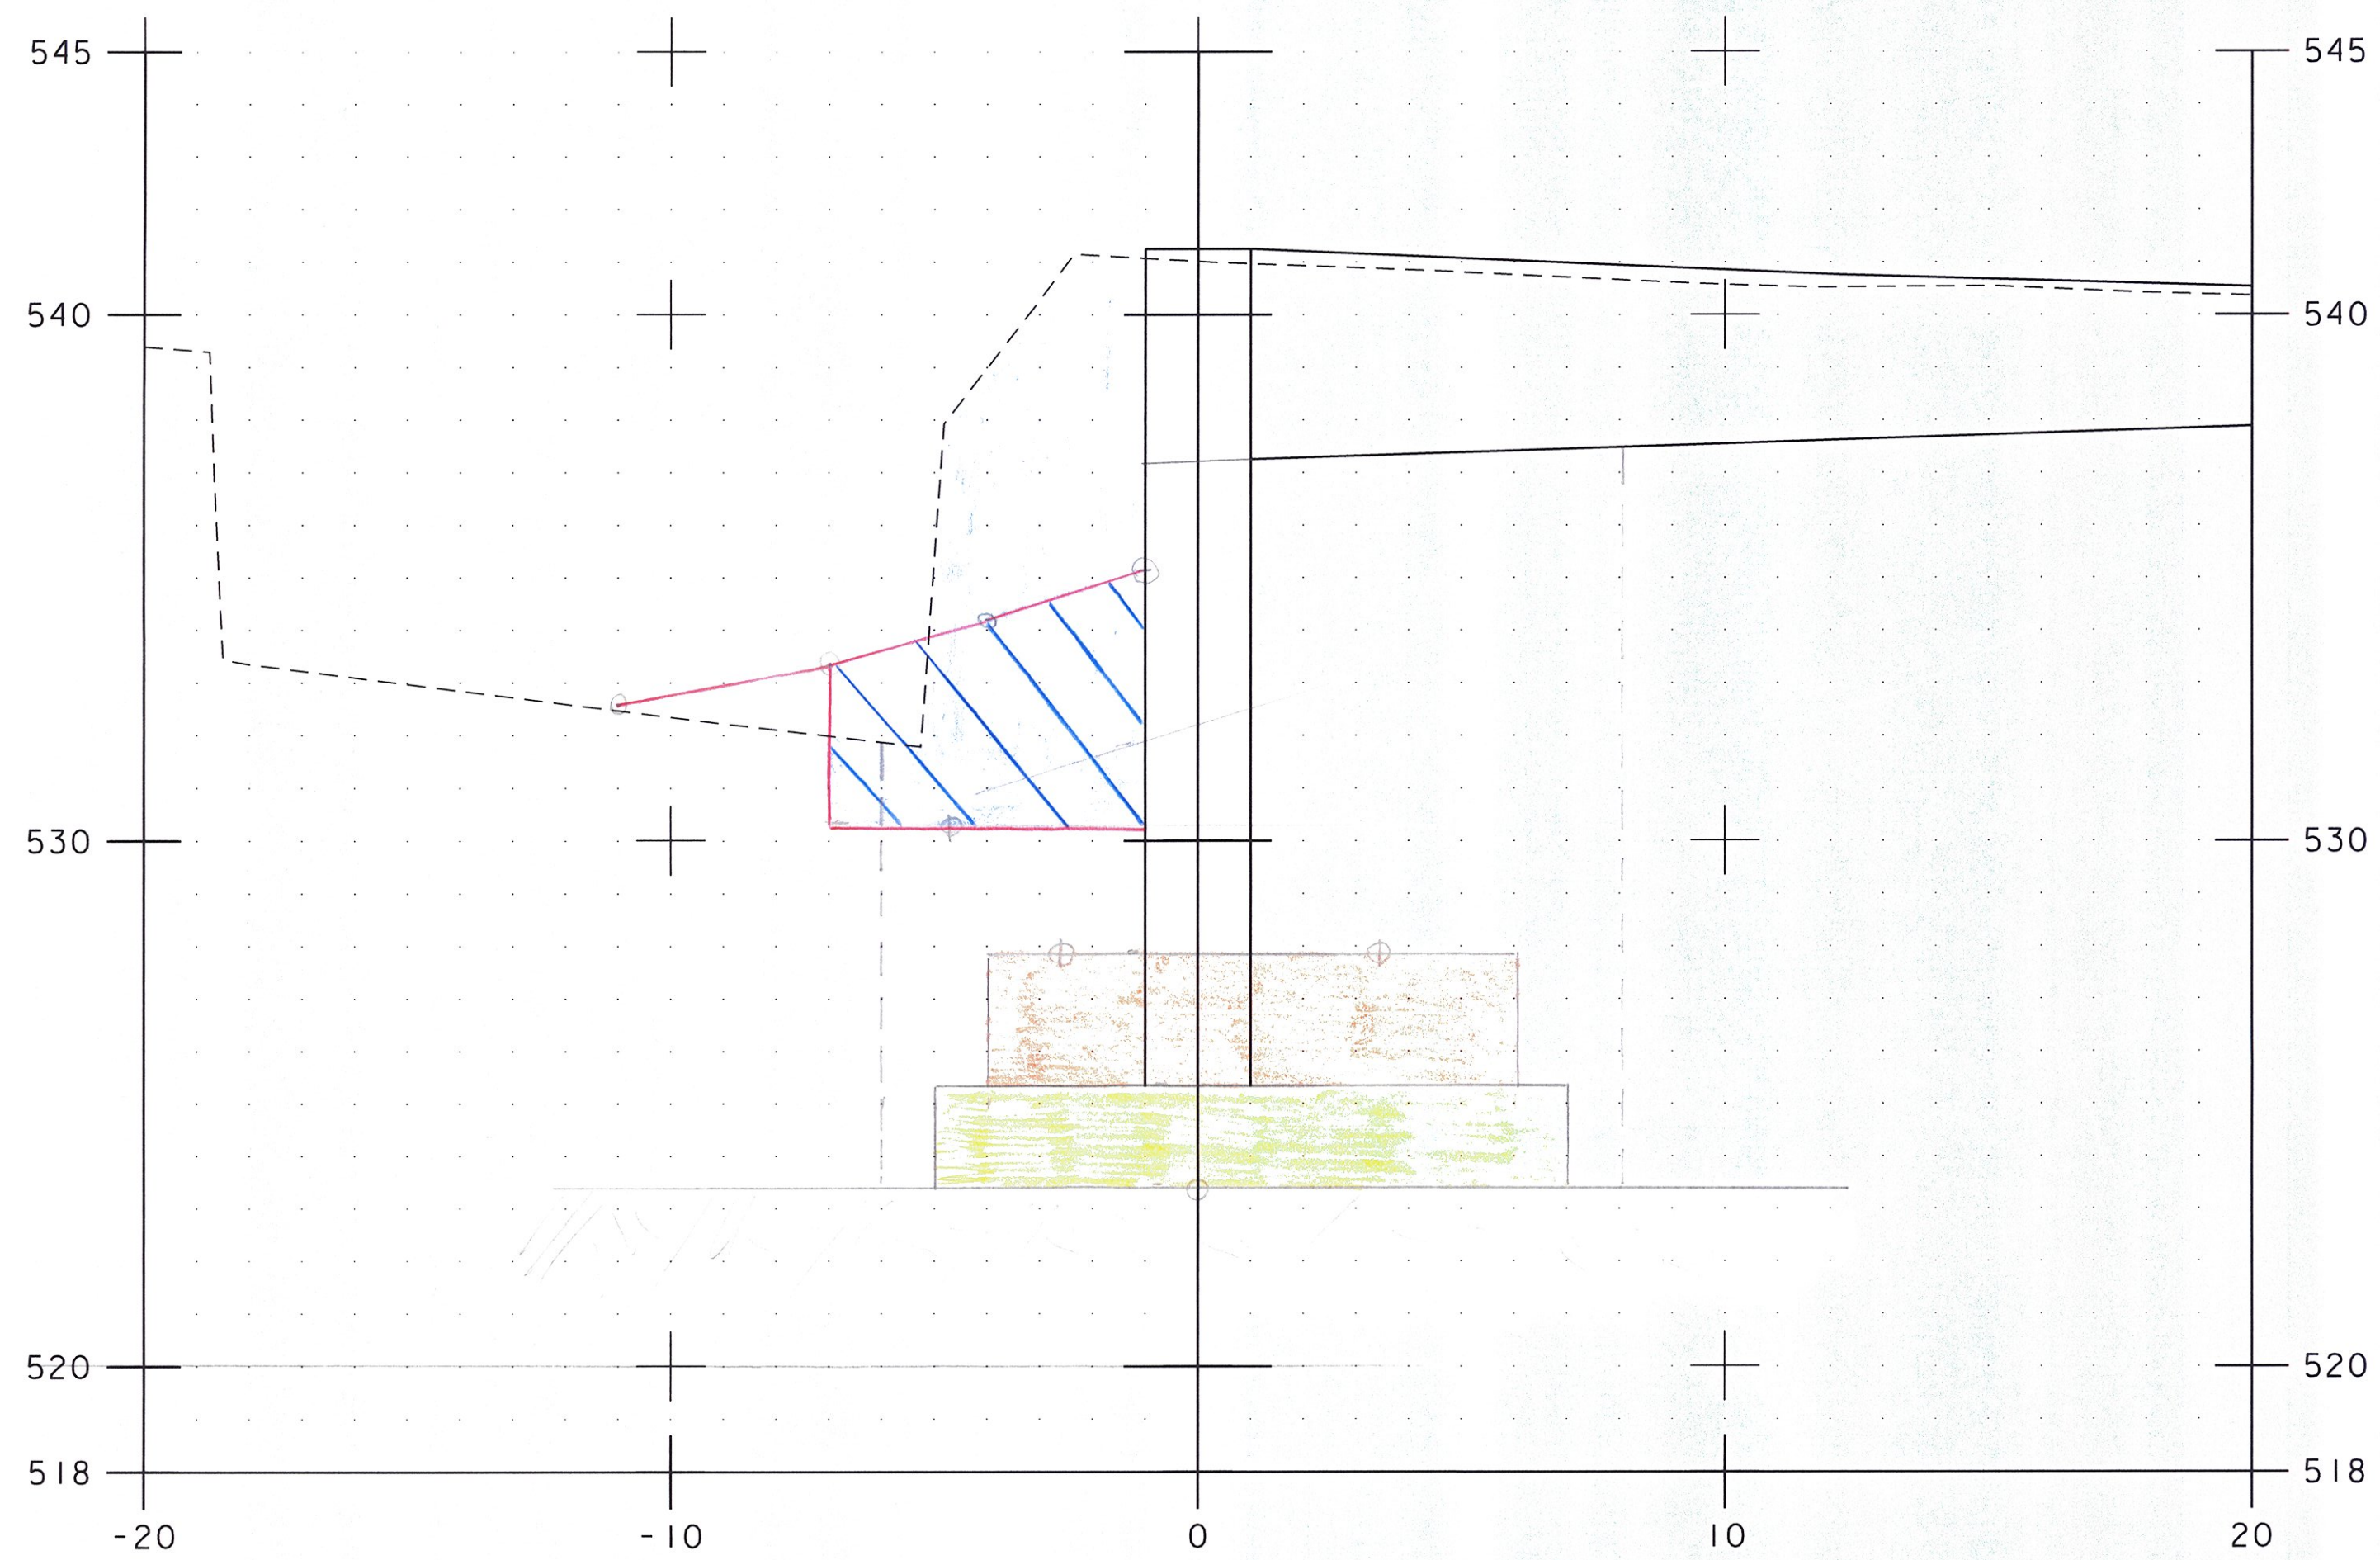

Confirmed Earth = 158.5 FT ✓
 Granular Base for Structure = 9.5 FT ✓
 Unimproved Road Shoulder = 4.3 FT ✓
 Stone Fill, Type II = 0.2 FT ✓
 Granular Stone Fill = 1 FT ✓
 for 5/3/15

39+95.00

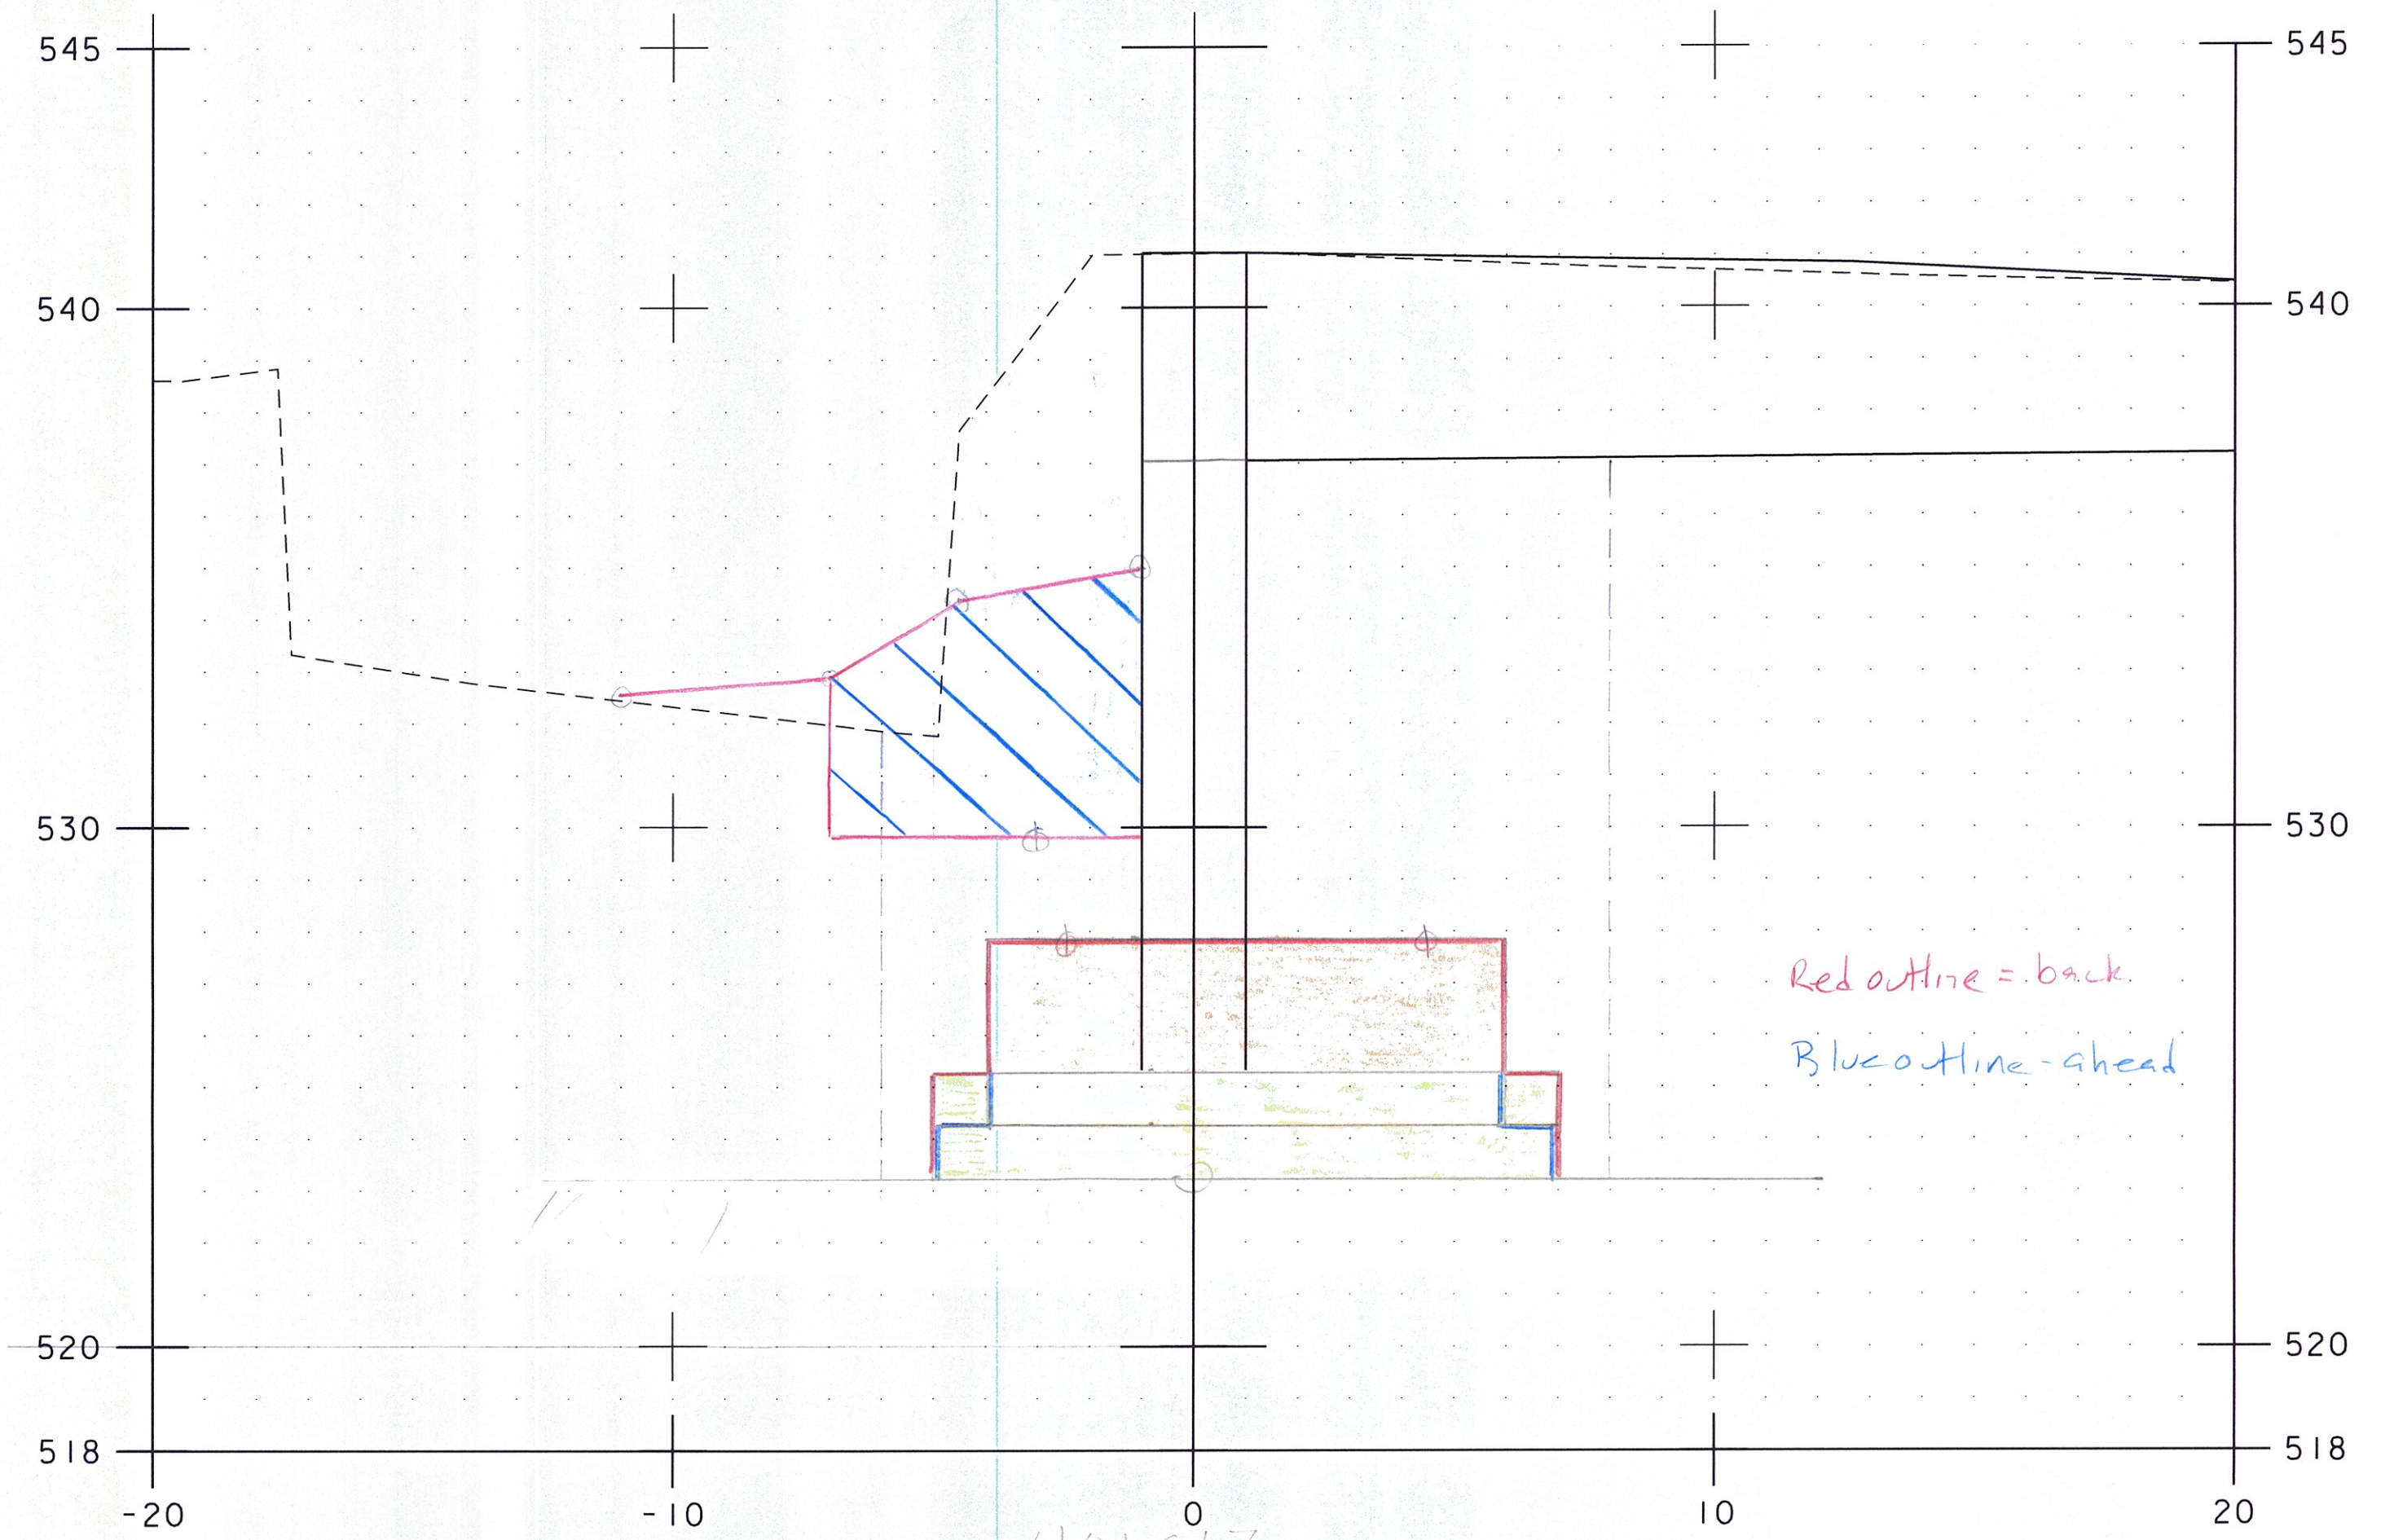

Confirmed Earth = 155.4 FT ✓
 Granular Base for Structure
 (B) = 5 FT ✓
 (A) = 2 FT ✓
 Unimproved Road Shoulder = 4.3 FT ✓
 Stone Fill = 0.2 FT ✓
 Granular Stone Fill = 1 FT ✓
 for 5/3/15

40+00.00

Red outline = back
 Blue outline = ahead

NOTE: LOCATION OF SUBBASE IS APPROXIMATE.

PROJECT NAME: BRATTLEBORO	
PROJECT NUMBER: BRO 1442(35)	
FILE NAME: z10j062_customEL.dgn	PLOT DATE: 3/2/2015
PROJECT LEADER: S.E. BURBANK	DRAWN BY: E.F. LAWES
DESIGNED BY: E.F. LAWES	CHECKED BY: S.E. BURBANK
ABUTMENT NO. 1 CROSS SECTIONS (5 OF 7)	SHEET 21 OF 28



SCALE 1" = 3'-0"