


Cofferdam Earth = 185.7 FF² ✓
 Granular Backfill for Structures = 105.7 FF² ✓
 Unclassified Channel Exc = 25.9 FF² ✓
 Stone Fill, type III = 23.9 FF² ✓
 Geo. Under Stone Fill = 13.5' ✓
 520.7
 520.5
 40+13.6
 Use section
 40+14.40

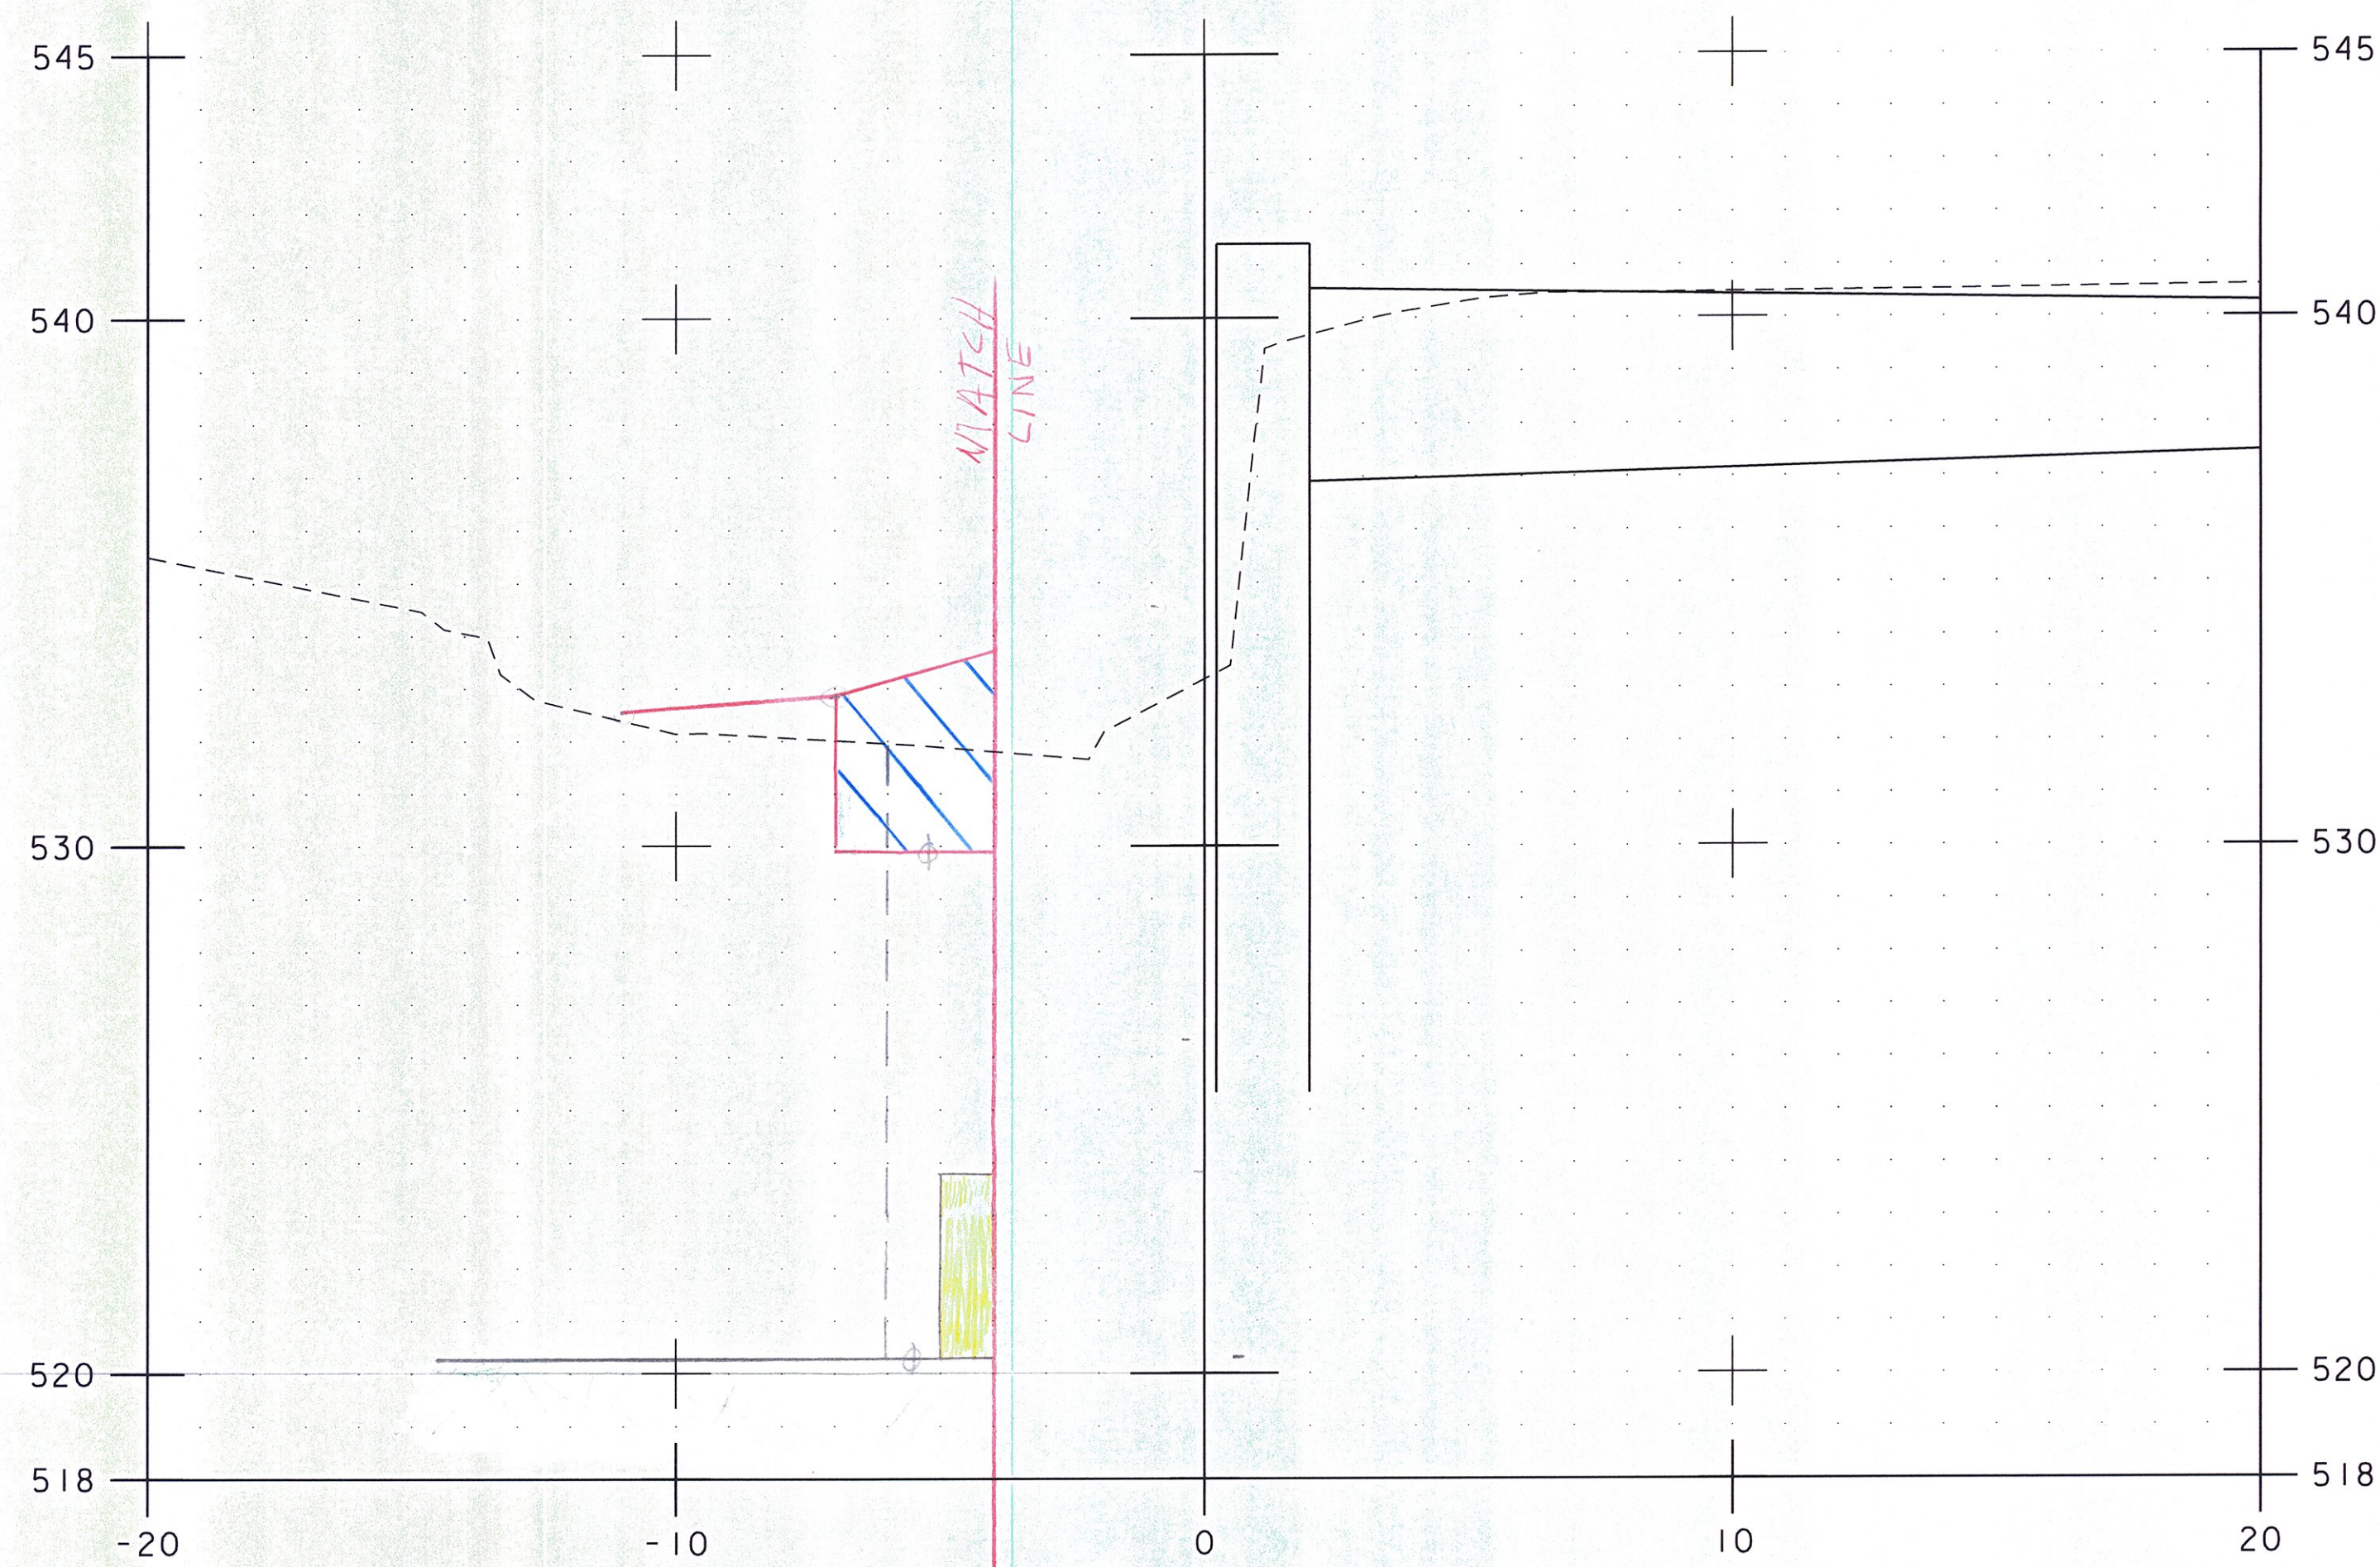

Cofferdam Earth = 19.0 FF² ✓
 Granular Backfill for Structures = 15.4 FF² ✓
 Unclassified Channel Exc = 5.0 FF² ✓
 Stone Fill, type III = 10.2 FF² ✓
 Geo. Under Stone Fill = 6' ✓
 520.3
 520.3
 40+18.60

40+19.4 = Zero Cofferdam Exc & G.B.F. ✓
 40+20 = Zero D.C. Exc = S.F. & G.D.S.F. ✓

NOTE: LOCATION OF SUBBASE IS APPROXIMATE.

PROJECT NAME:	BRATTLEBORO
PROJECT NUMBER:	BRO 1442(35)
FILE NAME:	z10j062_customEL.dgn
PROJECT LEADER:	S.E. BURBANK
DESIGNED BY:	E.F. LAWES
ABUTMENT NO. / CROSS SECTIONS (7 OF 7)	SHEET 23 OF 28
PLOT DATE:	3/2/2015
DRAWN BY:	E.F. LAWES
CHECKED BY:	S.E. BURBANK

SCALE 1" = 3'-0"

