
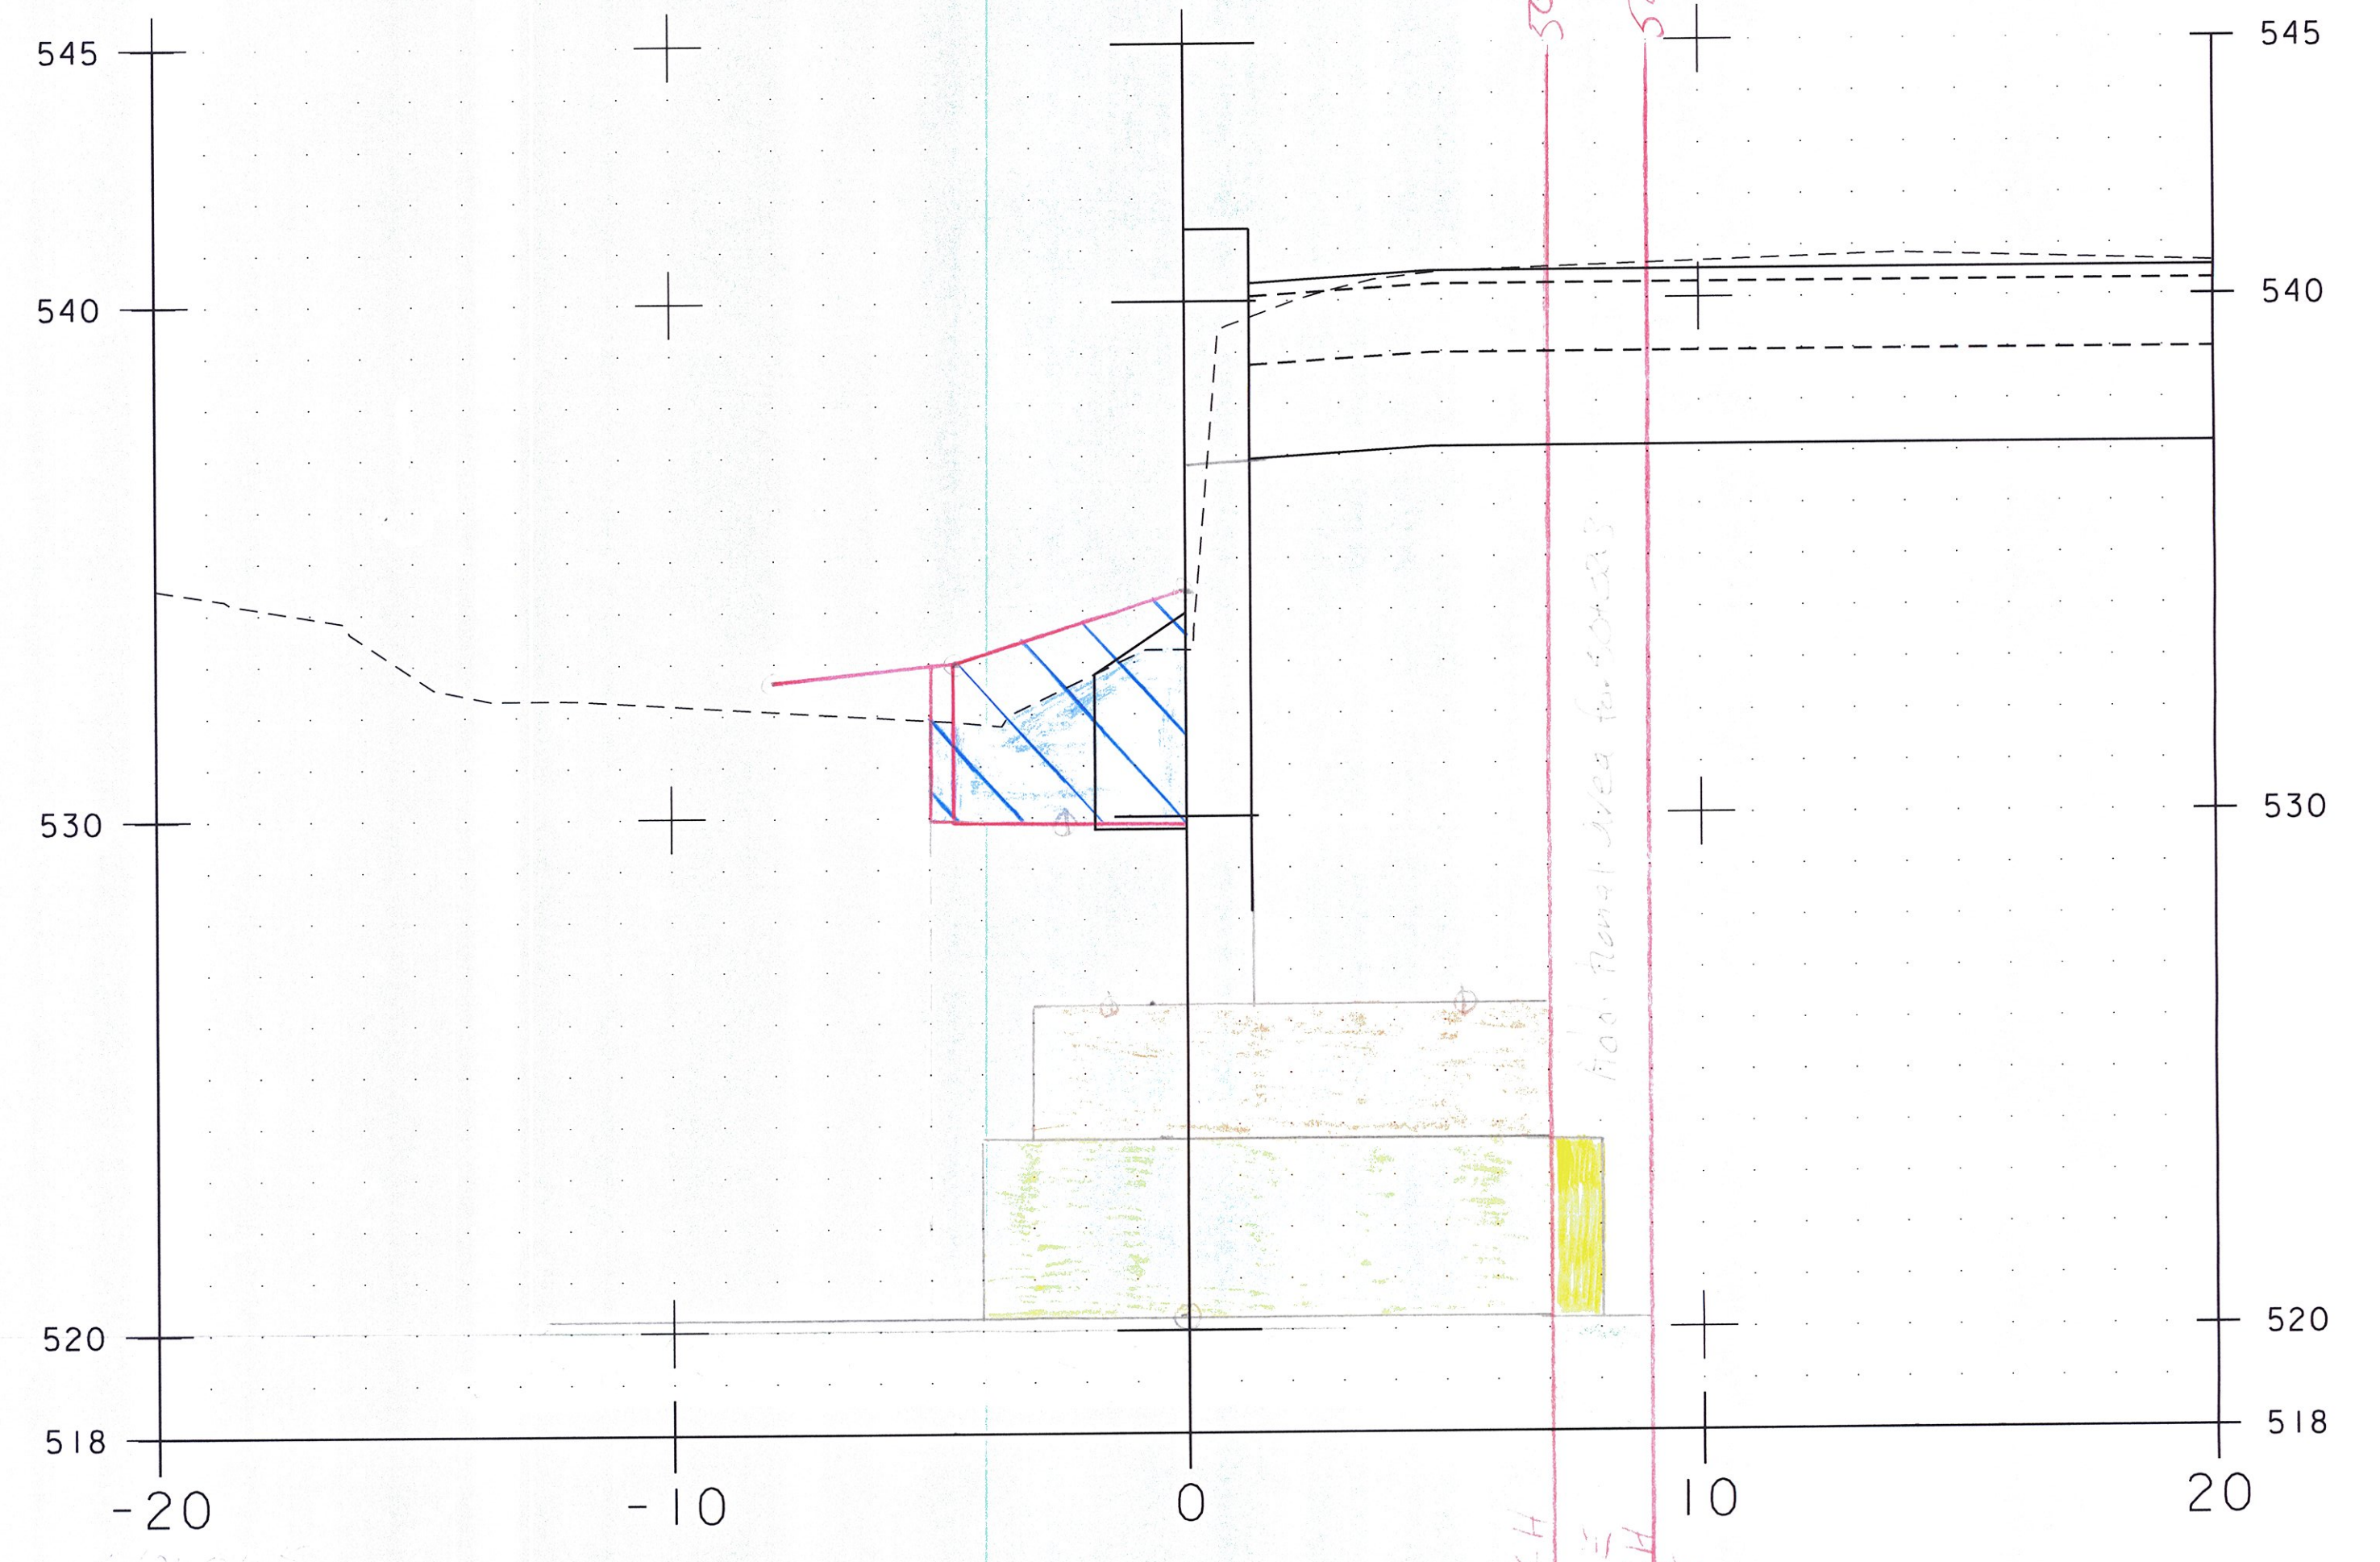


197  
162

450  
139

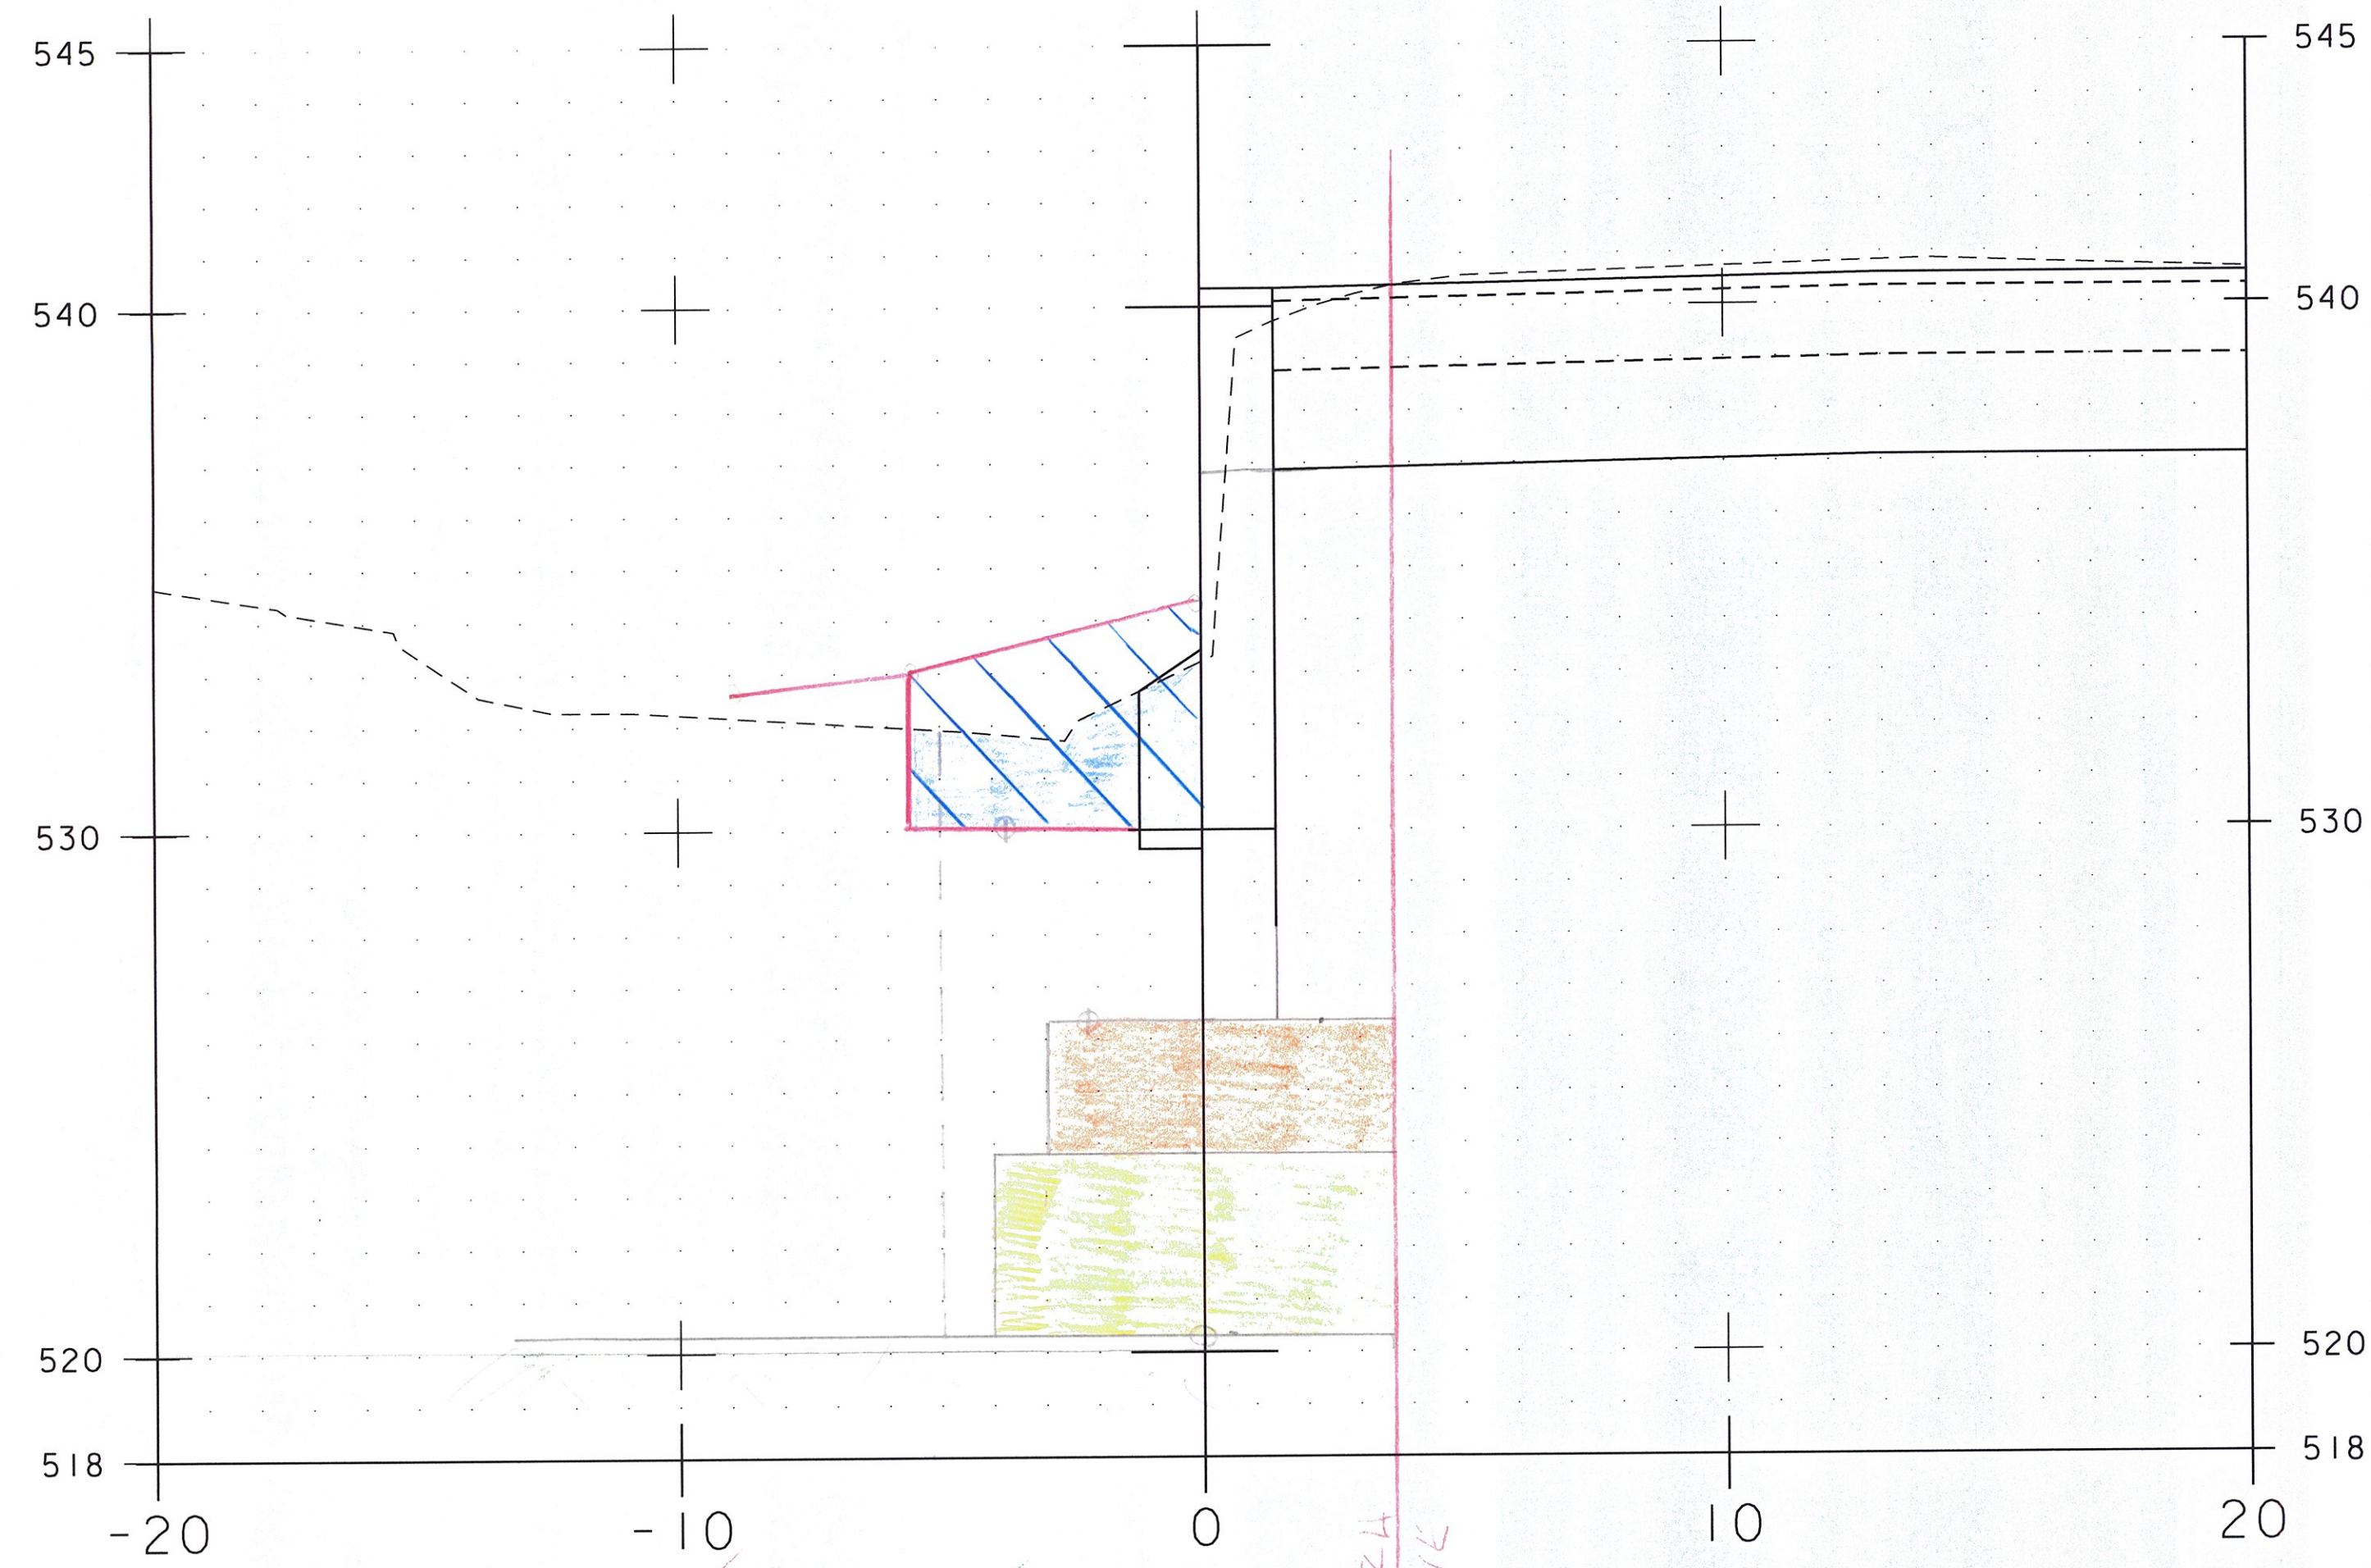

Collarless Earth = 10650' ✓  
 Granular Backfill = 1240' ✓  
 Unclassified Channel Soil = 1300' ✓  
 Stone Fills = 1300' ✓  
 Granular Stone Fills = 13' ✓  
 JDD 7-22-15  
 51.2 ✓  
 50+00.00  
 MATCH LINE

Collarless Earth = 1200' ✓  
 Granular Backfill = 1240' ✓  
 Unclassified Channel Soil = 1300' ✓  
 Stone Fills = 1300' ✓  
 Granular Stone Fills = 13' ✓  
 50+01.50

Collarless Earth = 1463' ✓  
 Granular Backfill = 1240' ✓  
 Unclassified Channel Soil = 1300' ✓  
 Stone Fills = 1800' ✓  
 Granular Stone Fills = 125' ✓  
 50+01.50  
 MATCH LINE

SCALE 1" = 3'-0"



PROJECT NAME:	BRATTLEBORO
PROJECT NUMBER:	BRO 1442(35)
FILE NAME:	z10j062.customEL.dgn
PROJECT LEADER:	S.E. BURBANK
DESIGNED BY:	E.F. LAWES
WINGWALL NO. 2 CROSS SECTIONS (1 OF 4)	
PLOT DATE:	3/2/2015
DRAWN BY:	E.F. LAWES
CHECKED BY:	S.E. BURBANK
SHEET	24 OF 28