


50+08.50 back of area

Collection Basin ✓
 Concrete Substructure ✓
 (60) = 1350' (11') ✓
 (40) = 1100' (11') ✓
 Unexcavated Area ✓
 Stone Fill Area ✓
 Gen. Drainage Pipe ✓
 SDD 2115
 for 11/15

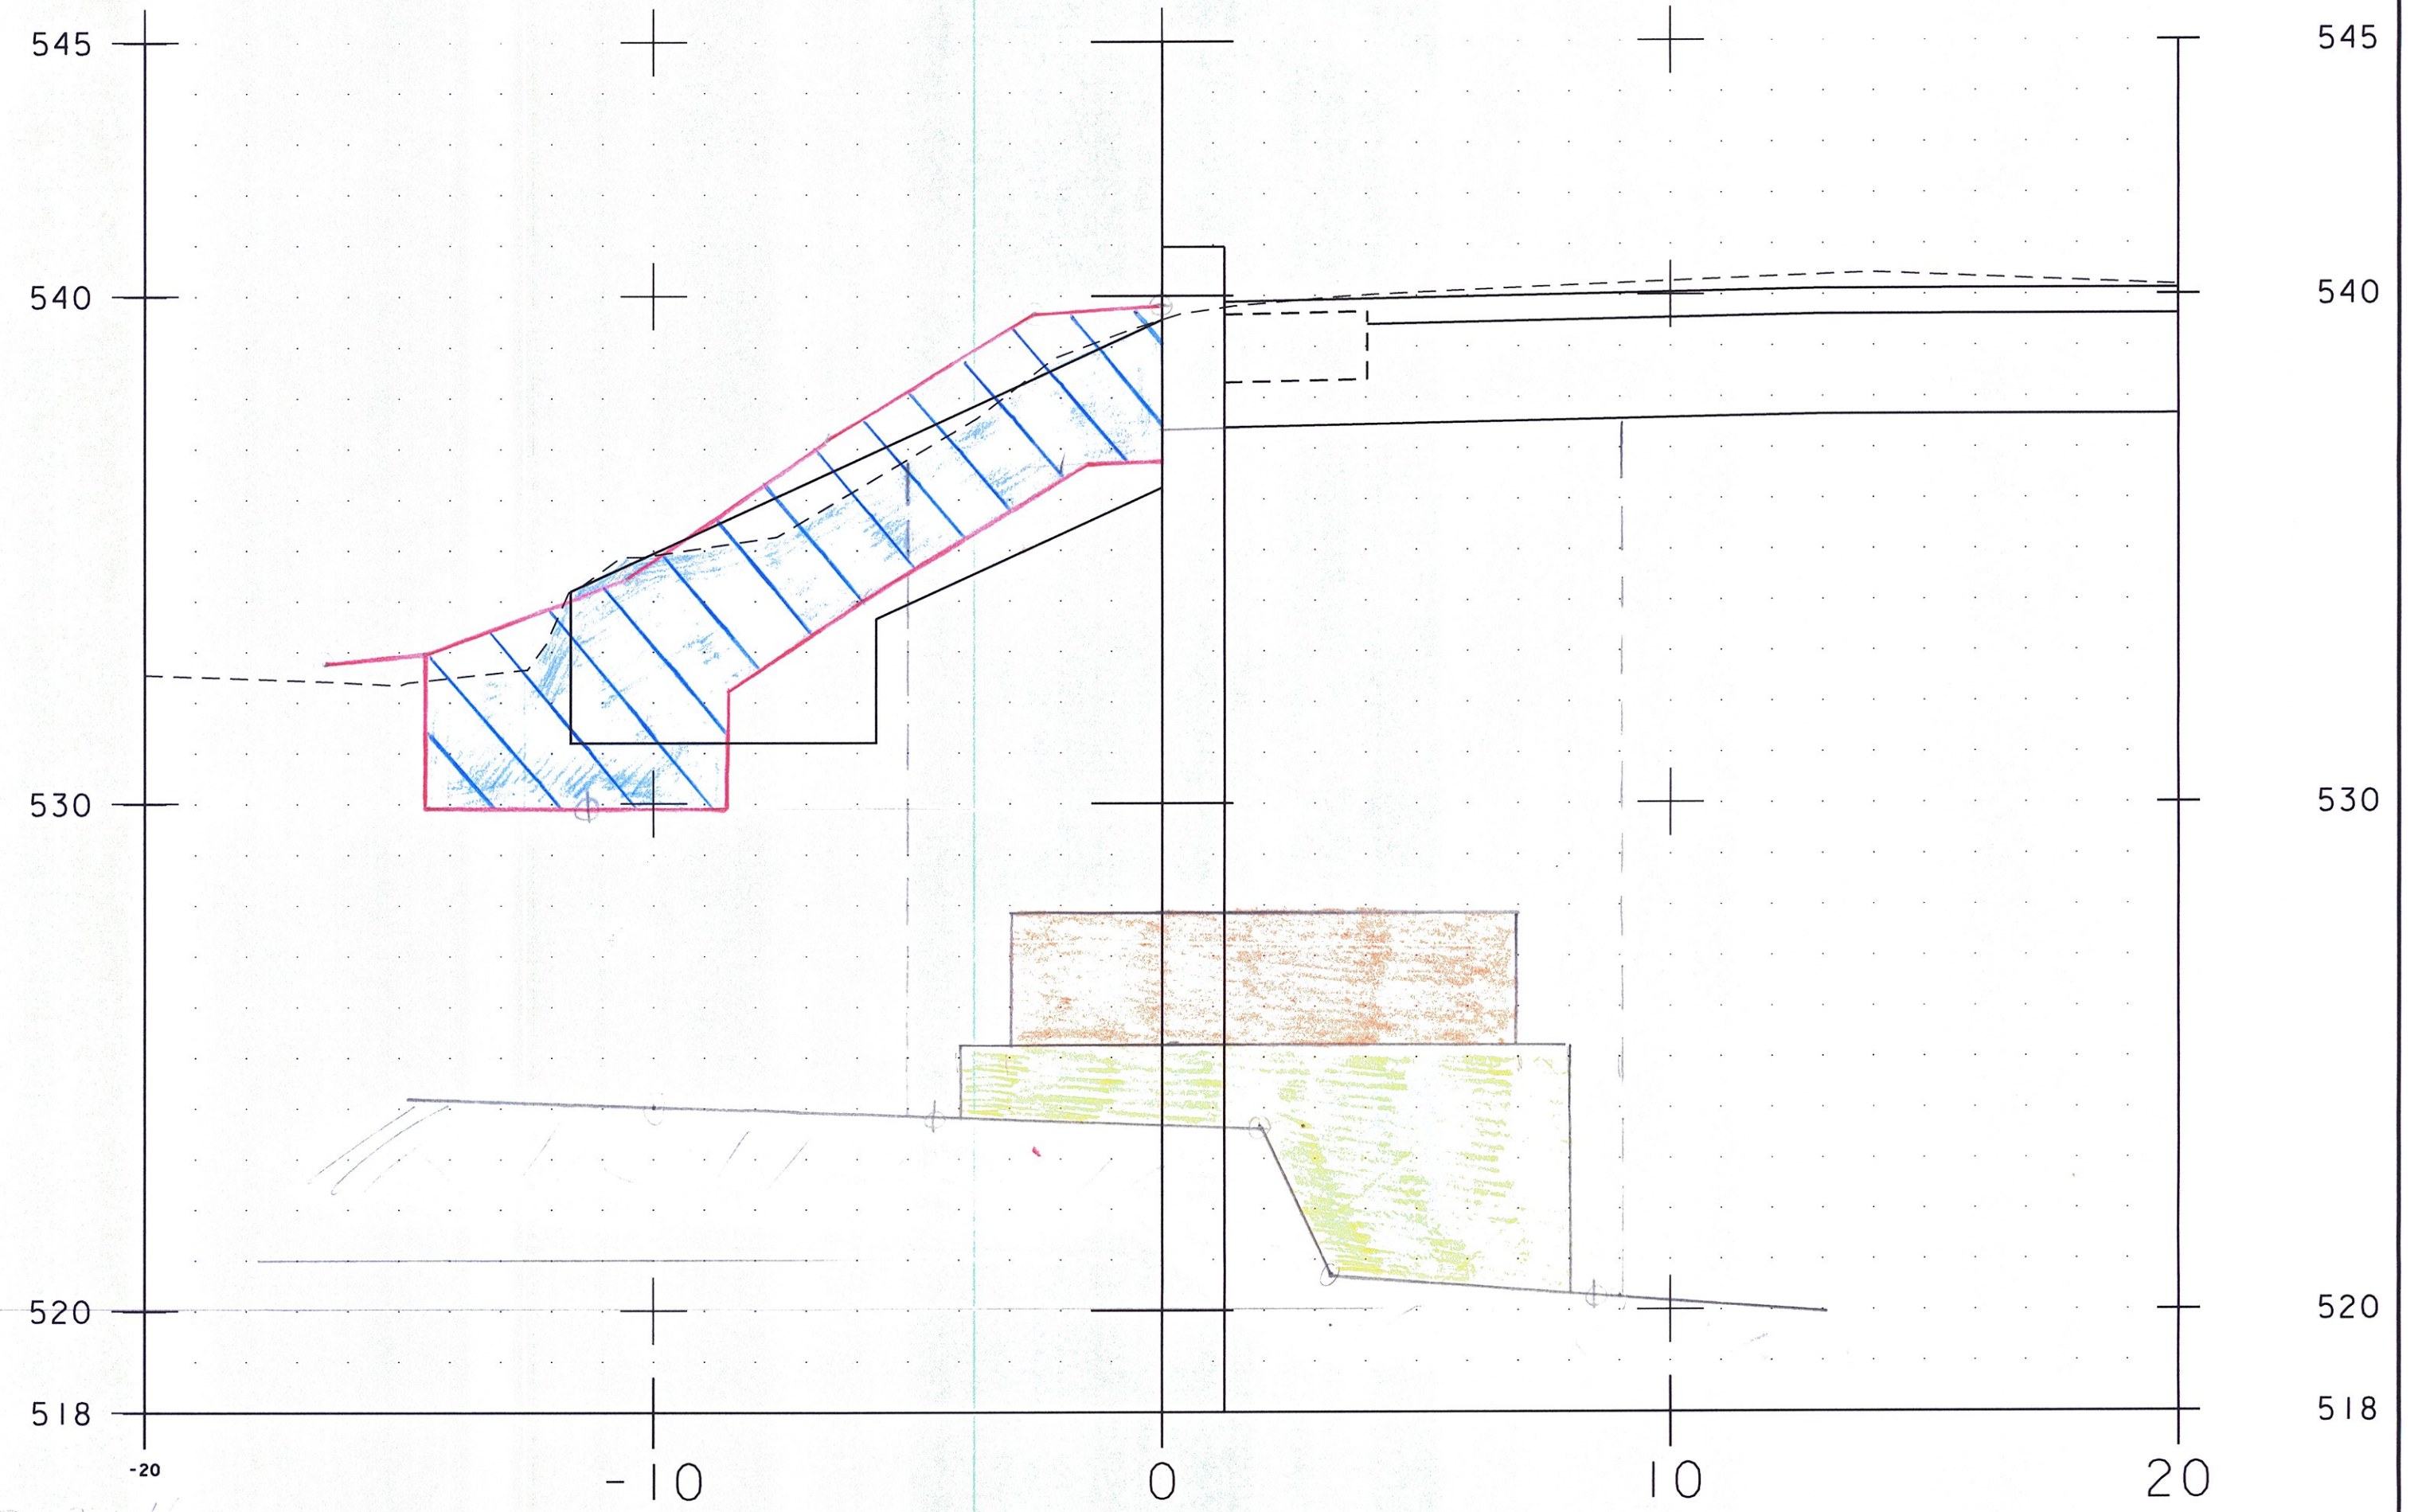

50+22.40 butt section for loading

50+22.4
 Collection Basin ✓
 Concrete Substructure ✓
 (60) = 1350' (11') ✓
 (40) = 1100' (11') ✓
 Unexcavated Area ✓
 Stone Fill Area ✓
 Gen. Drainage Pipe ✓
 SDD 2115
 for 11/15

SCALE 1" = 3'-0"



PROJECT NAME: BRATTLEBORO	
PROJECT NUMBER: BRO 1442(35)	
FILE NAME: z10j062_customEL.dgn	PLOT DATE: 3/2/2015
PROJECT LEADER: S.E. BURBANK	DRAWN BY: E.F. LAWES
DESIGNED BY: E.F. LAWES	CHECKED BY: S.E. BURBANK
WINGWALL NO. 2 CROSS SECTIONS (2 OF 4)	SHEET 25 OF 28