


Cofferdam Earth = 77.0' ✓  
 Granular Base Fill for Structures = 77.7' ✓  
 Discrete Sand Channel Excavation = 81.0' ✓  
 Stone Fill, Type III = 12.4' ✓  
 Geotextile Stone Fill = 16' ✓  
 13.5' ✓ for 7/23/15  
 m.w.h. 6/26/15  
 JDD 7-1-15

19+87.00

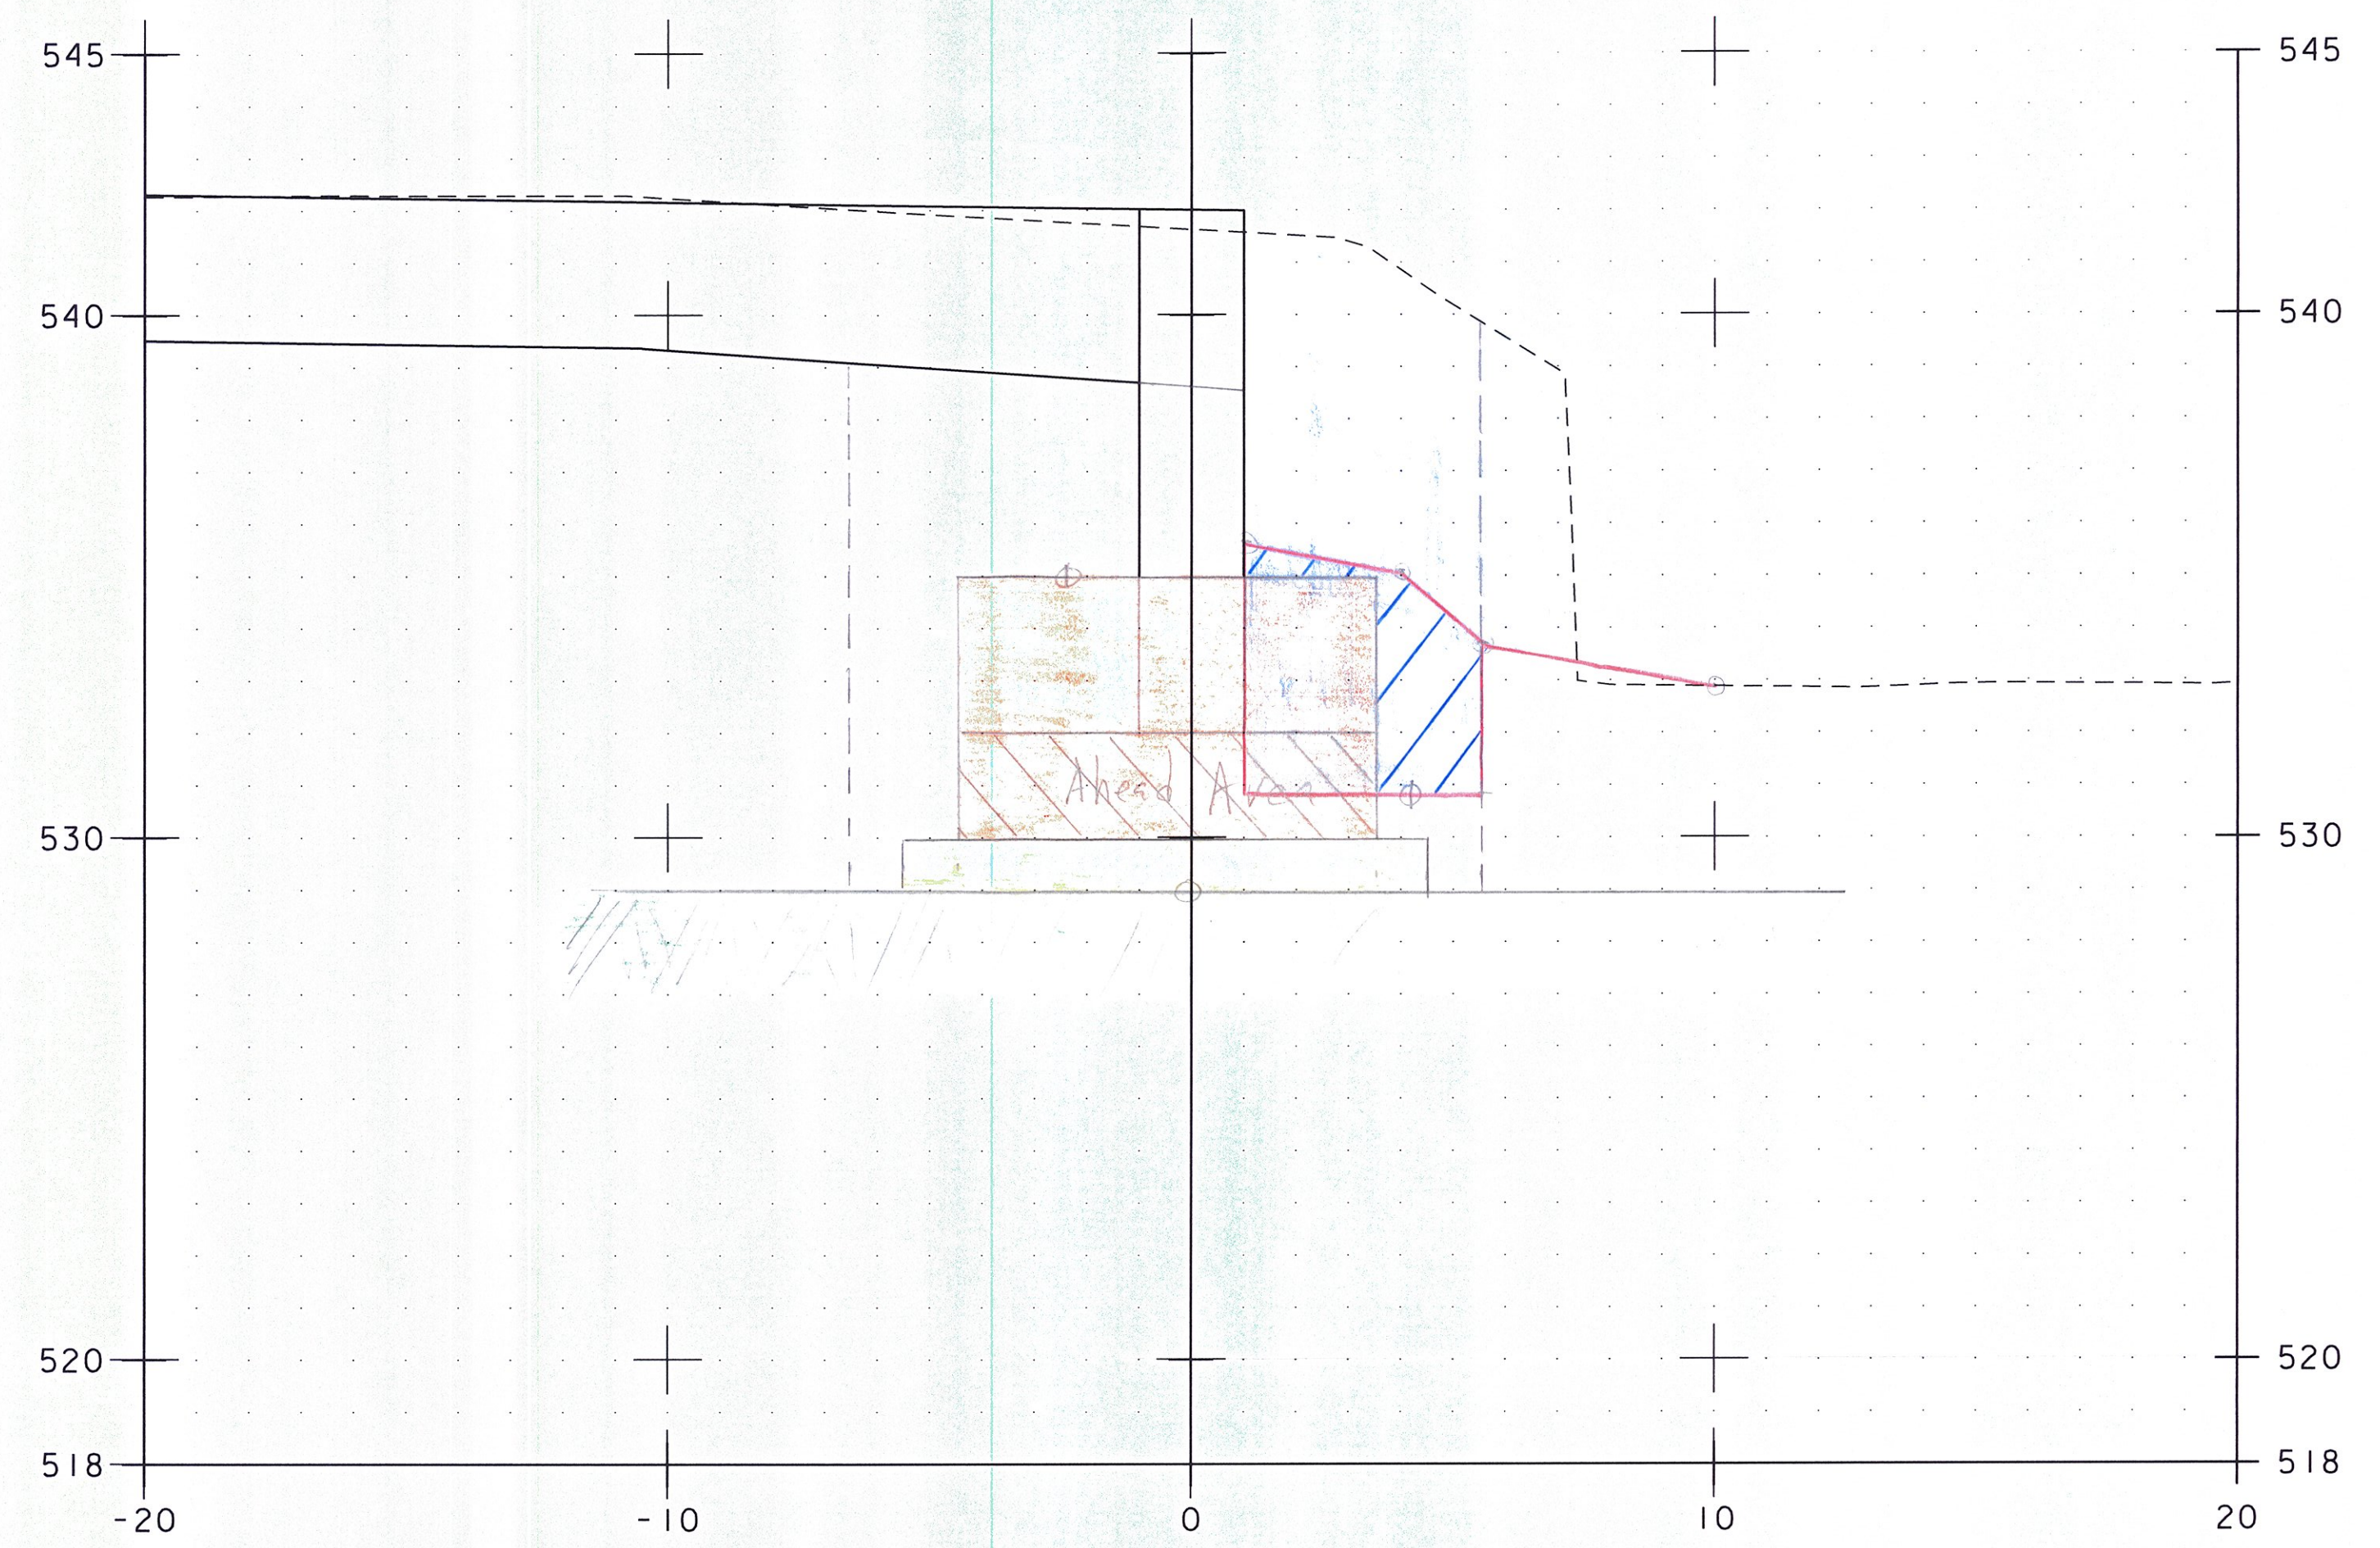

Cofferdam Earth = 82.1' ✓  
 Granular Base Fill for Structures = 82.0' ✓  
 (bk) = 82.0' ✓  
 Geotextile Stone Fill = 49.7' ✓  
 Discrete Sand Channel Excavation = 52.1' ✓  
 Stone Fill, Type III = 14.9' ✓  
 Geotextile Stone Fill = 12.5' ✓  
 m.w.h. 6/26/15

19+89.50 back of canal

NOTE: LOCATION OF SUBBASE IS APPROXIMATE, PROPOSED GRADE IS NOT SHOWN.

PROJECT NAME: BRATTLEBORO	
PROJECT NUMBER: BRO 1442(35)	
FILE NAME: z10j062_customEL.dgn	PLOT DATE: 3/2/2015
PROJECT LEADER: S.E. BURBANK	DRAWN BY: E.F. LAWES
DESIGNED BY: E.F. LAWES	CHECKED BY: S.E. BURBANK
ABUTMENT NO. 2 CROSS SECTIONS (3 OF 9)	SHEET 3 OF 28



SCALE 1" = 3'-0"