


Confirmed Earth = 1010.90 ✓  
 Granular Backfill Structure  
 (L) = 48.2 FT ✓  
 (R) = 63.2 FT ✓  
 Unclassified Channel Bed = 76.0 FT ✓  
 Stone Fill, Type II = 32.9 FT ✓  
 Conc. Under Stone Fill = 16.5 FT ✓  
 M.W.H. 6/26/15 ✓  
 JTB 7-1-15 ✓

19+94.00 back ahead

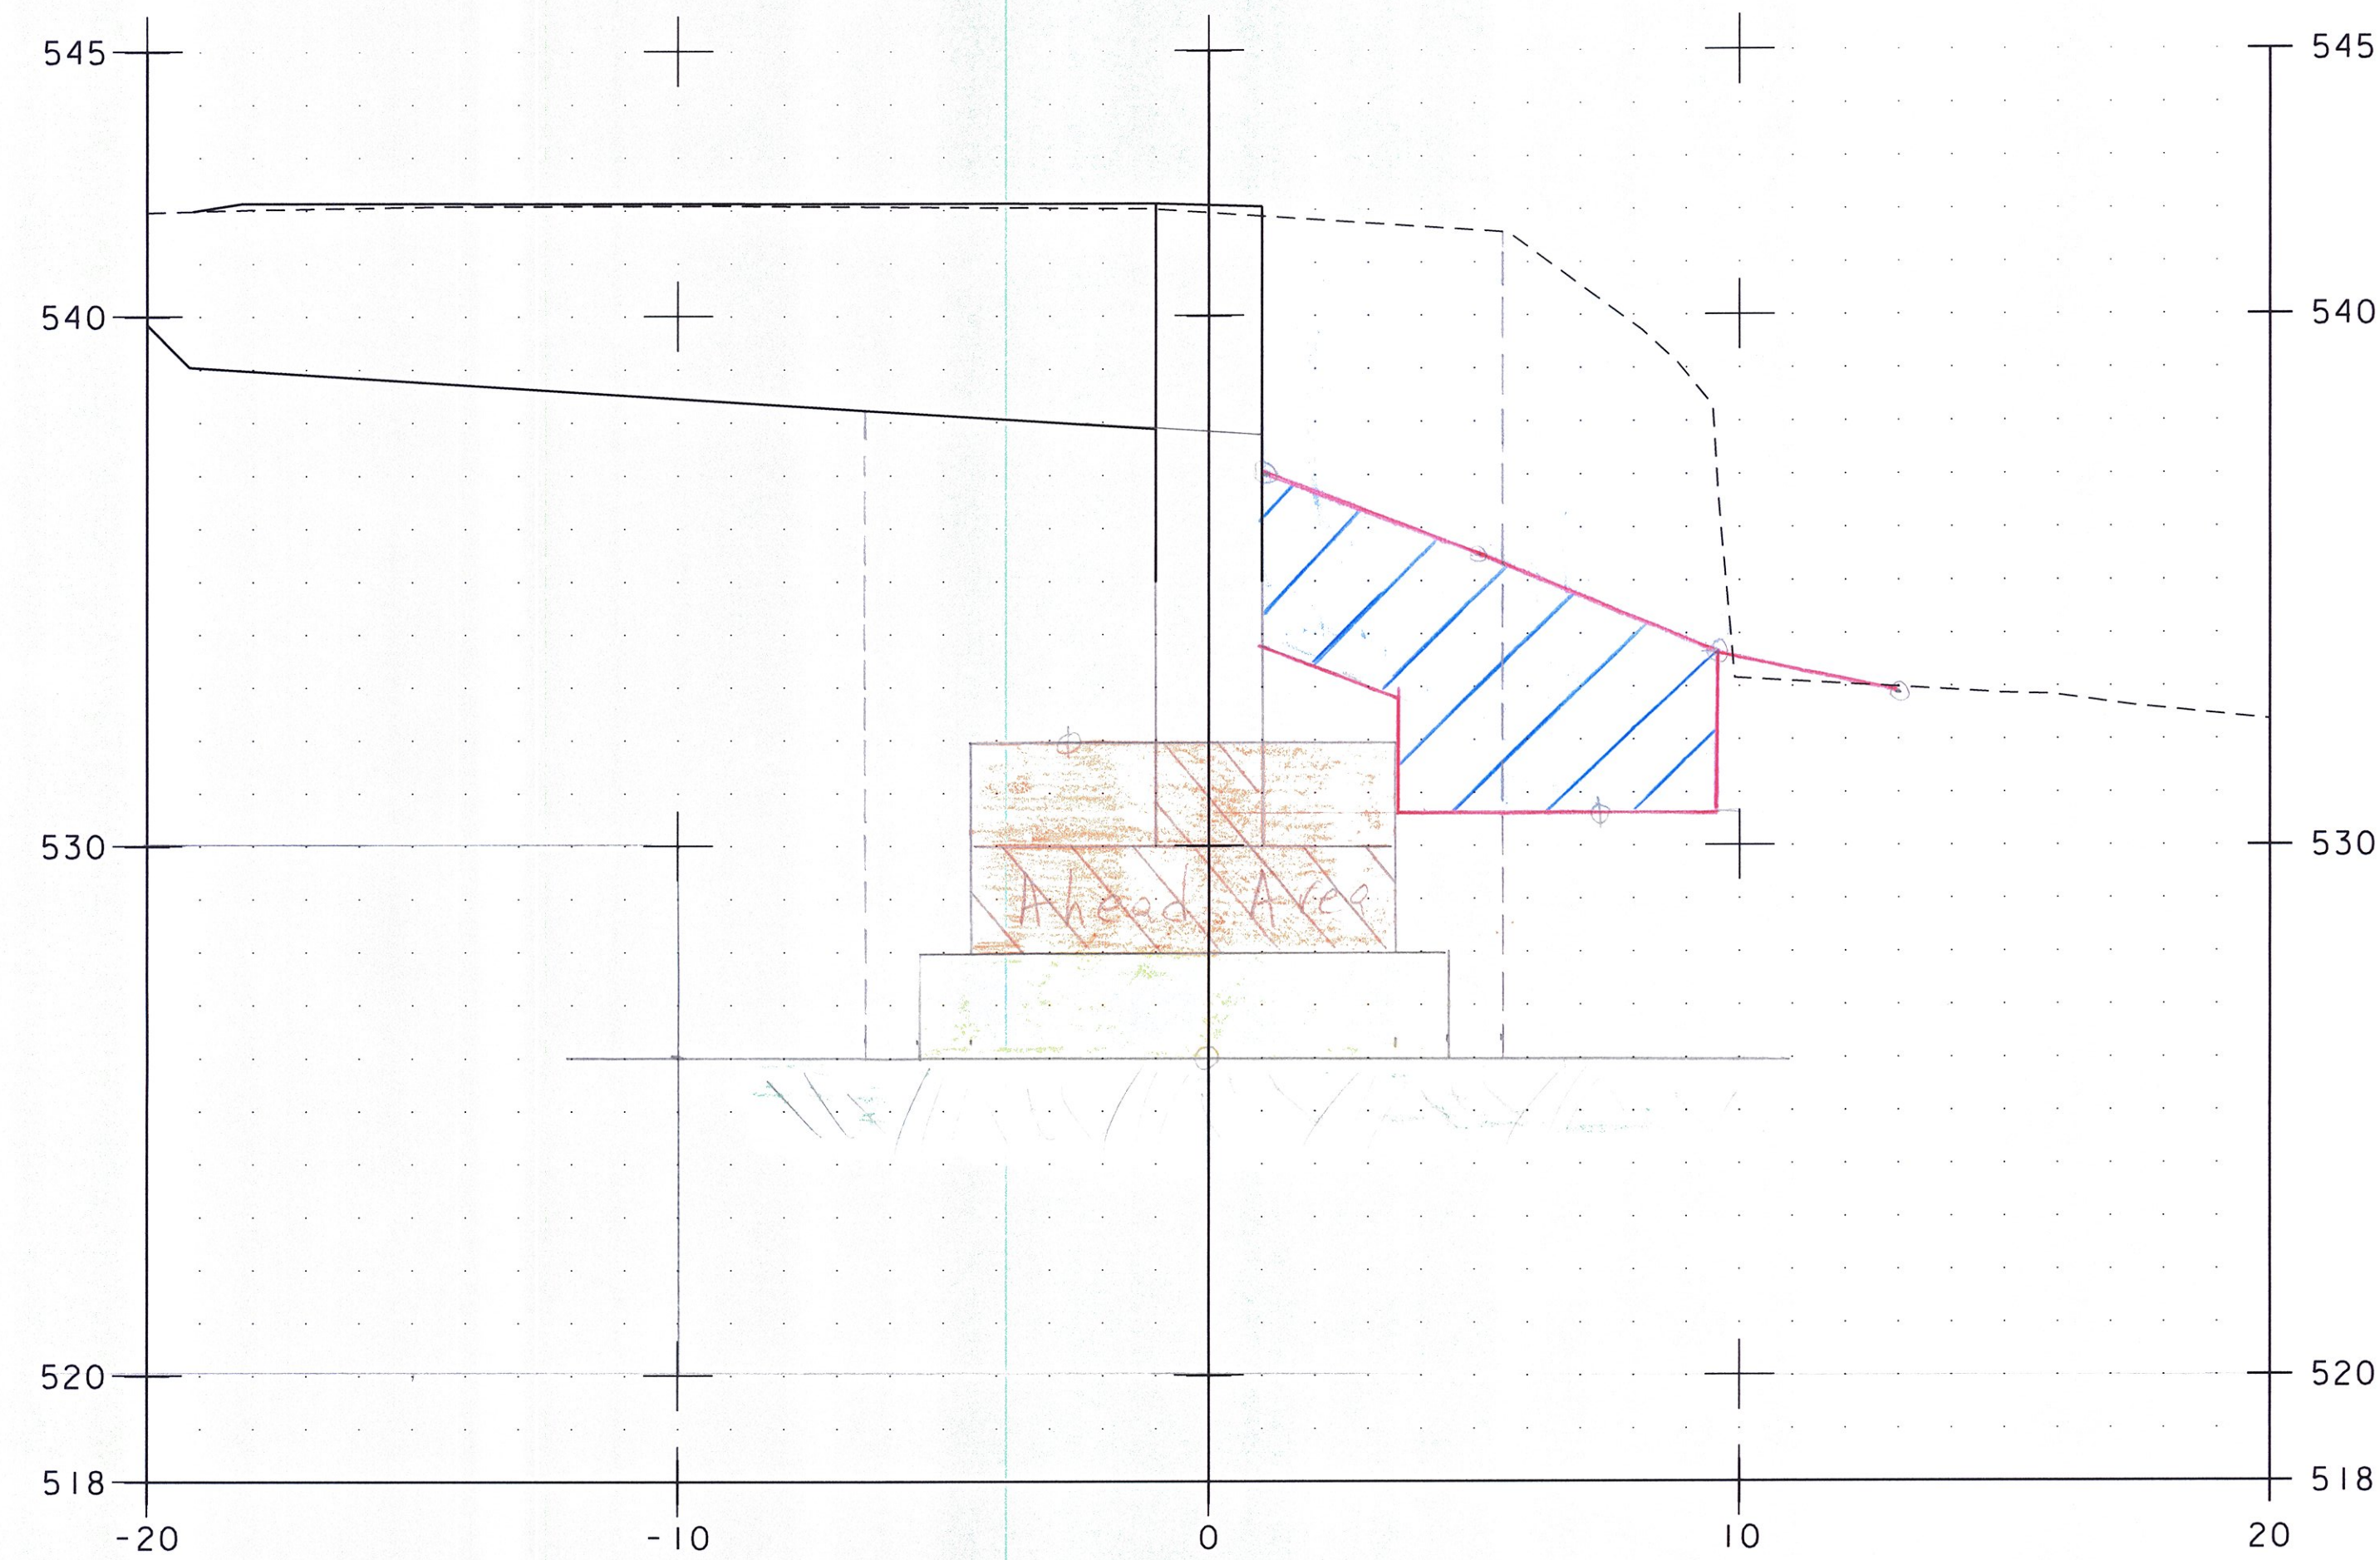

Confirmed Earth = 116.1 FT ✓  
 Granular Backfill Structure  
 (L) = 53.5 FT ✓  
 (R) = 65.3 FT ✓  
 Unclassified Channel Bed = 51.0 FT ✓  
 Stone Fill, Type II = 37.3 FT ✓  
 Conc. Under Stone Fill = 18.7 FT ✓  
 M.W.H. 6/26/15 ✓  
 JTB 7-1-15 ✓

19+99.00 back ahead

NOTE: LOCATION OF SUBBASE IS APPROXIMATE, PROPOSED GRADE IS NOT SHOWN.

|  |                          |
|--|--------------------------|
| PROJECT NAME: BRATTLEBORO              |                          |
| PROJECT NUMBER: BRO 1442(35)           |                          |
| FILE NAME: z10j062_customEL.dgn        | PLOT DATE: 3/2/2015      |
| PROJECT LEADER: S.E. BURBANK           | DRAWN BY: E.F. LAWES     |
| DESIGNED BY: E.F. LAWES                | CHECKED BY: S.E. BURBANK |
| ABUTMENT NO. 2 CROSS SECTIONS (4 OF 9) | SHEET 4 OF 28            |



SCALE 1" = 3'-0"