


Cofferdam Earth = 185.7 FT<sup>3</sup> ✓  
 Granular Base Fill for Str = 86.4 FT<sup>3</sup> ✓  
 Unclassified Channel Exc = 98.8 FT<sup>3</sup> ✓  
 Stone Fill, Type II = 38.4 FT<sup>3</sup> ✓  
 Geo. Under Stone Fill = 18.5' M.W.H. 6/26/15  
 JLD 5/15/15  
 JDD 7/15

20+11.50

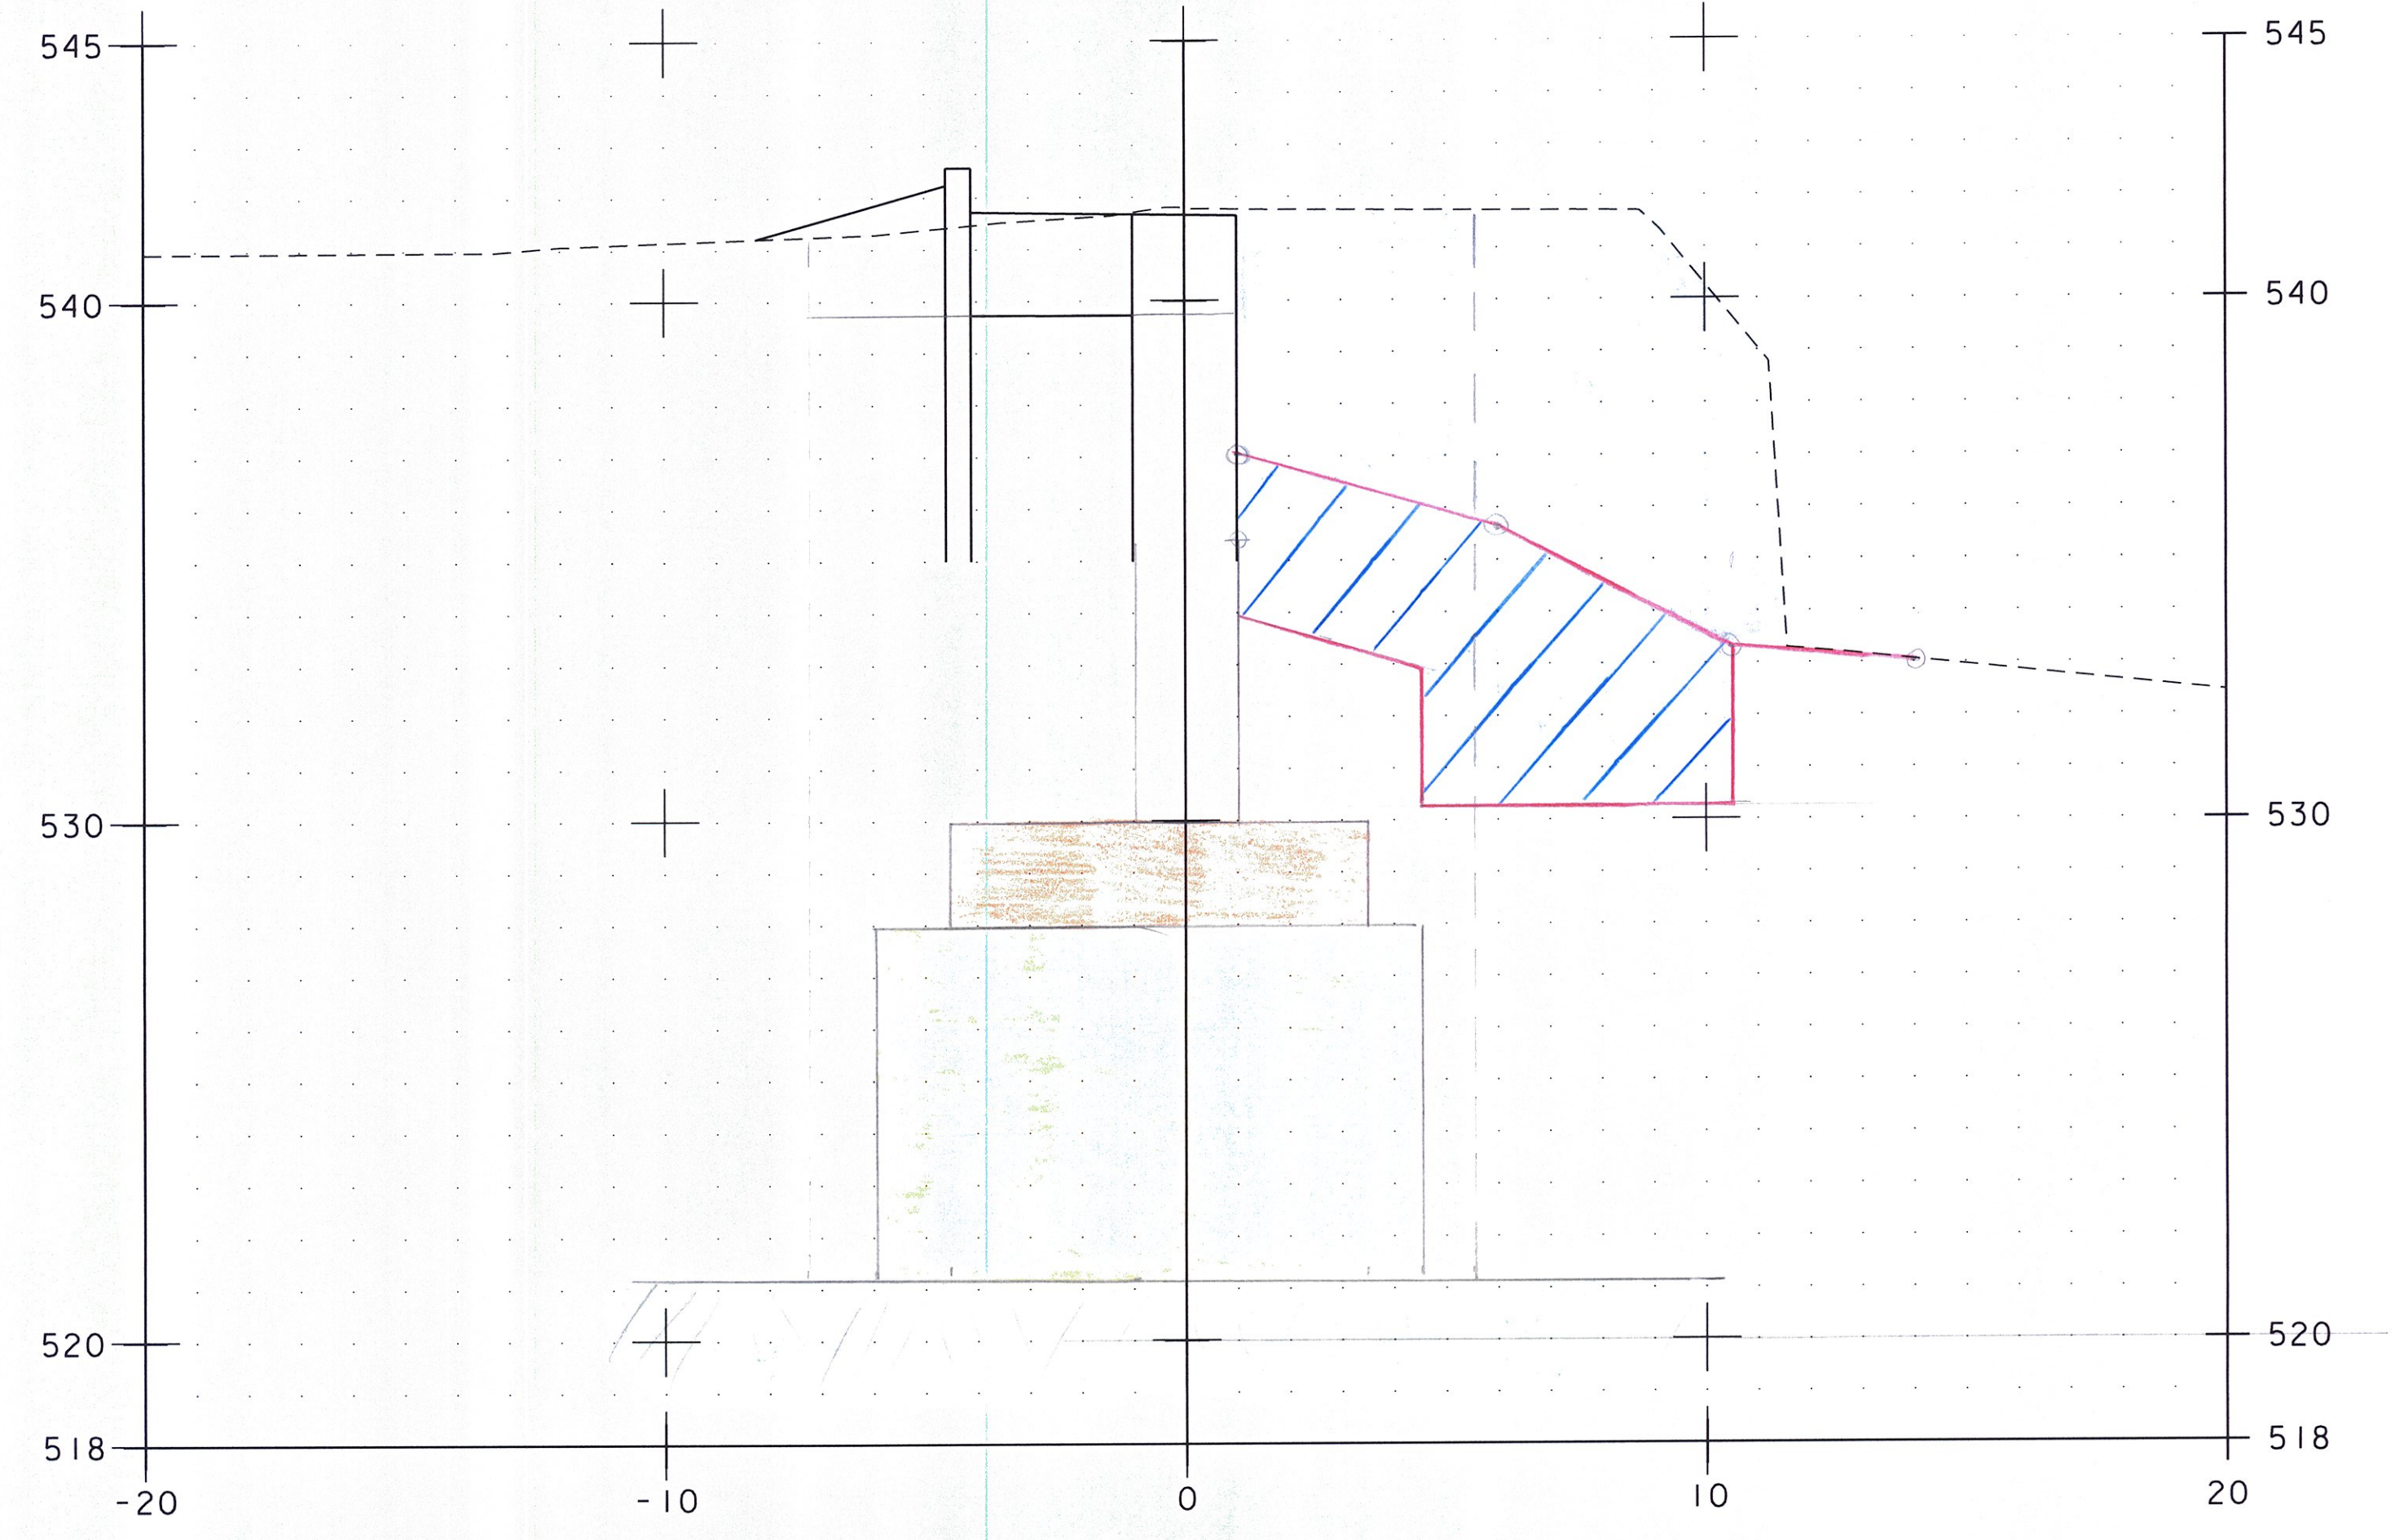

Cofferdam Earth = 204.8 FT<sup>3</sup> ✓  
 Granular Base Fill for Str = 97.5 FT<sup>3</sup> ✓  
 Unclassified Channel Exc = 100.0 FT<sup>3</sup> ✓  
 Stone Fill, Type II = 35.0 FT<sup>3</sup> ✓  
 Geo. Under Stone Fill = 13.5' M.W.H. 6/26/15  
 JLD 5/15/15

20+12.50

SCALE 1" = 3'-0"

NOTE: LOCATION OF SUBBASE IS APPROXIMATE, PROPOSED GRADE IS NOT SHOWN.



PROJECT NAME: BRATTLEBORO	
PROJECT NUMBER: BRO 1442(35)	
FILE NAME: z10j062_customEL.dgn	PLOT DATE: 3/2/2015
PROJECT LEADER: S.E. BURBANK	DRAWN BY: E.F. LAWES
DESIGNED BY: E.F. LAWES	CHECKED BY: S.E. BURBANK
ABUTMENT NO. 2 CROSS SECTIONS (5 OF 9)	SHEET 5 OF 28