



249

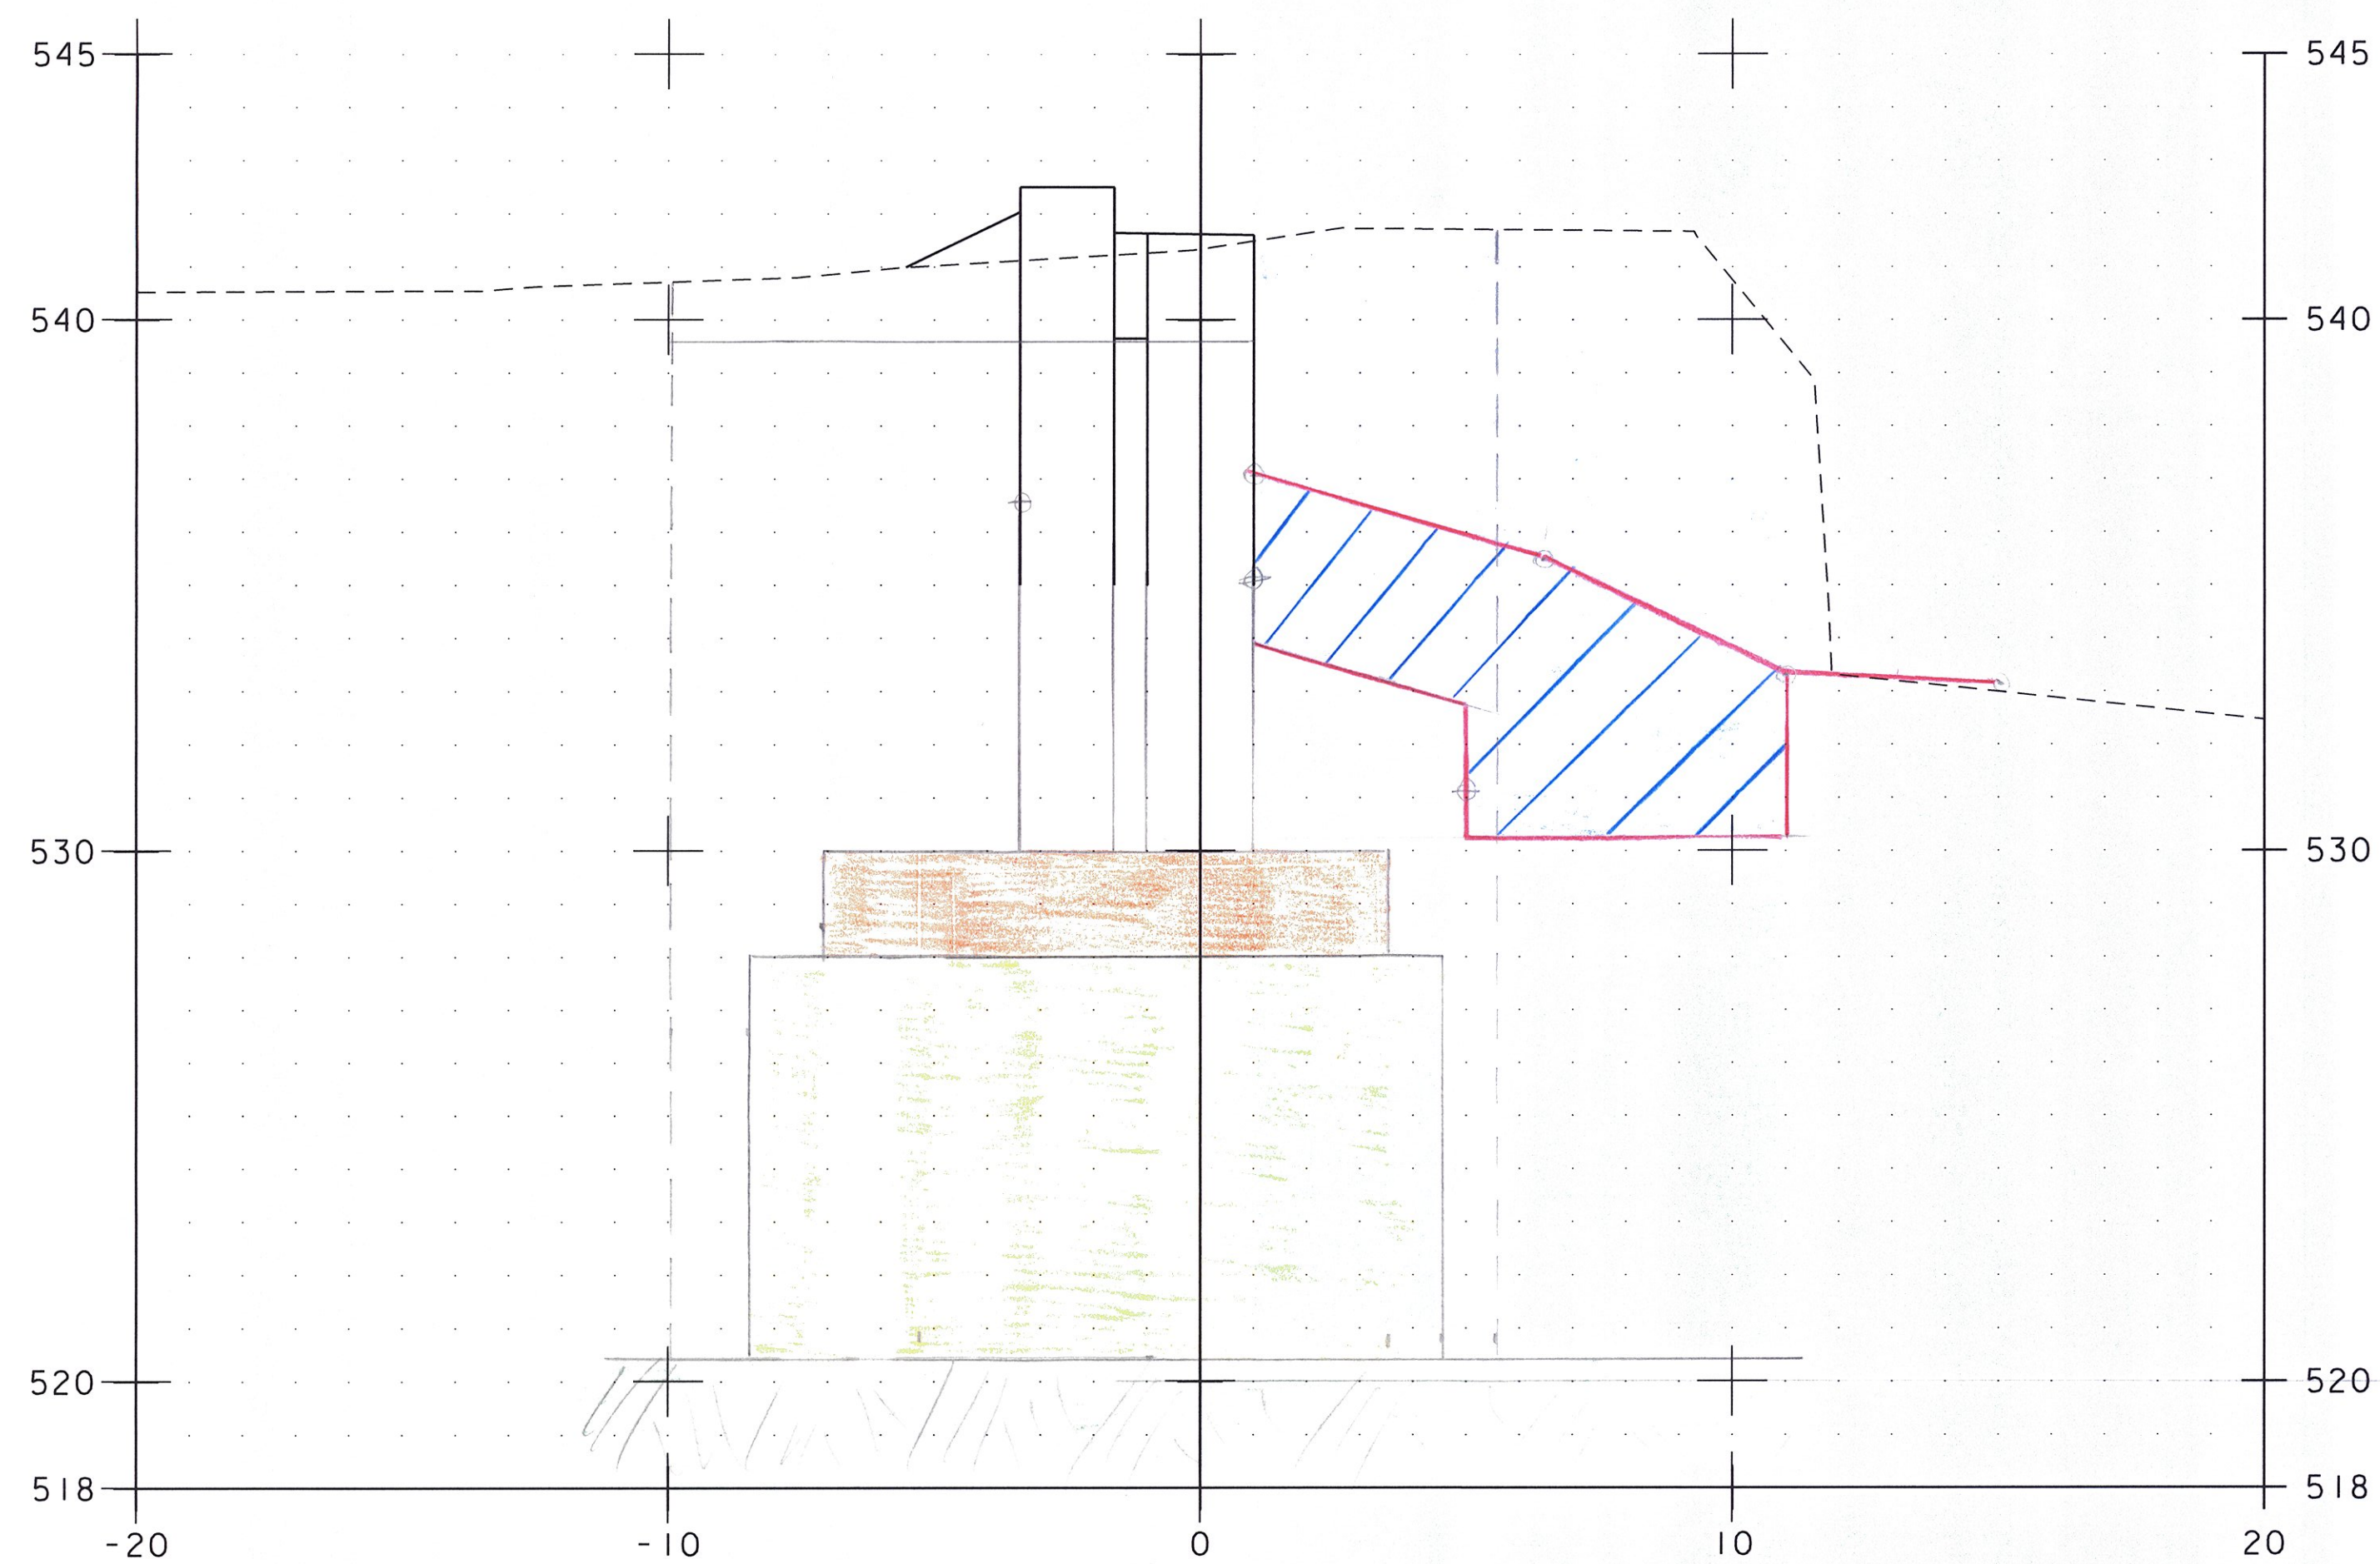

Cofferdam Earth = 2641 FT³ ✓
 Granular backfill (ex. SW) = 103.7 FT³ ✓
 Unclassified Channel Exc = 102.9 FT³ ✓
 Stone Fill, type III = 40.0 FT³ ✓
 Geo. Under Stone Fill = 19' M.W.H. 6/26/15
 JFD 7-1-15

20+15.00

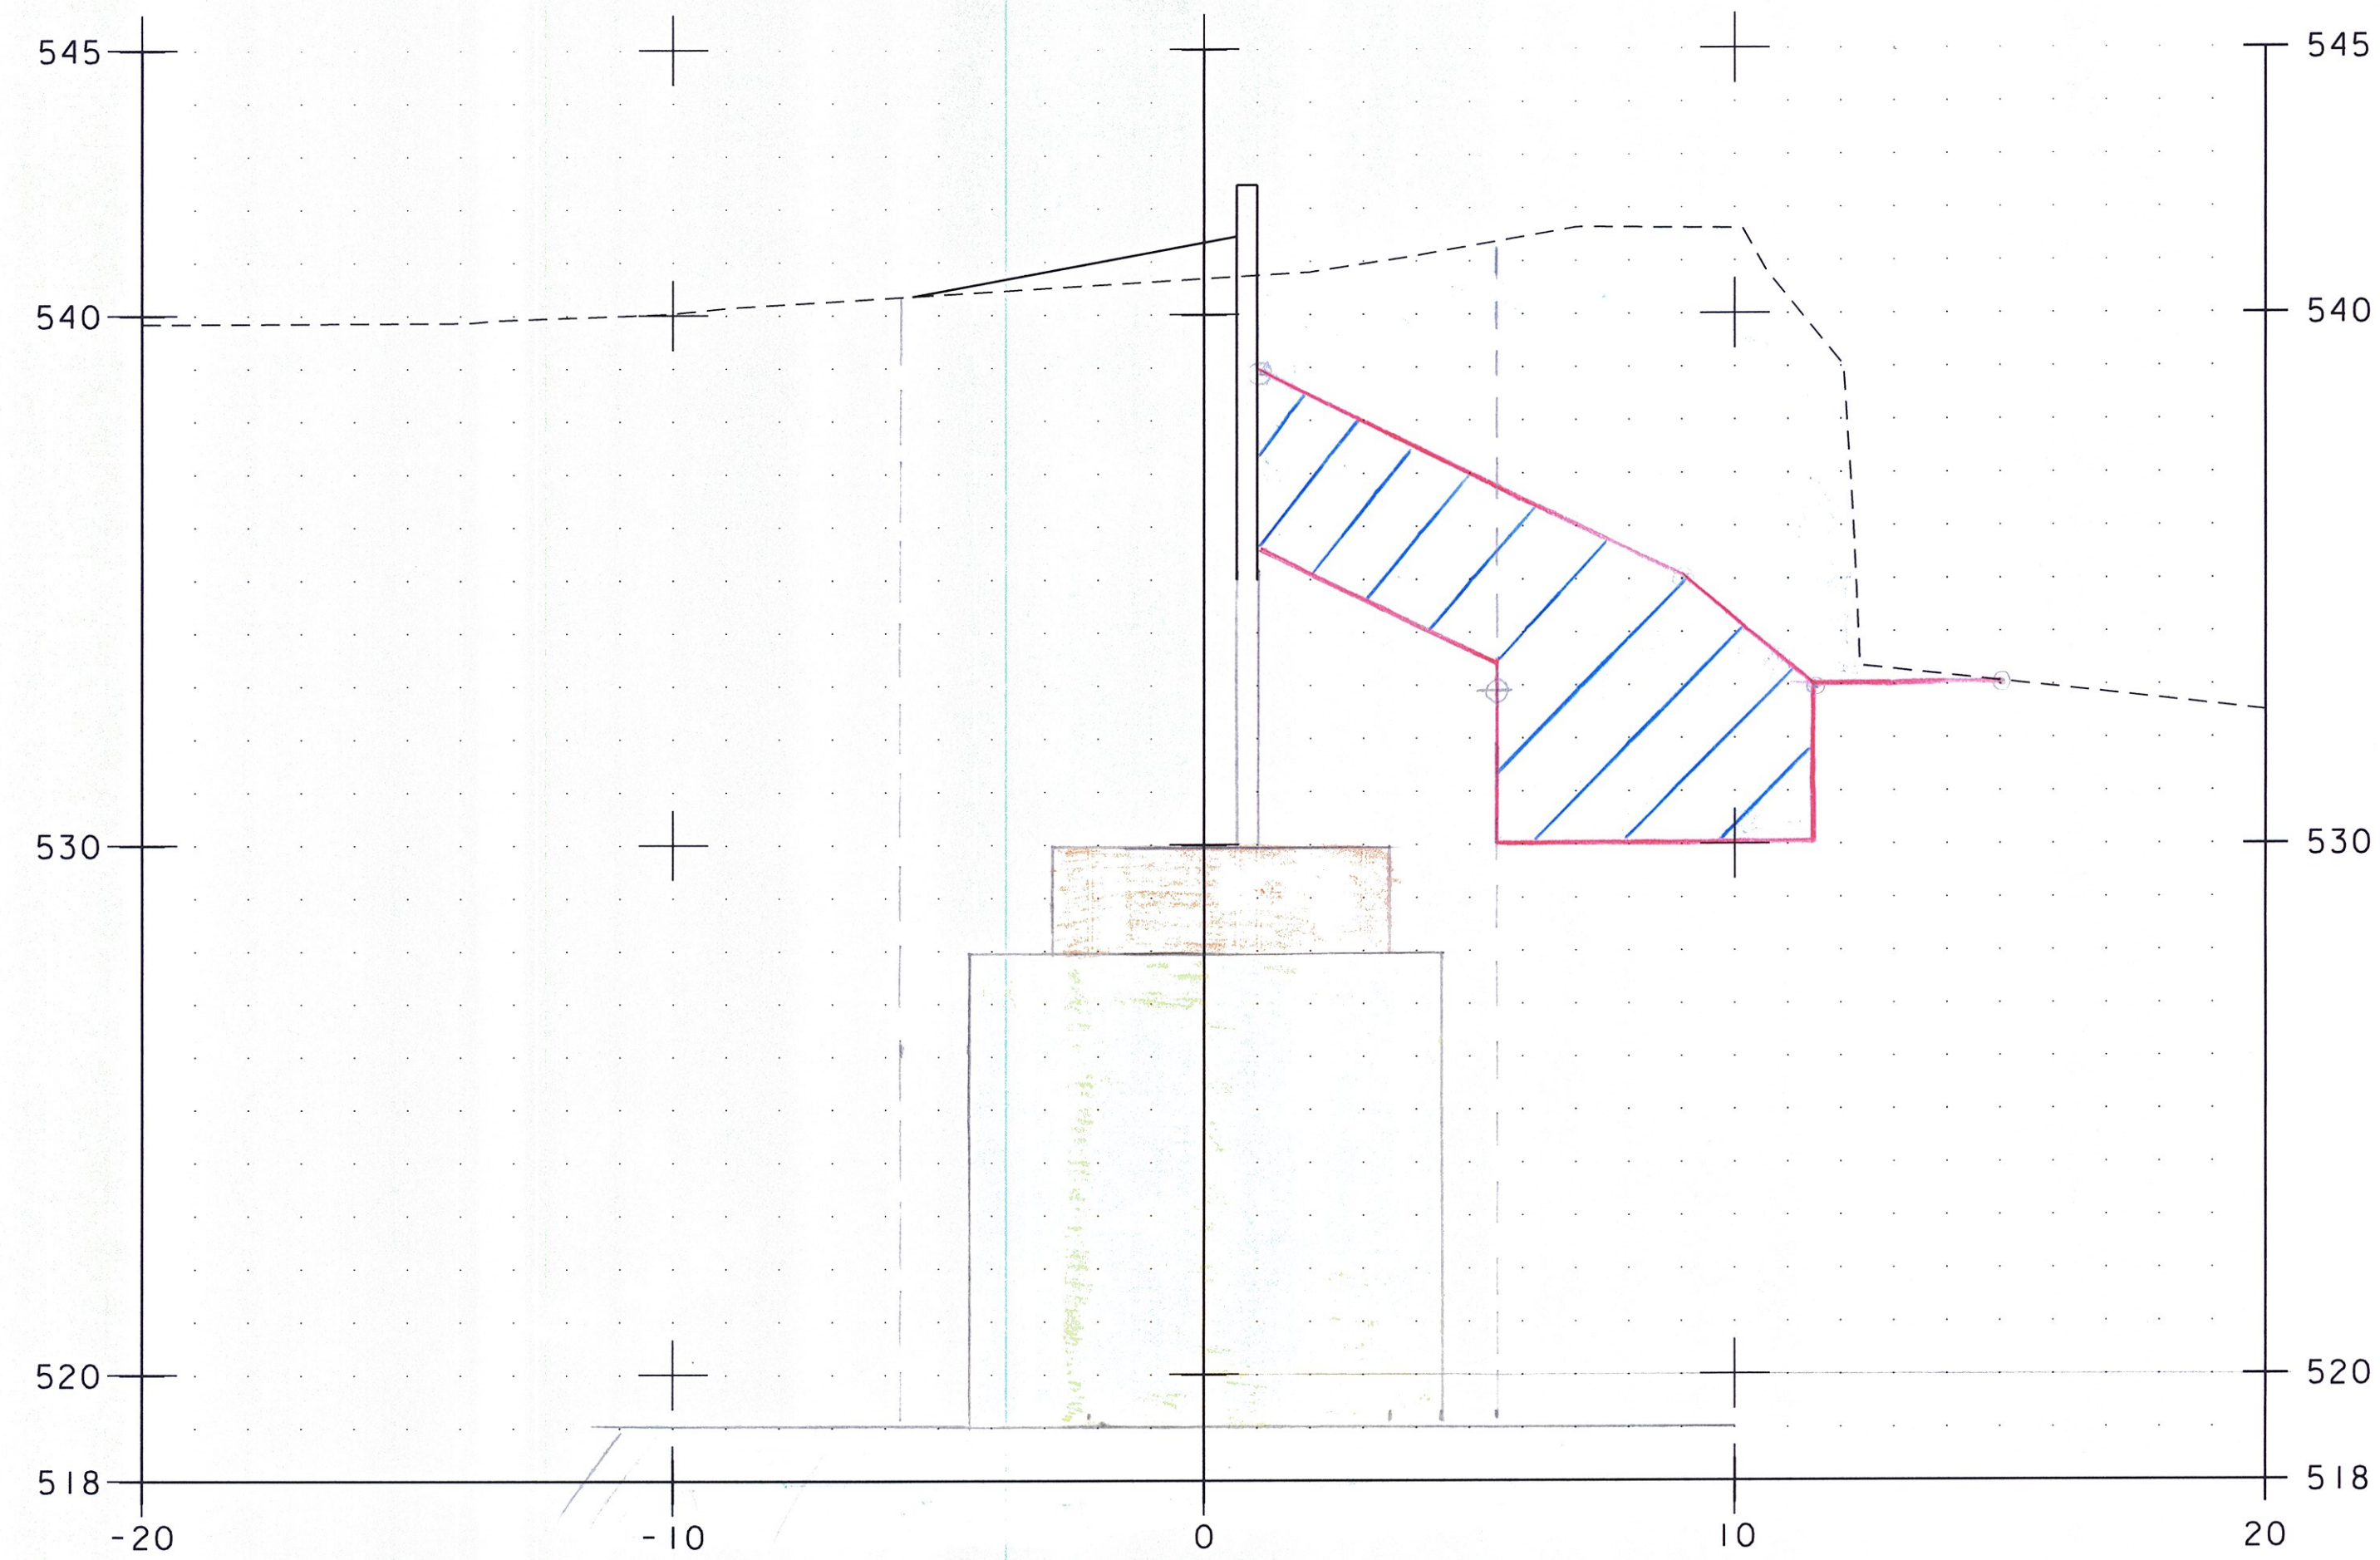

Cofferdam Earth = 213.5 FT³ ✓
 Granular backfill (ex. SW) = 121.0 FT³ ✓
 Unclassified Channel Exc = 50.0 FT³ ✓
 Stone Fill, type III = 45.0 FT³ ✓
 Geo. Under Stone Fill = 21' M.W.H. 6/26/15
 JFD 7-1-15

20+19.00

NOTE: LOCATION OF SUBBASE IS APPROXIMATE,
PROPOSED GRADE IS NOT SHOWN.

PROJECT NAME: BRATTLEBORO
 PROJECT NUMBER: BRO 1442(35)

FILE NAME: z10j062_customEL.dgn
 PROJECT LEADER: S.E. BURBANK
 DESIGNED BY: E.F. LAWES
 ABUTMENT NO. 2 CROSS SECTIONS (6 OF 9) SHEET 6 OF 28

PLOT DATE: 3/2/2015
 DRAWN BY: E.F. LAWES
 CHECKED BY: S.E. BURBANK

SCALE 1" = 3'-0"

